

TIMBERLINE PARK
DEAN ECHELBERGER ~ DEVELOPER

The City of Mountlake Terrace

APPLICATION

for

SIDE SEWER PERMIT

OUTSIDE ☒ INSIDE ☐ REPAIRS ☐

CARD No. _____

EASEMENT No. _____

OWNER _____ CONTRACTOR UNIVERSAL UTIL. CO. INC.

HOUSE No. 22403 36TH AVE W STREET EDMONDS, WASH PERMIT No. 74-14


AVENUE LOT No. 12 BLOCK No. _____

NAME ADD _____



12 11

13 12

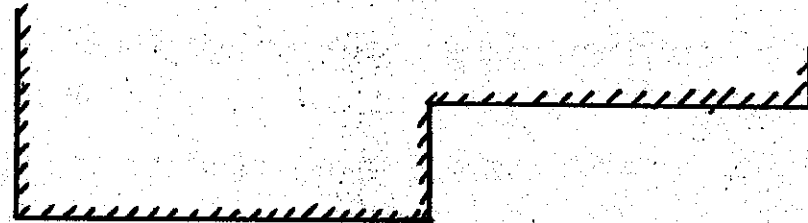

CO. (2' DEEP)

4" CLAY

CO. (3' DEEP)

★ PERMIT NO. UA-75-52
ISSUED TO LYNNWOOD
SEPTIC TANK.
INSPECTED & APPROVED
7-28-75.. W.H. VAN RY. ★

8' deep

6" CONC

36TH AVE W

8" S.S.

290' TO MH 4

290'

BACKFILL WORK ORDER ISSUED 7-1-74

SEWER WORK ORDER ISSUED 4-15-74
MAIN & SERVICE TO DIL

DEPOSIT, \$ _____

Approved: _____

DATE 8-74

BY F.H. SMITH

DWG
11/19/74