


As Built  
PERMIT # U-14-0033

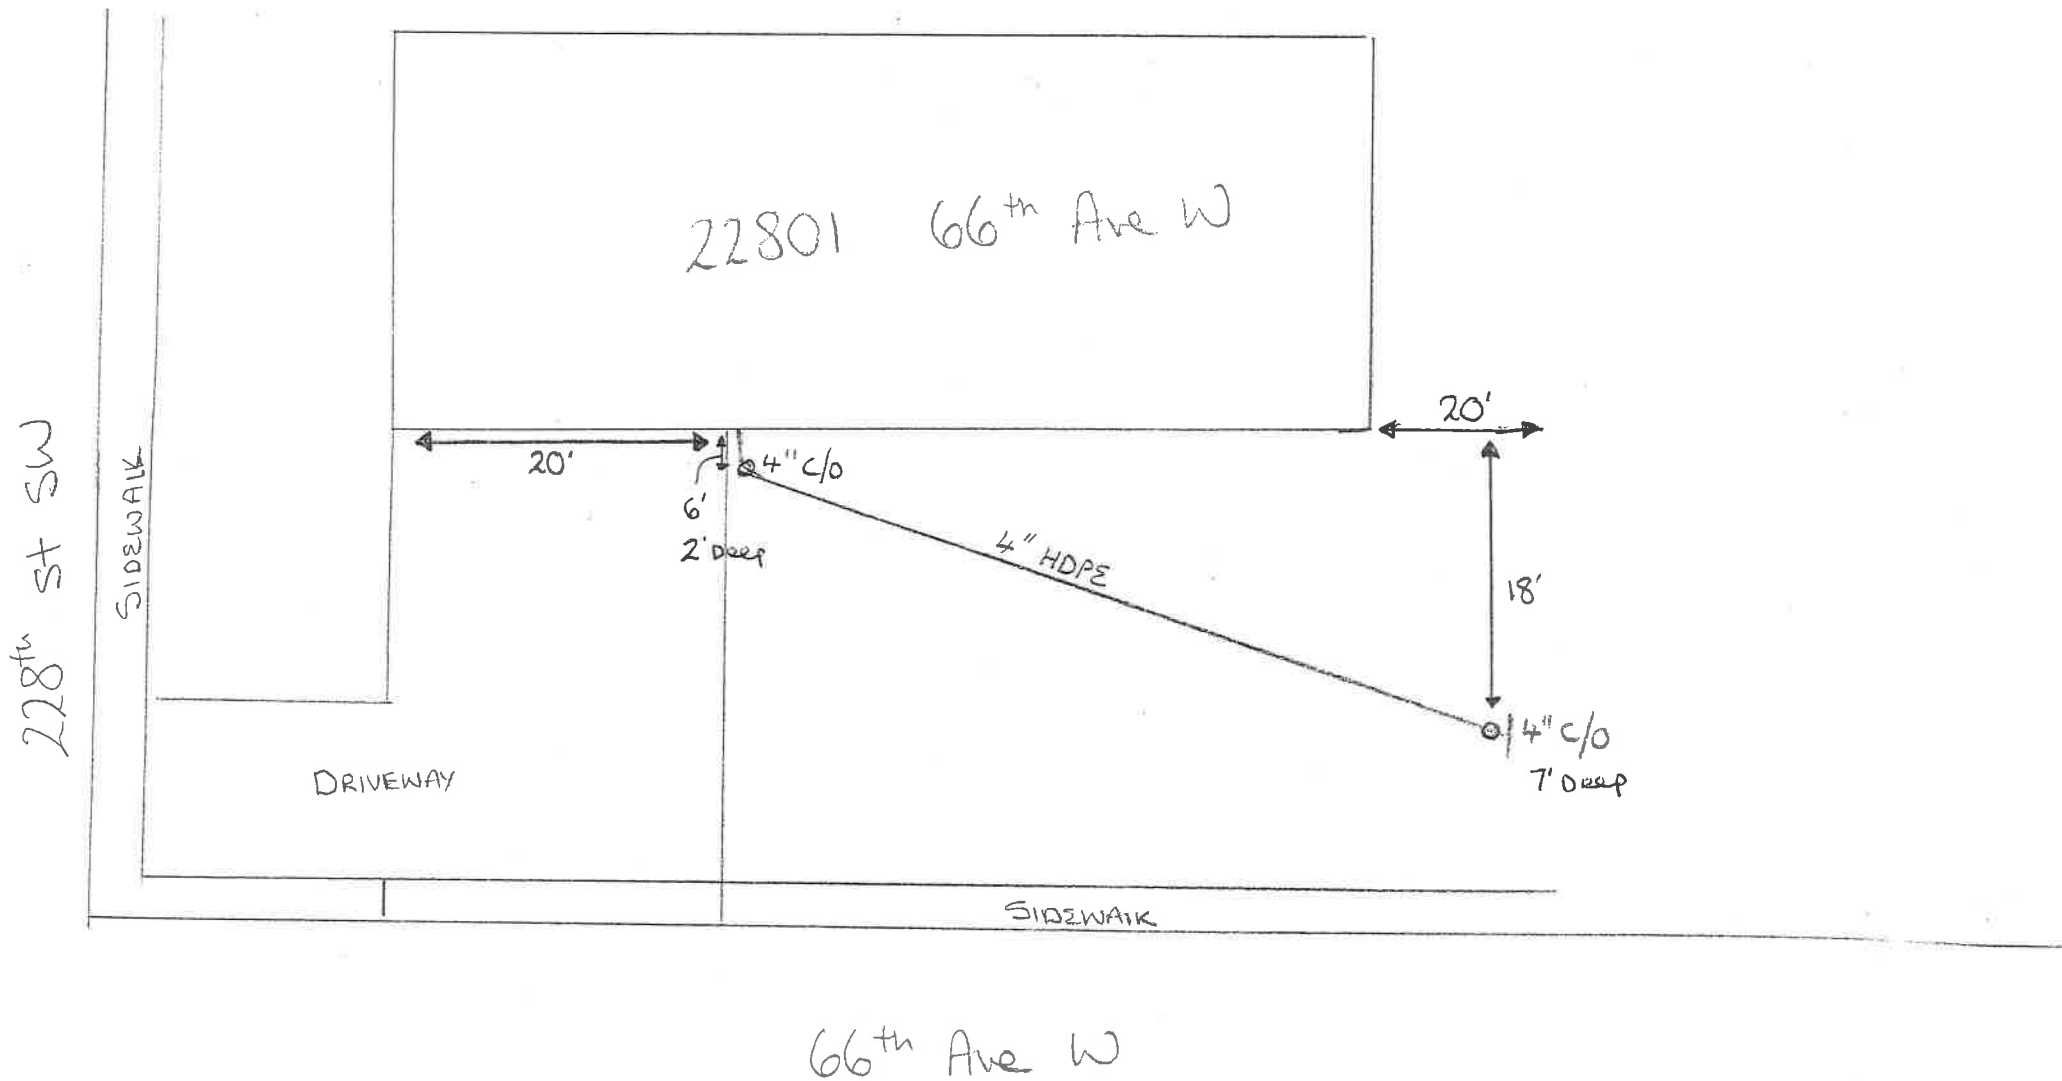

NOT TO SCALE