

TIMBERLINE PARK

DEAN E. HELBARGER ~ DEVELOPER

The City of Mountlake Terrace

APPLI CATION

for

SIDE SEWER PERMIT

OUTSIDE ☒ INSIDE ☐ REPAIRS ☐

EQUIP WITH BACKFLOW VALVE

CARD No. _____

EASEMENT No. _____

OWNER

Per lot #

CONTRACTOR

UNIVERSAL LITL. CO. INC.

EDMONDS, WASH.

PERMIT No.

74-14

HOUSE No.

~~3706~~

225 TH PL SW

STREET

AVENUE LOT No.


2

BLOCK No.

NAME ADD

225 TH PL SW

PERMIT NO. UA-75-54
ISSUED TO LYNN WOOD
SEPTIC TANK. INSPECTED
7-28-75 & APPROVED
W. H. VAN RY

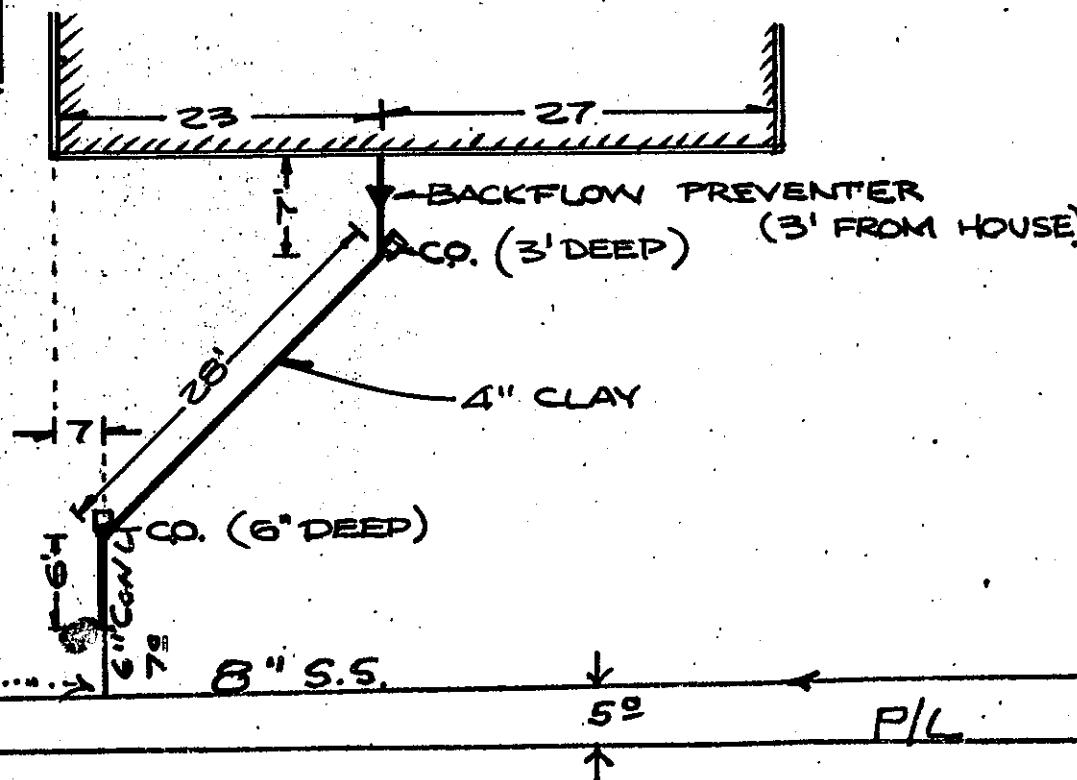

BACKFILL WORK ORDER ISSUED

7-1-74

DEPOSIT, \$

Approved:

DATE 8-74

BY

F. H. SMITH

SEWER WORK ORDER ISSUED

4-15-74