
As Built for Permit #U-17-0011

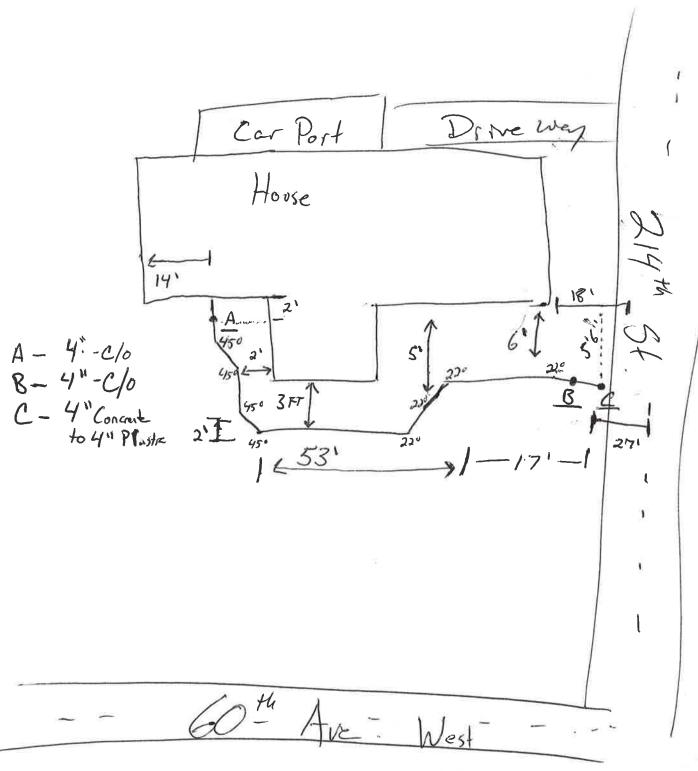

- 5907 214th St SW

RECEIVED MAR 1 4 201

MOUNTLAKE TERRACE