



PLAN	DATE	BY
REVISIONS		
NO.		

PROFILE	DATE	BY
REVISIONS		
NO.		

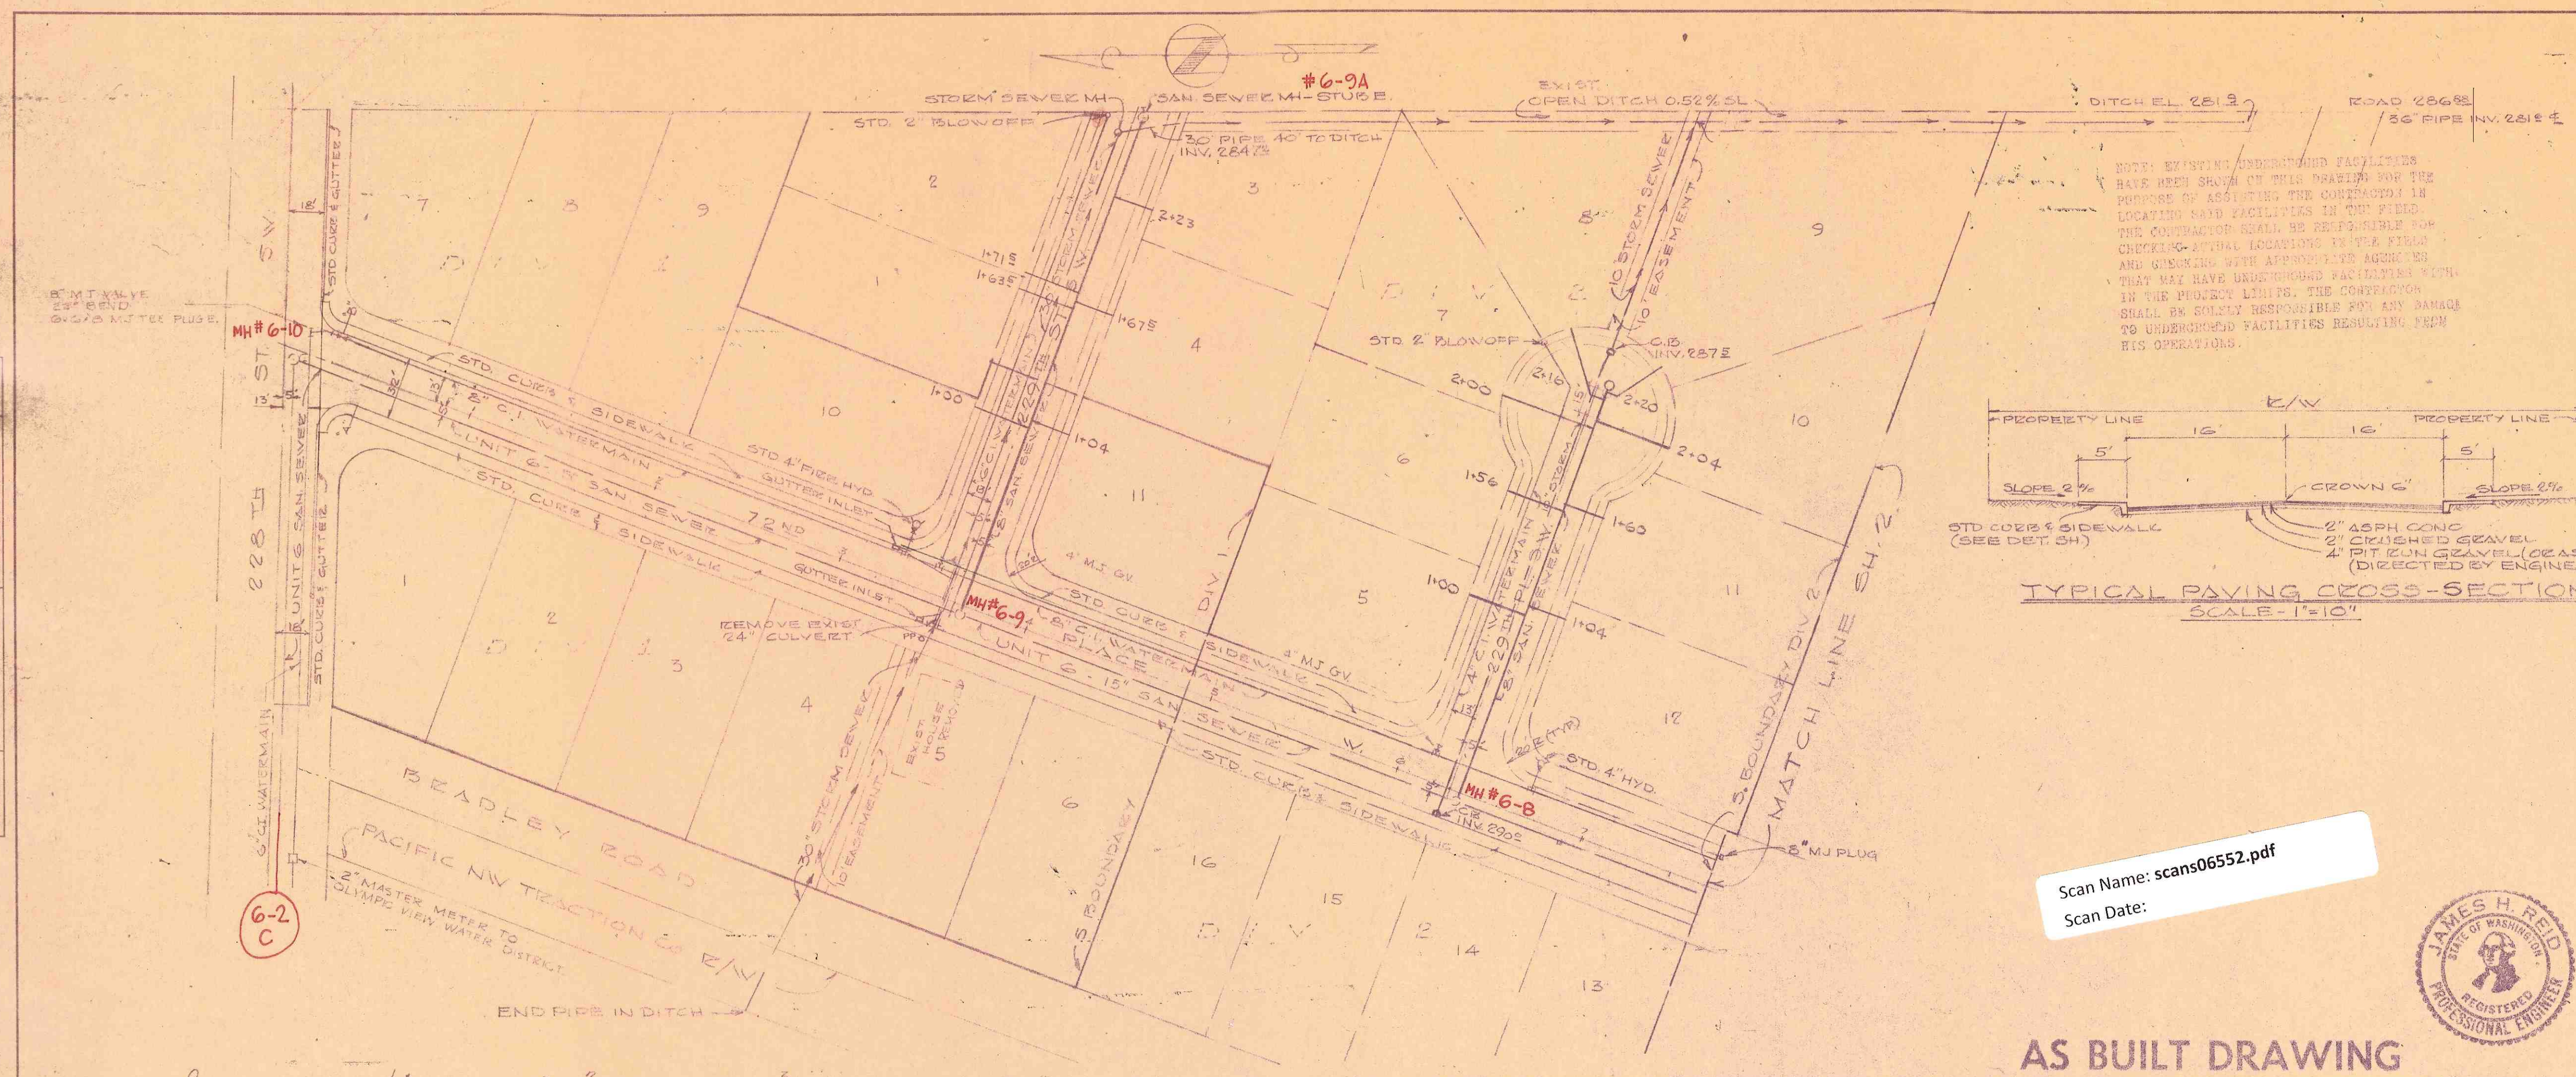

Scan Name: scans06552.pdf
Scan Date:

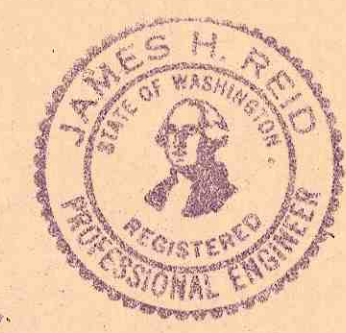

4	ADDED AS BUILT DATA	6/7/62	DLN
3	ADDED 229TH PL. SEWER PROFILE	4/5/62	DLN
2	ADDED WATER CONNECTION ON 228TH, ADDED VALVE ON 229TH PL.	11/27/61	DLN
1	ADDED CR. 10" STORM SEWER-230TH PL.-X-SECTIONS	10/24/61	DLN
NO.	REVISIONS	DATE	BY

CITY OF MOUNTLAKE TERRACE


CURBS, SIDEWALKS, STREET PAVING,
8" C.I. WATERMAINS, SANITARY &
STORM SEWERS

LAKE BALLINGER ESTATES-DIV. 1 & DIV. 2

REID, MIDDLETON & ASSOCIATES, INC.
CONSULTING ENGINEERS & LAND SURVEYORS
324 MAIN STREET EDMONDS, WASHINGTON

FILE NO. 5.177
SHEET 1 OF 2

AS BUILT DRAWING

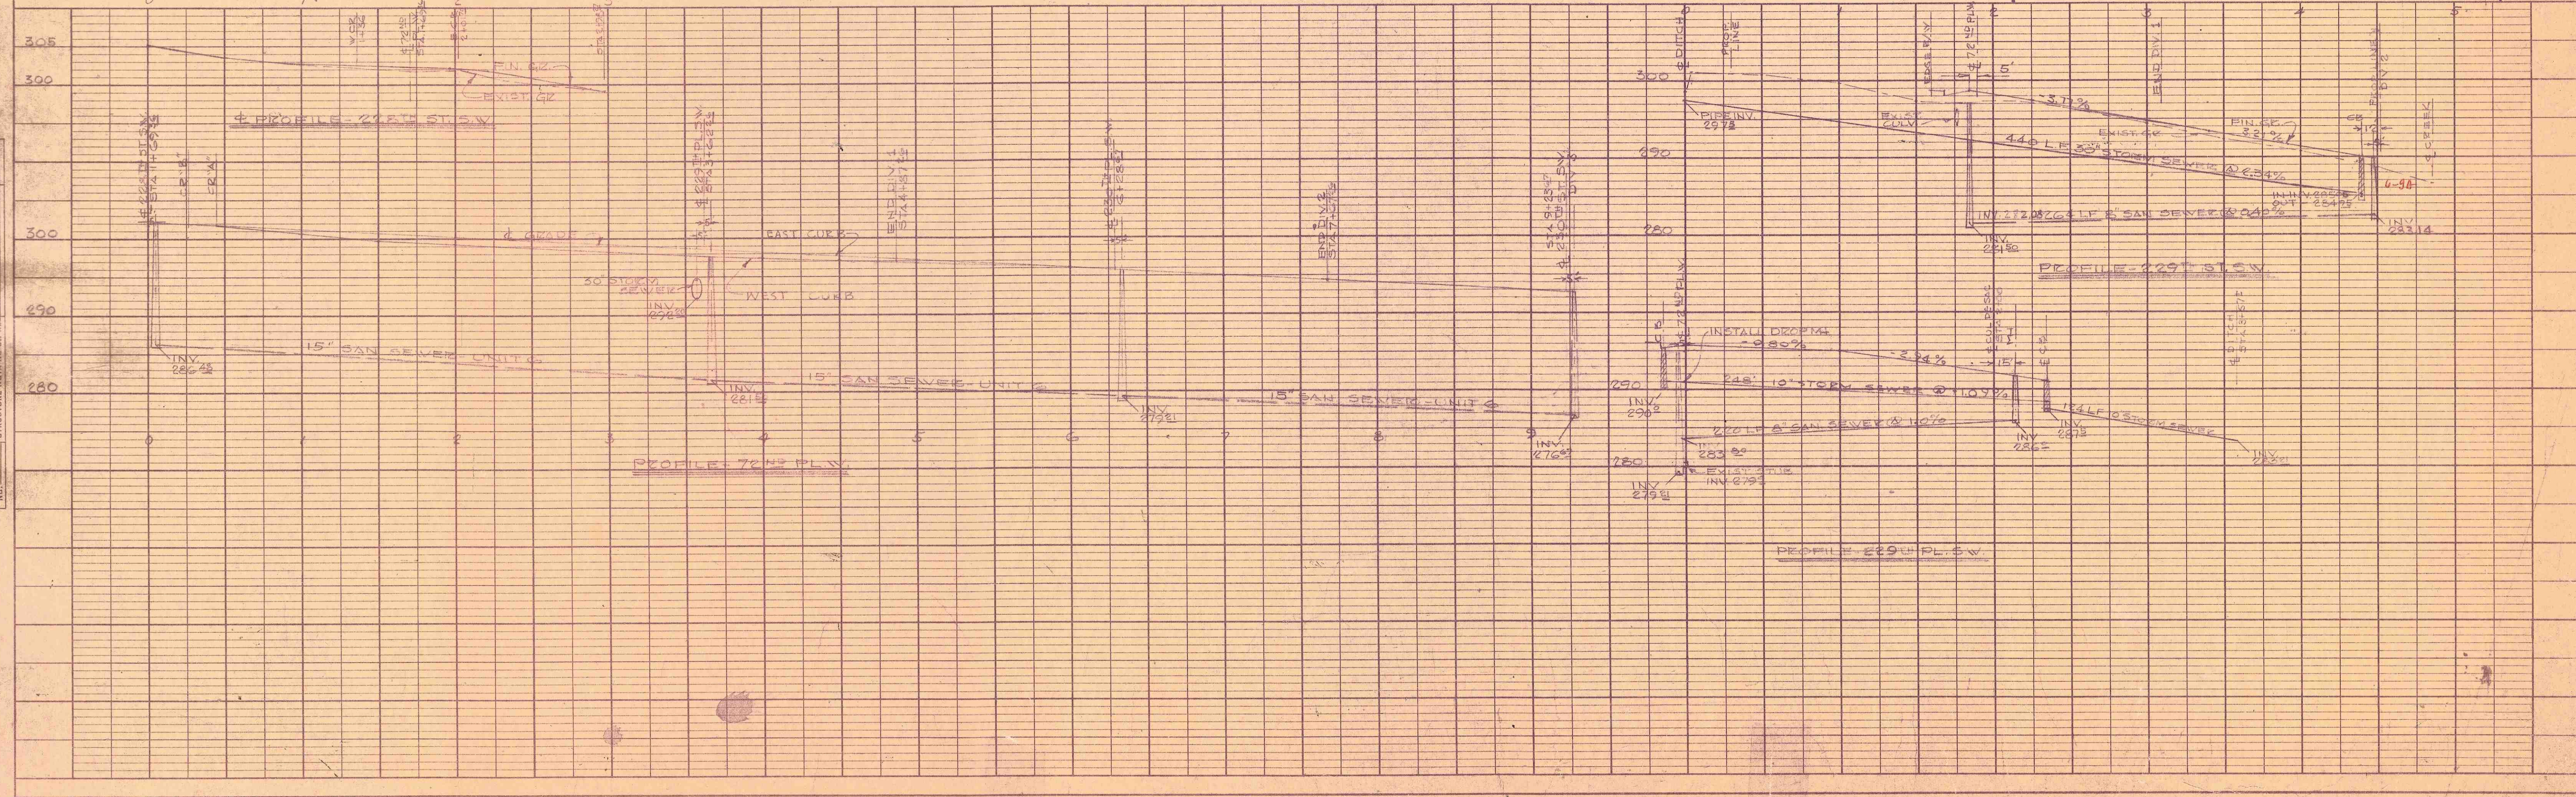

6-2-B