

The City of Mountlake Terrace

APPLICATION

SIDE SEWER PERMIT

OUTSIDE ☒ INSIDE ☐ REPAIRS ☐

CARD No. 51501

EASEMENT No. ✓

OWNER Thos. R. Sprague

HOUSE No. 28901 140 Ave. S.


4915 240th Place S.W.

CONTRACTOR \_\_\_\_\_ PERMIT No. 2218

STREET \_\_\_\_\_

AVENUE LOT No. 3 BLOCK No. 2

NAME ADD. Rose Frank DANNY PARK

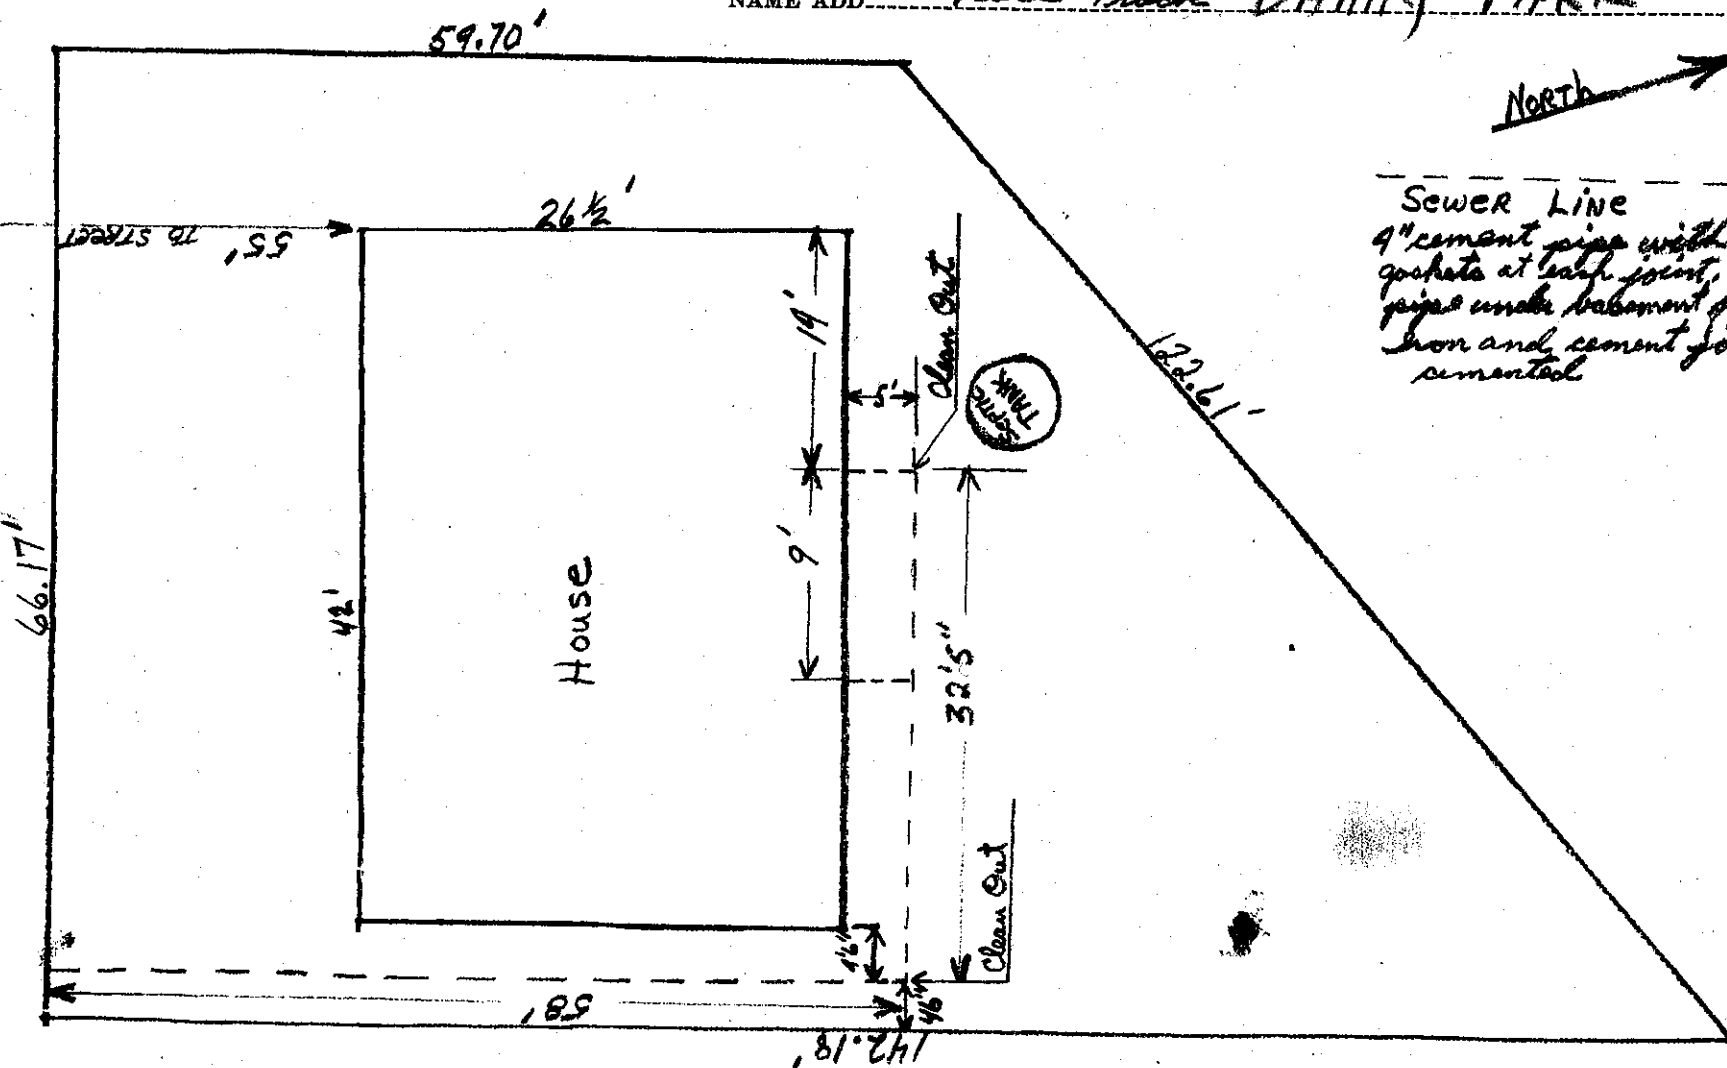

Sewer Line  
9" cement pipe with Rubber  
gaskets at each joint. Cast iron  
pipe under basement floor. Cast  
iron and cement joint are  
cemented

Date

Approved:

BACKFILL WORK ORDER ISSUED \_\_\_\_\_

DEPOSIT, \$10.00

3/28/60

SEWER WORK ORDER ISSUED \_\_\_\_\_

1027

DATE

9-16-60

BY

S. M. Holton/NSKCON

2203