



The City of Mountlake Terrace

APPLICATION

SIDE SEWER PERMIT

OUTSIDE INSIDE REPAIRS

J.R. MAYER
CARD NO. 8

EASEMENT No. _____

OWNER John R Maser

HOUSE No. 21802 - 50th Pl.

CONTRACTOR

B+E

PERMIT No. 2108


STREET

AVENUE LOT No. 6

BLOCK No. _____

NAME ADD

M.LT Div. No. 20

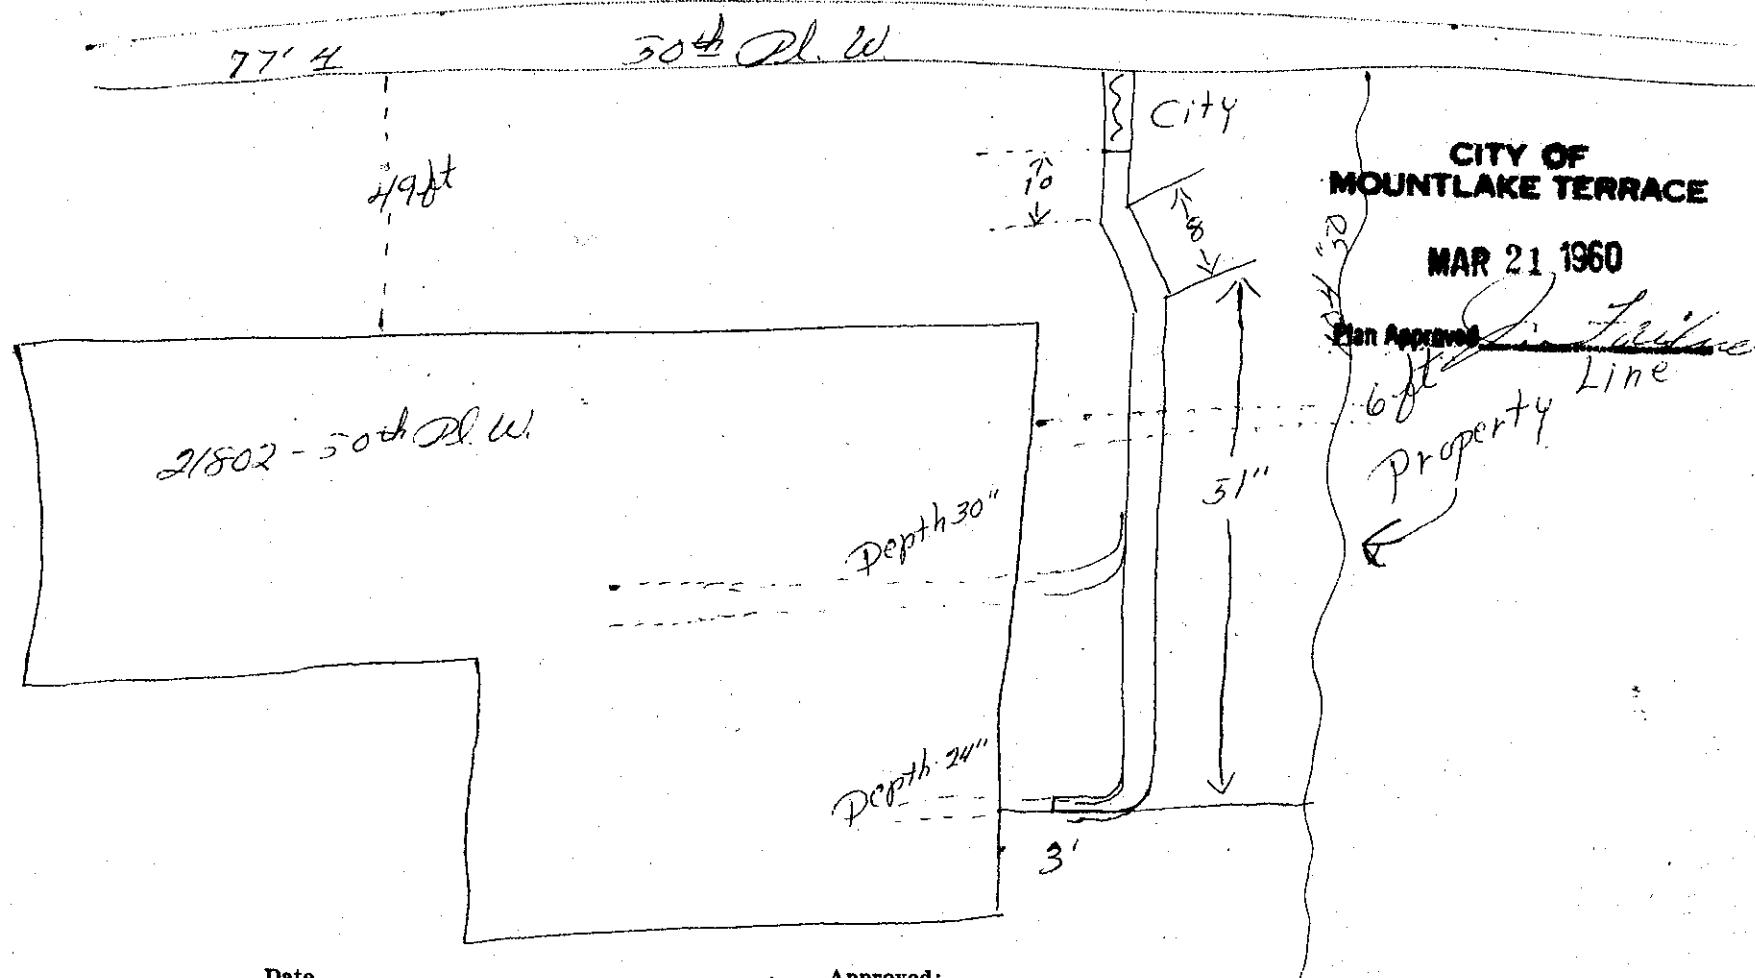

Date

Approved:

BACKFILL WORK ORDER ISSUED

DEPOSIT, \$10.00 7/28/59

SEWER WORK ORDER ISSUED

#3792

DATE 3-22-60

BY Scott McHoltor INS.N.C.

4/11/60

J. Falmer Room



The City of Mountlake Terrace

APPLICATION

SIDE SEWER PERMIT

OUTSIDE INSIDE REPAIRS

RAYMOND HERVEY
CARD No. _____

EASEMENT No. _____

OWNER: RAYMOND H. HERVEY
HOUSE No. 21804 50th Place W

CONTRACTOR

Self

PERMIT NO. 202

STREET

AVENUE LOT No.


BLOCK No. _____

NAME ADD.

Div 20

104-5

SEWER MAIN

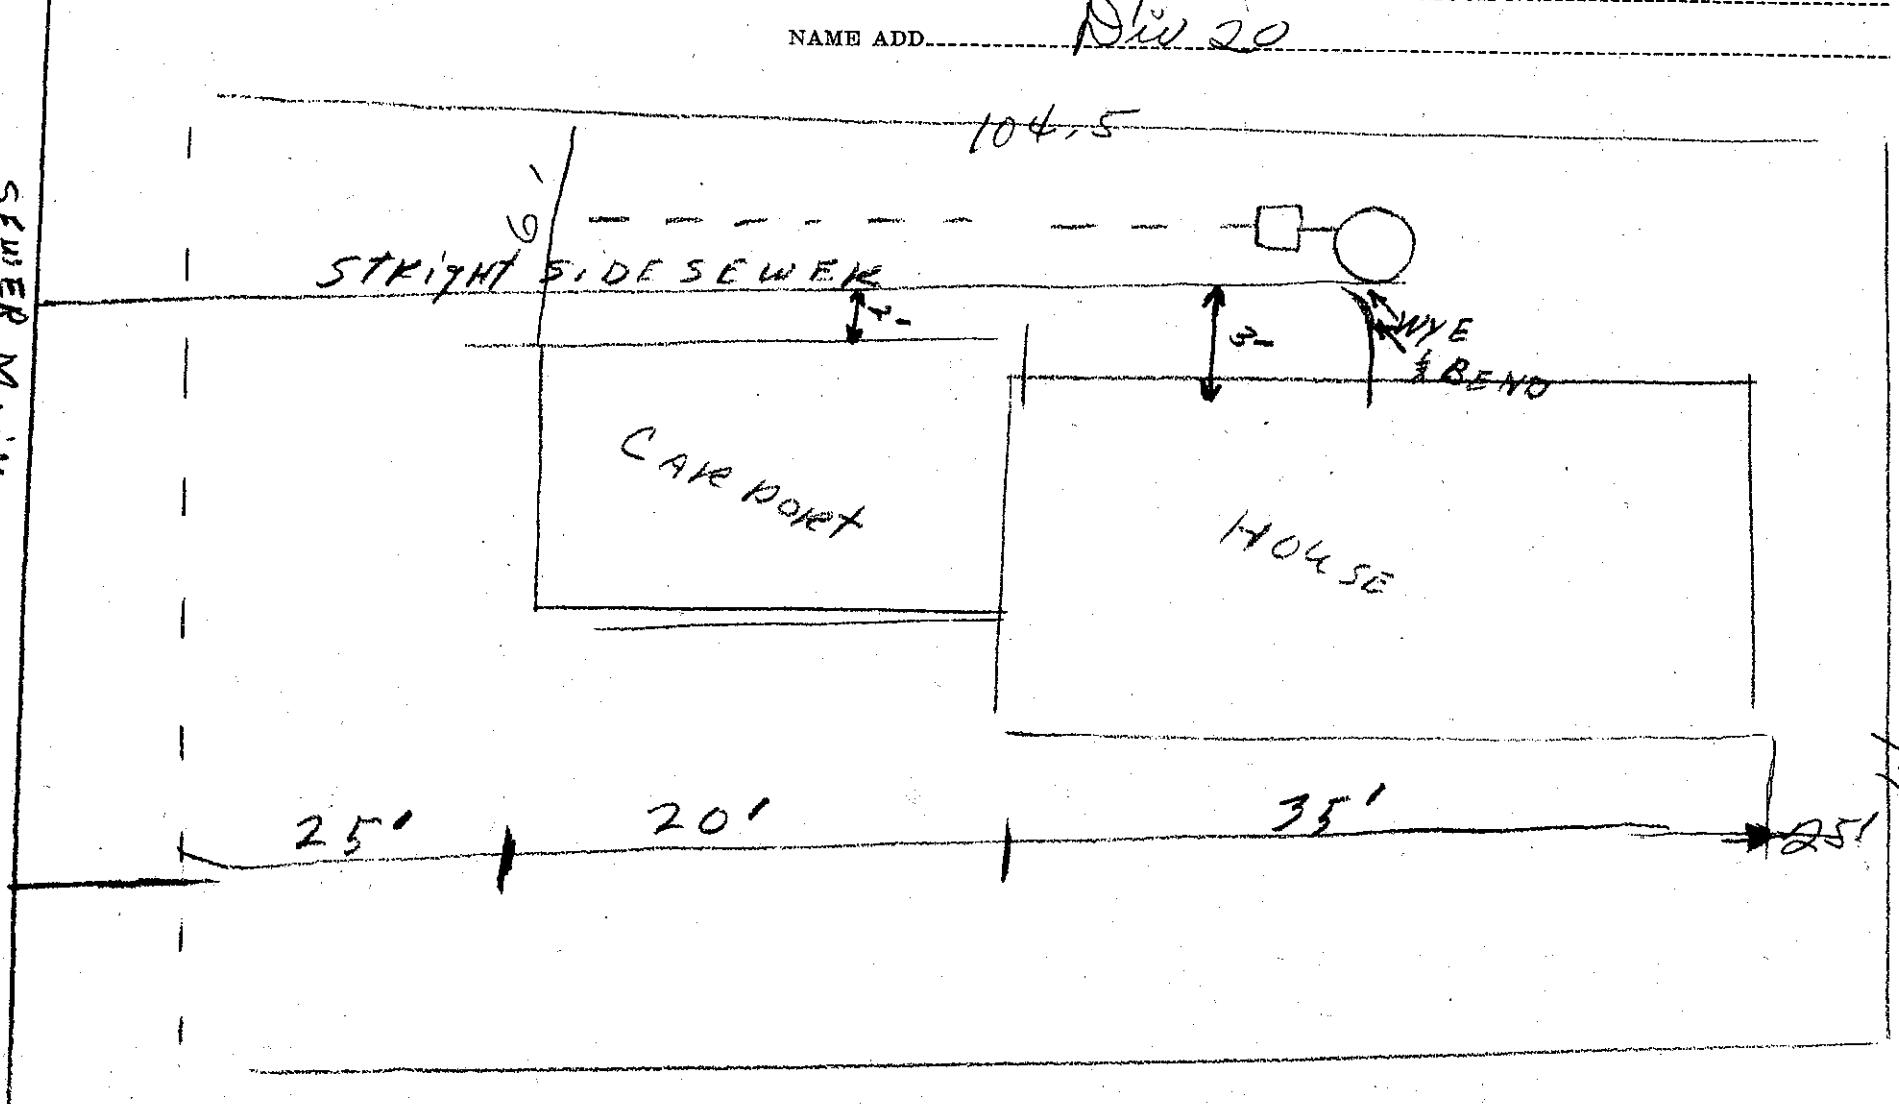

Date

BACKFILL WORK ORDER ISSUED

SEWER WORK ORDER ISSUED

DEPOSIT, \$10~~00~~

Approved:

16.38

6-25-60

DATE

6-27-60 BY S.M. Holton WS & CON



The City of Mountlake Terrace

APPLICATION

B. R. Koe

CARD No.

SIDE SEWER PERMIT

OUTSIDE INSIDE REPAIRS

EASEMENT No.

OWNER MR & MRS BRUCE R. KOEHN

CONTRACTOR

PERMIT No. 2481

HOUSE No. 21806 50TH PL. WEST


STREET
AVENUE LOT No.

8

BLOCK No.

NAME ADD.

DIV. 20

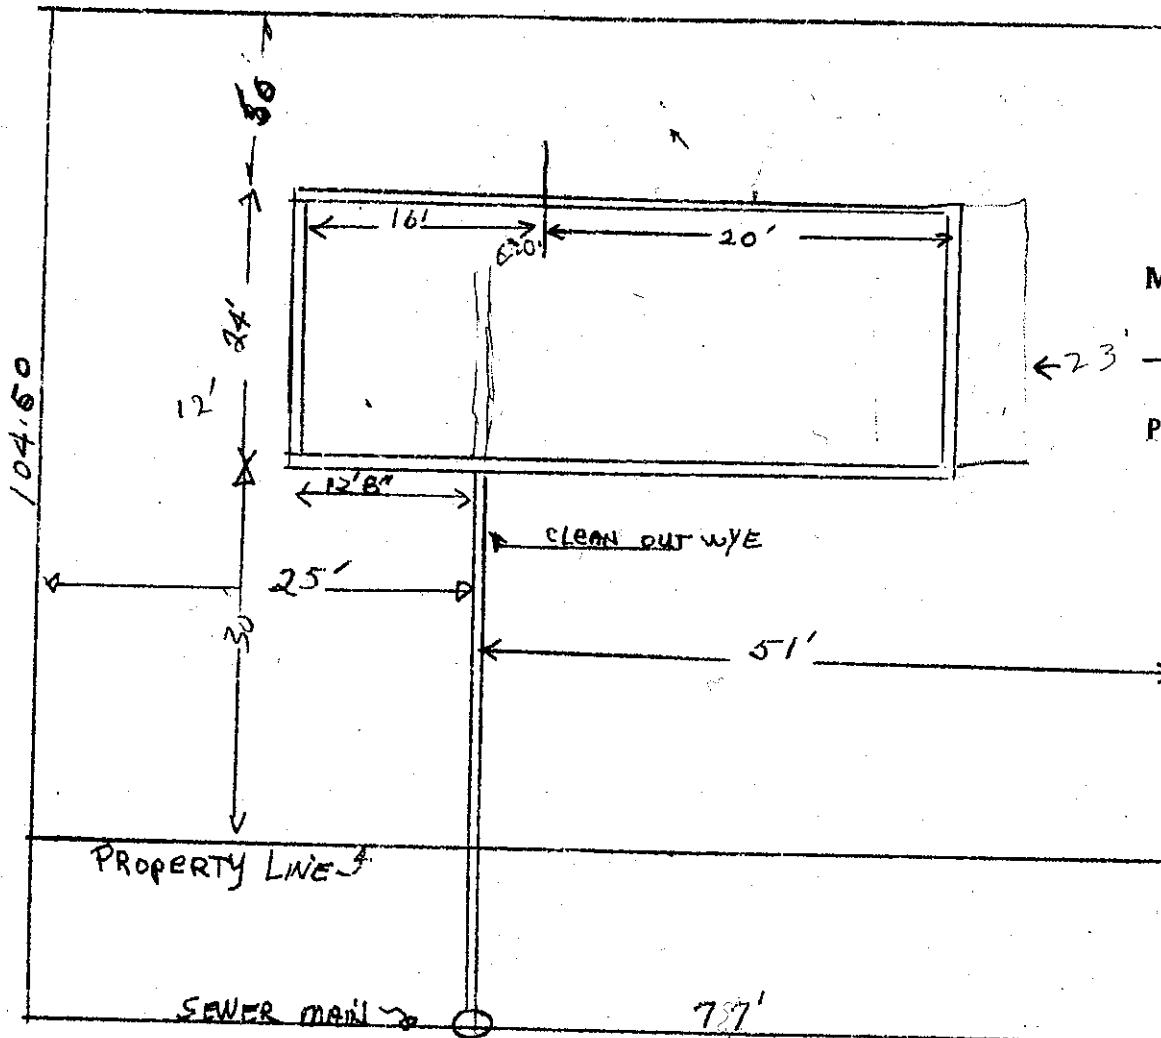

CITY OF
MOUNTLAKE TERRACE

APR 21 1960

Plan Approved

S. McAllee

Date

Approved:

BACKFILL WORK ORDER ISSUED

DEPOSIT, \$10.00

4/14/60

SEWER WORK ORDER ISSUED

1270

DATE 4-21-60

BY Scott M Holton INS+COR

The City of Mountlake Terrace

APPLICATION
for


SIDE SEWER PERMIT
OUTSIDE INSIDE REPAIRS

W. C. BALLARD

CARD No.

EASEMENT No. 1373955

OWNER WILLIS C. & SHIRLEY A. BALLARD CONTRACTOR SCLC PERMIT No. 1103
HOUSE No. 23107 50TH PLACE WEST STREET
AVENUE LOT No. LOT 4 BLOCK No. BLOCK 3
NAME ADD. MOUNTLAKE TERRACE #10

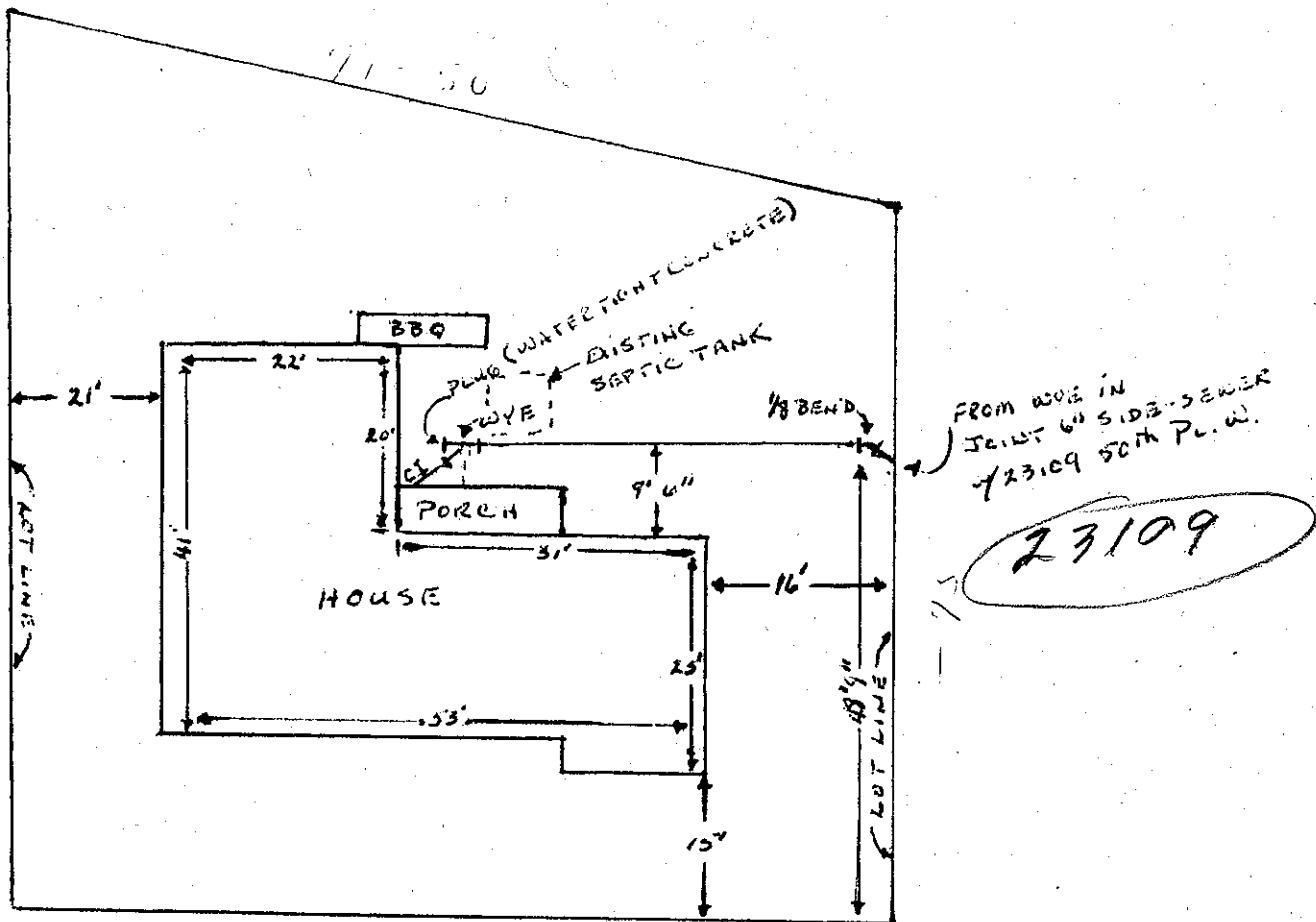

50 TH PL. WEST

Date

Approved:

BACKFILL WORK ORDER ISSUED
SEWER WORK ORDER ISSUED

DEPOSIT, \$ 100.00

DATE 7-15-60 BY J. M. Holton INS+CON

The City of Mountlake Terrace

APPLICATION

CARD No.....

SIDE SEWER PERMIT

OUTSIDE INSIDE REPAIRS

EASEMENT No.....

OWNER.....

McDowell Homes

CONTRACTOR.....

B & M. Const.

PERMIT No.....

HOUSE No.....

24001 50th PL W

STREET


9

AVENUE LOT No.....

BLOCK No.....

NAME ADD.....

Lake Forest Heights

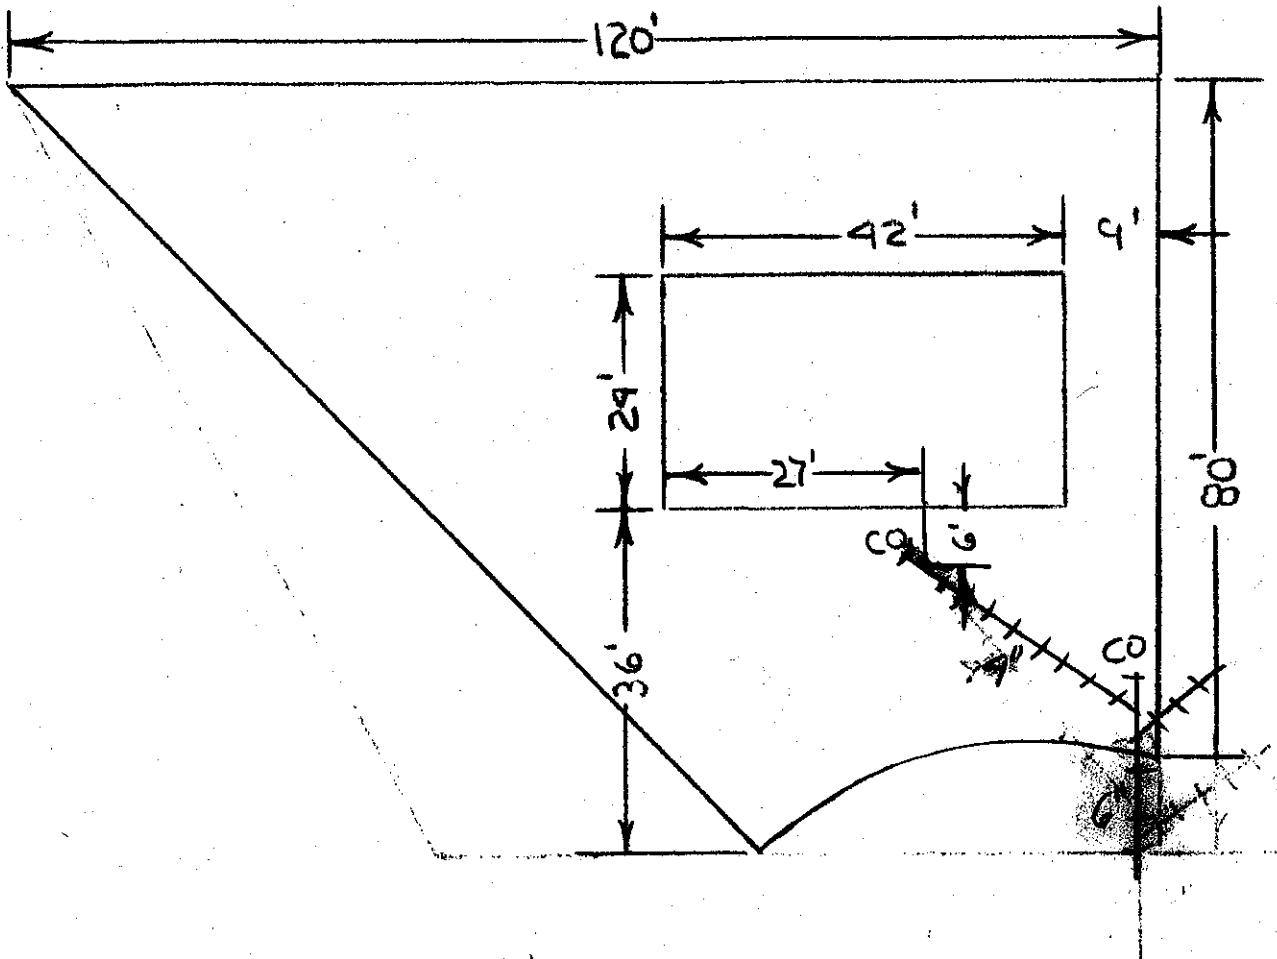

50th PL. W.

Date

Approved:

BACKFILL WORK ORDER ISSUED.....
SEWER WORK ORDER ISSUED.....

DEPOSIT, \$10.00 1/23/61

DATE

1-25-61 BY S. M. Holton

APPLICATION

SIDE SEWER PERMIT

The City of Mountlake Terrace

CARD No.

OUTSIDE INSIDE REPAIRS

EASEMENT No.....

OWNER McDowell Homes
HOUSE No. 24003 50th Pt W

CONTRACTOR

D + M Const

PERMIT NO.

657


STREET
AVENUE LOT NO.

10

BLOCK NO.

NAME ADD.

Lake Forest Heights

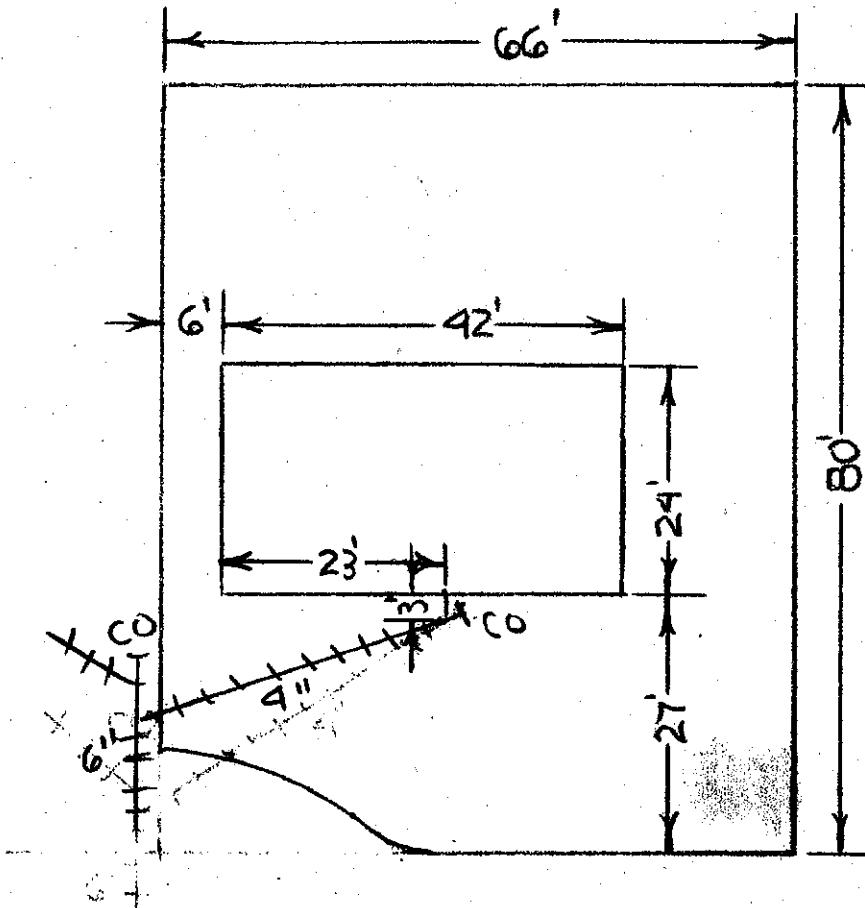

Date

Approved:

BACKFILL WORK ORDER ISSUED.....

DEPOSIT, \$16.00 1/23/61

SEWER WORK ORDER ISSUED.....

DATE 1-25-61 BY S. M. Holton

The City of Mountlake Terrace

APPLICATION
10

CARD No. 1

SIDE SEWER PERMIT

OUTSIDE INSIDE REPAIRS

EASEMENT No. 1448053

OWNER

McKeechane House

CONTRACTOR

Bon M. Conest

PERMIT No. 2712

HOUSE No.

24005 55' RL W.


STREET

AVENUE LOT No.

BLOCK No.

NAME ADD.

Fake Forest Heights

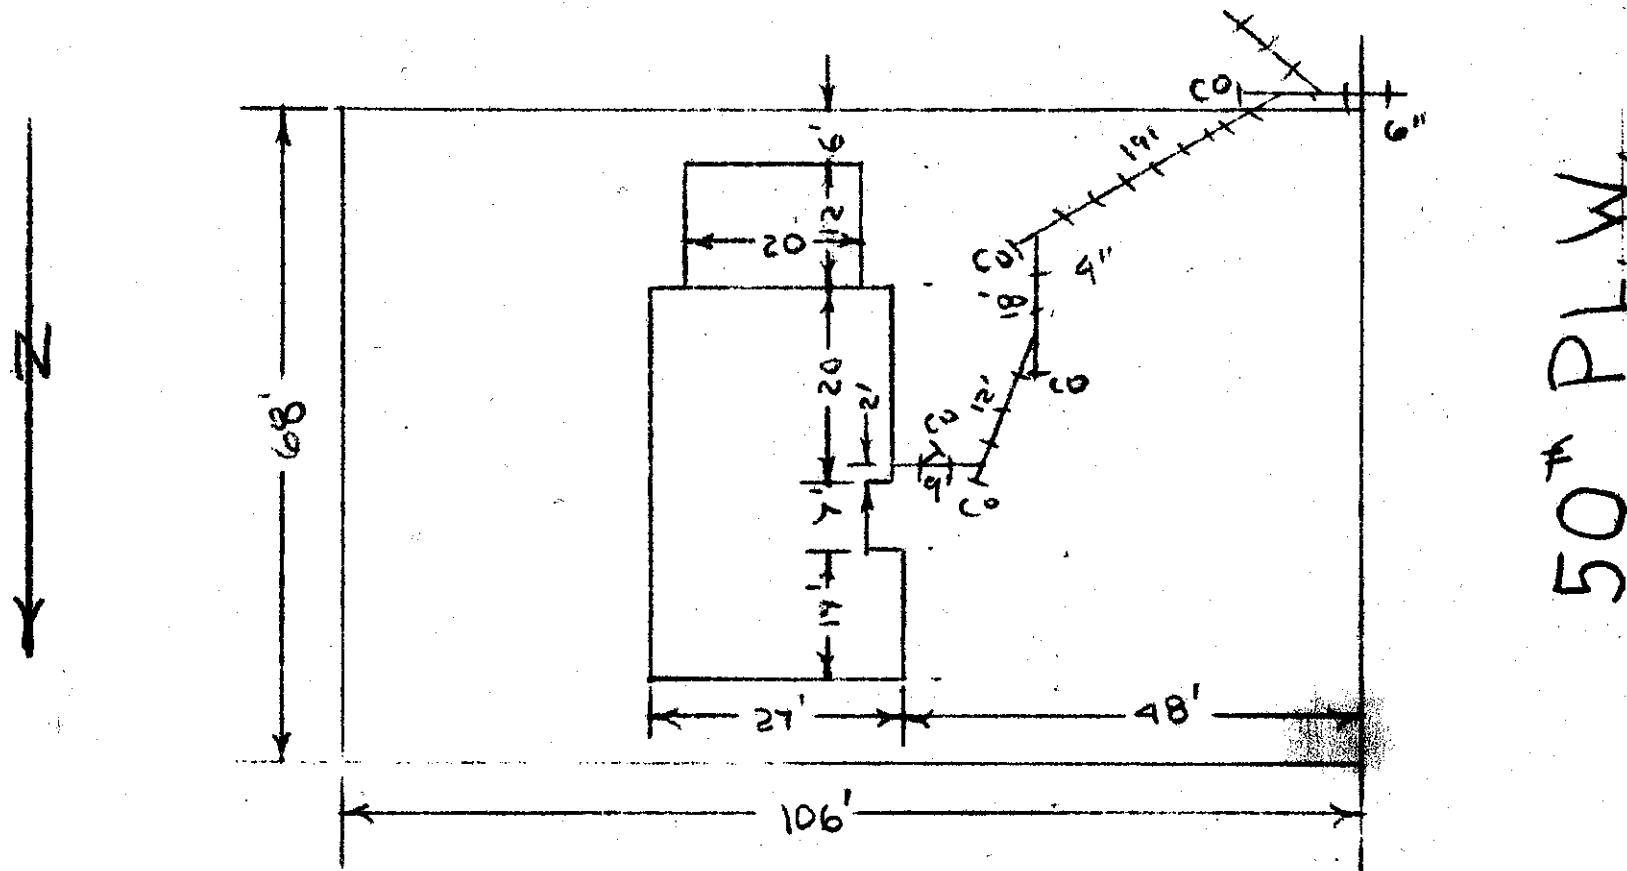

Date

BACKFILL WORK ORDER ISSUED
SEWER WORK ORDER ISSUED

DEPOSIT, \$10,000

Approved:

5/9/61

DATE

6-6-61 BY S. M. Holton

The City of Mountlake Terrace

APPLICATION

CARD No.

SIDE SEWER PERMIT

OUTSIDE INSIDE REPAIRS

EASEMENT No.

OWNER McDeath Homes

HOUSE No. 2400 1/2 55th PL W

CONTRACTOR I B & M Const


PERMIT No. 731

STREET

AVENUE LOT No. 34

BLOCK No.

NAME ADD. Lake Forest Heights

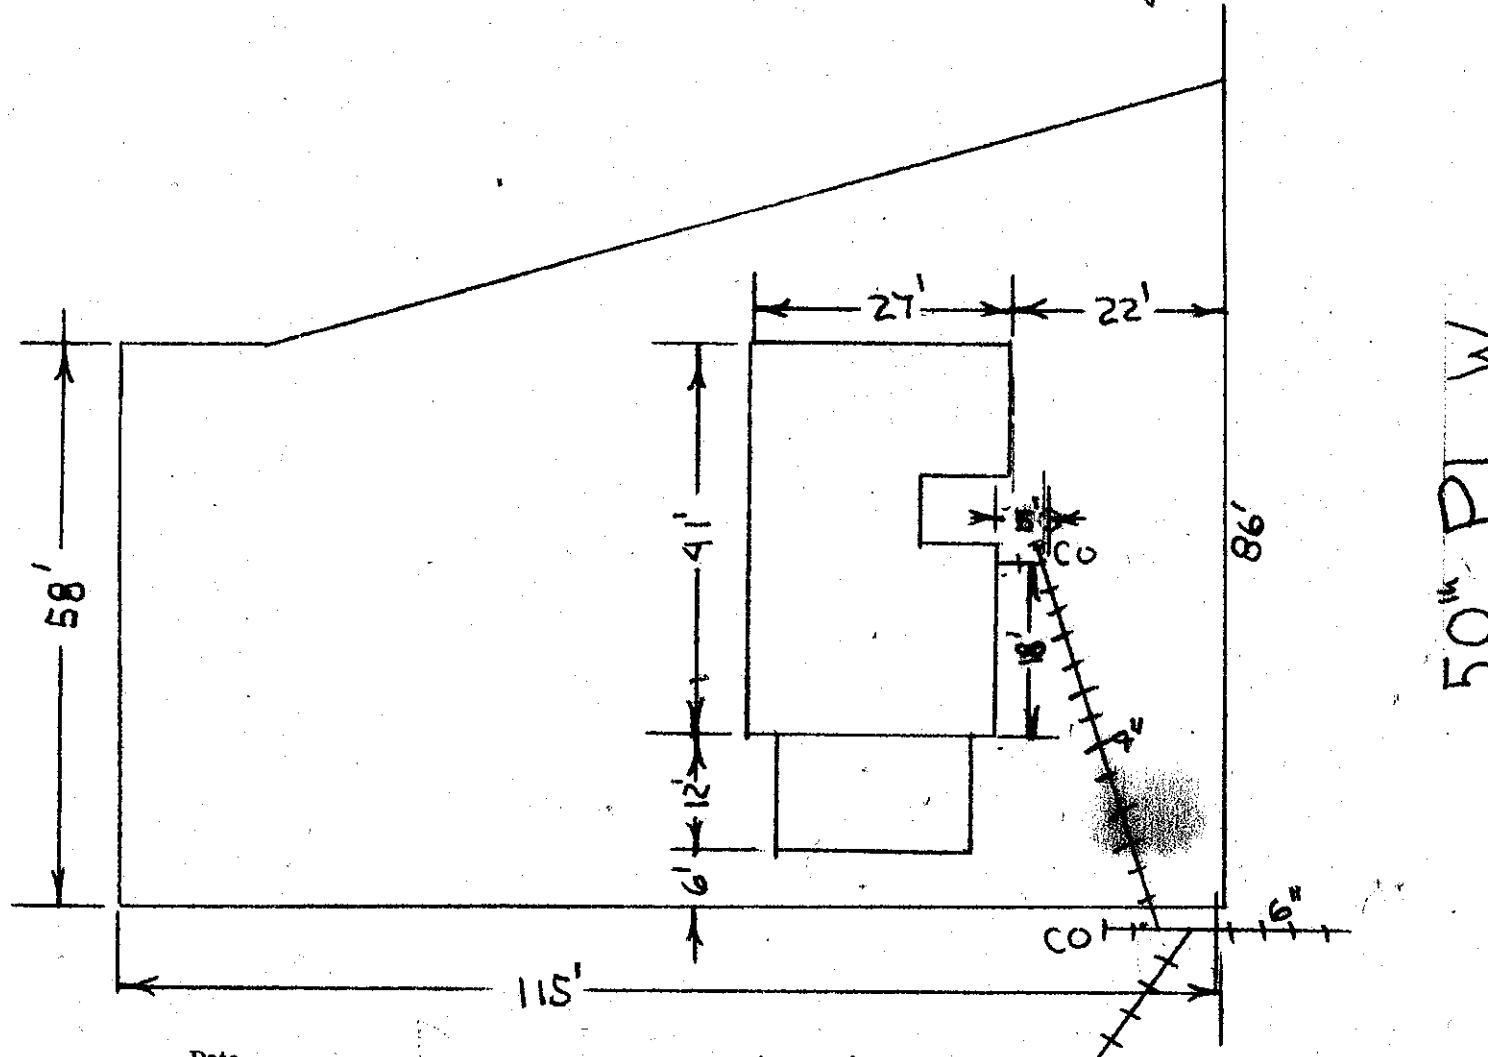

Date

Approved:

BACKFILL WORK ORDER ISSUED

DEPOSIT, \$

SEWER WORK ORDER ISSUED

DATE 4/12/61

BY

J. M. Holton

The City of Mountlake Terrace

APPLICATION

for

SIDE SEWER PERMIT

OUTSIDE INSIDE REPAIRS

CARD No.....

EASEMENT No.....

OWNER McGraw Homes

HOUSE No. 2900 B 50th PL W

CONTRACTOR

B + M Const

PERMIT NO.

730

STREET


AVENUE LOT No.

33

BLOCK No.

NAME ADD.

Lake Forest Heights

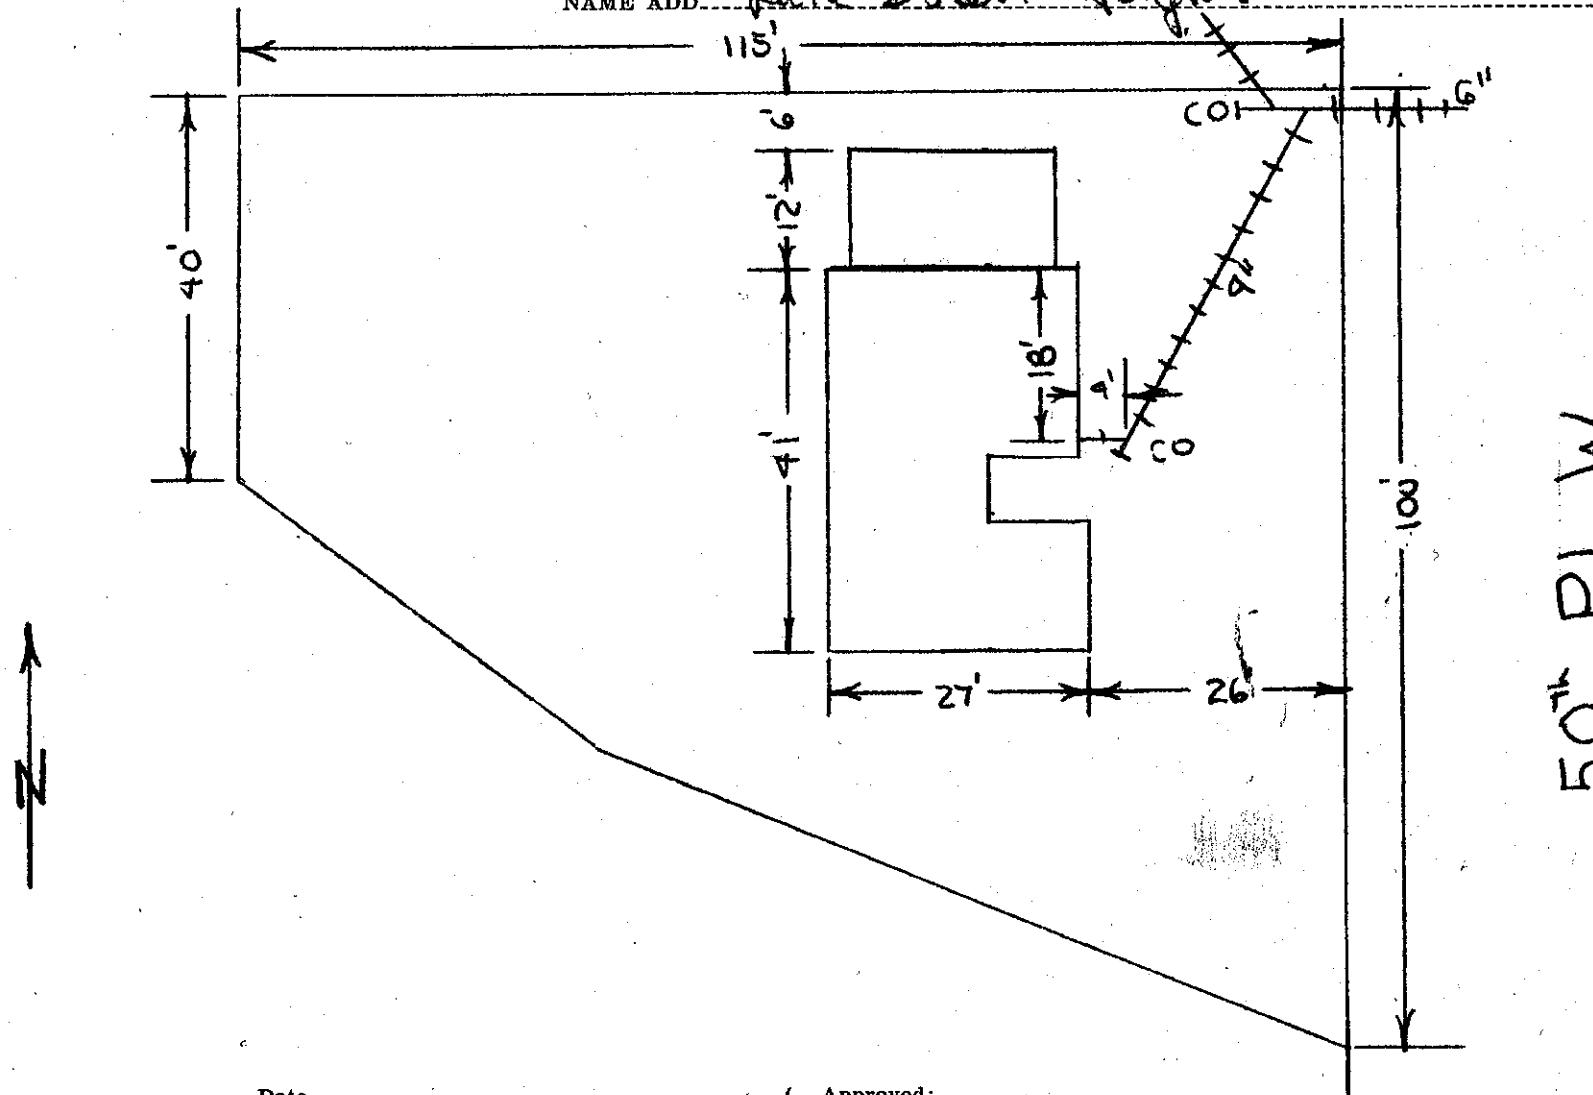

Date

Approved:


BACKFILL WORK ORDER ISSUED

DEPOSIT, \$10,000 4/5/61

SEWER WORK ORDER ISSUED

DATE 4/12/61 BY J. M. Holton

21223 - 50th Ave W

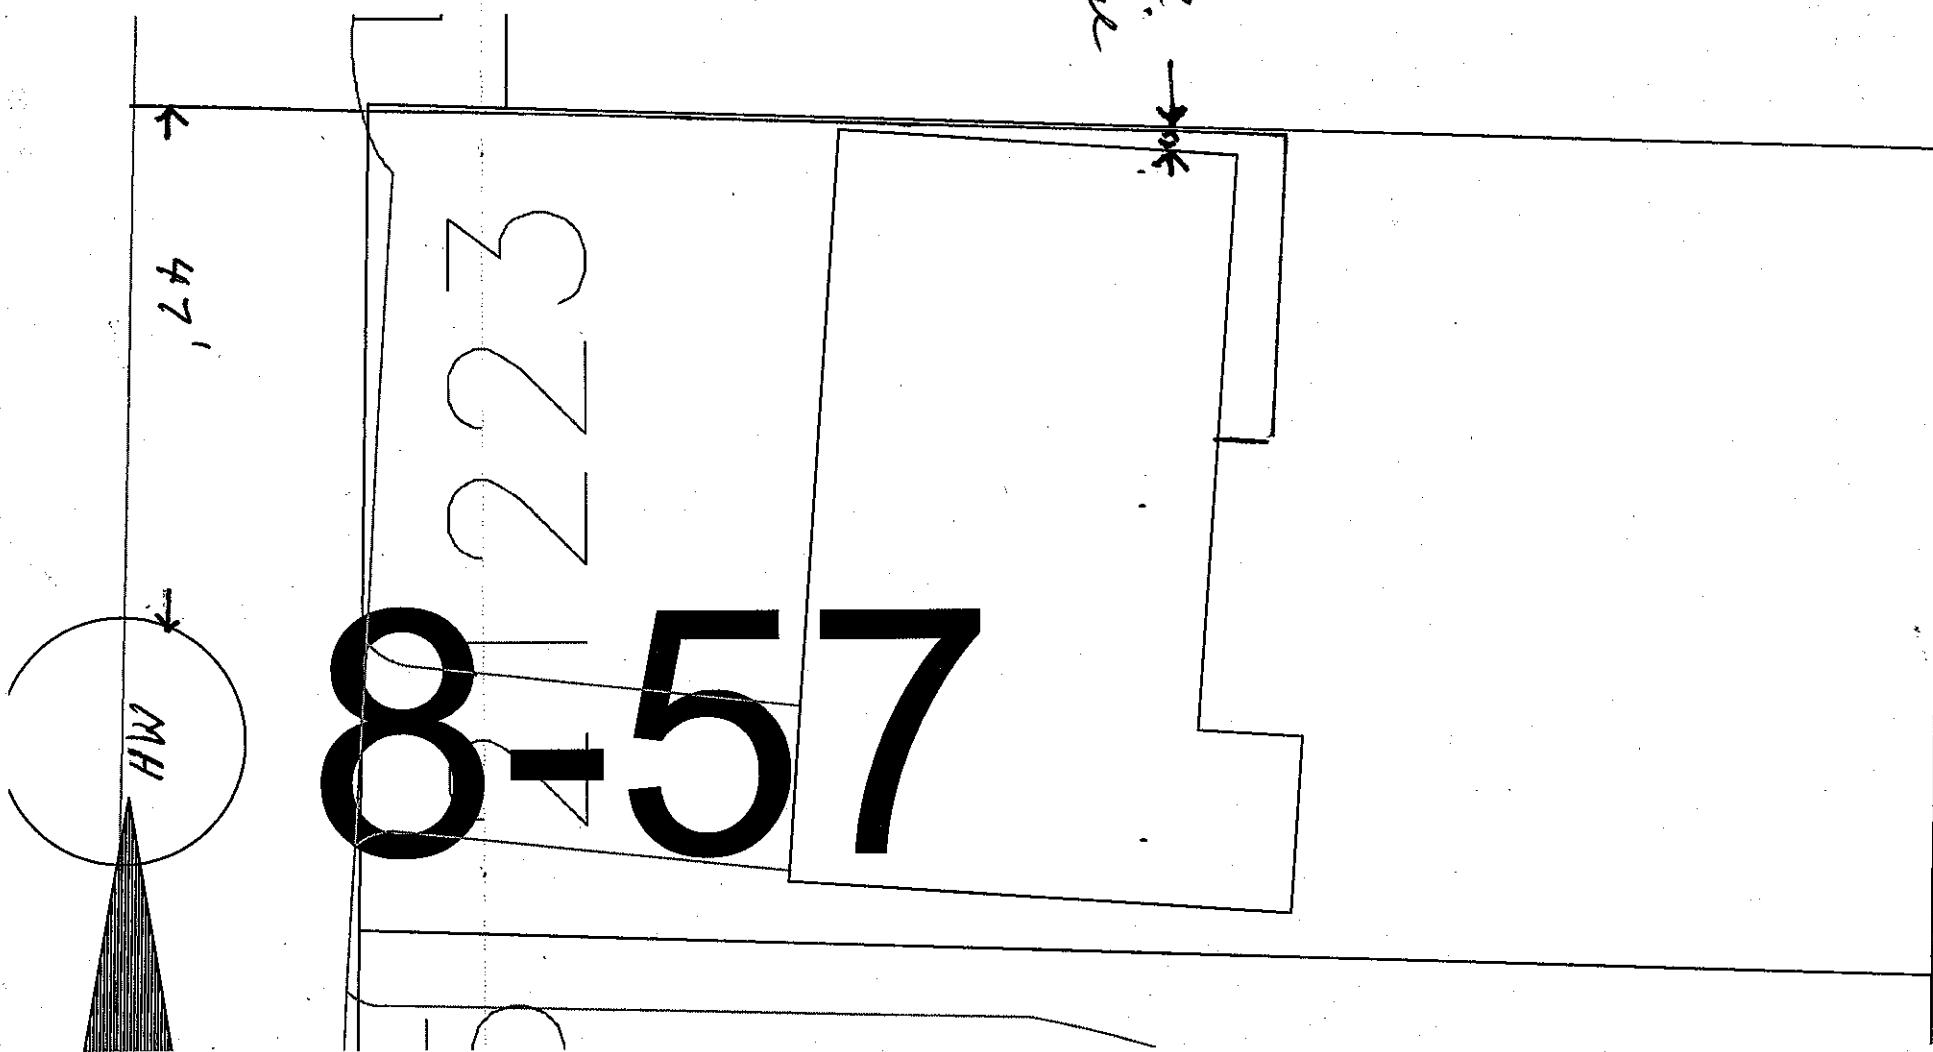

The City of Mountlake Terrace

APPLICATION
for

SIDE SEWER PERMIT

OUTSIDE INSIDE REPAIRS

EASEMENT No.....

OWNER L. Helm
HOUSE No. 21702 - 50th w.


CONTRACTOR B.E. const

STREET
AVENUE LOT No. 1

PERMIT No. 2613

DIV 20 BLOCK No.

NAME ADD.

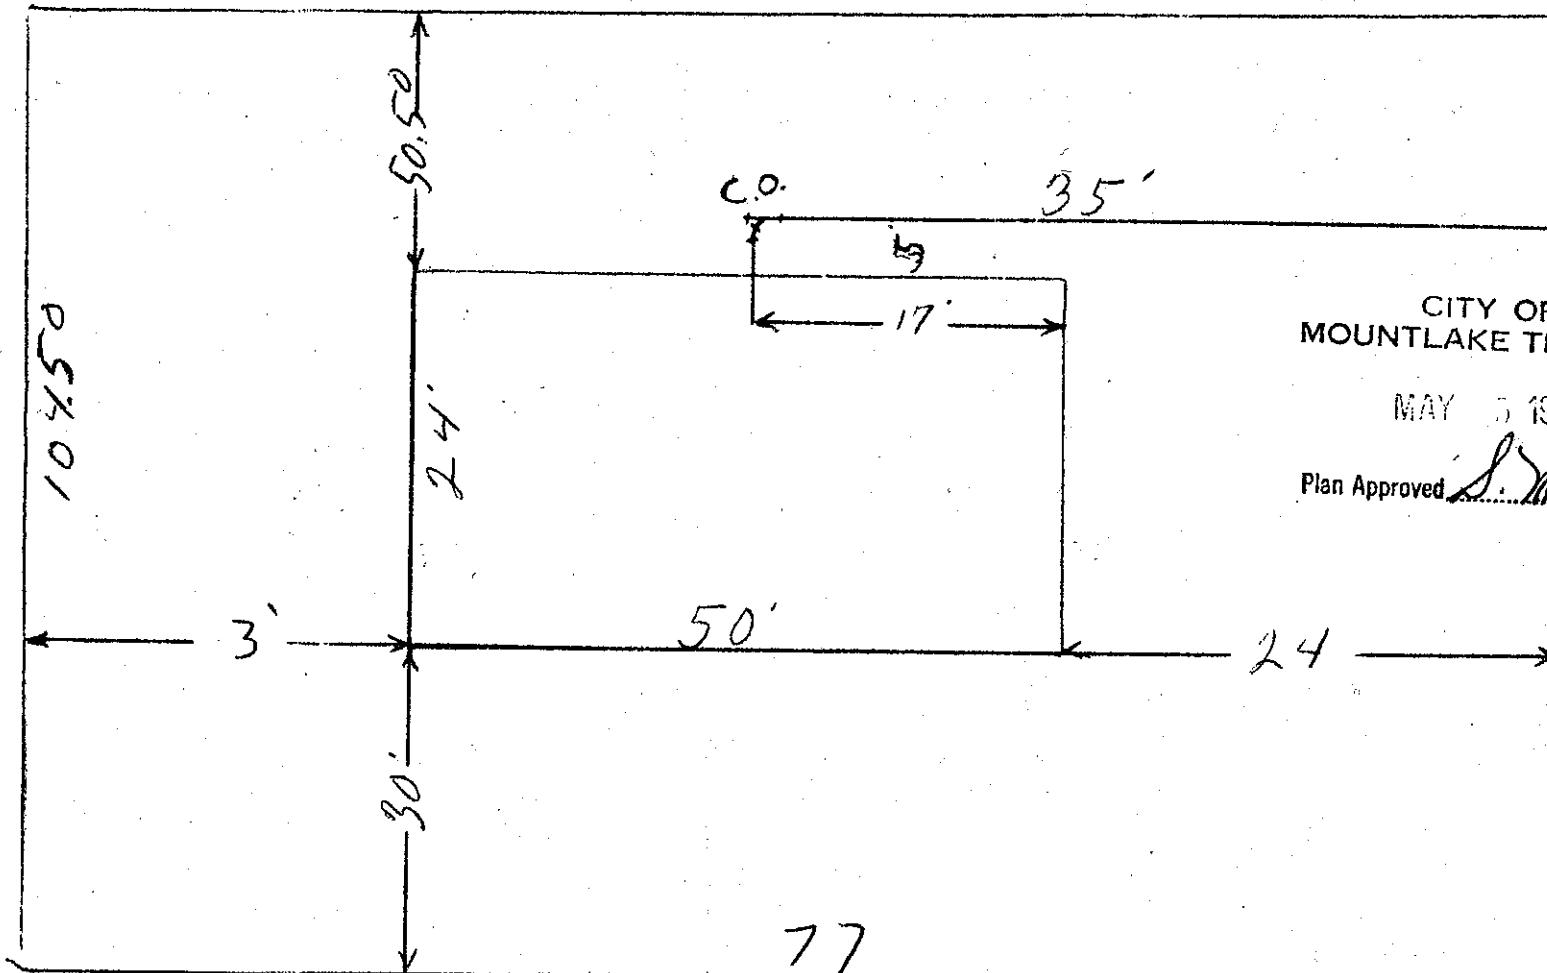

Date

BACKFILL WORK ORDER ISSUED
SEWER WORK ORDER ISSUED

DEPOSIT, \$10.00 5/5/60

Approved:

1388

DATE 5-5-60

BY Sam Holton NS & son

Mountlake Terrace

APPLICATION

M. A. GRINAGER

CARD No.

SIDE SEWER PERMIT

OUTSIDE INSIDE REPAIRS

EASEMENT No.

OWNER MARYWARD A. GRINAGER
HOUSE No. 21704 50th PL. W.

CONTRACTOR


STREET
AVENUE LOT No.

OWNER

50 PL W. LOT 2

PERMIT No. 187

BLOCK No.

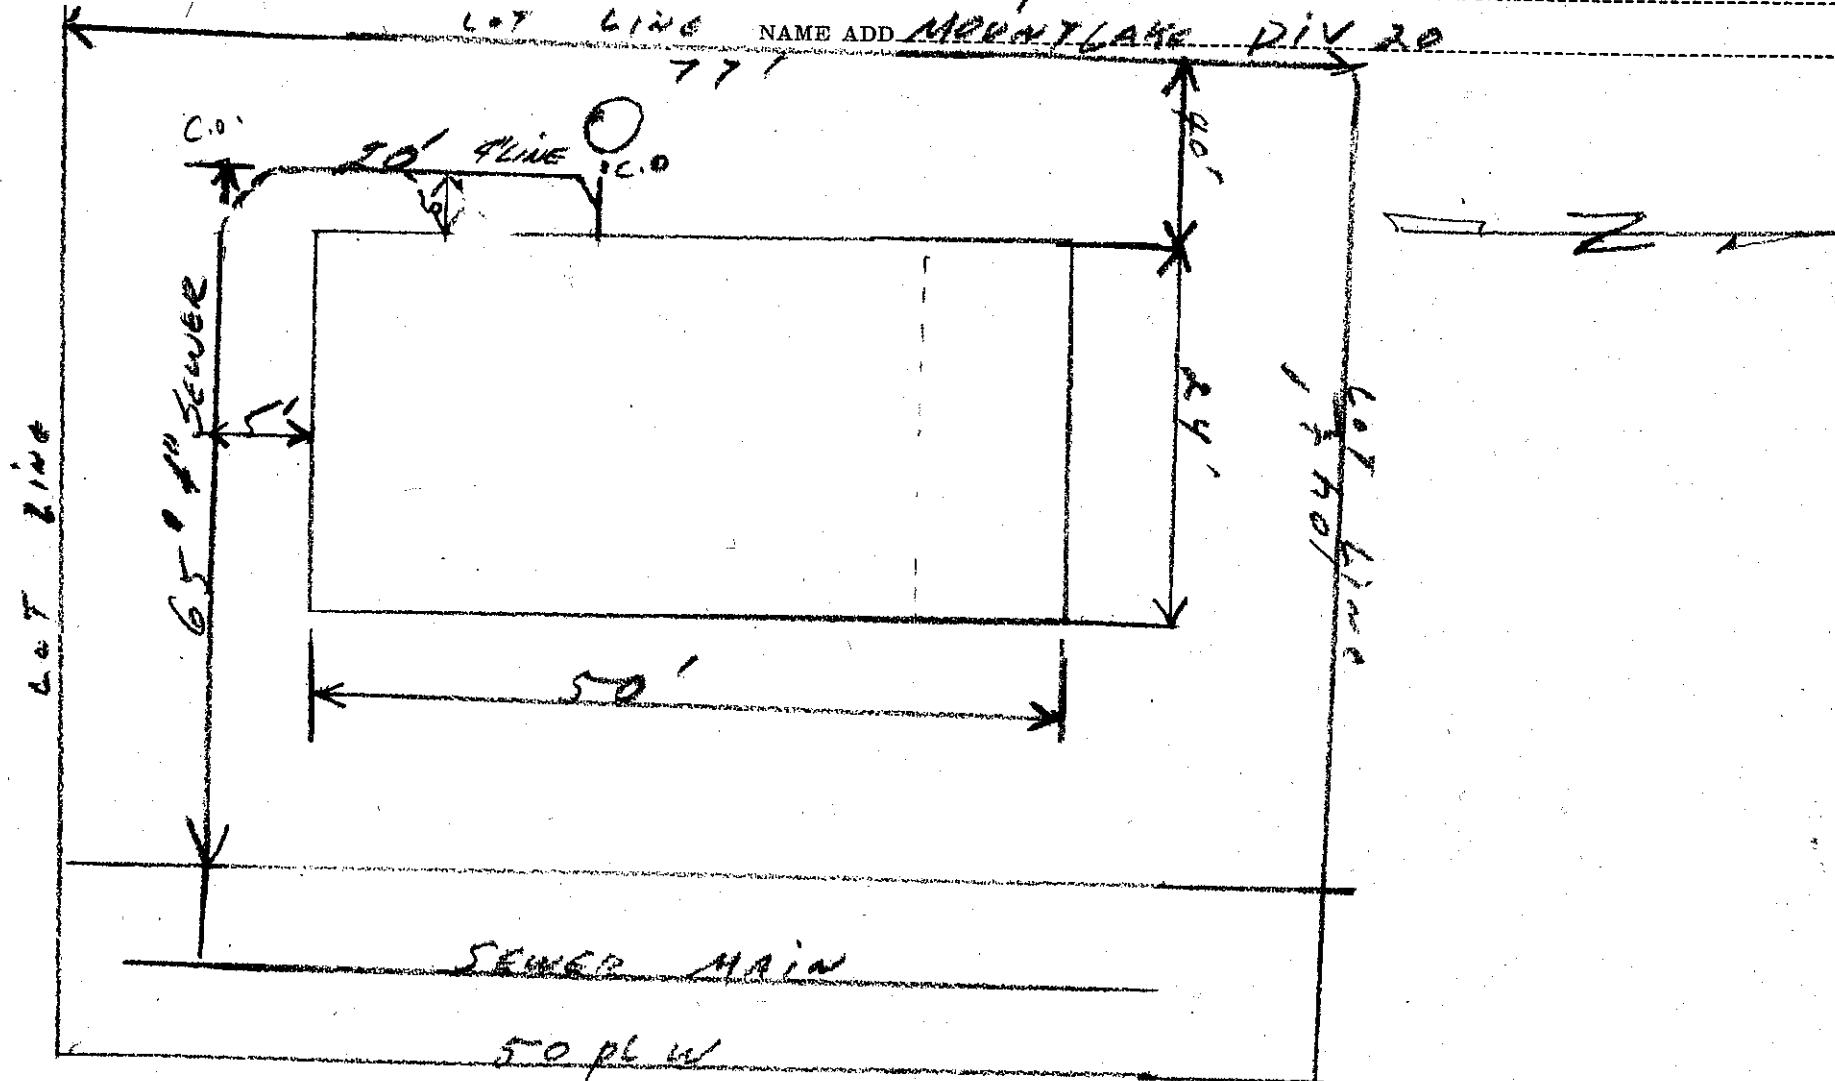

Date

Approved:

BACKFILL WORK ORDER ISSUED

DEPOSIT, \$ 60.00

SEWER WORK ORDER ISSUED

673-60
4/14/68

DATE

BY

J. M. Grinager

The City of Mountlake Terrace

APPLICATION

SIDE SEWER PERMIT
OUTSIDE INSIDE REPAIRS

JAMES C. MURRAY
CARD No.

EASEMENT No. None

OWNER James Chambers
HOUSE No. 21707 - 50th W.

CONTRACTOR Wingfield-Brown


PERMIT No. 2409

STREET
AVENUE LOT No. 47

BLOCK No.

NAME ADD.

Div# 20

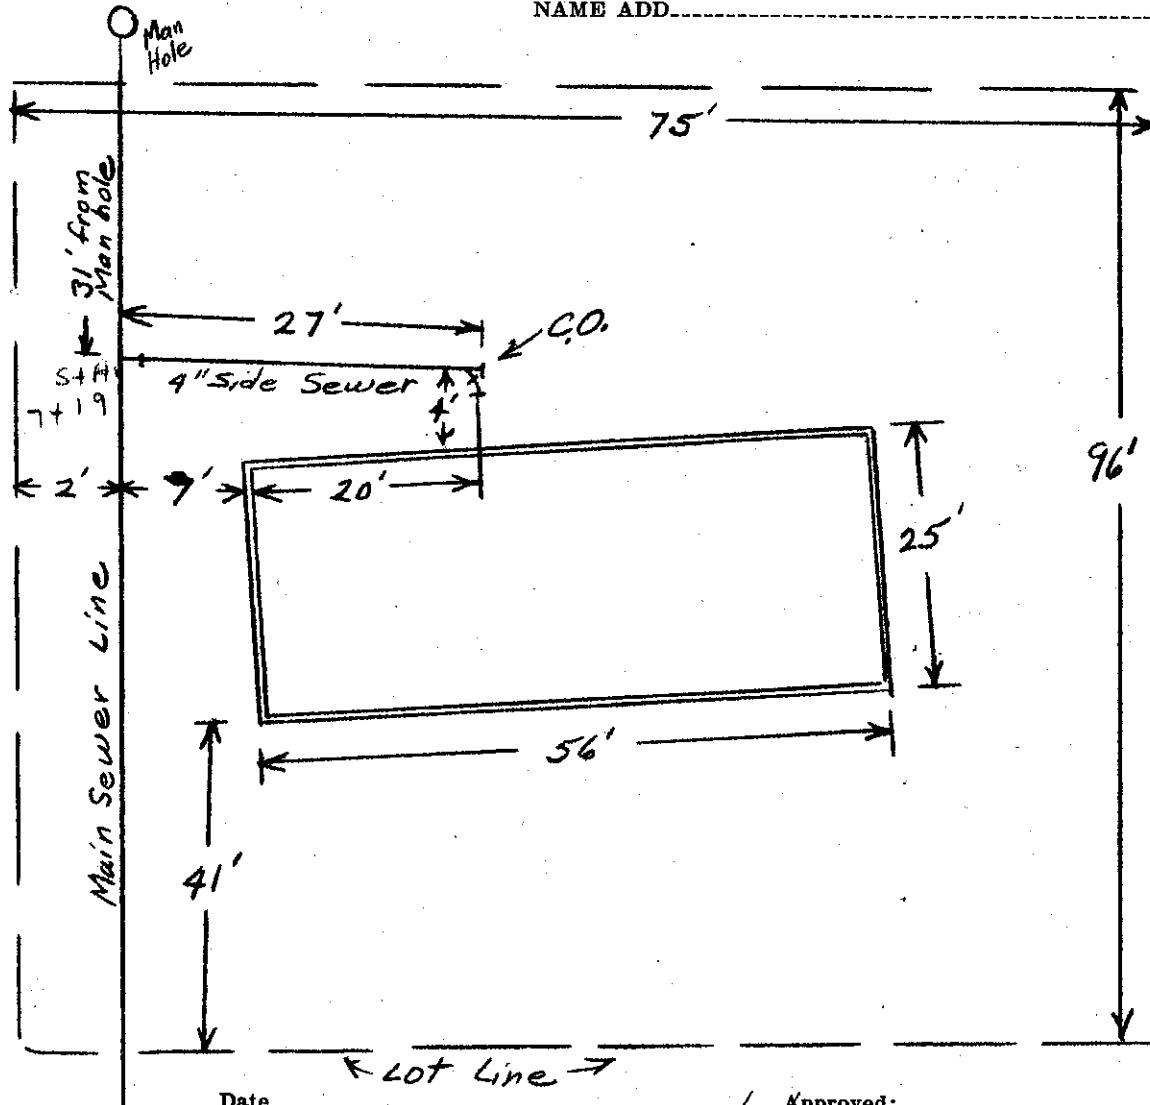

CITY OF
MOUNTLAKE TERRACE

APR 5 1960

Plan Approved

BACKFILL WORK ORDER ISSUED
SEWER WORK ORDER ISSUED

DEPOSIT, \$10.00 4/5/60

1196

Approved:

DATE 4/5/60 BY J. Fairman

The City of Mountlake Terrace

APPLICATION

Rex McCleary
CARD No.

SIDE SEWER PERMIT

OUTSIDE INSIDE REPAIRS

EASEMENT No. 1346815

OWNER Rex Mc Cleary
HOUSE No. 21708 - 50th W.

CONTRACTOR D. E. const


PERMIT No. 3600

STREET

AVENUE LOT No. 4 - DIV 2D

BLOCK No.

NAME ADD.

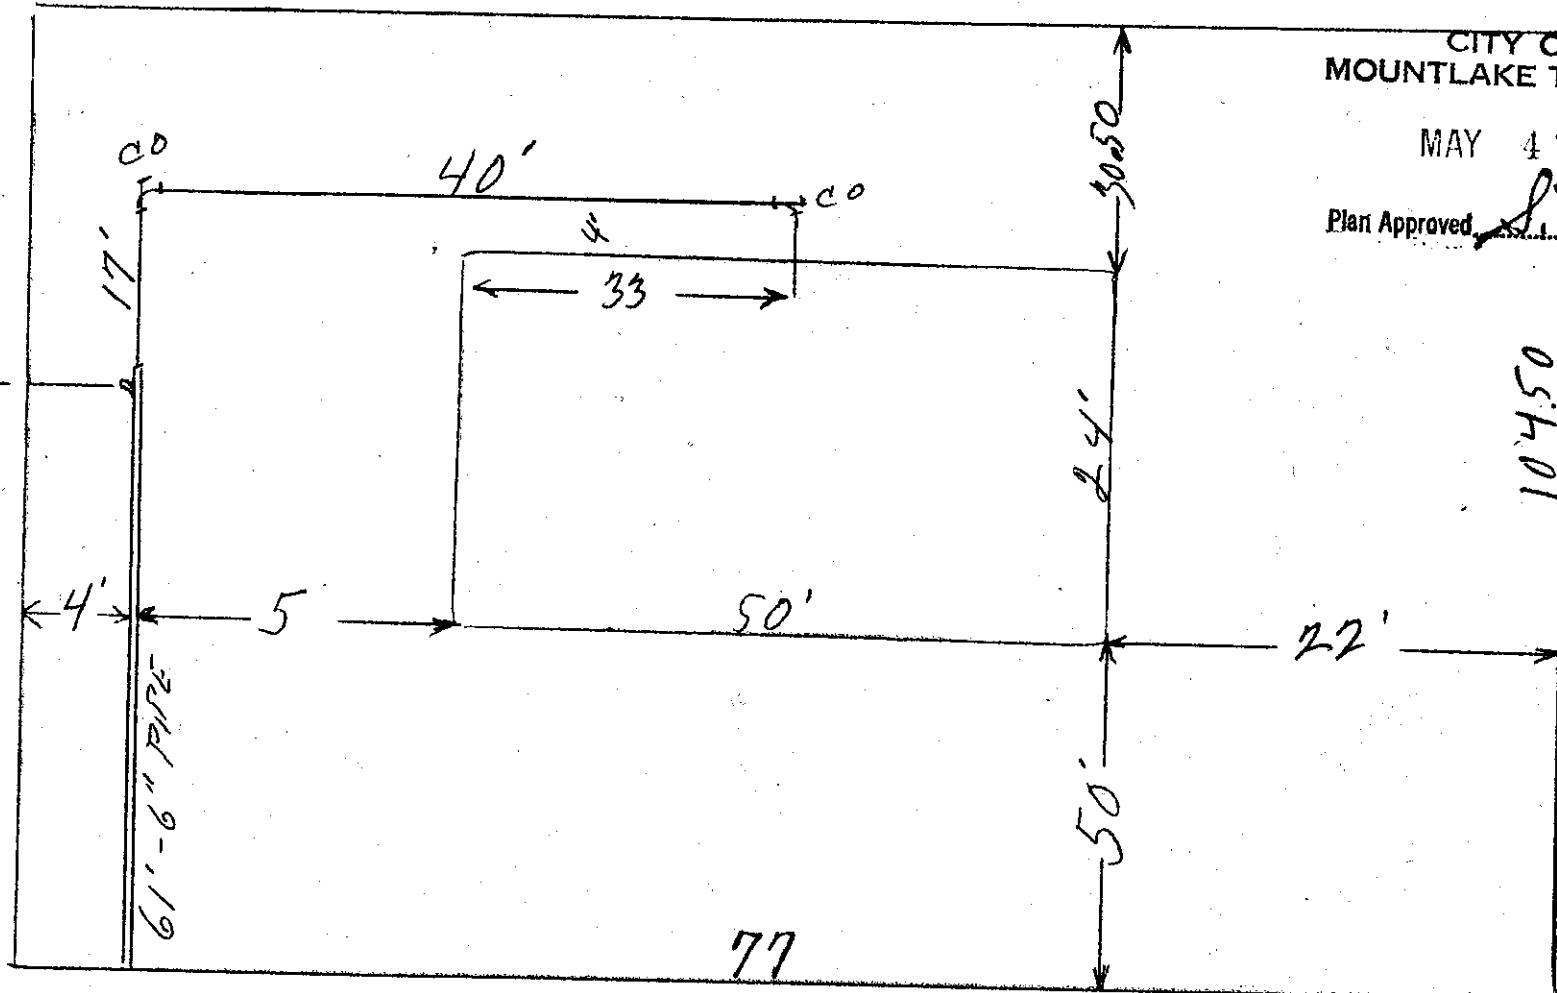

Date

BACKFILL WORK ORDER ISSUED

DEPOSIT, \$10.00

Approved:

SEWER WORK ORDER ISSUED

1375 - 5/4/60

Approved:

DATE 5-4-60

BY L. M. Holloman NS & CO

APPLICATION

The City of Mountlake Terrace

L. C. HUBBARD

CARD No.

SIDE SEWER PERMIT

OUTSIDE INSIDE REPAIRS

EASEMENT No. 1393626

OWNER LIMAN C. HUBBARD
HOUSE No. 21709 50th WEST

CONTRACTOR S&C

STREET 48
AVENUE LOT No.

NAME ADD.

2007

PERMIT No.

48


BLOCK No.

DIV. 20

CITY OF
MOUNTLAKE TERRACE

APR 21 1960

Plan Approved.

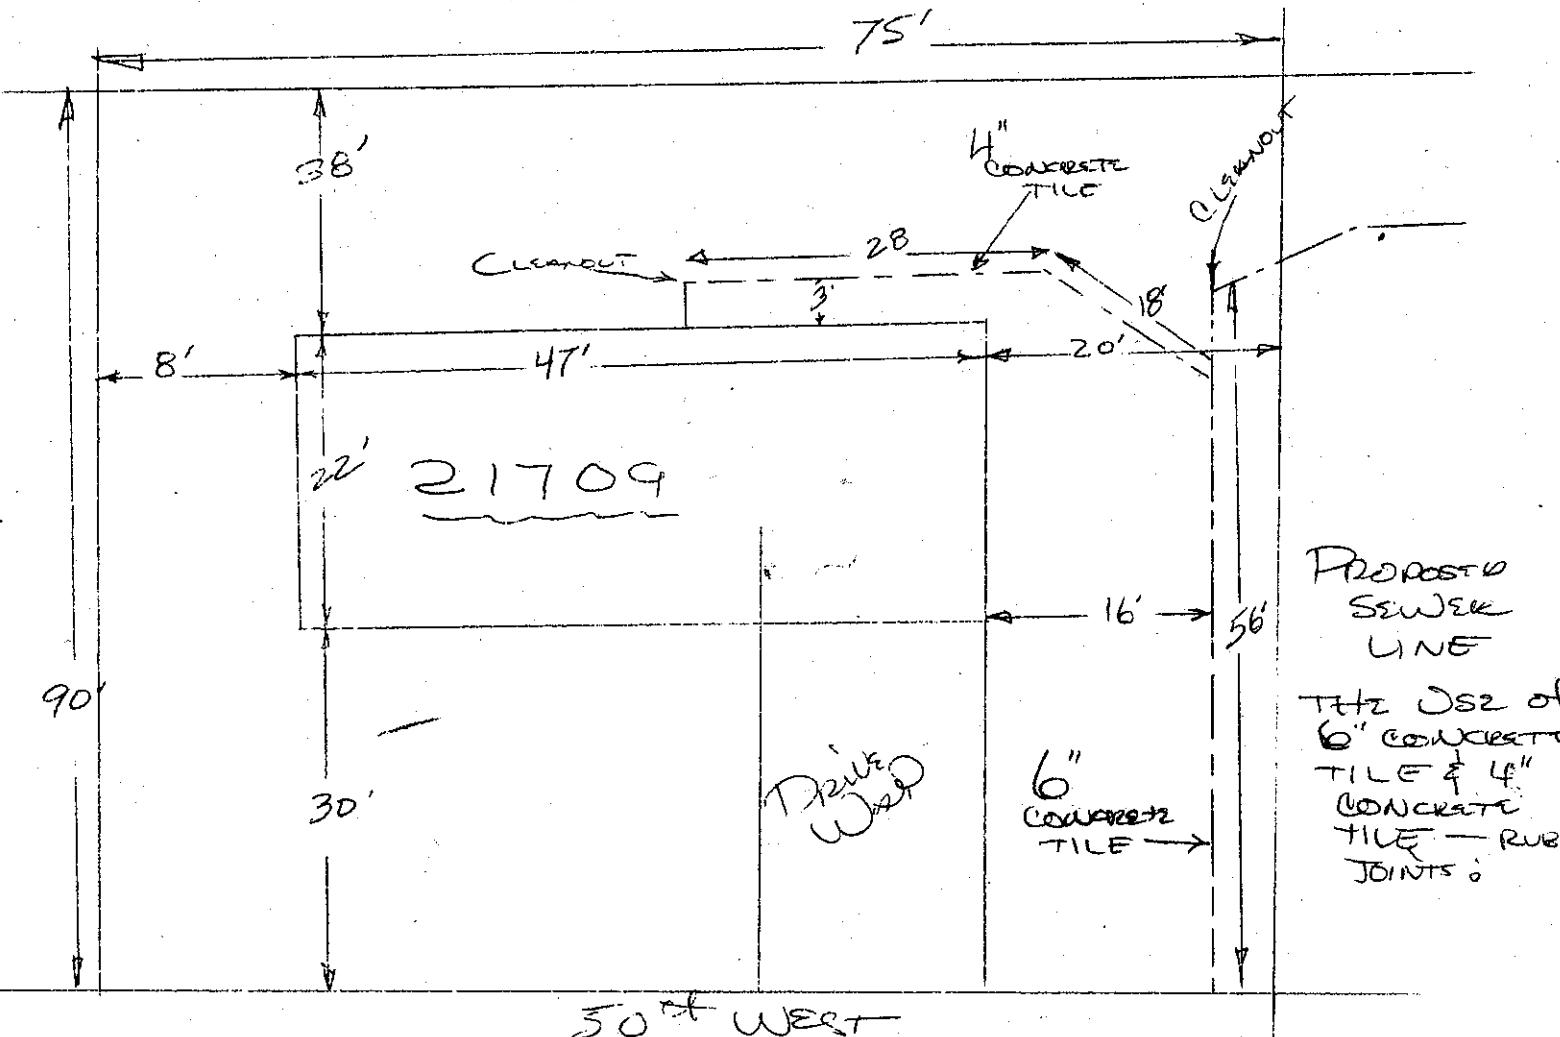BACKFILL WORK ORDER ISSUED
SEWER WORK ORDER ISSUED

DEPOSIT, \$10.00 4/20/60

129

DATE

4-26-60

BY

The City of Mountlake Terrace

APPLICATION
FOR

SIDE SEWER PERMIT

OUTSIDE INSIDE REPAIRS

HARRY M. JONES II

CARD No.

EASEMENT No. 1393626

OWNER Harry MC DONELL
HOUSE No. 21711 50th W

CONTRACTOR SELF.

STREET
AVENUE LOT NO.

49

BLOCK No.

NAME ADD.


Div. 20

PERMIT No. 2508

CITY OF
MOUNTLAKE TERRACE

APR 21 1960

Plan Approved, S.M. Ahern

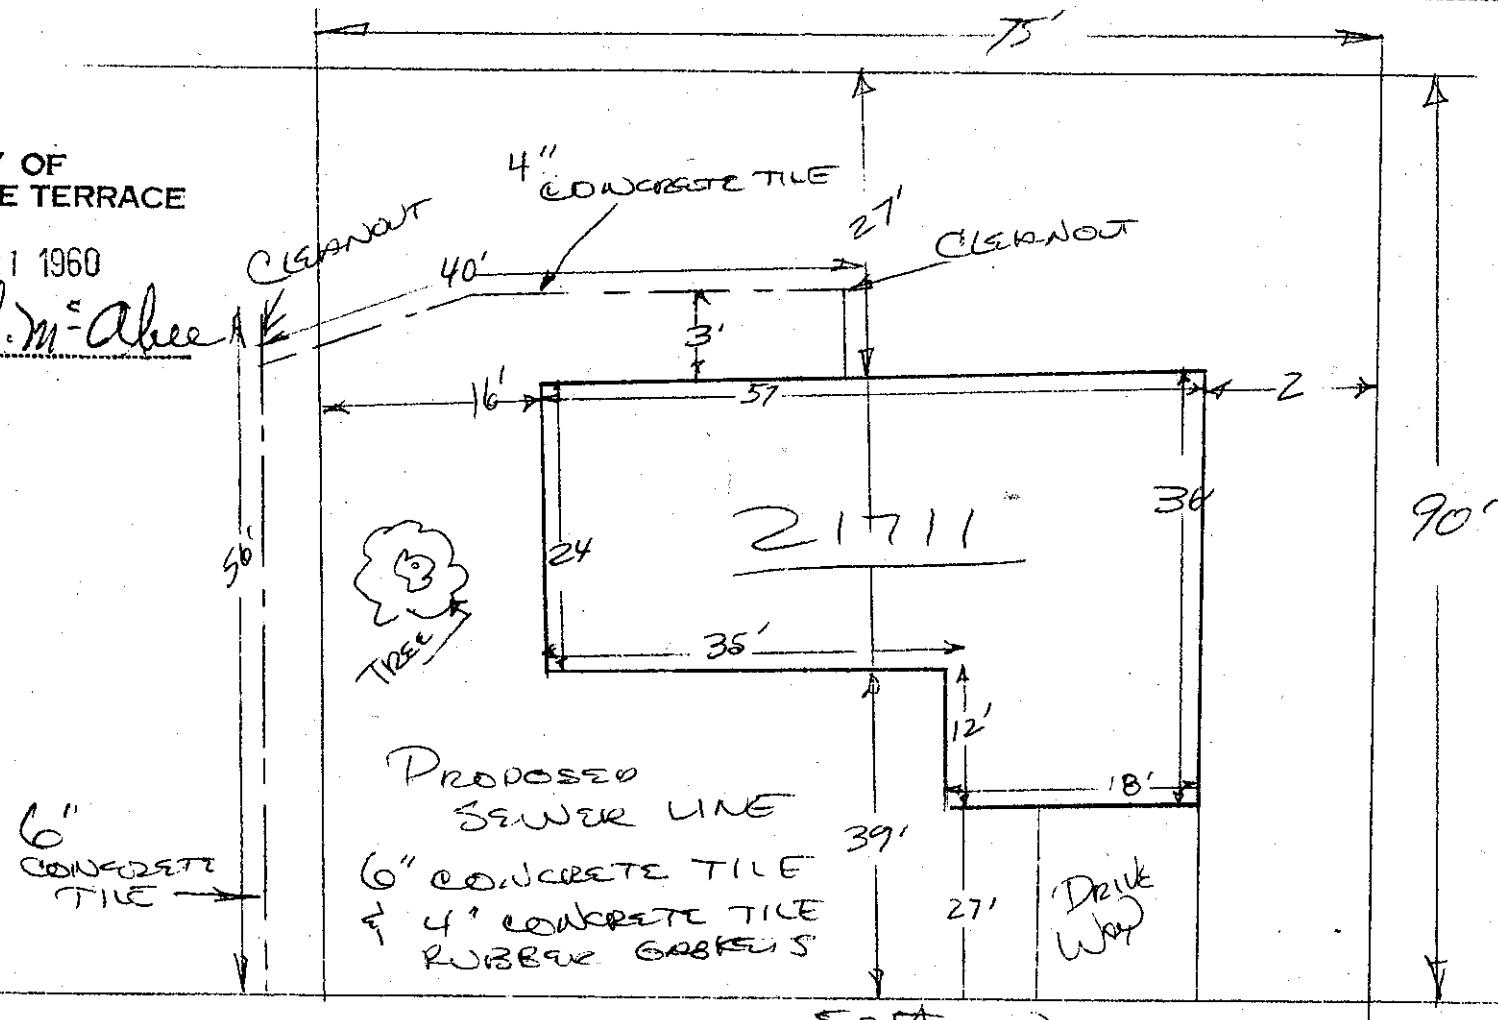

BACKFILL WORK ORDER ISSUED
SEWER WORK ORDER ISSUED

Date

DEPOSIT, \$ 10.00 4/20/60
1295 Approved:

DATE 4-26-60 BY Scott M. Holton STC-ON

The City of Mountlake Terrace

APPLICATION
for

SIDE SEWER PERMIT

OUTSIDE INSIDE REPAIRS

ELLIOTT IRVIN

CARD No.

EASEMENT No.


OWNER Elliott Irvin
HOUSE No. 21801 - 50th W.

CONTRACTOR B. & C.

PERMIT No. 2152

STREET AVENUE LOT No. 52 DIV 20 BLOCK No.

NAME ADD.

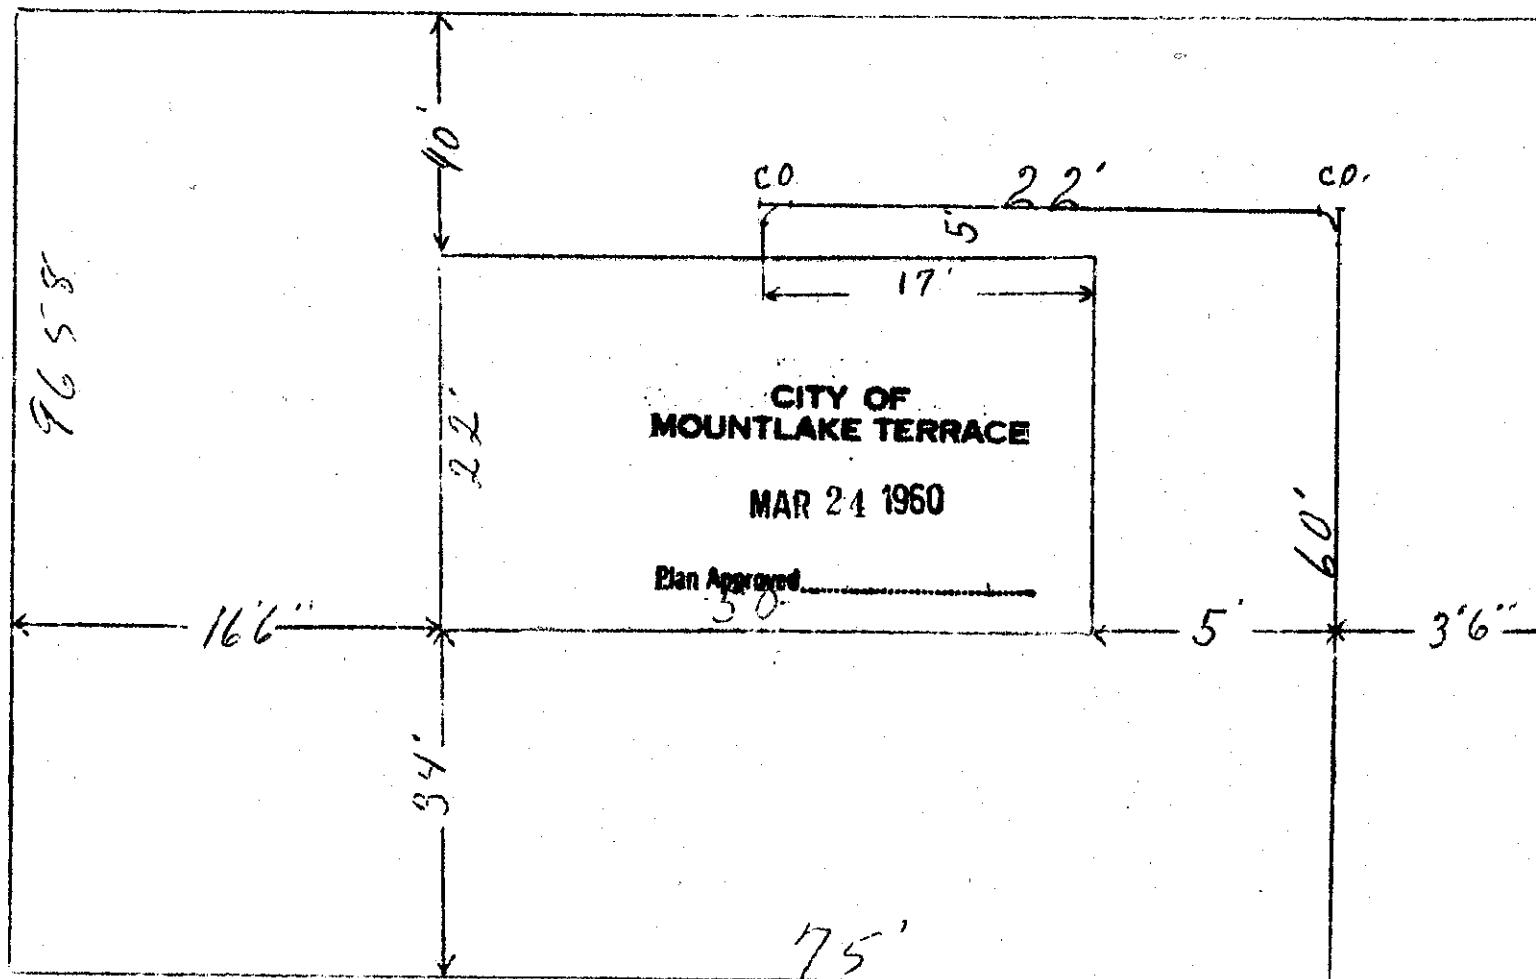

Date

BACKFILL WORK ORDER ISSUED
SEWER WORK ORDER ISSUED

DEPOSIT, \$10.00 3/24/60

Approved:

971

DATE

3-24-60

BY

Scott M Holton, WSTEON

W. S. Moffitt JT


1364182

Permit No. 2129

W. S. Moffitt
21805 - 50th W.

B. + E.

52 DIV 20

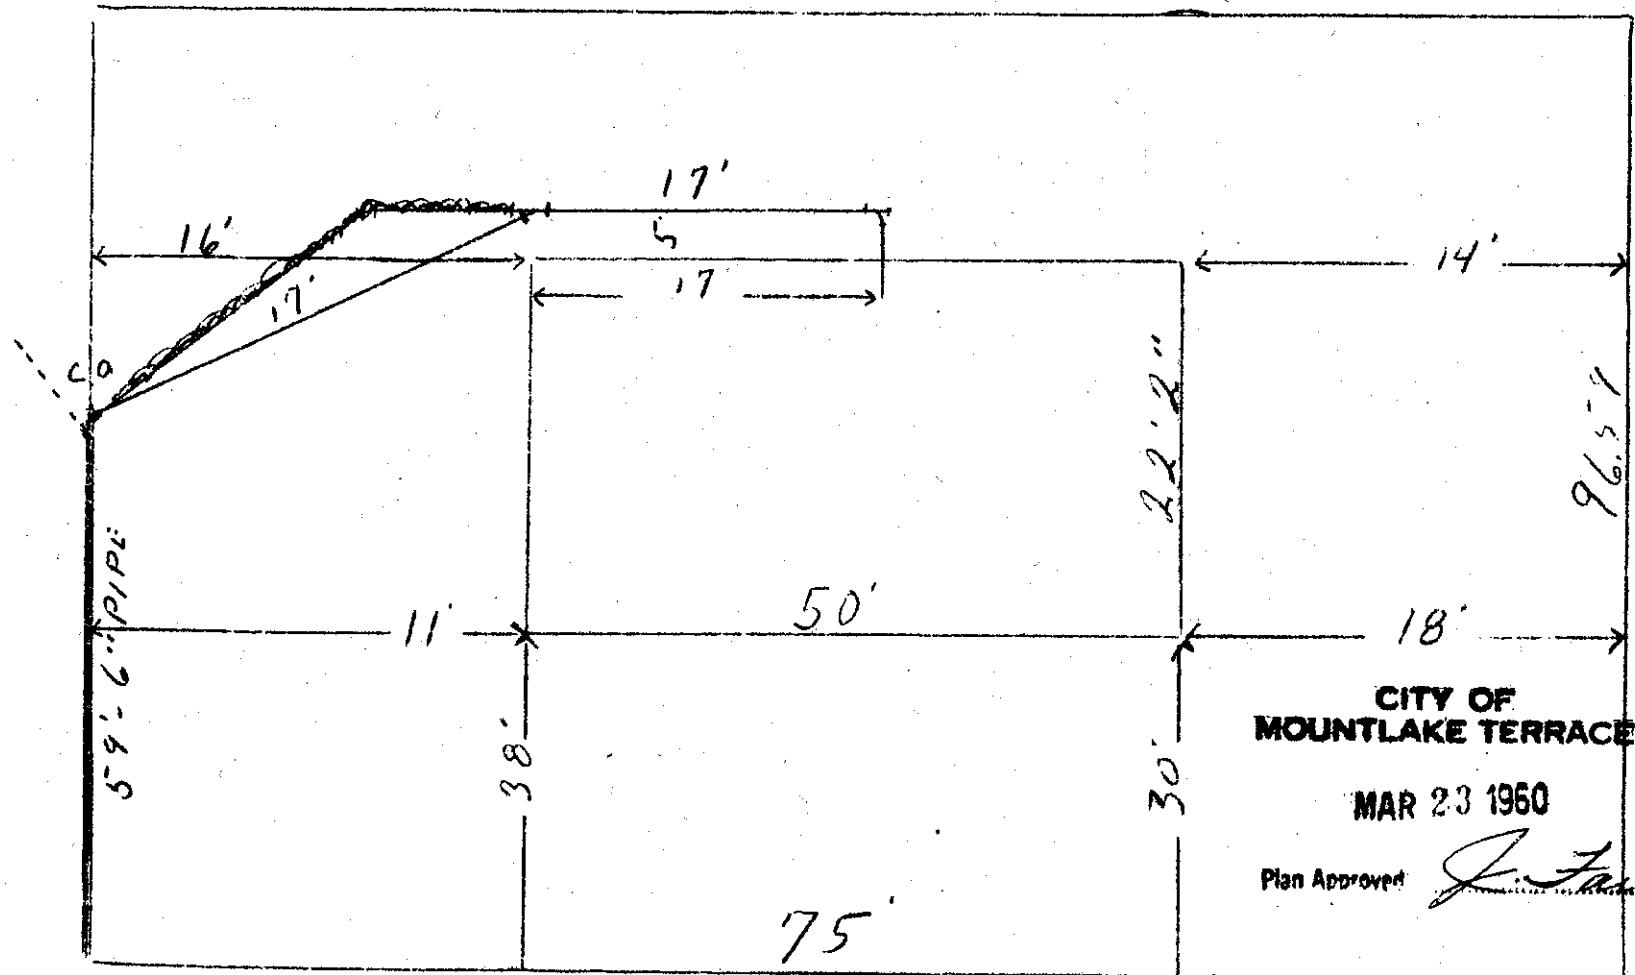

10100 3/23/60
956

3-24-60 Scott on Holton 1/8 sec

The City of Mountlake Terrace

APPLICATION

SIDE SEWER PERMIT

OUTSIDE INSIDE REPAIRS

CARD No.

EASEMENT No. 1360230


OWNER James C. Holm
HOUSE NO. 21807 - 50th W.

CONTRACTOR B. & E.

STREET AVENUE LOT No. 53 - DIV 20 BLOCK No.

PERMIT No. 2128

NAME ADD.

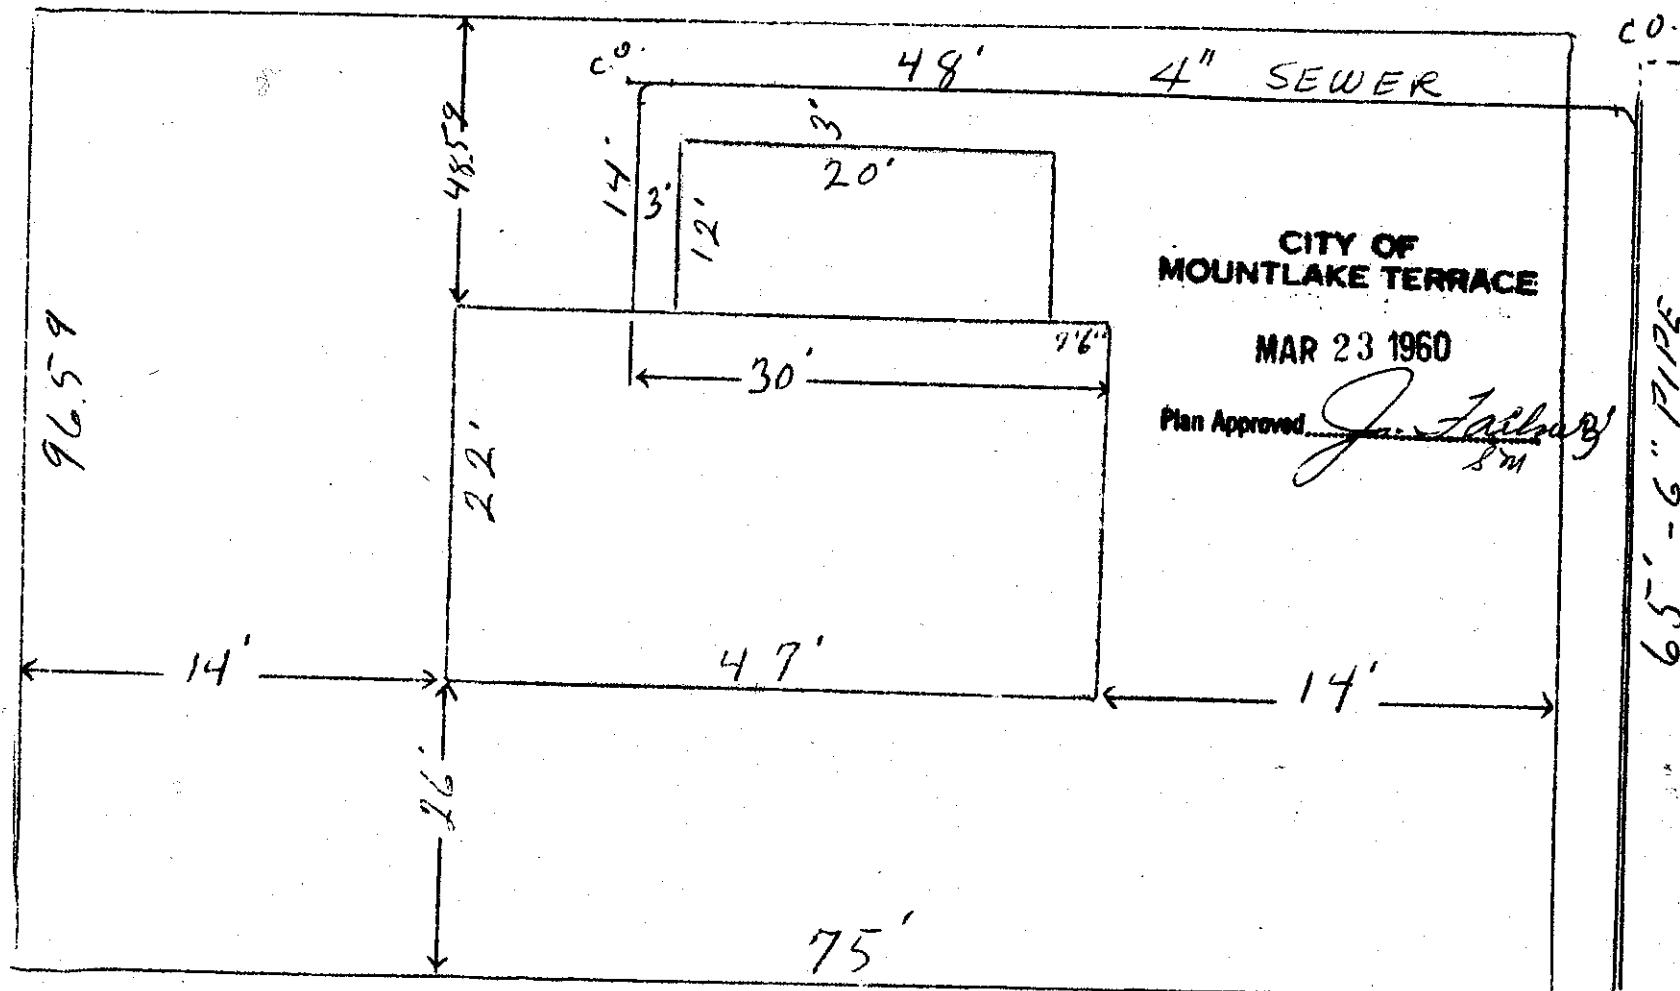

Date

BACKFILL WORK ORDER ISSUED
SEWER WORK ORDER ISSUED

DEPOSIT, \$10.00 3/23/60
956 Approved:

DATE

3-23-60 BY Scott m Holton INSTCON

The City of Mountlake Terrace

APPLICATION

for

SIDE SEWER PERMIT

OUTSIDE INSIDE REPAIRS

G.E. BERND

CARD No.

EASEMENT No.

OWNER G.E. BERND.

HOUSE No. 23010 NW 50

CONTRACTOR

STREET

AVENUE LOT No. 10

PERMIT No. 1280

BLOCK No. 2

NAME ADD Div. #10


96 FT

20 FT

-HHFT-

-29 FT -

6'-10"

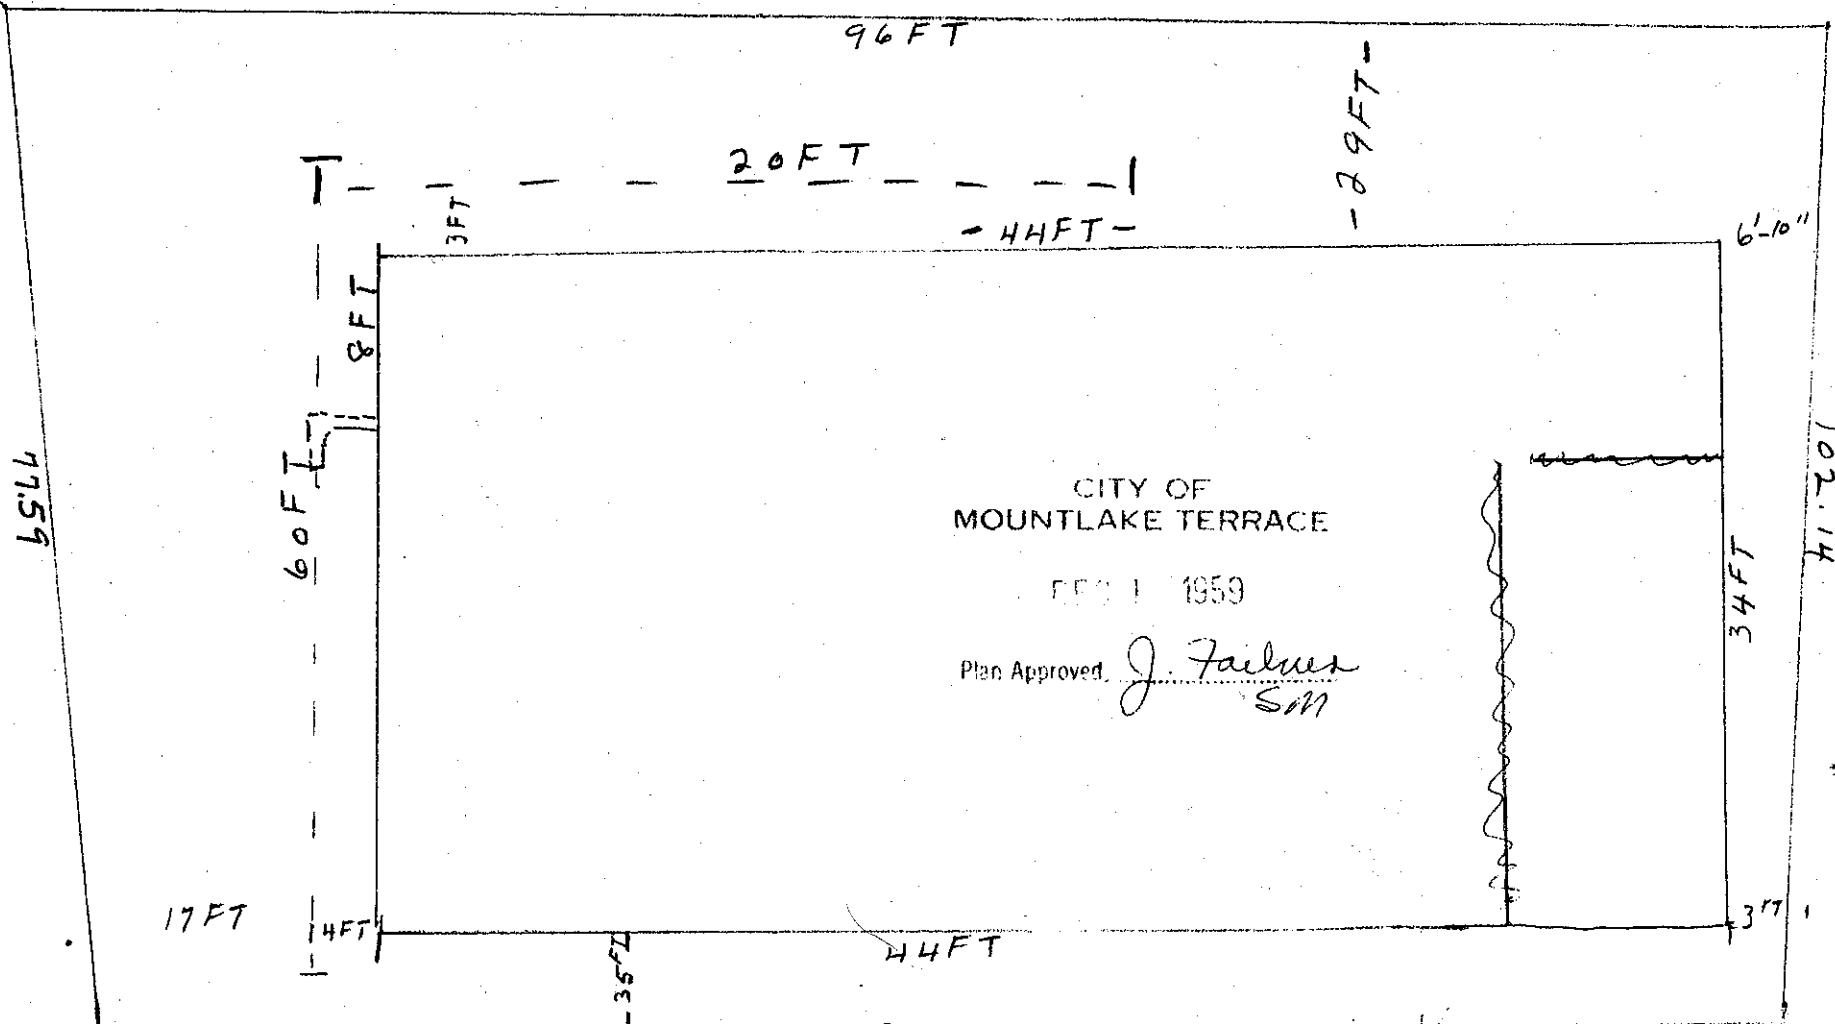

CITY OF
MOUNTLAKE TERRACE

DEC 1 1959

Plan Approved J. Failes
SM

Date

Approved:

BACKFILL WORK ORDER ISSUED

DEPOSIT, \$ 10.00

12/5/59

SEWER WORK ORDER ISSUED

5501

DATE 7-19-60 BY

2-19-60 INST-COM 8MTH

The City of Mountlake Terrace

APPLICATION
for

SIDE SEWER PERMIT
OUTSIDE INSIDE REPAIRS

W.D. HANSON
CARD No.

EASEMENT No.

OWNER W.D. Hamilton

CONTRACTOR Self


PERMIT No. 2000

HOUSE No. 23104 - 50th West

STREET
AVENUE LOT No. 9

BLOCK No. 2

NAME ADD Mountlake Terrace Division # 10

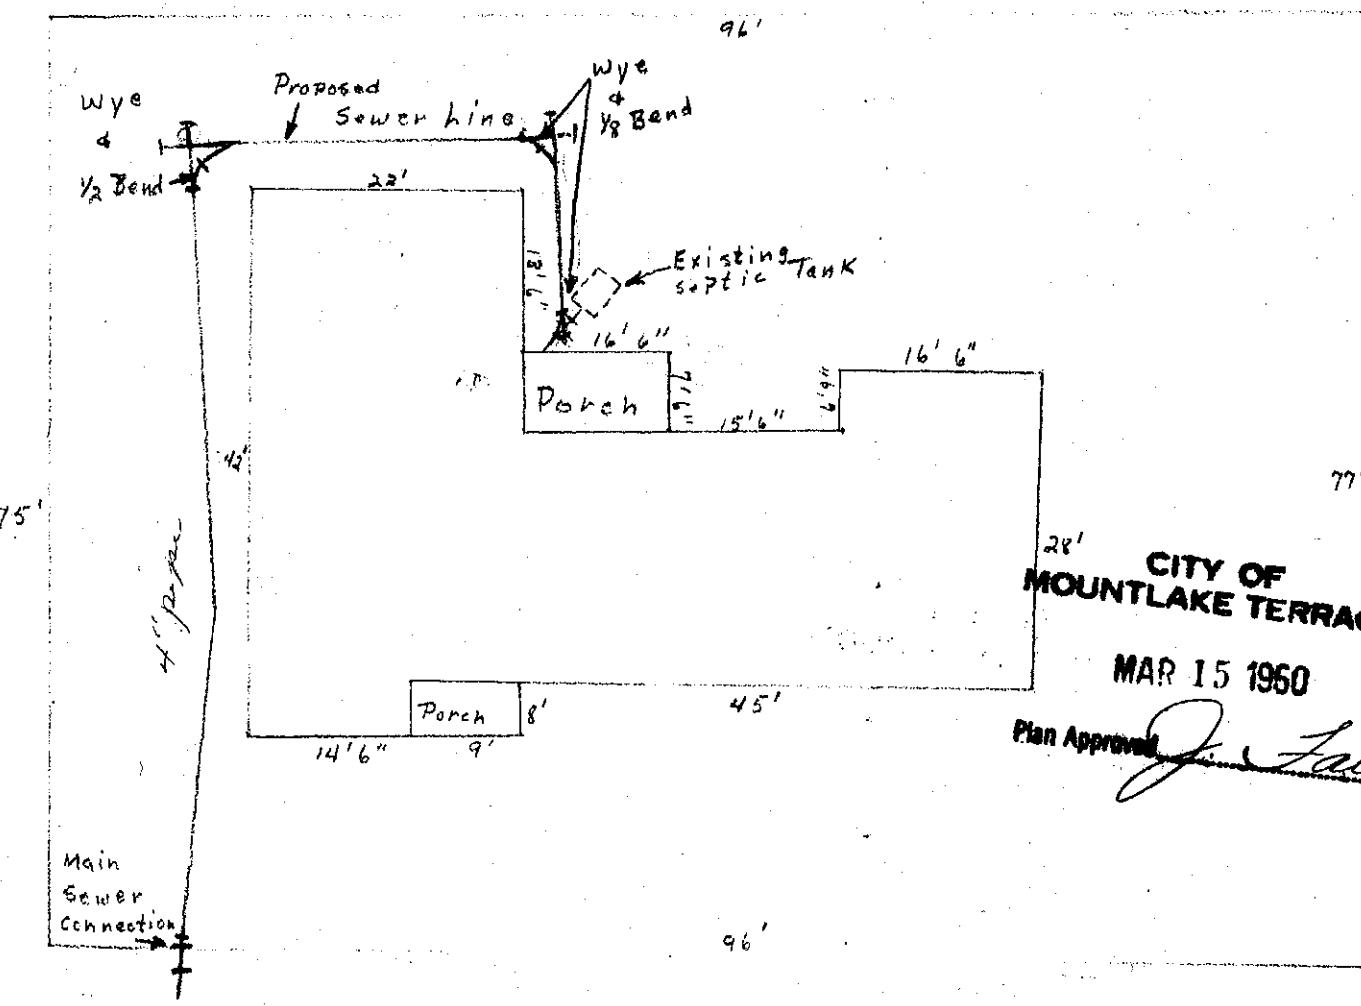

CITY OF
MOUNTLAKE TERRACE

MAR 15 1960

Plan Approved

J. Falmer

Date

Approved:

BACKFILL WORK ORDER ISSUED

DEPOSIT, \$ 10.00

SEWER WORK ORDER ISSUED

3/15/60

DATE 5-13-60 BY

T1 845

Scott M Holton, Asst Cw

The City of Mountlake Terrace

APPLICATION

for

SIDE SEWER PERMIT

OUTSIDE INSIDE REPAIRS

R.R. 17-1-10-102
CARD No. _____

EASEMENT No. _____

OWNER Robert R. Haaland

CONTRACTOR *John Z.* - Owner


PERMIT NO. 1537

HOUSE NO. 23168 - 30TH AV. WEST

STREET
AVENUE LOT NO. 8

BLOCK NO. 2

NAME ADD. Mountlake Terrace Division #10

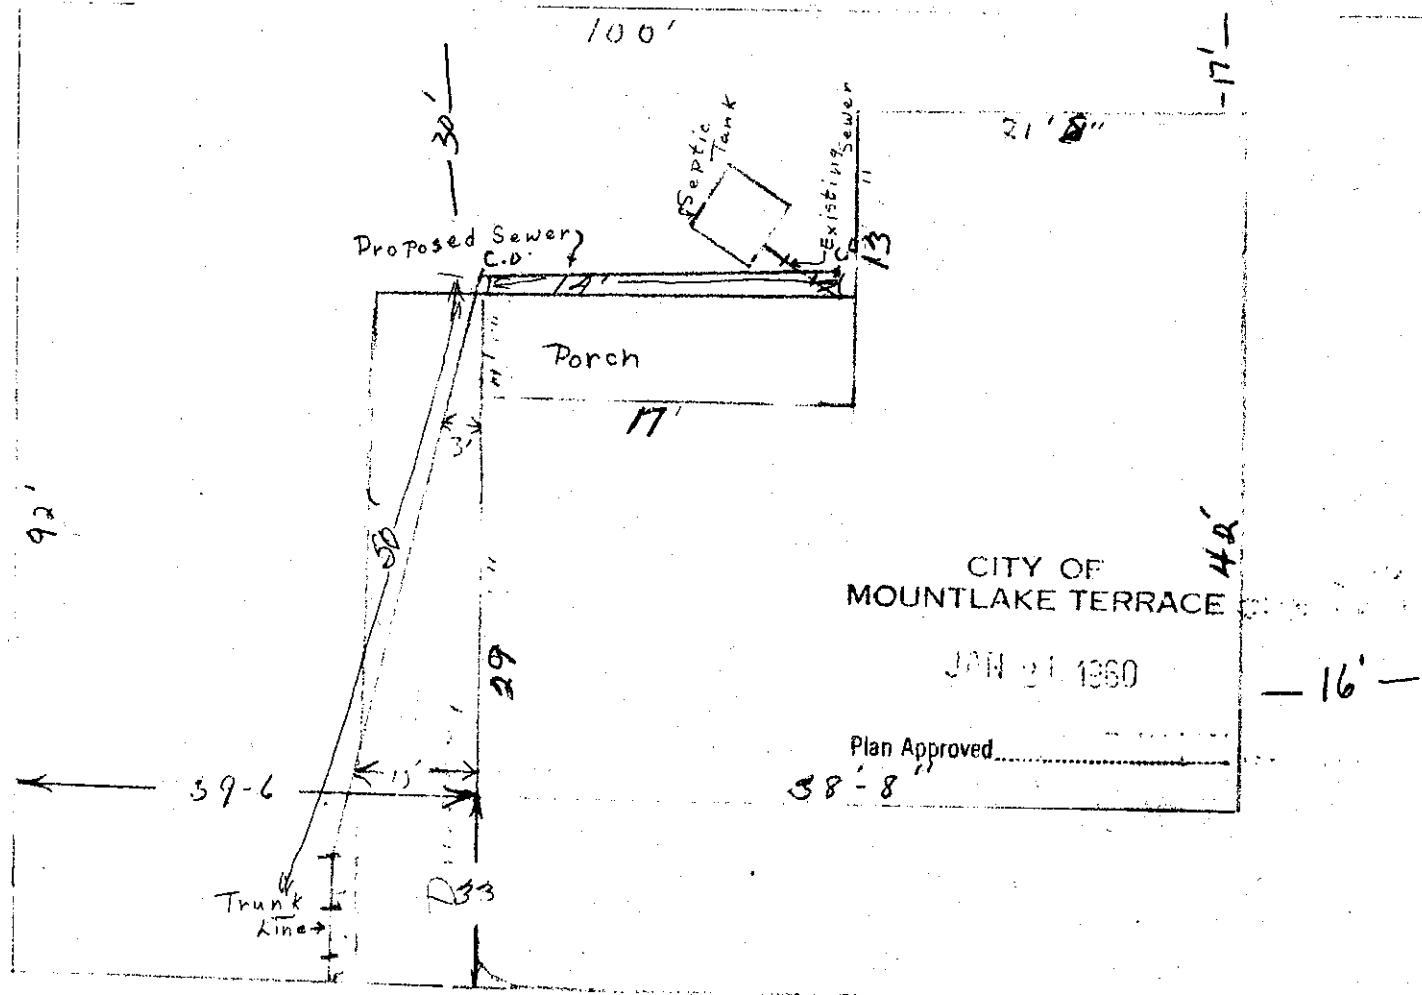

Date

Approved:

BACKFILL WORK ORDER ISSUED

DEPOSIT, \$10.00

SEWER WORK ORDER ISSUED

mc 552 DATE 1-22-60 BY S. Cotton Holton N.C.
11-1-60 2-1-1960 1-1-1960 1-1-1960

The City of Mountlake Terrace

APPLICATION

CARD No.

SIDE SEWER PERMIT

OUTSIDE INSIDE REPAIRS

EASEMENT No.


None

OWNER L. Patten CONTRACTOR Pyle Construction Co. PERMIT No. 800

HOUSE No. 2311 1/2 75th Place STREET 75th AVENUE LOT No. 7 BLOCK No. 2

NAME ADD.

Dix No 10

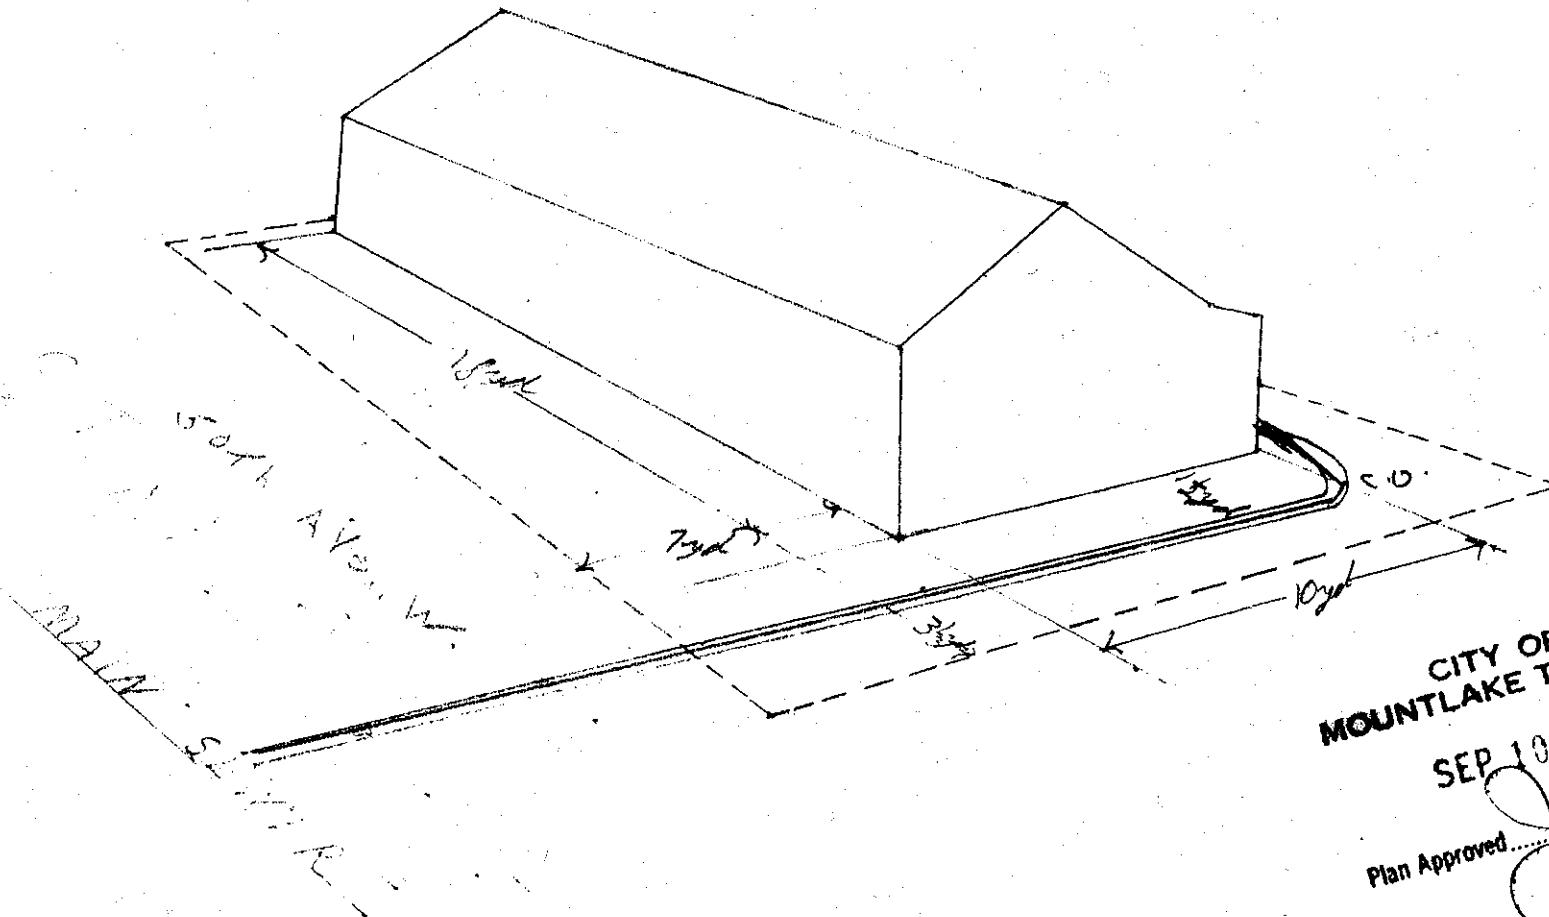

CITY OF
MOUNTLAKE TERRACE

SEP 10 1959

Plan Approved

Date

Approved:

BACKFILL WORK ORDER ISSUED

DEPOSIT, \$10⁰⁰ 9-8-59

SEWER WORK ORDER ISSUED

A 4345 DATE

6/13/60

BY

J. E. Morris

The City of Mountlake Terrace


APPLICATION

CARD No.

SIDE SEWER PERMIT
 OUTSIDE INSIDE REPAIRS

EASEMENT No.

OWNER David Deleso CONTRACTOR Rainier const. PERMIT No. 2267
 HOUSE No. 23205 50 w STREET AVENUE LOT No. 3 BLOCK No. 7
 NAME ADD NO 10

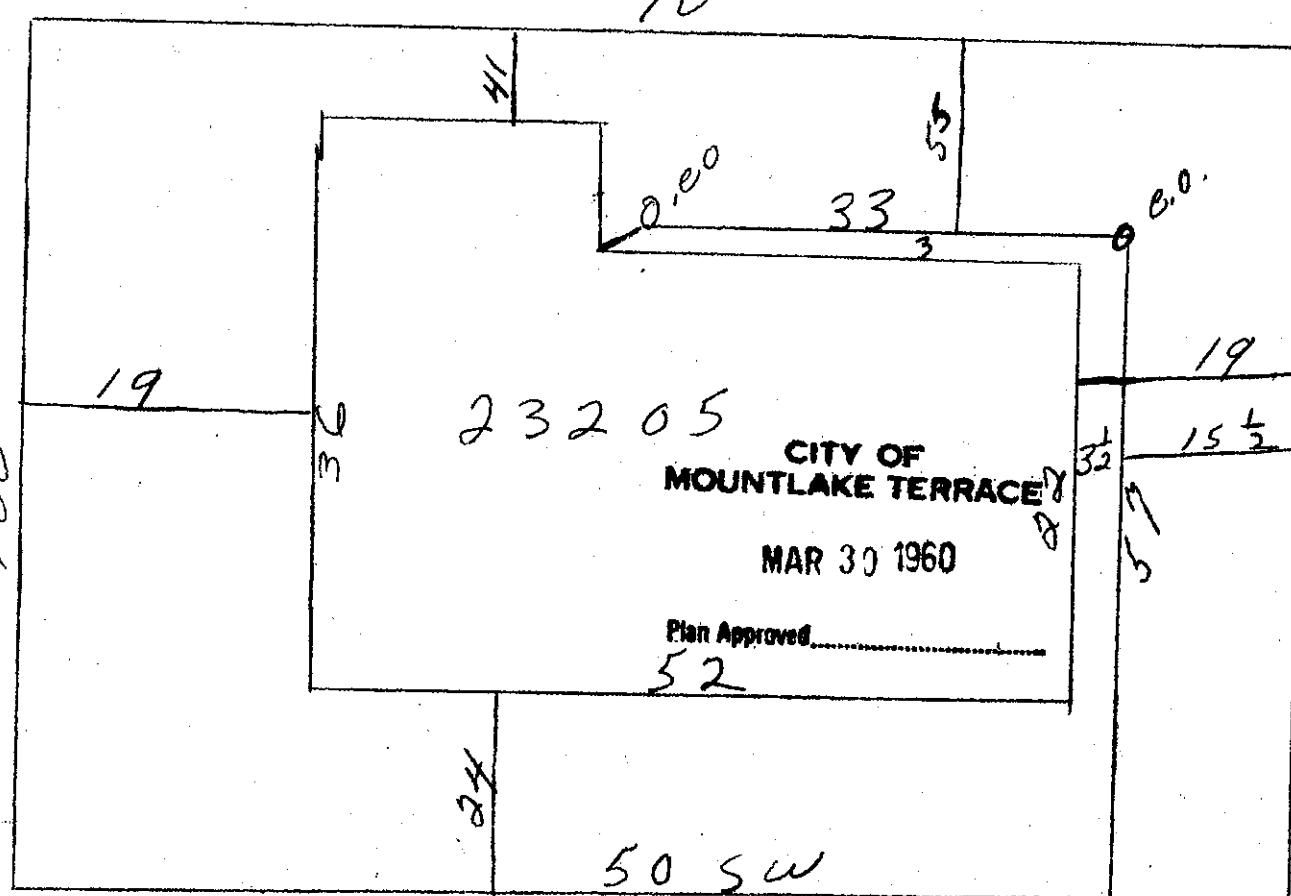

Date

BACKFILL WORK ORDER ISSUED
 SEWER WORK ORDER ISSUED

DEPOSIT, \$10.00 Approved:
 3/09/60

1065 DATE 3-31-60 BY Scott McHale, MSA

The City of Mountlake Terrace

APPLICATION

SIDE SEWER PERMIT
OUTSIDE INSIDE REPAIRS

ARVID JJDEN
CARD No. _____

OWNER ARVID JJDEN

HOUSE NO. 23206 - 50TH WEST

DWELL


CONTRACTOR

STREET
AVENUE LOT No.

NAME ADD. DIA #10

PERMIT No. 166

EASEMENT No. _____
BLOCK No. 6

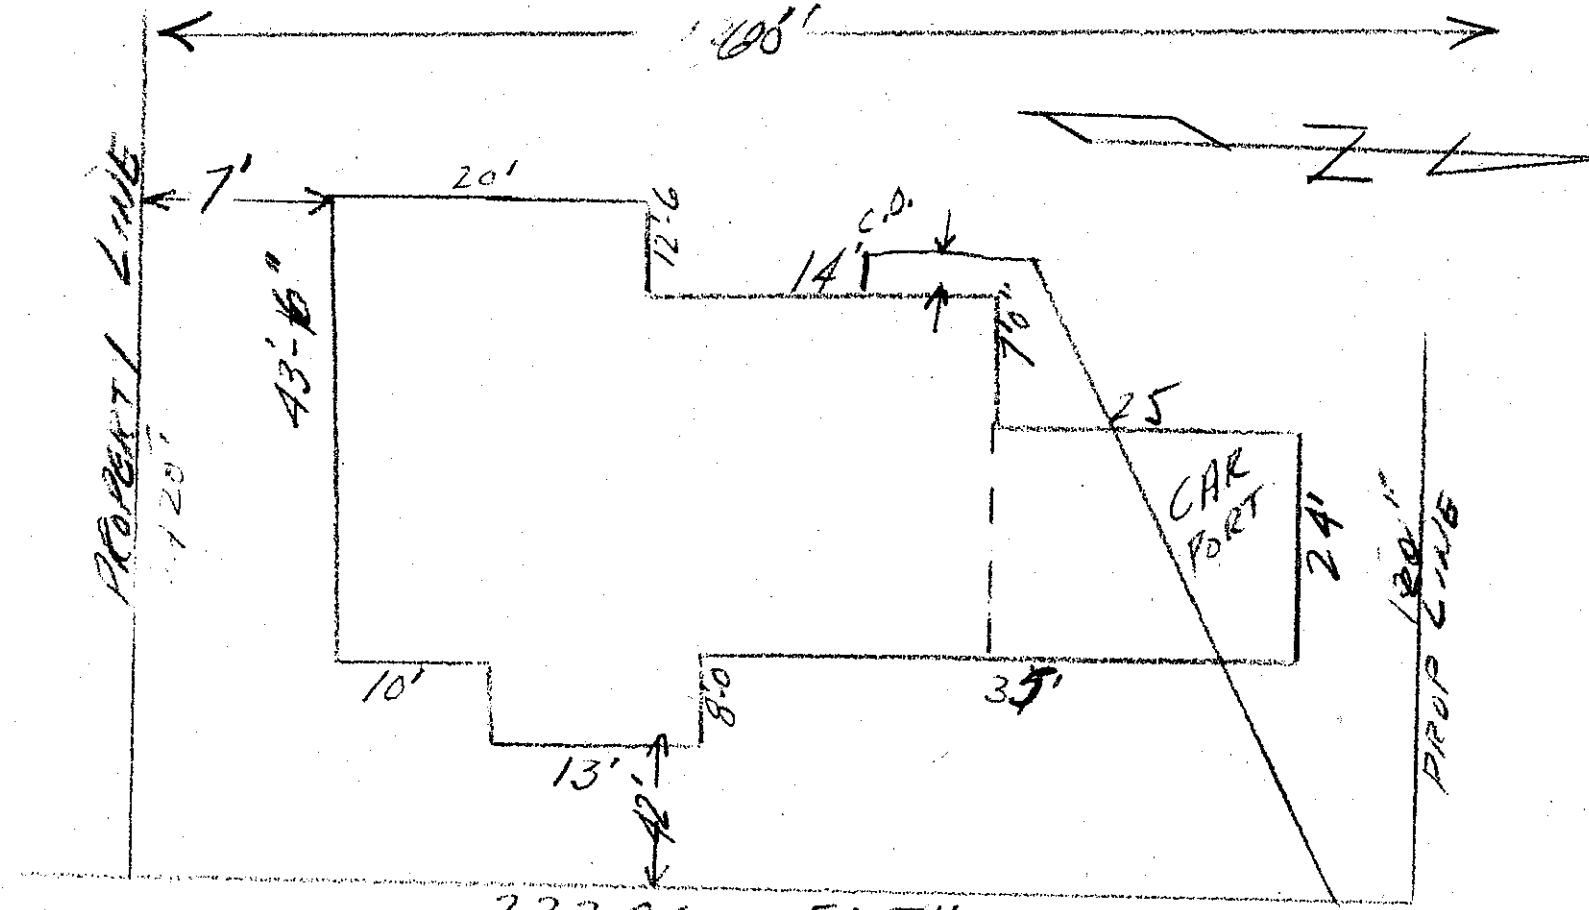

Date

6/10/60

DEPOSIT, \$ 10.00

Approved:

BACKFILL WORK ORDER ISSUED

SEWER WORK ORDER ISSUED

6-6-60

1595

DATE

6/10/60 BY

J. E. Moran

The City of Mountlake Terrace

APPLICATION

CARD No.

SIDE SEWER PERMIT

OUTSIDE INSIDE REPAIRS

EASEMENT No. None

OWNER Ewing & Clark
HOUSE No. 2320 1/2 - 50th W.

CONTRACTOR

Wingfield

STREET
AVENUE LOT No. 17

PERMIT NO. 606


BLOCK No. 6

NAME ADD.

Div. #10

67'

N

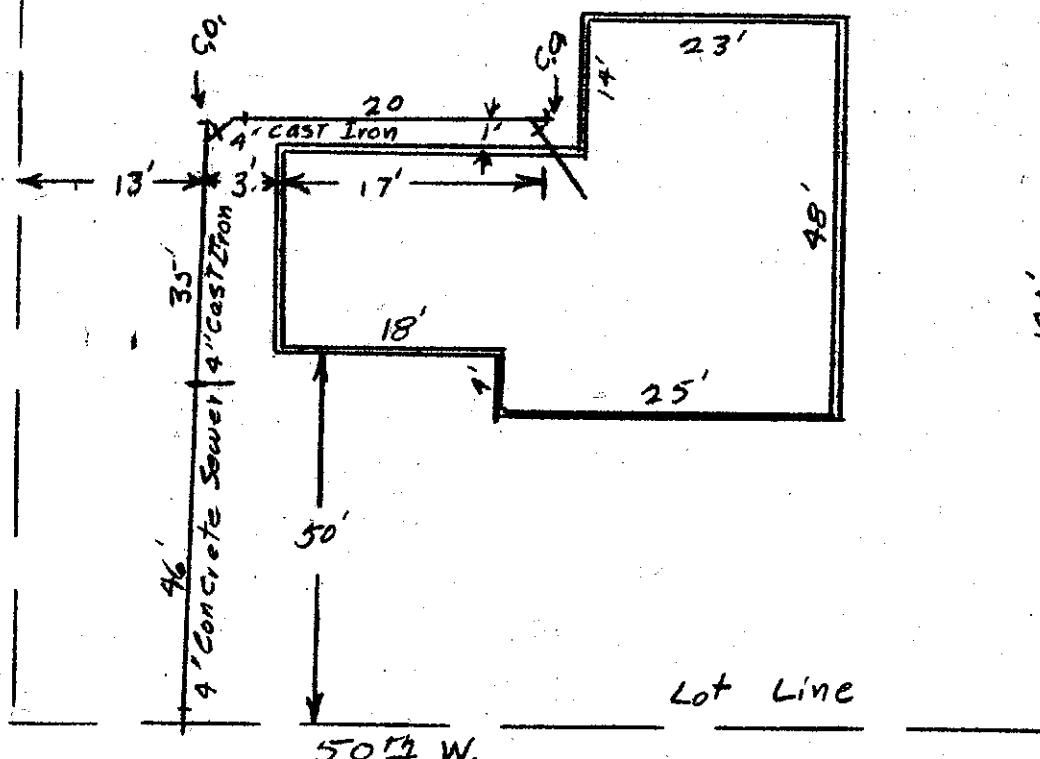

Date

Approved:

BACKFILL WORK ORDER ISSUED

DEPOSIT, \$10.00 12/6/60

SEWER WORK ORDER ISSUED

2062 DATE 12-6-60

BY J. M. Hollon

The City of Mountlake Terrace

APPLICATION

W. G. HUGHES
CARD No.

SIDE SEWER PERMIT

OUTSIDE INSIDE REPAIRS

EASEMENT No.

OWNER W H HUGHES
HOUSE No. 23305 50 SW


CONTRACTOR RAINIER

PERMIT No. 2148

STREET AVENUE LOT No. 537 Lot 6 N. 31' Lot 7 BLOCK No. 7

NAME ADD. M.L.T. Div. No. 10

69

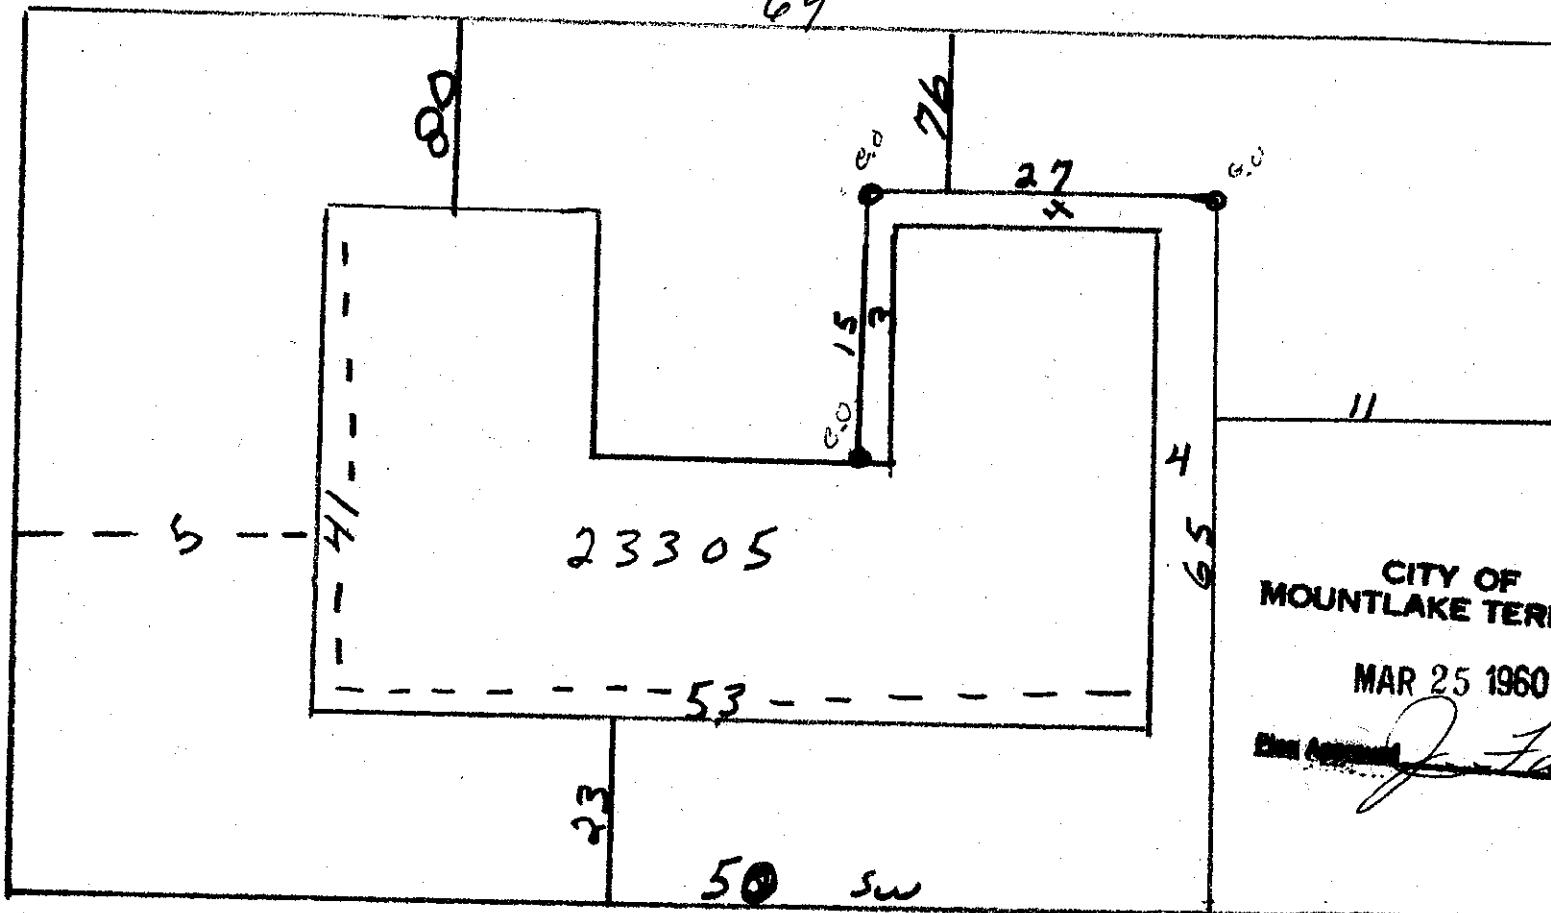

Date

BACKFILL WORK ORDER ISSUED
SEWER WORK ORDER ISSUED

Approved:

DEPOSIT, \$10.00 3/23/60

968

DATE 3/24/60 BY

J. Fialuer

The City of Mountlake Terrace

APPLICATION

for

SIDE SEWER PERMIT

OUTSIDE INSIDE REPAIRS

CARD No.

14208-
1391477

EASEMENT No.

3-Way easement

OWNER

E MULLEN J.

HOUSE No.

23308 - 50 SW

CONTRACTOR

STREET

AVENUE LOT No.


NAME ADD.

13

BLOCK No.

6

PERMIT No. 2414

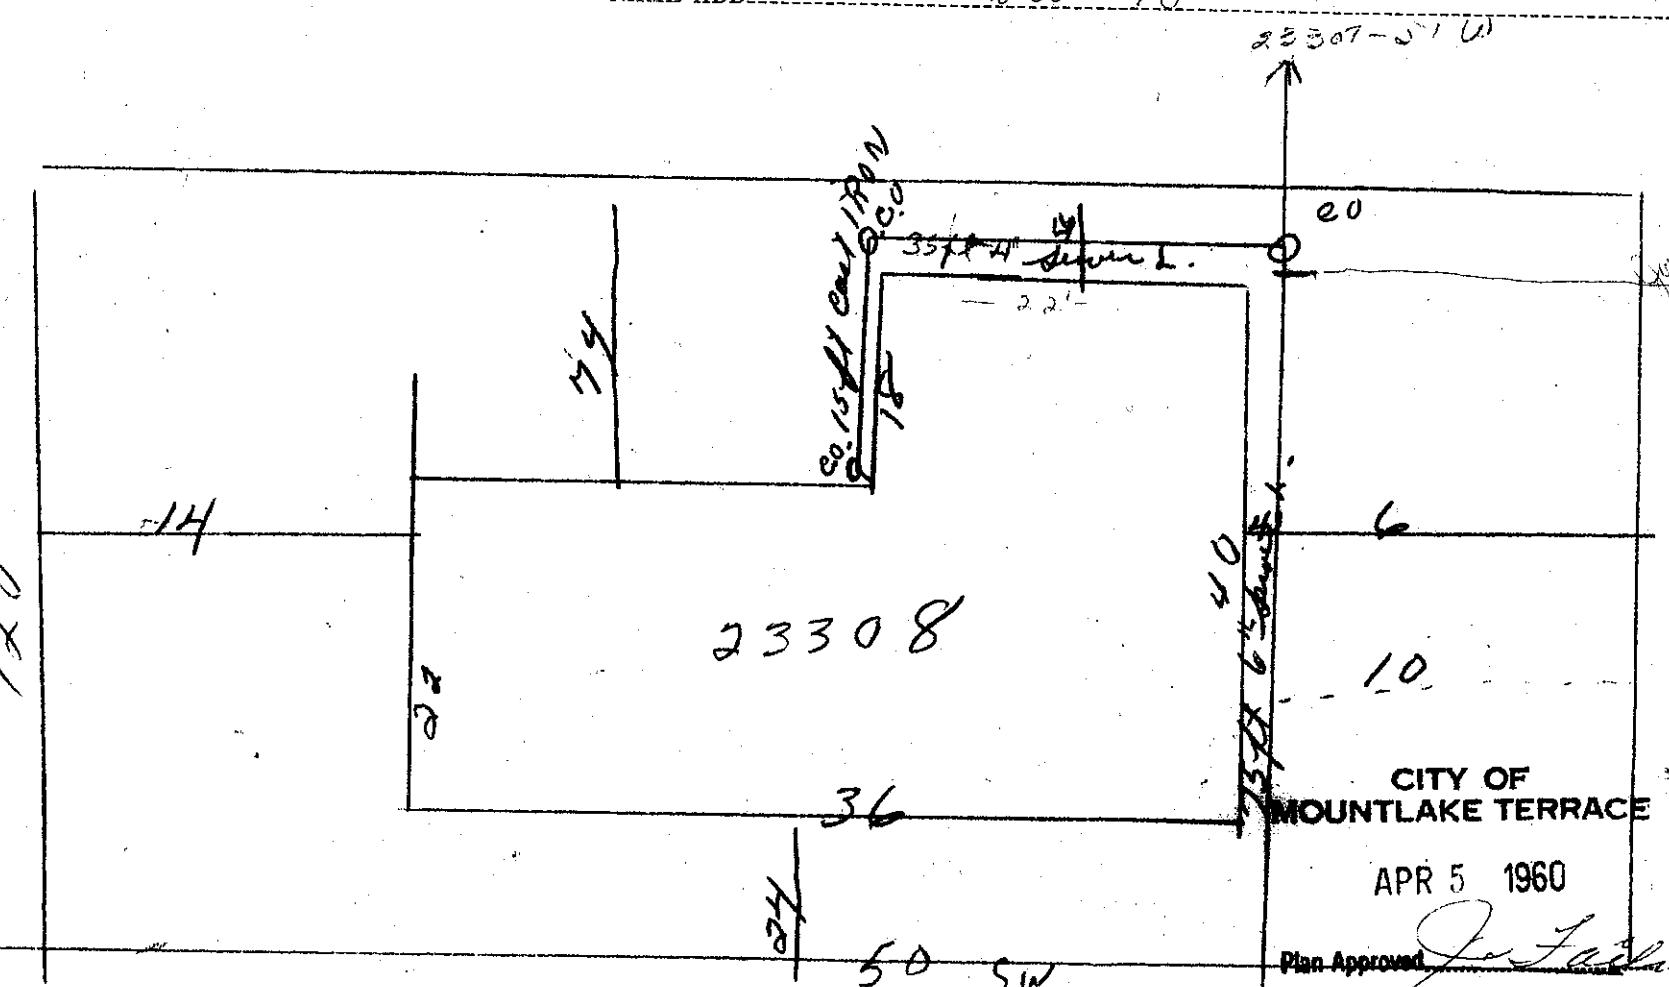

CITY OF
MOUNTLAKE TERRACE

APR 5 1960

Plan Approved

F. Fairman

Date

Approved:

BACKFILL WORK ORDER ISSUED

DEPOSIT, \$ 10.00

10.00

SEWER WORK ORDER ISSUED

4/5/60
H. 12.00

DATE

4/5/60 BY

F. Fairman

The City of Mountlake Terrace

APPLICATION

for

SIDE SEWER PERMIT

OUTSIDE INSIDE REPAIRS

LARRY JONES

CARD No. _____

EASEMENT No. _____

OWNER LARRY JONES

HOUSE No. 23402 50th W.

CONTRACTOR

L. O. FRANKLIN

PERMIT No. 1965


STREET

AVENUE LOT No. 21

BLOCK No. 10

NAME ADD.

DIV. 11

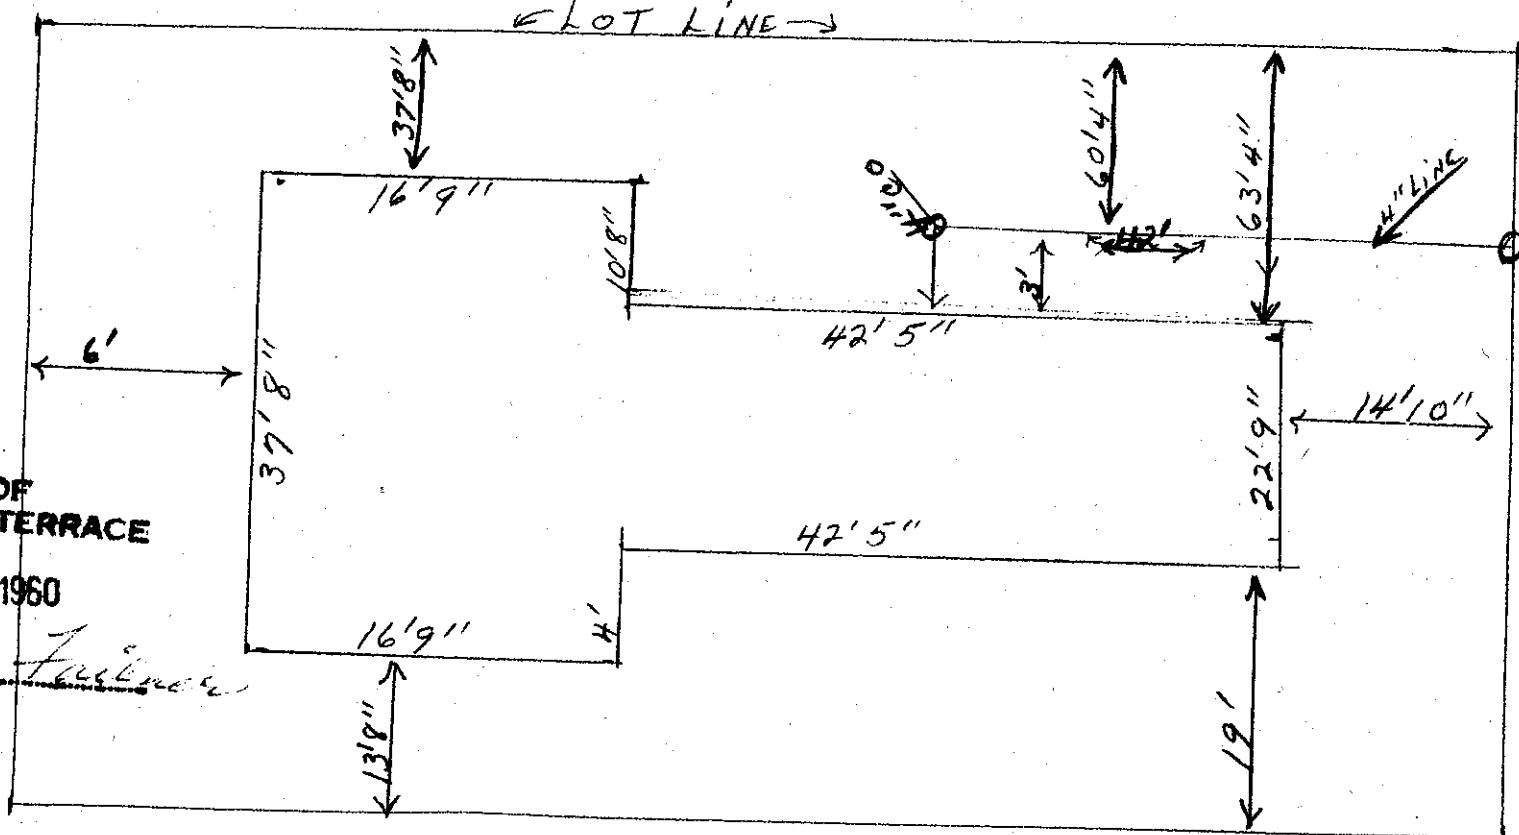

Date

Approved:

BACKFILL WORK ORDER ISSUED
SEWER WORK ORDER ISSUED

DEPOSIT, \$ 10⁰⁰ 3-14-60

816

DATE

3/15/60 BY *J. Franklin*

The City of Mountlake Terrace

APPLICATION

FOR

SIDE SEWER PERMIT

OUTSIDE INSIDE REPAIRS

H. V. UX
CARD No.

EASEMENT No.

OWNER ALBERT V. LUX

HOUSE NO. 23406 - 50th W.

CONTRACTOR

STREET
AVENUE LOT No.


19

PERMIT No. 2164

NAME ADD

BLOCK No. 10

Div. 11

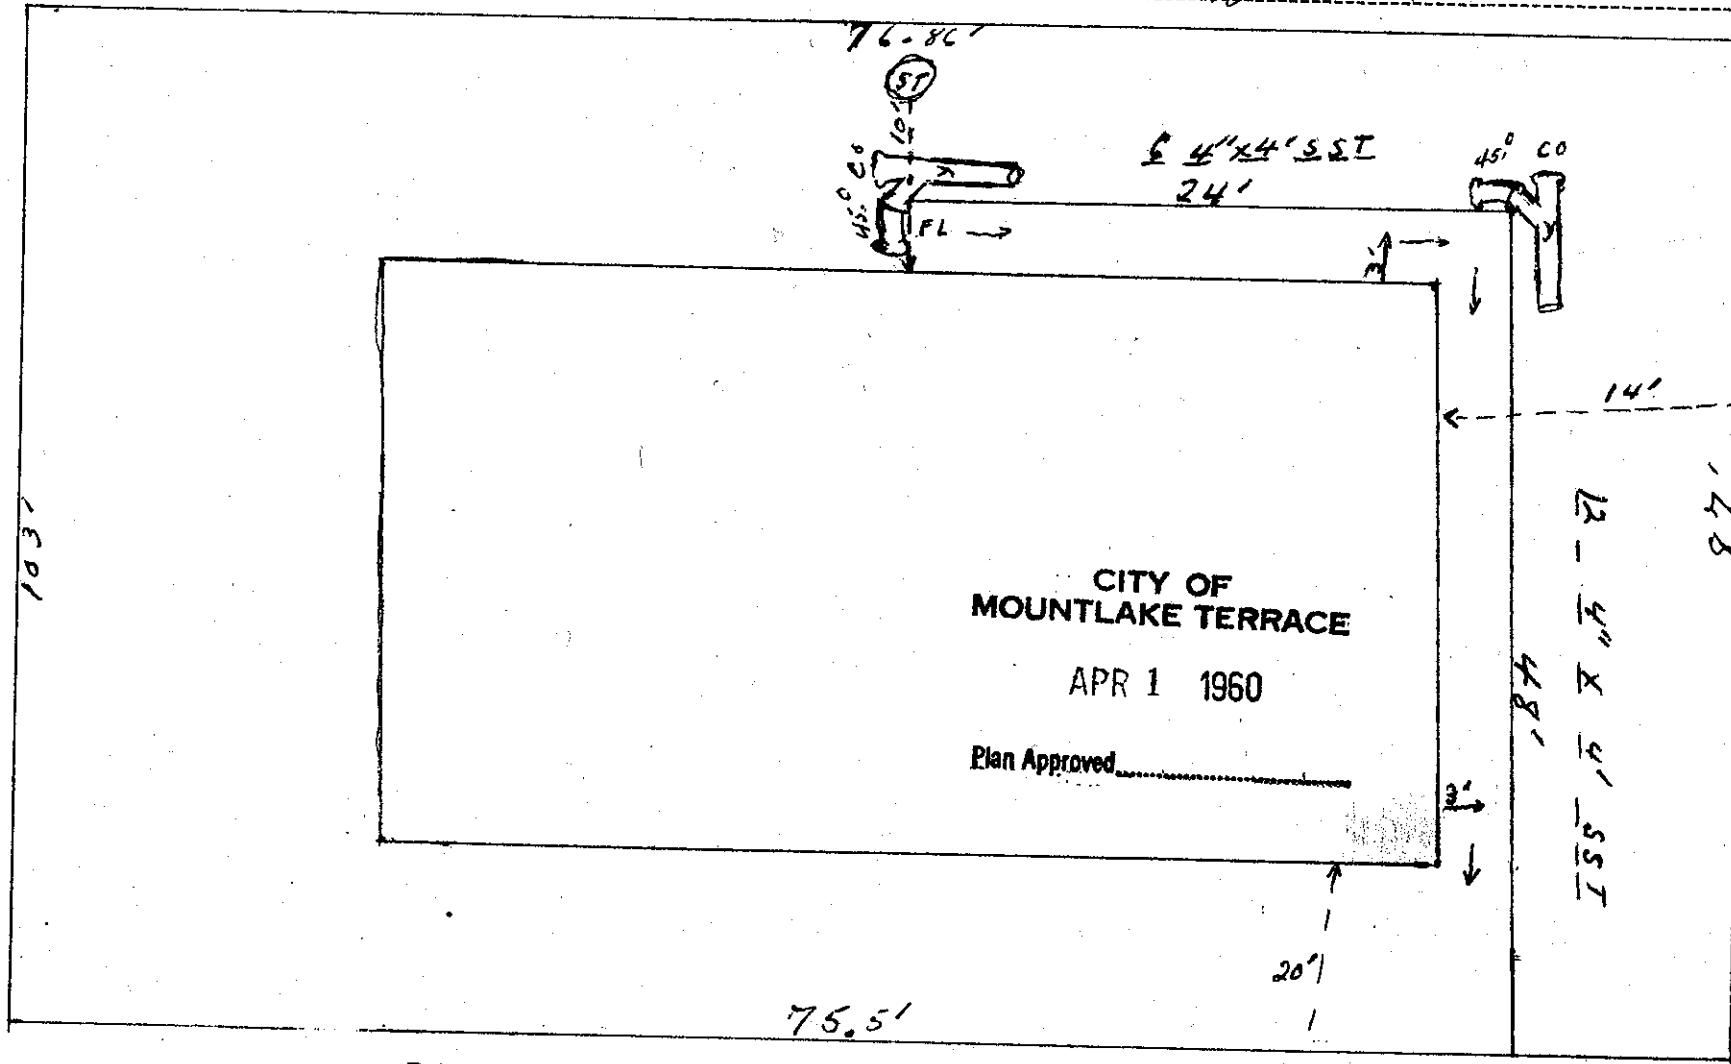

Date

BACKFILL WORK ORDER ISSUED
SEWER WORK ORDER ISSUED

DEPOSIT, \$10.00

98)

Approved:

3/24/60

DATE 4-1-60

BY Scott M. Koltan

The City of Mountlake Terrace

APPLICATION
for

SIDE SEWER PERMIT

OUTSIDE INSIDE REPAIRS

K.L. Henrick
CARD No. _____

EASEMENT No. _____

OWNER ROBERT L. HENRICK

HOUSE No. 23502 - 50 W.

CONTRACTOR


PERMIT No. 117

STREET

AVENUE LOT No. 17

BLOCK No. 10

NAME ADD. DIVISION 11

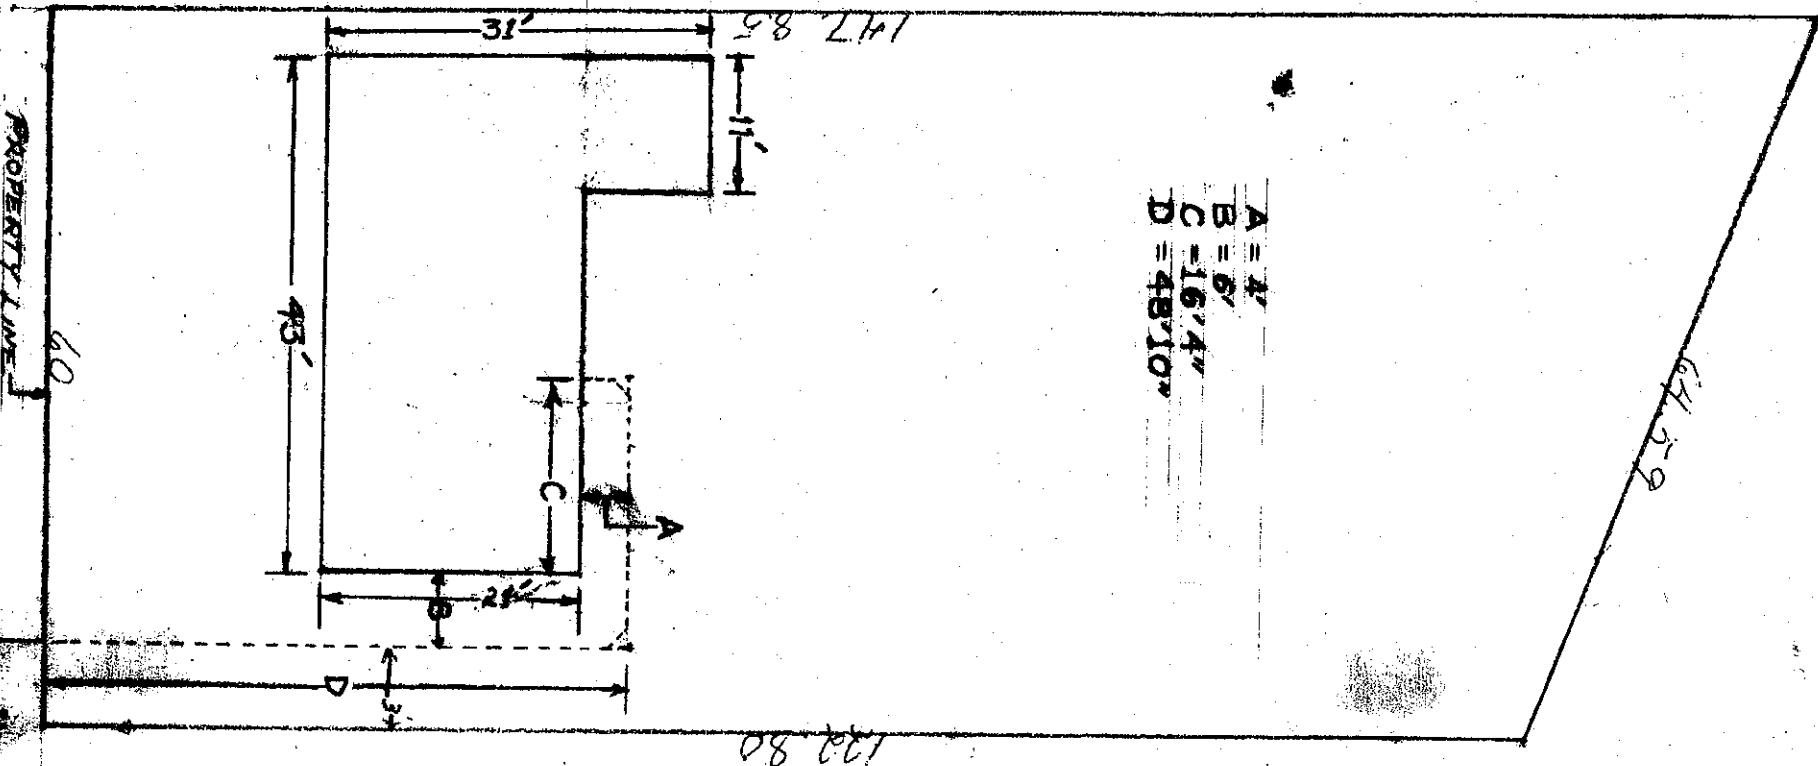

SEWER
TAP OFF

Date

BACKFILL WORK ORDER ISSUED

Approved:
DEPOSIT, \$10.00 5/27/60

SEWER WORK ORDER ISSUED

1549 DATE 6/13/60 BY J. Henrick

The City of Mountlake Terrace

APPLICATION

K. M. Togter
CARD No.

SIDE SEWER PERMIT

OUTSIDE INSIDE REPAIRS

EASEMENT No.

OWNER Keye M. Easter
HOUSE No. 23504 - 52 W.

CONTRACTOR None

PERMIT No. 2653


STREET AVENUE LOT No. 16

BLOCK No. 10

DIV. II

NAME ADD.

Concrete Septic Tank
1/2 Bend Clean out plug

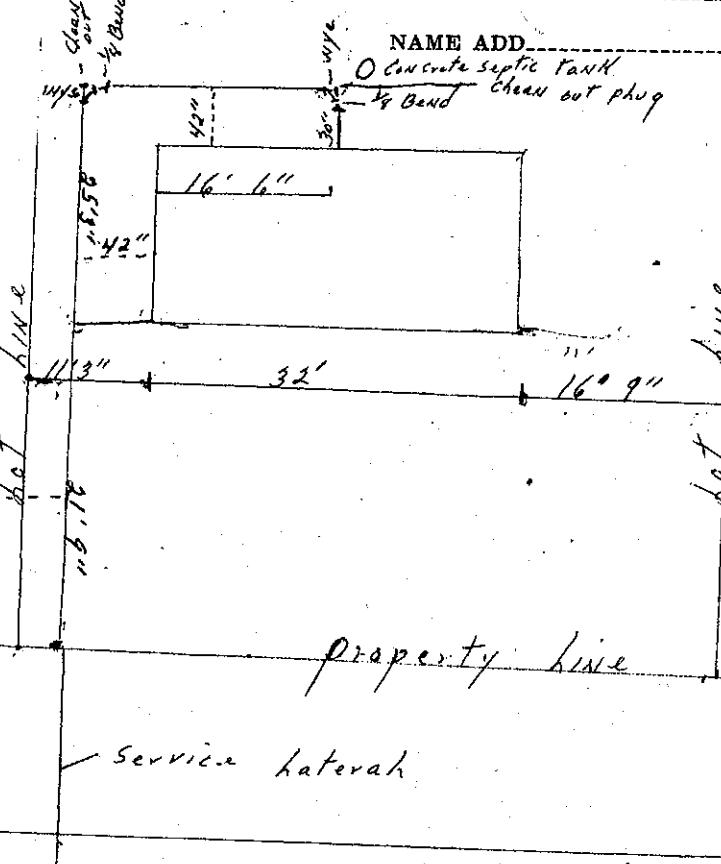

CITY OF
MOUNTLAKE TERRACE

MAY 16 1960

Plan Approved

S. M. Ahern

BACKFILL WORK ORDER ISSUED
SEWER WORK ORDER ISSUED

Date

Approved:

DEPOSIT \$10.00 5/13/60

1436

DATE

5-16-60 BY S. M. Holton INS CON

The City of Mountlake Terrace

APPLICATION

SIDE SEWER PERMIT
OUTSIDE INSIDE REPAIRS

ALBERT LUX
CARD No.

EASEMENT No.

OWNER ALBERT V LUX

HOUSE No. 23506-50thW

CONTRACTOR

Selfe

PERMIT No. 136


STREET

AVENUE

LOT No. 15 Div 11 BLOCK No. 10

NAME ADD.

Albert V Lux 23406-50thW

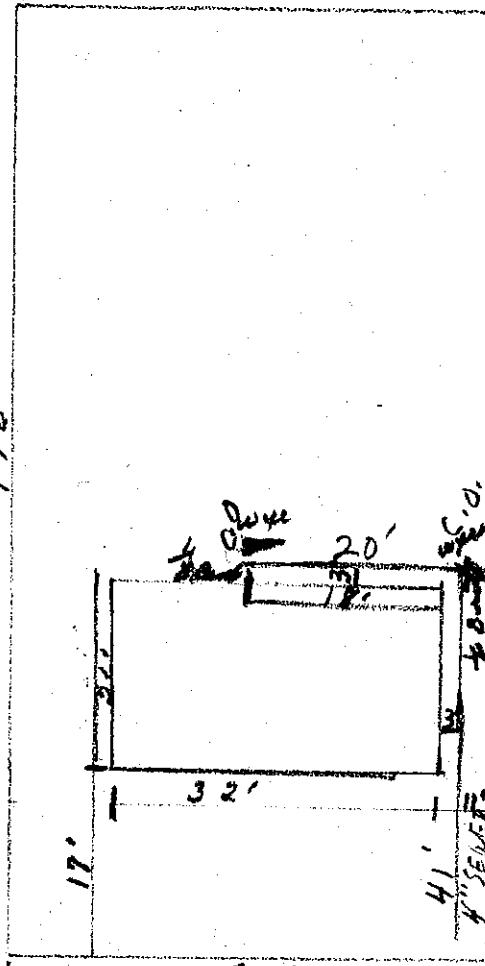

Date

Approved:

BACKFILL WORK ORDER ISSUED

SEWER WORK ORDER ISSUED

DEPOSIT, \$ 10.00

5-31-60

1570

DATE 7-11-60 BY S. M. Holton INST+CO

The City of Mountlake Terrace

APPLICATION

CARD No.

SIDE SEWER PERMIT

OUTSIDE INSIDE REPAIRS

EASEMENT No.

OWNER IVER GILBERT

HOUSE No. 22507-51st-

CONTRACTOR SAME


PERMIT No. 3941

STREET
AVENUE LOT No. 9

BLOCK No.

NAME ADD. VALLEY CREST

51st. Cul De Sac

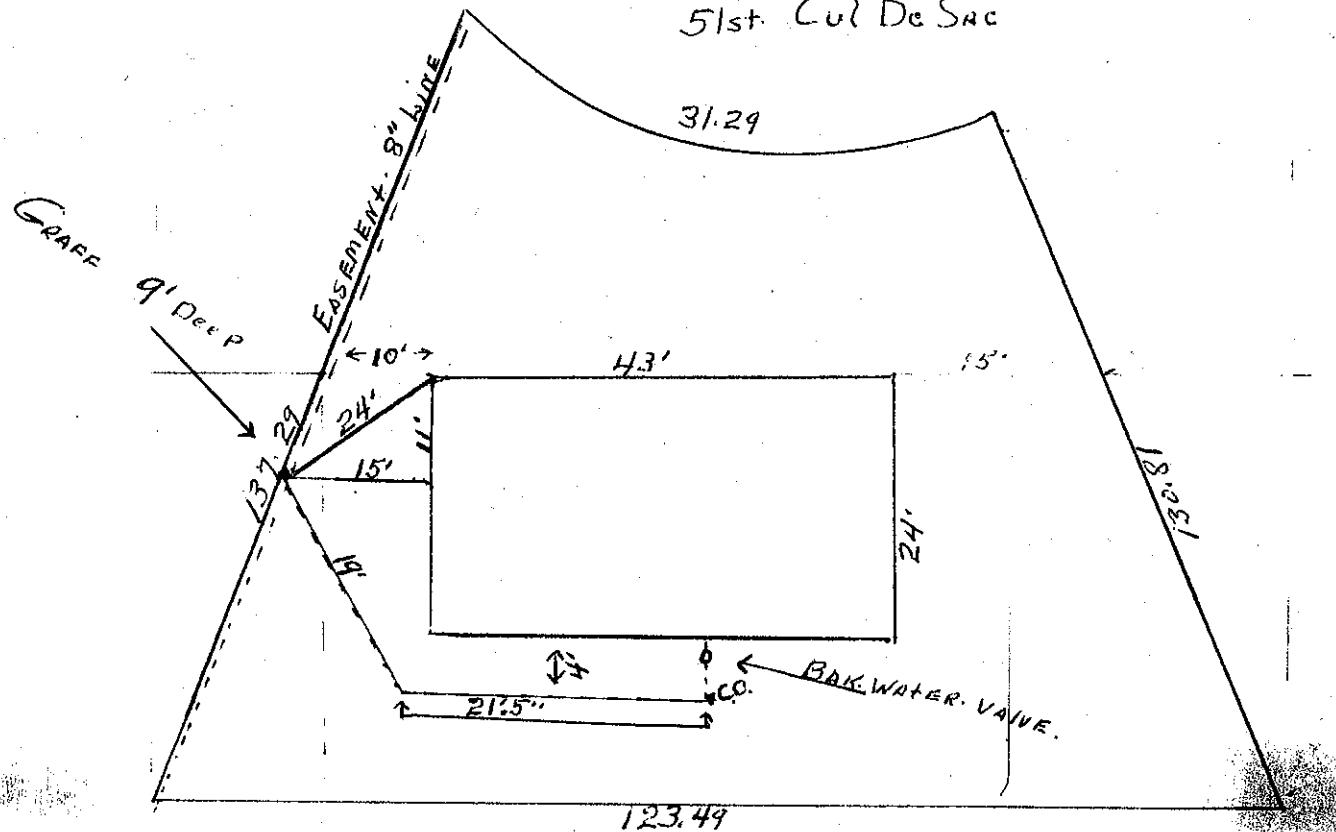

Building Permit # 3594

CITY OF
MOUNTLAKE TERRACE

Date

Approved:

MAY 21 1965

BACKFILL WORK ORDER ISSUED

DEPOSIT, \$

SEWER WORK ORDER ISSUED

DATE

BY Plan Approved

George Baker

The Cliff Mountlake Terrace

APPLICATION
FOR

SIDE SEWER PERMIT

OUTSIDE INSIDE REPAIRS

CARD NO.

EASEMENT No. None

OWNER Nancy Hawley

HOUSE 21701

51ST W.

CONTRACTOR Wingfield - Brown

PERMIT NO. 978


STREET
AVENUE LOT NO.

18

BLOCK NO.

20

NAME ADD

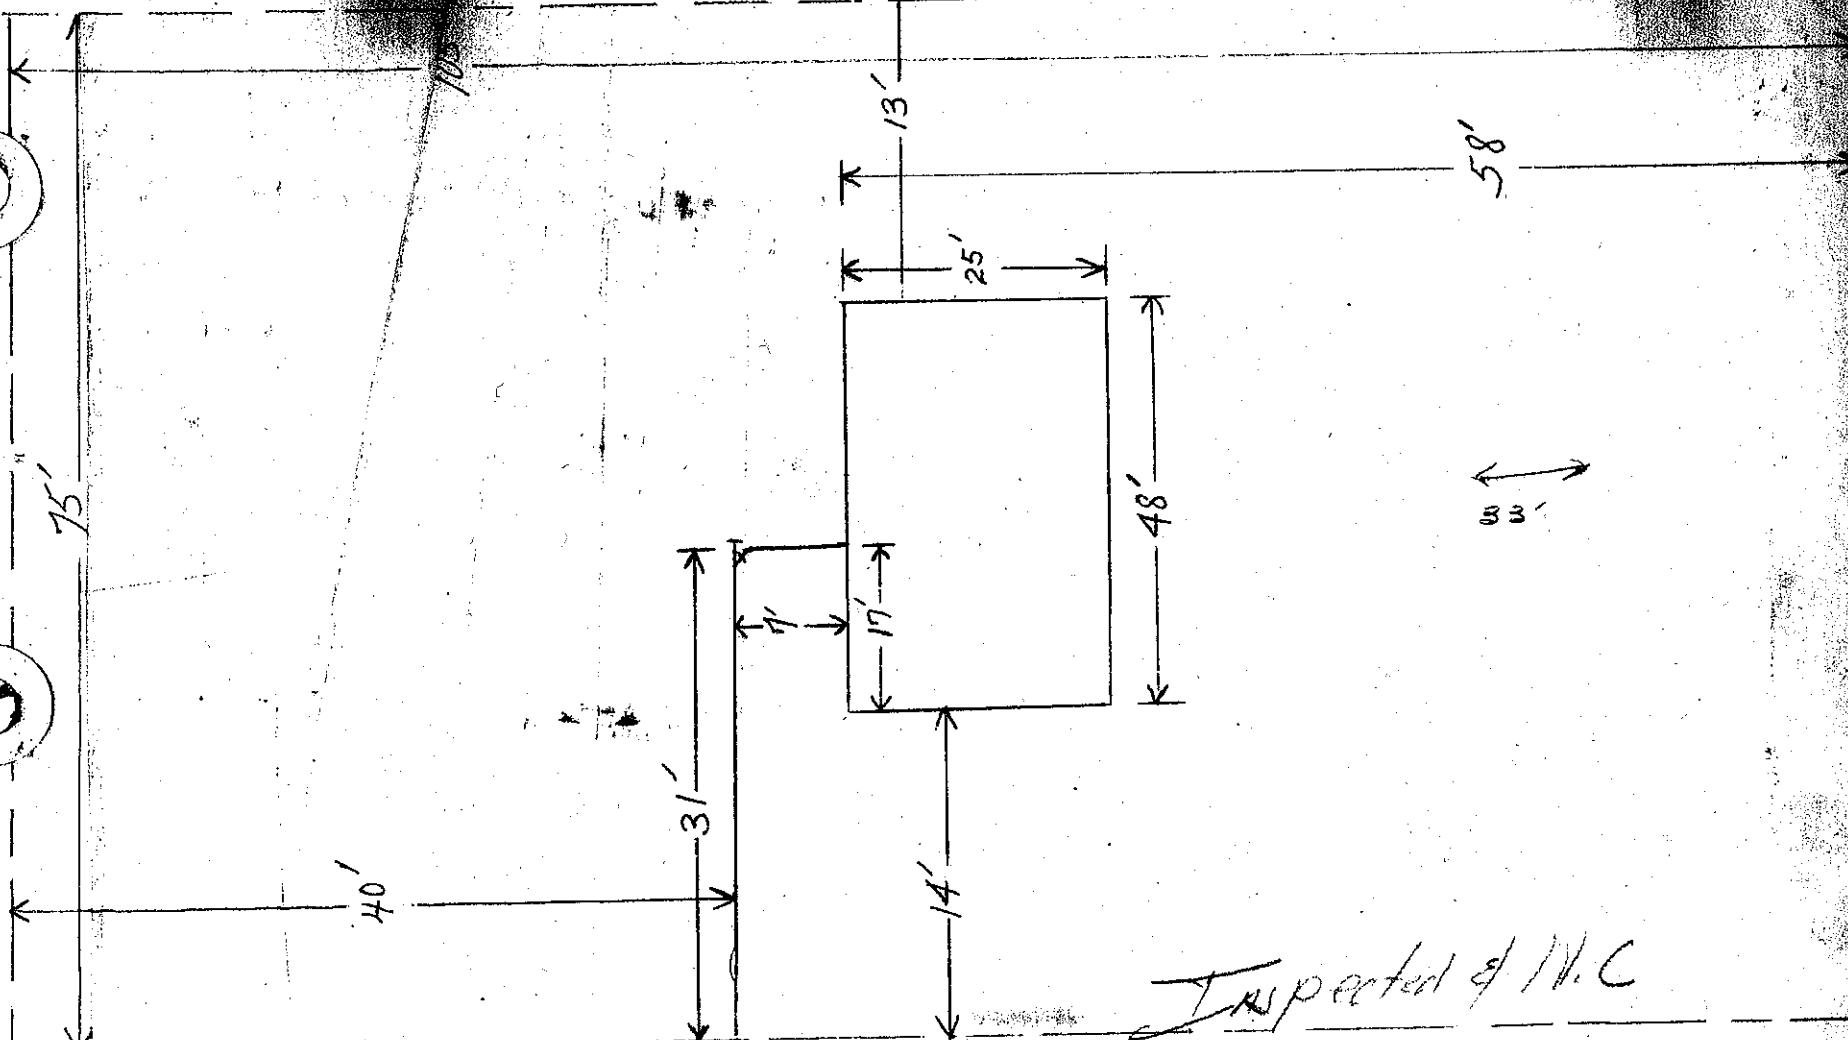

Date

Approved:

BACKFILL WORK ORDER ISSUED

DEPOSIT \$

18.00

Rec 5164

10/13/59

DATE

BY

SEWER WORK ORDER ISSUED

1001-101-1111

3-7-18 INST CON & MAINT

B. R. Plaut

The City of Mountlake Terrace

APPLICATION

FOR

SIDE SEWER PERMIT

OUTSIDE INSIDE REPAIRS

B.E. Duncan, Jr.

CARD No. _____

EASEMENT No. _____

OWNER

BURTON E. DUNCAN, JR.

CONTRACTOR

HOUSE No. 21703 - 51 W

STREET


AVENUE LOT No. 17

PERMIT No. 2382

BLOCK No. _____

NAME ADD.

DIV. 20

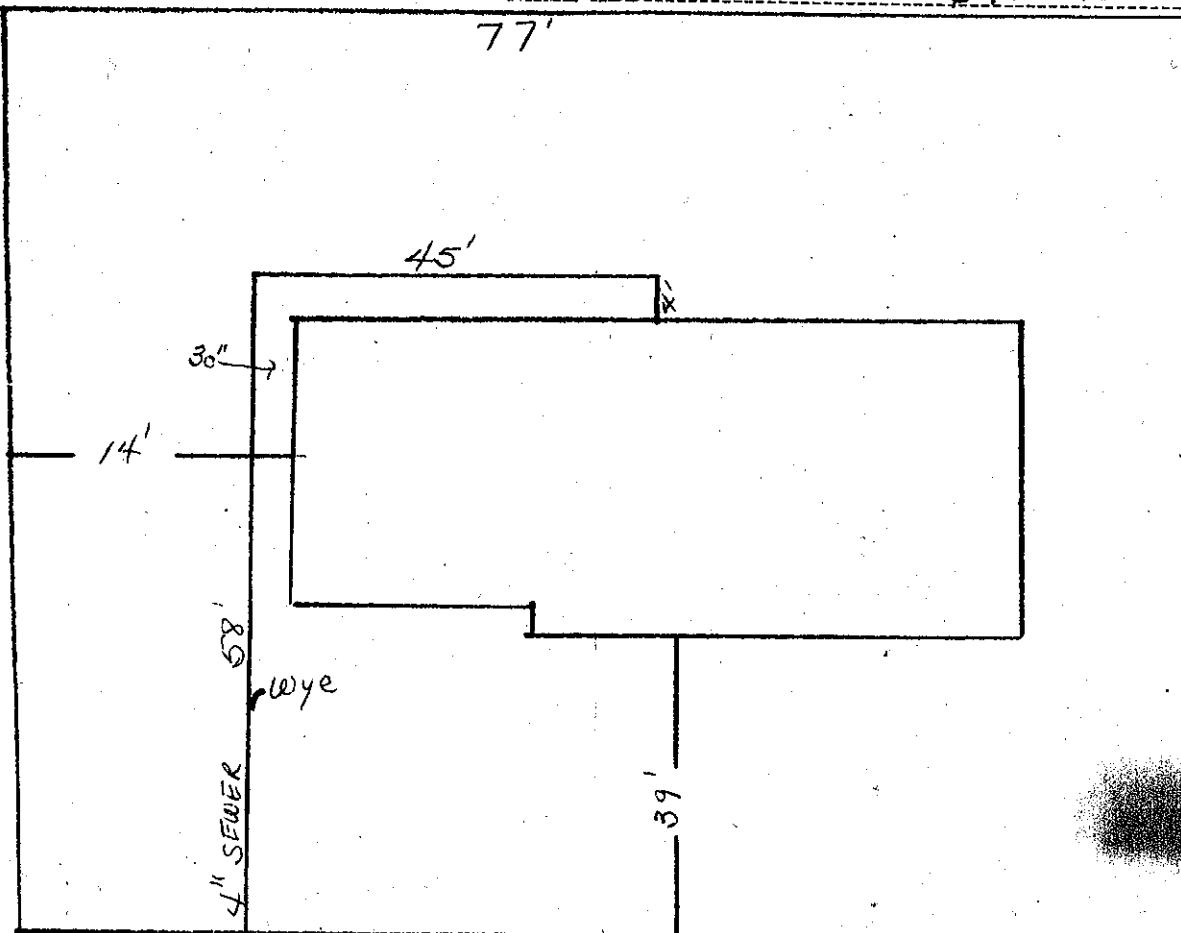

CITY OF
MOUNTLAKE TERRACE

APR 13 1960

Plan Approved

Dr Failear

Date

Approved:

BACKFILL WORK ORDER ISSUED

DEPOSIT, \$10.00 4/1/60

SEWER WORK ORDER ISSUED

1164

DATE

4/13/60

BY

Dr Failear

The City of Mountlake Terrace

APPLICATION

R. J. McWAN

CARD No.

SIDE SEWER PERMIT

OUTSIDE INSIDE REPAIRS

EASEMENT No.

OWNER *Robert J. McEwan*
HOUSE No. 21705 5th st W.


CONTRACTOR *self*

PERMIT No. 2288

STREET
AVENUE LOT No. 16

BLOCK No.

NAME ADD *Div 30*

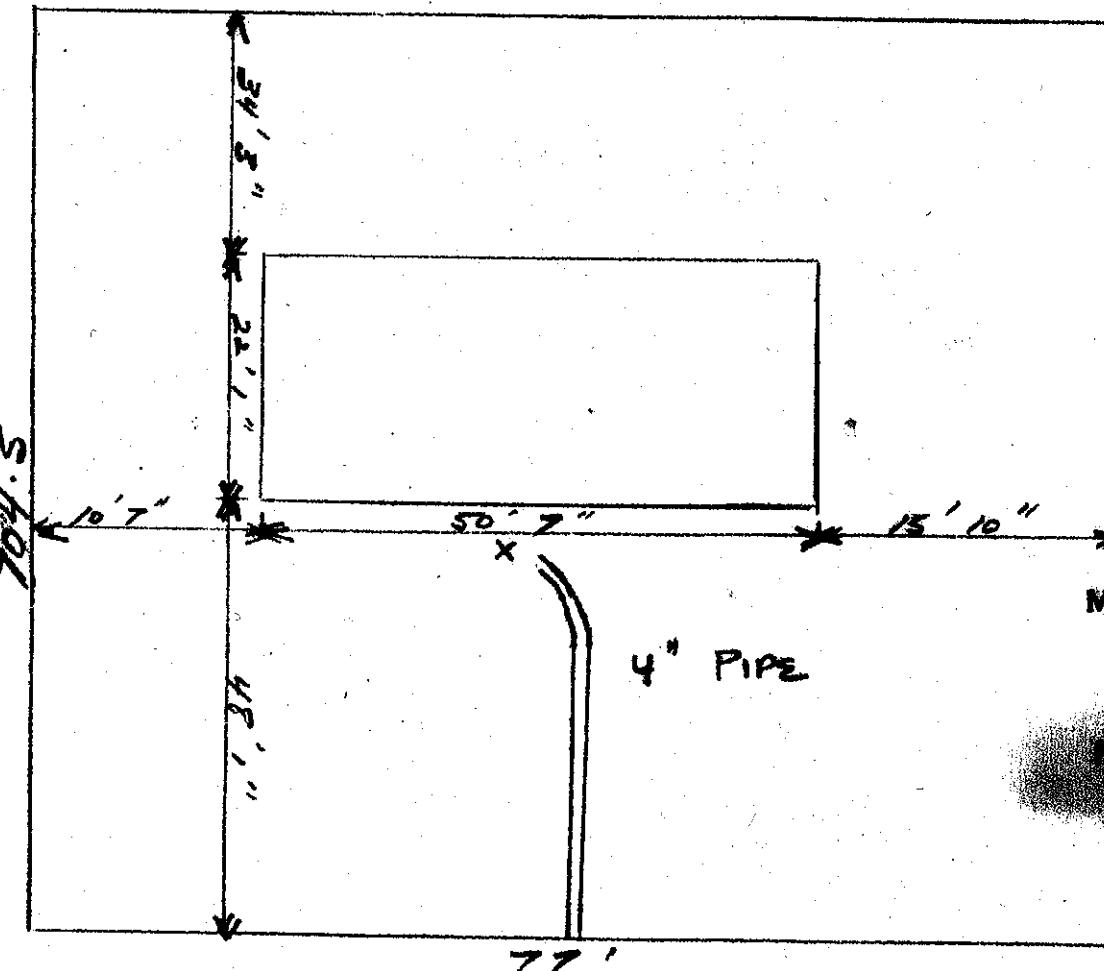

CITY OF
MOUNTLAKE TERRACE

APR 5 1960

Approved.....

Date

Approved:

BACKFILL WORK ORDER ISSUED
SEWER WORK ORDER ISSUED

DEPOSIT, \$ 10.00

10.00

rec.#1171

DATE 4/6/60

BY

Reeni Freeman

J. Eller

The City of Mountlake Terrace

APPLICATION
for

SIDE SEWER PERMIT

OUTSIDE INSIDE REPAIRS

O. H. KINNUEN

CARD No.

EASEMENT No.

OWNER ORVILLE H. & IRENE L. KINNUEN
HOUSE No. 21706 - 51st AVE. W.

CONTRACTOR

STREET
AVENUE LOT No.


PERMIT No. 2404

21

NAME ADD.

DIV. 20

BLOCK No.

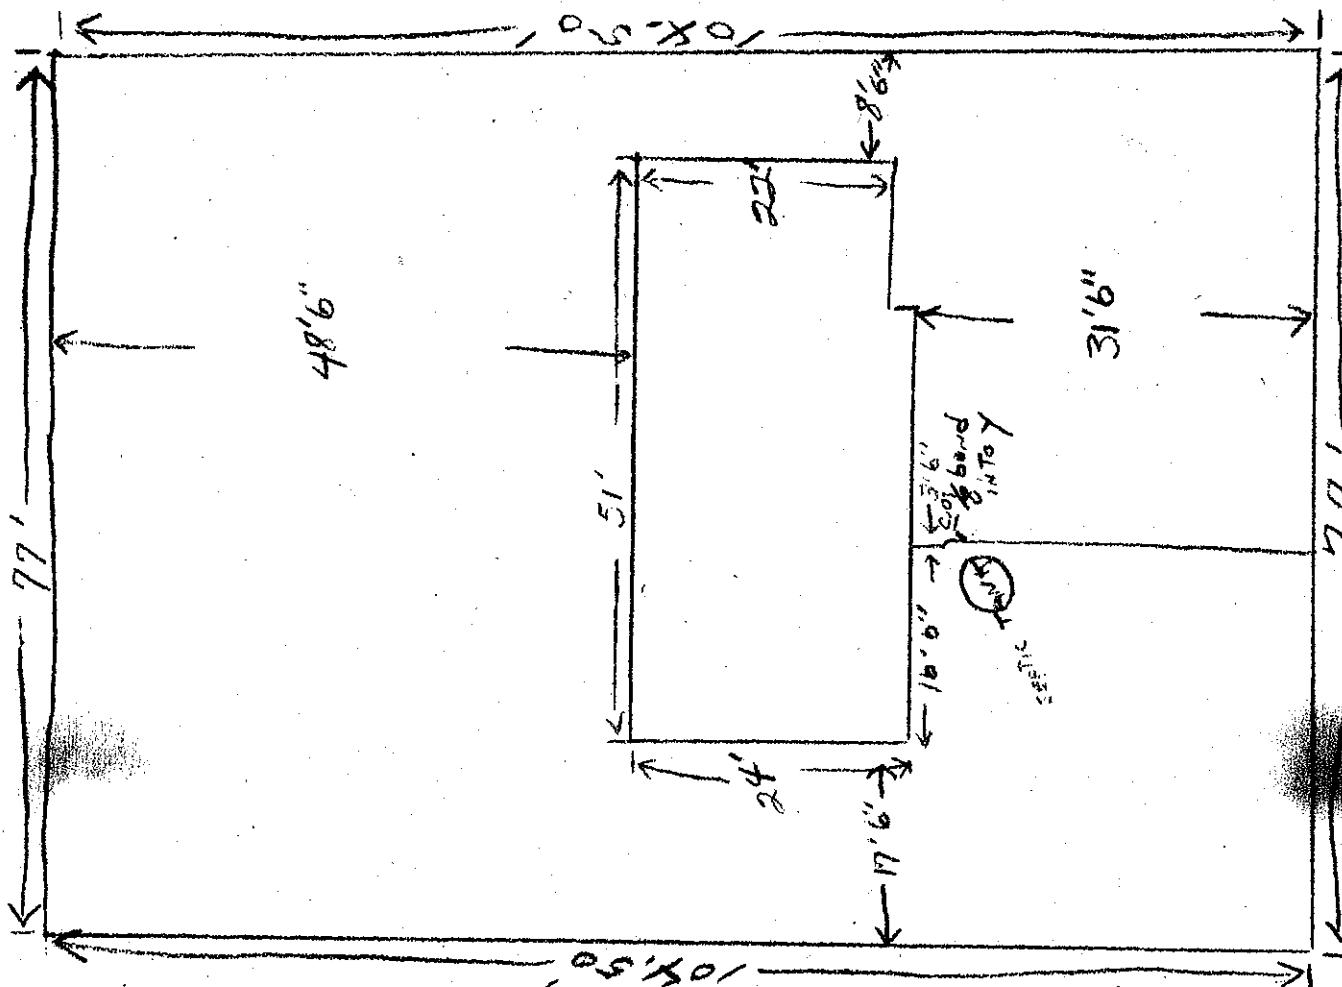

Date

BACKFILL WORK ORDER ISSUED
SEWER WORK ORDER ISSUED

DEPOSIT, \$10.00

Approved:

4/4/60
1192

DATE

4-22-60 BY J. M. Holton INST COV

The City of Mountlake Terrace

APPLICATION

CARD No.....

SIDE SEWER PERMIT

OUTSIDE INSIDE REPAIRS

EASEMENT No.....

OWNER Geo Fisher Reality

HOUSE No. 21707 - 51 W

CONTRACTOR

STREET


AVENUE LOT No. 15

387

PERMIT No.

BLOCK No.

NAME ADD. Mountlake Terrace Division No. 20

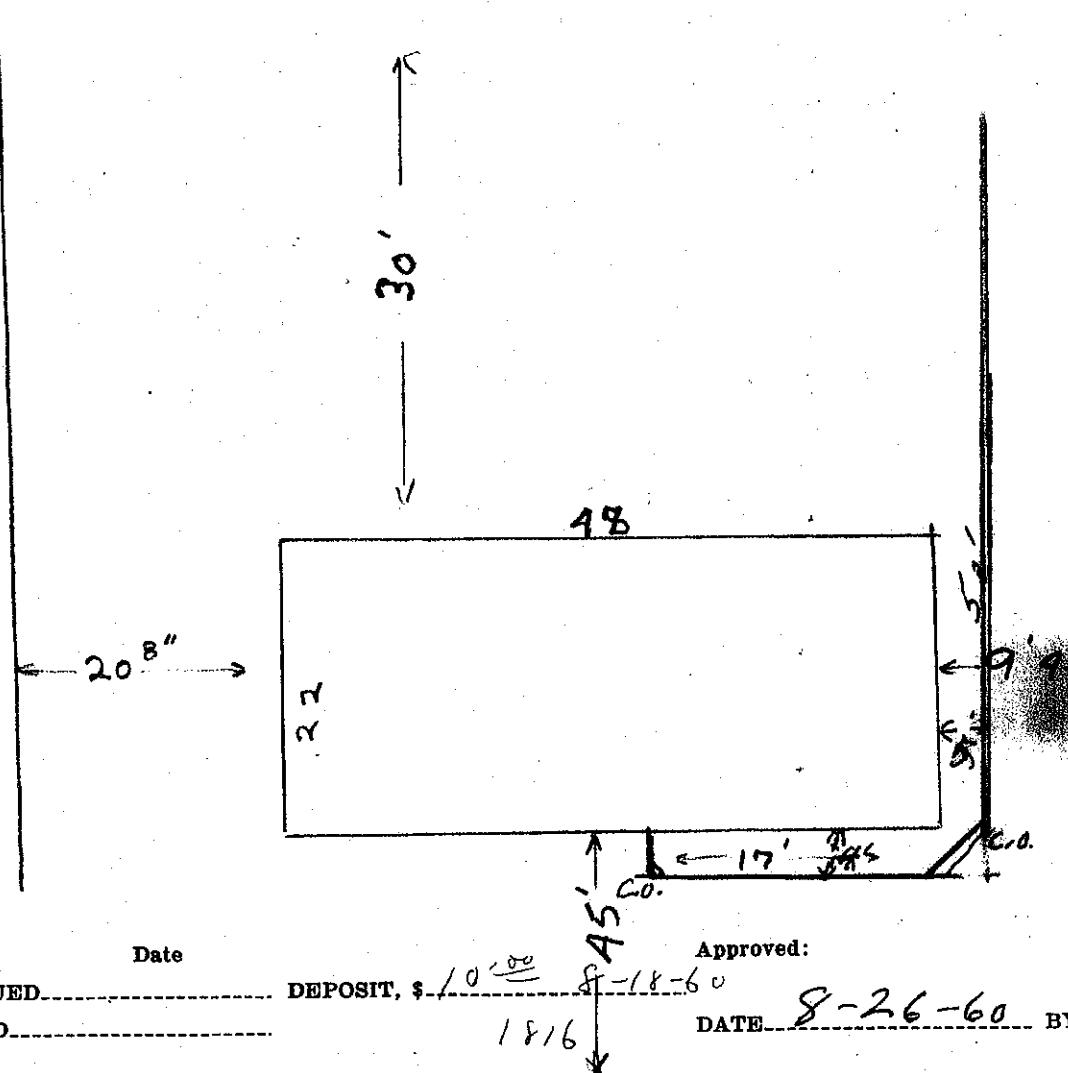

Date

BACKFILL WORK ORDER ISSUED.....

SEWER WORK ORDER ISSUED.....

DEPOSIT, \$10⁰⁰

8-18-60

1816

Approved:

DATE

8-26-60 BY

S. M. Holton IN STC

The City of Mountlake Terrace

APPLICANT ON

for

SIDE SEWER PERMIT

OUTSIDE INSIDE REPAIRS

CARD No.....

EASEMENT No.....

OWNER E. E. NANCE

HOUSE No. 21709

51st w

CONTRACTOR

Self

PERMIT NO. 401

STREET


AVENUE LOT NO.

14

BLOCK NO.

NAME ADD.

20

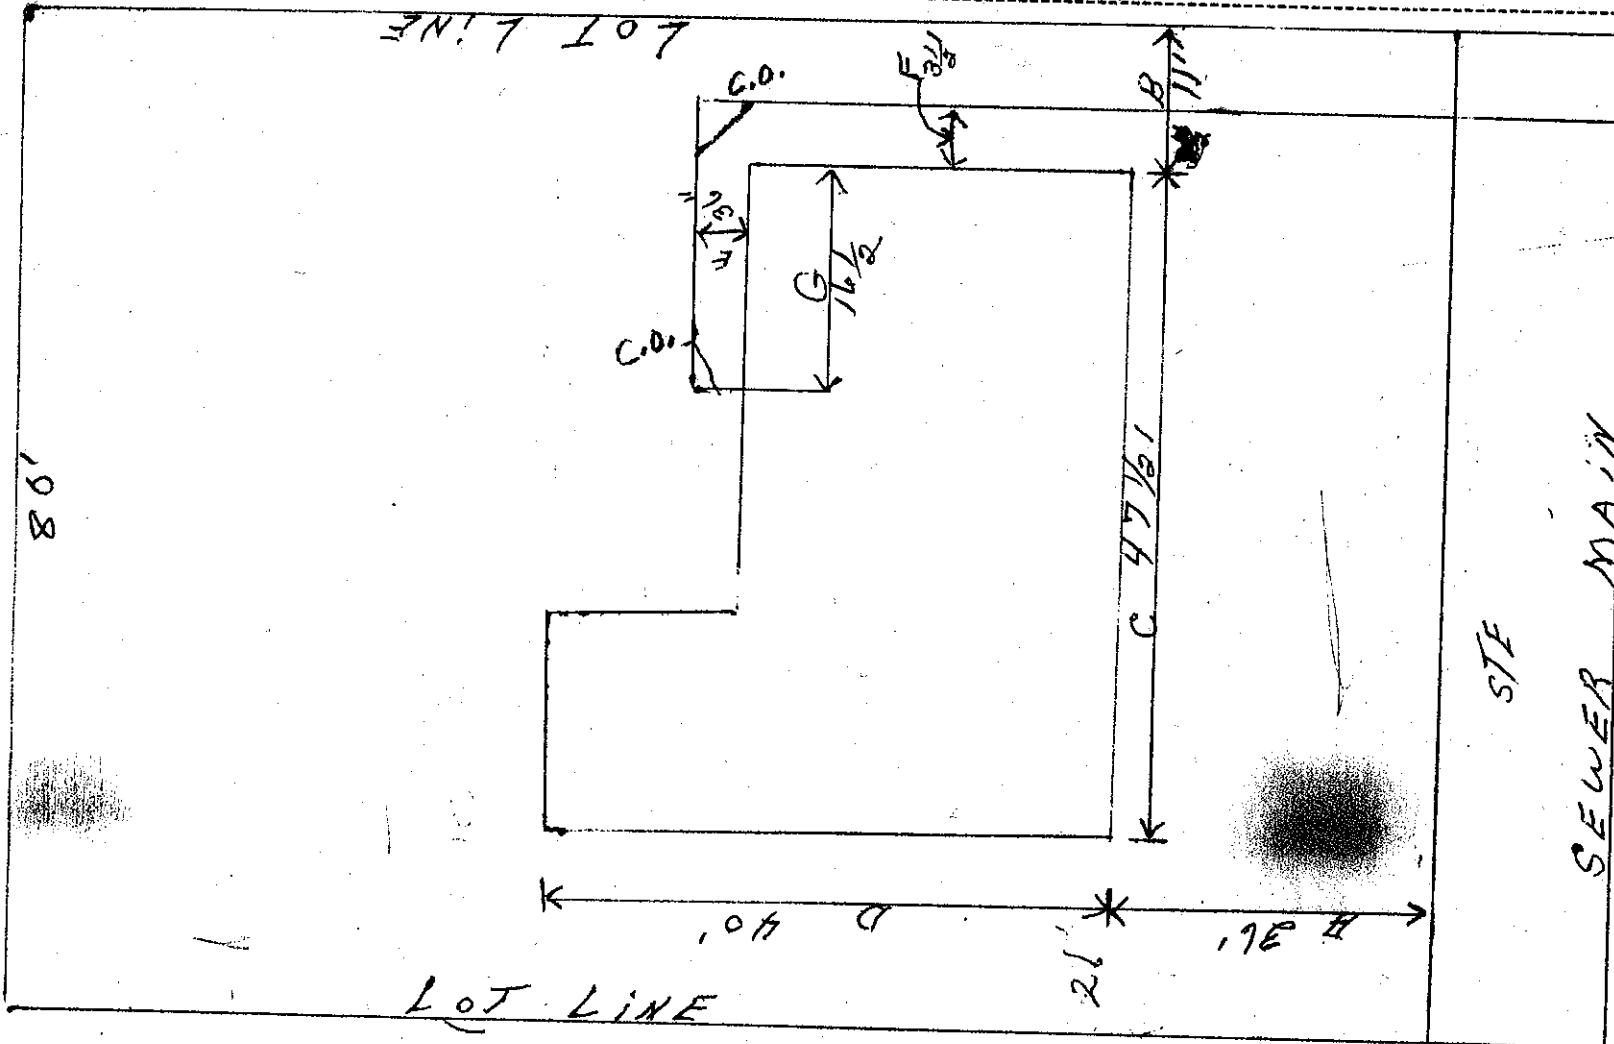

Date

BACKFILL WORK ORDER ISSUED
SEWER WORK ORDER ISSUED

DEPOSIT, \$10.00

Approved:

8/26/60

#1834

DATE 10-18-60

SM

BY J. M. Holton INS+CO

The City of Mountlake Terrace

APPLICATION

for

SIDE SEWER PERMIT

OUTSIDE INSIDE REPAIRS

CARD No.

EASEMENT No.

OWNER K. B. Chambers
HOUSE No. 217 10 - 51 West.
MA SAmo

CONTRACTOR

STREET

AVENUE LOT No.


NAME ADD.

PERMIT NO. 389

2 3

BLOCK No.

Div #20

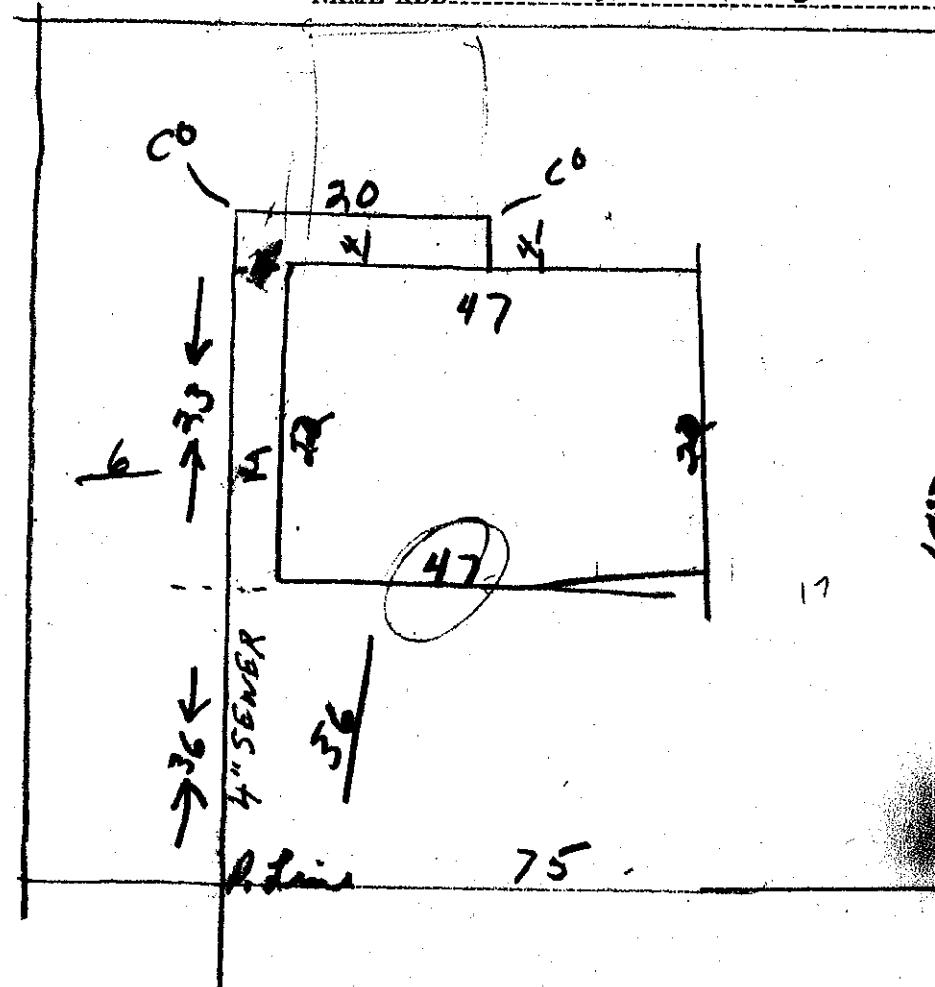

51 at 126 ft to m. h.

Date

Approved:

BACKFILL WORK ORDER ISSUED

SEWER WORK ORDER ISSUED

DEPOSIT: \$ 10.00

8/19/60
#1833

DATE 8-23-60

BY

Sam Holton INST CON

The City of Mountlake Terrace

APPLICATION

CARD No. 10

SIDE SEWER PERMIT

OUTSIDE INSIDE REPAIRS

EASEMENT No. None

OWNER

Morrison

HOUSE No. 21802 - 51ST W.

CONTRACTOR

Wingfield

PERMIT No.

562

STREET


AVENUE LOT No.

24

BLOCK No.

NAME ADD.

Dix #20

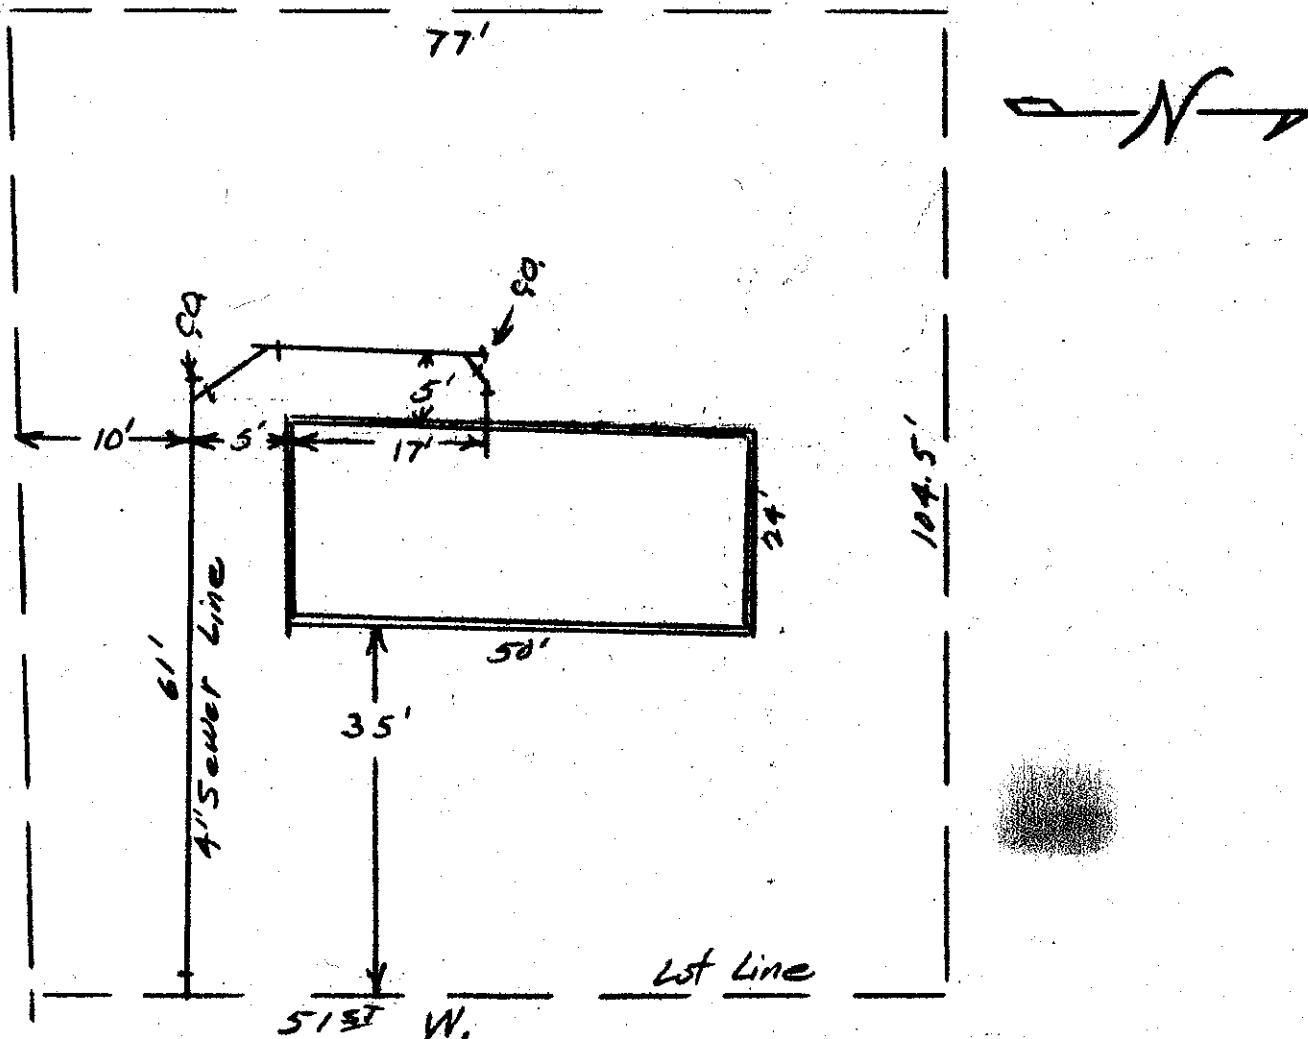

Date

Approved:

BACKFILL WORK ORDER ISSUED

DEPOSIT, \$

SEWER WORK ORDER ISSUED

DATE 11-11-60

BY S. M. Holton

The City of Mountlake Terrace

APPLICATION

JOHN DERN

CARD No.

SIDE SEWER PERMIT

OUTSIDE INSIDE REPAIRS


EASEMENT No.

OWNER John Dern
HOUSE No. 22202 51 w

CONTRACTOR Rainier Const. PERMIT No. 2266

STREET AVENUE LOT No. 1 BLOCK No.

NAME ADD. add. 21

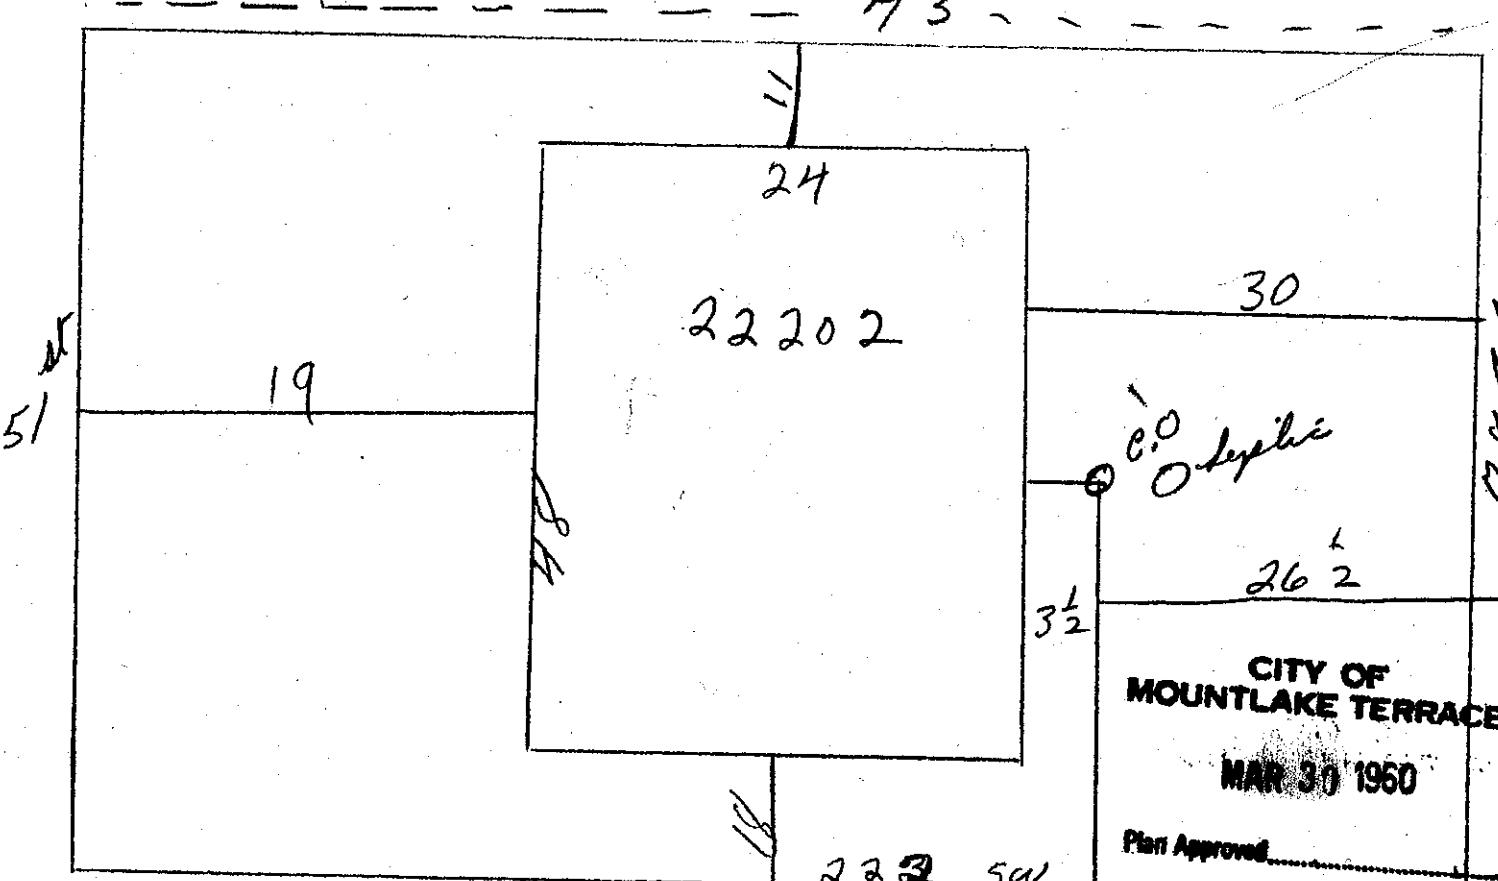

Date

DEPOSIT, \$10.00 3/29/60 Approved:

BACKFILL WORK ORDER ISSUED

SEWER WORK ORDER ISSUED

1065

DATE 3-30-60 BY Scott M Holton/MS/CON

The City of Mountlake Terrace

APPLICATION

SIDE SEWER PERMIT

OUTSIDE INSIDE REPAIRS

HON CARD No.

EASEMENT No. 1358654

OWNER Don E. Bushler
HOUSE No. 22203 - 51st

CONTRACTOR Sdt


PERMIT NO. 2496

STREET AVENUE LOT No. 30

BLOCK No.

NAME ADD.

DIV. 21

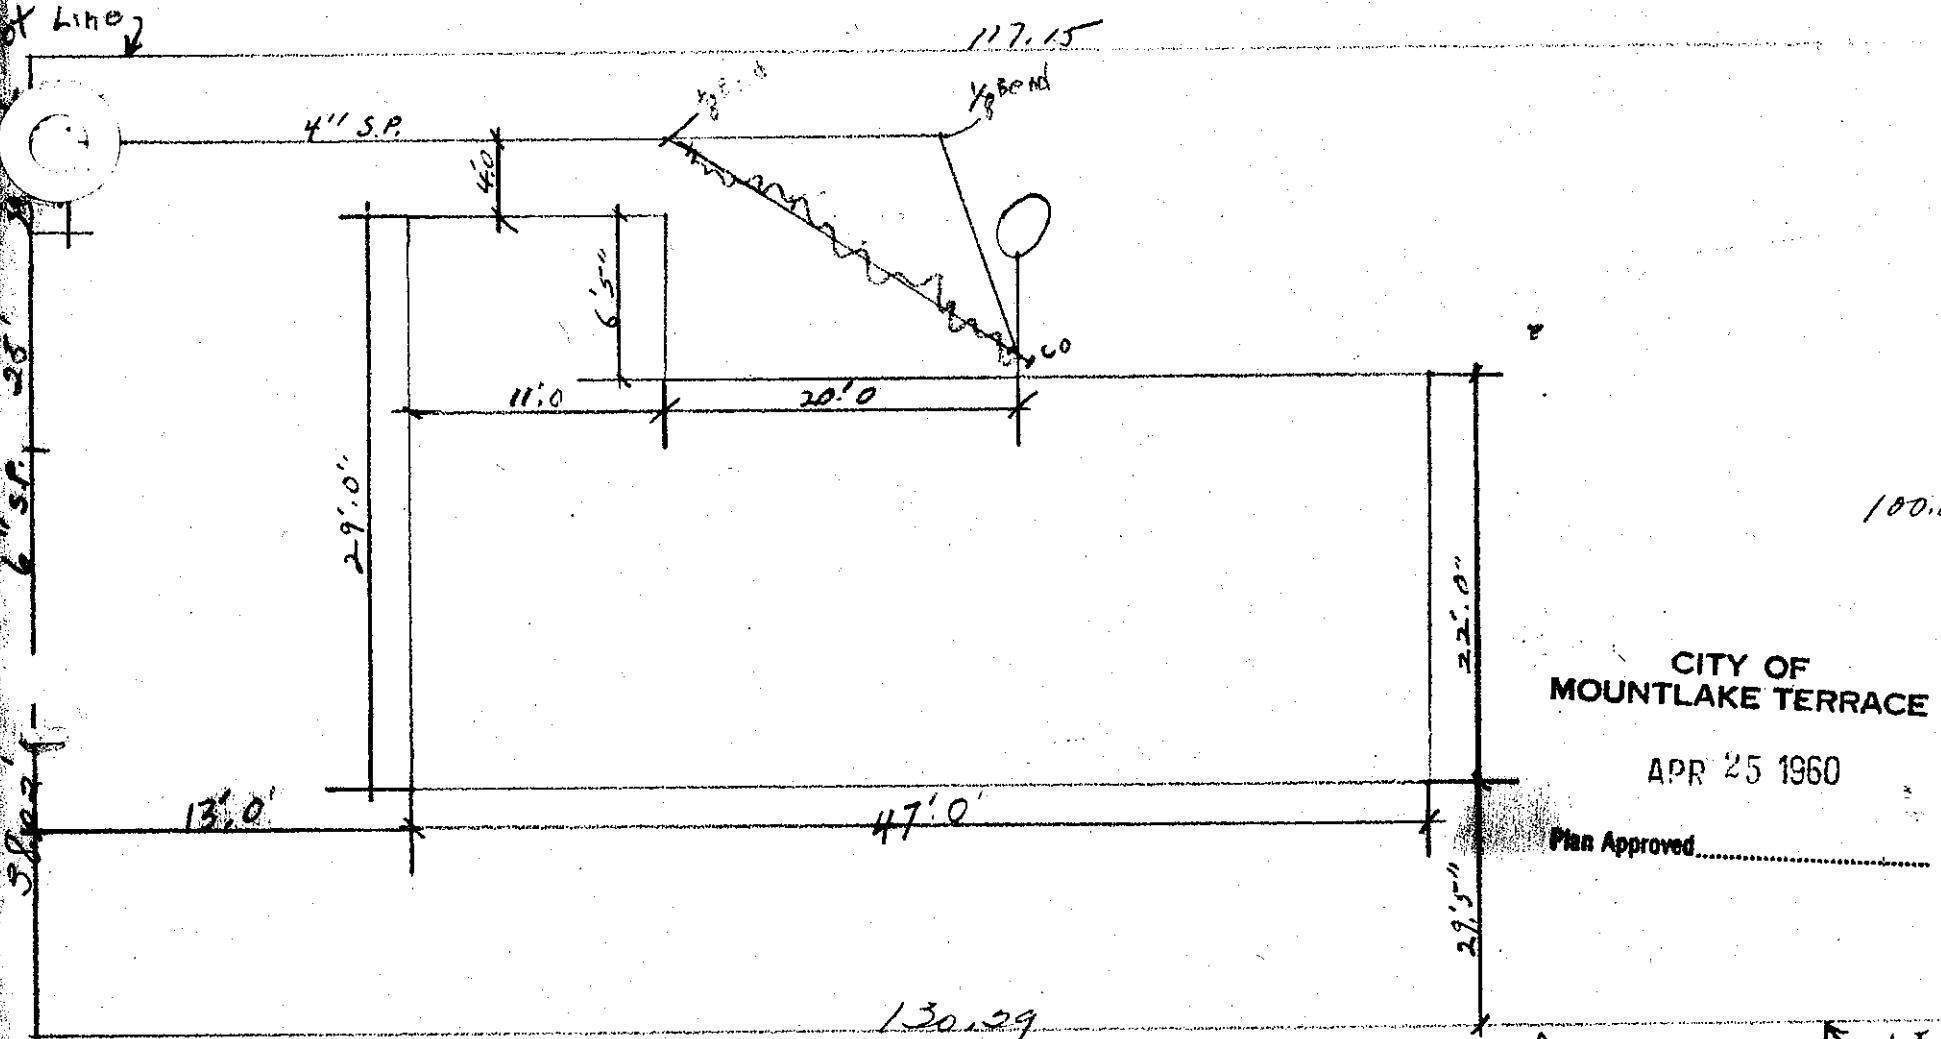

Date

Approved:

BACKFILL WORK ORDER ISSUED

DEPOSIT, \$ 10.00

SEWER WORK ORDER ISSUED

DATE 6/9/60 BY J. Schaefer

rec #1283
Beem Thomas

The City of Mountlake Terrace

APPLICATION

CARD No. 0

SIDE SEWER PERMIT

OUTSIDE INSIDE REPAIRS

EASEMENT No. None

OWNER Bernice Christensen

HOUSE No. 22205 - 51st W.

CONTRACTOR Wingfield


STREET
AVENUE LOT No. 31

PERMIT No. 568

BLOCK No.

NAME ADD.

DIV. #21

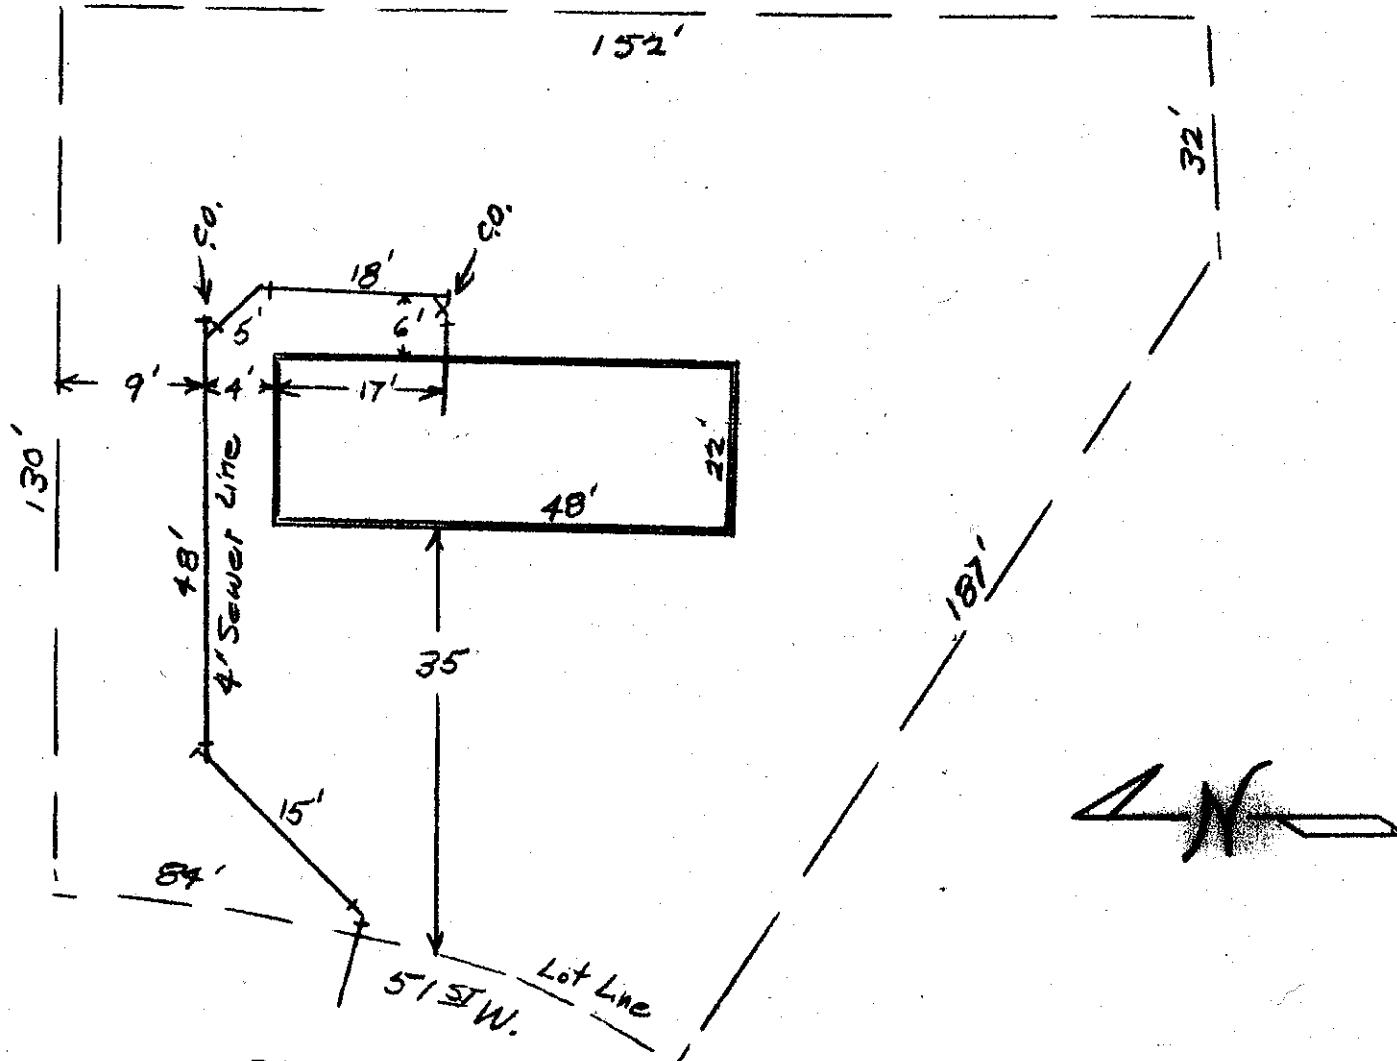

Date

Approved:

BACKFILL WORK ORDER ISSUED

DEPOSIT, \$10.00

11/16/60

SEWER WORK ORDER ISSUED

2023 DATE 11/17/60

BY Arthur E. Knutson

APPLICATION

CARD No.

The City of Mountlake Terrace

SIDE SEWER PERMIT

OUTSIDE INSIDE REPAIRS

EASEMENT No.

OWNER DAN CRISP

HOUSE No. 22206 51. W.

CONTRACTOR WINGFIELD CONST. CO.

PERMIT No.


STREET

AVENUE LOT No. 27

BLOCK NO. DIV. No. 21

NAME ADD. MOUNT-LAKE TERRACE

106.78

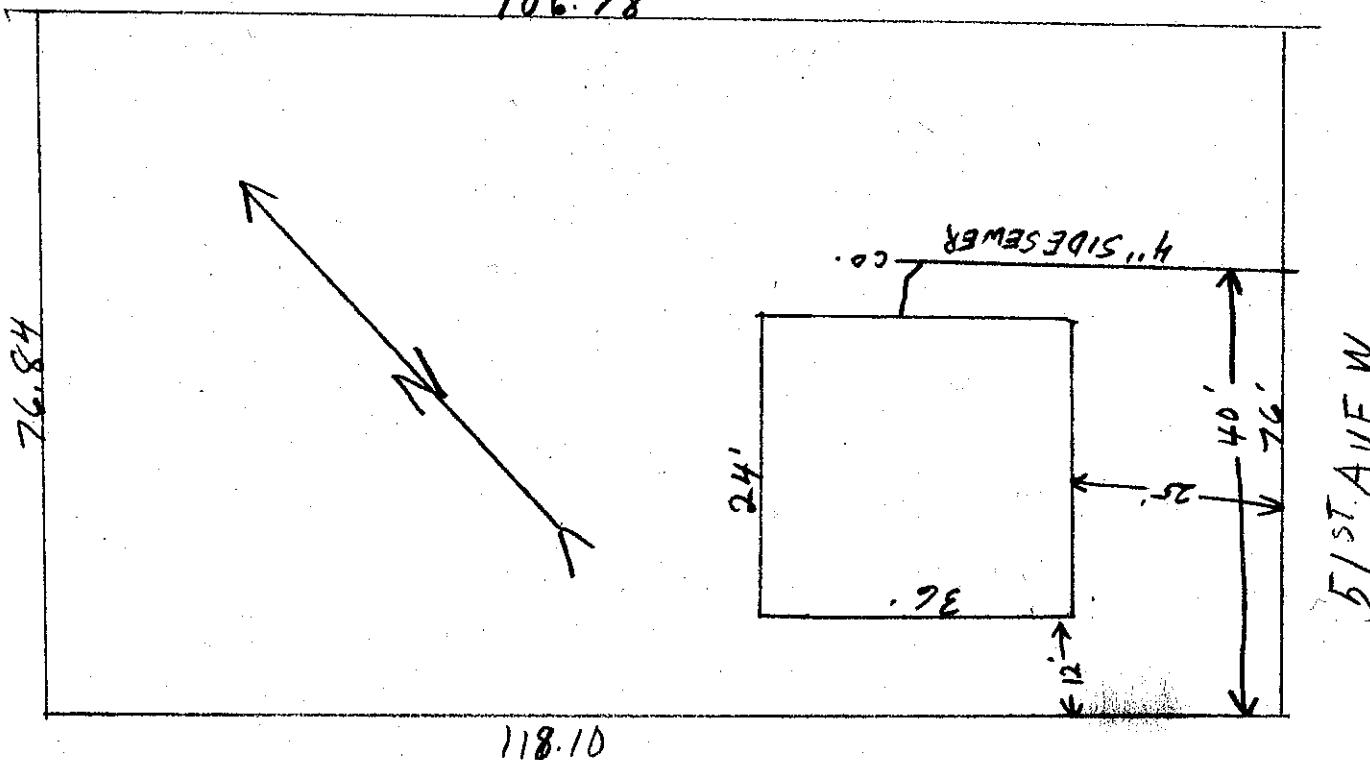CITY OF
MOUNTLAKE TERRACE

AUG 85 1963

Date

Approved:

BACKFILL WORK ORDER ISSUED

DEPOSIT, \$

SEWER WORK ORDER ISSUED

DATE 8/28/63

Plan Approved

BY George R. Walker

The City of Mountlake Terrace

APPLIC ON

for

SIDE SEWER PERMIT

OUTSIDE INSIDE REPAIRS

CARD No.

DOL JR

EASEMENT No.

1344293 ✓

OWNER

DOWCR

HOUSE No.

22302 S/W.

CONTRACTOR

EVERGREEN CONST. PERMIT NO. 1318

STREET


AVENUE LOT NO.

19

BLOCK No.

NAME ADD

MLT. Div #21

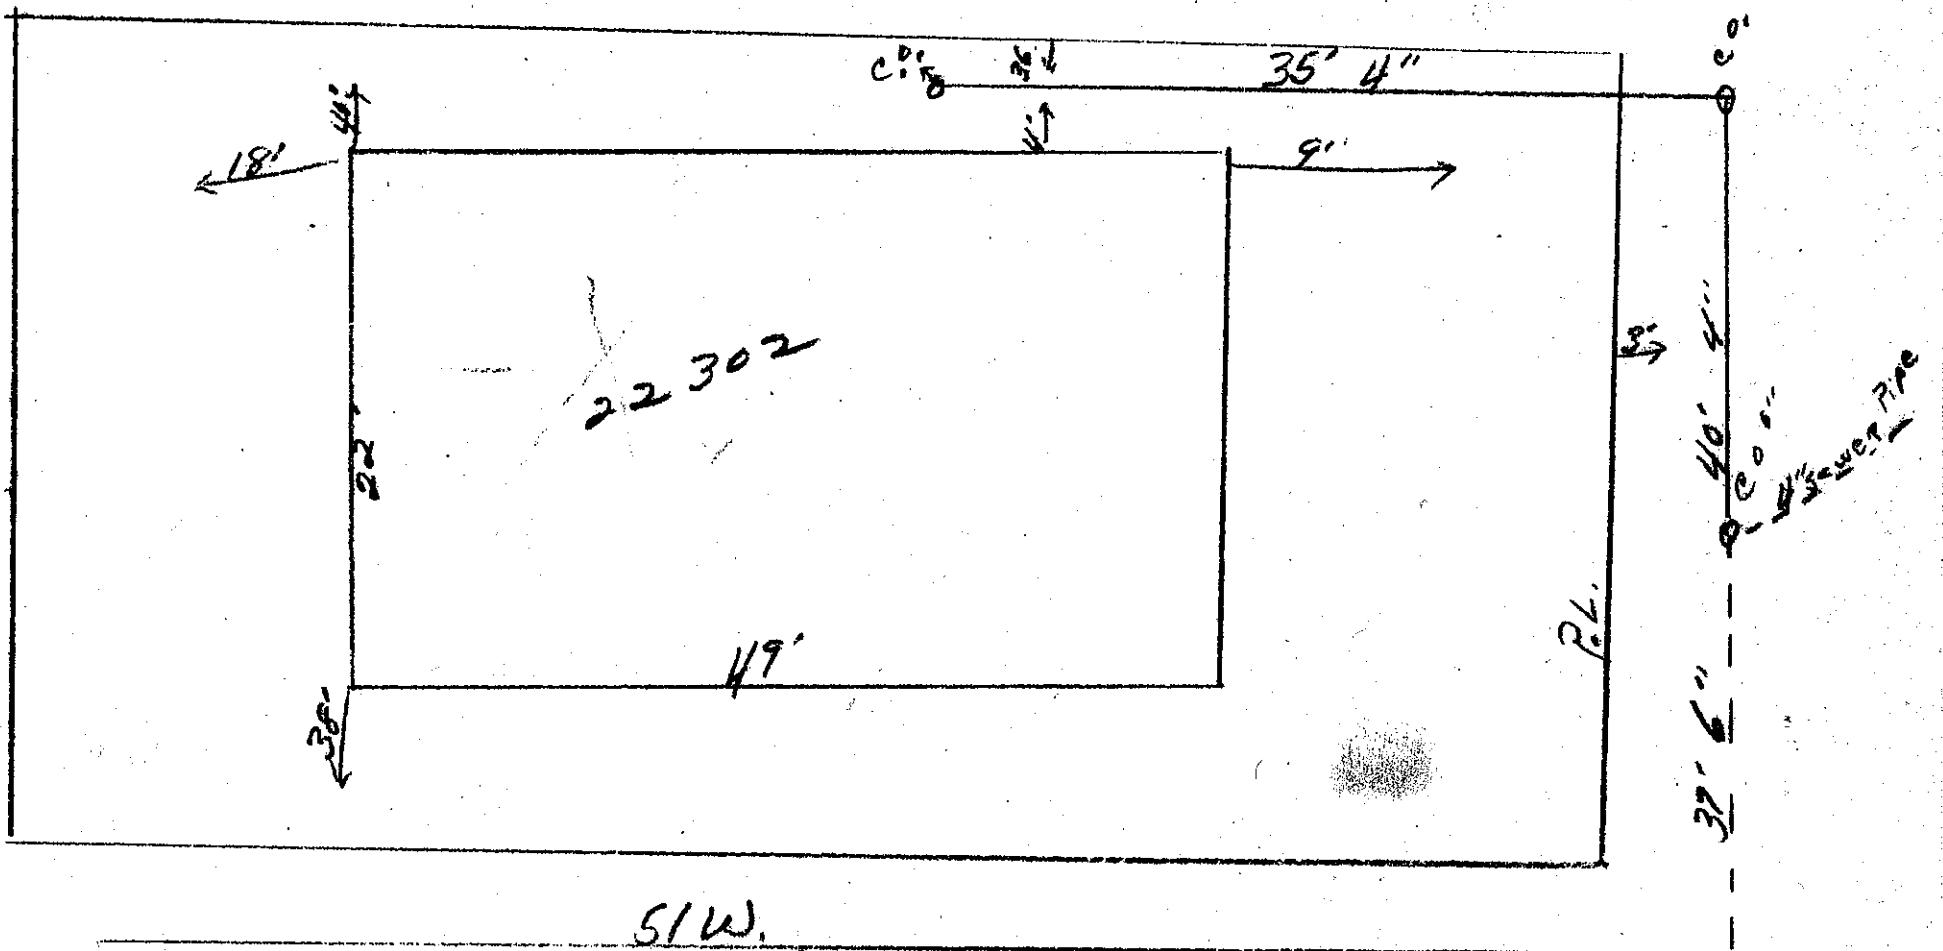

S/W.

Date

10/31/

Approved:

BACKFILL WORK ORDER ISSUED

DEPOSIT, \$

SEWER WORK ORDER ISSUED

12/9/59

DATE

9-23-60

BY

J. M. Holton INS+Cov

The City of Mountlake Terrace

APPLICATION

EMERY LACROSSE

CARD No.

SIDE SEWER PERMIT

OUTSIDE INSIDE REPAIRS

EASEMENT No.

OWNER Emery LaCrosse

HOUSE NO. 22303 - 51 W.

CONTRACTOR

STREET
AVENUE LOT NO.

Owner

35


PERMIT No. 2649

NAME ADD.

DIV. 21

BLOCK No.

99.51

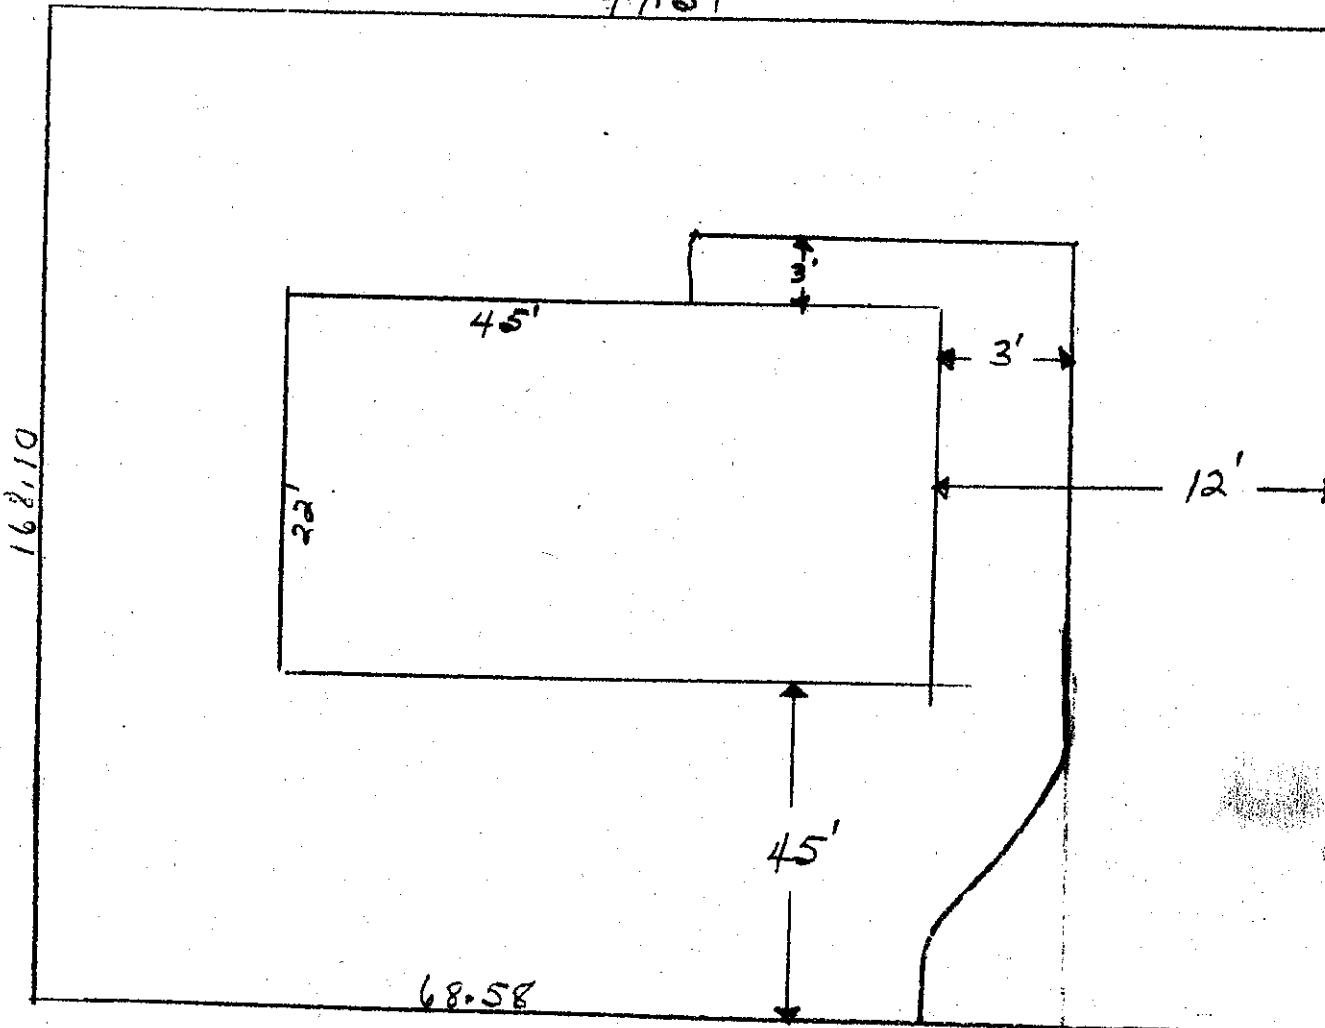

Date

Approved:

BACKFILL WORK ORDER ISSUED

DEPOSIT, \$10.00 5/12/60

SEWER WORK ORDER ISSUED

1482

DATE 5-12-60

BY S. M. Holton INS CON

Plan Approved, S. M. Holton

CITY OF
MOUNTLAKE TERRACE

MAY 12 1960



The City of Mountlake Terrace

APPLICATION

HAROLD JOE

CARD No.

SIDE SEWER PERMIT

OUTSIDE INSIDE REPAIRS

EASEMENT No.

OWNER Harold Joe

HOUSE No. 22305

CONTRACTOR

Harold Joe

PERMIT NO. 2666

STREET


AVENUE LOT No. 51 W Lot 36

BLOCK No.

NAME ADD.

Mountlake Terrace D-21 According to
Plot thereof recorded in Volume 14 of lot
page 38 Record of Subdivision County.

124-89

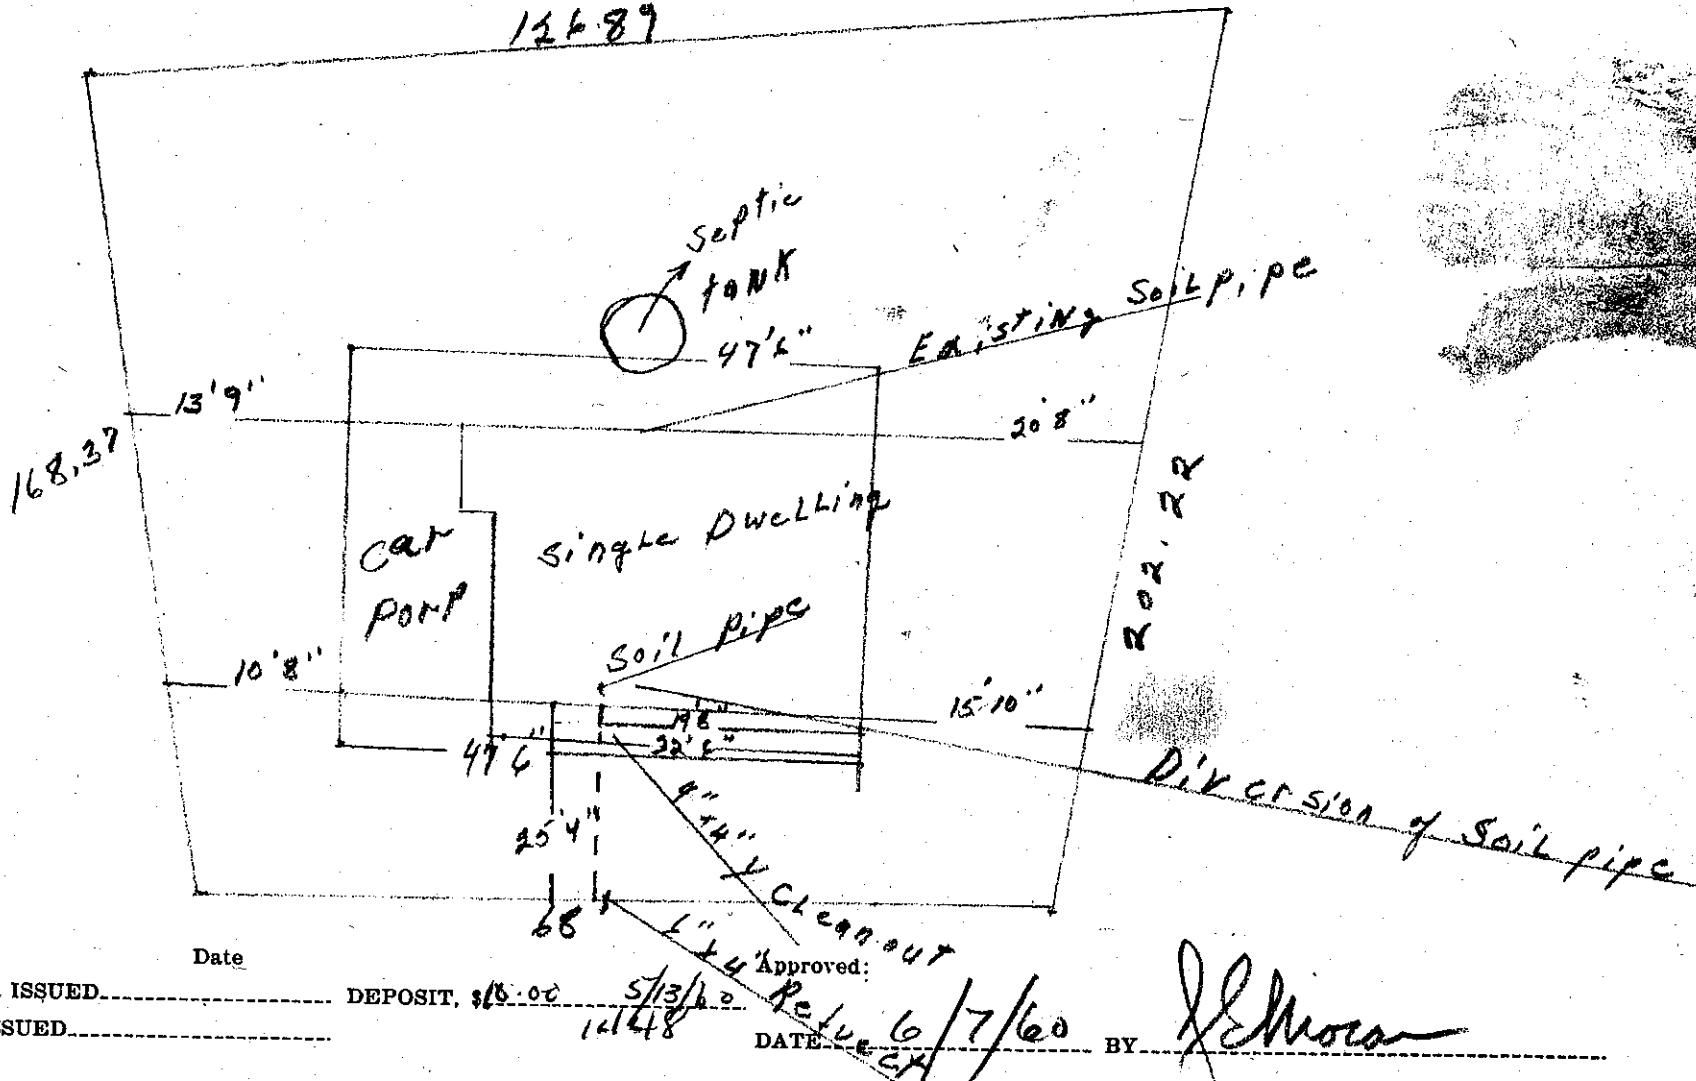

BACKFILL WORK ORDER ISSUED
SEWER WORK ORDER ISSUED

Date

DEPOSIT, \$10.00

Approved:
5/13/60
R. C. [Signature]

DATE

6/7/60

BY

J. M. Moran

The City of Mountlake Terrace

APPLICATION

CARD No.

SIDE SEWER PERMIT

OUTSIDE INSIDE REPAIRS

EASEMENT No.

OWNER: Robert Knist Ney
HOUSE No.: 2230 7 S 157

CONTRACTOR:

STREET:

AVENUE LOT NO.:

NAME ADD:

PERMIT No. 660


BLOCK No.

CITY OF
MOUNTLAKE TERRACE

MAY 13 1960

Plan Approved,

S. McAllee

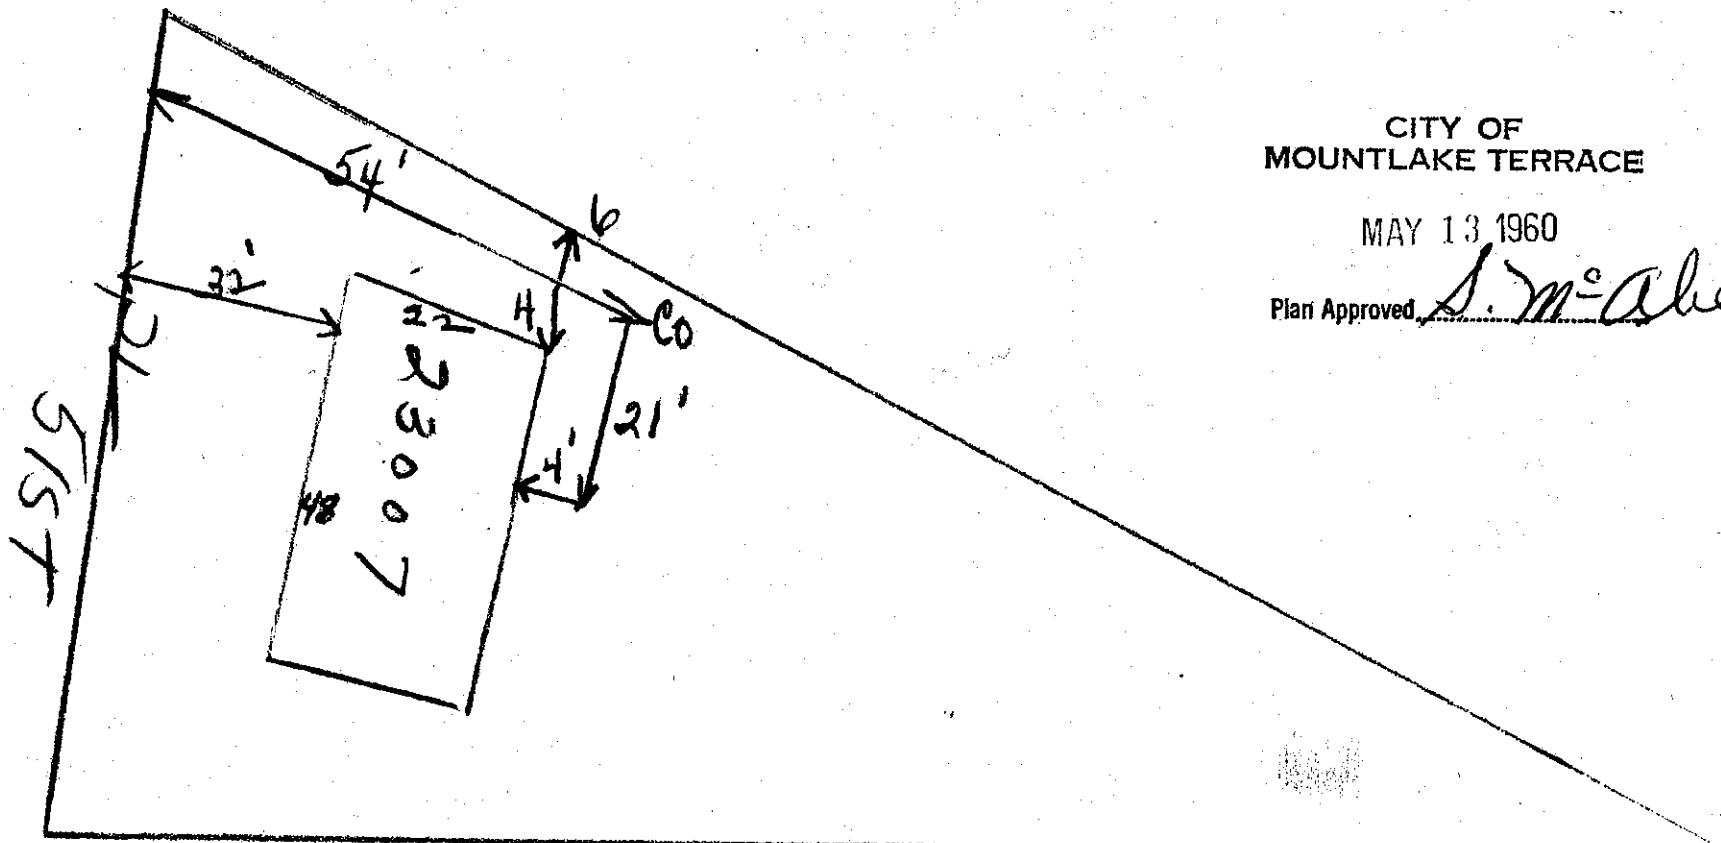

224th

Date

Approved:

BACKFILL WORK ORDER ISSUED

DEPOSIT, \$ 100.00

SEWER WORK ORDER ISSUED

DATE 5-13-60 BY S. M. Holton INS & CON

The City of Mountlake Terrace

for
SIDE SEWER PERMIT

CARD No.

OUTSIDE INSIDE REPAIRS

EASEMENT No.

OWNER Iver Gilbert

HOUSE No. 22501-51 SW.


CONTRACTOR Wingfield

PERMIT No. 2949

STREET
AVENUE LOT No. 6

BLOCK No.

NAME ADD. Valley Crest

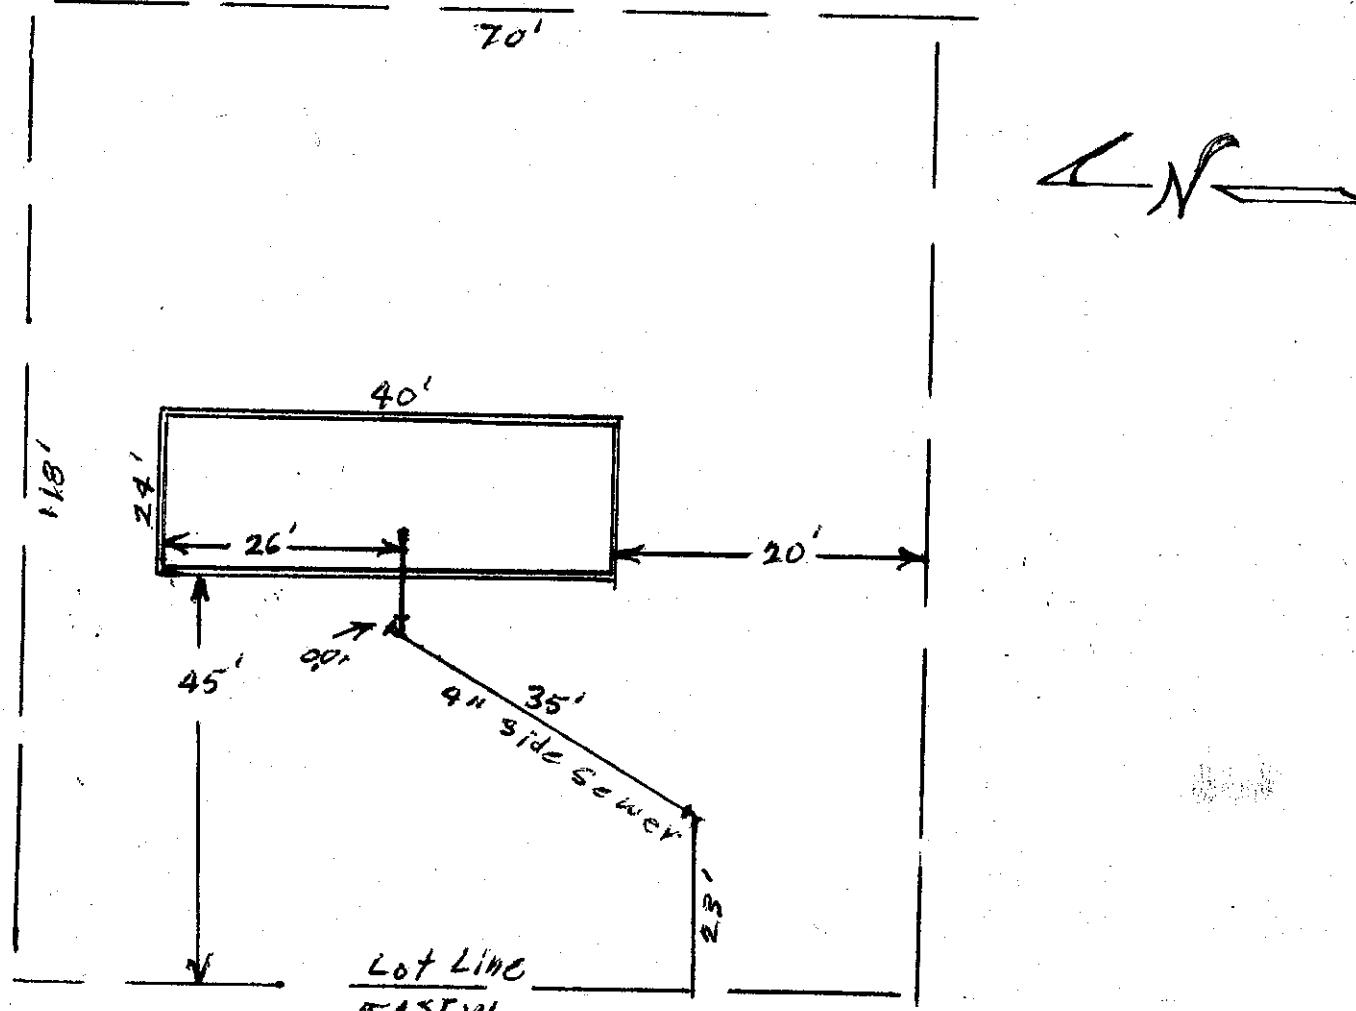

BACKFILL WORK ORDER ISSUED
SEWER WORK ORDER ISSUED

Date

DEPOSIT, \$

Approved:

DATE

11/6/61

BY

John Shedd

The City of Mountlake Terrace

APPLICATION

CARD No.

SIDE SEWER PERMIT

OUTSIDE INSIDE REPAIRS

EASEMENT No. None

OWNER Iver Gilbert

HOUSE No. 22503 - 51st Ave. W.


CONTRACTOR Wingfield

PERMIT No. 2972

STREET
AVENUE LOT No. 7

BLOCK No.

NAME ADD. Valley Crest

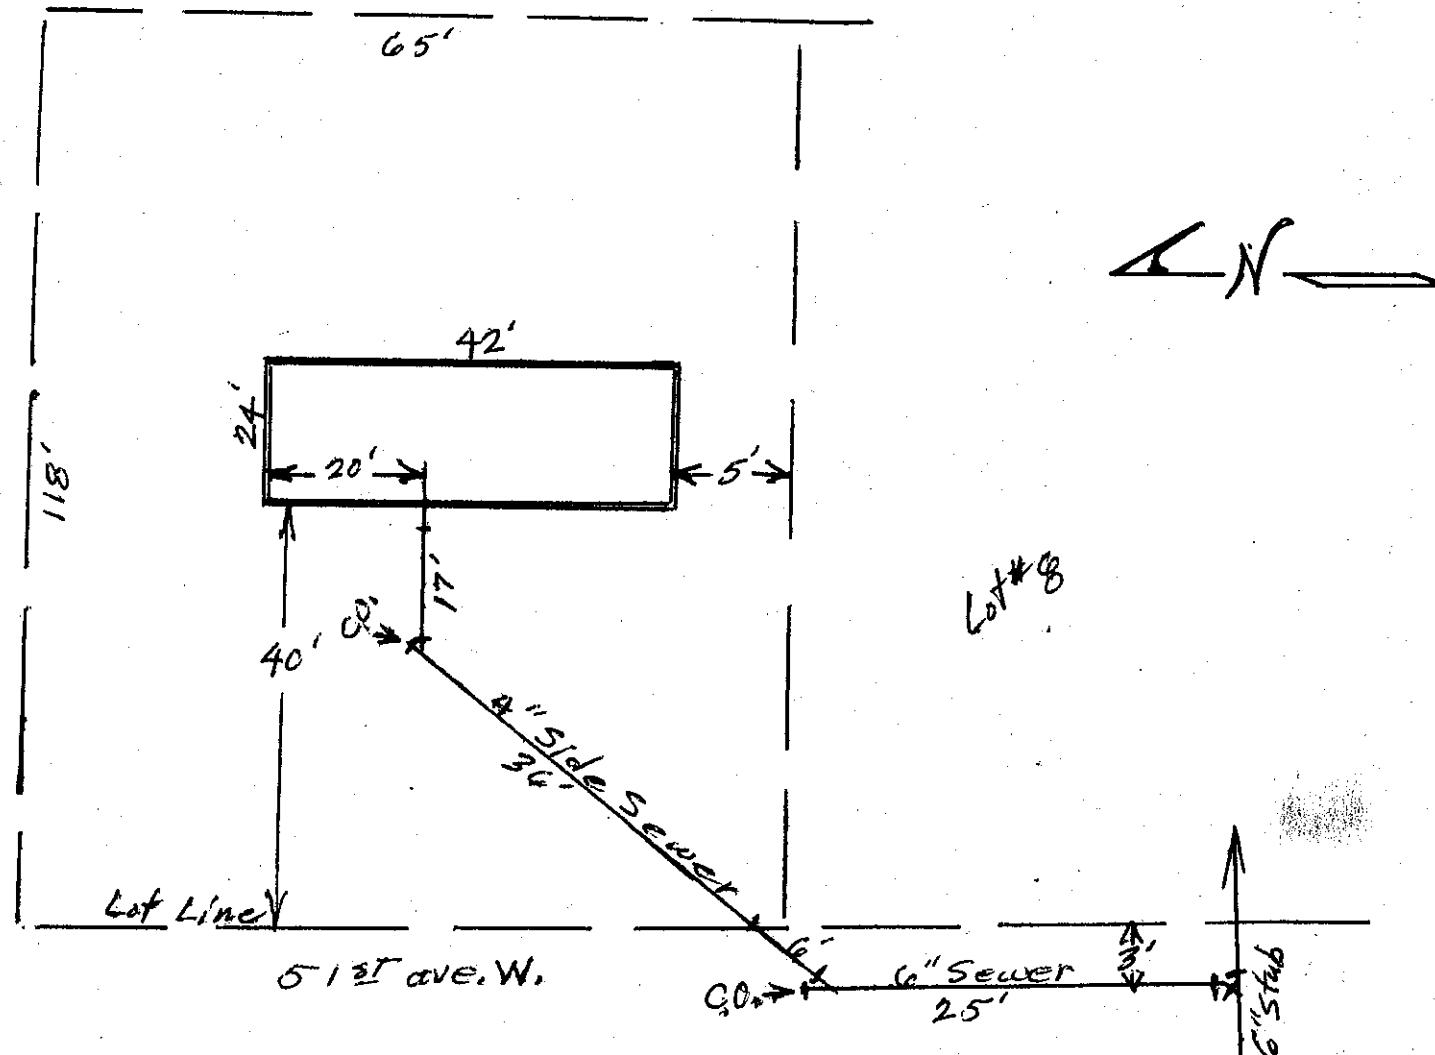

Date

Approved:

BACKFILL WORK ORDER ISSUED

DEPOSIT, \$

SEWER WORK ORDER ISSUED

DATE 12-14-61 BY J. M. Holton

The City of Mountlake Terrace

APPLICATION

CARD No.

SIDE SEWER PERMIT

OUTSIDE INSIDE REPAIRS

EASEMENT No.

OWNER Iver Gilbert

HOUSE No. 2250 ~~18~~ - 51st W.

CONTRACTOR

Wingfield

PERMIT No. 2973

STREET


AVENUE LOT No. 12

BLOCK No.

NAME ADD

Valley Crest

N
A

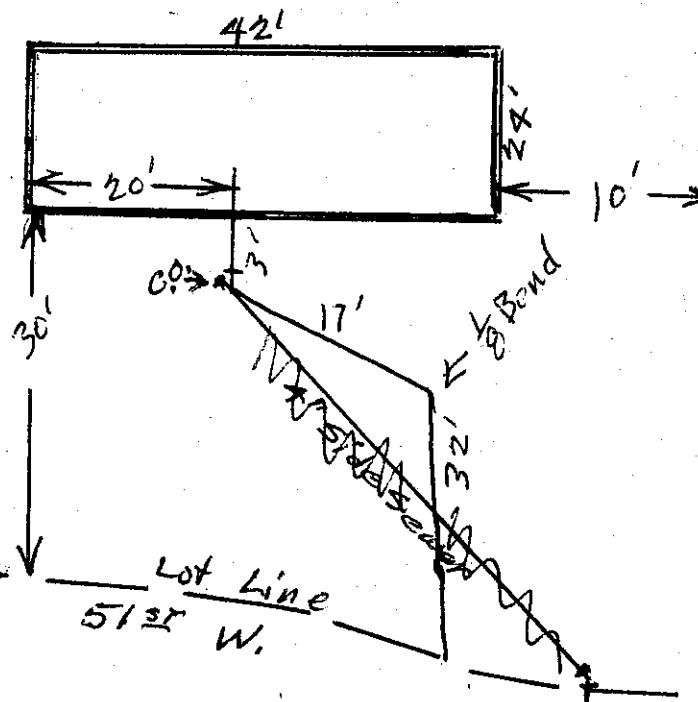

Date

Approved:

BACKFILL WORK ORDER ISSUED

DEPOSIT, \$

SEWER WORK ORDER ISSUED

DATE 12-12-61 BY

S. M. Holton

The City of Mountlake Terrace

APPLICATION

CARD No.

SIDE SEWER PERMIT

OUTSIDE INSIDE REPAIRS

EASEMENT No.

OWNER Iver Gilbert

HOUSE No. 22505 - 51st W.


CONTRACTOR Wingfield

PERMIT No. 2948

STREET
AVENUE LOT No. 8

BLOCK No.

NAME ADD Valley Crest

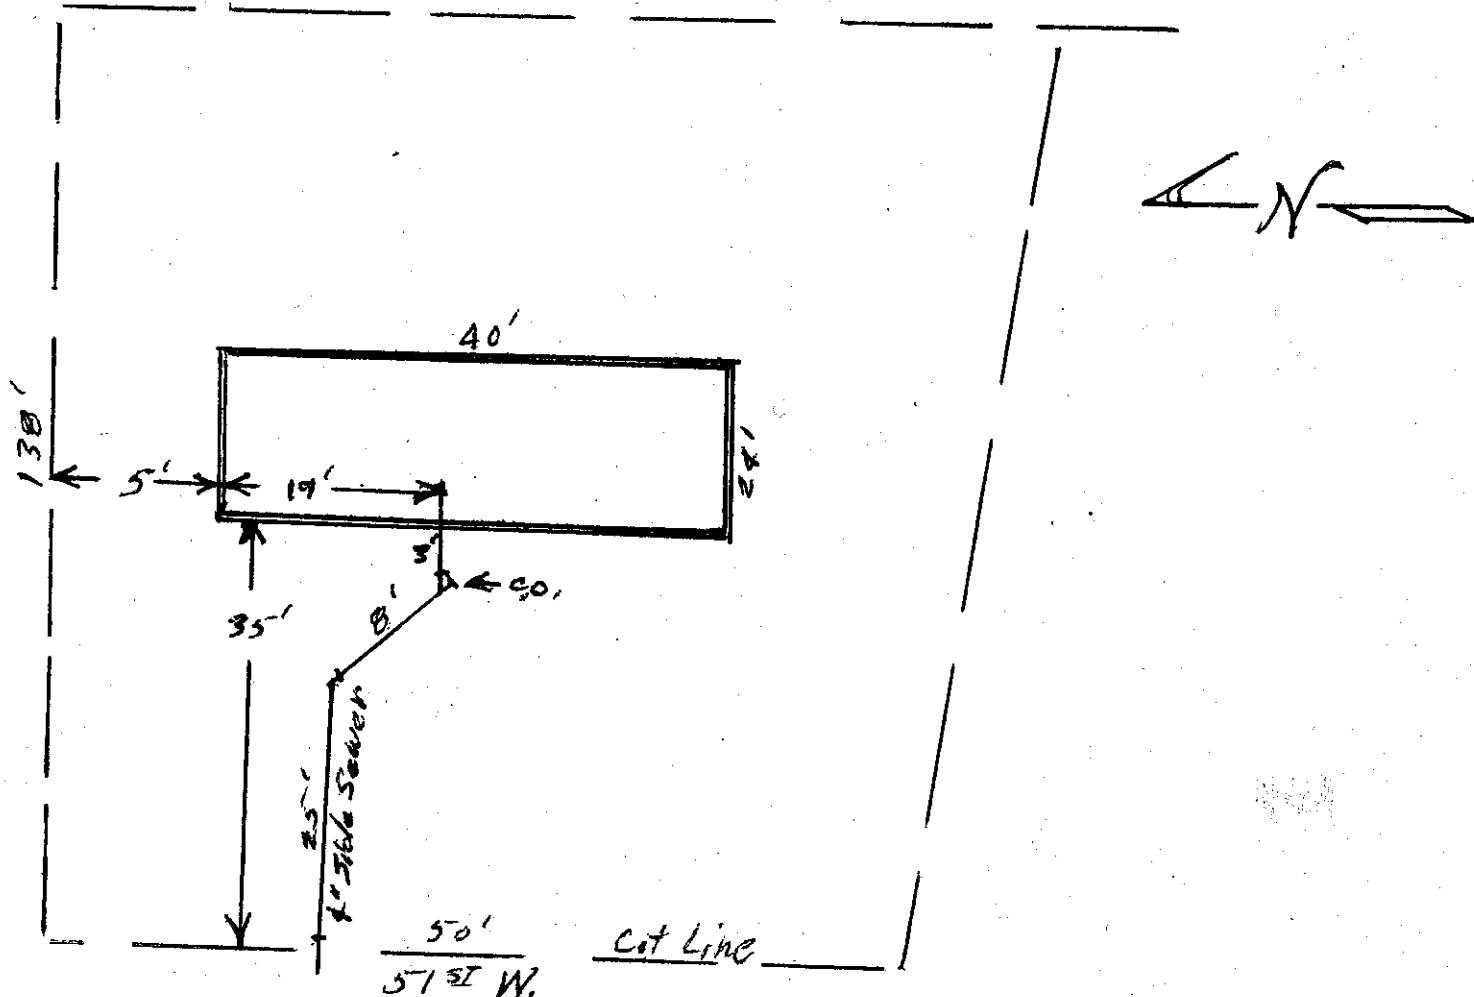

Date

Approved:

BACKFILL WORK ORDER ISSUED
SEWER WORK ORDER ISSUED

DEPOSIT, \$

DATE 11/9/01

BY

Joe Peterson

The City of Mountlake Terrace

APPLICATION

to

SIDE SEWER PERMIT

OUTSIDE INSIDE REPAIRS

CARD No.

EASEMENT No. None

OWNER Ivor Gilbert

HOUSE No. 22506 - 51st W.

CONTRACTOR

Wingfield


PERMIT NO. 2963

STREET

AVENUE LOT No. 11

BLOCK No.

NAME ADD. Valley Crest

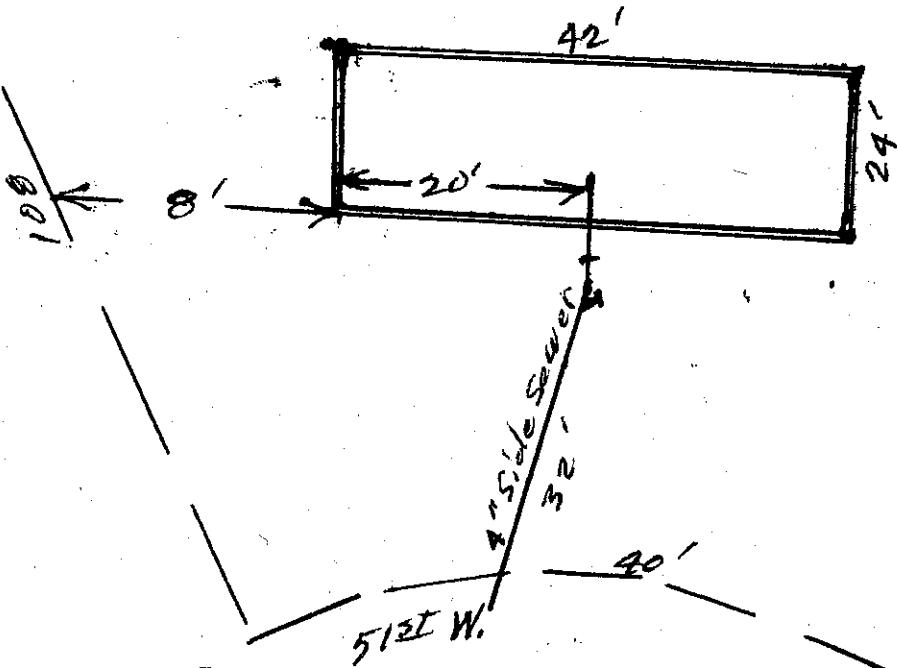

Date

Approved:

BACKFILL WORK ORDER ISSUED.....

DEPOSIT, \$.....

SEWER WORK ORDER ISSUED.....

DATE 12-4-61 BY J. M. Holton

SEWER WORK ORDER ISSUED


DATE

12-12-61 BY

DEPOSIT:

Approved:

Date

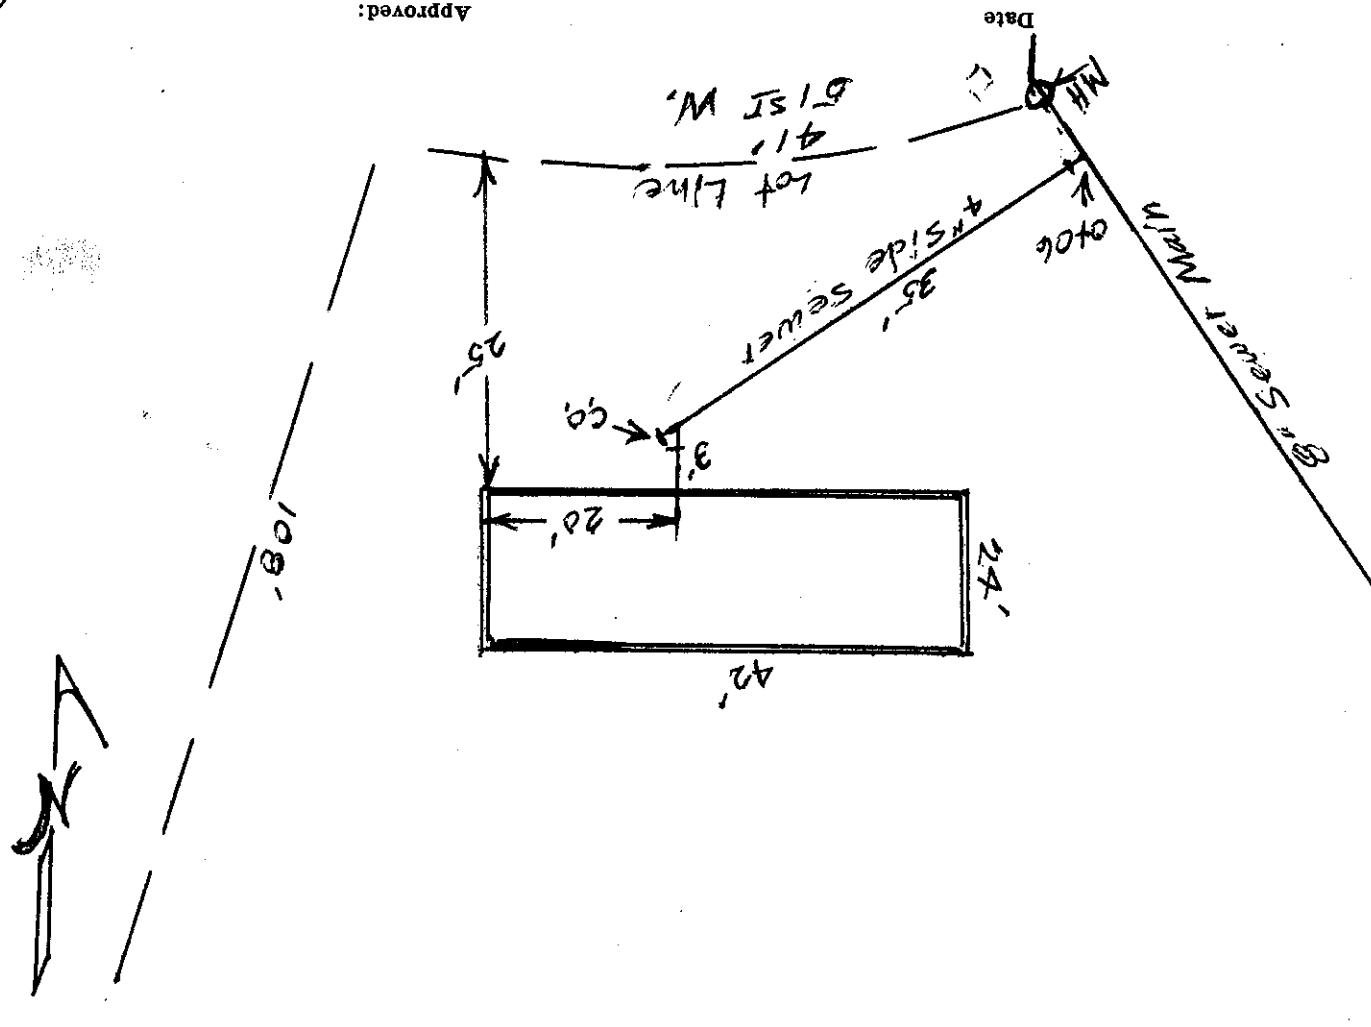

APPLICATION

The City of Mountlake Terrace

CARD NO.

BASEMENT NO.

OUTSIDE INSIDE REPAIRS

SIDE SEWER PERMIT

CONTRACTOR: Mungfield Const. PERMIT NO. 2974

STREET AVENUE LOT NO. 10 BLOCK NO.

NAME ADD: Miller Crest

HOUSE NO. 22308-51st W.

OWNER: Liver Gilbert

The City of Mountlake Terrace

APPLICATION

R. F. Hall
CARD No.

SIDE SEWER PERMIT

OUTSIDE INSIDE REPAIRS

EASEMENT No.

OWNER ROBERT F HALL

HOUSE No. 23008 W 51


CONTRACTOR THUNDERBIRD CONST.

PERMIT No. 1861

STREET
AVENUE LOT NO. N. 25 of lot 16
S. 45 of lot 17

BLOCK No. 1-DIV. 10

NAME ADD.

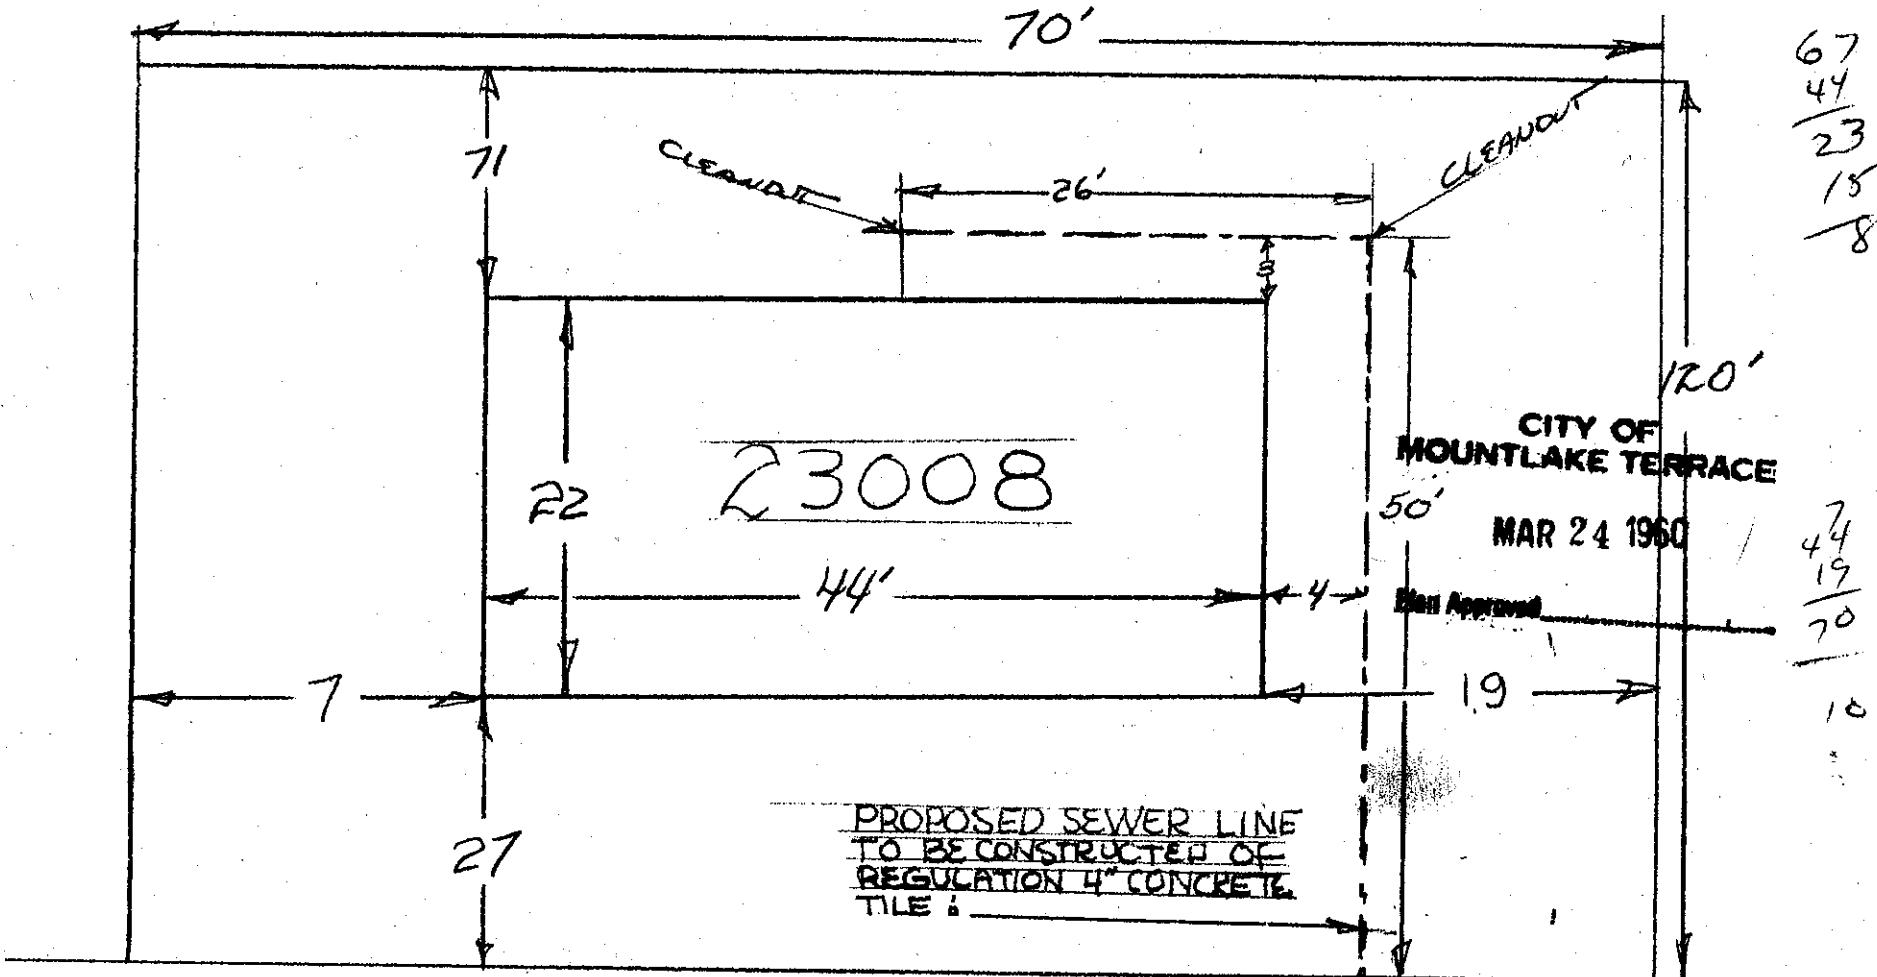

Date

51. W

Approved:

BACKFILL WORK ORDER ISSUED
SEWER WORK ORDER ISSUED

DEPOSIT, \$

10.00

3/21/60
#726

DATE

3-24-60

BY

Scott M. Holtz, INS CON

The City of Mountlake Terrace

APPLICATION

SIDE SEWER PERMIT
OUTSIDE INSIDE REPAIRS

MARY H. PERSON

CARD No.

EASEMENT No.

OWNER Mary Anderson
HOUSE No. 23009-51st S. E. W.

CONTRACTOR


STREET
AVENUE LOT No. 3

PERMIT No. 1382

BLOCK No. 2

Div. 10

NAME ADD.

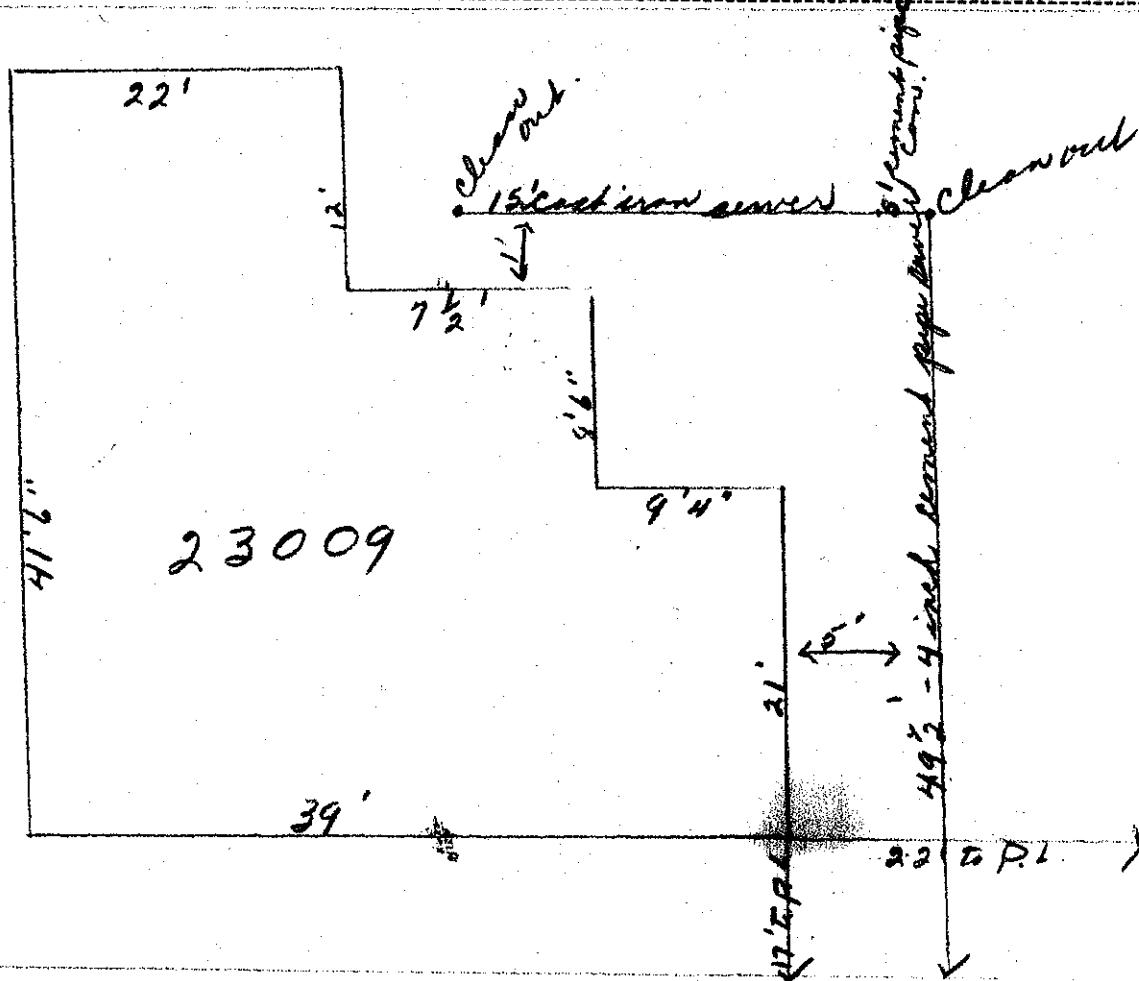

CITY OF
MOUNTLAKE TERRACE

DEC 28 1959

Plan Approved

J. Sailor

9 1/2"

Date

57 1/2 ft. w.
DEPOSIT, \$10⁰⁰ 12-28-59

Approved:

BACKFILL WORK ORDER ISSUED
SEWER WORK ORDER ISSUED

5628
et

DATE 12-28-59 BY Scott

3-16-60 INSTCO

The City of Mountlake Terrace

APPLICATION

CARD No.

SIDE SEWER PERMIT

OUTSIDE INSIDE REPAIRS

EASEMENT No. 1357255

OWNER Wallace D. Caswell

23104 - 57 W

HOUSE No.

CONTRACTOR


PERMIT NO. 2541

STREET

AVENUE LOT No. 14-15

BLOCK No. 1

NAME ADD MLT. Div

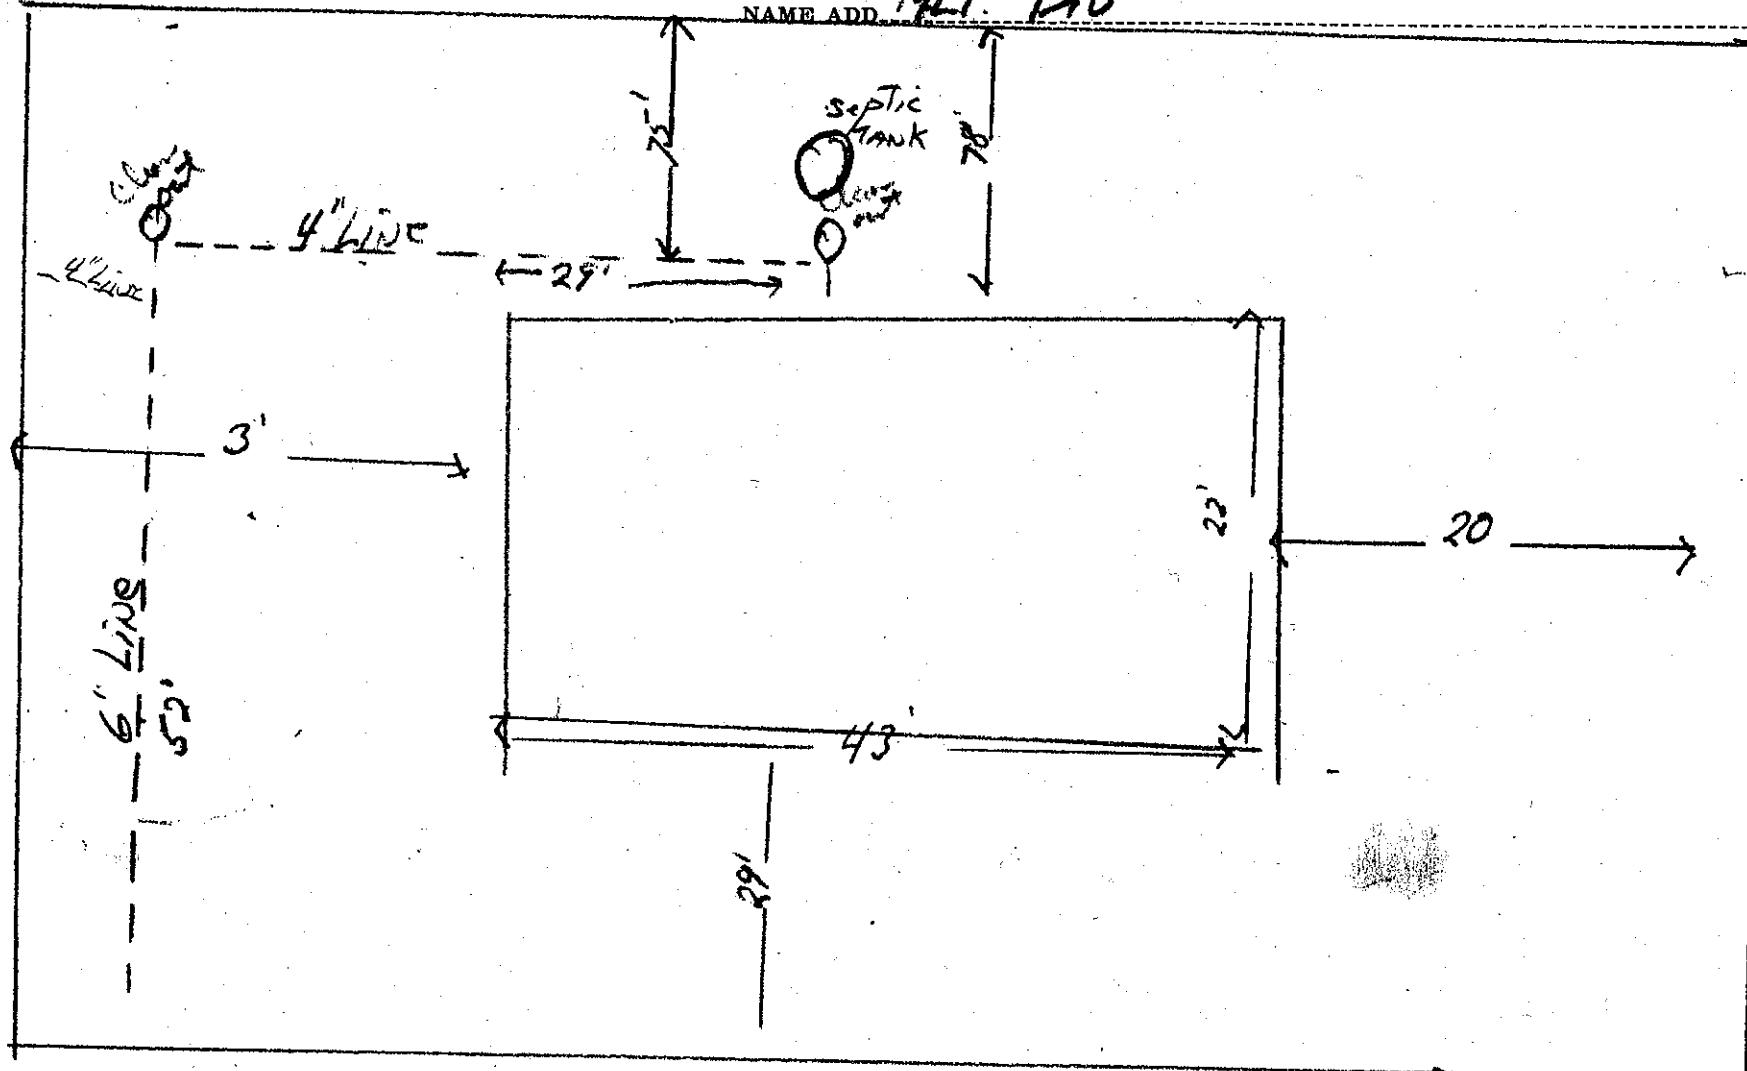

BACKFILL WORK ORDER ISSUED

SEWER WORK ORDER ISSUED

Date

DEPOSIT, \$10.00

Approved:

1316 4/23/60 DATE 4/25/60

BY

J. M. Moyer

The City of Mountlake Terrace

APPLICATION
for

MARY FOSSE

CARD No.

SIDE SEWER PERMIT

OUTSIDE INSIDE REPAIRS

EASEMENT No.

OWNER Mary FOSSE
HOUSE No. 23107 51 w

CONTRACTOR Rainier Const.

PERMIT No.

2437


STREET
AVENUE LOT No.

5

BLOCK No.

Div. 10

NAME ADD.

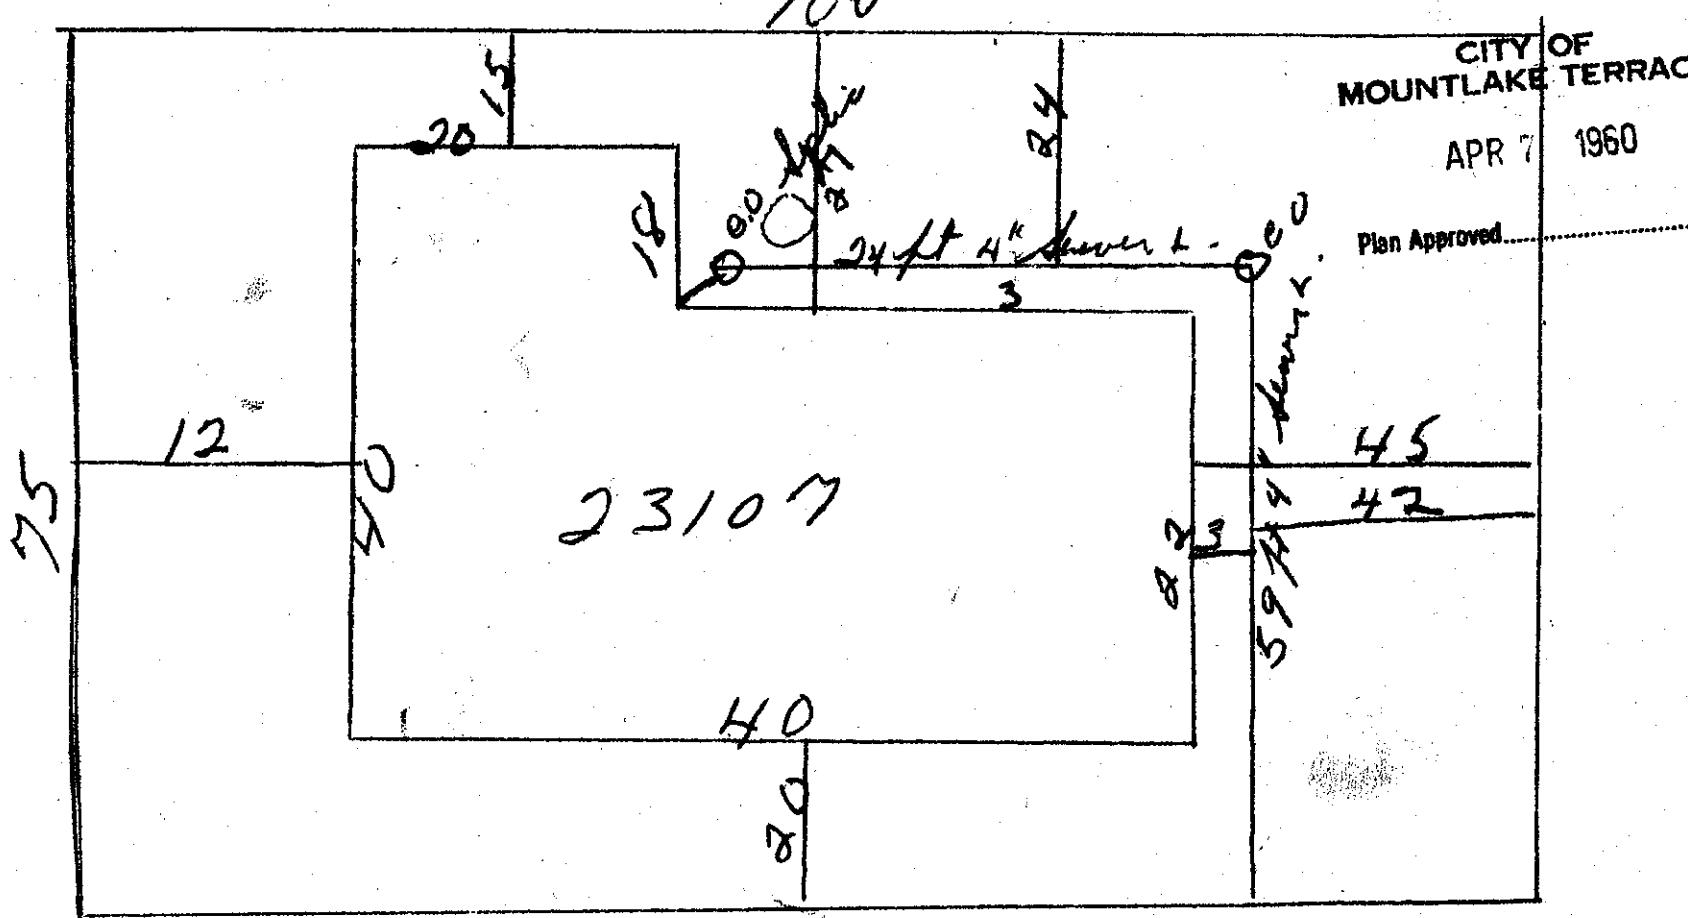

Date

BACKFILL WORK ORDER ISSUED
SEWER WORK ORDER ISSUED

DEPOSIT, \$10.00

Approved:
4/7/60
1224

4/7/60

DATE

4/7/60 BY

J. Falmer

W N W
The City of Mountlake Terrace

APPLICATION

CARD No.

SIDE SEWER PERMIT

OUTSIDE INSIDE REPAIRS

EASEMENT No. ✓

OWNER MRS JOHN J. JONES

HOUSE No. 23203 51st St. W.

CONTRACTOR *John J. Jones*


PERMIT No. 1605

STREET

AVENUE LOT NO. 2

BLOCK No. 6

NAME ADD. DIV. 10

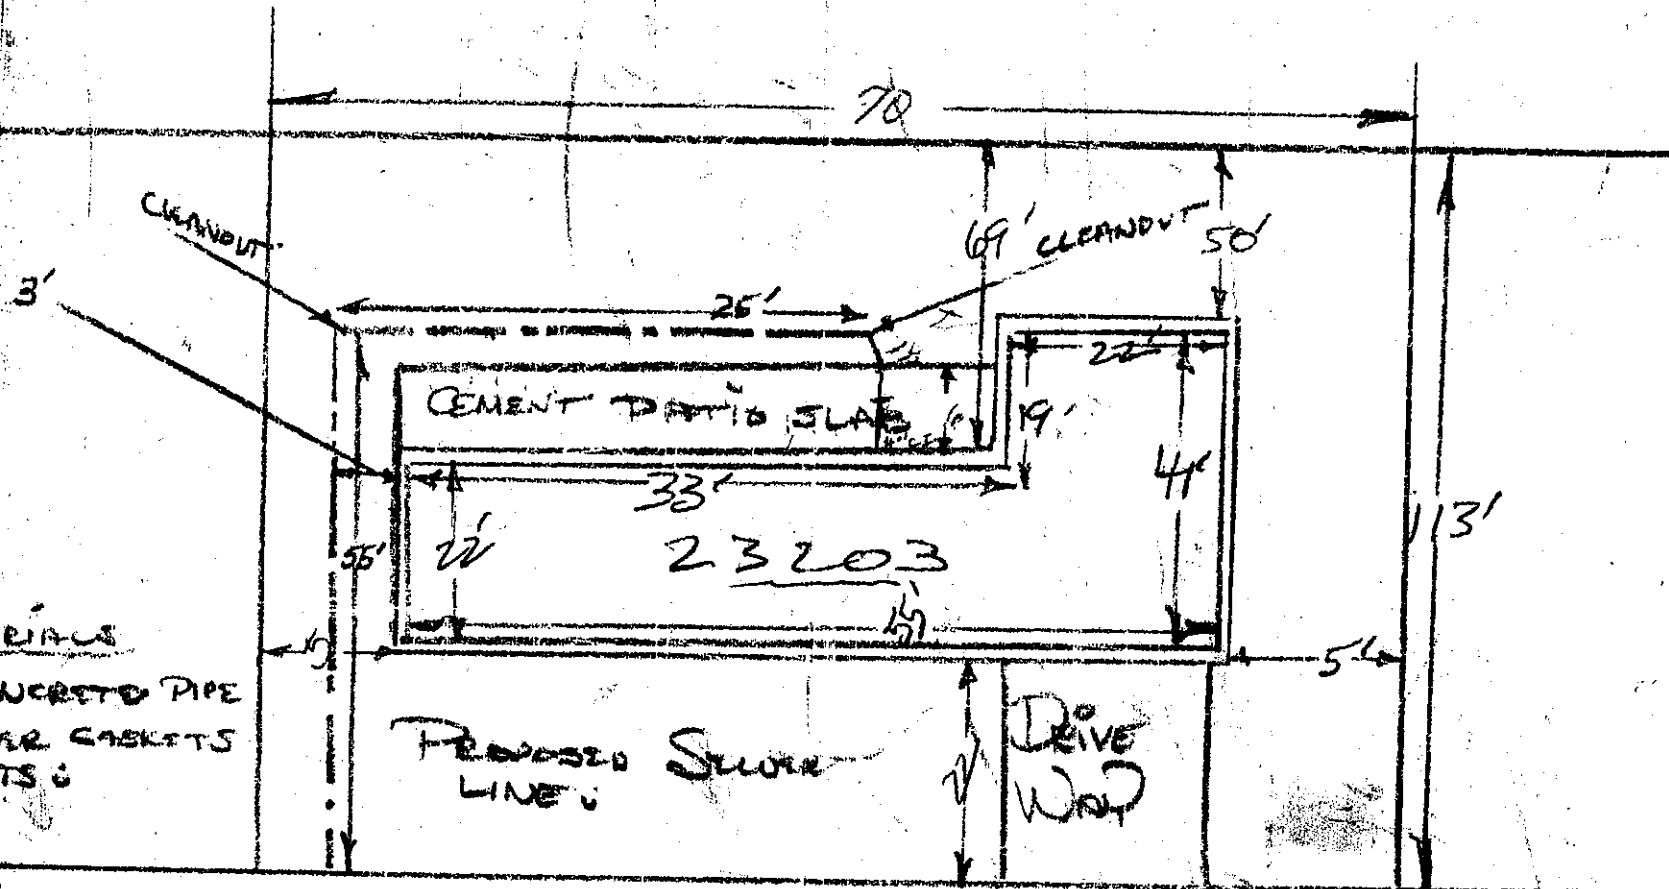

Date

Approved:

BACKFILL WORK ORDER ISSUED
SEWER WORK ORDER ISSUED

DEPOSIT:

1000

req'd *1594* *Permit* *Exempt* DATE 10-24-60 BY S.M. Holton, INS+CON

APPLICATION

CARD NO.

The City of Mountlake Terrace

SIDE SEWER PERMIT

OUTSIDE INSIDE REPAIRS

EASEMENT No. 1347542

OWNER Robert T. Lordin MACCAUGHEY

CONTRACTOR Se 17.

PERMIT No. 754


HOUSE No. 23204 51 Ave West.

STREET AVENUE LOT No. Pos. 10 + 11

5

BLOCK No. Mountlake Terrace Div 10

NAME ADD. West Property Line

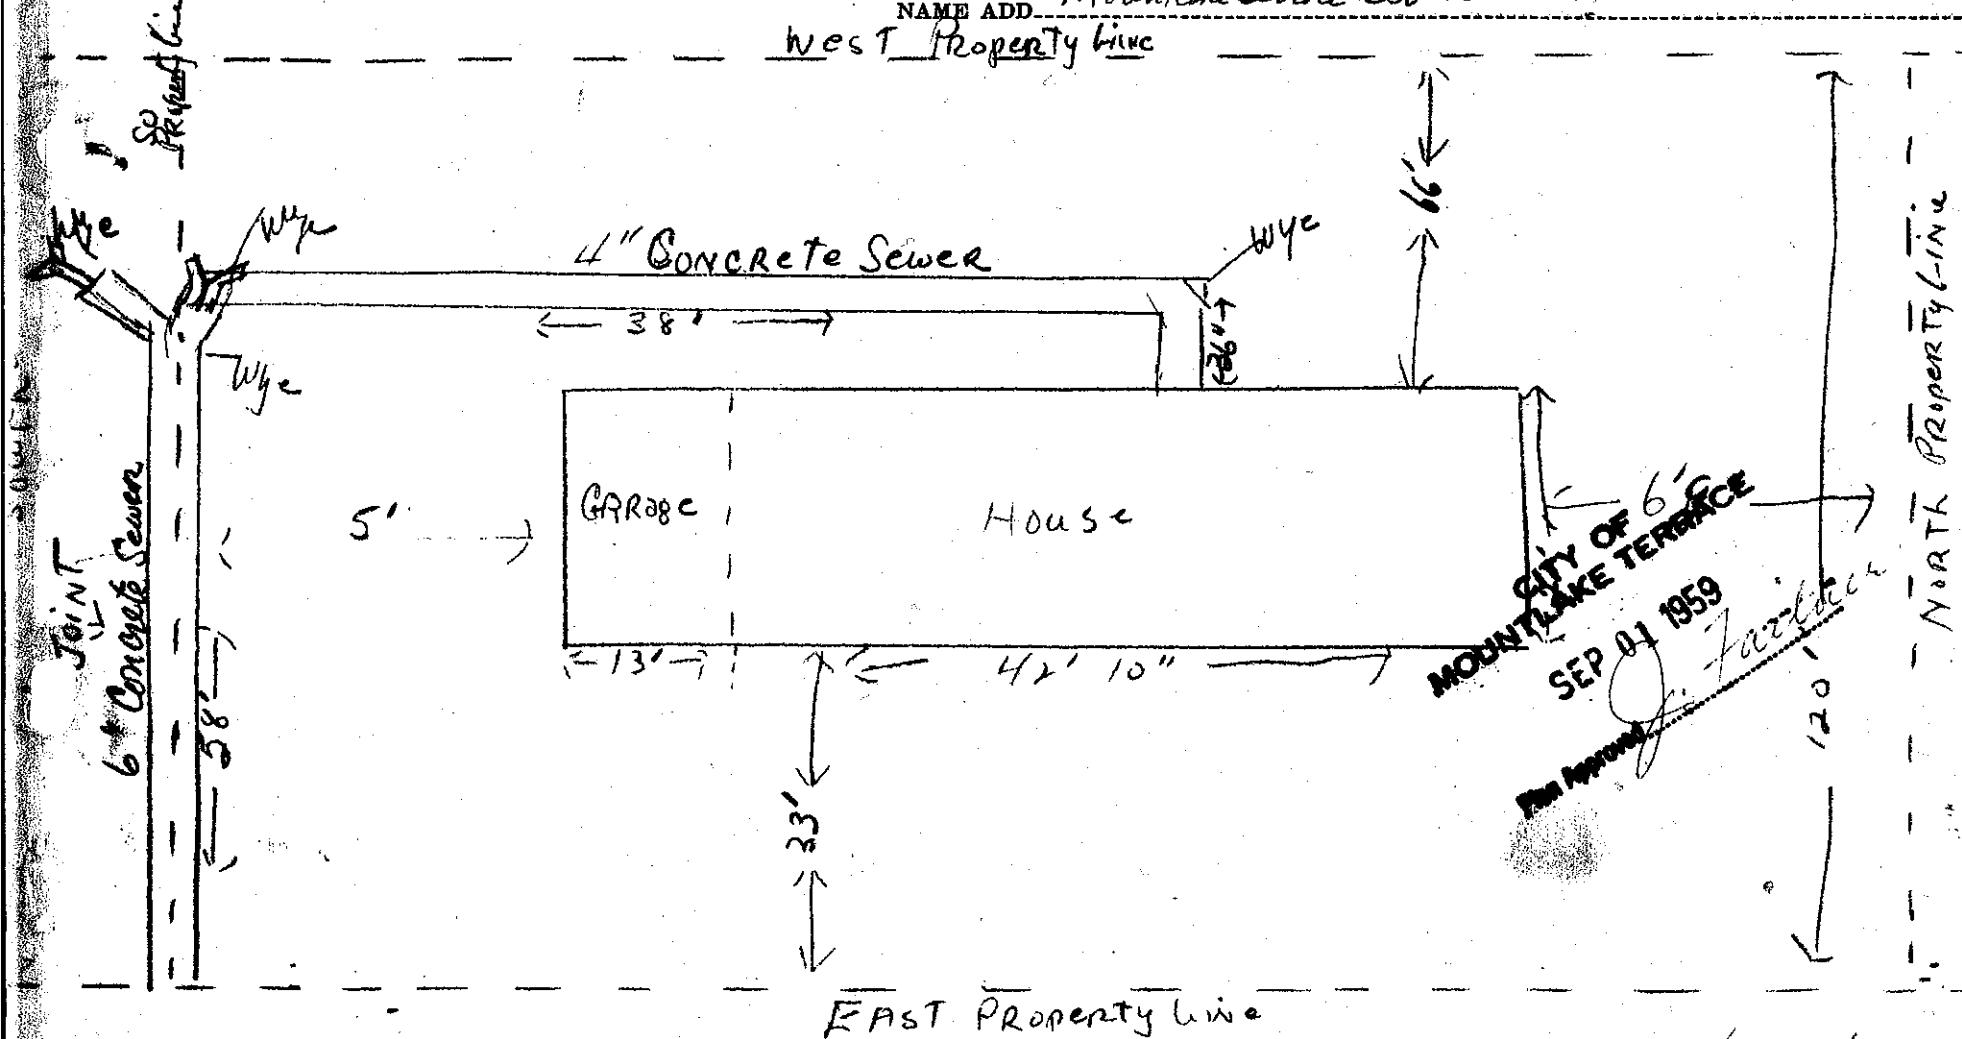

Date

DEPOSIT, \$

BACKFILL WORK ORDER ISSUED

SEWER WORK ORDER ISSUED

10 or 8/26/59

Approved:

#3994

DATE

9/2/59

BY

Inspector N.C.

6/2/59
F. J. Farber

Connected 2/29/60 K. Moran

The City of Mountlake Terrace

APPLICATION
for

SIDE SEWER PERMIT

OUTSIDE INSIDE REPAIRS

J.C. DJH
CARD No.

EASEMENT No. 1384327


OWNER Joseph C. Bell

HOUSE No. 23205 - 51W Mountlake TERR

CONTRACTOR TOPNOTCH PLUMBING PERMIT NO. 115

STREET AVENUE LOT NO. South 1/2 Lot 3 North 1/2 Ref Block No. 6

NAME ADD. MOUNTLAKE TERR. #10
53' 0" x 6"

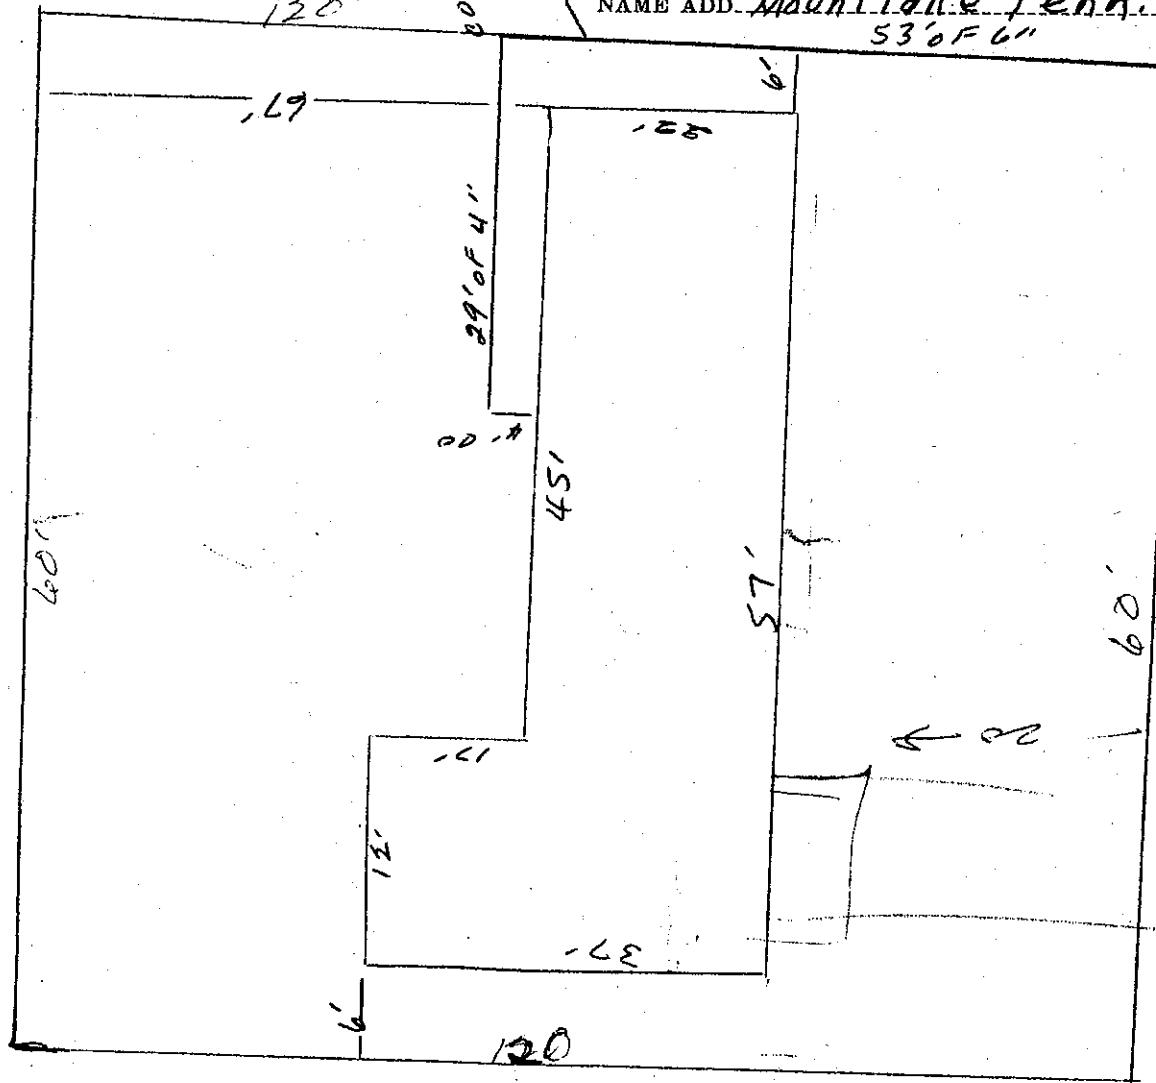

Date

Approved:

BACKFILL WORK ORDER ISSUED

DEPOSIT, \$10.00 5/27/60

SEWER WORK ORDER ISSUED

1543 DATE 5/27/60

BY J. Moran

The City of Mountlake Terrace

APPLICATION

NINNY

60143

CARD No.

SIDE SEWER PERMIT

OUTSIDE INSIDE REPAIRS

EASEMENT No. 1384327

OWNER Mary Bakolas

HOUSE No. 23207 51 W Mountlake TERR

CONTRACTOR

TOPNOTCH PLUMBING


STREET 465
AVENUE LOT No.

MOUNTLAKE TERR. 2210

PERMIT No. 114

NAME ADD

120'

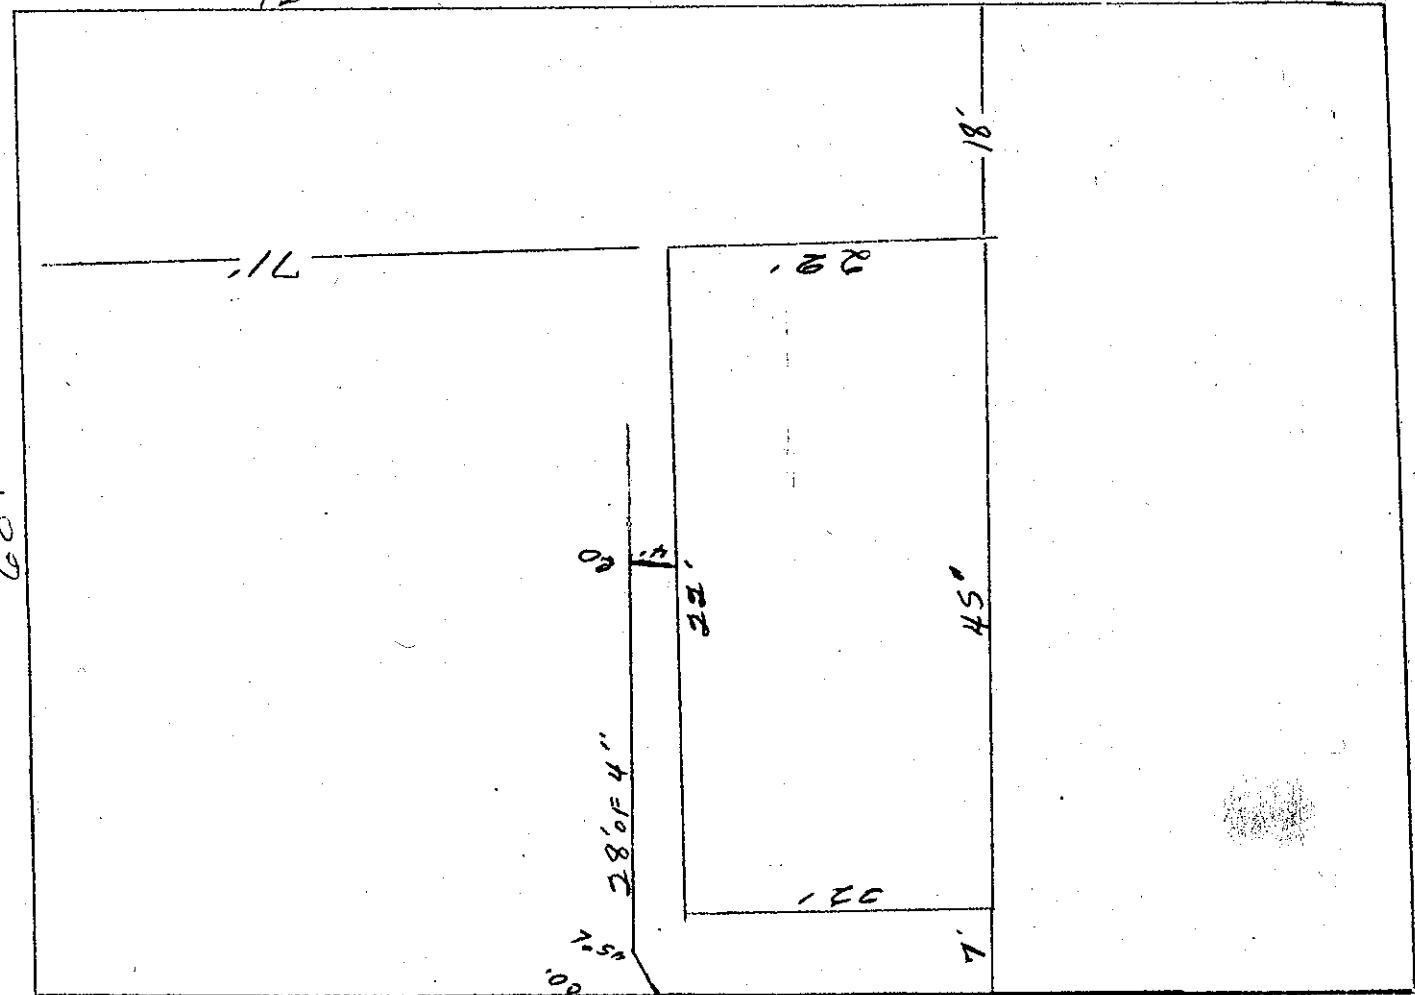

Date

Approved:

BACKFILL WORK ORDER ISSUED

DEPOSIT, \$10.00 5/27/60

SEWER WORK ORDER ISSUED

1547

DATE

5/27/60

BY

J. M. Morris

APPLICATION


The City of Mountlake Terrace

CARD No.

SIDE SEWER PERMIT

OUTSIDE INSIDE REPAIRS EASEMENT No. NoneOWNER A.J. Moseley
HOUSE No. 23208 - 51st W.CONTRACTOR Wing FieldSTREET 9AVENUE LOT No. 9PERMIT No. 514BLOCK No. 5

NAME ADD.

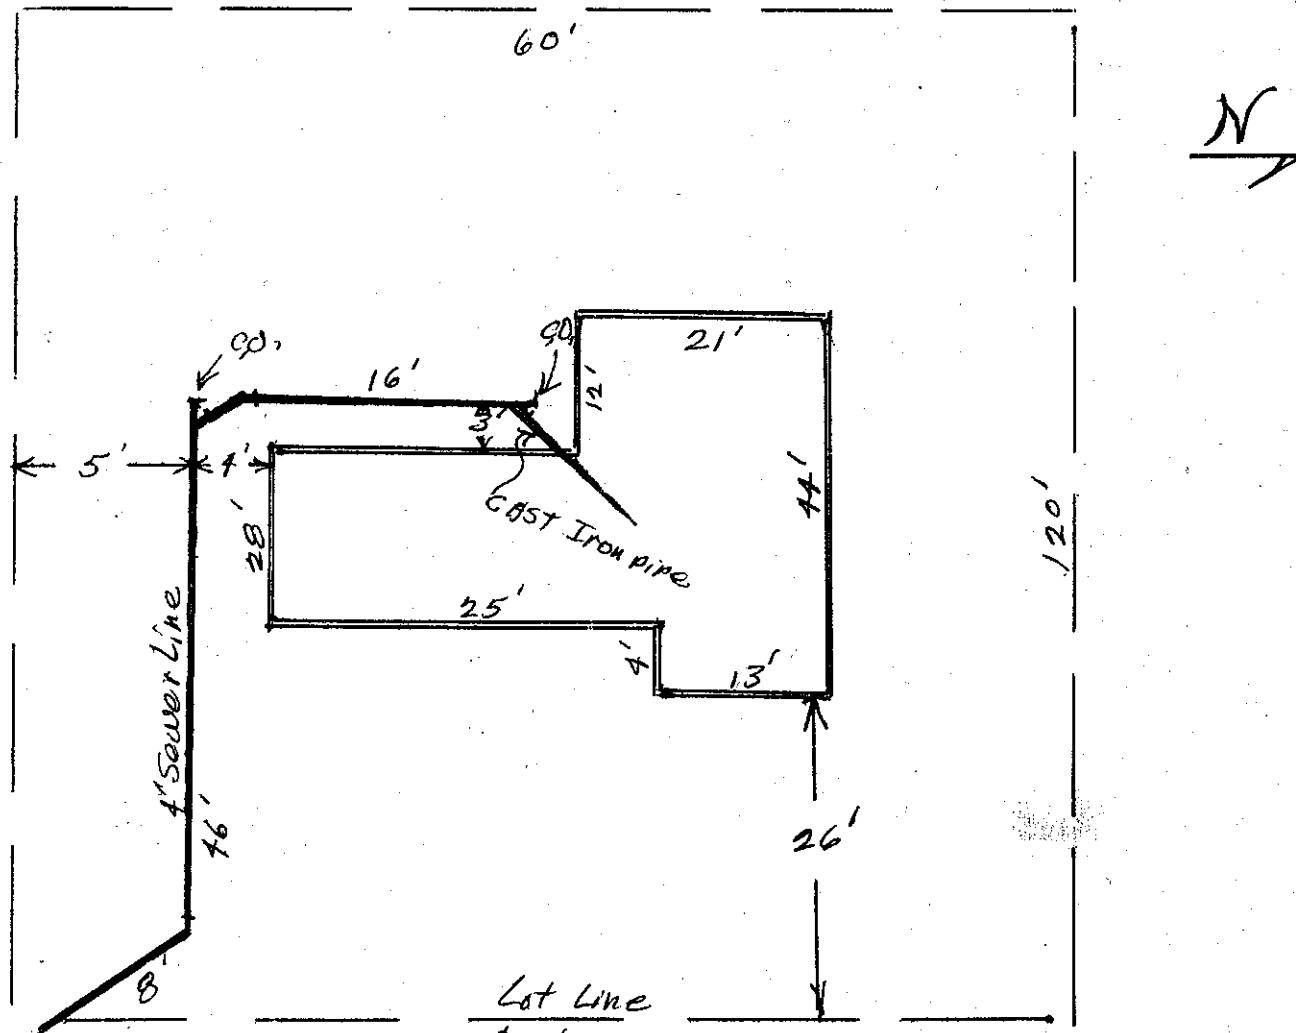Div. #10

Date

Approved:
51st W.
10/19/60BACKFILL WORK ORDER ISSUED
SEWER WORK ORDER ISSUED

#1957

DATE 10/26/60

BY Arthur E. Brunton

The City of Mountlake Terrace

APPLICATION

SIDE SEWER PERMIT
OUTSIDE INSIDE REPAIRS

GARD No.

NEW J 740

EASEMENT No.

OWNER Merle L. Newstad

HOUSE No. 23302 - 51 W.

CONTRACTOR

Self.

PERMIT No. 2594

STREET
AVENUE LOT No.


7

BLOCK No.

5

NAME ADD.

DIV. # 10

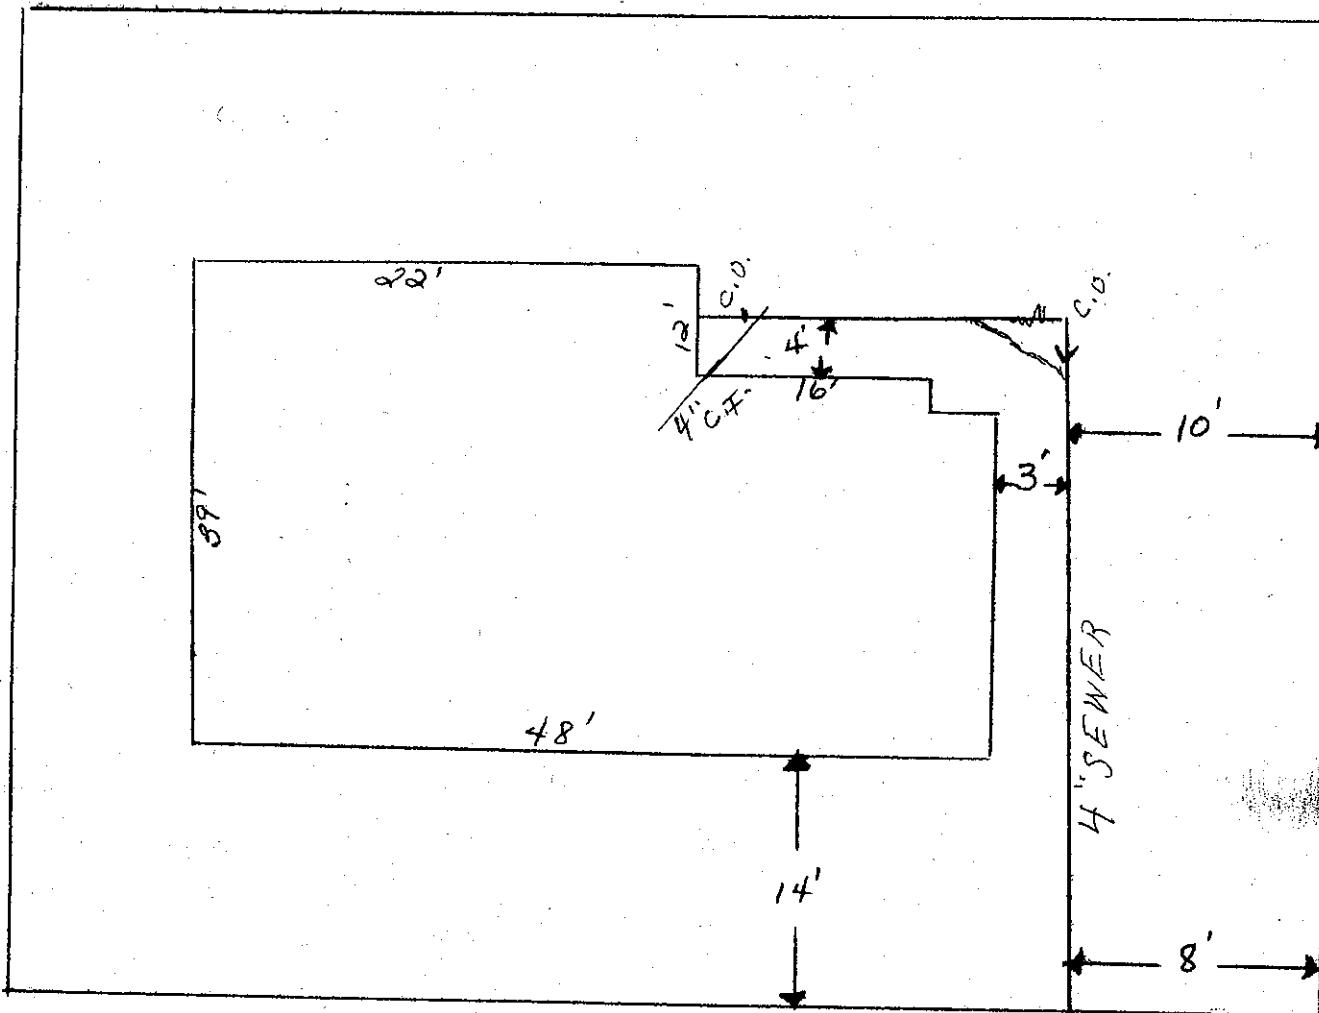

Date

Approved:

BACKFILL WORK ORDER ISSUED

DEPOSIT, \$10.00 5/2/60

SEWER WORK ORDER ISSUED

1369

DATE 10-10-60

BY S. McHolton INS & CO

APPLICATION

CARD No. 0

Mountlake Terrace

SIDE SEWER PERMIT


OUTSIDE INSIDE REPAIRS

EASEMENT No.

OWNER HERBERT F. Kluthe
HOUSE No. 23303 51st (W)CONTRACTOR Owner
STREET SOUTH 28' OF LOT # 6
AVENUE LOT NO. NORTH 33' OF LOT # 7
NAME ADD. Div - 10

PERMIT No. 805

BLOCK No. 6

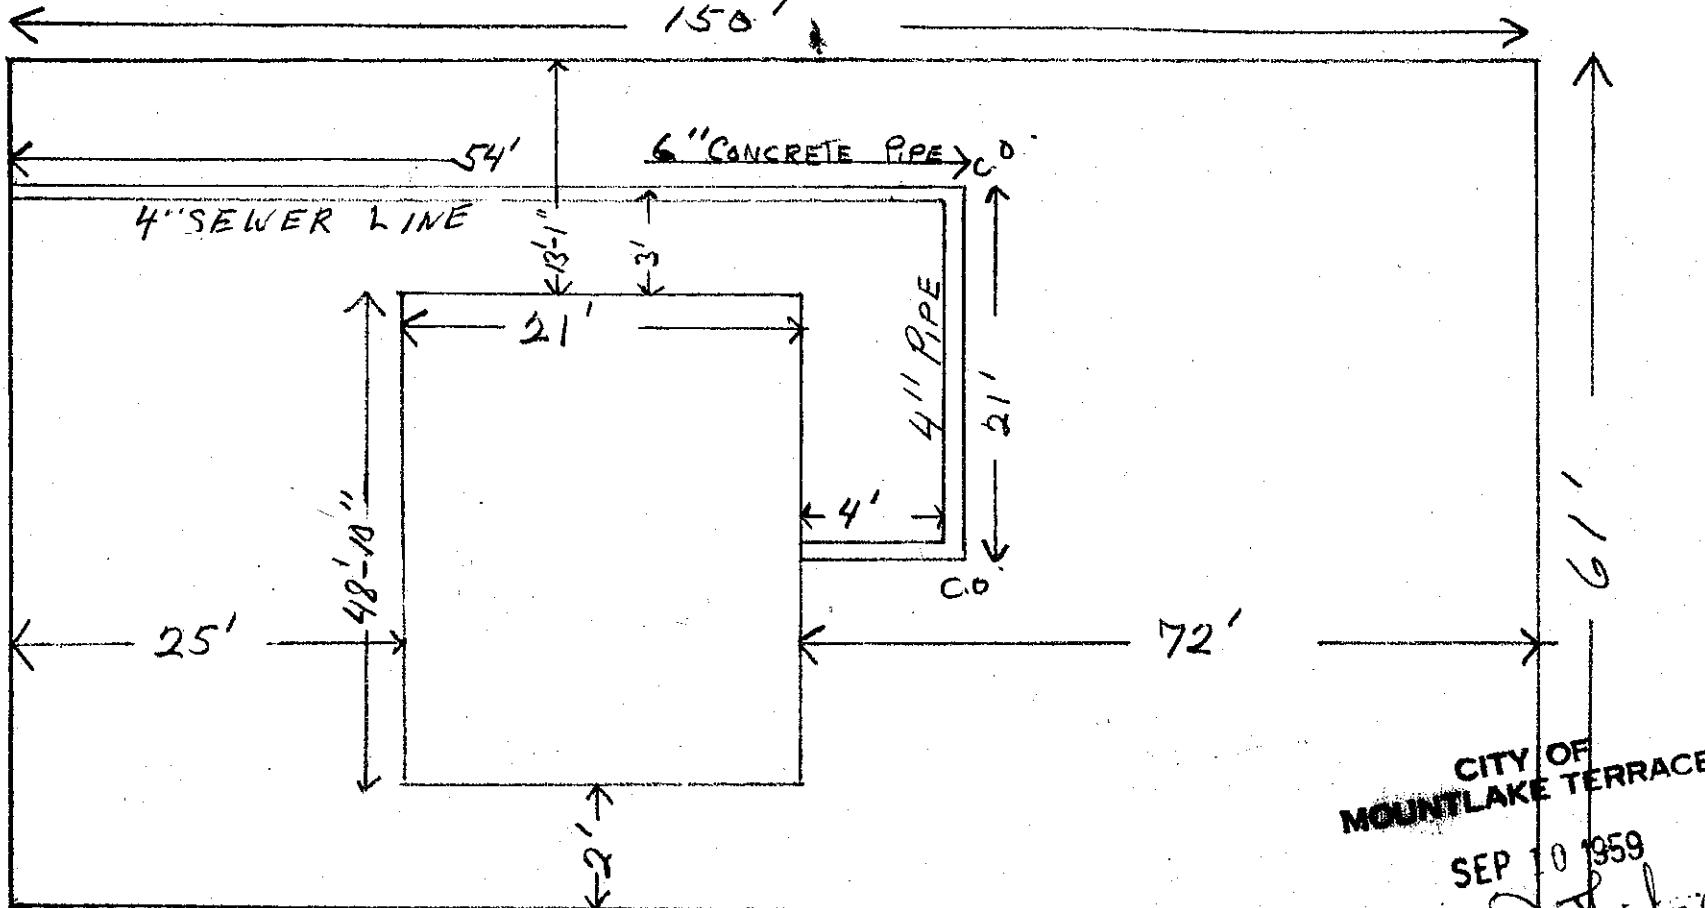CITY OF
MOUNTLAKE TERRACE

SEP 10 1959

Plan Approved

Inspected N.C.

Date

DEPOSIT, \$

BACKFILL WORK ORDER ISSUED

SEWER WORK ORDER ISSUED

Approved:

100 18/59
#4368

DATE

9/9/59 BY B. G. Lantz

3-14-60 INST CON & MFT

The City of Mountlake Terrace

APPLICATION

SIDE SEWER PERMIT

OUTSIDE INSIDE REPAIRS

CARD No.

EASEMENT No.

LAURENCE LOCATI

OWNER Lawrence Locati
HOUSE No. 23305 W. 51st

CONTRACTOR

Owner

STREET


AVENUE LOT No. 23305-W 51st

PERMIT No. 912

BLOCK No. Lot 748 Blk 6 Div 10

NAME ADD.

Property line 157'

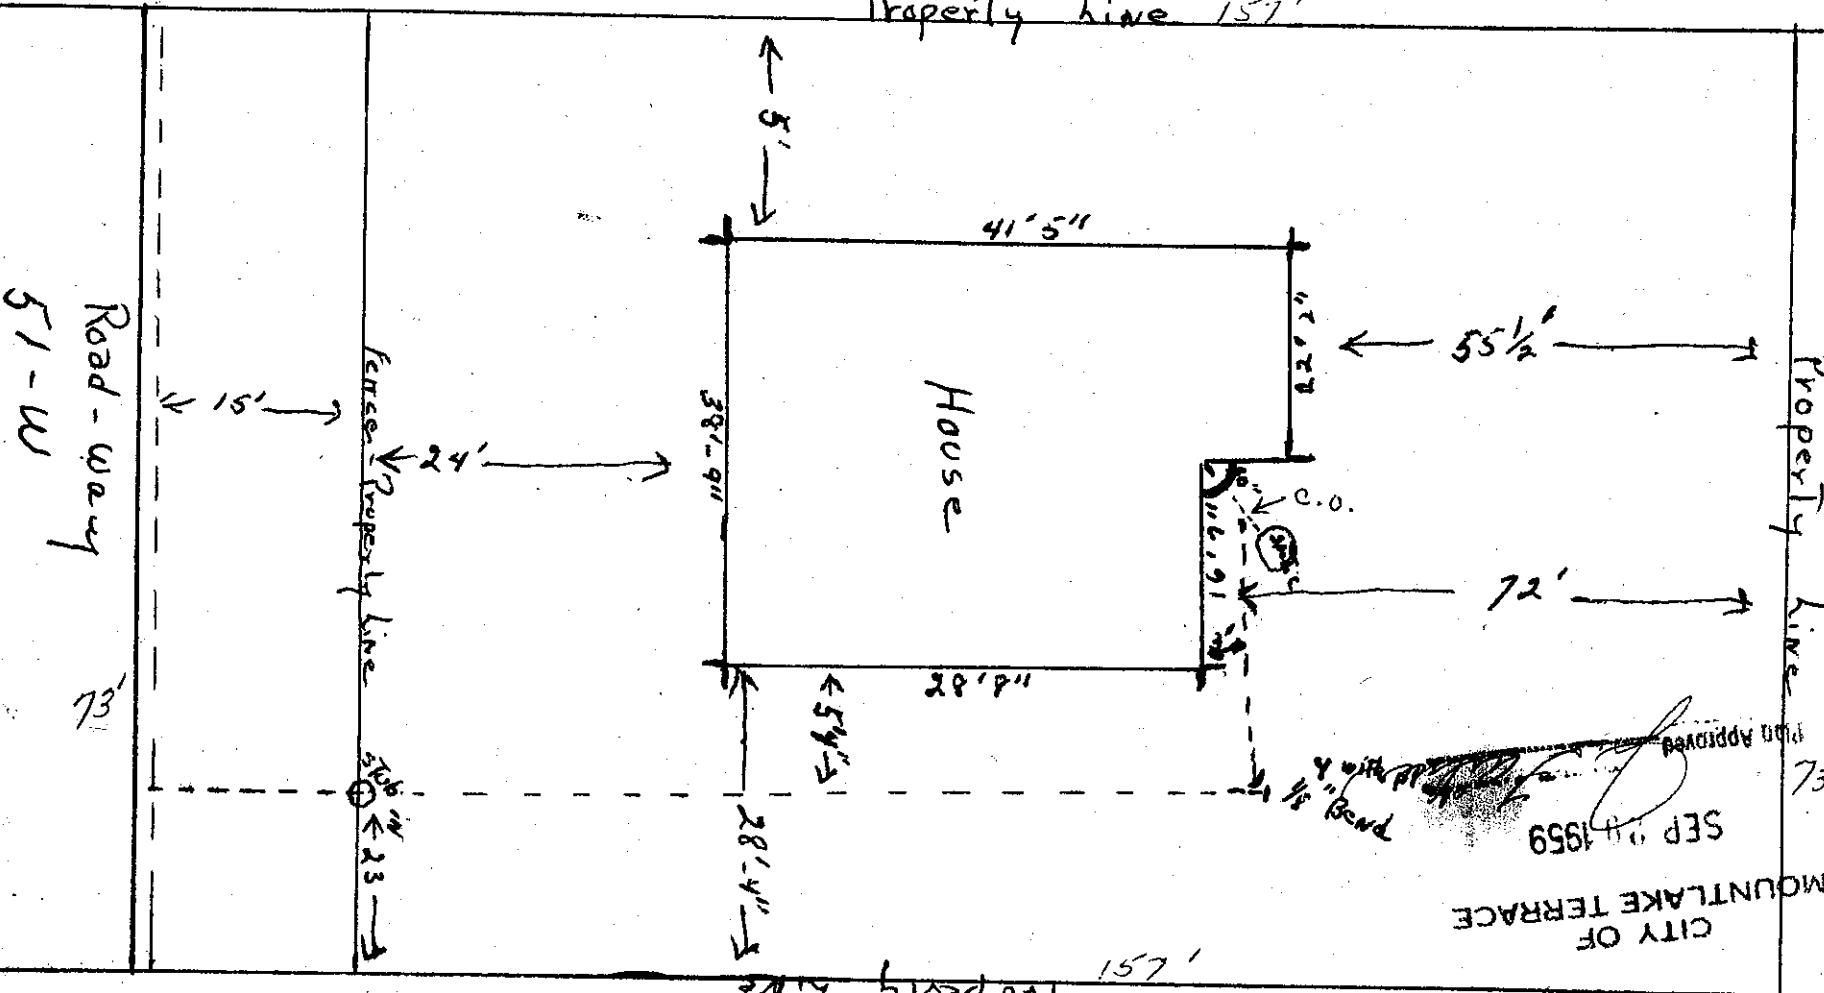

Date

BACKFILL WORK ORDER ISSUED
SEWER WORK ORDER ISSUED

DEPOSIT, \$ 10.00

Approved:

Inspected & N.C.

9/29/59
4979

DATE

9/29/59 BY (Signature)
10-3-60 INS CON & M&K

The City of Mountlake Terrace

SIDE SET PERMIT
OUTSIDE INSIDE REPAIRS

EASEMENT No. 142-823

OWNER Cronin, R. A.
HOUSE NO. 23307 - 51st W.


CONTRACTOR Wingfield

STREET
AVENUE LOT No. - 9 -

NAME ADD-

BLOCK No. ---

PERMIT No. 4-B-7

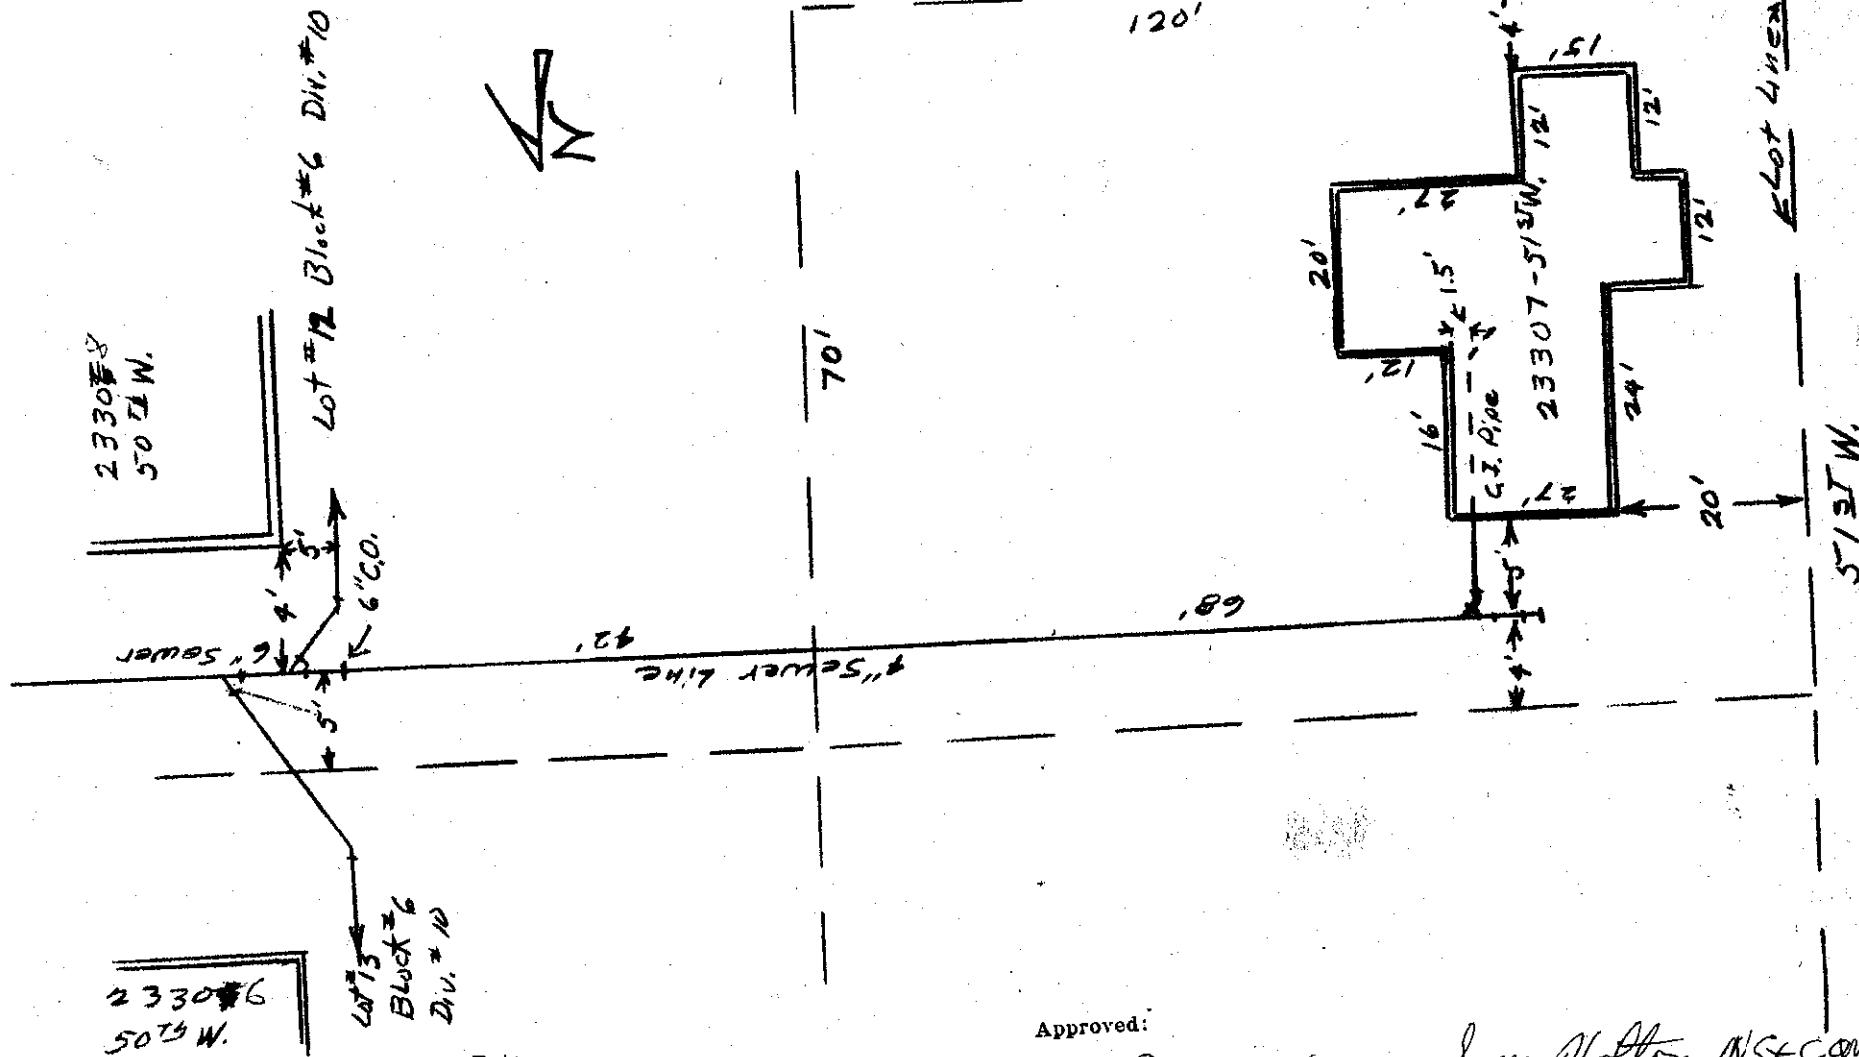

**BACKFILL WORK ORDER ISSUED
SEWER WORK ORDER ISSUED**

Date

DEPOSIT, \$ -

Approved:

DATE.

9-27-60 BY S.M. Holton MSSC

Mountlake Terrace

APPLICATION
for

SIDE SEWER PERMIT

OUTSIDE INSIDE REPAIRS

Milton A. NELSON
CARD No.

EASEMENT No.

MILTON A. NELSON

23309 - 51st LN

CONTRACTOR

SELF

PERMIT No.


2011

STREET SOUTH 7 FEET OF LOT 9

AVENUE LOT No. AND ALL OF LOT 10

BLOCK No. 6 DIV #20

NAME ADD.

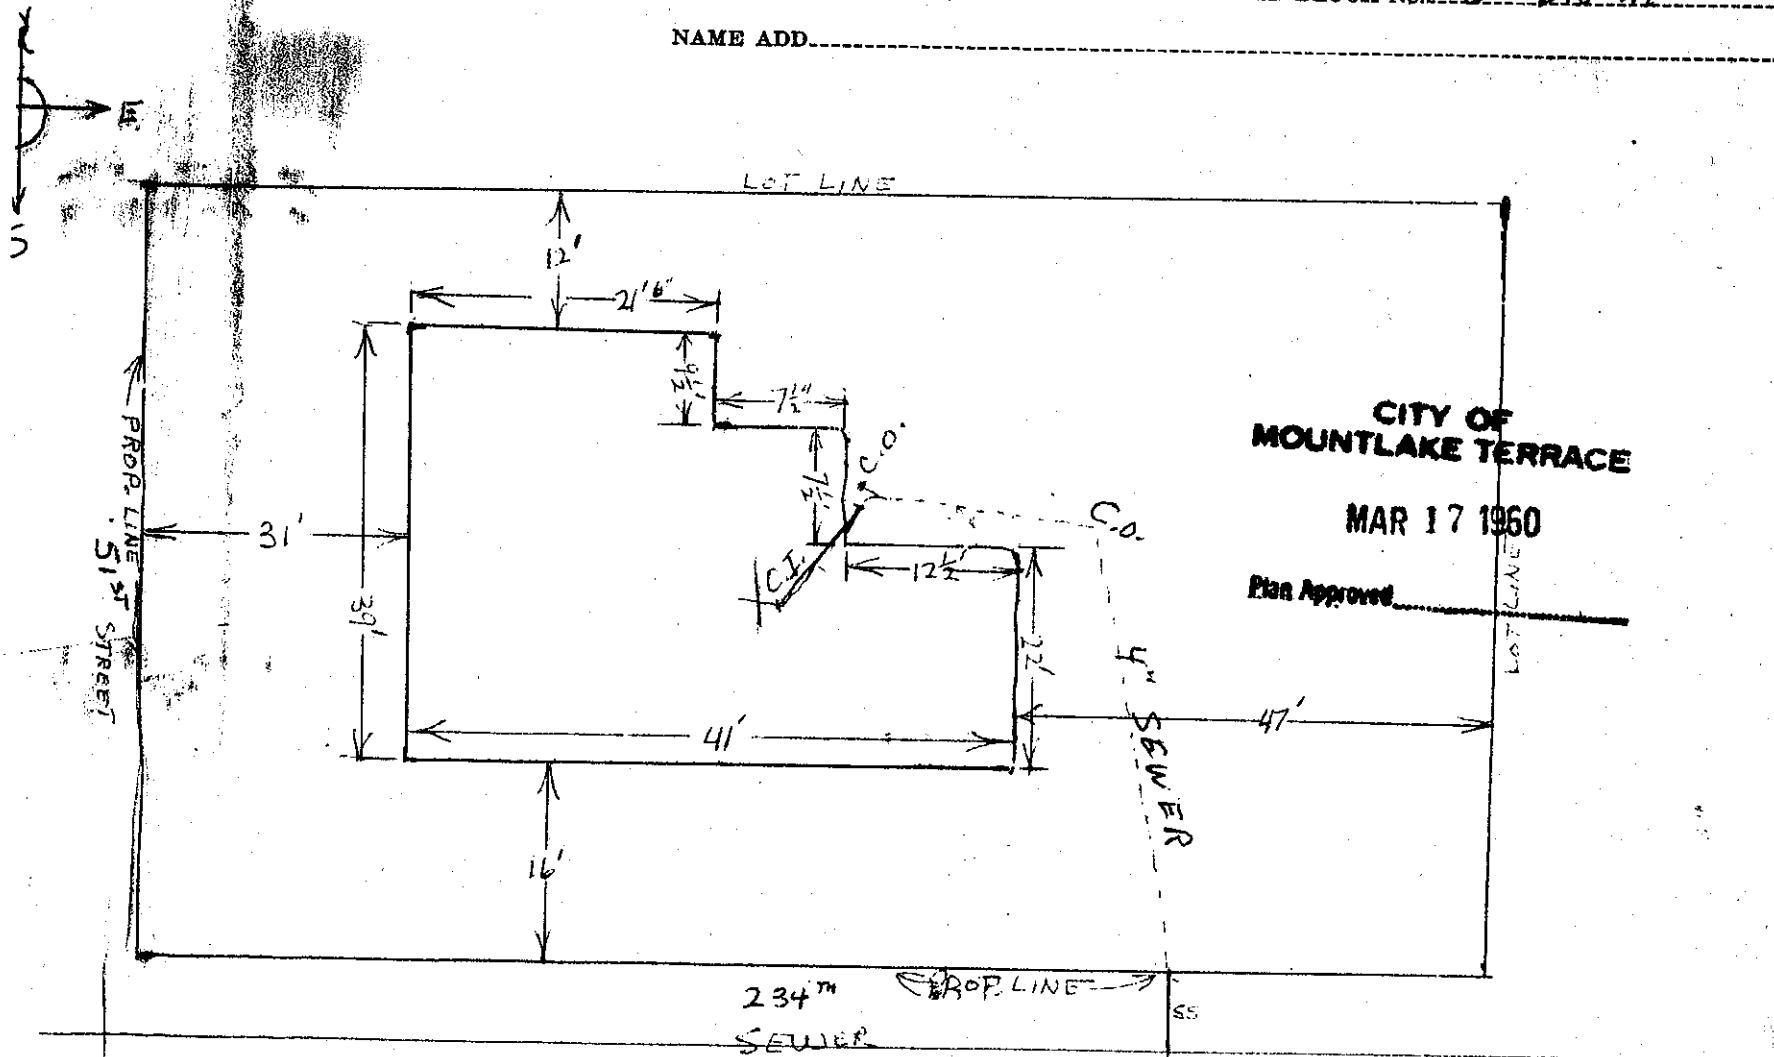

Date

Approved:

WORK ORDER ISSUED

DEPOSIT, \$10 ~~ov~~ 3-15-60


WORK ORDER ISSUED

858

DATE 3-17-60 BY S. M. Holton IV, S. C. O.

21216-52

existing
proposed 6" extension

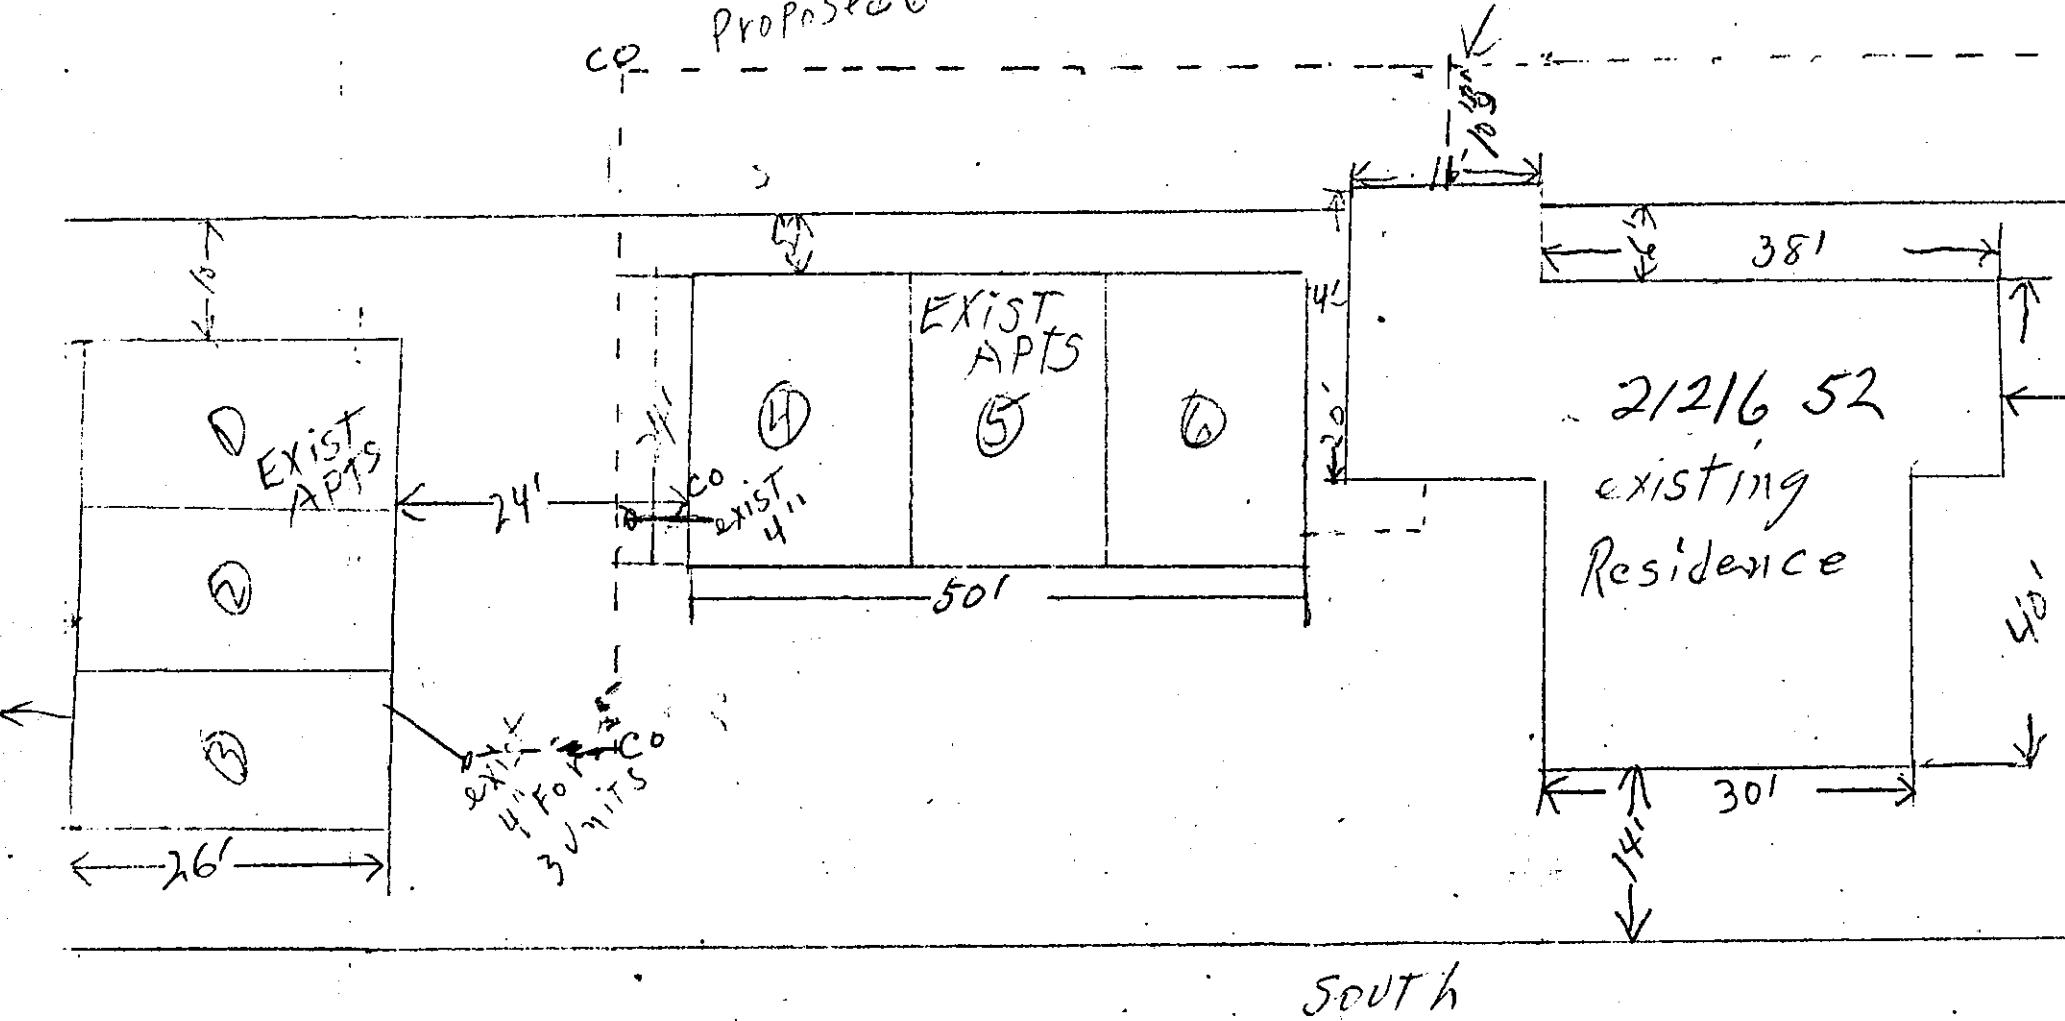

scale $\frac{1}{8}$ " = 1'

21216 - S-2 U
R. J. William

The City of Mountlake Terrace

APPLICATION

CARD No.....

SIDE SEWER PERMIT

OUTSIDE INSIDE REPAIRS

EASEMENT No.....

OWNER Hillwood Park Homes
HOUSE No. 21503 - 52 PL.


CONTRACTOR Echo Lake Builders

PERMIT No. 692

STREET AVENUE LOT No. 13

BLOCK No.

NAME ADD. Hillwood Park # 11

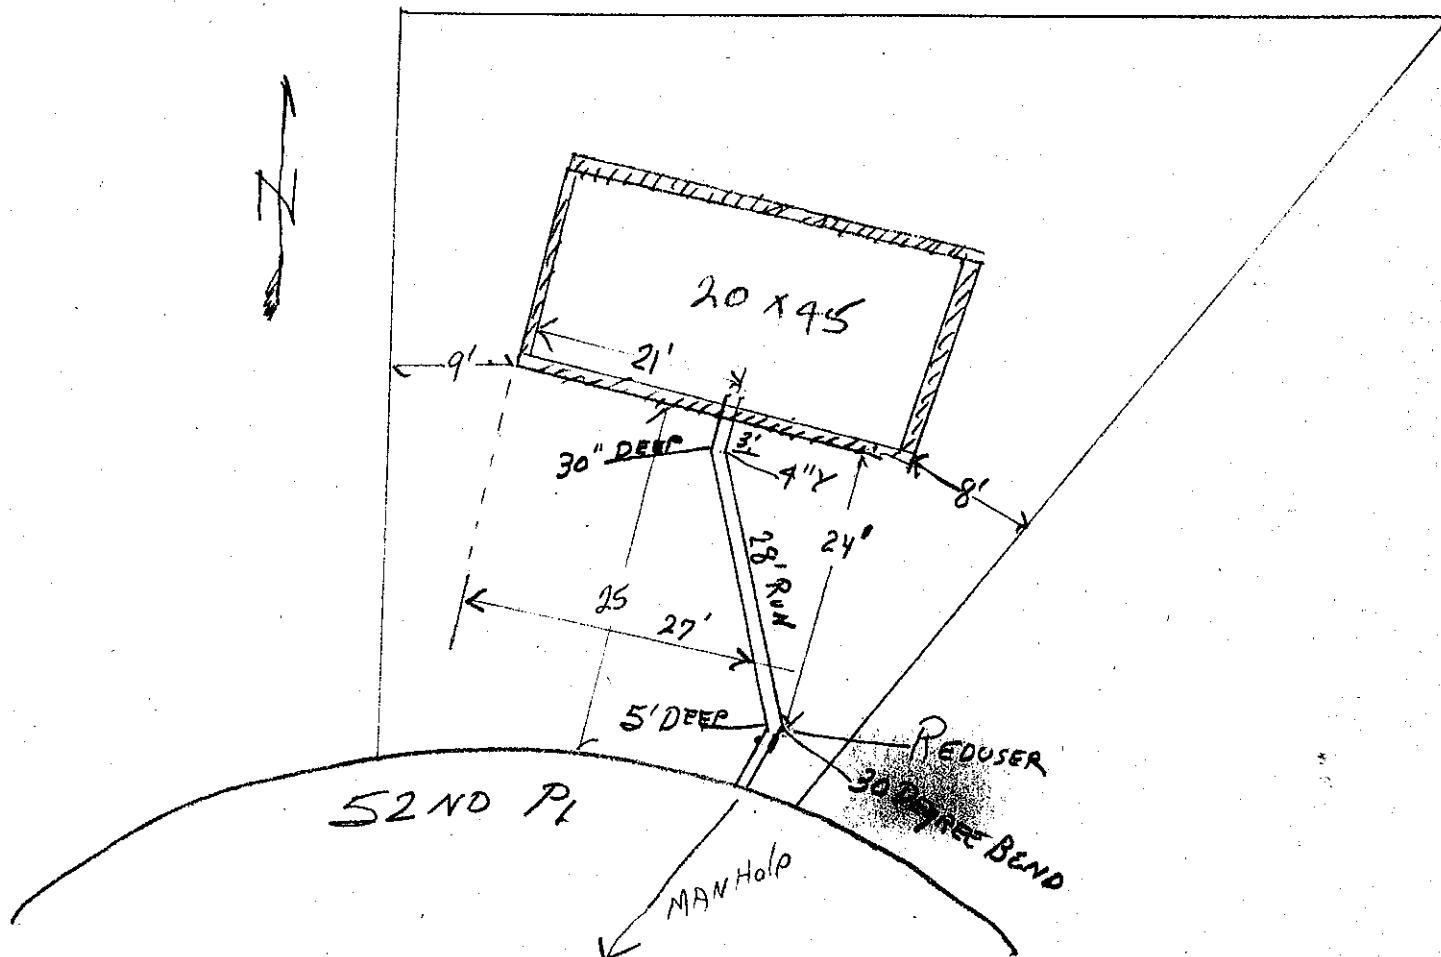

Date

Approved:

BACKFILL WORK ORDER ISSUED
SEWER WORK ORDER ISSUED

DEPOSIT, \$

DATE 3-9-61 BY S. M. Holton

The City of Mountlake Terrace

APPLICATION

CARD No.

SIDE SEWER PERMIT

OUTSIDE INSIDE REPAIRS

EASEMENT No.

OWNER Hillwood PARK HOMES
HOUSE No. 21505 - 52nd PLACE

CONTRACTOR ECHO LAKE BUILDERS


PERMIT NO. 691

STREET AVENUE LOT No.

14

BLOCK No.

NAME ADD. HILLWOOD PARK # 11

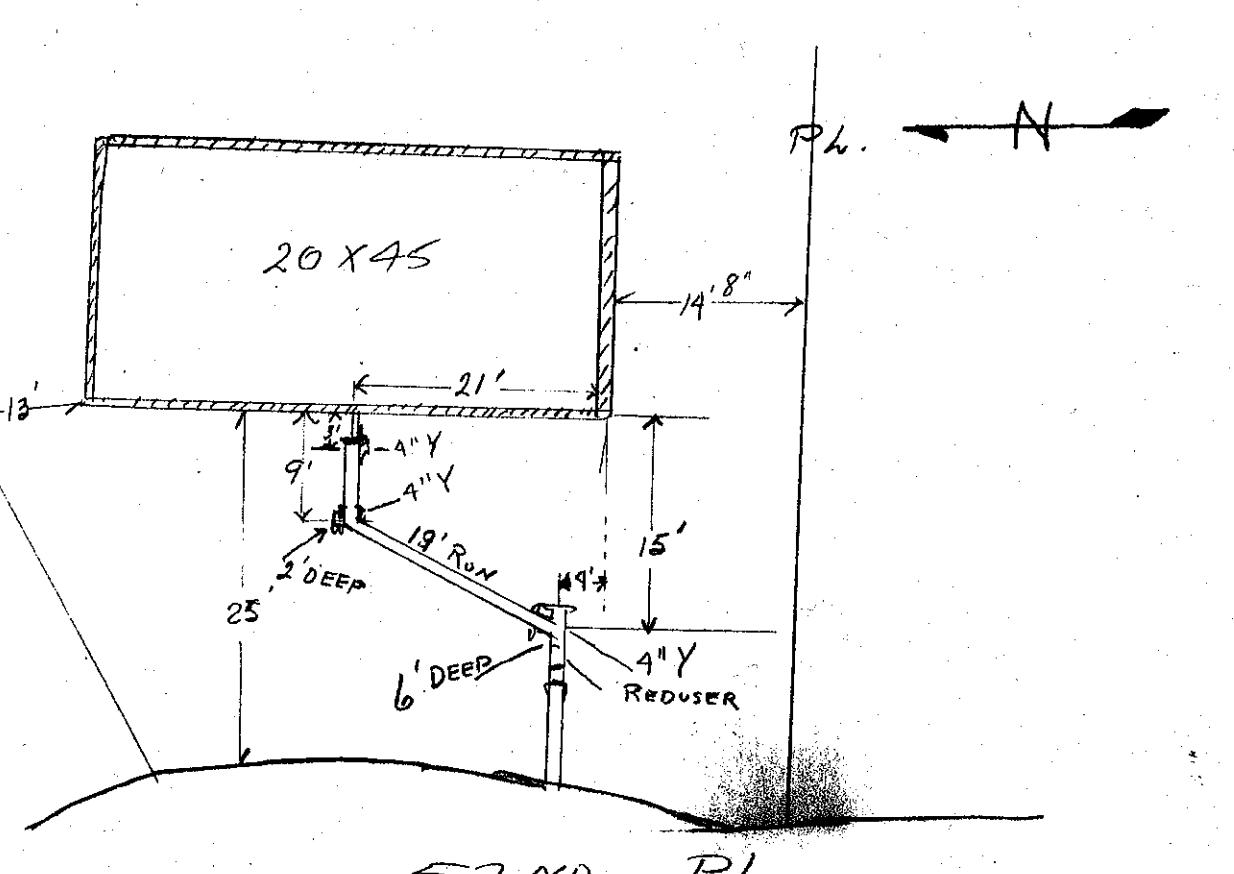

Date

BACKFILL WORK ORDER ISSUED
SEWER WORK ORDER ISSUED

DEPOSIT, \$

Approved:

DATE

3-8-61 BY *L. M. Holton*

STREET ADDRESS

STREET ADDRESS

OUTSIDE INSIDE REPAIRS

ASSMENT NO.

HORN PARK TIMES
2508 52ND PI

CONTRACTOR *Eric Lake Builders*

PERMIT NO. 696


STREET

9

AVENUE LOT No.

BLOCK NO.

NAME ADD *Horn Park*

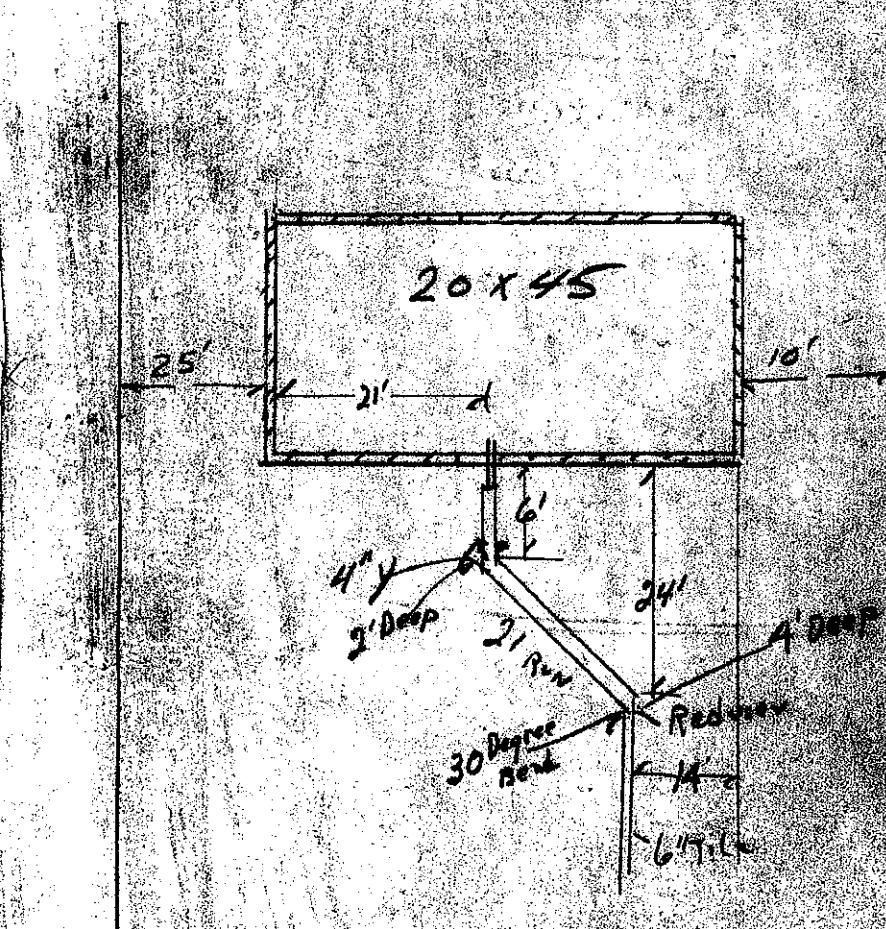

Date

Approved:

WORK ORDER ISSUED
RECEIPT ISSUED

DEPOSIT \$

DATE 3-9-61

BY

S. M. Miller

The City of Mountlake Terrace

APPLICATION

for

SIDE SEWER PERMIT

OUTSIDE INSIDE REPAIRS

J. A. ZALEWSKI

CARD No.

EASEMENT No. 1371487

OWNER FRANCIS A. ZALEWSKI

HOUSE No. 21506 - 52' x 140'

CONTRACTOR J. A. Franklin & Co.


PERMIT No. 1331

STREET

AVENUE LOT No.

BLOCK No.

NAME ADD

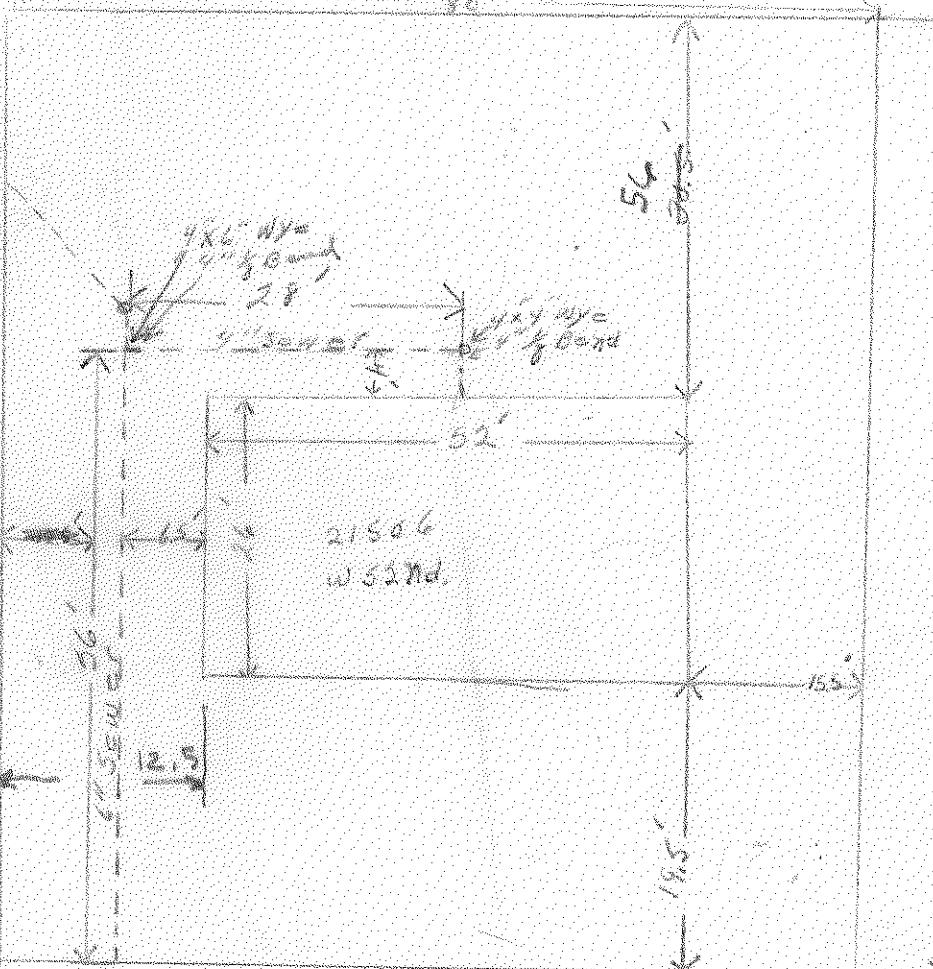

CITY OF
MOUNTLAKE TERRACE

FEB 19 1960

Plan Approved

Date

Approved:

BACKFILL WORK ORDER ISSUED
SEWER WORK ORDER ISSUED

DEPOSIT, \$10.00 paid 8-19-59

3920

DATE

2-19-60

BY

Scott McVilton WS NC

et

2-23-60 INSTANTLY

The City of Mountlake Terrace

APPLICATION
for

SIDE SEWER PERMIT

OUTSIDE INSIDE REPAIRS

E. K. MEEGAN

CARD NO.

EASEMENT No. 1360414

OWNER E. R. McEgan
HOUSE No. 21604 - 52nd W.

CONTRACTOR

STREET


AVENUE LOT No. North half of Southly of lot 2

PERMIT NO.

976

BLOCK No.


NAME ADD.

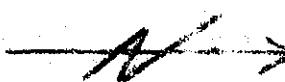

CITY OF
MOUNTLAKE TERRACE

APR 5 1960

Plan Approved

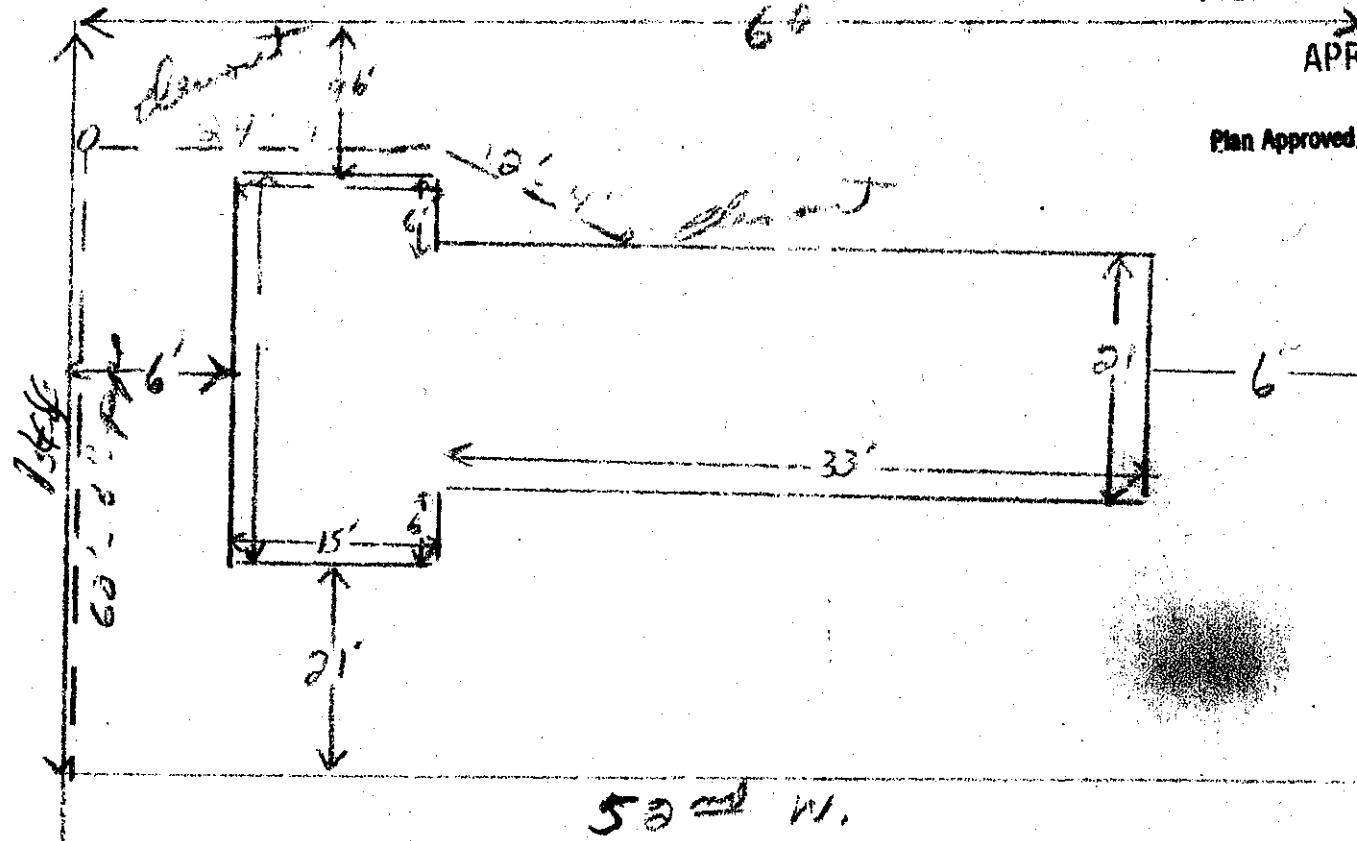

Date

BACKFILL WORK ORDER ISSUED

SEWER WORK ORDER ISSUED

DEPOSIT, \$ 10.00

Approved:

10/2/59 - August DATE

10/19/60 BY

T. W. Park & H. C.
Co. Inc.
4/4/60

The City of Mountlake Terrace

APPLICATION

CARD No.

SIDE SEWER PERMIT

OUTSIDE INSIDE REPAIRS

EASEMENT No.

OWNER: Munger Homes

CONTRACTOR: B & M Const

PERMIT NO.

HOUSE No. 21608 1/2 52nd Ave W


STREET:

AVENUE LOT No. Israel 3

BLOCK No.

NAME ADD:

Seattle Heights Gardens

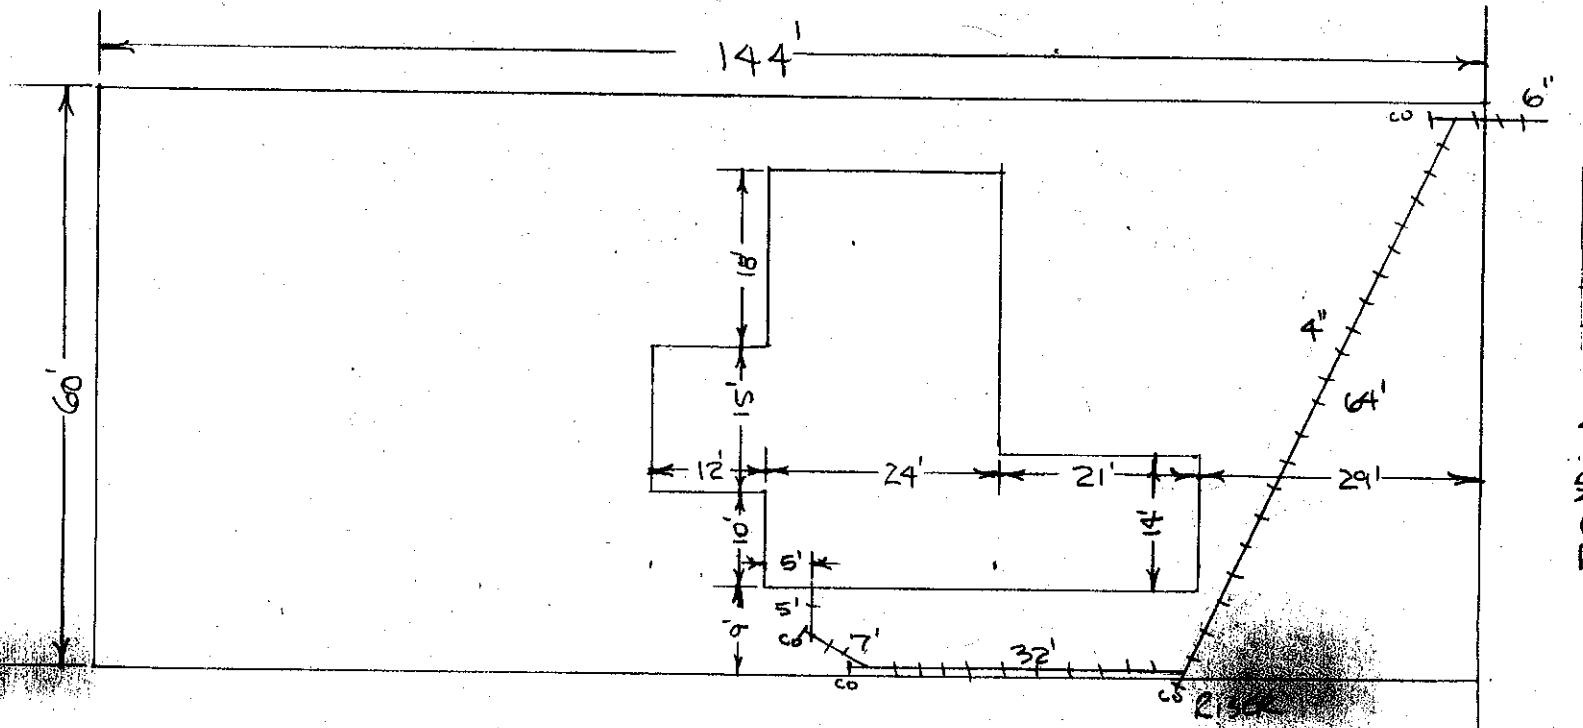

CITY OF
MOUNTLAKE TERRACE

Date

Approved:

AUG 6 1962

BACKFILL WORK ORDER ISSUED

DEPOSIT, \$

SEWER WORK ORDER ISSUED

DATE

BY: *John A. Rose*

The City of Mountlake Terrace

APPLICATION

CARD No.

SIDE SEWER PERMIT

OUTSIDE INSIDE REPAIRS

EASEMENT No.

OWNER: Mungen Homes
HOUSE No. 21610 52 Ave. W

CONTRACTOR:

B & W Const

PERMIT No.


STREET
AVENUE LOT NO.

Dract 3

BLOCK No.

NAME ADD:

Seattle Heights Gardens

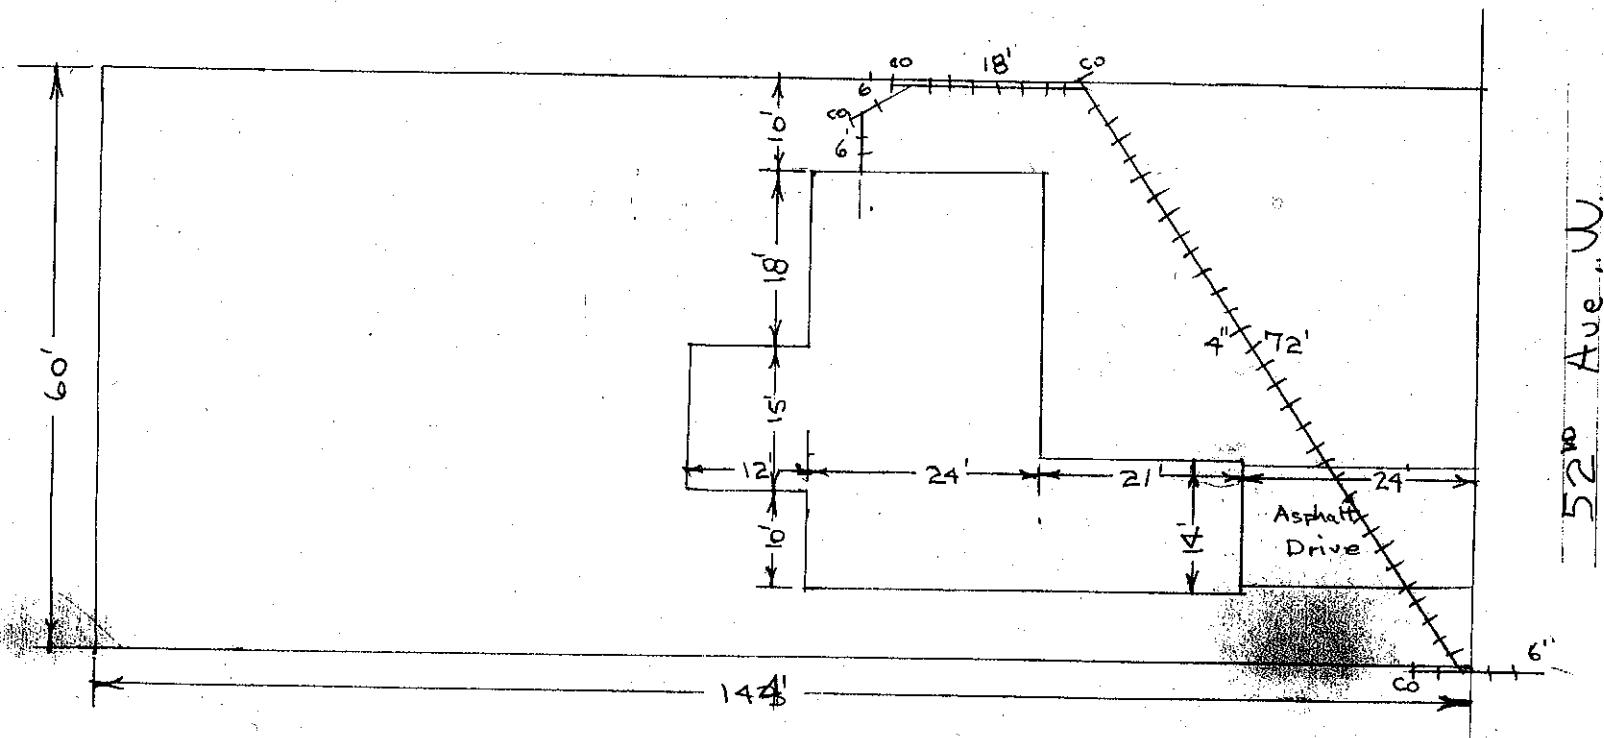

CITY OF
MOUNTLAKE TERRACE

Date

Approved:

AUG 6 1962

BACKFILL WORK ORDER ISSUED

DEPOSIT, \$

SEWER WORK ORDER ISSUED

DATE

BY

Plan Approved:

[Signature]

The City of Mountlake Terrace

APPLICATION


CARD No. *01*

SIDE SEWER PERMIT

OUTSIDE INSIDE REPAIRS

EASEMENT No. _____

OWNER *J.C. FISHER REALITY* CONTRACTOR *REDFORD & RUSSELL* PERMIT No. *386*
HOUSE No. *21702-52* STREET AVENUE LOT No. *NORTH ONE 1/2 OF E 45TH* BLOCK No. _____
NAME ADD *SENTRAL HEIGHTS BORDER #9 PLATS PHASE 14.*

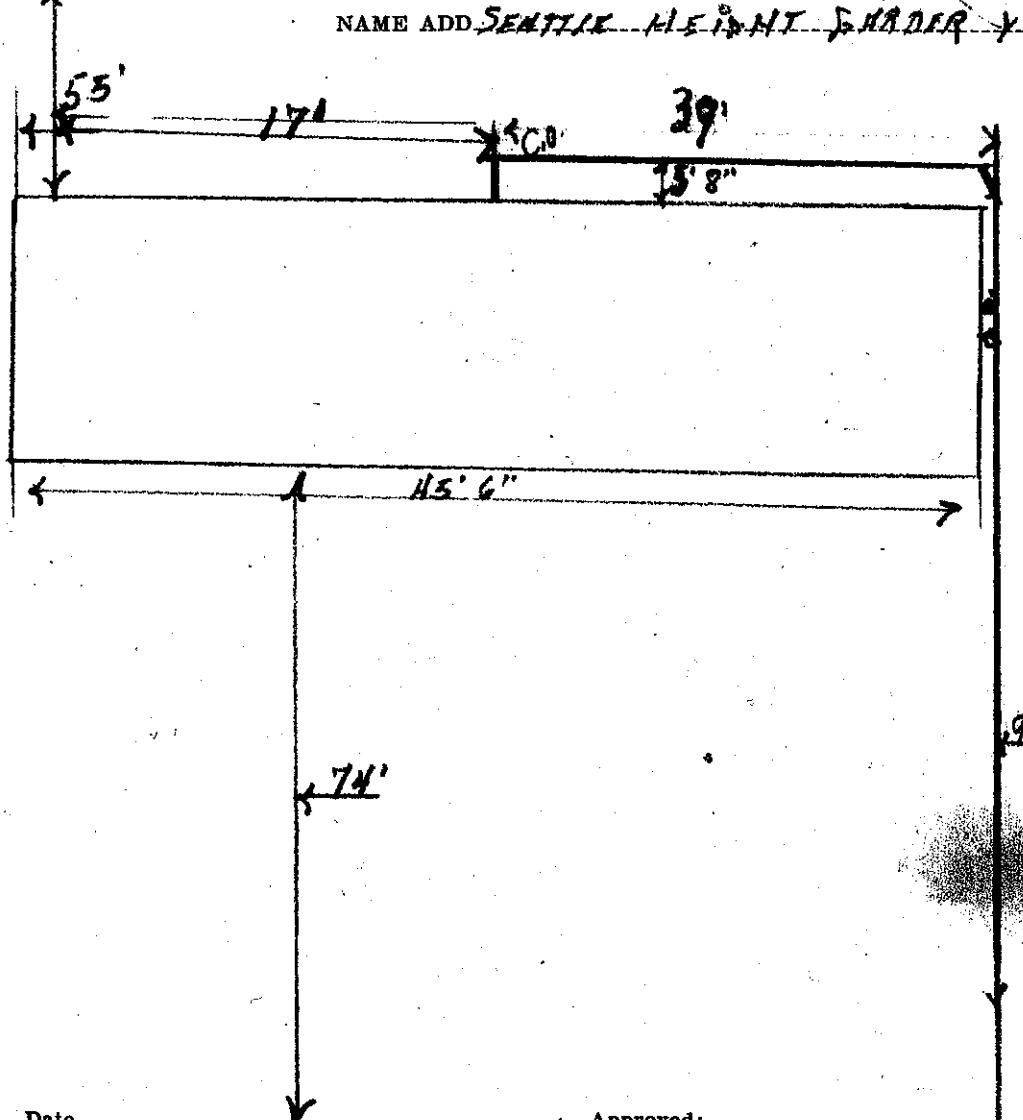

Date

Approved:

BACKFILL WORK ORDER ISSUED

SEWER WORK ORDER ISSUED

DEPOSIT, \$10.00 8/18/60

1816

DATE 8-25-60 BY

8 m. Holton INS CON

The City of Mountlake Terrace

APPLICATION

for

SIDE SEWER PERMIT

OUTSIDE INSIDE REPAIRS

Donald M. Odeh
CARD No.

EASEMENT No.

1304200

OWNER Donald M. Odeh

HOUSE No. 21903 52 W

CONTRACTOR Tamm Construction Co., Inc. PERMIT NO.


STREET

AVENUE LOT No.

BLOCK NO.

NAME ADD

Lot 25 Div 50

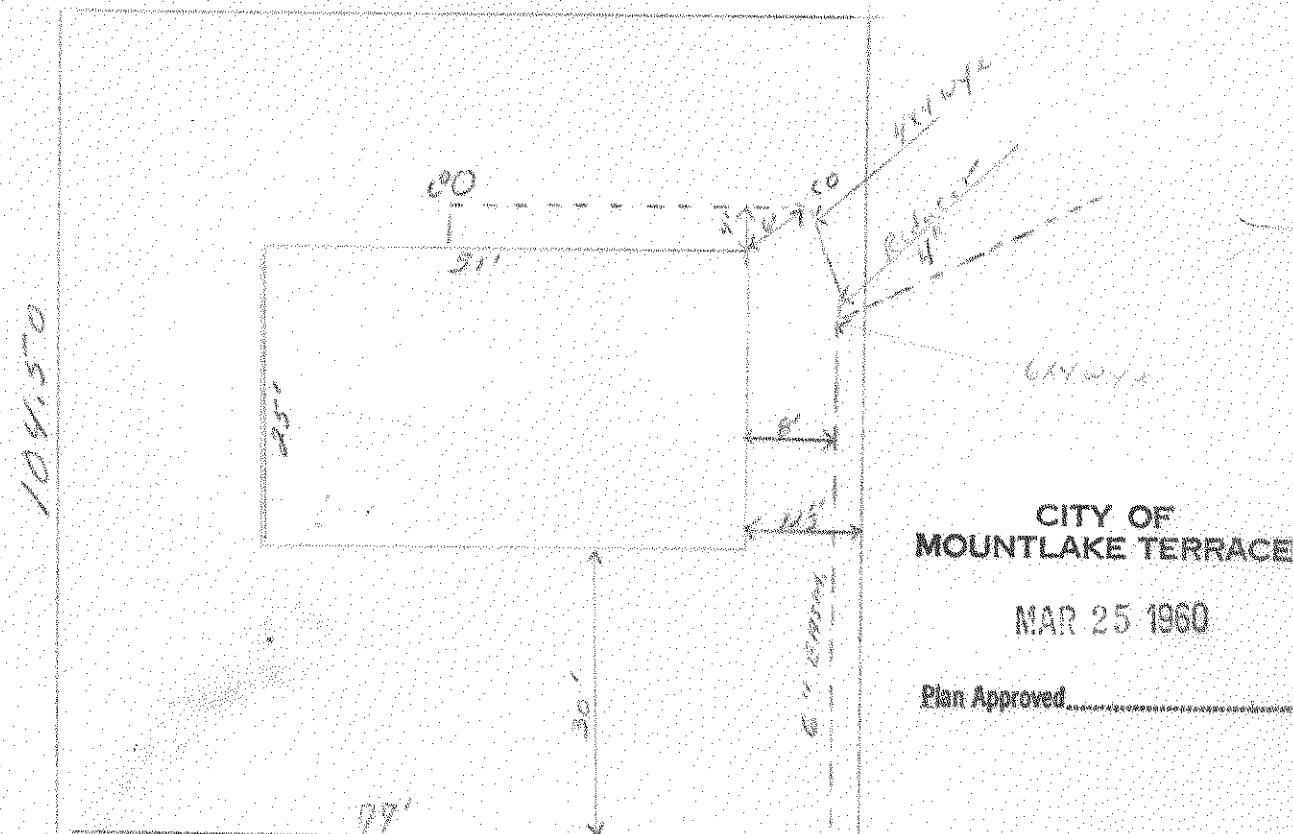

CITY OF
MOUNTLAKE TERRACE

MAR 25 1960

Plan Approved

Date

Approved:

BACKFILL WORK ORDER ISSUED

DEPOSIT, \$10.00 3/23/60

SEWER WORK ORDER ISSUED

965 DATE 3-25-60 BY S. M. Holton, M.S.C. on

The City of Mountlake Terrace

APPLICATION

CARD No.

SIDE SEWER PERMIT

OUTSIDE INSIDE REPAIRS

EASEMENT No. None

OWNER Laura Olson

HOUSE No. 21709 - 52nd W.

CONTRACTOR Wingfield City


PERMIT No. 511

STREET Avenue LOT No. S.E. 8 of 24

BLOCK No.

NAME ADD.

Seattle Heights Gardens

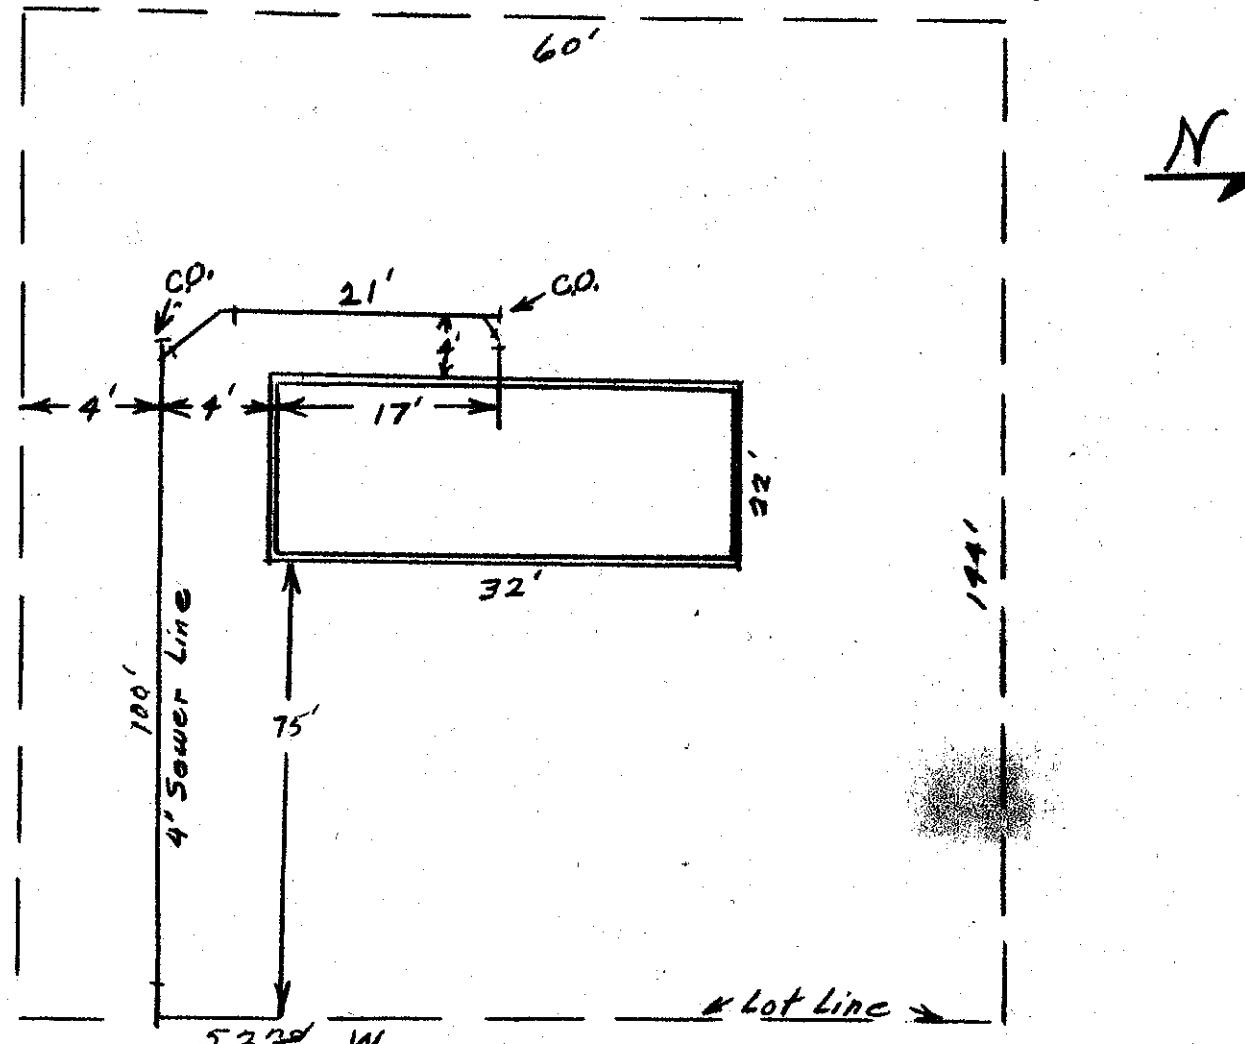

Date

Approved:

DEPOSIT, \$10.00 10/14/60

1949

DATE 10-14-60

BY S.M. Holton INS CON

BACKFILL WORK ORDER ISSUED

SEWER WORK ORDER ISSUED

The City of Mountlake Terrace

APPLICATION

To

SIDE SEWER PERMIT

OUTSIDE INSIDE REPAIRS

CARD No.


EASEMENT No. 1384200

OWNER JOHN L GROOM
HOUSE No. 21705 52 West

CONTRACTOR Tucker Coast Co. PERMIT No. 2145

STREET AVENUE LOT No. 34 BLOCK No.

NAME ADD Div 20

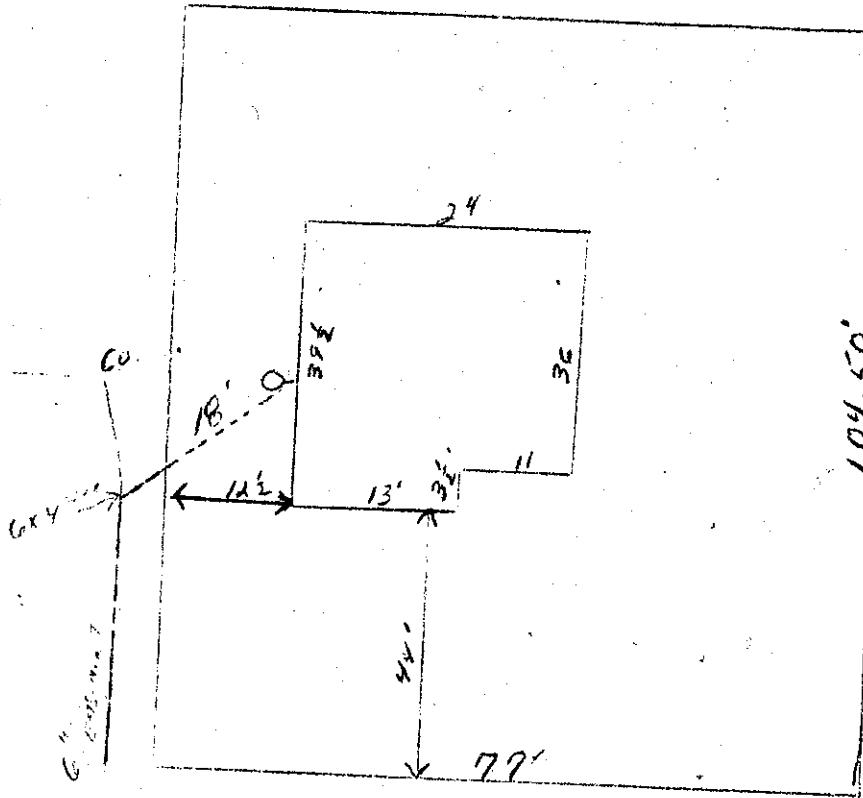

CITY OF
MOUNTLAKE TERRACE

MAR 25 1960

Plan Approved.....

BACKFILL WORK ORDER ISSUED
SEWER WORK ORDER ISSUED

Date

DEPOSIT \$10.00 3/23/60

Approved:

965-

DATE 3-25-60 BY S. M. Holton INS+CON

The City of Mountlake Terrace

APPLICATION

CARD No.

SIDE SEWER PERMIT

OUTSIDE INSIDE REPAIRS

EASEMENT No.

OWNER Claude S. Burke

HOUSE No. 21706 52 W.

CONTRACTOR out

PERMIT No. 2455

STREET N.E. 6th of TRACT 5 BLOCK No. 5
AVENUE LOT No.


NAME ADD.

* SEATTLE HTS GARDENS

61'

21'

144'

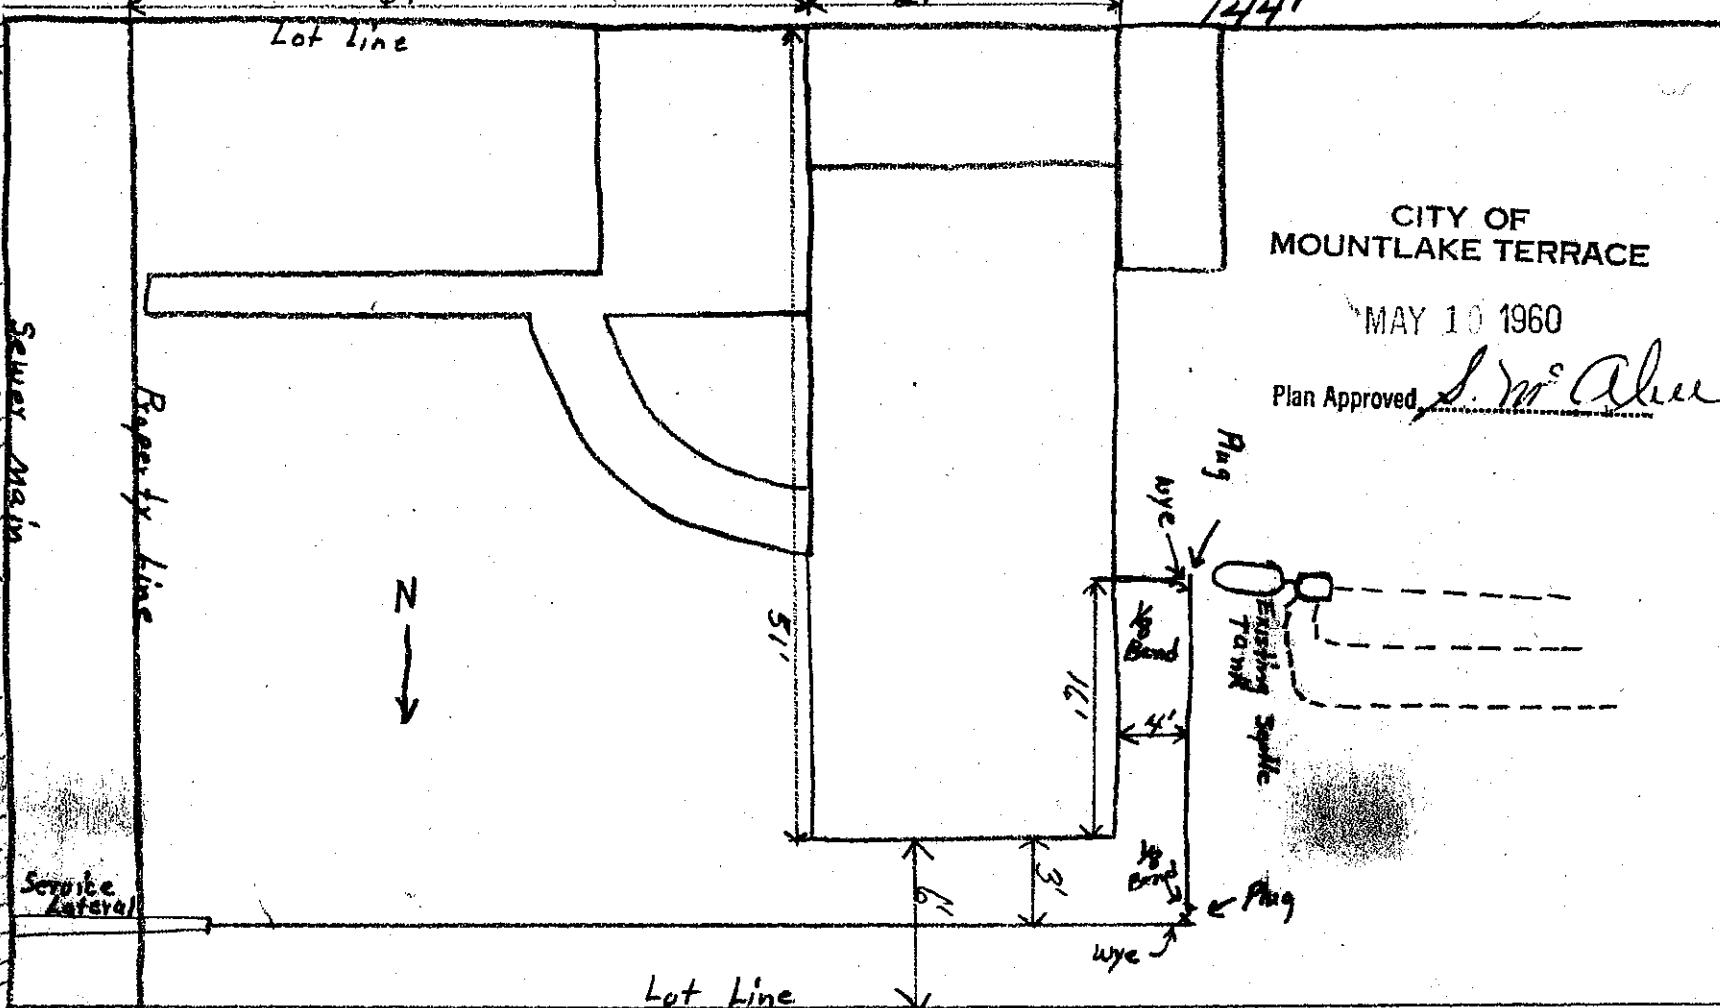

165

Date

Approved:

BACKFILL WORK ORDER ISSUED

SEWER WORK ORDER ISSUED

DEPOSIT, \$ 10.00

DATE 5-10-60 BY S. M. Holton, NSCEC

1245

The City of Mountlake Terrace

APPLICATION

Roy Roy
CARD No.

SIDE SEWER PERMIT

OUTSIDE INSIDE REPAIRS

EASEMENT No.

OWNER Roy Roy

HOUSE No. 21707 52 West

CONTRACTOR TUCKER CONST CO

PERMIT NO. 2411

STREET


AVENUE LOT No.

LOT 33

BLOCK No.

NAME ADD

Div 20

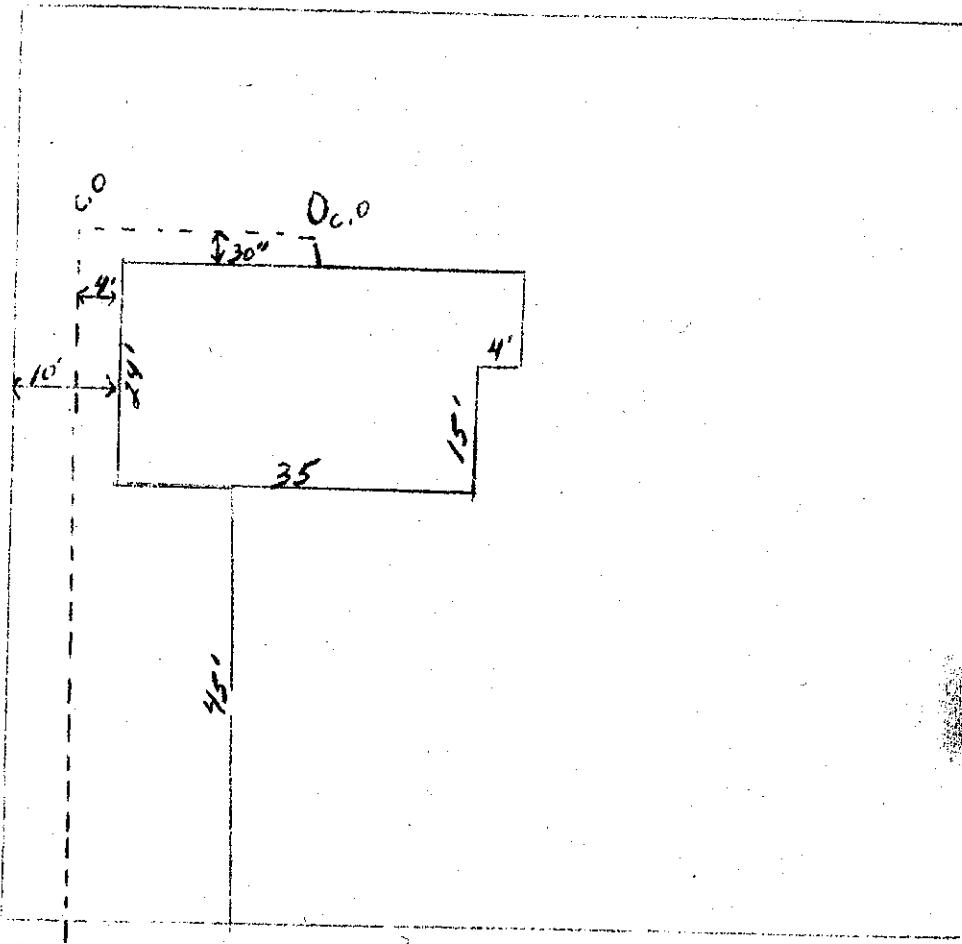

CITY OF
MOUNTLAKE TERRACE

APR 8 1960

Approved

Date

Approved:

BACKFILL WORK ORDER ISSUED
SEWER WORK ORDER ISSUED

DEPOSIT \$10.00 4/5/60

1198

DATE

4/8/60

BY

The City of Mountlake Terrace

APPLICATION

CARD No.

SIDE SEWER PERMIT

OUTSIDE INSIDE REPAIRS

CITY

EASEMENT No. None

OWNER 21709 - 52nd W

HOUSE No. V.R. Miller

CONTRACTOR

Wing field

PERMIT No.

5419


STREET

AVENUE LOT No.

32

BLOCK No. 20

NAME ADD.

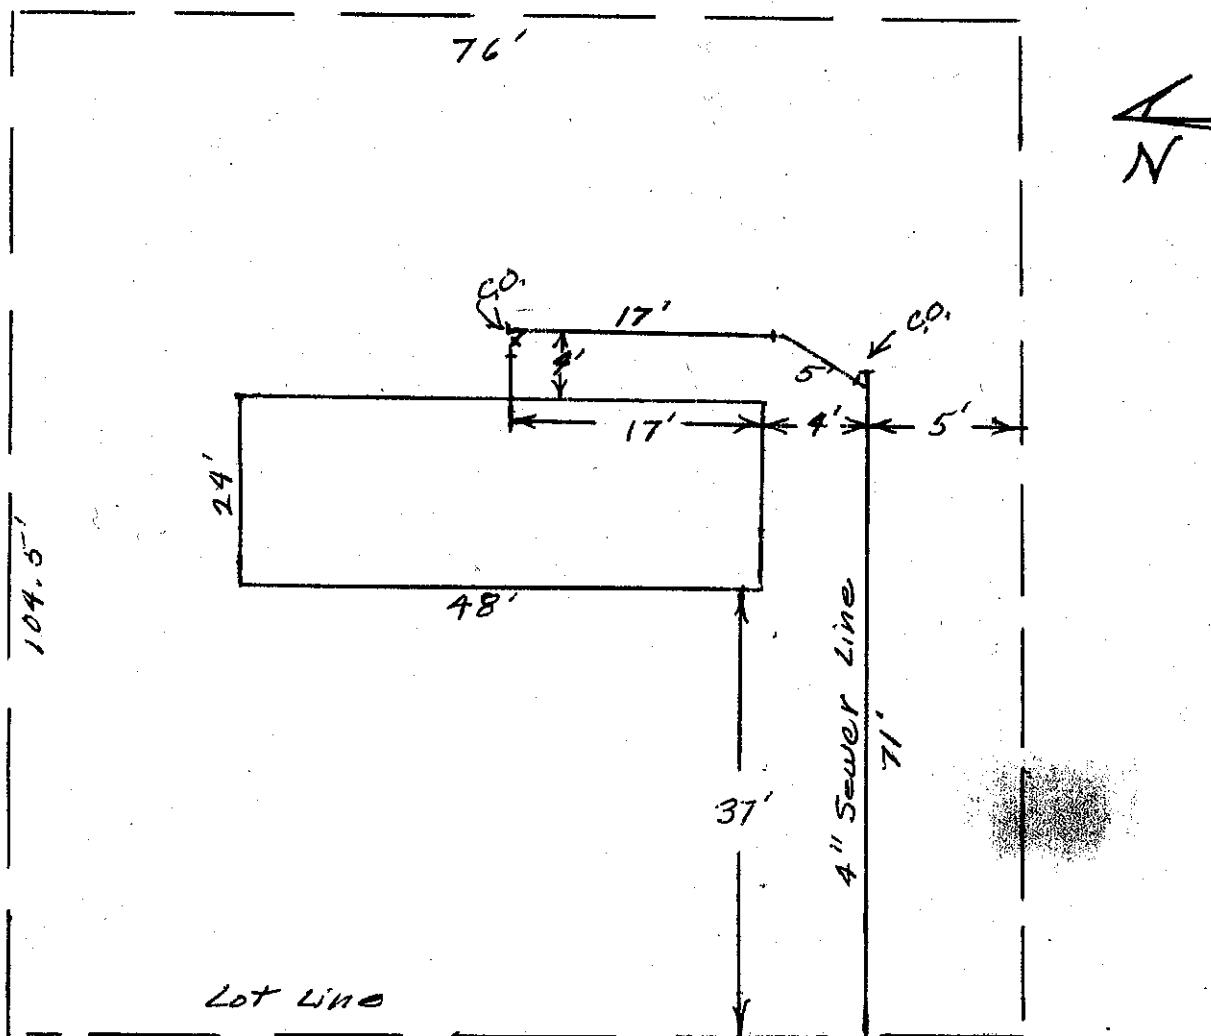

LOT LINE

52nd W.

Date

Approved:

BACKFILL WORK ORDER ISSUED

DEPOSIT, \$10.00 1446

SEWER WORK ORDER ISSUED

1993

DATE 11/1/60

BY Arthur E. Trulson

The City of Mountlake Terrace

APPLICATION

ALVIN DUNA YN
CARD No.

SIDE SEWER PERMIT

OUTSIDE INSIDE REPAIRS

EASEMENT No.

OWNER Alvin N. Dunakin

HOUSE No. 21801 52nd w Mountlake

CONTRACTOR

TOP NOTch Plumbing


86

STREET

AVENUE LOT No. 31

BLOCK No.

NAME ADD. Mountlake Terr. #20

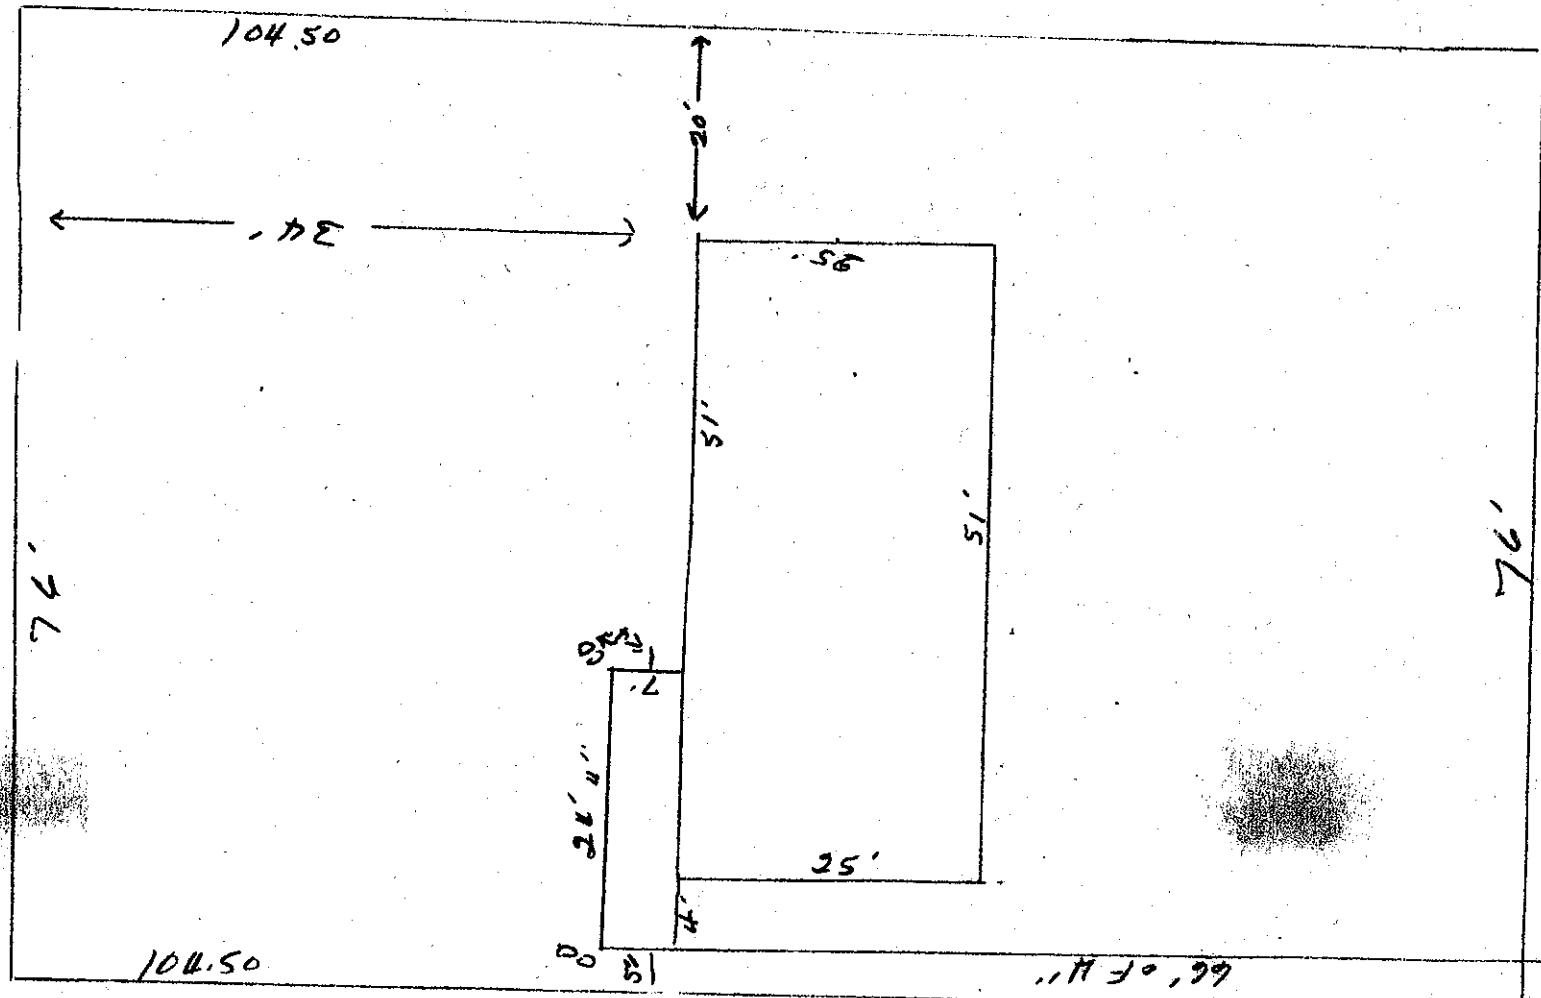

Date

BACKFILL WORK ORDER ISSUED

SEWER WORK ORDER ISSUED

Approved:
DEPOSIT, \$10.00 5/24/60

1521 DATE 5/25/60

BY J. Moore

The City of Mountlake Terrace

APPLICATION

H-11 JUN 1960

CARD No.

SIDE SEWER PERMIT

OUTSIDE INSIDE REPAIRS

EASEMENT No.

OWNER Albert A. JUNDT

CONTRACTOR

HOUSE NO. 21804 - 52nd Ave. W.

STREET

AVENUE LOT NO. NE 1/4 Lot 7


NAME ADD.

S.H. Gardens

PERMIT NO.

2479

BLOCK No.

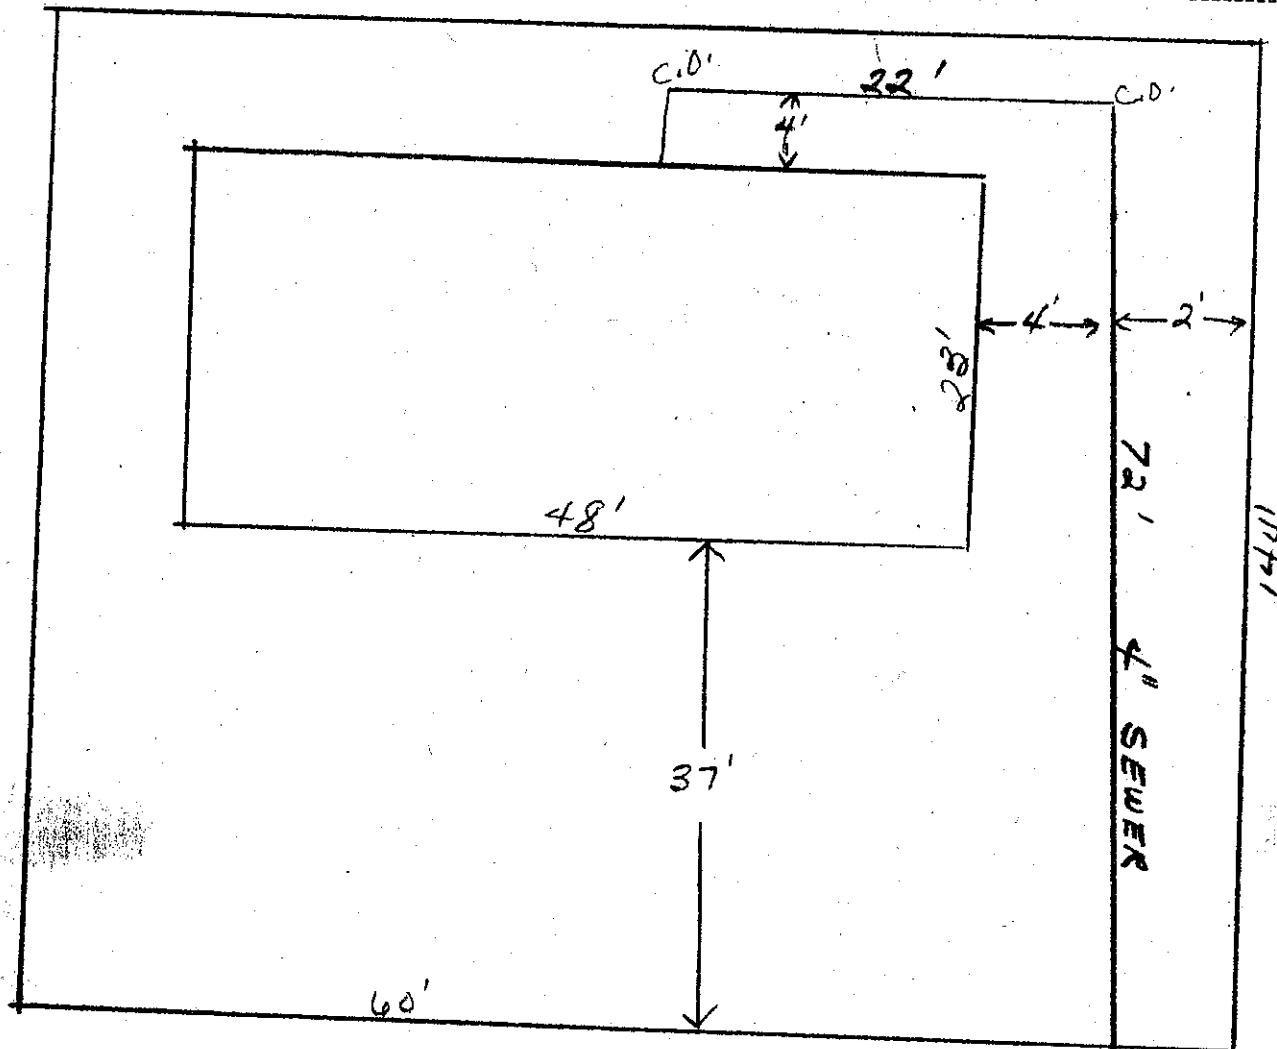

Date

BACKFILL WORK ORDER ISSUED

DEPOSIT, \$ 10.00 Approved:

SEWER WORK ORDER ISSUED

4/14/60

1267

DATE 4-28-60

BY S.M. Holton

The City of Mountlake Terrace

APPLICATION

A. J. LANDRETH
CARD No. _____

SIDE SEWER PERMIT

OUTSIDE INSIDE REPAIRS


EASEMENT No. None

OWNER A.J. Landreth
HOUSE No. 21808 - 52nd W.

CONTRACTOR Wingfield - Brown PERMIT No. 159

STREET
AVENUE LOT No. E 1/2 of N. 1/2 of #8 BLOCK No. _____

NAME ADD. Seattle Heights Gardens

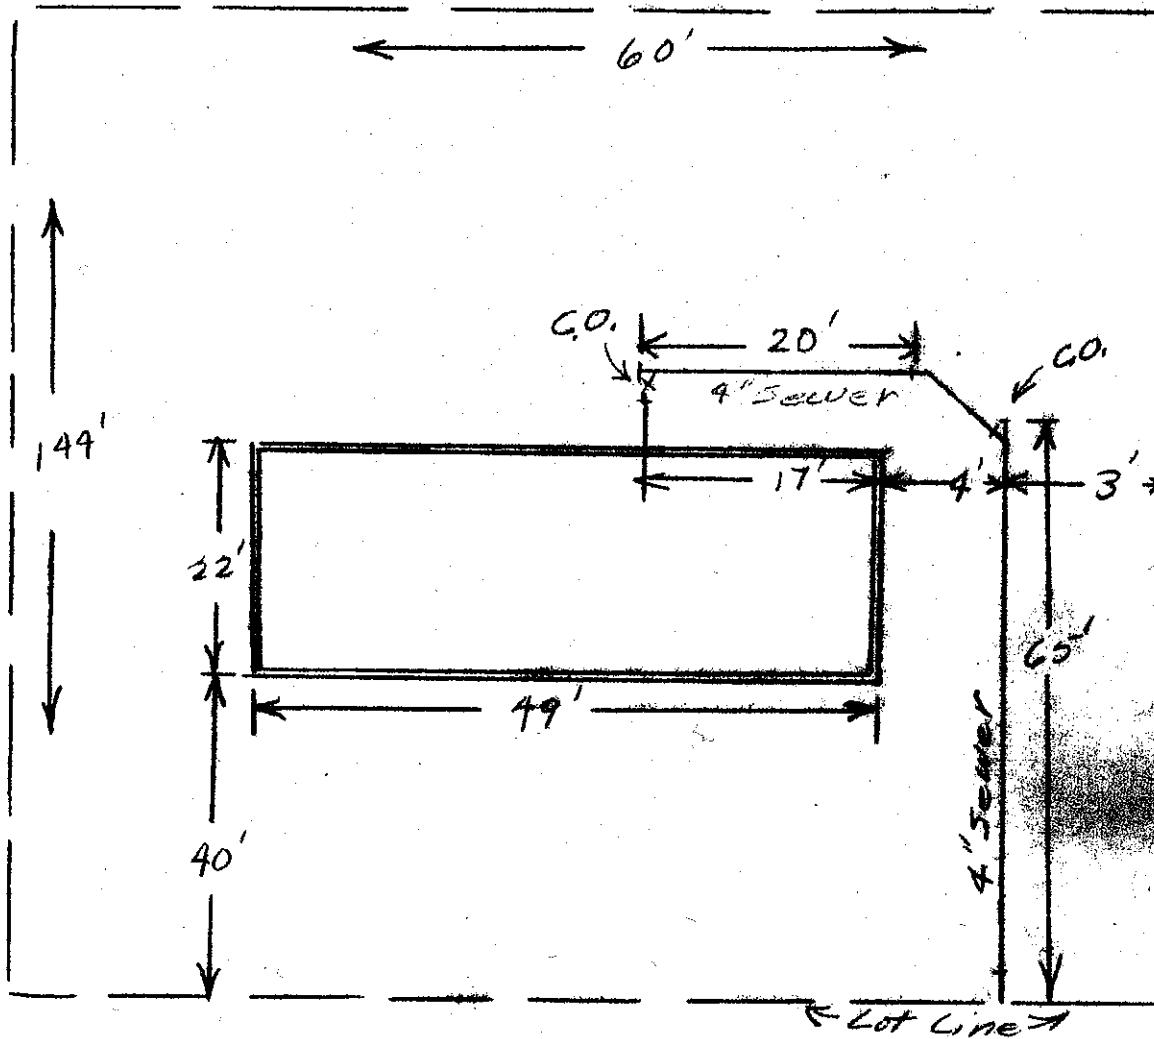

Date

Approved:

BACKFILL WORK ORDER ISSUED
SEWER WORK ORDER ISSUED

DEPOSIT, \$10.00 6/3/60
159/

DATE

6/9/60 BY J. Ellmore

The City of Mountlake Terrace

APPLICATION

(2) H. E. Golder
CARD No.

SIDE SEWER PERMIT

OUTSIDE INSIDE REPAIRS

EASEMENT NO. 1520

OWNER

H. E. Golder

HOUSE NO.

21900 52 W

CONTRACTOR

Evergreen Const.

PERMIT NO.

STREET

1/2 of C. 1/2 of Lot #8

1520


AVENUE LOT NO.

BLOCK NO.

NAME ADD.

Seattle Heights Gardens

← 60' →

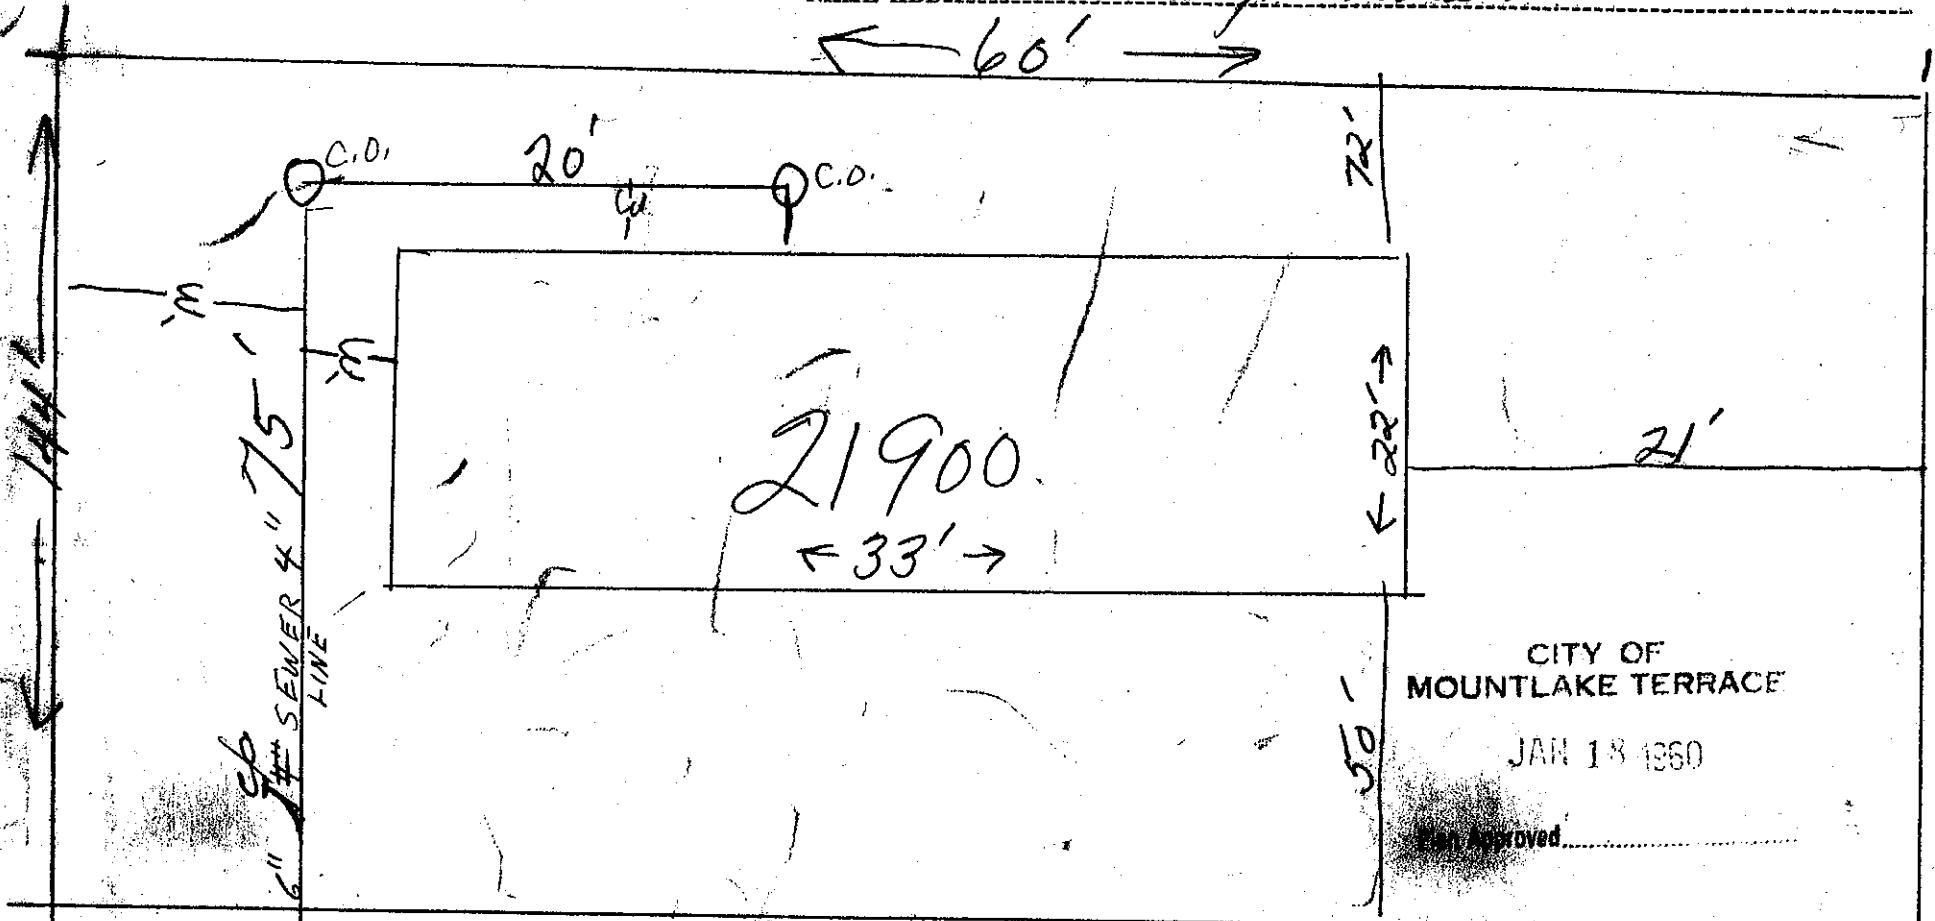

CITY OF
MOUNTLAKE TERRACE

JAN 18 1960

Approved

Approved: 9-15-60 Scott M Holton, NSCO
DATE: Jan. 18, 1960 BY H. P. DeLaveaga
rec. 548 1-19-1-10 100-11-8 m PL

Date

DEPOSIT \$ 10.00

1/18/60

BACKFILL WORK ORDER ISSUED
SEWER WORK ORDER ISSUED

The City of Mountlake Terrace

APPLICATION

J.R. Barry, Jr.

CARD No.

SIDE SEWER PERMIT

OUTSIDE INSIDE REPAIRS

EASEMENT No.

OWNER JACQUES R. & JOAN N. BARRY JR.
HOUSE NO. 21904 - 52 NW

CONTRACTOR OWNER


STREET
AVENUE LOT NO. SE 1/4 9

NAME ADD.

PERMIT No. 95

BLOCK No.

Seattle Heights, Gardens

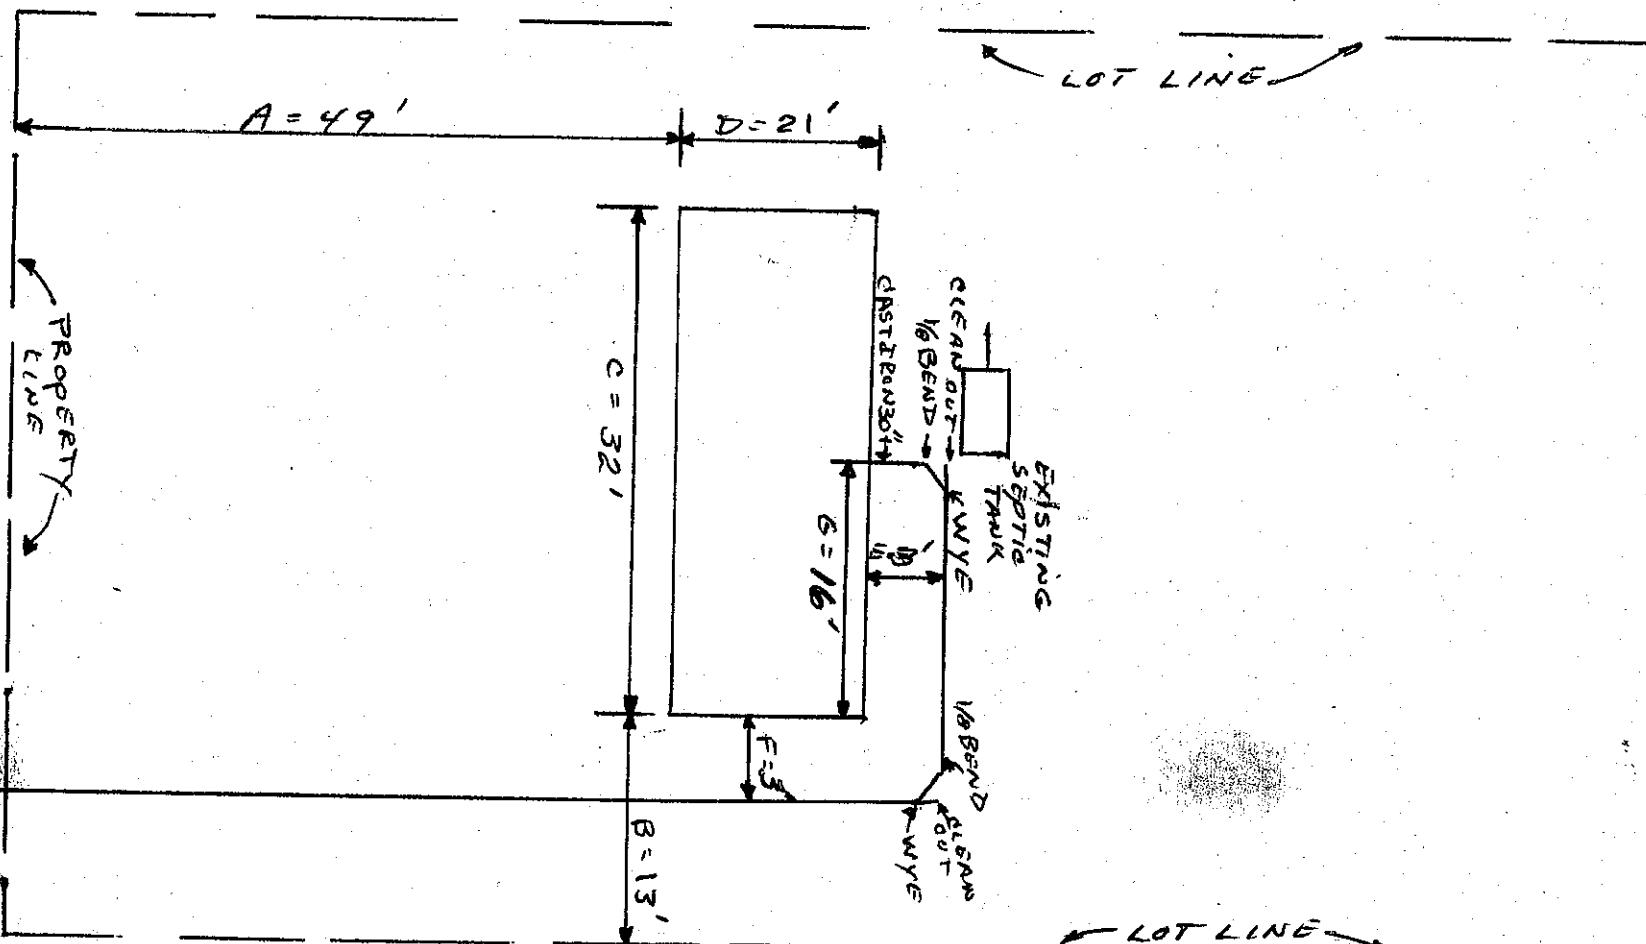

Date

Approved:

BACKFILL WORK ORDER ISSUED

DEPOSIT, \$10.00

5/25/60

WER WORK ORDER ISSUED

15-22

DATE

5/31/60 BY

J. Morris

The City of Mountlake Terrace

APPLICATION

Douglas Goughy
CARD No.

SIDE SEWER PERMIT


OUTSIDE INSIDE REPAIRS

EASEMENT No.

OWNER DOTTIE KAS GOUGHY
HOUSE No. 21906 52W

CONTRACTOR RATTNER CONSTRUCTION PERMIT NO. 2480
STREET
AVENUE LOT No. ~~10~~ NET of track 10 decimal high gardens
BLOCK No.

NAME ADD.

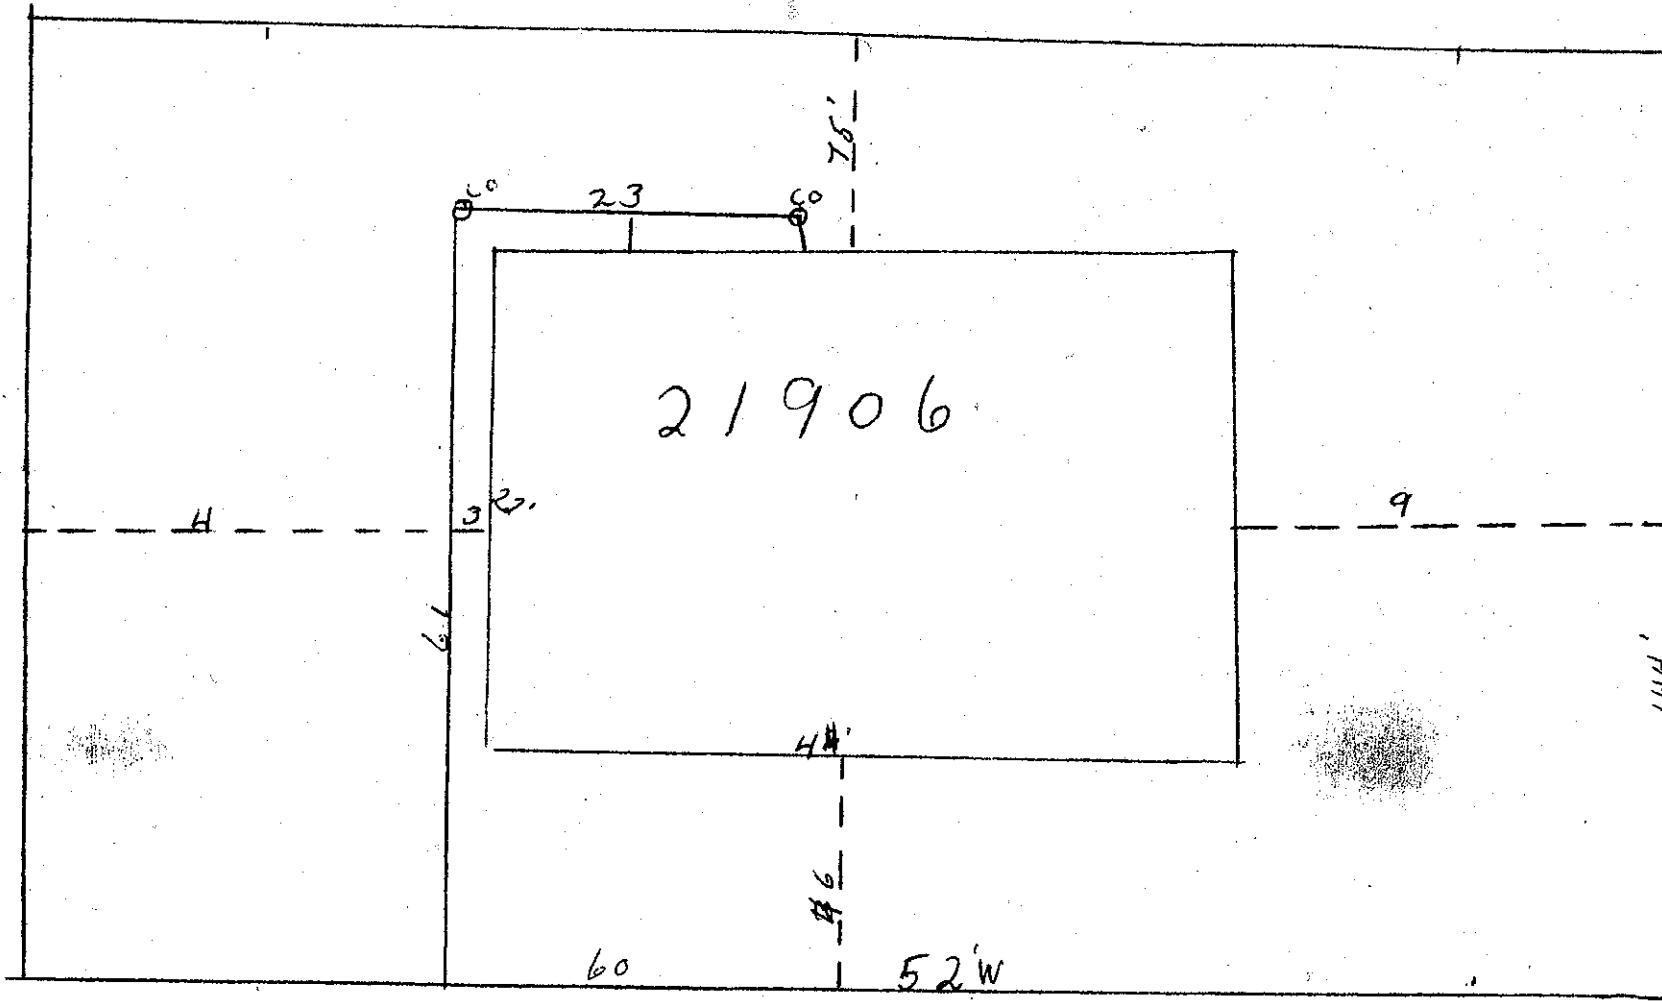

Date

Approved:

BACKFILL WORK ORDER ISSUED

DEPOSIT, \$10.00

WER WORK ORDER ISSUED

4/14/60
1268

DATE 4/14/60 BY J. Fairner

APPLICATION

SIDE SEWER PERMIT

CARD No.

The City of Mountlake Terrace

OUTSIDE INSIDE REPAIRS

EASEMENT No.

OWNER Robert L. Hock

HOUSE No. 22004 - 52 NO W

CONTRACTOR

Hedges D. M. Inc.

PERMIT No. 567


STREET

AVENUE LOT NO. 4

BLOCK No.

Div 22

NAME ADD.

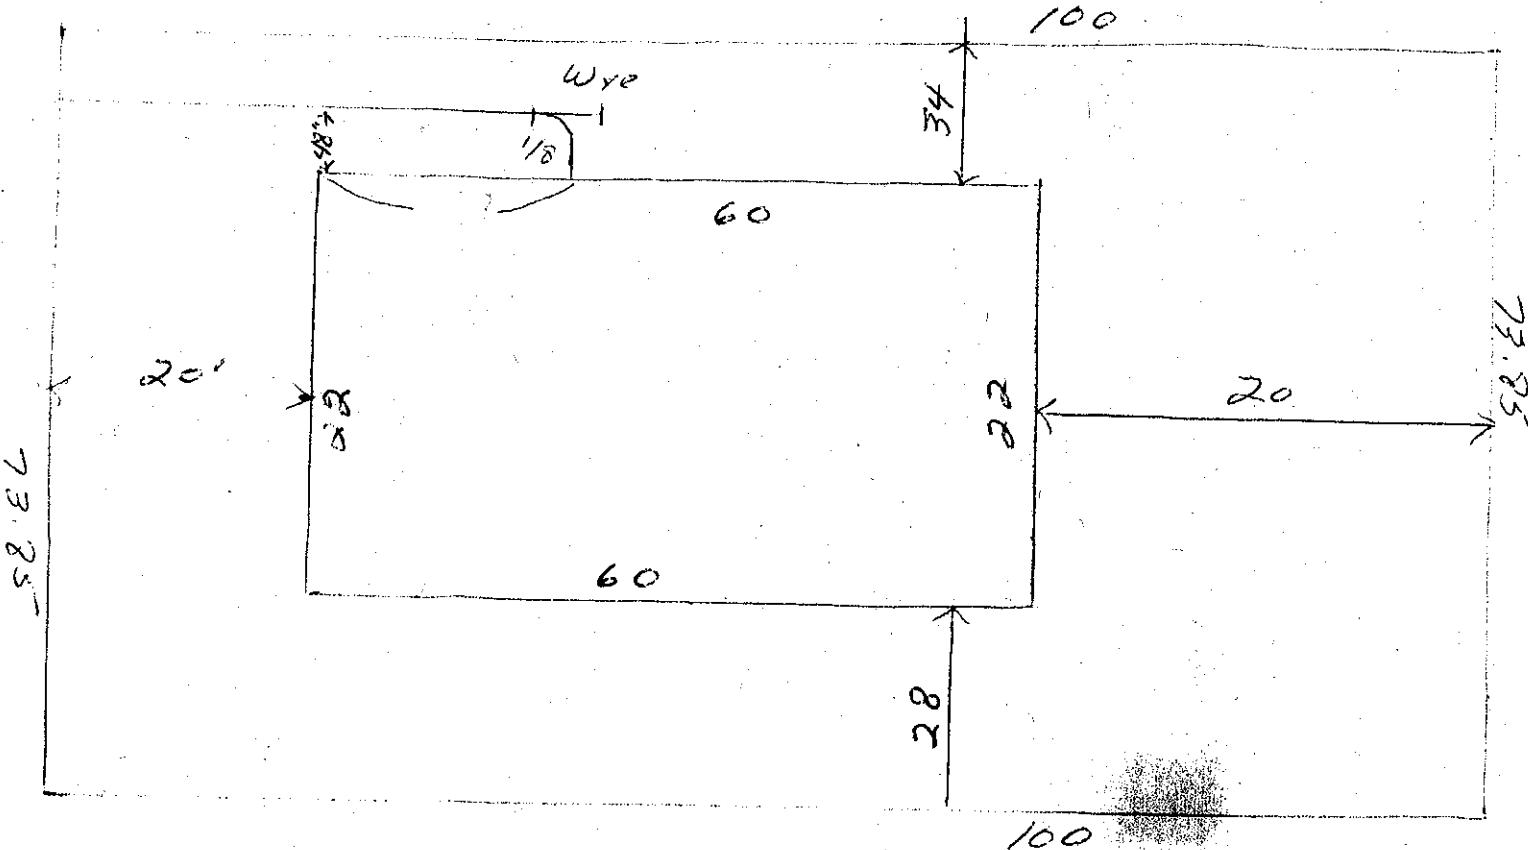

Date

BACKFILL WORK ORDER ISSUED

SEWER WORK ORDER ISSUED

DEPOSIT, \$ 10~~00~~ 11-76-60 Approved:

DATE 11-23-60 BY S. M. Holton

APPLICATION

K. L. HODGES

CARD No.

The City of Mountlake Terrace

SIDE SEWER PERMIT

OUTSIDE INSIDE REPAIRS

EASEMENT No. 1386683

OWNER KENNETH L. HODGES

HOUSE No. 22102 52 W.

CONTRACTOR O'NEIL & CO

PERMIT No. 2392

STREET


AVENUE LOT NO. 11

BLOCK NO.

NAME ADD.

DIV 22

Hot line 138.92 ft

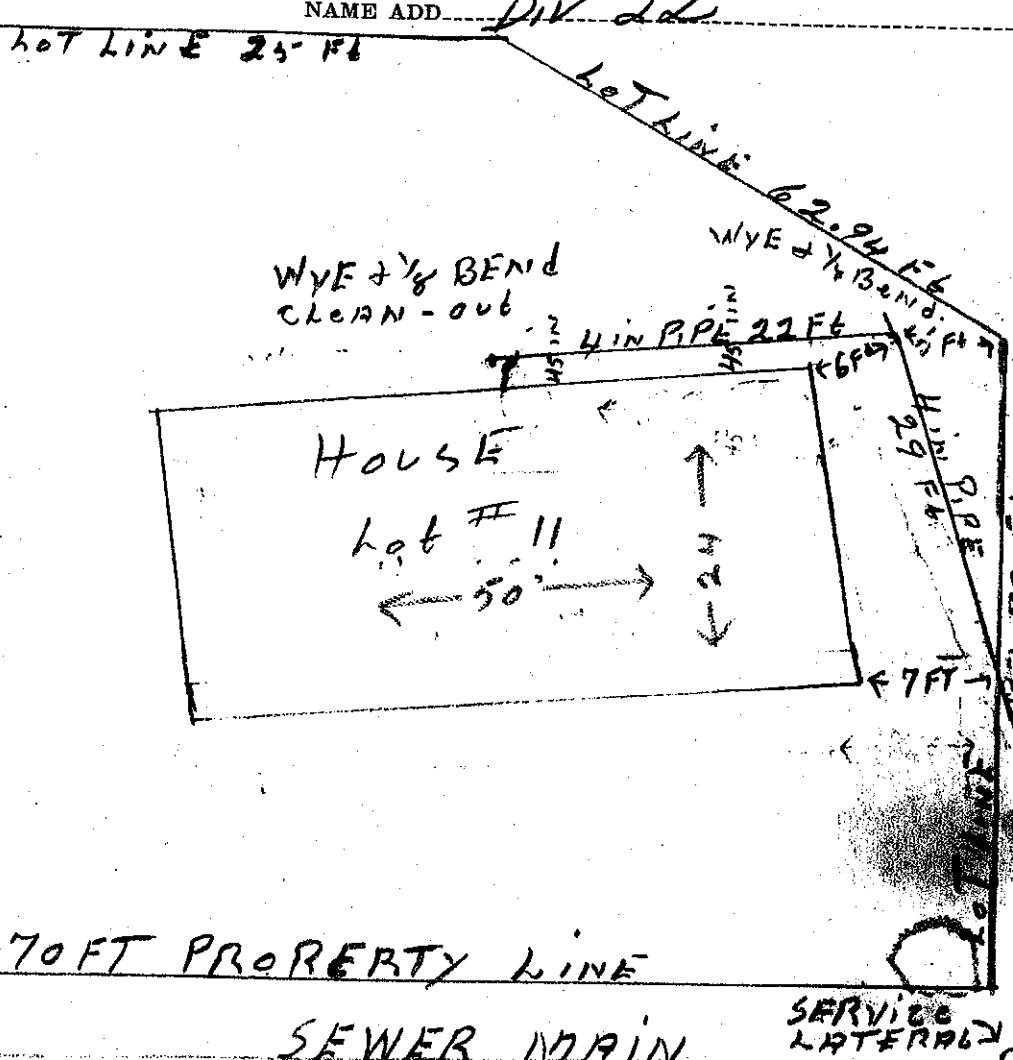CITY OF
MOUNTLAKE TERRACE

APR 30 1960

Plan Approved,

J. M. Alice

Date

DEPOSIT, \$ 10.00

Approved:

BACKFILL WORK ORDER ISSUED
SEWER WORK ORDER ISSUEDrec. 1176
Reeni Freeman

DATE 4-30-60

BY S. M. Holton MSTRCON

The City of Mountlake Terrace

APPLICATION

FOR

SIDE SEWER PERMIT

OUTSIDE INSIDE REPAIRS

A. M. Fliehan


CARD No.

EASEMENT No.

OWNER ALBERT M. FLIEHMAN

HOUSE No. 22104 52 West

CONTRACTOR THUNDERBIRDS CONST. PERMIT No. 2509
STREET AVENUE LOT No. 12 BLOCK No. DIV. 22
NAME ADD.

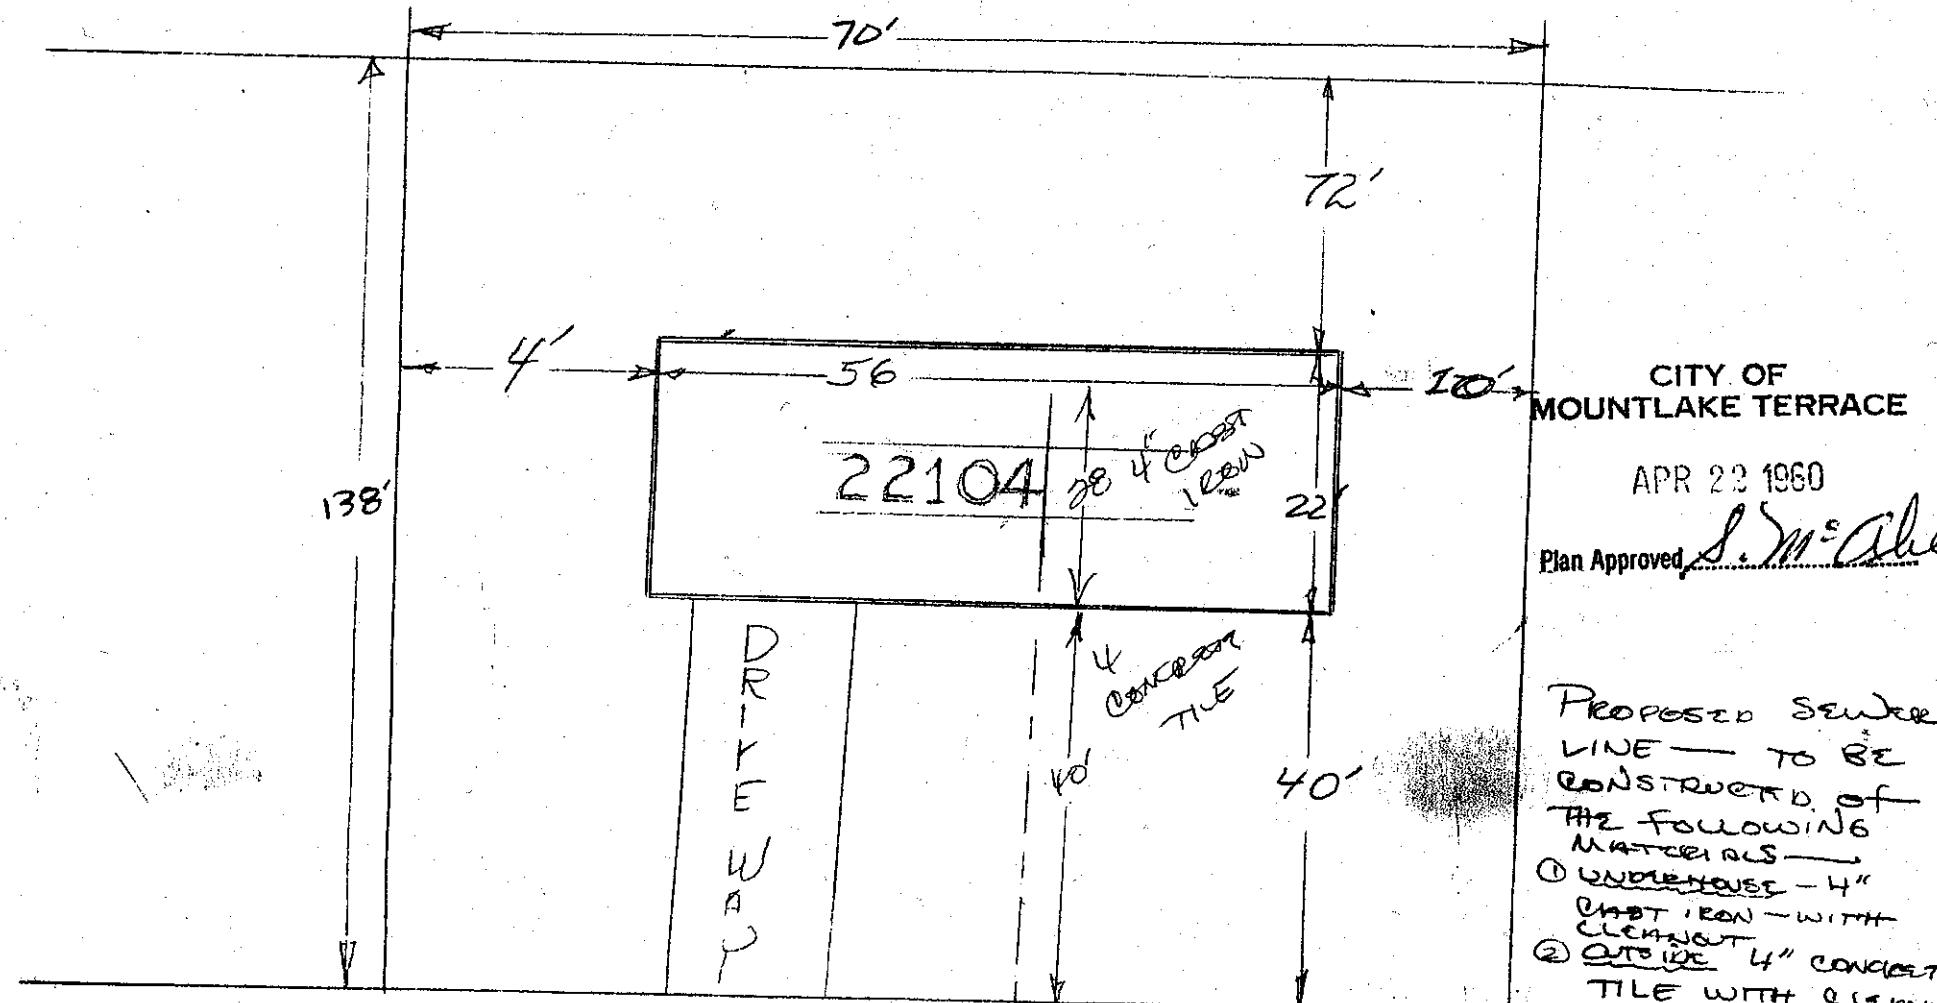

Date

52 WEST

Approved:

BACKFILL WORK ORDER ISSUED
SEWER WORK ORDER ISSUED

DEPOSIT, \$10.00

4/20/60

1295

DATE

4-22-60

BY

S. M. Hale

The City of Mountlake Terrace

API ON

CARD No.

VJ 76

SIDE SEWER PERMIT

OUTSIDE INSIDE REPAIRS

EASEMENT NO.

OWNER Ton Toy

HOUSE No. 22106 32nd W.

CONTRACTOR Carlson & Martin Inc. PERMIT No. 148


554

STREET

AVENUE LOT No. f 3

BLOCK No.

NAME ADD. Spokane 22

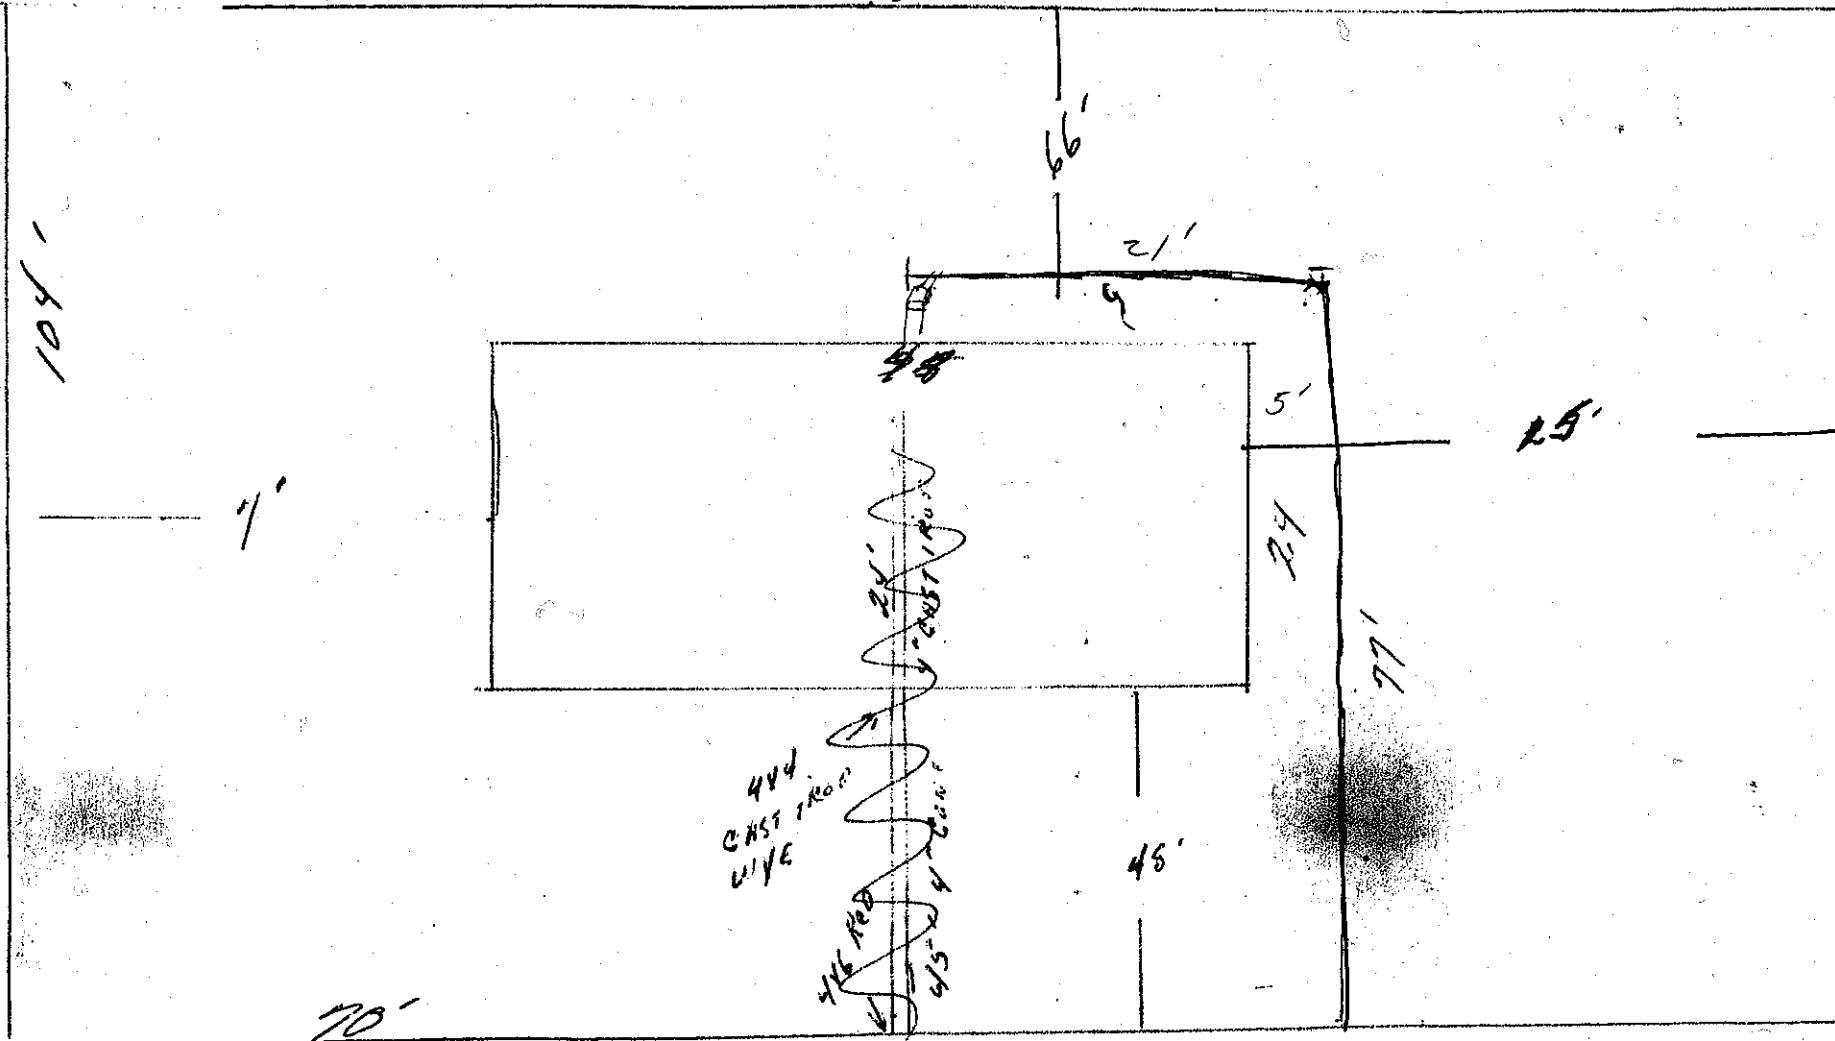

Date

Approved:

BACKFILL WORK ORDER ISSUED

DEPOSIT, \$

SEWER WORK ORDER ISSUED

DATE 11/3/60

BY

Arthur E. Tritton

Carlson will submit another set of drawings

The City of Mountlake Terrace

APPLICATION

for

SIDE SEWER PERMIT

OUTSIDE INSIDE REPAIRS

CARD No.

EASEMENT No. 150,776-1

OWNER James O'Toole
HOUSE No. 2210 1/2 5th Av

CONTRACTOR Ourself


PERMIT No. 520

STREET

AVENUE LOT NO. 14

BLOCK No.

NAME ADD. 011 RR

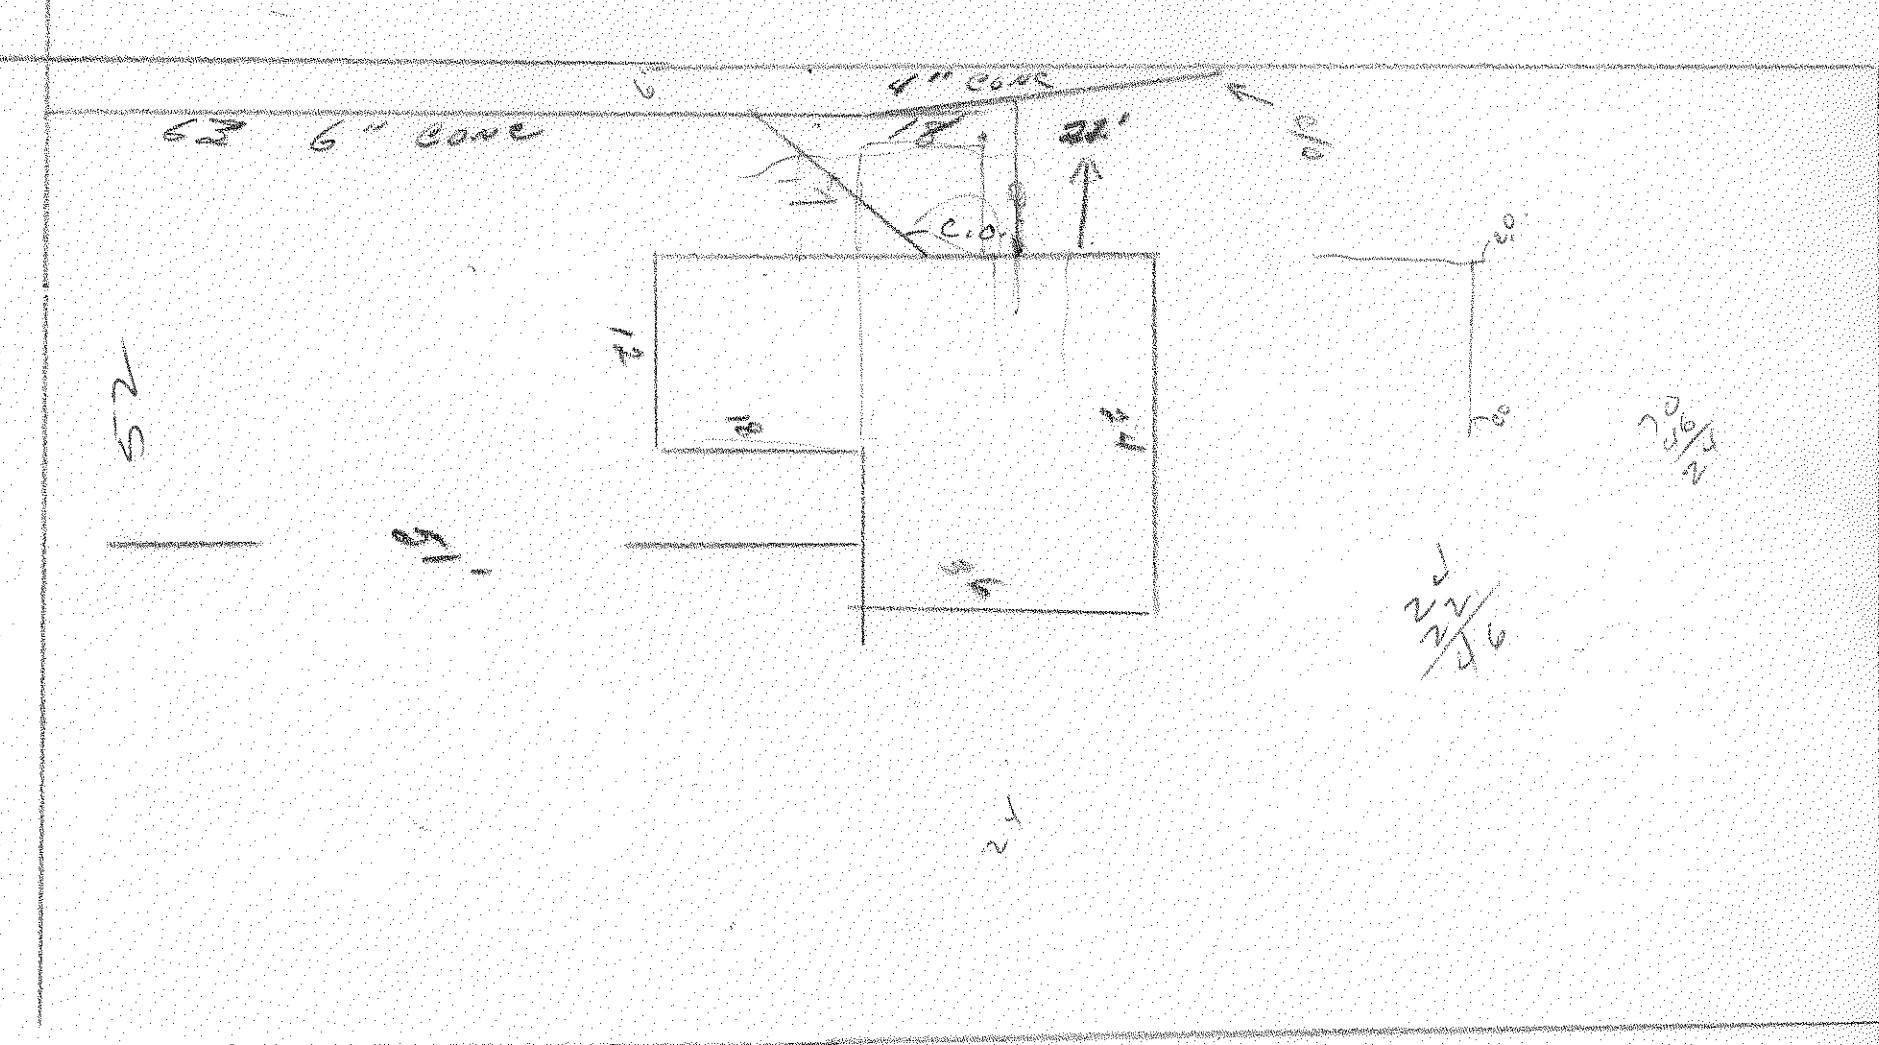

Date

Approved:

BACKFILL WORK ORDER ISSUED

DEPOSIT, \$10.00 10/19/60

SEWER WORK ORDER ISSUED

1960

DATE 10-20-60 BY J.M. Holton IN SCON

The City of Mountlake Terrace

APPLICATION

CARD No.

SIDE SEWER PERMIT

OUTSIDE INSIDE REPAIRS

EASEMENT No.

OWNER BRYAN KING
HOUSE NO. 22201 52nd Av.


CONTRACTOR Don Carlson

PERMIT No. 521

STREET
AVENUE LOT No. 7

BLOCK No.

NAME ADD. 01/1/21

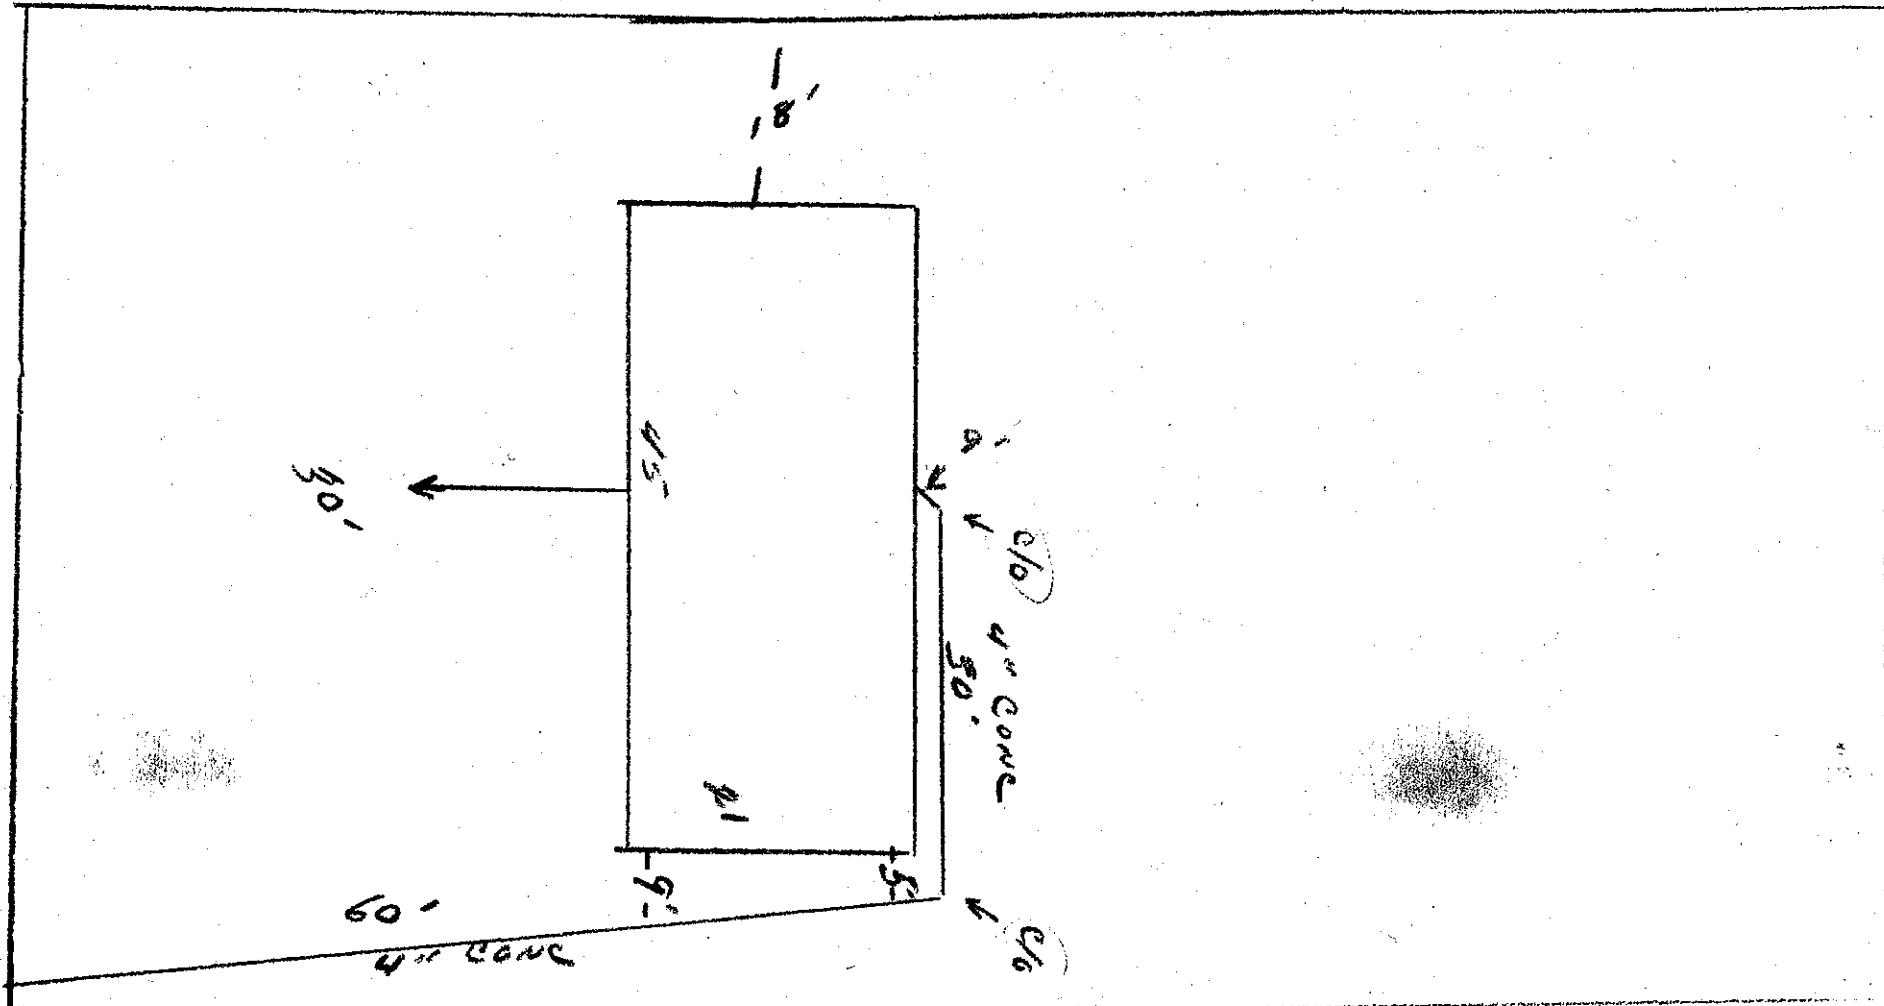

Date

BACKFILL WORK ORDER ISSUED

DEPOSIT, \$ 10.00 Approved: 6/19/60

SEWER WORK ORDER ISSUED

7700
1961

DATE

10-20-60 BY J. M. Holton WSTCON

The City of Mountlake Terrace

APPLICATION

for

SIDE SEWER PERMIT

OUTSIDE INSIDE REPAIRS

CARD No. _____

EASEMENT No. 1391863

OWNER H. Heest

HOUSE No. 2220 52nd Av.


CONTRACTOR Don Garrison PERMIT No. 519

STREET

AVENUE LOT No. 15

BLOCK No. _____

NAME ADD Div 22

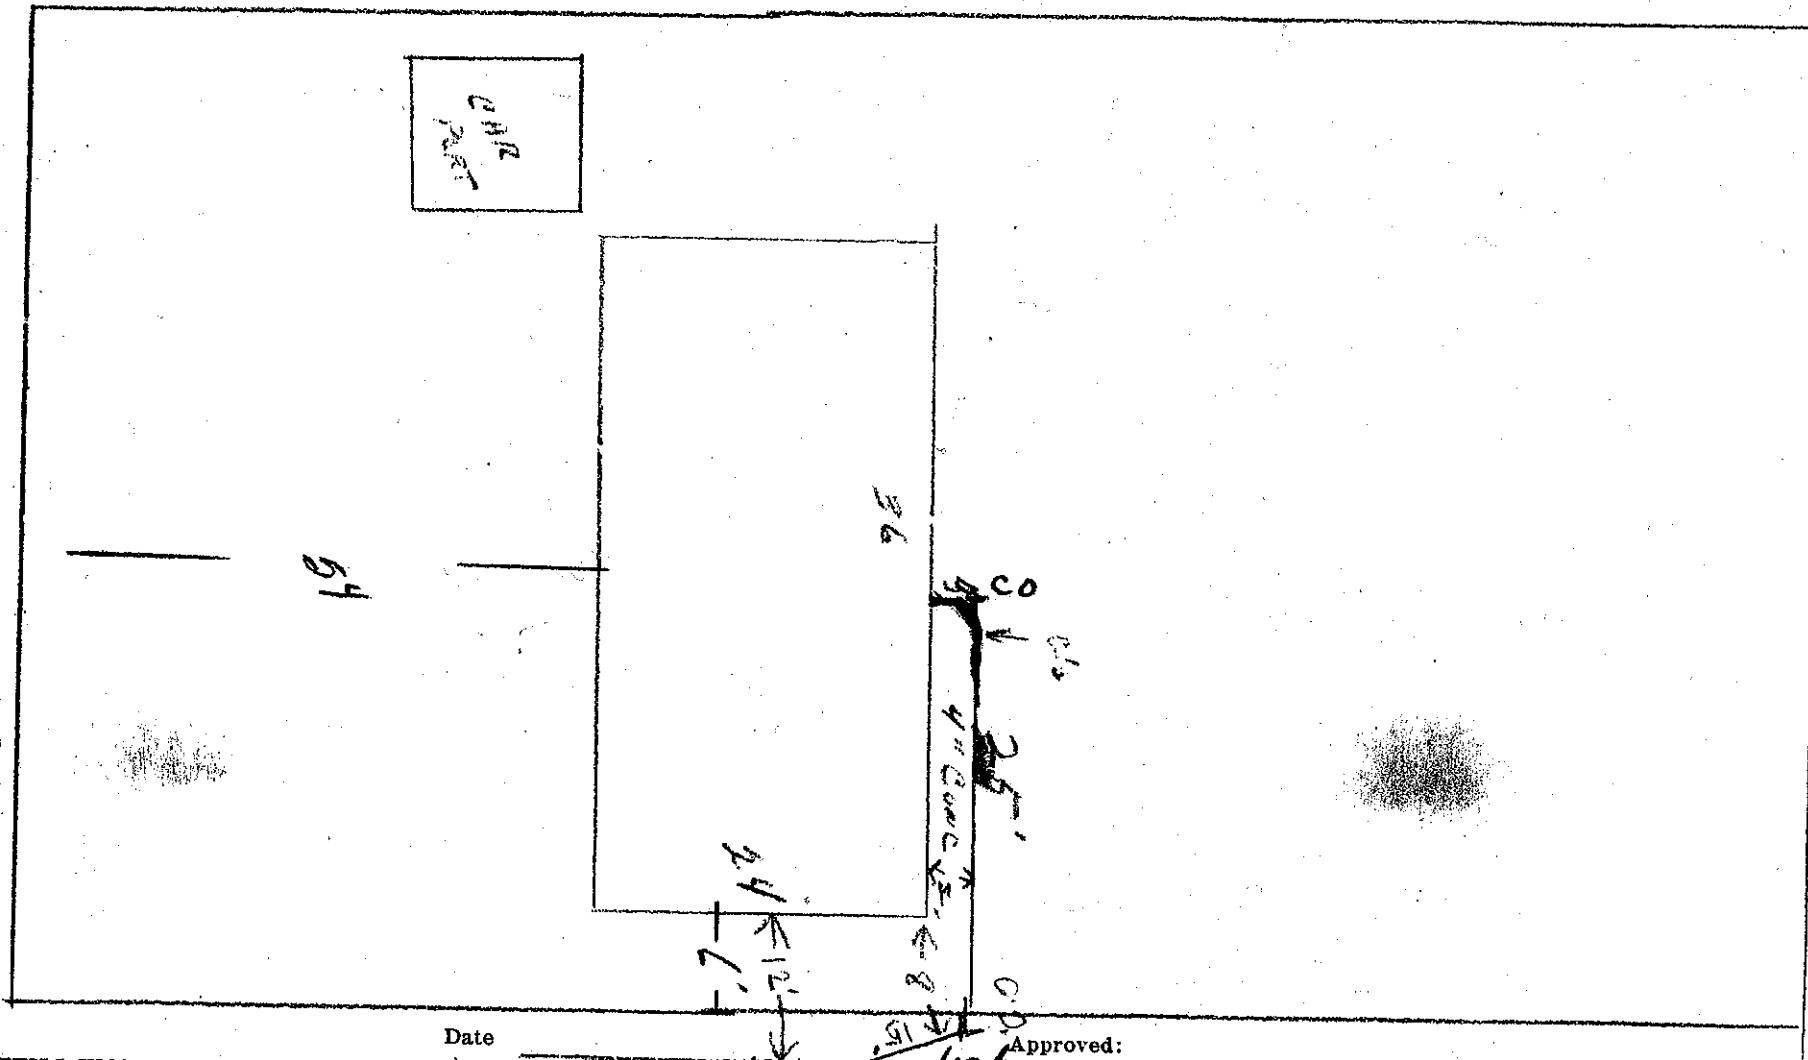

Date

BACKFILL WORK ORDER ISSUED
SEWER WORK ORDER ISSUED

DEPOSIT, \$10.00 Approved:

~~10/19/60~~
1960

DATE

11-30-60 BY S. M. Holton

The City of Mountlake Terrace

APPLICATION

SIDE SEWER PERMIT

OUTSIDE INSIDE REPAIRS

LYNN G. BRYAN

CARD No.

EASEMENT No. 1362301

OWNER LYNN G. BRYAN

HOUSE No. 22203-52nd W.


CONTRACTOR BY OWNER

STREET
AVENUE LOT No. 8

PERMIT No. 1148

BLOCK No. Div. 21

NAME ADD.

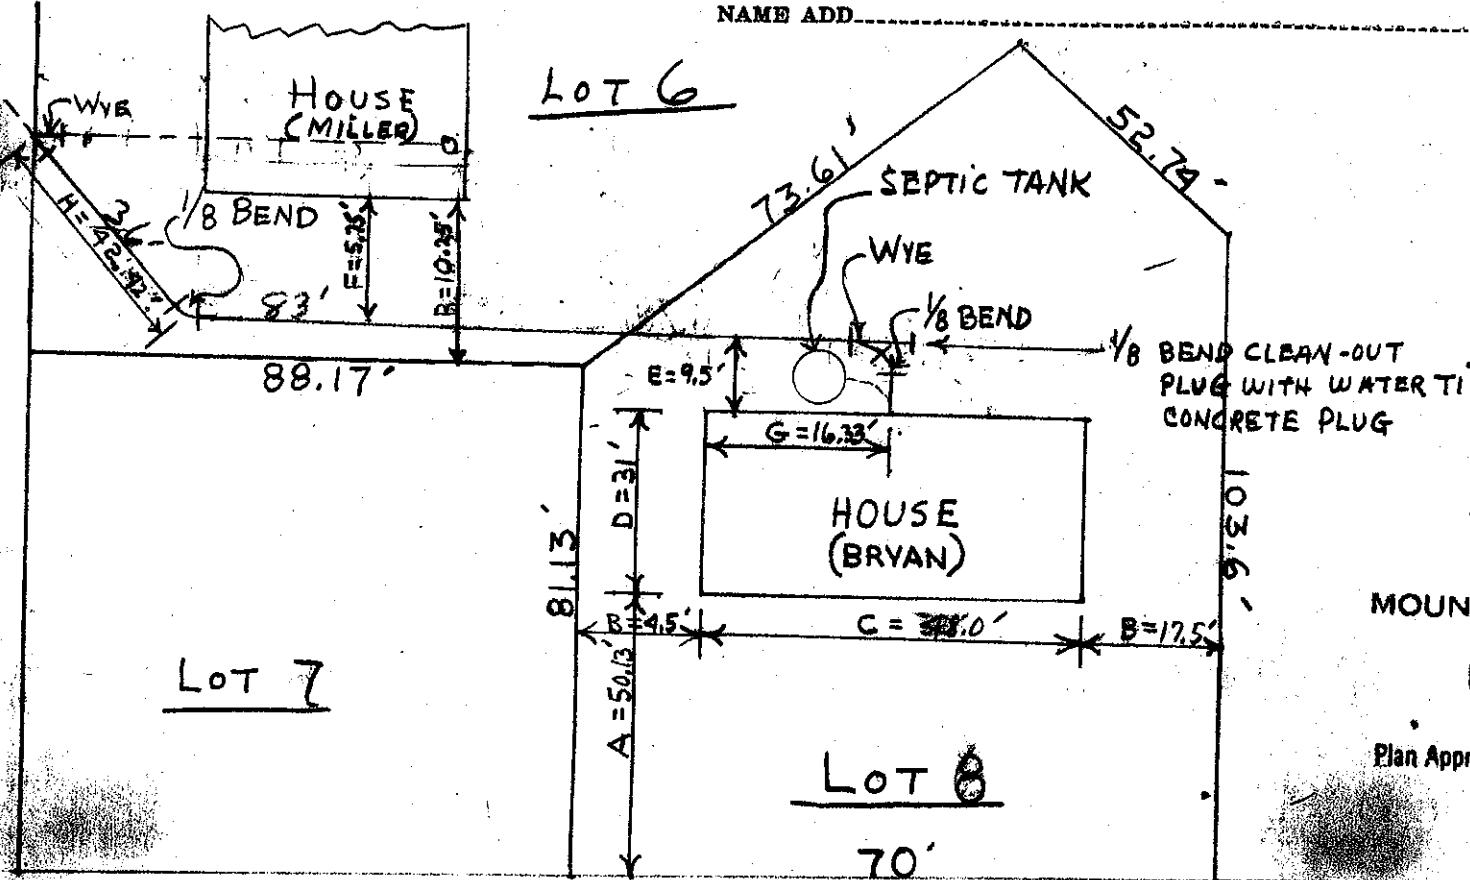

CITY OF
MOUNTLAKE TERRACE

NOV 23 1959

Plan Approved.

J. J. Culver
J. S. M. K.

52 ND WEST

Date

Approved:

BACKFILL WORK ORDER ISSUED

SEWER WORK ORDER ISSUED

DEPOSIT, \$100.00

Rec 5374

11/23/59. Due at 3-71x 115th and 8th Av.

DATE 11-23-59

BY Scott M. Holler I.P.S.

No. 10

The City of Mountlake Terrace

APPLICATION

SIDE SEWER PERMIT

OUTSIDE INSIDE REPAIRS

V.L.C.A. CARD No.

EASEMENT No. 1356581

OWNER Donald L Carlson

HOUSE No. 22204 - 52 west

Lot 16+17

Service lateral

Joint system

CONTRACTOR

Owner

PERMIT No. 1122

STREET


AVENUE LOT No.

16

BLOCK No.

NAME ADD.

22

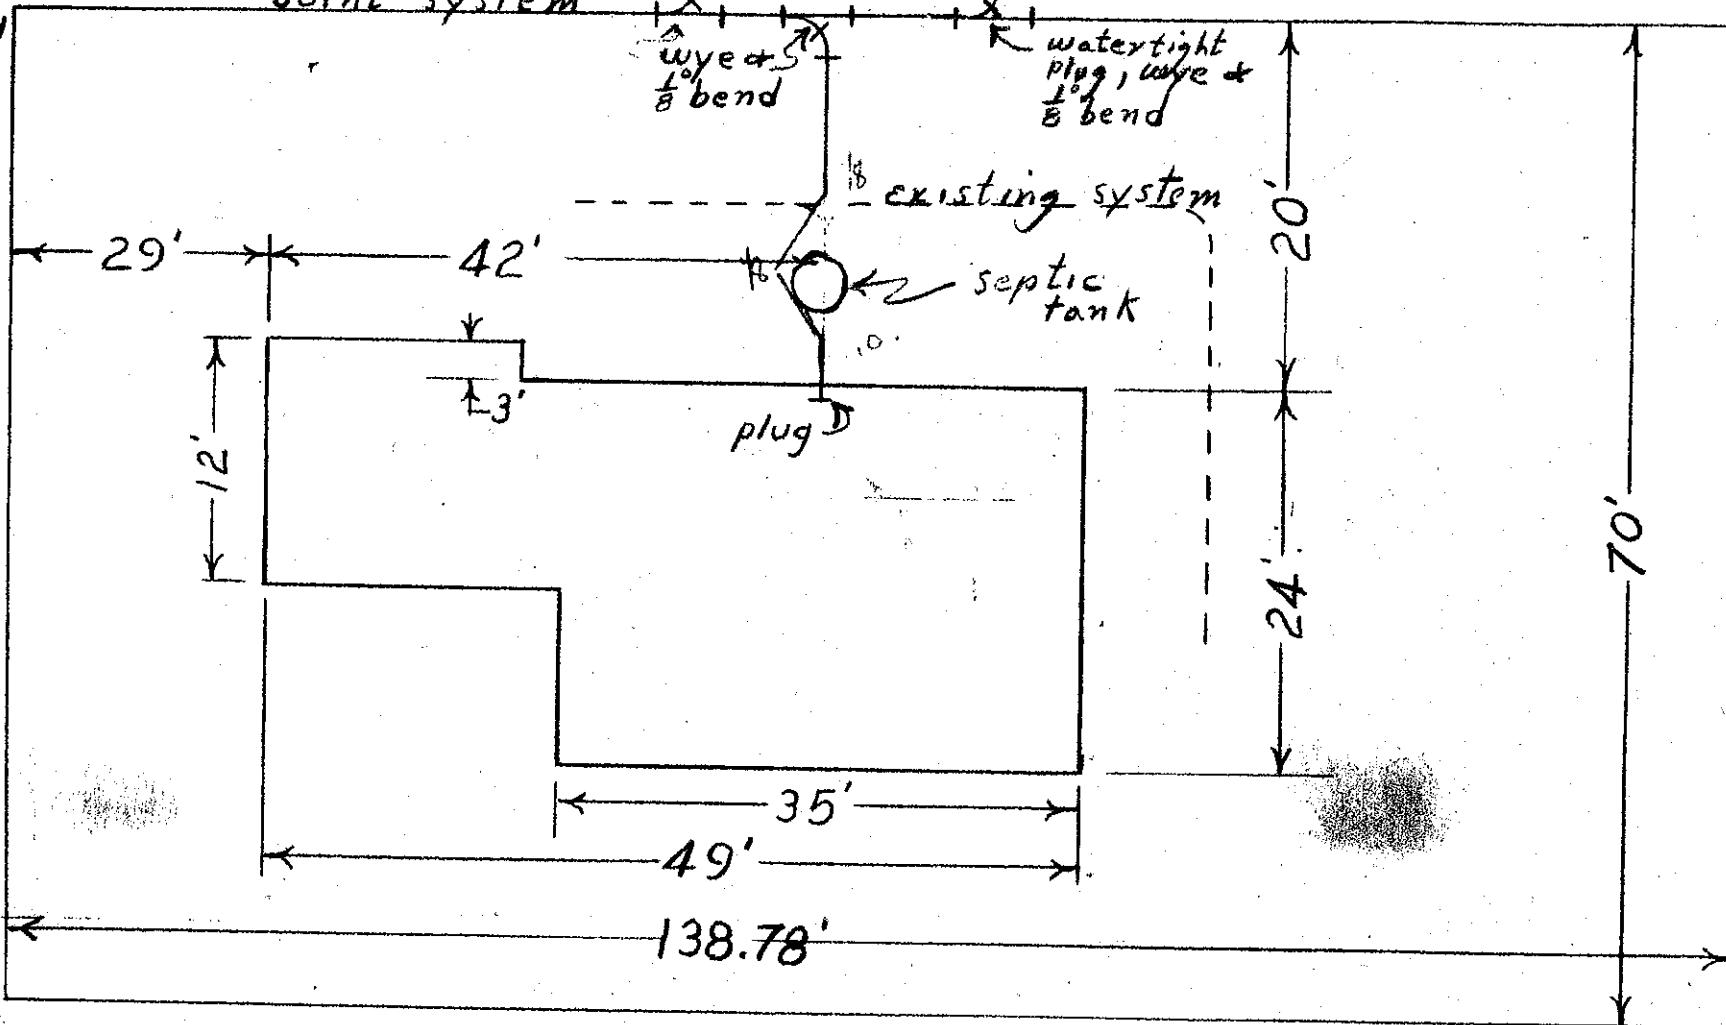

Date

Approved:

BACKFILL WORK ORDER ISSUED

DEPOSIT, \$10⁰⁰

11-10-59

SEWER WORK ORDER ISSUED

5352 DATE 4-28-60

BY S. M. Holton

4" LINE INSPECTION

The City of Mountlake Terrace

APPLICATION

SIDE SEWER PERMIT
OUTSIDE INSIDE REPAIRS

JESSE TARREN
CARD No.

EASEMENT No. 1358637

OWNER

Jesse Tarran

CONTRACTOR

Pioneer cont

PERMIT No. 2337

HOUSE No.

22301 52 w

STREET


AVENUE LOT No. 11

BLOCK No.

NAME ADD.

21

Easement comes "in back".

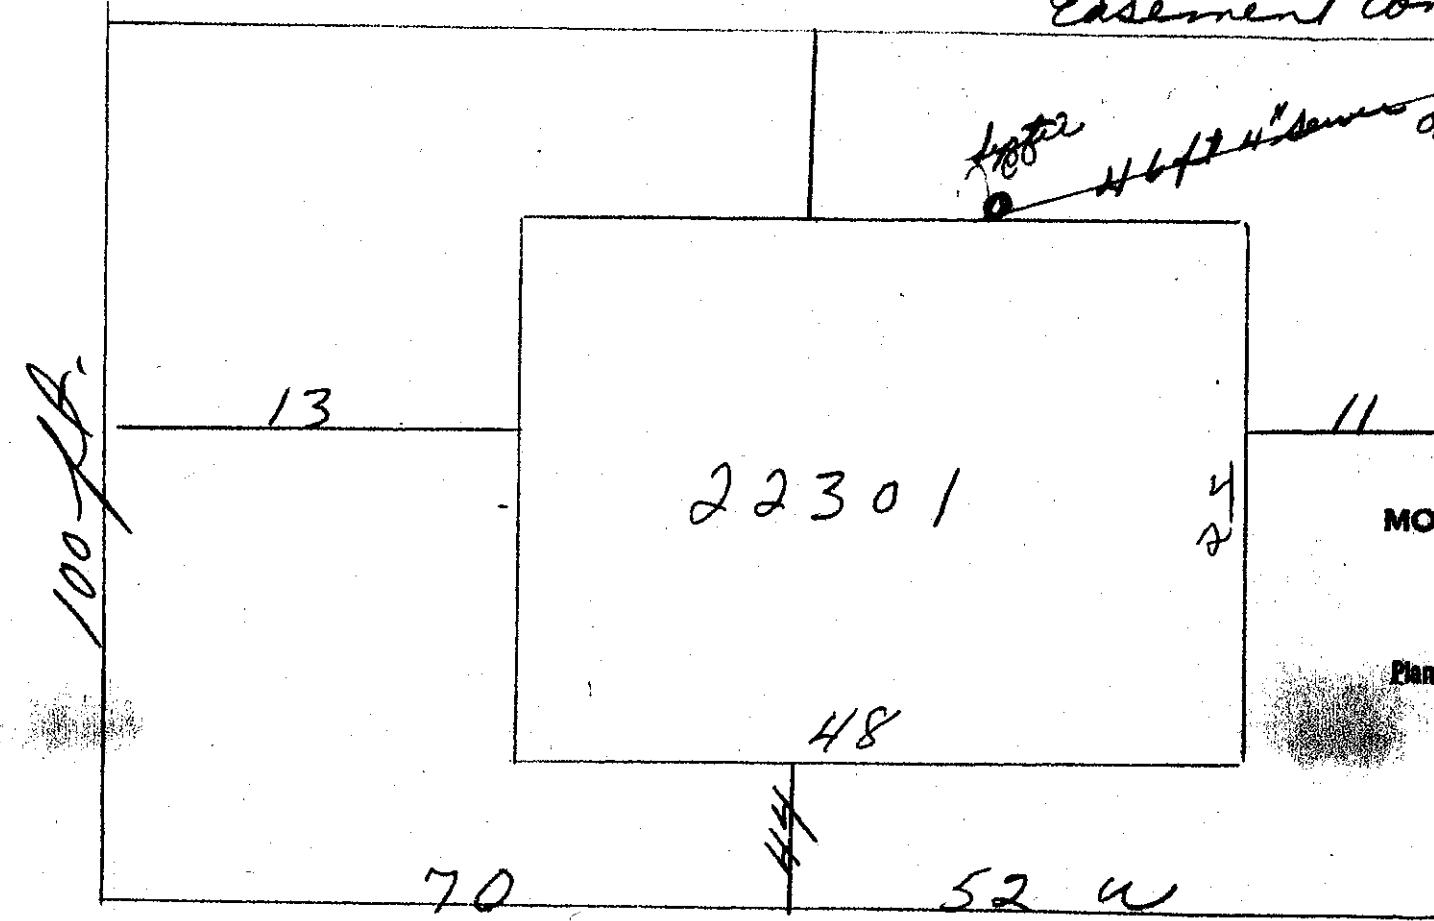

CITY OF
MOUNTLAKE TERRACE

APR 2 1960

Plan Approved

Date

BACKFILL WORK ORDER ISSUED
SEWER WORK ORDER ISSUED

DEPOSIT \$10.00 3/31/60 Approved:
1110 DATE 4/4/60

BY

J. Moore map 16

APPLICATION

SIDE SEWER PERMIT

OUTSIDE INSIDE REPAIRS

JOHN W. CROCKER

CARD No.

EASEMENT No. #1351023

The City of Mountlake Terrace

OWNER John W. CROCKER

HOUSE No. 22302 52nd w.

CONTRACTOR Deiner


PERMIT No. 919-

STREET
AVENUE LOT No. 52nd w.

BLOCK No. Lot 21 & 1/2 of 20

NAME ADD. Plat of Mt. Terrace sec 22

37 FT.

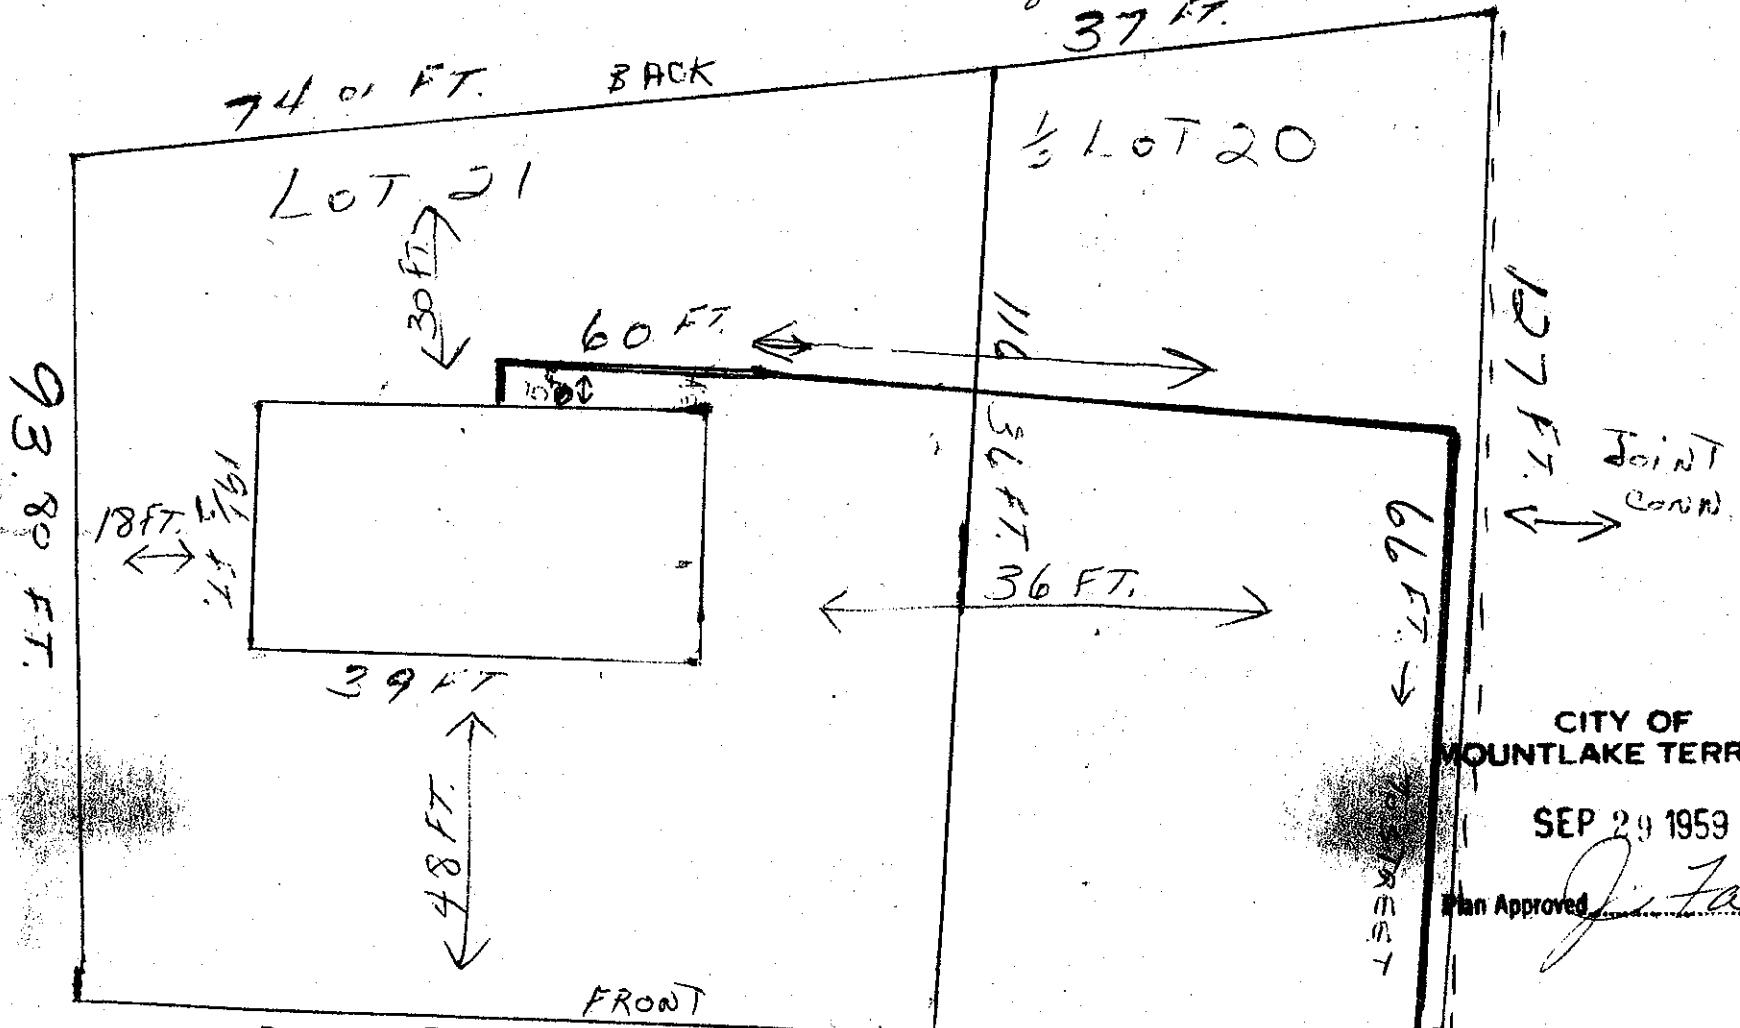CITY OF
MOUNTLAKE TERRACE

SEP 29 1959

Plan Approved

BACKFILL WORK ORDER ISSUED

Date

DEPOSIT, \$10.00

SEWER WORK ORDER ISSUED

Approved:

DATE

BY

8/21/59
By Rec 3946 - 2-25-61 INS CON J.M.H.

The City of Mountlake Terrace

APPLICATION

to

SIDE SEWER PERMIT

OUTSIDE INSIDE REPAIRS

CARD No.

EASEMENT No.

1258637

OWNER William Jay

HOUSE No. 22303

52 W

CONTRACTOR

STREET

AVENUE LOT No.

Rainier coast

PERMIT No. 2338

BLOCK No.


NAME ADD.

21

20 ft 6" LINC
0' 0"

115 ft 4" down. 0' 0" 3' 8"

0' 0"

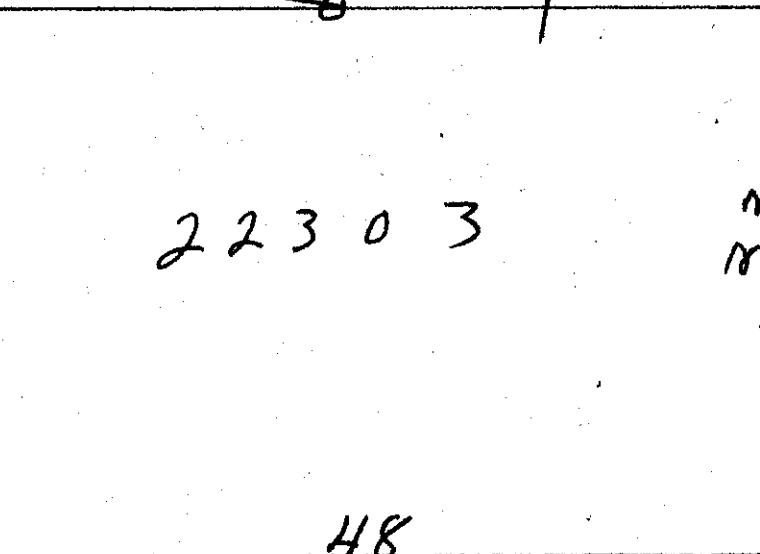

CITY OF
MOUNTLAKE TERRACE

MAR 31 1960

Plan Approved

J. Fairman

Date

BACKFILL WORK ORDER ISSUED

DEPOSIT \$10.00 3/31/60 Approved:

SEWER WORK ORDER ISSUED

1110

DATE

4/4/60

BY

J. M. McLean - msp/can

The City of Mountlake Terrace

APPLICATION

CARD No.

SIDE SEWER PERMIT

OUTSIDE INSIDE REPAIRS

EASEMENT No. None

OWNER

Charles L. Collins

CONTRACTOR

Wingfield

PERMIT No. 607

HOUSE No. 22304 - 52nd W.

STREET

AVENUE LOT No.

22


BLOCK No.

NAME ADD.

Div. F 22

77'

N

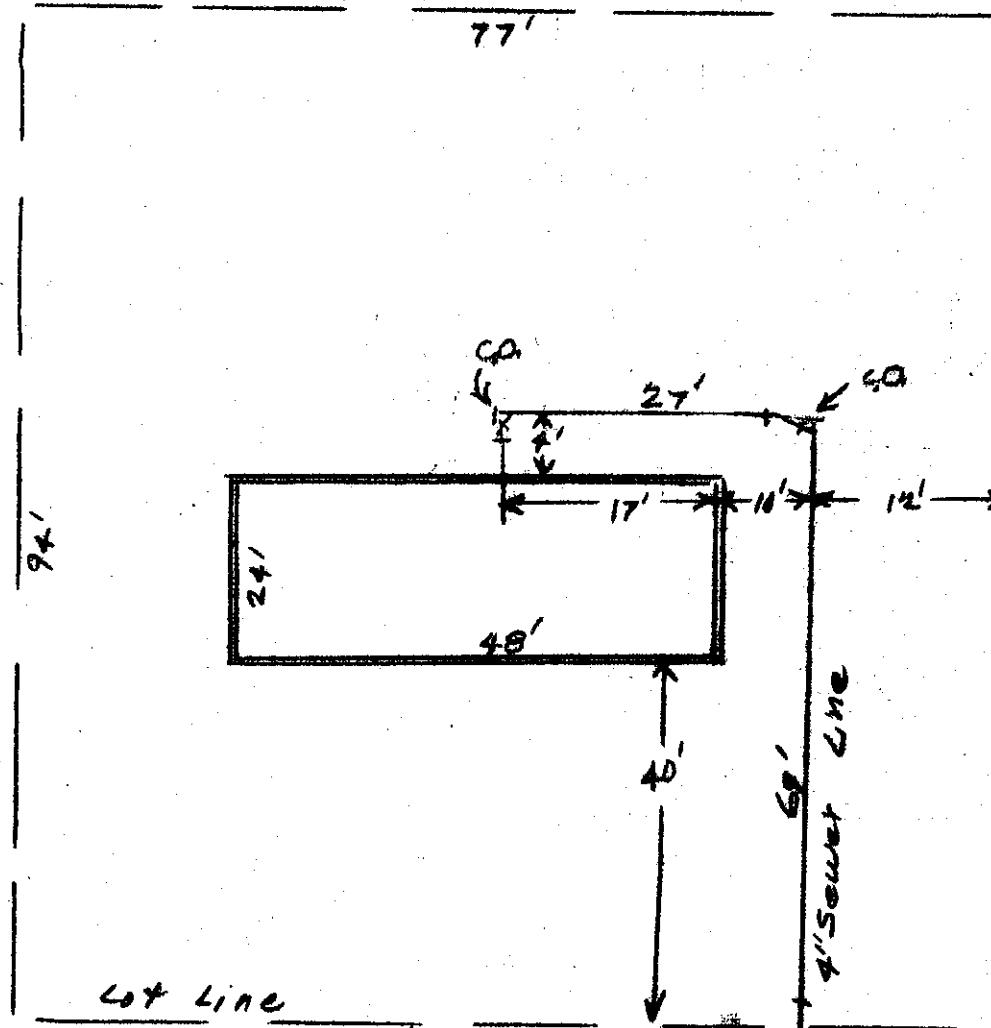

Lot Line

Date

52nd W.

Approved:

BACKFILL WORK ORDER ISSUED

DEPOSIT: \$10.00 12/6/60

SEWER WORK ORDER ISSUED

DATE 12-7-60

BY D. M. Holton IVS & CO

The City of Mountlake Terrace

APPLICATION
FOR

SIDE SEWER PERMIT

OUTSIDE INSIDE REPAIRS

WILLIAM DEAKIN

CARD No.

EASEMENT No. 1384778

OWNER WILLIAM DEAKIN
HOUSE No. 22305 52 W


CONTRACTOR RAINIER

PERMIT No. 2093

STREET
AVENUE LOT No. 13

BLOCK No.

NAME ADD. DIV NO 21

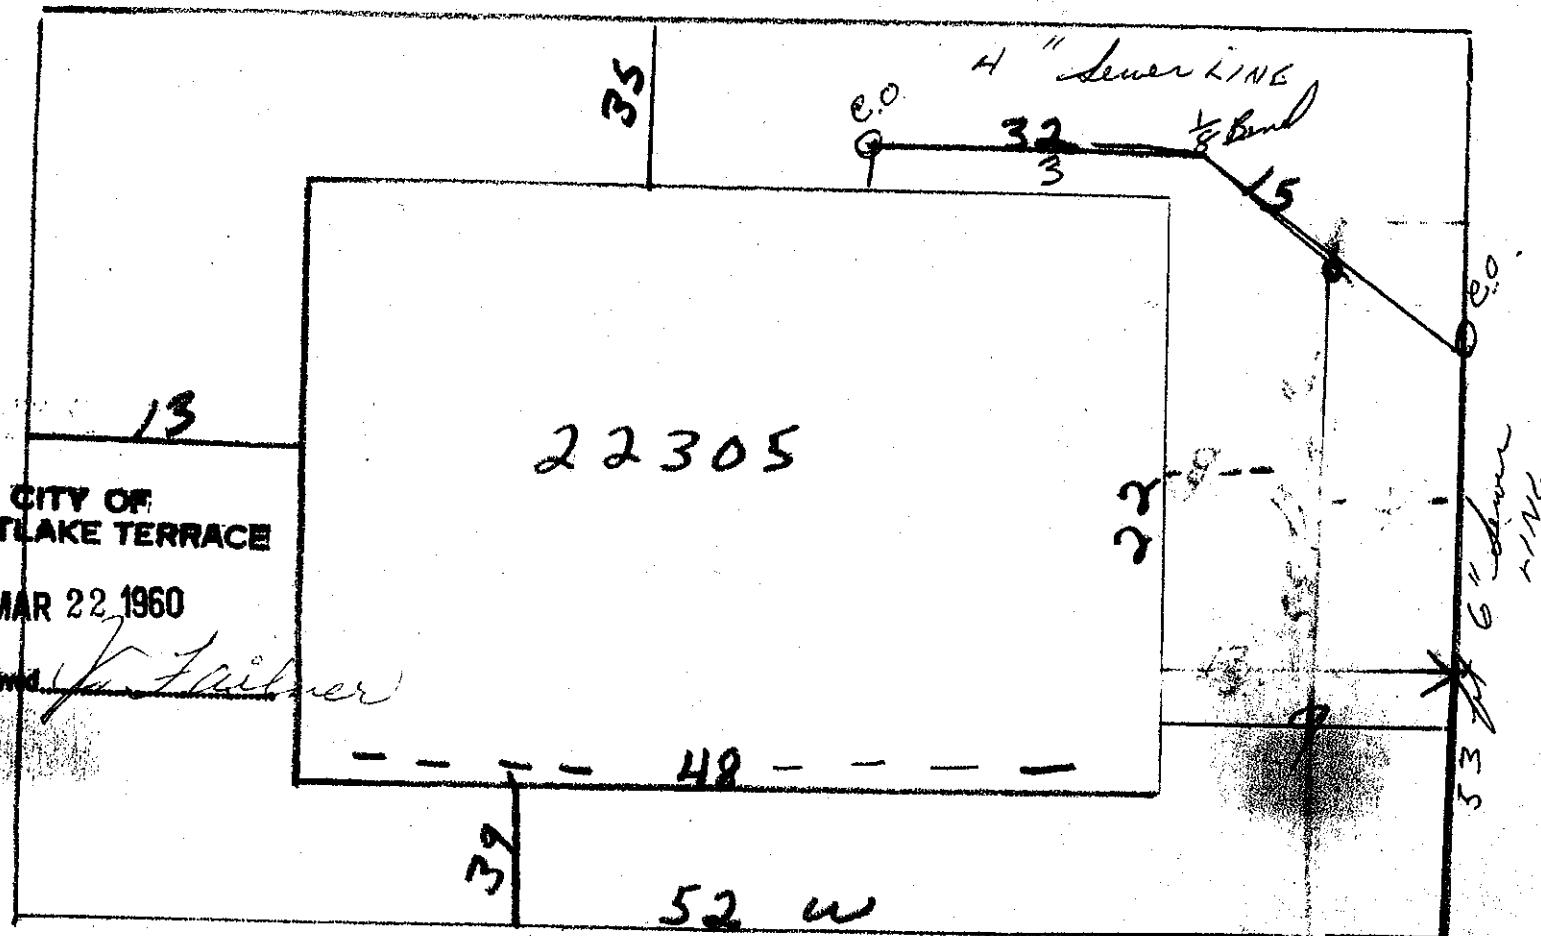

CITY OF
MOUNTLAKE TERRACE

MAR 22 1960

Plan Approved

J. L. Silmer

Date

BACKFILL WORK ORDER ISSUED
SEWER WORK ORDER ISSUED

Approved:

DEPOSIT, \$10.00 3/21/60

929

DATE

3/23/60

BY J. L. Silmer

The City of Mountlake Terrace

APPLICATION

K. C. /e
CARD No.

SIDE SEWER PERMIT

OUTSIDE INSIDE REPAIRS

EASEMENT No. 211

OWNER K. Ogle
HOUSE No. 22306

52 W.

CONTRACTOR

STREET

AVENUE LOT No.


Evergreen Const

PERMIT No. 1594

NAME ADD.

BLOCK No.

SLD 22

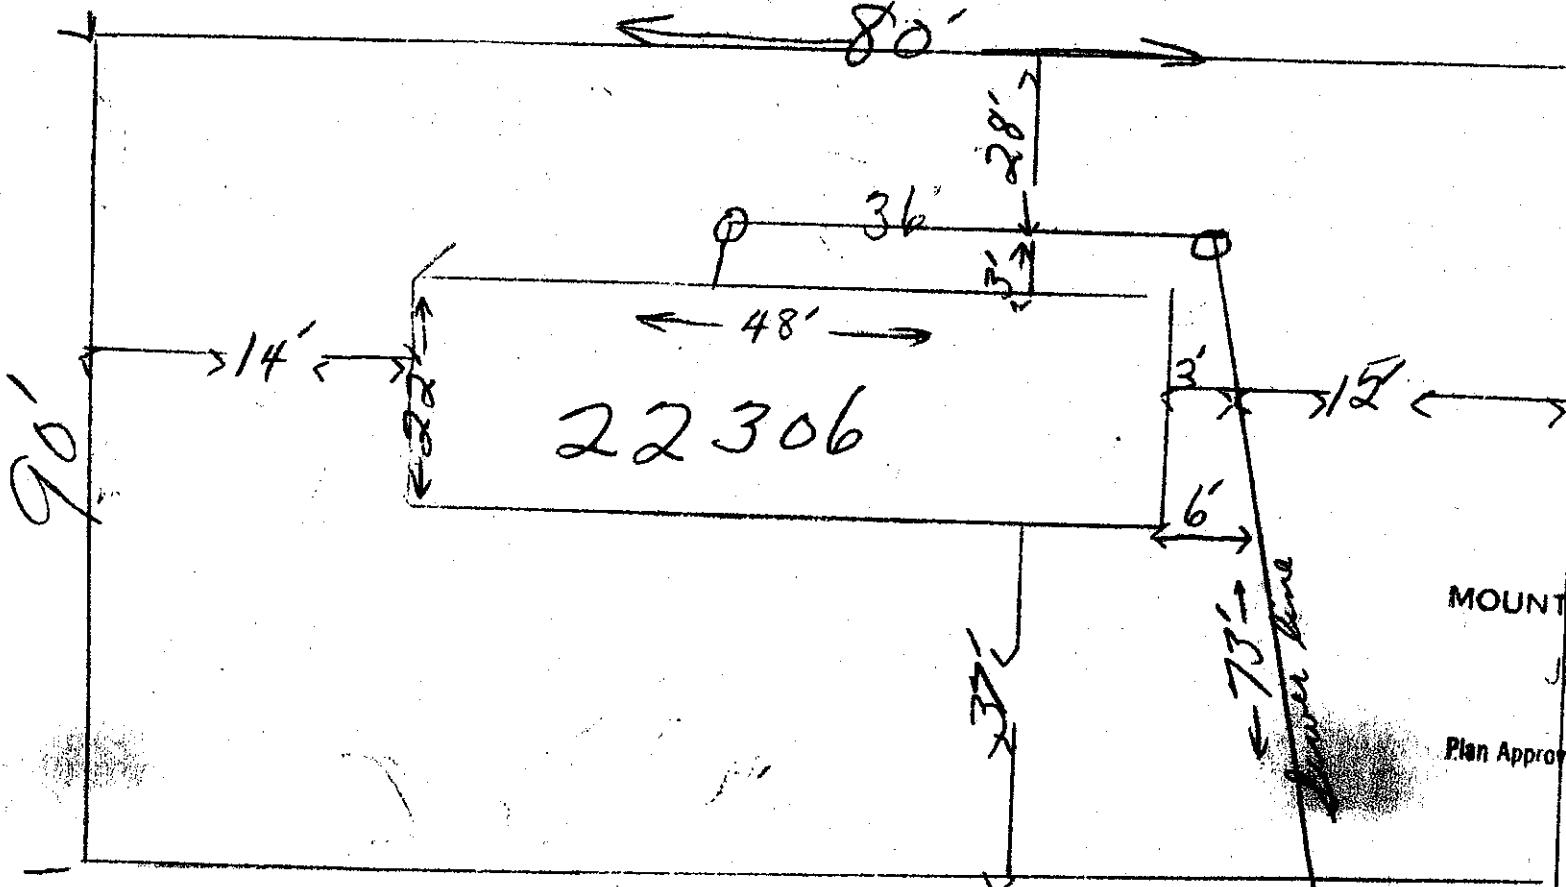

CITY OF
MOUNTLAKE TERRACE

JAN 23 1950

Plan Approved

R. Failler

← 52 W →

Date

Approved:

BACKFILL WORK ORDER ISSUED

DEPOSIT, \$ 10.00

SEWER WORK ORDER ISSUED

5876

DATE 3/19/60 BY J. Failler

The City of Mountlake Terrace

APPLICATION

SIDE SEWER PERMIT

OUTSIDE INSIDE REPAIRS

CARD No.

EASEMENT No.

OWNER

HARRIS LOT 4

HOUSE No. 22442 52nd W

CONTRACTOR

CARLSON & MARTINI

PERMIT NO. 2539


STREET

AVENUE LOT No.

BLOCK No.

NAME ADD.

Div 4 22

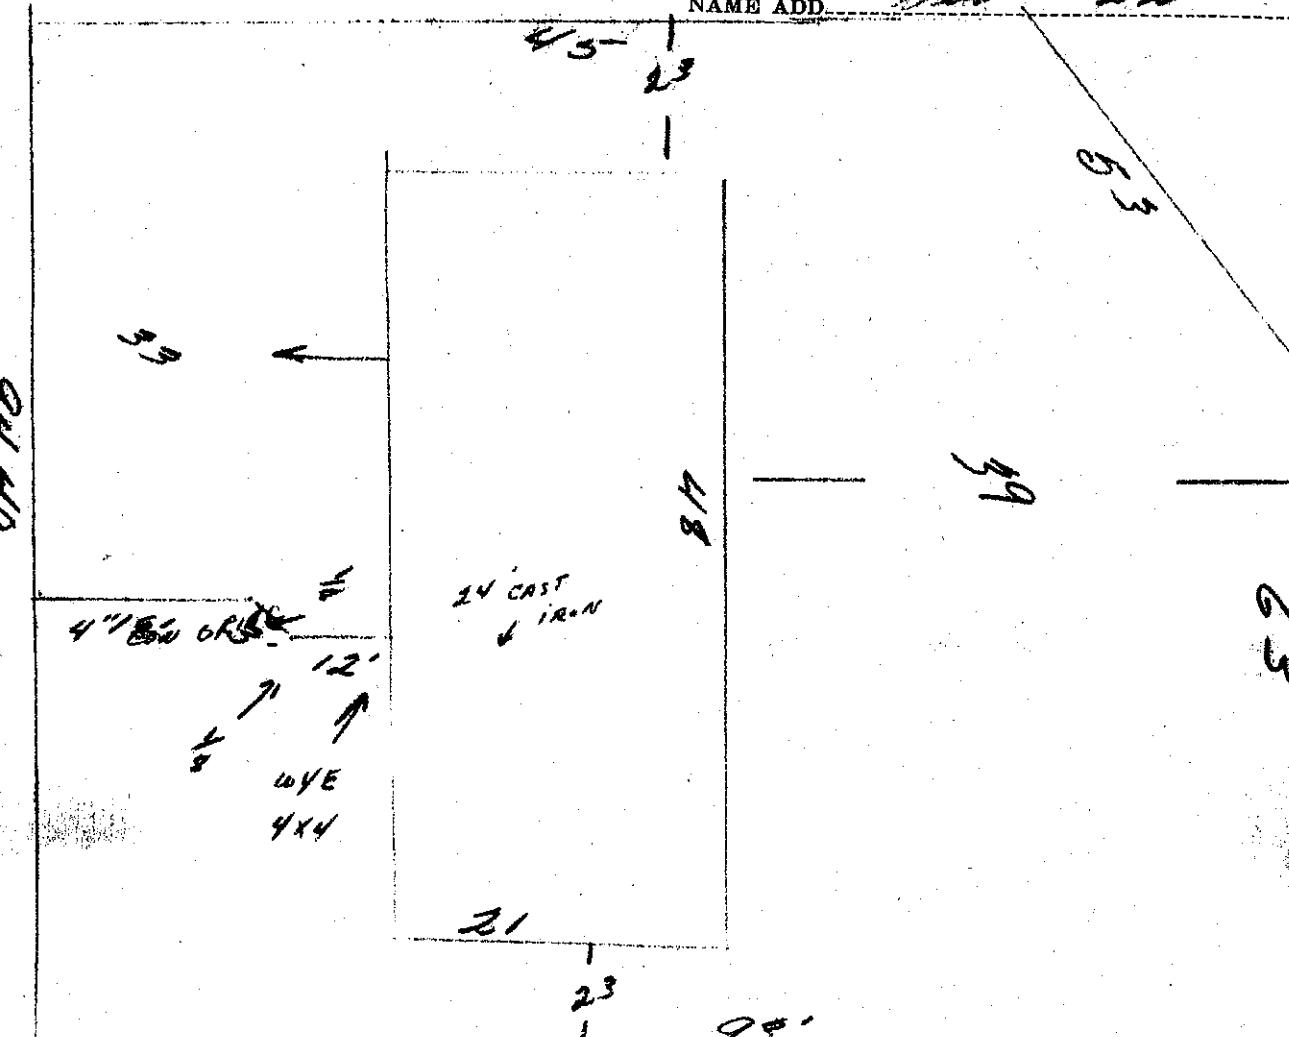

Date

BACKFILL WORK ORDER ISSUED

SEWER WORK ORDER ISSUED

Approved:

DEPOSIT, \$10.00 4/23/60

1315

DATE

4/25/60

BY

J. M. Molaro

THE CITY OF MOUNTLAKE TERRACE

APPLICATION

FOR

SIDE SEWER PERMIT

OUTSIDE INSIDE REPAIRS

CARD NO.

EASEMENT NO.

OWNER John Leland

CONTRACTOR

B + M

PERMIT NO.

HOUSE No. 22403 - 52nd West

STREET


AVENUE LOT No.

2

BLOCK NO.

NAME ADD

Foster Mountlake Terrace Park

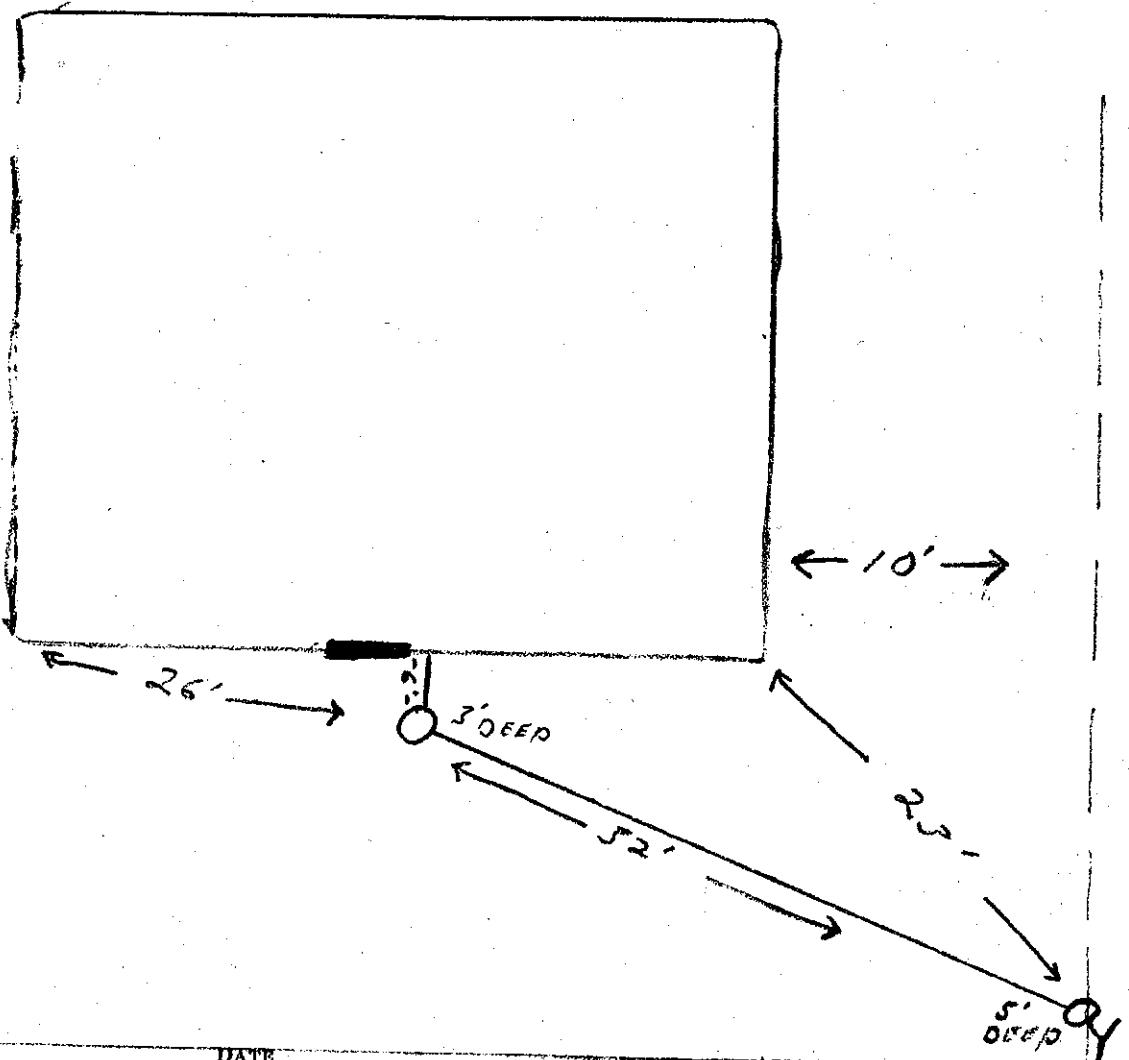

CITY OF
MOUNTLAKE TERRACE

FEB 28 1968

PAID \$

DATE

APPROVED

BACKFILL WORK ORDER ISSUED

DEPOSIT, \$

SEWER WORK ORDER ISSUED

DATE

BY

THE CITY OF MOUNTLAKE TERRACE

APPLICATION

FOR

SIDE SEWER PERMIT

OUTSIDE INSIDE REPAIRS

CARD NO.

EASEMENT NO.

OWNER JOHN Belano

CONTRACTOR

B + M

PERMIT NO.

HOUSE NO. 22805 52nd West



STREET

AVENUE LOT NO.

LOT 1

BLOCK NO.

NAME ADD Folsom & Belie Terrace Park

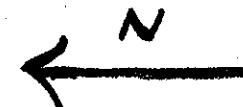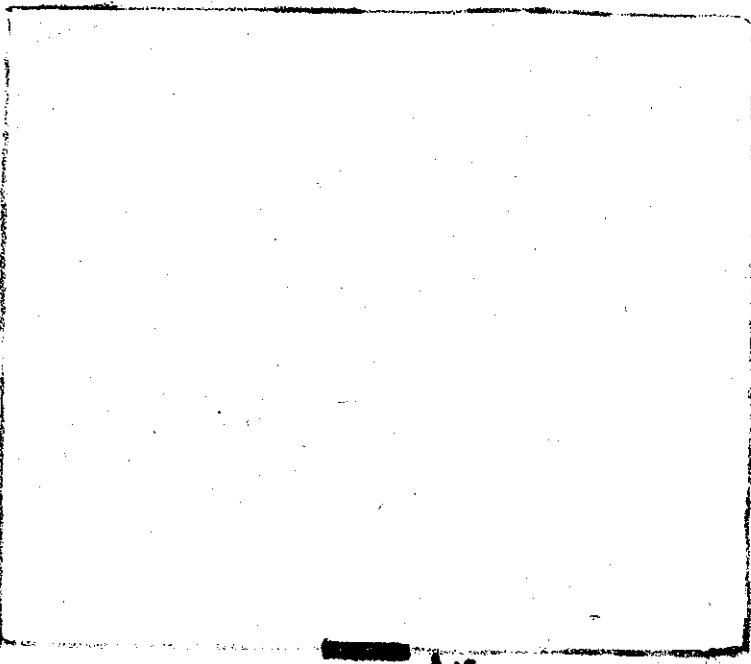

CITY OF
MOUNTLAKE TERRACE

FEB 28 1968

PAID \$

BACKFILL WORK ORDER ISSUED

DATE

APPROVED

DEPOSIT \$

SEWER WORK ORDER ISSUED

DATE

BY

The City of Mountlake Terrace

APPLICATION

CARD No.

SIDE SEWER PERMIT

OUTSIDE INSIDE REPAIRS

EASEMENT No. None

OWNER Iver Gilbert

HOUSE No. 22501 - 52nd W.


CONTRACTOR Wingfield

PERMIT No. 2965

STREET
AVENUE LOT NO. 16

BLOCK No.

NAME ADD. Valley Crest

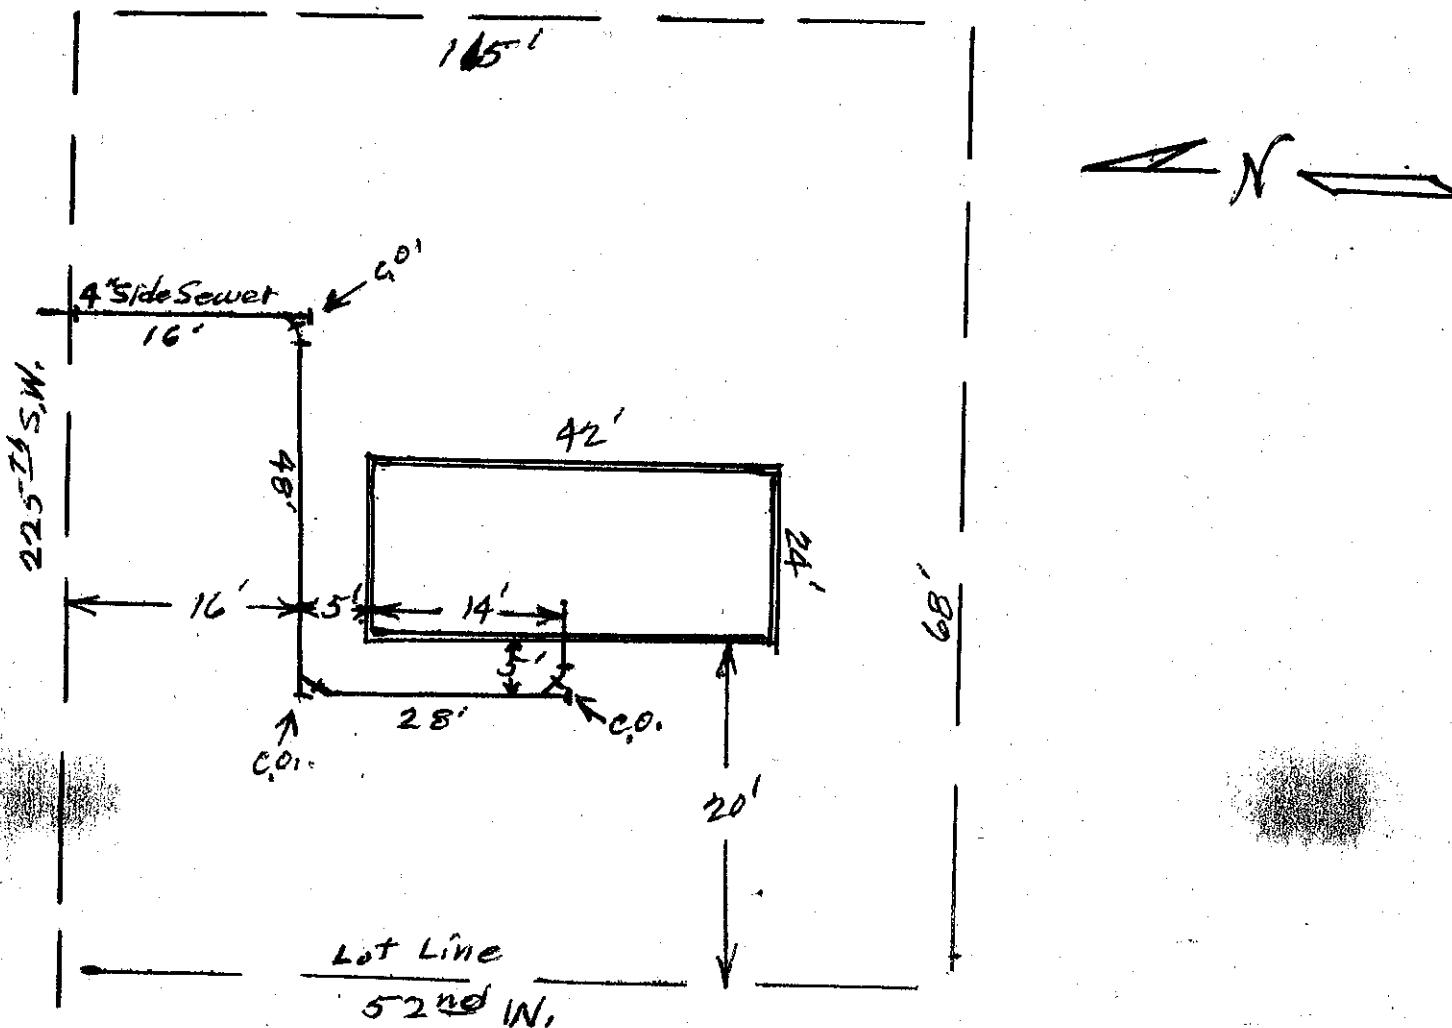

Date

Approved:

BACKFILL WORK ORDER ISSUED

DEPOSIT, \$

SEWER WORK ORDER ISSUED

DATE 12-4-61

The City of Mountlake Terrace

APPLICATION

SIDE SEWER PERMIT

OUTSIDE INSIDE REPAIRS

Sophia Jesse
CARD No.

EASEMENT No.

OWNER Sophia Jesse
HOUSE No. 23003 West 52 St

CONTRACTOR

Thunderbird Const

PERMIT No.

1789


STREET
AVENUE LOT No.

2

BLOCK No.

1 DIV 10

NAME ADD.

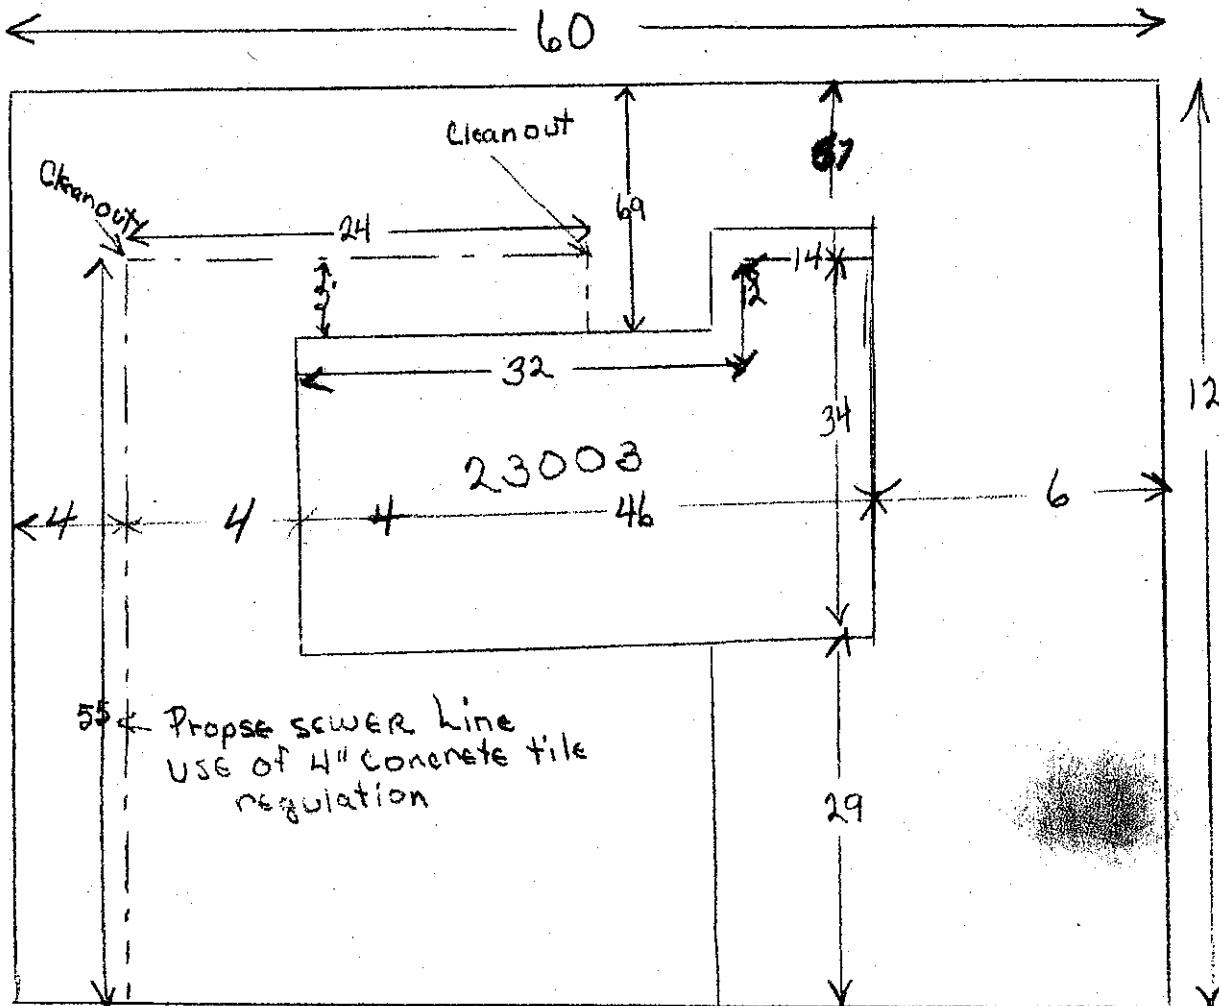

52 West

Date

Approved:

BACKFILL WORK ORDER ISSUED

DEPOSIT \$

10.00

SEWER WORK ORDER ISSUED

2/24/60
658

DATE 2-26-60

BY

J. Scott Holton MASTCON

CITY OF MOUNTLAKE TERRACE

APPLICATION

FOR
BUILDING PERMIT

OUTSIDE INSIDE REPAIRS

D. Bradshaw

CARD No.

BASEMENT No.

D. Bradshaw
No. 23004 524 W

CONTRACTOR

STREET

AVENUE LOT No. 19


NAME ADD.

12

PERMIT No.

1307

BLOCK No. 3

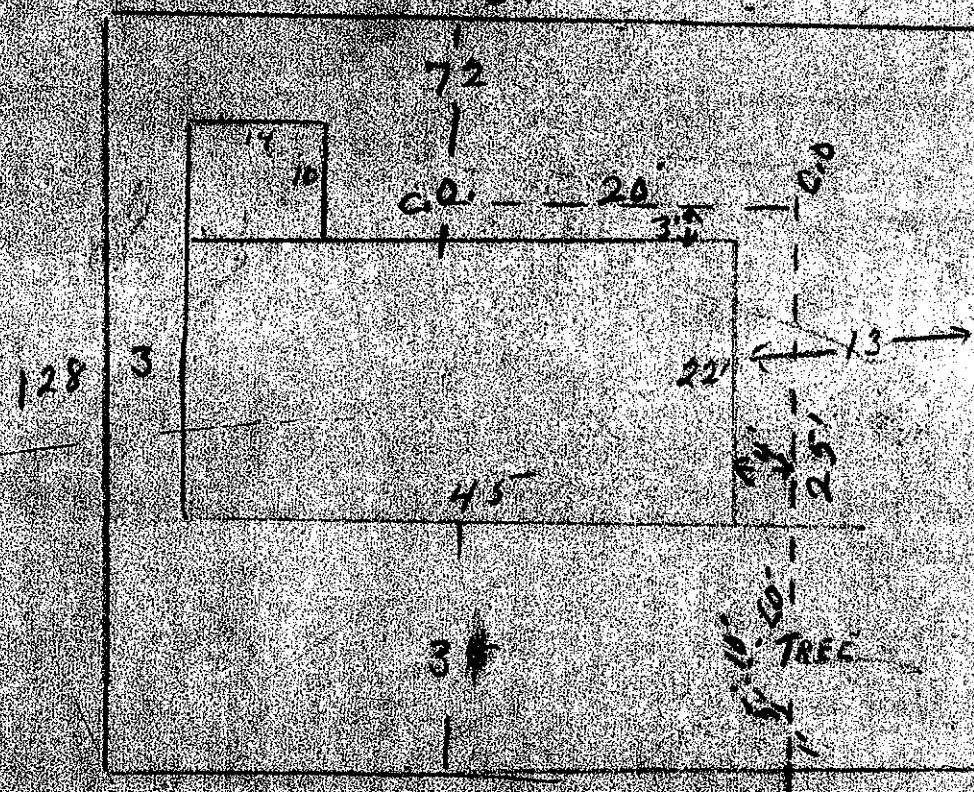

CITY OF
MOUNTLAKE TERRACE

DEC 9 1959

Plan Approved

J. Carlson
J. S. McH.

Date

Approved:

"ALL WORK ORDER ISSUED

DEPOSIT \$10 ~~12-8-59~~

12-8-59

DATE 12-9-59

PY

Scotia Holt

"WORK ORDER ISSUED

The City of Mountlake Terrace

APPLICATION

FOR

SIDE SEWER PERMIT

OUTSIDE INSIDE REPAIRS

CARD No. _____

EASEMENT No. _____

OWNER: Gerry Gourier

CONTRACTOR: B and C

PERMIT No. 1291


HOUSE No. 23005 - 52nd W 52nd

STREET

AVENUE LOT No. 3 - DIV 10

BLOCK No. 1

NAME ADD. _____

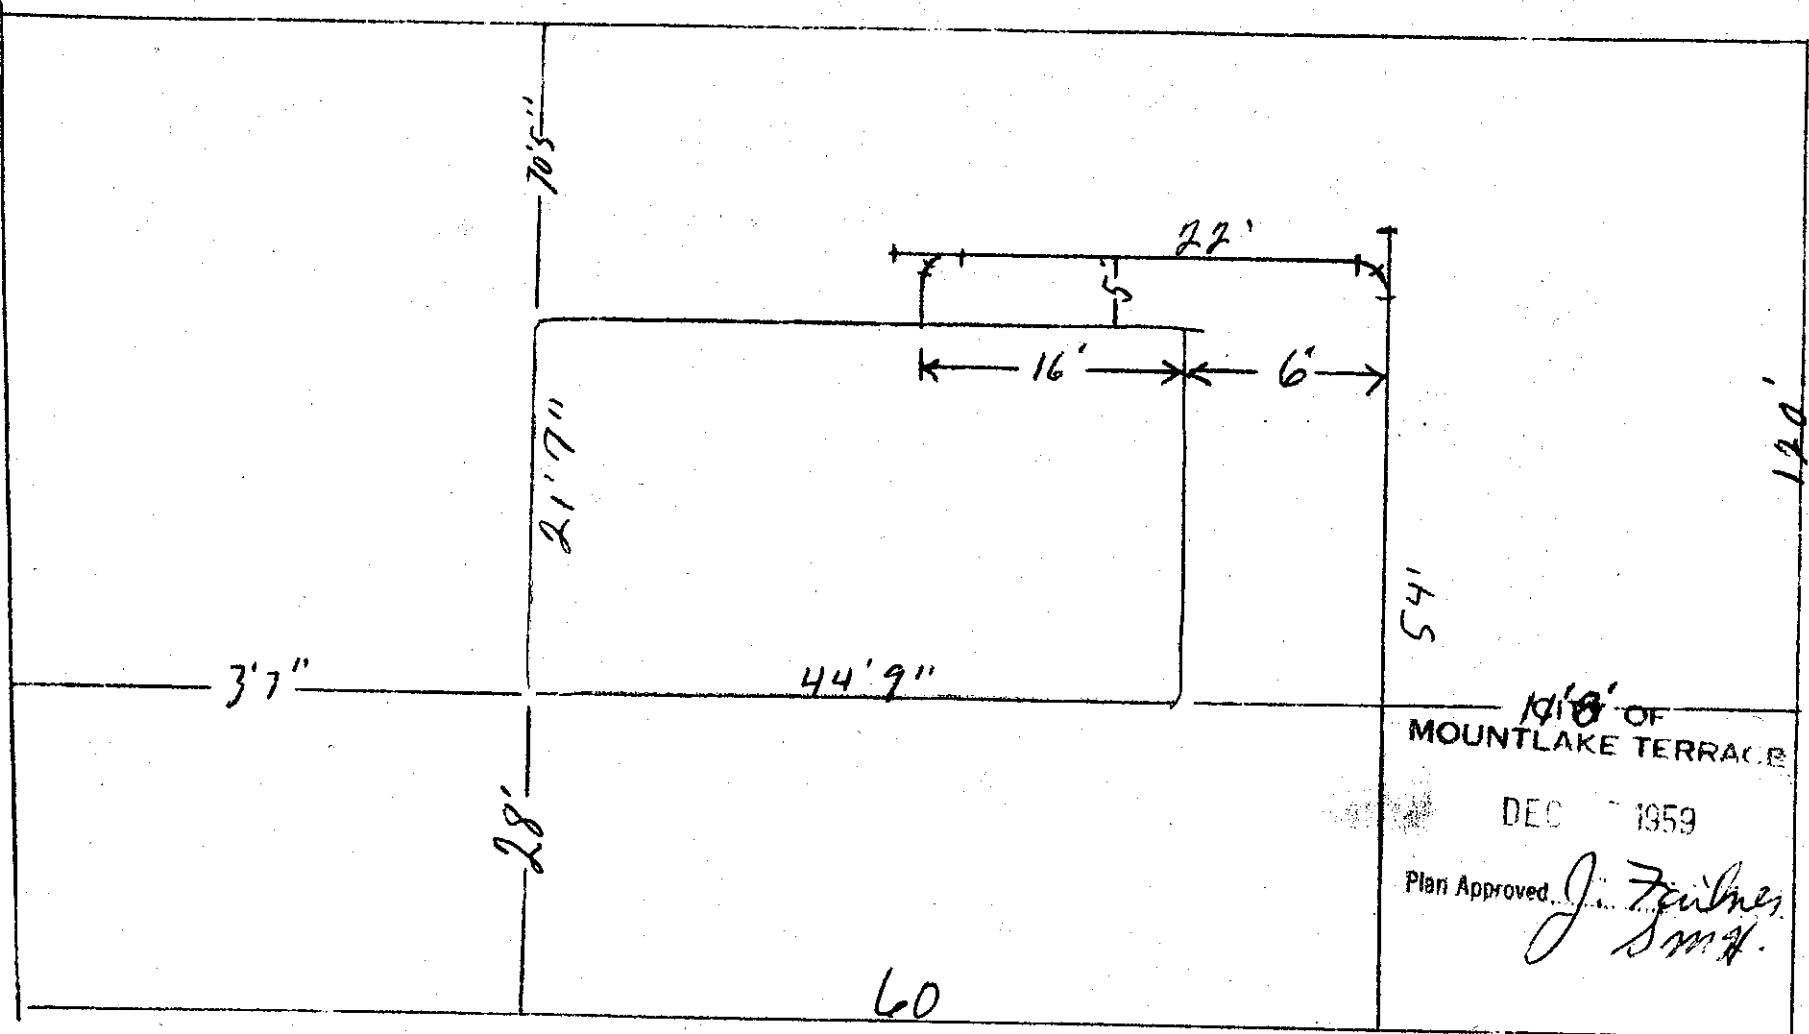

Date

Approved:

BACKFILL WORK ORDER ISSUED

DEPOSIT, \$ 10.00

SEWER WORK ORDER ISSUED

5512

DATE 12-7-59

12/7/59 - Deposit 3-11-60 Scott on Holton 115

The City of Mountlake Terrace

APPLICATION

SIDE SEWER PERMIT

OUTSIDE INSIDE REPAIRS

CARD No.

EASEMENT NO.

1364668

OWNER Hugh E. Marshall

HOUSE No. 23006 - 52 W

CONTRACTOR

Dweller

PERMIT No. 26576

STREET

AVENUE LOT No.


18

BLOCK No.

3

NAME ADD.

Div. 12

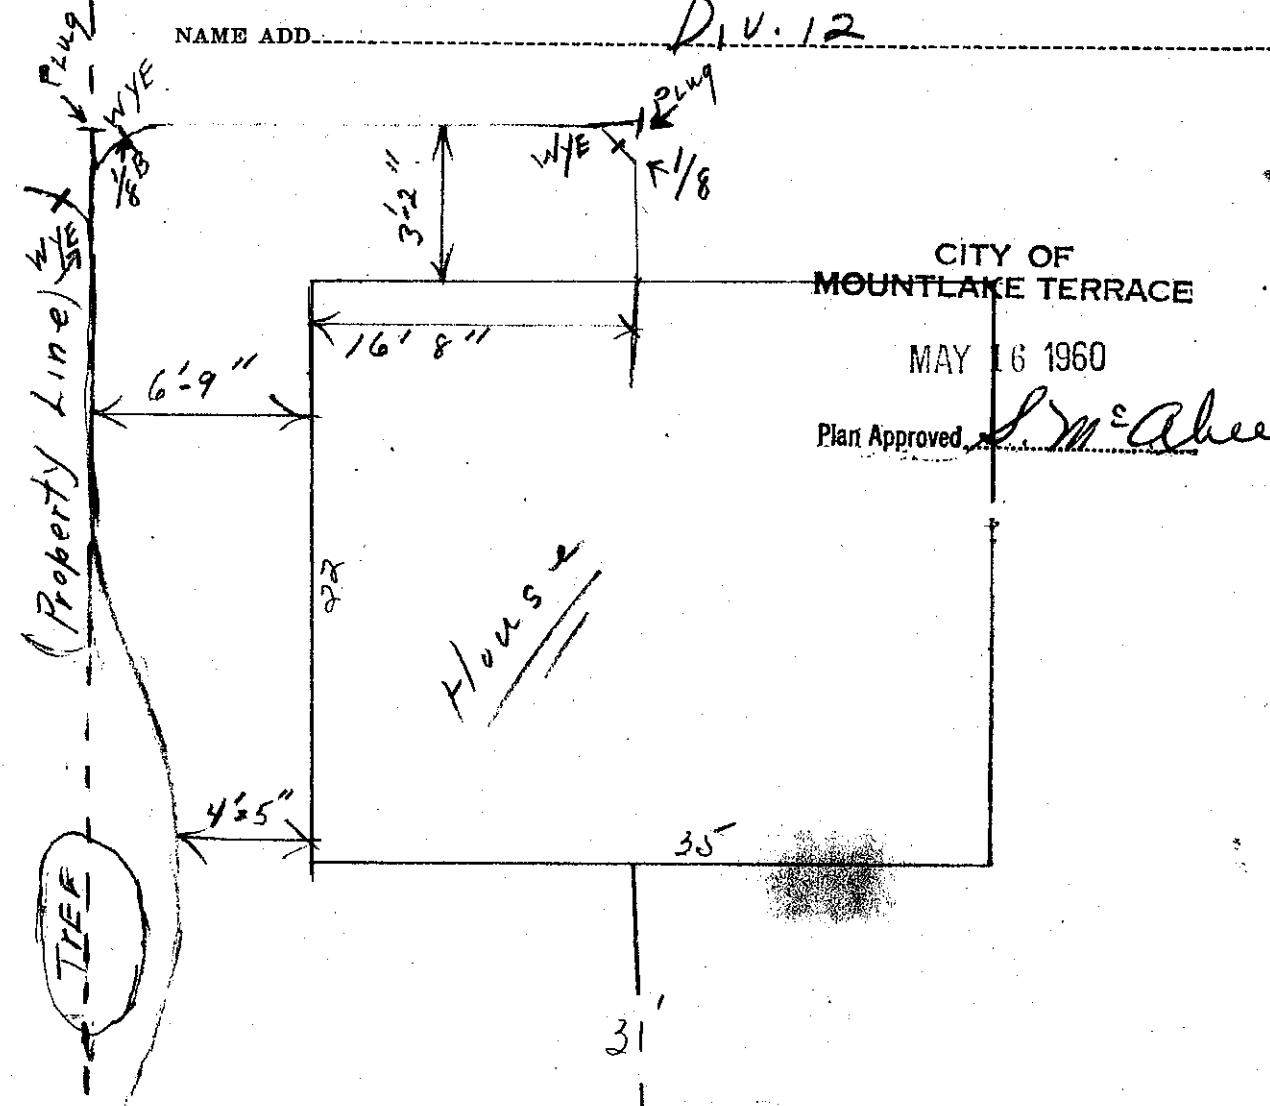

Date

BACKFILL WORK ORDER ISSUED

SEWER WORK ORDER ISSUED

DEPOSIT, \$10.00

Approved: 5/12/60

1439

DATE

5-16-60 BY S. M. Holton/NSTCON

The City of Mountlake Terrace

APPLICATION

SIDE SEWER PERMIT

OUTSIDE INSIDE REPAIRS

DURHOP
CARD No.

EASEMENT No.

OWNER: Durhop

HOUSE No. 23007 - 52nd St

CONTRACTOR

Hill Construction

PERMIT No. 1302

STREET


AVENUE LOT No.

4

BLOCK No.

NAME ADD.

Dev 10

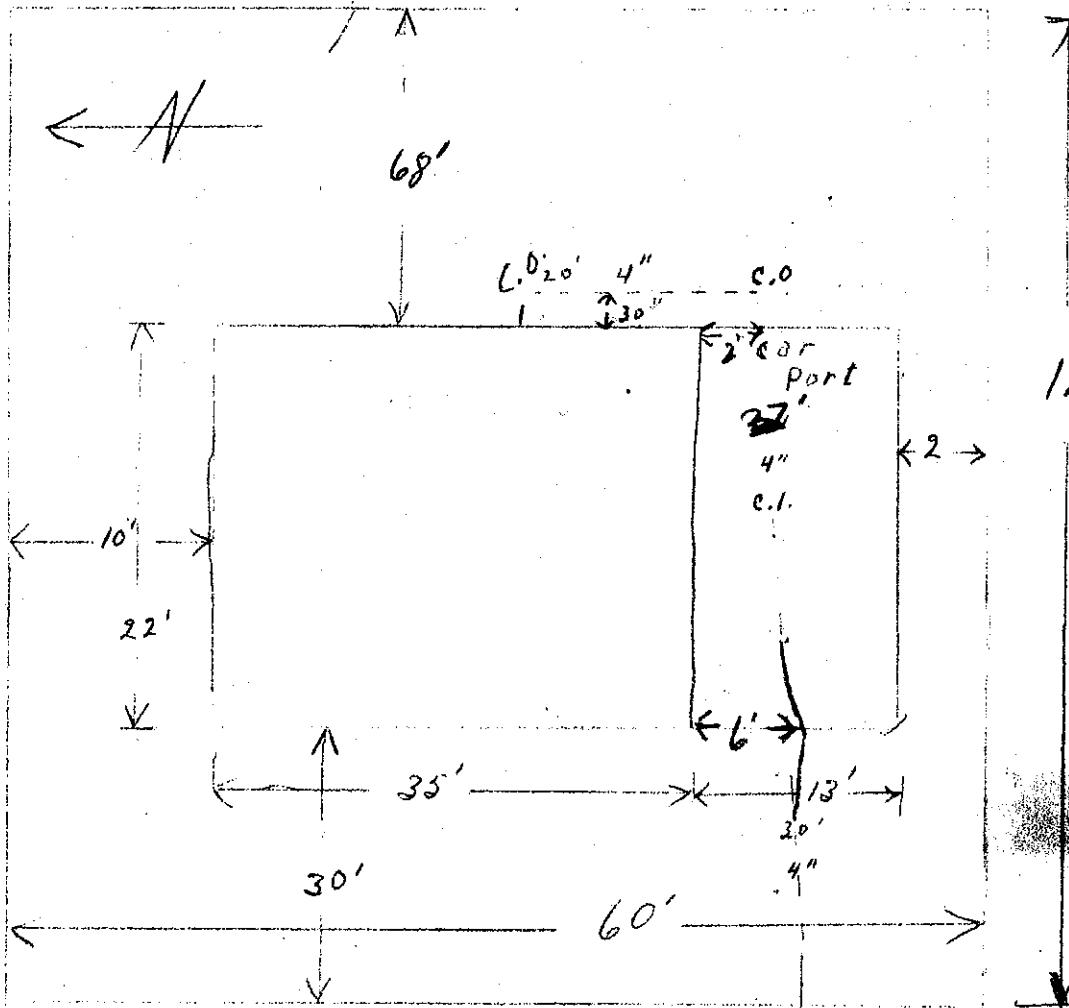

CITY OF
MOUNTLAKE TERRACE

DEC 10 1959

Plan Approved

J. Farney
S. Maff

Date

Approved:

BACKFILL WORK ORDER ISSUED

DEPOSIT, \$10⁰⁰ = 12-8-59

SEWER WORK ORDER ISSUED

5522

DATE 12-9-59

E.T.

Scott M Holton INS
3-4-60 INST CON Am H.
N.C.

APPLICATION

SIDE SEWER PERMIT

OUTSIDE INSIDE REPAIRS

W.W. MUNICIPALITY

CARD No.

The City of Mountlake Terrace

OWNER

H. H. McMurtry

HOUSE No. 23008

TH S'Z

EASEMENT No. 1364668

CONTRACTOR Owner

PERMIT No. 26465

STREET

AVENUE LOT NO.

17


BLOCK NO. 3

NAME ADD.

DIV. 12

CITY OF
MOUNTLAKE TERRACE

MAY 16 1960

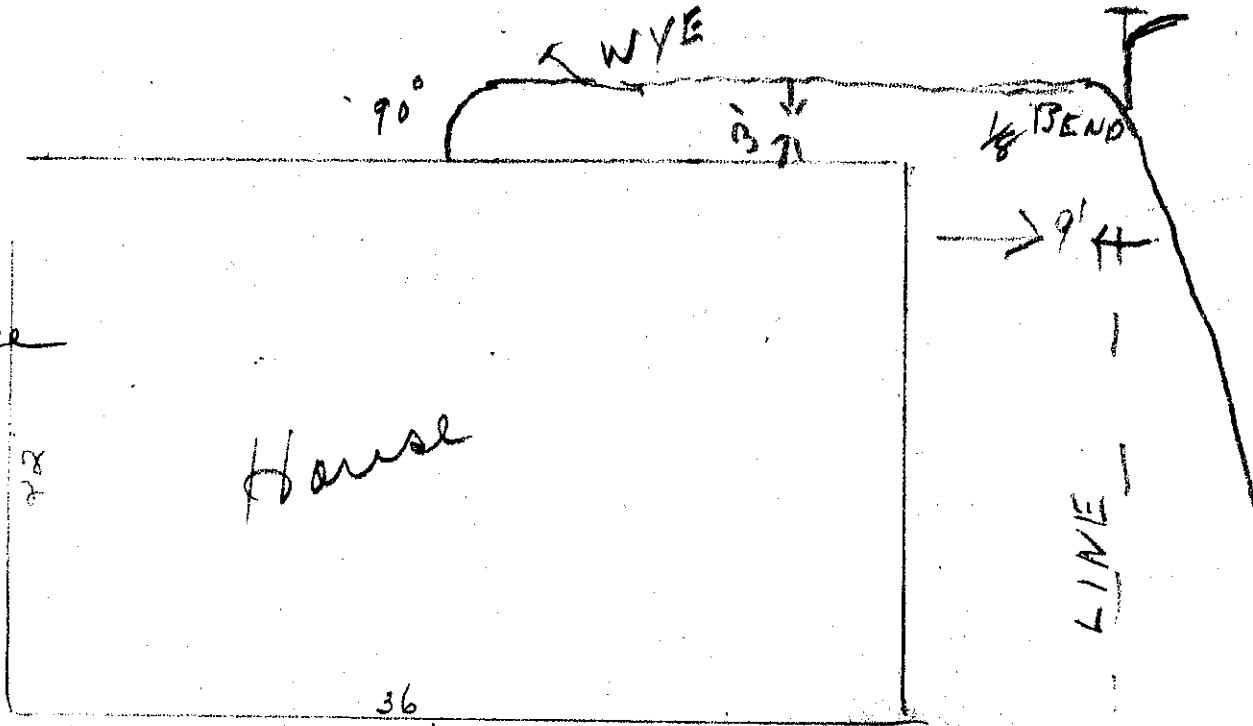Plan Approved S. M. Ahern

Date

Approved:

BACK FILL WORK ORDER ISSUED

DEPOSIT, \$10.00

5/14/60

SEWER WORK ORDER ISSUED

1426

DATE

5-16-60 BY S. M. Holton INST CON

The City of Mountlake Terrace

APPLICATION

SIDE SEWER PERMIT
OUTSIDE INSIDE REPAIRS

G. NORT' Sope
CARD No. _____

OWNER G. NORT' Sope
HOUSE No. 23010 W. 52nd

CONTRACTOR HILLS CONST


STREET AVENUE LOT No. 16

PERMIT No. 1221

EASEMENT No. _____

3

NAME ADD. 12

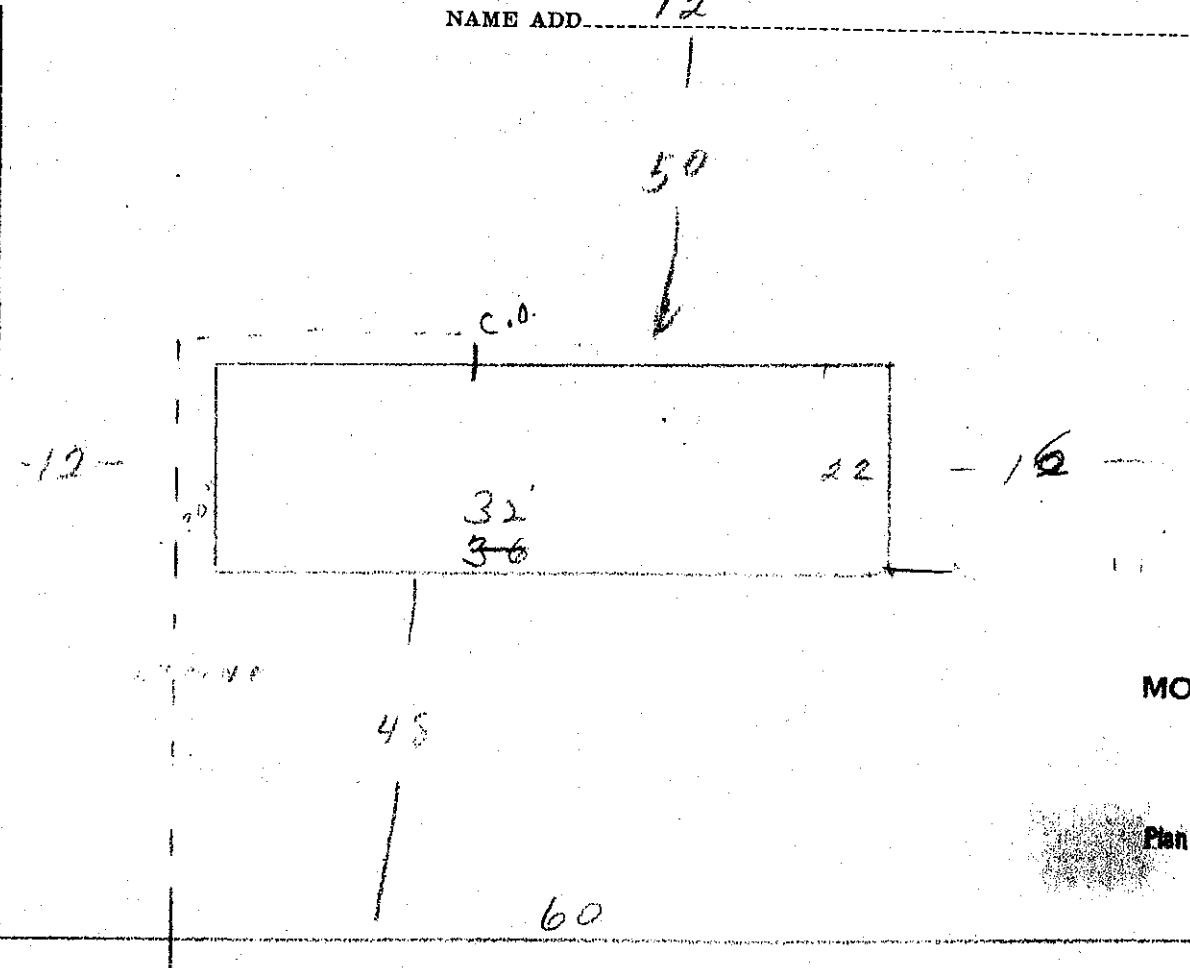

CITY OF
MOUNTLAKE TERRACE

DEC 1 1959

Plan Approved.

J. Failles
SM

Date

BACKFILL WORK ORDER ISSUED

DEPOSIT, \$10.00

SEWER WORK ORDER ISSUED

11/24/59
5449

Approved:

DATE BY

3-4-60 INST CON DEM H.

APPLICATION

THE PINE MOUNTAINS

CARD No.

The City of Mountlake Terrace

SIDE SEWER PERMIT

OUTSIDE **INSIDE** **REPAIRS**

EASEMENT No. 1319343

A. F. Anderson.

OWNER: John C. Smith

HOUSE No. 23101 52 W

CONTRACTOR *R. D. Johnson Const. Co.*

PERMIT No. 1530

STREET


AVENUE LOT No..

1

— BLOCK No.

NAME ADD

Xiv 14
126

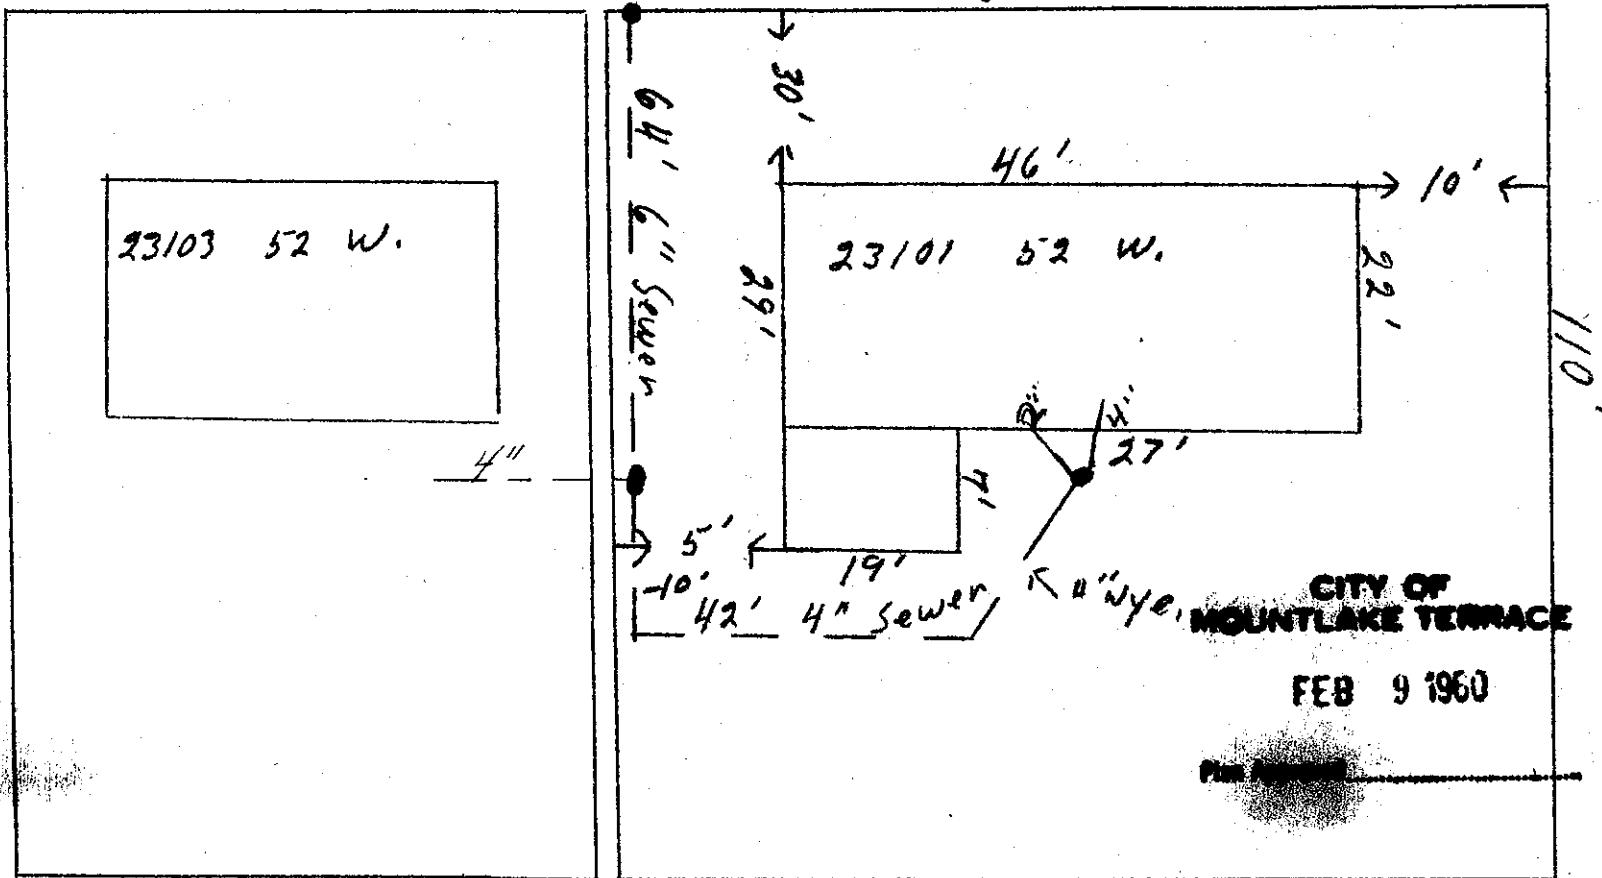

**BACKFILL WORK ORDER ISSUED.
SEWER WORK ORDER ISSUED.**

Date

DEPOSIT : 10.00

Approved

© 1966 RATE

878

ed:
2-10-60 BY Scott M Holton/NSTCOP

City of Duluth, Minnesota

SIDE SEW
INSIDE

EASEMENT No. None

OWNER Alice J. Mank

CONTRACTOR Z. Zeld


PERMIT No. 391

HOUSE No. 23102 - 52nd W.

STREET AVENUE LOT No. 15

BLOCK No. 3

NAME ADD Div. #12

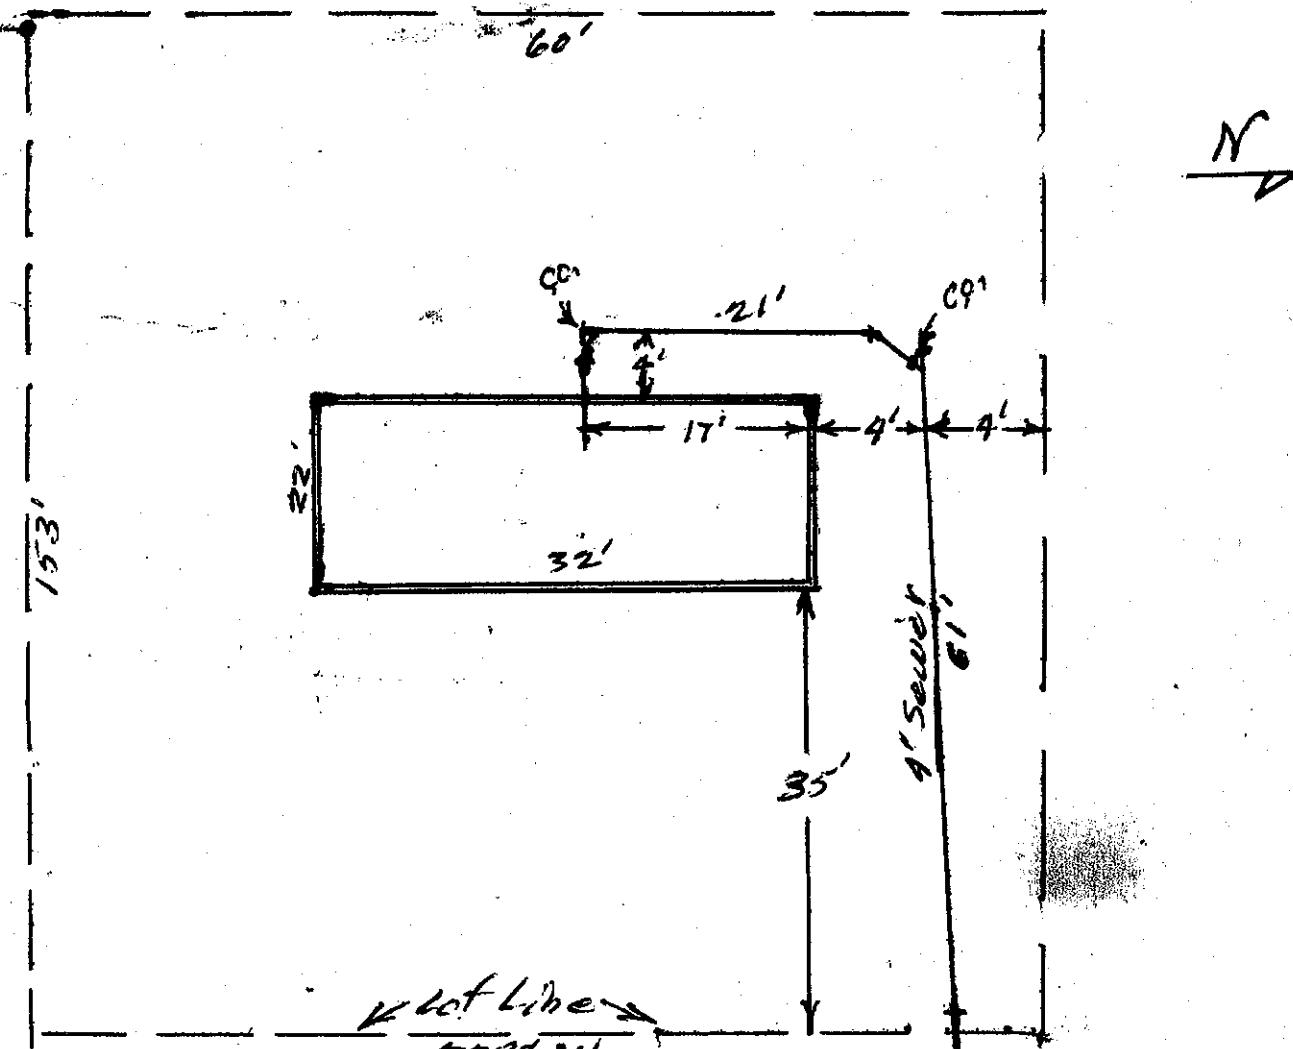

Date

5-22-60

Approved:

BACKFILL WORK ORDER ISSUED

DEPOSIT, \$10 .00

1823

SEWER WORK ORDER ISSUED

DATE 8-19-60

BY J.M. Holton INS+CON

8-19-60

The City of Mountlake Terrace

APPLICATION

H.F. 1001
CARD No. _____

SIDE SEWER PERMIT

OUTSIDE INSIDE REPAIRS

EASEMENT No. _____

OWNER Allynn E. Malean
HOUSE No. 2310 1/2 W 52nd


CONTRACTOR my self

STREET
AVENUE LOT No. 14

PERMIT No. 1001

BLOCK No. 3

NAME ADD.

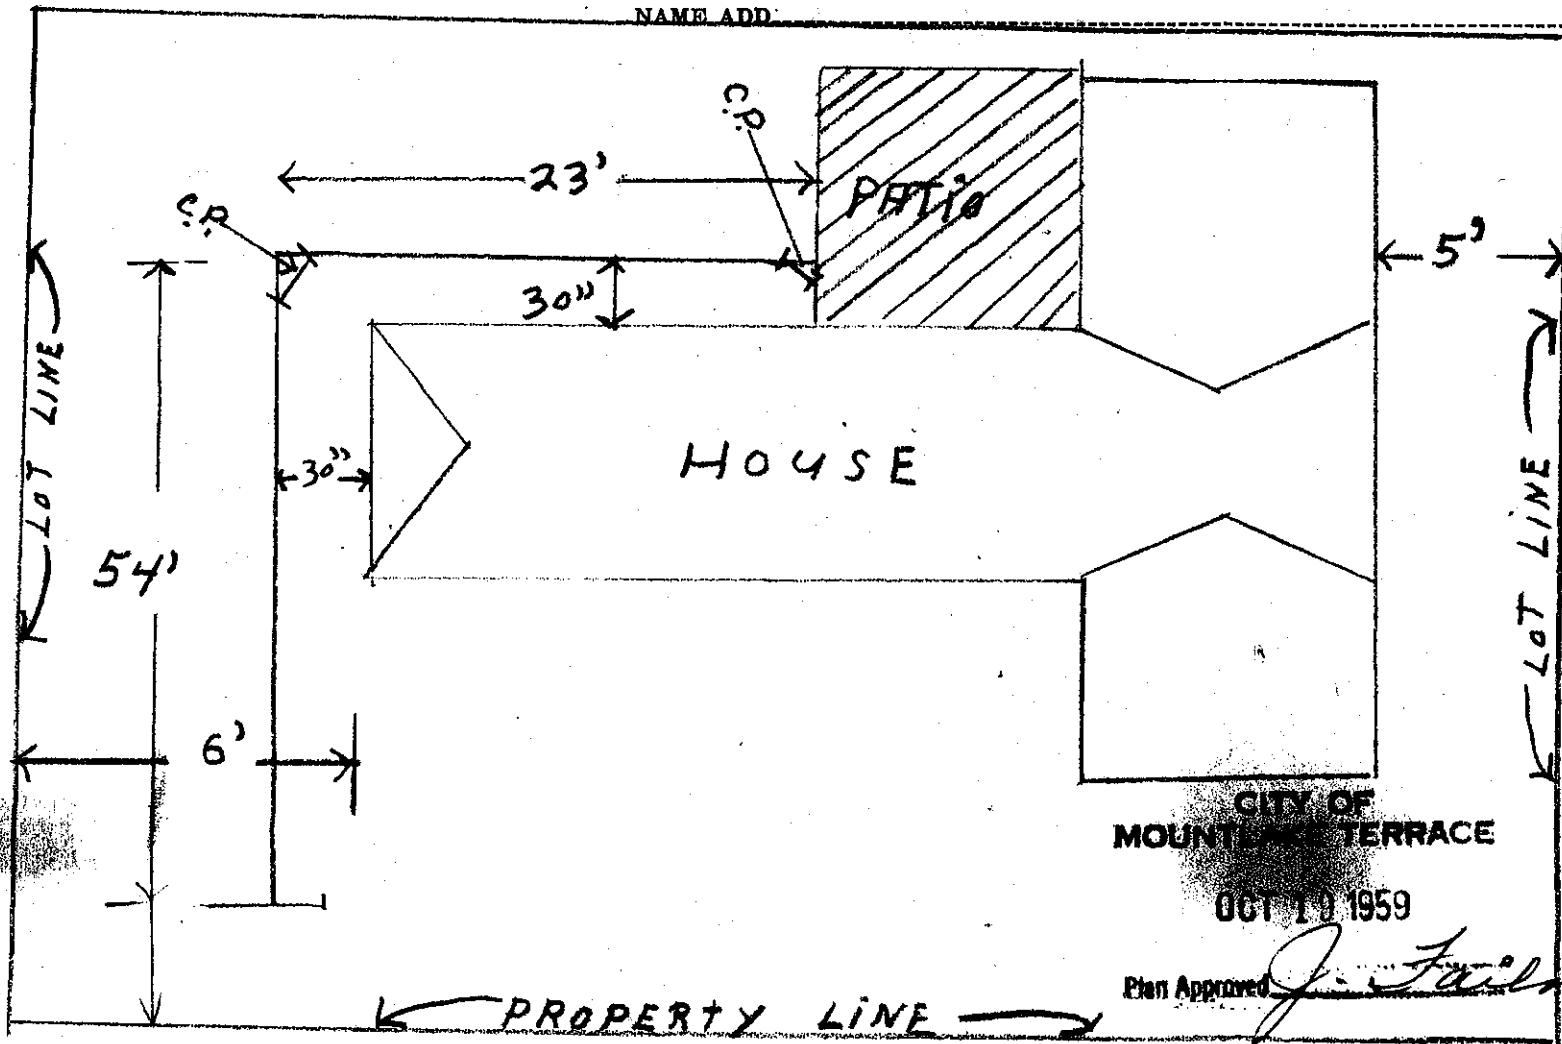

Date

Approved:

BACKFILL WORK ORDER ISSUED

DEPOSIT, \$ 11.00

SEWER WORK ORDER ISSUED

10-19-59

DATE


BY

J. Fairless

3/10/2014

ID-14-0001
23105-52nd Ave West

Z ↑

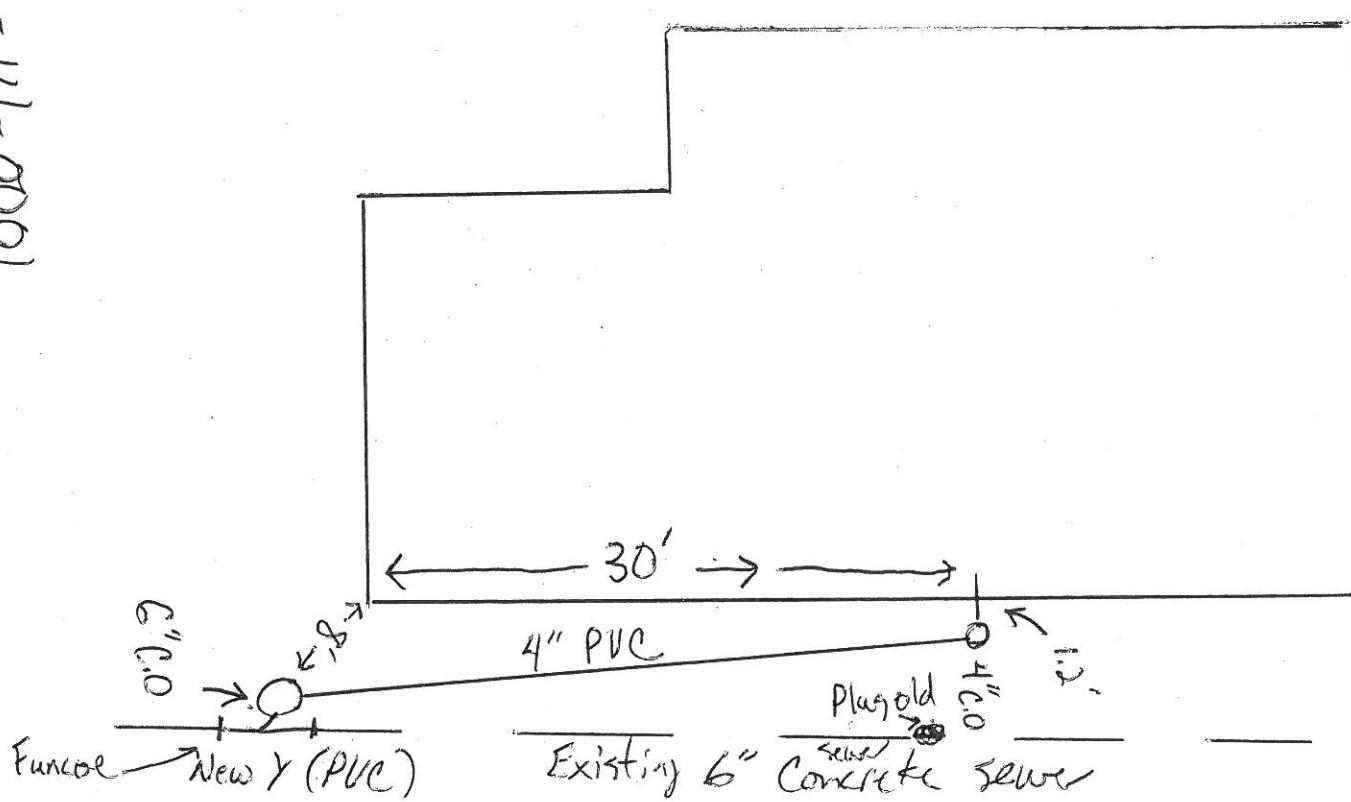

(2) *
The City of Mountlake Terrace

APPLICATION

EDWARD H. FREDRICKSON

CARD No.

EASEMENT No.

13721841

SIDE SEWER PERMIT

OUTSIDE INSIDE REPAIRS

OWNER Edward H. Frederickson

CONTRACTOR Self

PERMIT NO. 829

HOUSE No. 23106-LWS


STREET

AVENUE LOT No.

Lot 13 Blk 3 Dir 12

BLOCK No.

NAME ADD.

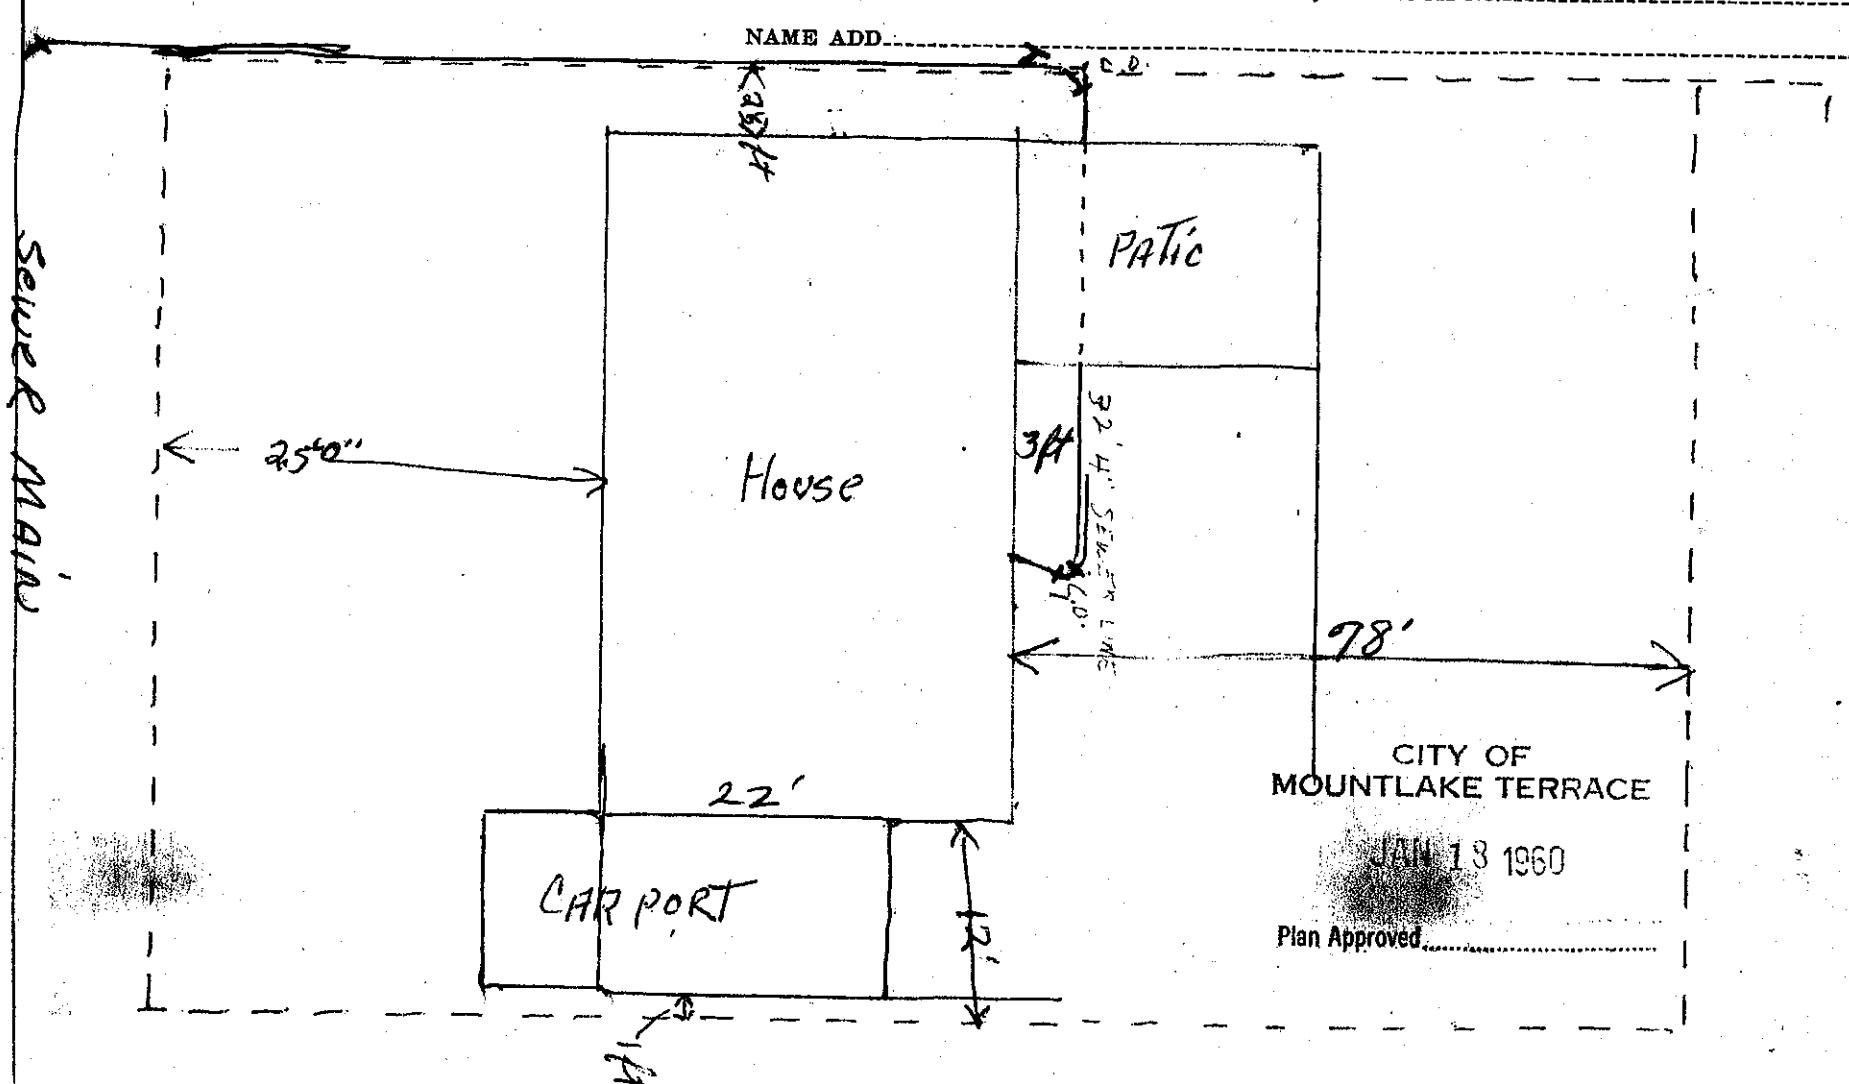

Date

Approved:

BACKFILL WORK ORDER ISSUED

DEPOSIT, \$10

9-12-59

SEWER WORK ORDER ISSUED

DATE

1-19-60 BY Scott M Holton, MS N.C.

9-26-60 IN 54 COND. R.H.

The City of Mountlake Terrace

APPLICATION

ROBERT E. KIMMEL

CARD No.

SIDE SEWER PERMIT

OUTSIDE INSIDE REPAIRS

EASEMENT No. 1377419

OWNER ROBERT E. KIMMEL


HOUSE No. 23107-W 52

CONTRACTOR RAY A STEWART, CO PERMIT No. 883

STREET AVENUE LOT No. #9

BLOCK No. #1

NAME ADD. MLT # 10

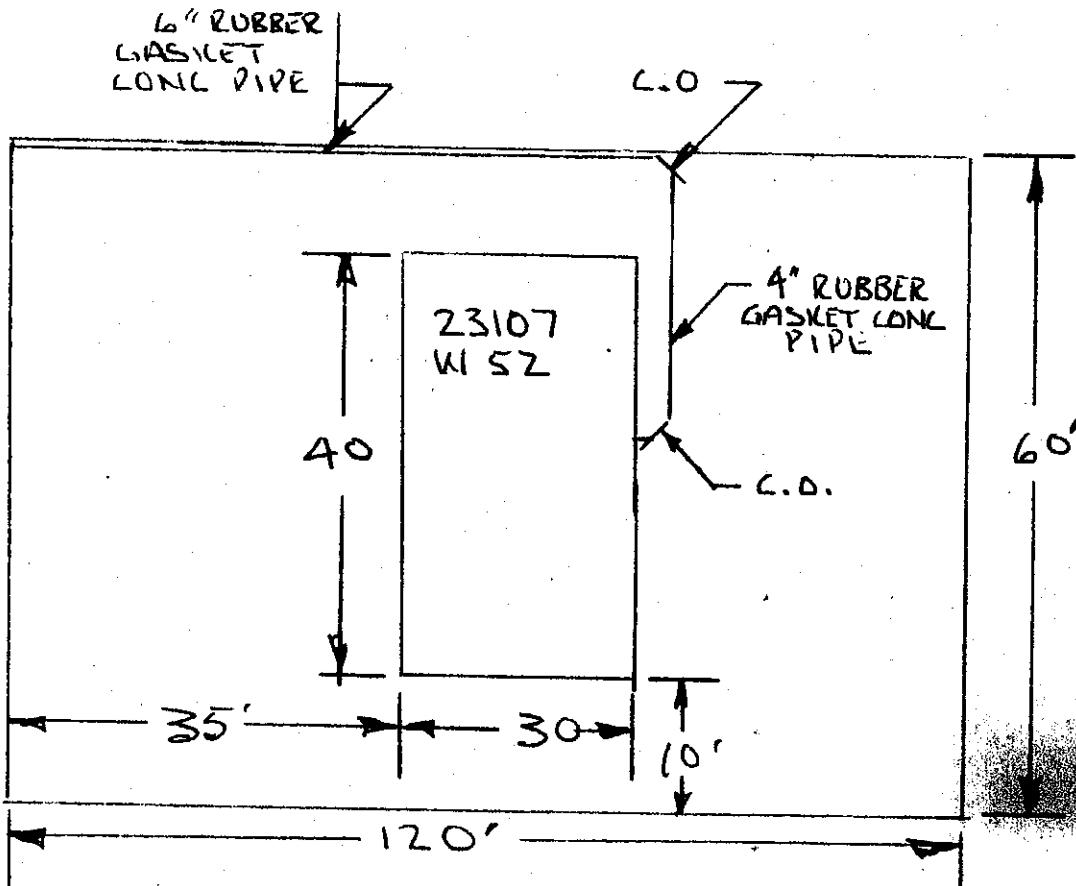

CITY OF
MOUNTLAKE TERRACE

NOV 24 1959

Plan Approved J. Fairless
SM

Date

Approved:

BACKFILL WORK ORDER ISSUED

SEWER WORK ORDER ISSUED

DEPOSIT, \$10.00

9-21-59

THE 4945

DATE 1-6-60

BY Scott on Holton INS INC

2-29-6x INSTCON SMT

20
The City of Mountlake Terrace

APPLICATION

PR. 8-2926

CHARLES E. Casagualdo

CARD No.

1372184 ✓

SIDE SEWER PERMIT

OUTSIDE INSIDE REPAIRS

D.A. 2-17-60

EASEMENT No.

OWNER Charles E. Casagualdo
HOUSE No. 23108 W. 52nd Ave.

CONTRACTOR

self

PERMIT No. 1164

STREET

AVENUE LOT No.


12

BLOCK No.

3

NAME ADD.

12

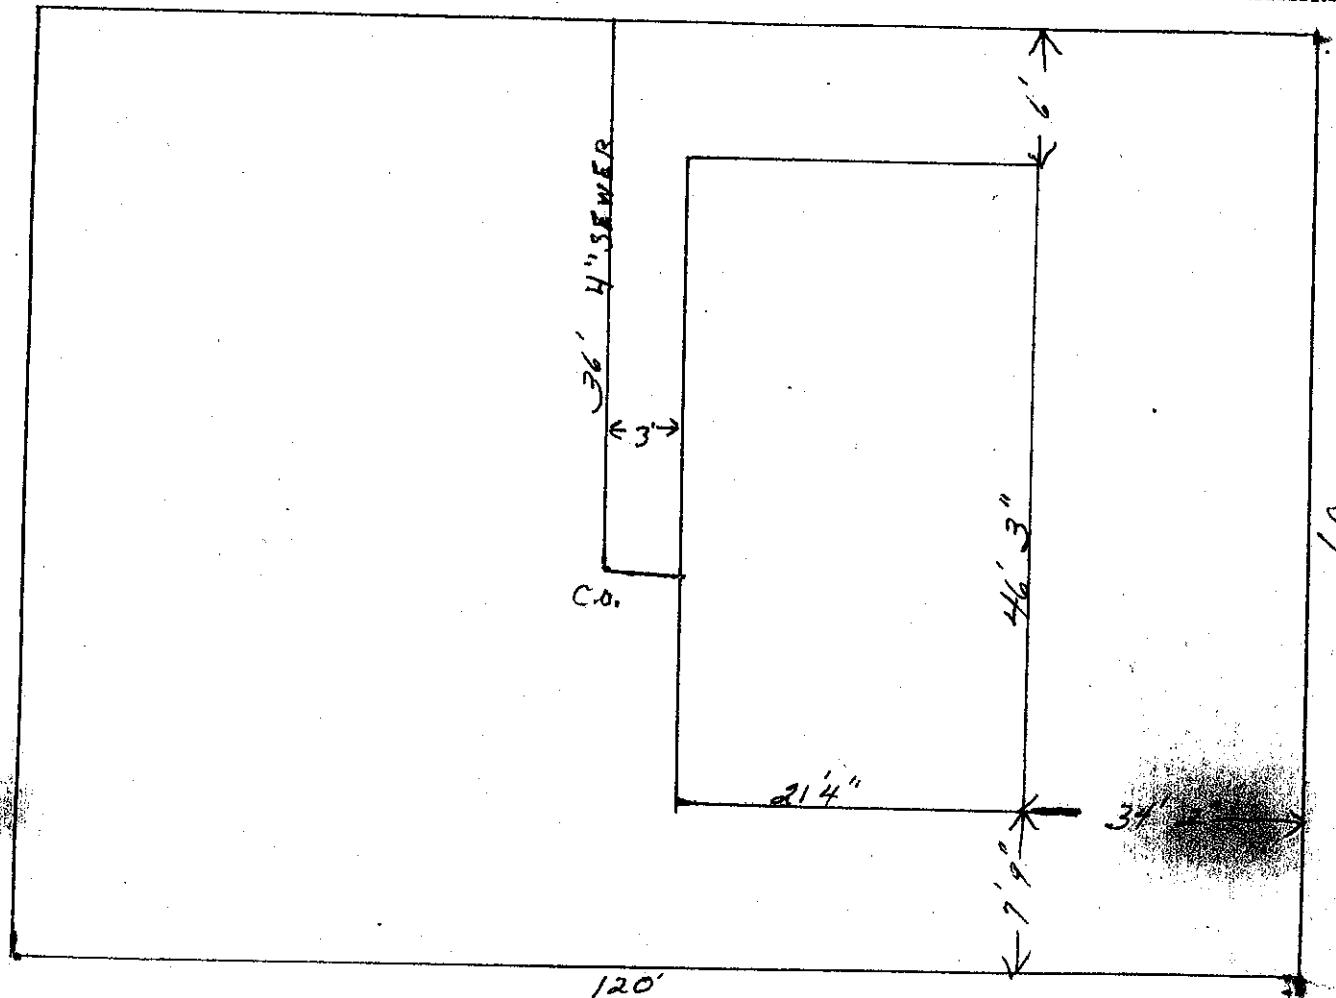

Date

BACKFILL WORK ORDER ISSUED

SEWER WORK ORDER ISSUED

DEPOSIT, \$10.00

Approved:

11-16-59

5389

DATE

12-8-59 BY Scott Mr. Holton IWS
9-19-68 INST. OF 1MAY IV.C.

APPLICATION

The City of Mountlake Terrace

SIDE SEWER PERMIT

CARD No.

OUTSIDE **INSIDE** **REPAIRS**

EASEMENT No. 1359048

OWNER: Billy E. & Frances R. Hadenfeldt

23204 West 52nd &

~~HOUSE No. - 5802 - 270-1 S.W.~~

CONTRACTOR.

Power

PERMIT No. 100

STREET

AVENUE

AVENUE LOT No. 19 & 20

NAME ADD.

Ad. 6

52 w

52 w

.. BLOCK No.4

PERMIT No. 160


MS. S. 1. 2nd

5202 232nd SW

Date

DEPOSIT.

**BACKFILL WORK ORDER ISSUED
SEWER WORK ORDER ISSUED**

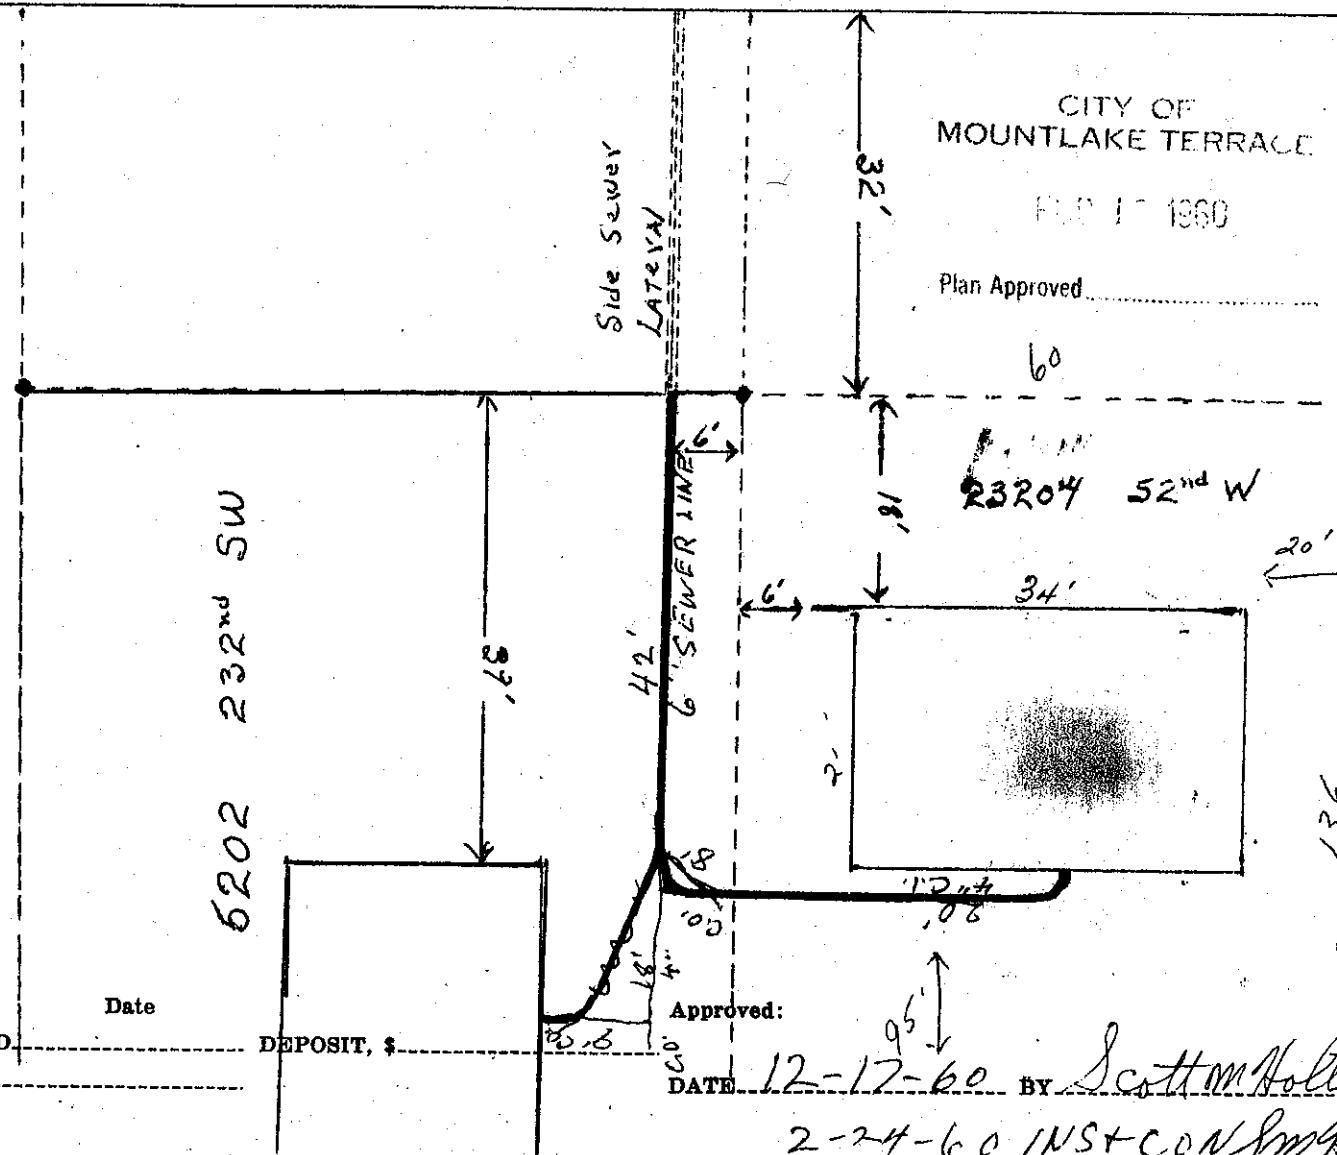

Approved.

DATE

12-17-60 BY Scott M Holton, MS NC

2-24-60 INST CON 8M91

The City of Mountlake Terrace

APPLICATION

L. H. DR. Schler
CARD No.

SIDE SEWER PERMIT

OUTSIDE INSIDE REPAIRS

EASEMENT No.

OWNER Lewis H Broschler

CONTRACTOR R.D. Johnson

PERMIT No. 2503


HOUSE No. 23205 52 W

STREET AVENUE LOT No. 3

BLOCK No. 51

NAME ADD. D10, 10

23205 52 W

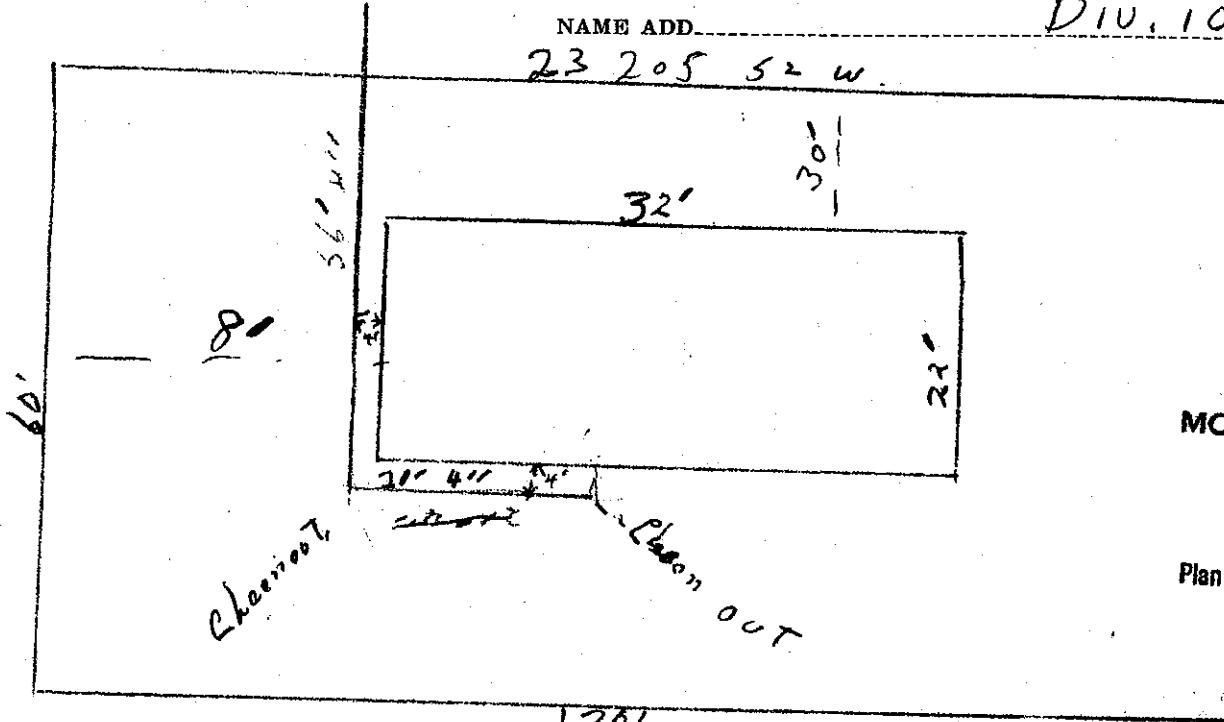

CITY OF MOUNTLAKE TERRACE

APR 19 1960

Plan Approved J. McAlhee

Date

BACKFILL WORK ORDER ISSUED

SEWER WORK ORDER ISSUED

DEPOSIT, \$10.00

4/18/60
1289

Approved:

DATE 4-19-60

BY S. M. Holton INST COX

The City of Mountlake Terrace

APPLICATION

CARD No.

SIDE SEWER PERMIT

OUTSIDE INSIDE REPAIRS

EASEMENT No.

OWNER Mr + Mrs Frank H Beard

HOUSE No. 23206 52nd West

CONTRACTOR

STREET


AVENUE LOT No. 18

PERMIT No.

2698

NAME ADD.

BLOCK No. 4 Div #6

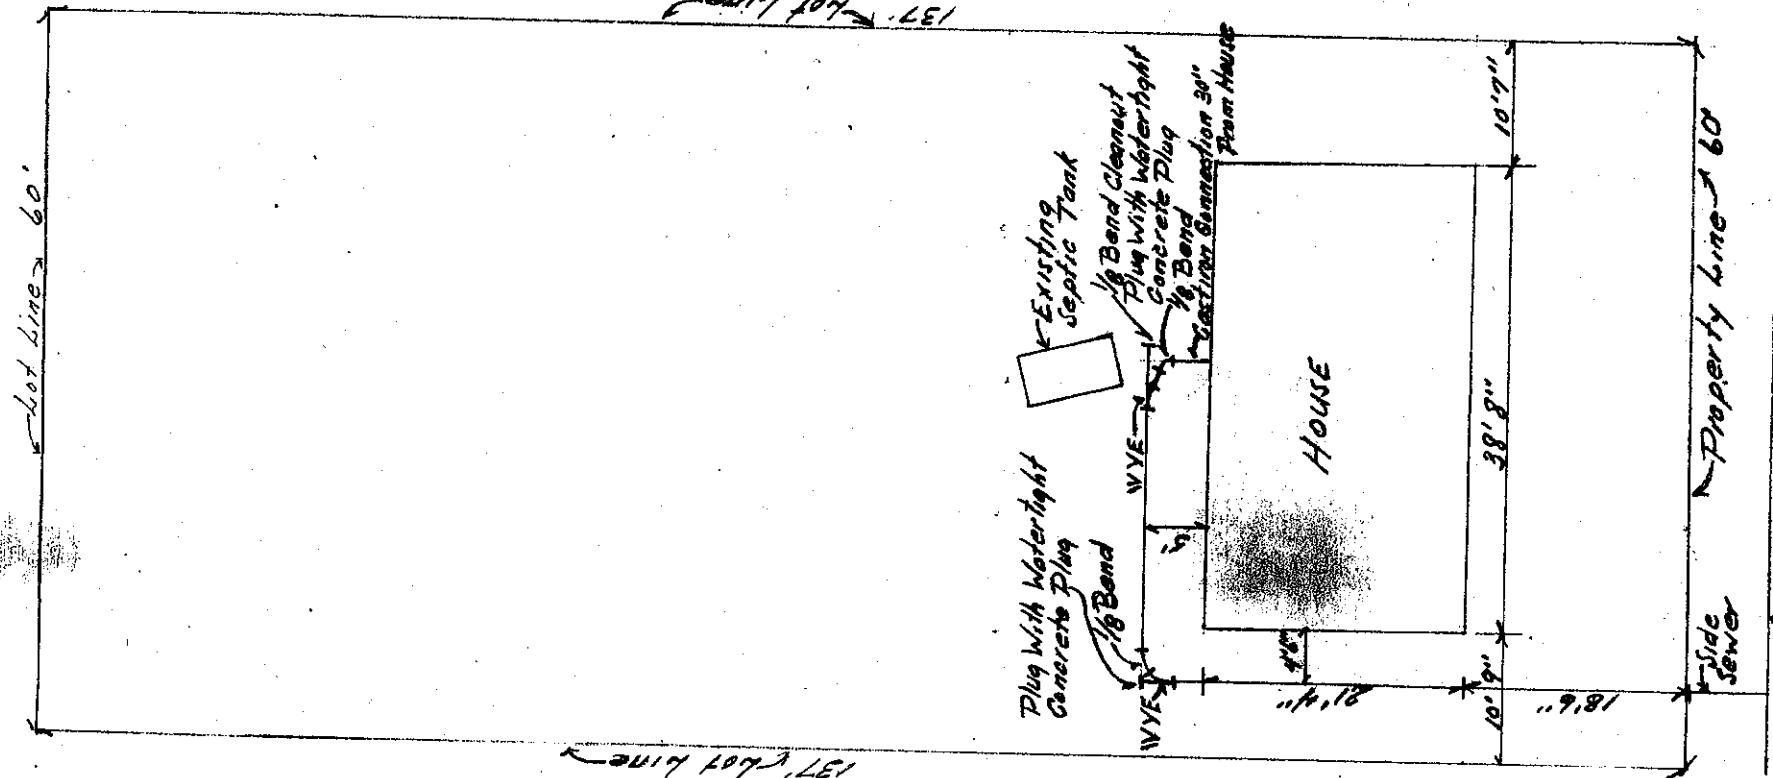

Date

BACKFILL WORK ORDER ISSUED

DEPOSIT \$10.00 5/19/60

Approved:

SEWER WORK ORDER ISSUED

1487

DATE 8-17-60

BY J. M. Holton INST CON

The City of Mountlake Terrace

APPLICATION

A.J.C.J.

CARD No.

SIDE SEWER PERMIT

OUTSIDE INSIDE REPAIRS

EASEMENT No.

1358844

OWNER ALLEN J. COOK
HOUSE No. 23302 West 52nd.

CONTRACTOR same


PERMIT No. 255

STREET AVENUE LOT No. 15

BLOCK No. 4

NAME ADD. Div 6

W. 52ND STREET
S. OF MAIN

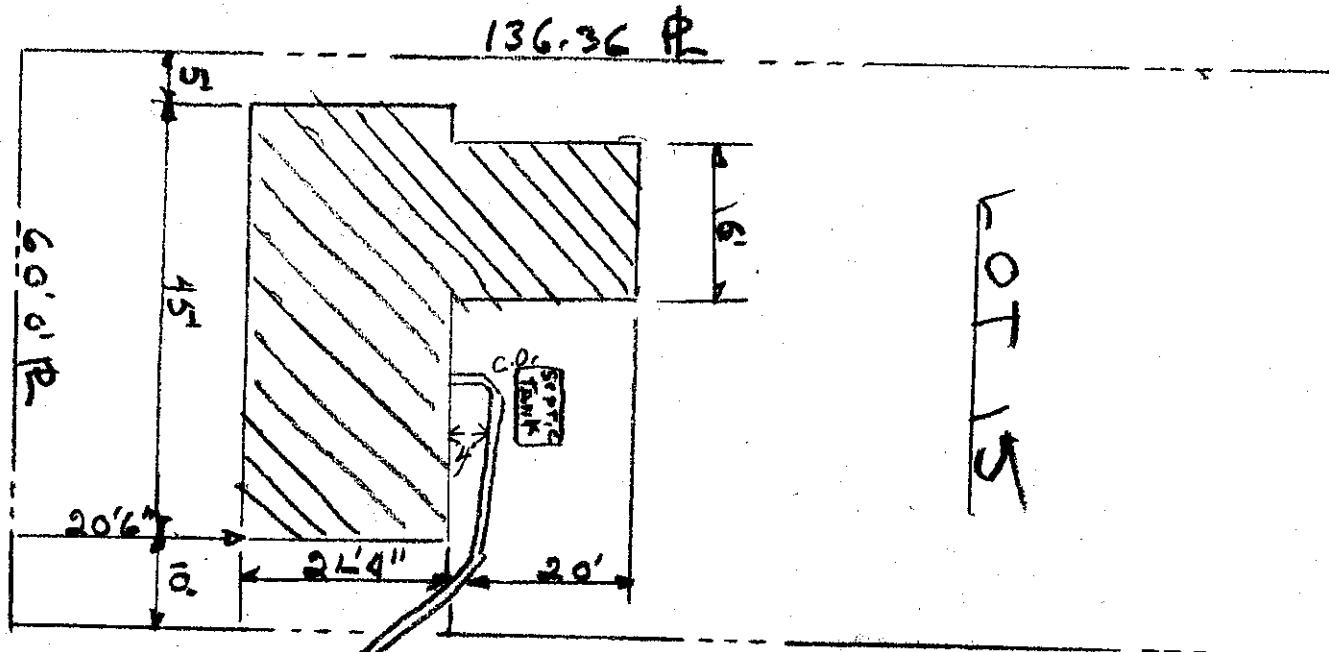

BACKFILL WORK ORDER ISSUED
SEWER WORK ORDER ISSUED

Date

DEPOSIT, \$ 10.00

Approved:

7/14/60
#1701

DATE

7-14-60

BY

Sam M. Hoffer, Inv.

The City of Mountlake Terrace

APPLICATION

O. GAUSSMAN

CARD NO.

EASEMENT No. 1357803

SIDE SEWER PERMIT

OUTSIDE INSIDE REPAIRS

OWNER O. Gausman

HOUSE No. 23401-52 nd W. M. L.

CONTRACTOR Brand E. const.

PERMIT No. 961


STREET

AVENUE LOT No. 1

NAME ADD.

BLOCK No. 9

DIV. 11

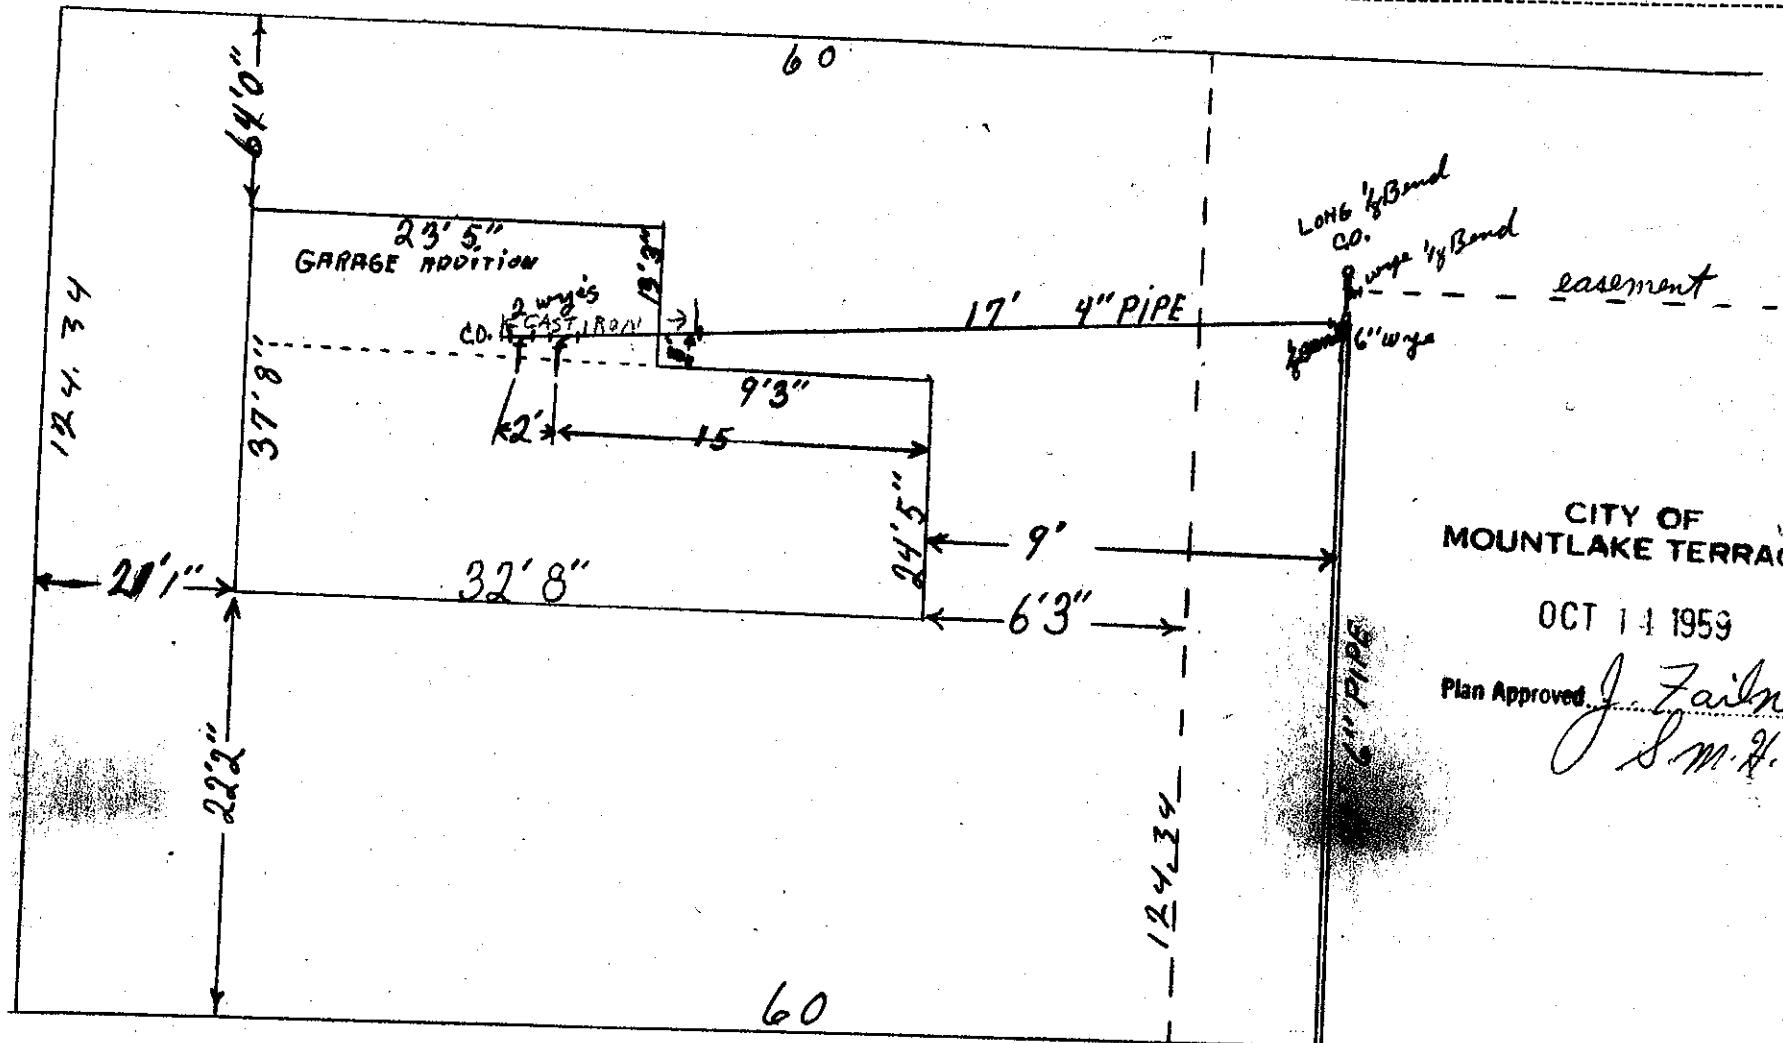

Date

DEPOSIT, \$10.00

Approved:

BACKFILL WORK ORDER ISSUED
SEWER WORK ORDER ISSUED

Receipt 513
Oct 19 1959

DATE 10-15-59 BY Scott M Holl JNS
10-15-59 10-15-59 10-15-59

The City of Mountlake Terrace

APPLICATION

J. GABORIAULT


CARD No.

SIDE SEWER PERMIT

OUTSIDE INSIDE REPAIRS

EASEMENT NO.

OWNER J. Gaboriault PERMIT NO. 955
HOUSE No. 23404-52nd W. M.L.T. CONTRACTOR B. and C. const co.
STREET AVENUE LOT No. 19 BLOCK No. 3
NAME ADD. DIV. 7

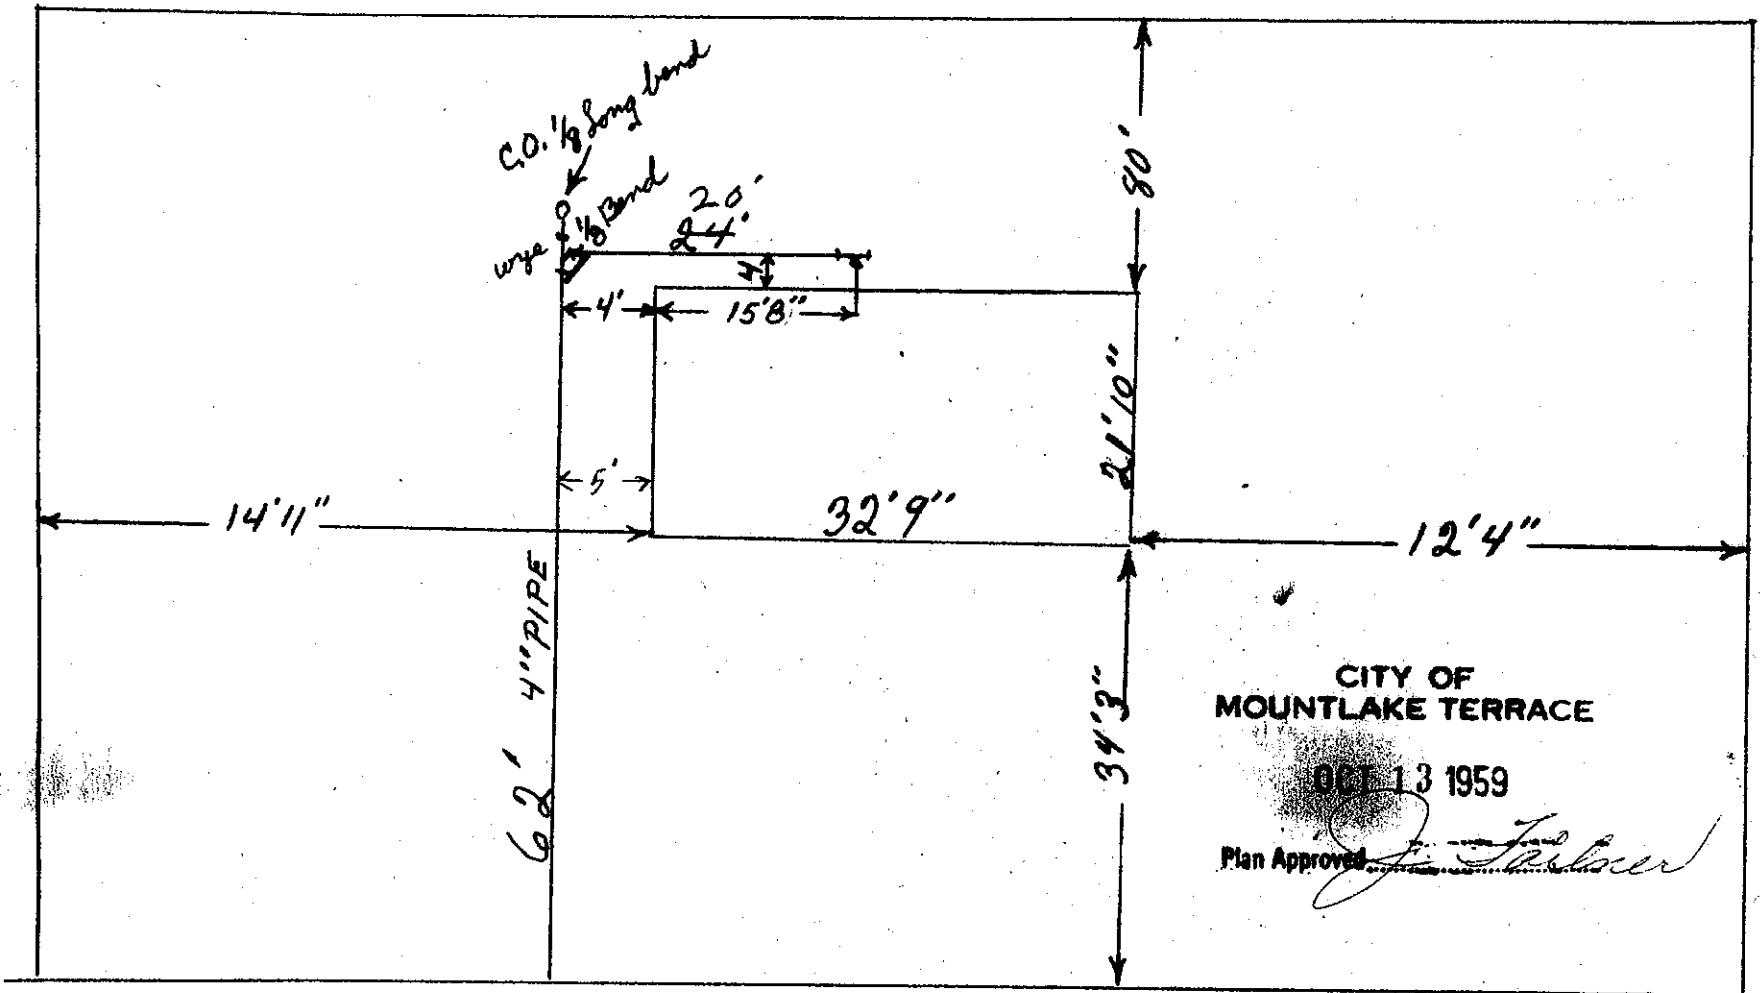

Date

Approved:

BACKFILL WORK ORDER ISSUED.....

SEWER WORK ORDER ISSUED.....

DEPOSIT, \$10.00

Rec. 5110
August 19/59

DATE 10-15-59 BY Scott on Holt

7-7-1A INSTANT D.M.H.

APPLICATION

SIDE SEWER PERMIT

The City of Mountlake Terrace

CARD No. _____

OUTSIDE INSIDE REPAIRS

EASEMENT No. _____

OWNER R. Cline

HOUSE No. 23406 - 52nd W. M.L.T.

CONTRACTOR B. and E. Const

PERMIT No. 956


STREET

18

AVENUE LOT NO.

BLOCK NO. 3

NAME ADD. DV. 7

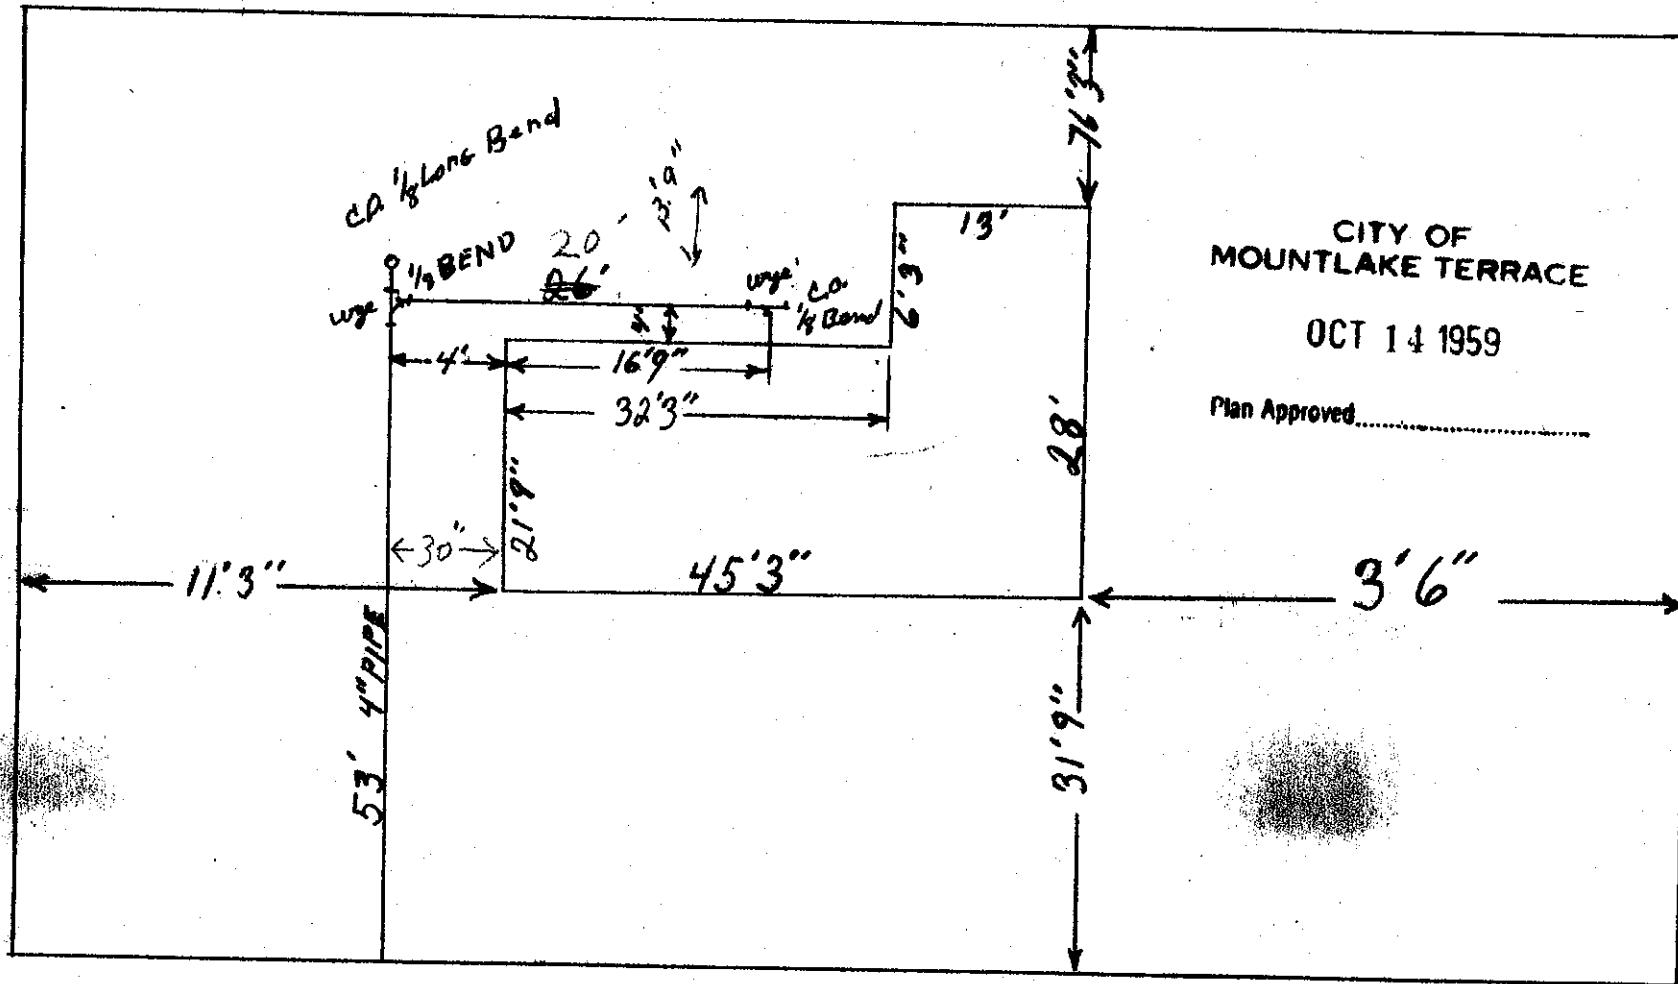

Date

BACKFILL WORK ORDER ISSUED.....

SEWER WORK ORDER ISSUED.....

Approved:

DEPOSIT, \$ 12.00 Rec'd 5/11

Dated 10/19/59

DATE

10-15-59 BY Scott M Holtom 118

2-2-61 INST CON SM&H

N.C.

The City of Mountlake Terrace

APPLICATION

Laura Jean Kirk
CARD No.

SIDE SEWER PERMIT

OUTSIDE INSIDE REPAIRS

EASEMENT No.


OWNER: Laura Jean Kirk
HOUSE No. 23409 - 52nd W.

CONTRACTOR: B+C

PERMIT No. 1739

STREET: AVENUE LOT No. 5 DIV 11 BLOCK No. 9

NAME ADD.

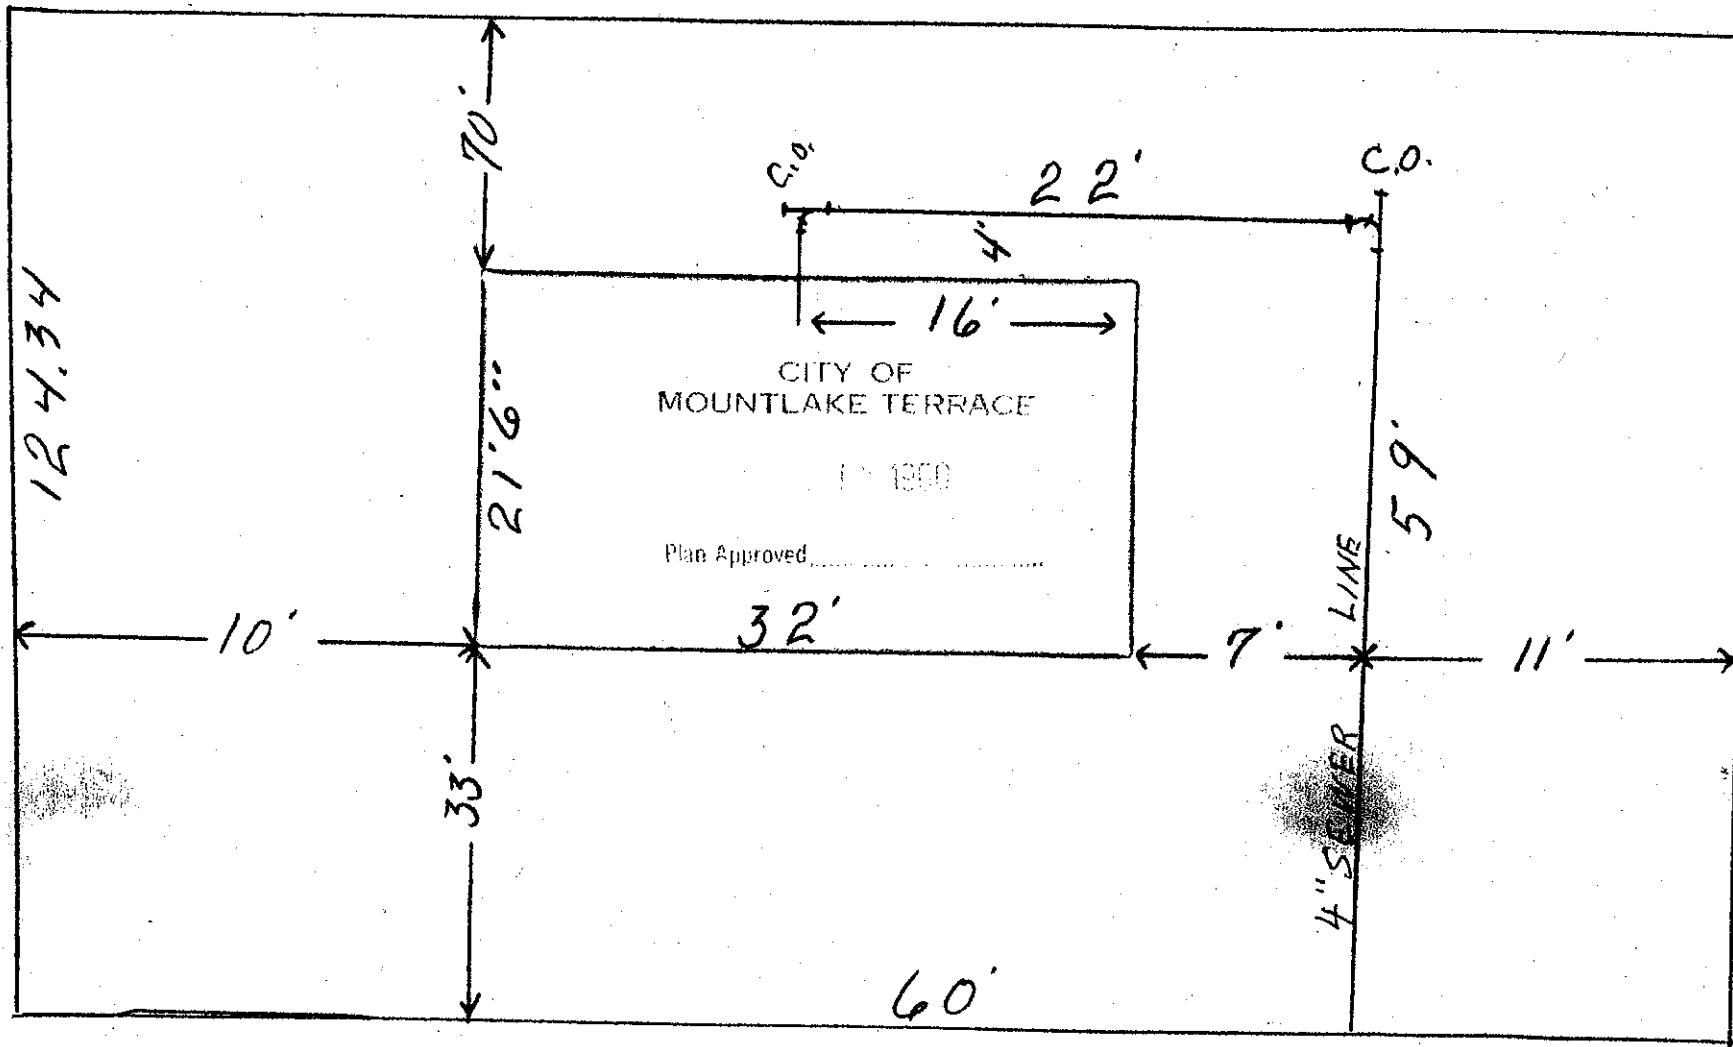

Date

BACKFILL WORK ORDER ISSUED

SEWER WORK ORDER ISSUED

DEPOSIT, \$ 10.00

2/18/60

604

Approved:

DATE 2-18-60

BY S. Scott m. Holton/NS+CON

City of Mountlake Terrace

APPLICTION

SIDE SEWER PERMIT

OUTSIDE **INSIDE** **REPAIRS**

Floyd T. BERKohl

CARD No

Use of Olds Property - Easement 1345978
EASEMENT NO. 1356577

OWNER Dloyd L. Bergdall
HOUSE No. 23503-52 Averill

HOUSE No. 23503 - 52 Aves (1)

CONTRACTOR, DeMonte Const Co


PERMIT NO. 768

STREET

AVENUE

~~RECORDED AND INDEXED NOV-19-1962~~

NAME ADD

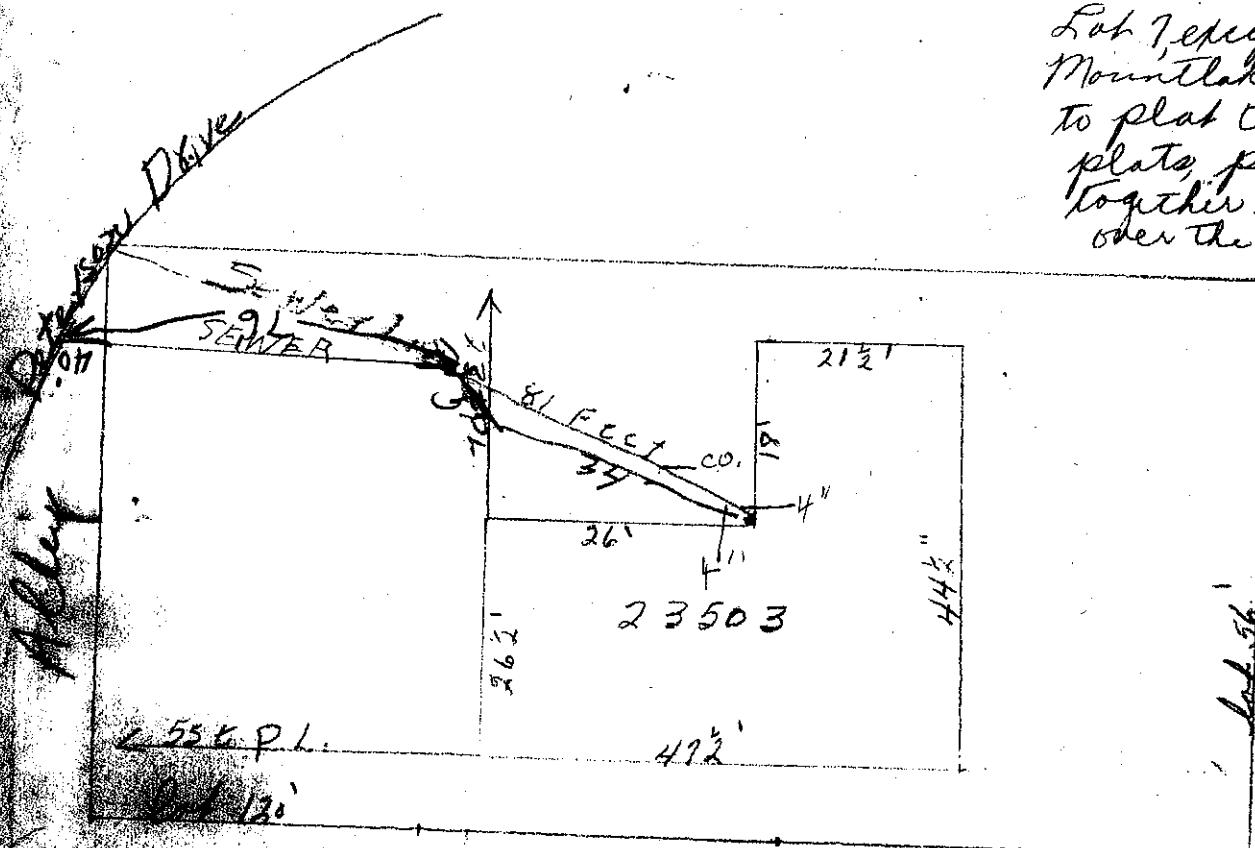

Approved:

**BACKFILL WORK ORDER ISSUED.
SEWER WORK ORDER ISSUED.**

DEPOSIT: \$ 10⁰⁰

9-1-59 A

4118 DATE -

4118 DATE Sept 1, 59 BY Scott m Holton IN 3
N.C.

3-9-1-2 140200Z 10 MDT

The City of Mountlake Terrace

APPLICATION

M.L.T. ID#10

CARD NO.

SIDE SEWER PERMIT

OUTSIDE INSIDE REPAIRS

EASEMENT No. 1383348

OWNER Marvin L. Gidian
HOUSE No. 23506 - 52nd w

CONTRACTOR T3+E


PERMIT No. 1230

STREET AVENUE LOT No. 13

DIV. 7

BLOCK No. 3

NAME ADD.

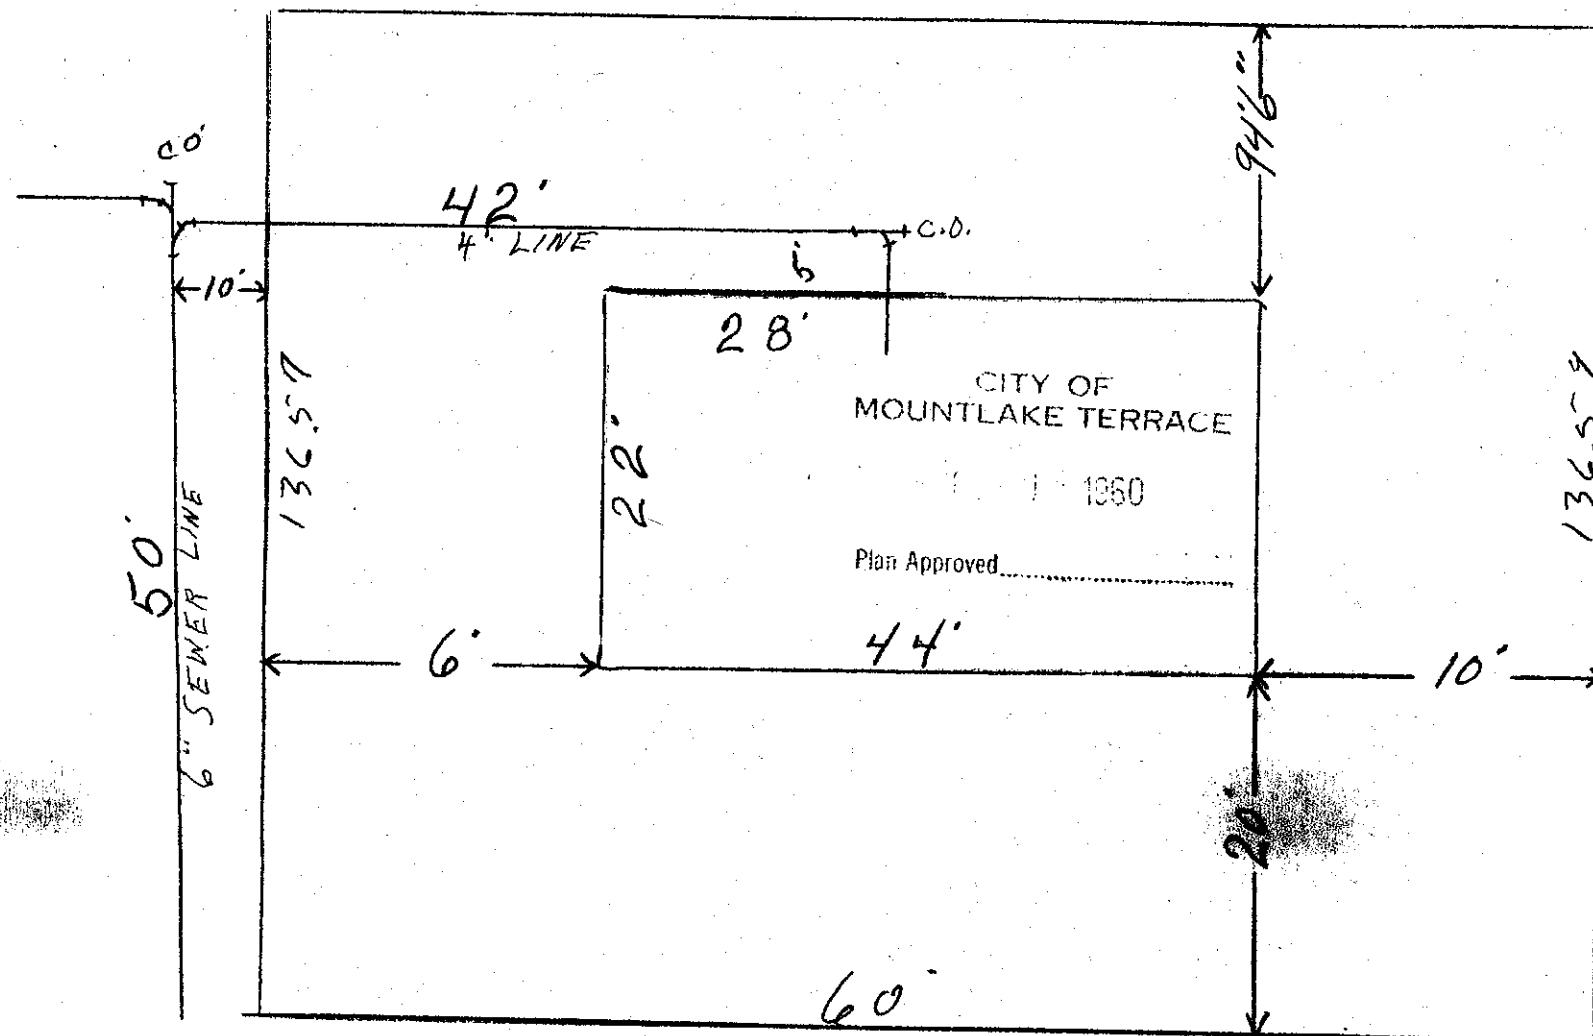

Date

Approved:

BACKFILL WORK ORDER ISSUED

SEWER WORK ORDER ISSUED

DEPOSIT, \$ 10.00

6/17/60

6/18/60

6/18/60

DATE 2-18-60

BY S. Scott on Holton INS+CON

The City of Mountlake Terrace

APPLICATION

ALFRED DRABOLD

CARD No.

SIDE SEWER PERMIT

OUTSIDE INSIDE REPAIRS

EASEMENT No. 1383348

OWNER Alfred Drabold
HOUSE No. 23508 - 52nd W.


CONTRACTOR B & E.

PERMIT No. 1731

STREET AVENUE LOT No. 12 - DIV 7.

BLOCK No. 3

NAME ADD.

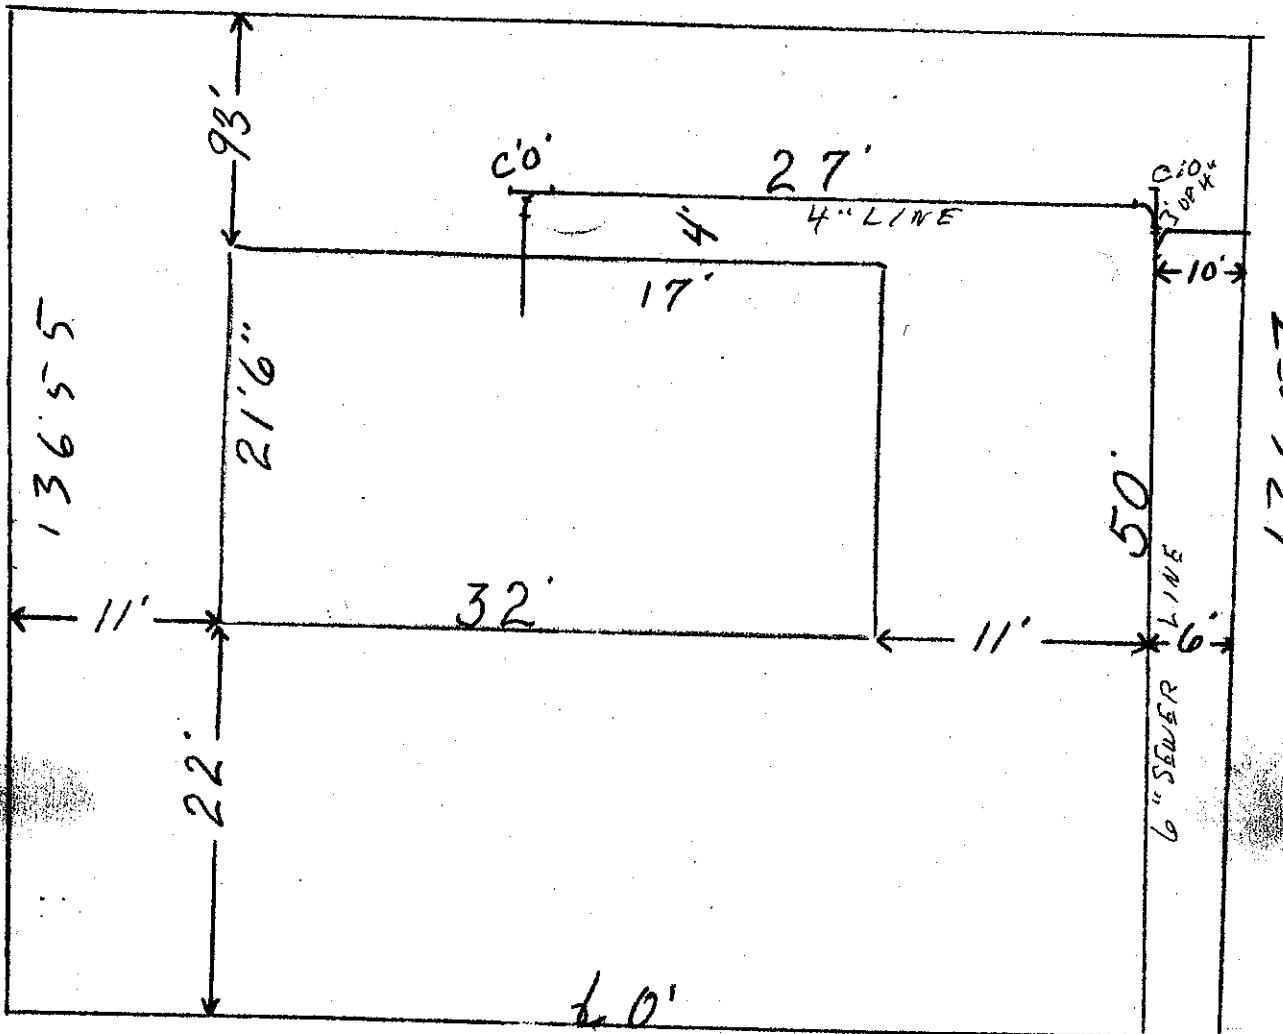

CITY OF
MOUNTLAKE TERRACE

FEB 11 1960

Plan Approved

Date

Approved:

BACKFILL WORK ORDER ISSUED

DEPOSIT, \$ 10.00

SEWER WORK ORDER ISSUED

2/17/60
#593

DATE 2-18-60

BY

Scott M Holton NS CON

APPLICATION

CARD No.

The City of Mountlake Terrace

SIDE SEWER PERMIT


OUTSIDE INSIDE REPAIRS

2274

EASEMENT No.

OWNER: *Doris Kuntz*
HOUSE No. *13604 - 52nd*CONTRACTOR: *Seif*PERMIT No. *3248*STREET
AVENUE LOT No. *5*

BLOCK No.

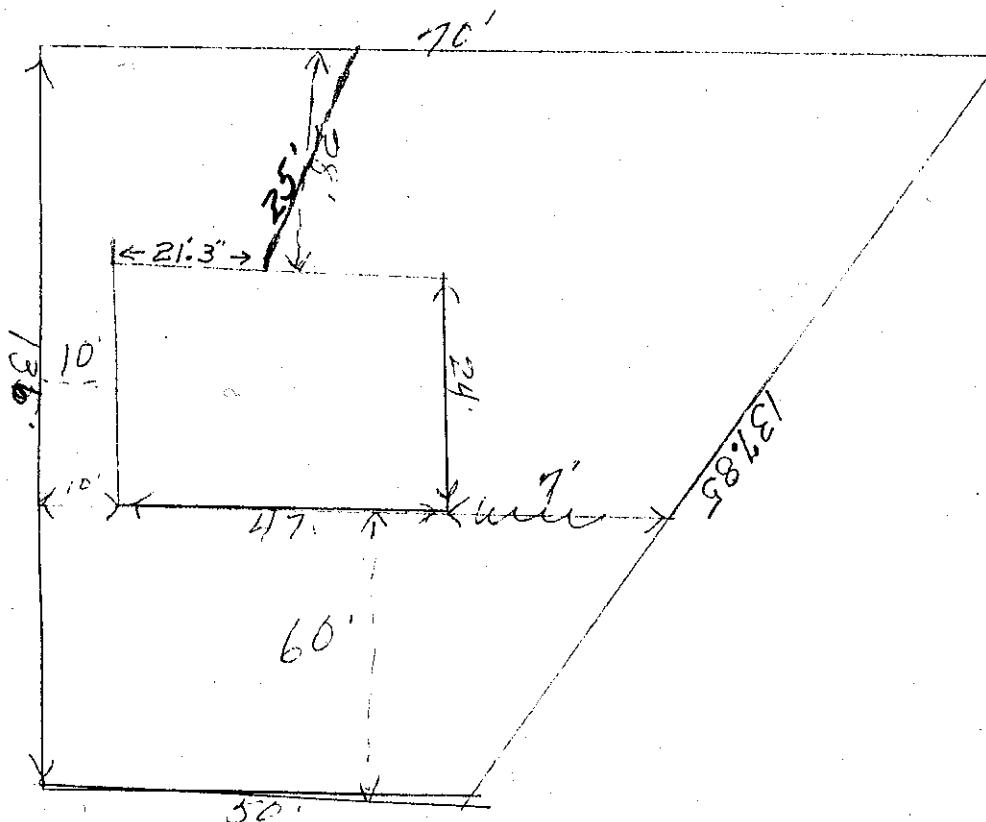NAME ADD. *Kuntz Addition**52nd St -*

Date

Approved:

BACKFILL WORK ORDER ISSUED

DEPOSIT, \$

SEWER WORK ORDER ISSUED

DATE *8-7-62* BY _____

The City of Mountlake Terrace

APPLICATION

W.H. K. TORD

CARD No.

SIDE SEWER PERMIT

OUTSIDE **INSIDE** **REPAIRS**

EASEMENT N

Zone

OWNER Wm. K. FORD

HOUSE No. 23716 - 52 NA WEST


CONTRACTOR.

STREET

AVENUE LOT No.

PERMIT No. 1709

NAME ADD.

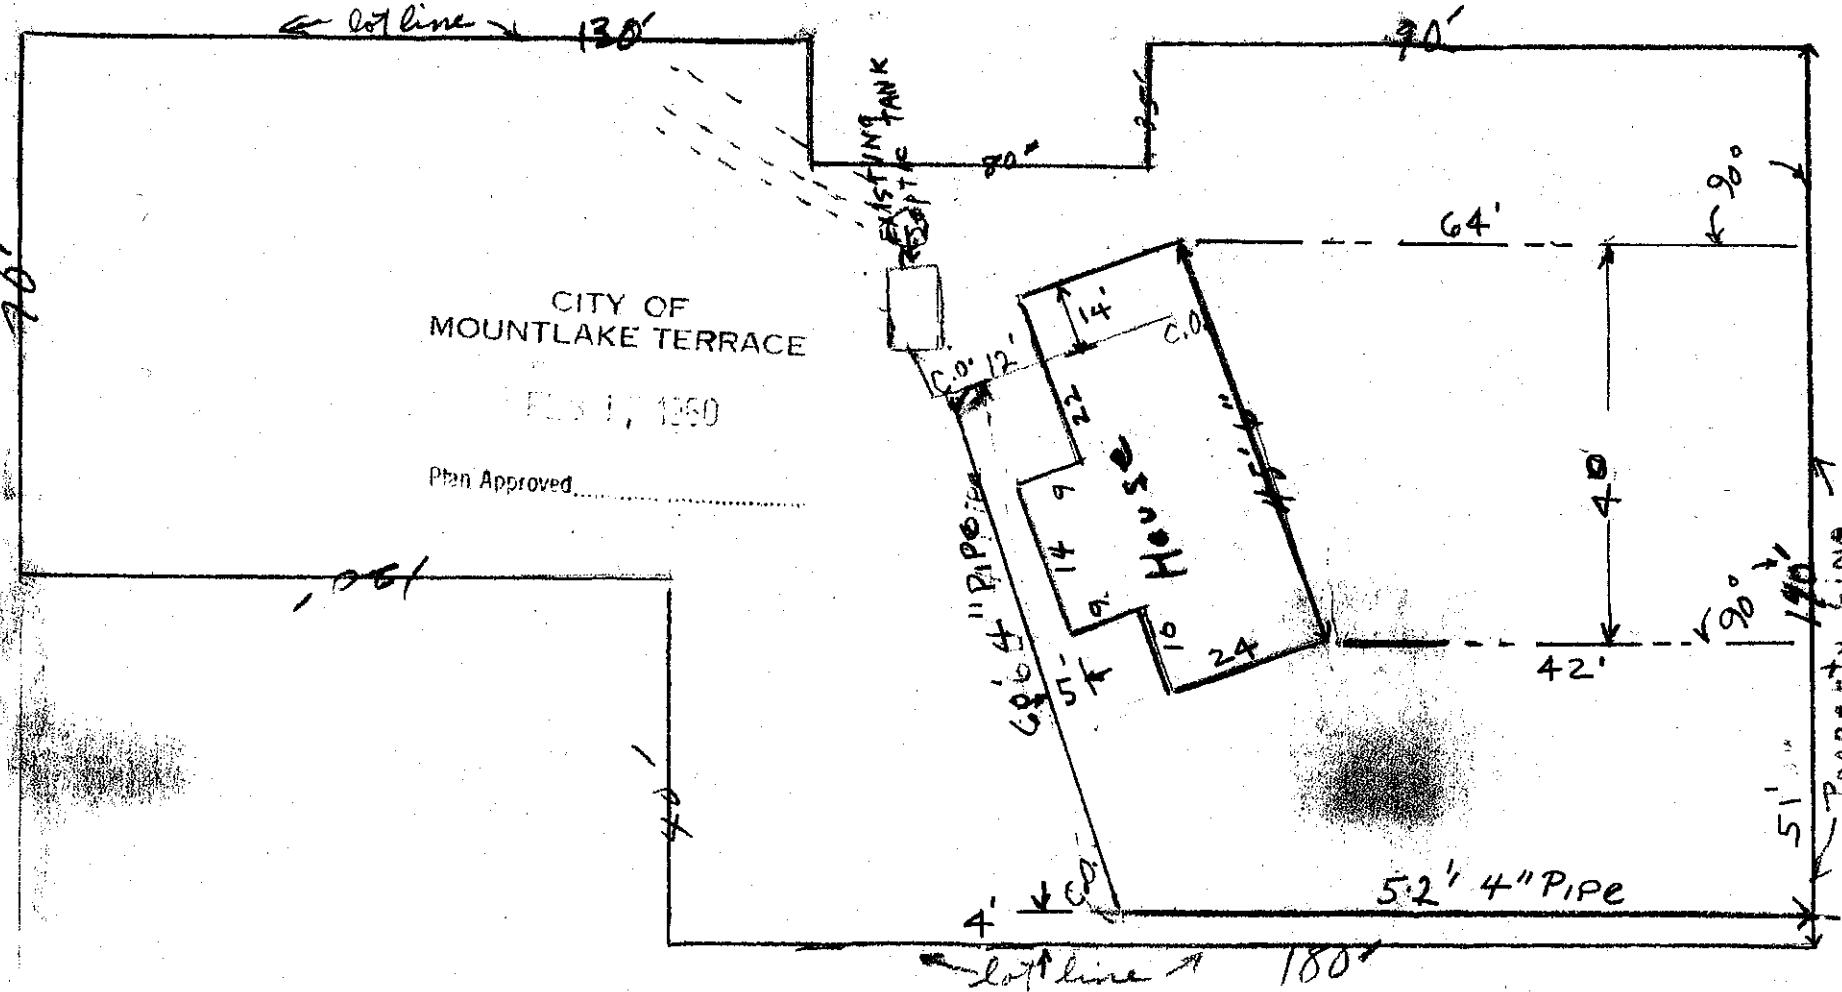

Date

Approved:

BACKFILL WORK ORDER ISSUED.

SEWER WORK ORDER ISSUED

DEPOSIT, \$10.00

#6014

2/13/69 Report

DATE 2-17-66

BY

Scott M Holton INSTcan

The City of Mountlake Terrace

APPLICATION

for

SIDE SEWER PERMIT

OUTSIDE INSIDE REPAIRS

CARD No.

EASEMENT No. None

OWNER ALBERT L MADISON

HOUSE No. 23806 - 52nd W.

5651 UNIVERSITY WAY
SEATTLE (5) WN.

INSTALLED FOR CITY

PERMIT No. 393

CONTRACTOR Wingfield


STREET
AVENUE LOT No. 38

BLOCK No.

Re Plot of Lind Tracts

NAME ADD.

25
32
817
23

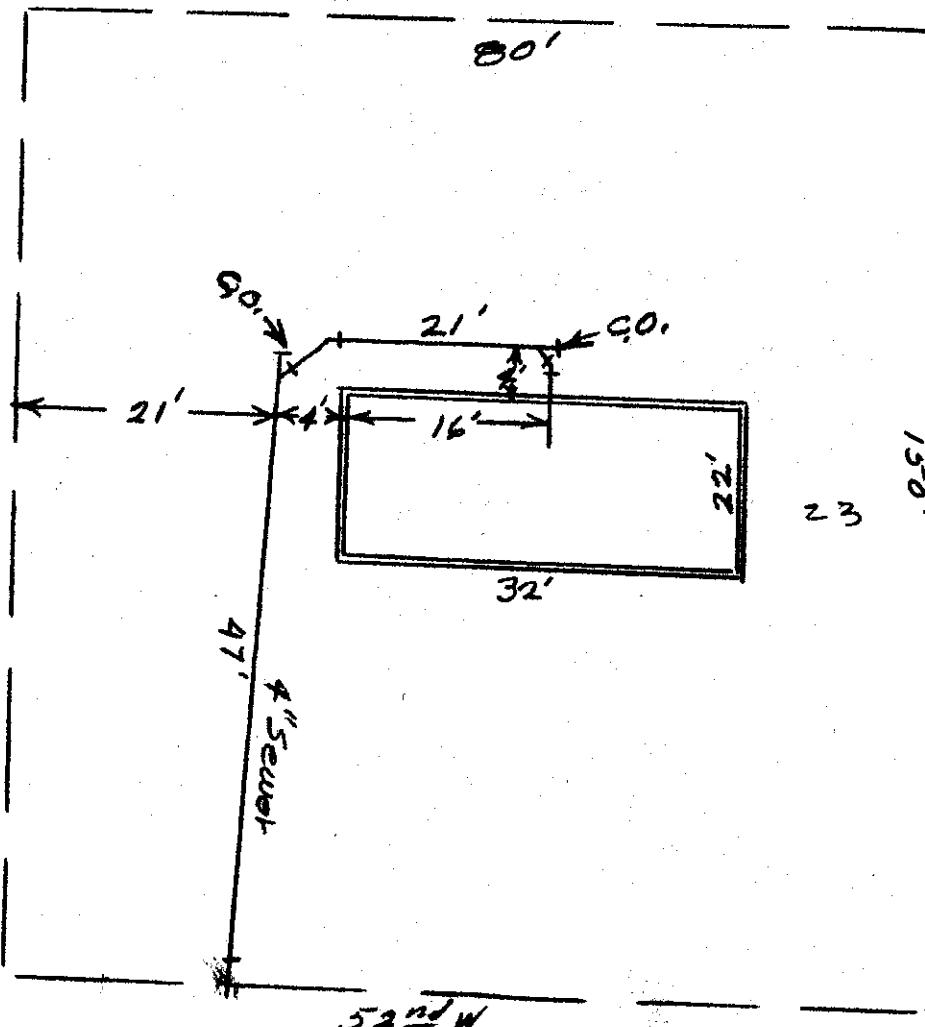

Date

Approved:

BACKFILL WORK ORDER ISSUED
SEWER WORK ORDER ISSUED

DEPOSIT, \$ 10.00

8/5/60
#1826

DATE 8-23-60 BY S.M. Holton INST CON

The City of Mountlake Terrace

APPLICATION

CARD No.

SIDE SEWER PERMIT

OUTSIDE **INSIDE** **REPAIRS**

EASEMENT No.

OWNER

CONTRACTOR RANDI N CONST Bob Argan EDITION PERMIT No. 4-31-83

HOUSE No

No. 23810 52ND AVE
HOUSE BEHIND 23808 52ND

STREET


STREET 542-5212

**STREET
AVENUE LOT No.**

542 5217

3 BLOCK No

NAME ADD

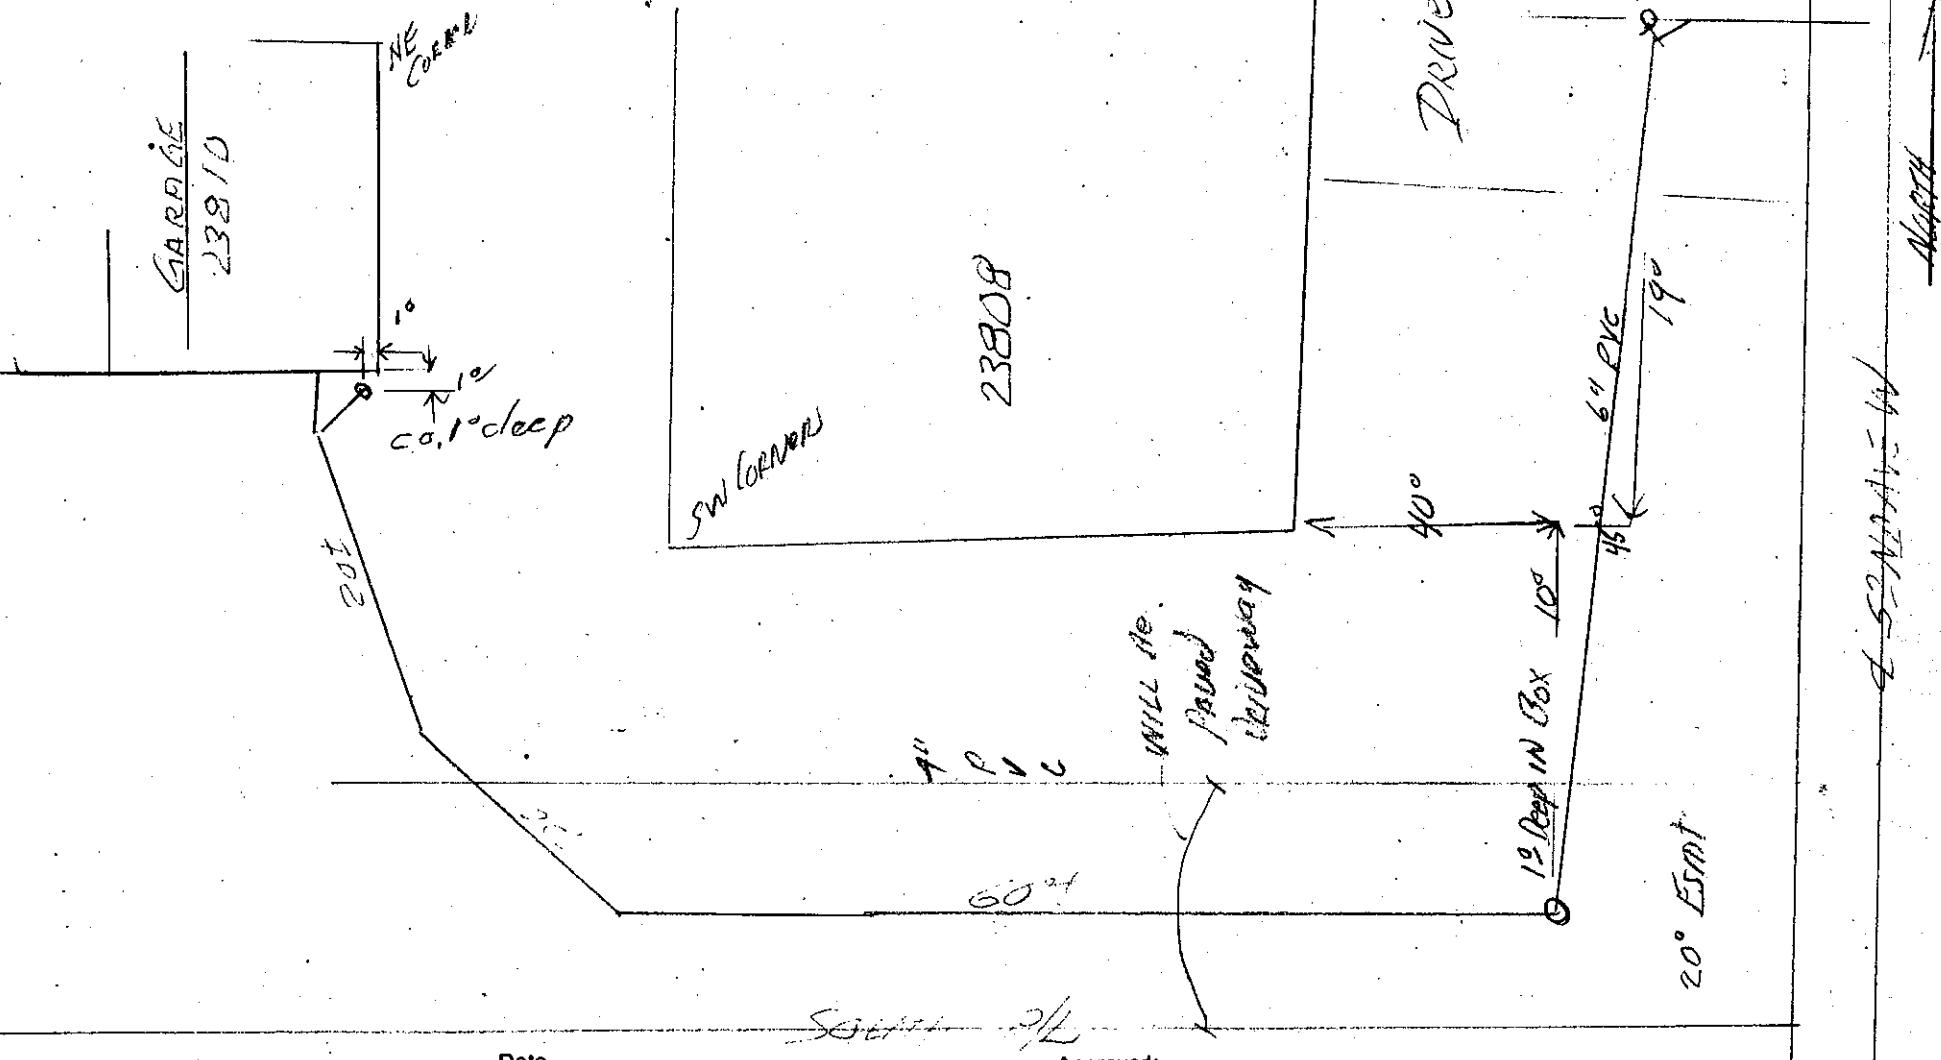

**BACKFILL WORK ORDER ISSUED
SEWER WORK ORDER ISSUED**

Date

DEPOSIT. \$

20

Approved

DATE

自

The City of Mountlake Terrace

APPLICATION

SIDE SEWER PERMIT

OUTSIDE INSIDE REPAIRS

W. L. Newcomb

CARD No.

EASEMENT No. 1358629

OWNER W L NEWCOMB

HOUSE No. 23904 52 W

CONTRACTOR

RAINIER

PERMIT No. 215-3

STREET

AVENUE LOT No. 27

NAME ADD.

BLOCK No.

Replat Line Tracts

60

0.0' 23

3

- - 11 SEWER L -


- - 12 -

CITY OF
MOUNTLAKE TERRACE

MAR 24 1960

Plan Approved

J. Fairweather

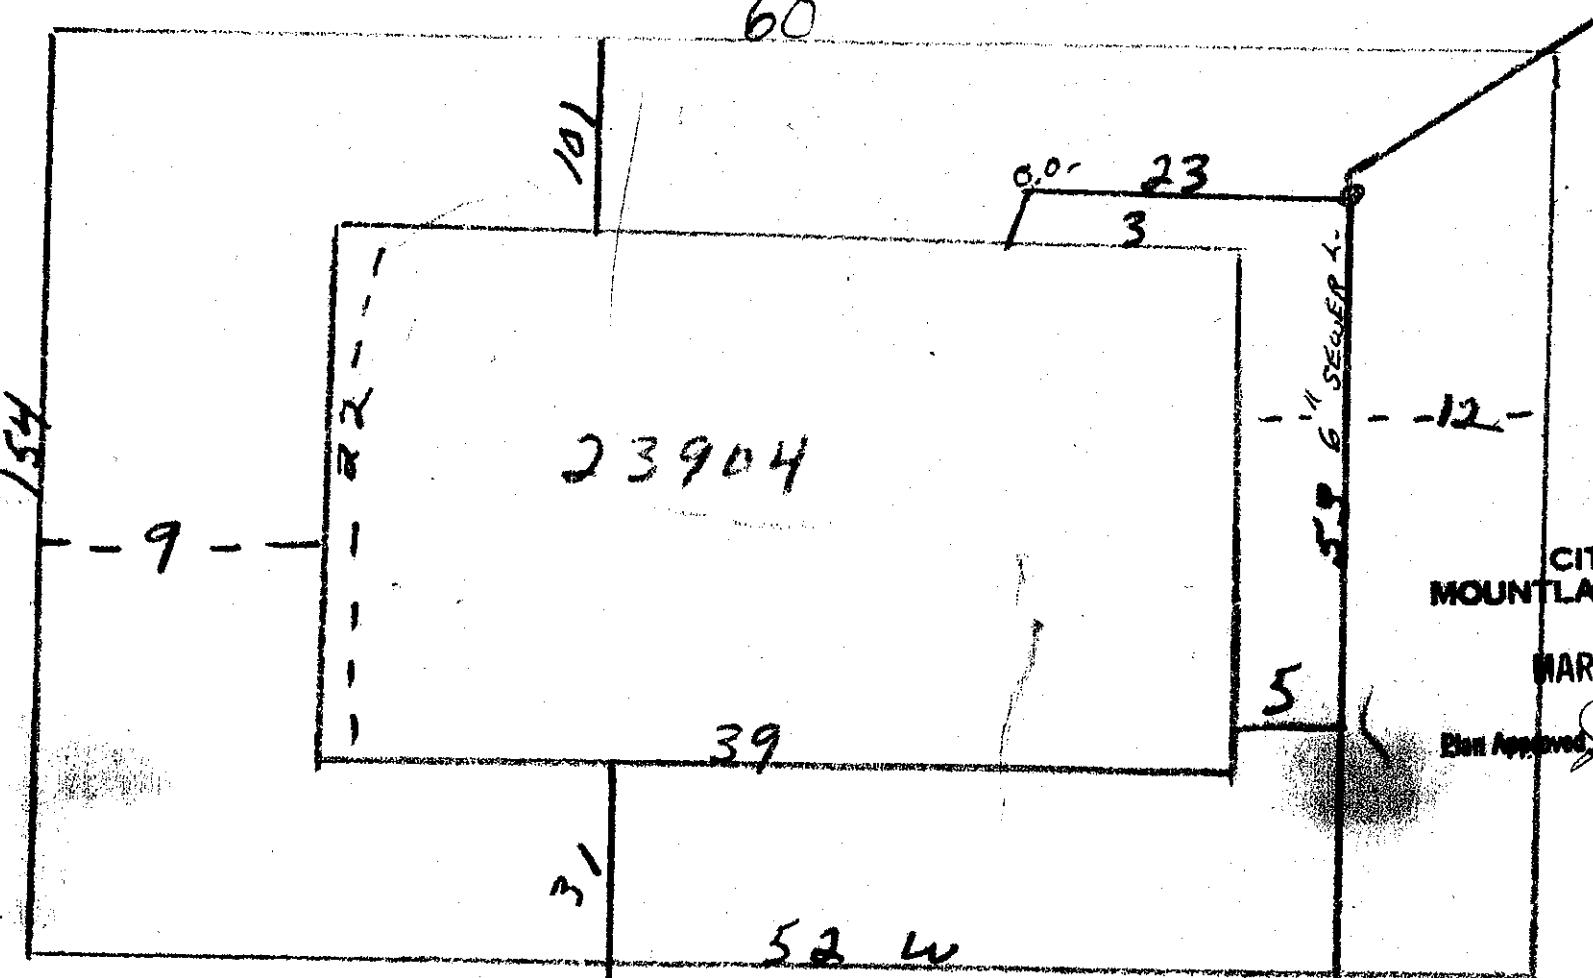

Date

BACKFILL WORK ORDER ISSUED
SEWER WORK ORDER ISSUED

DEPOSIT, \$ 10.00 3/24/60

Approved:

972

DATE 3/29/60 BY J. Fairweather

The City of Mountlake Terrace

FOR
SIDE SEWER PERMIT
OUTSIDE INSIDE REPAIRS

City EASEMENT No. None ✓

OWNER Mike Hollister
HOUSE No. 23906 - 52nd W.


CONTRACTOR Wingfield
STREET AVENUE LOT No. 26

PERMIT No. 455

BLOCK No.

NAME ADD.

Re-Plat of Lind Tracts

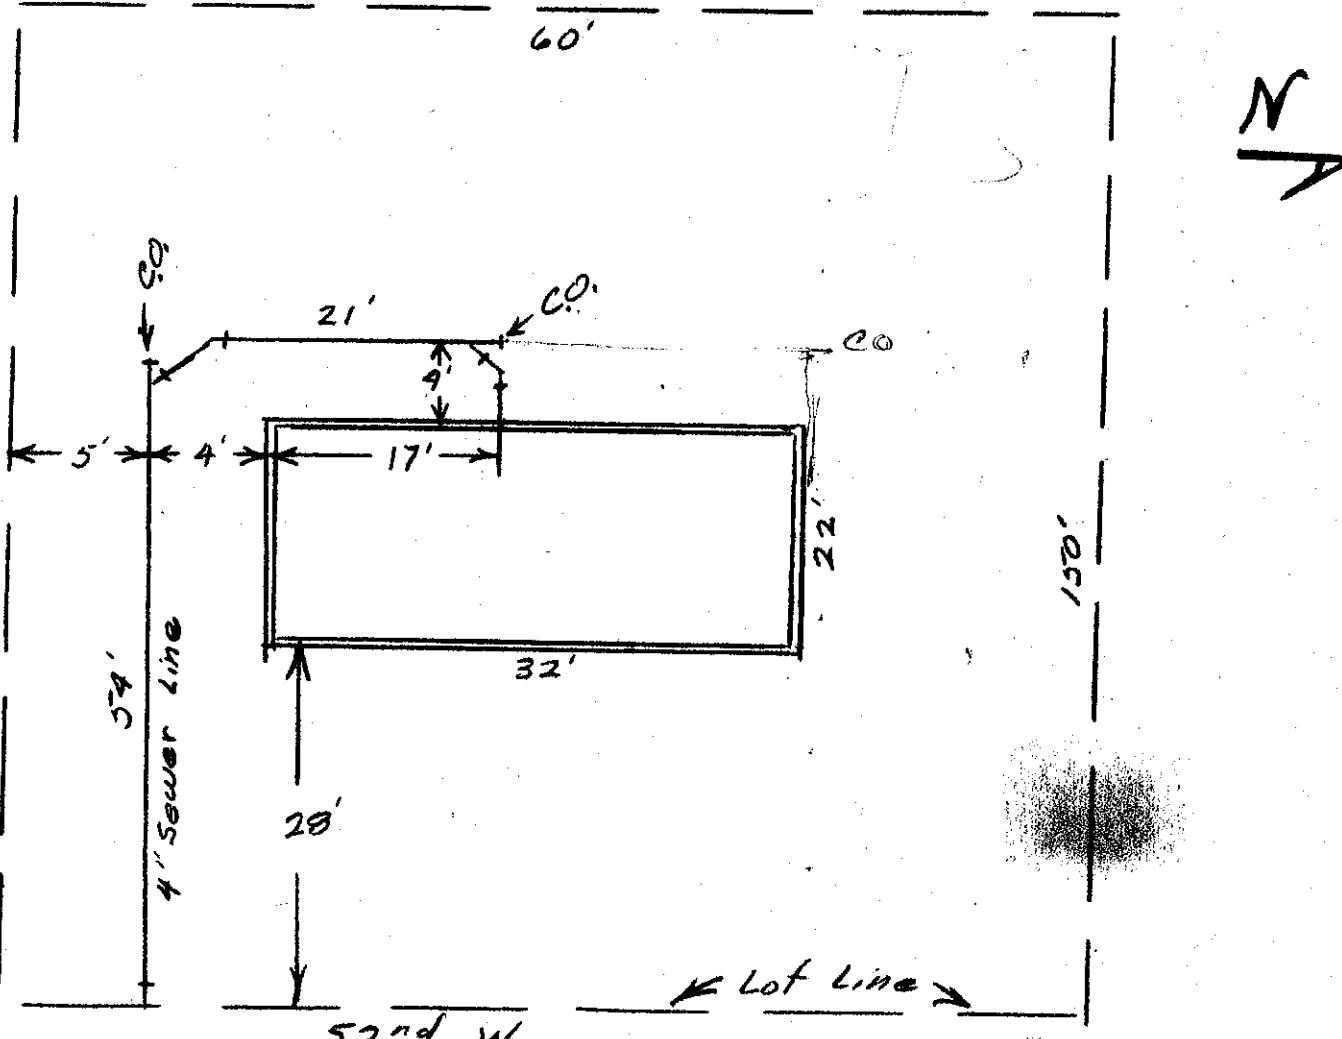

Date

52nd W.

Approved:

BACKFILL WORK ORDER ISSUED

DEPOSIT, \$ 10.00

SEWER WORK ORDER ISSUED

#1891

WY 9/17/60

DATE 9-19-60

BY S. M. Holton INS CON

The City of Mountlake Terrace

APPLICATION

BERT LINT

CARD No.


SIDE SEWER PERMIT

OUTSIDE INSIDE REPAIRS

EASEMENT No.

OWNER *Bert Lint*HOUSE NO. ~~23927-52~~ *23927-52*
*23929 - 52 Ave W*CONTRACTOR *Self*PERMIT No. *1595*

STREET

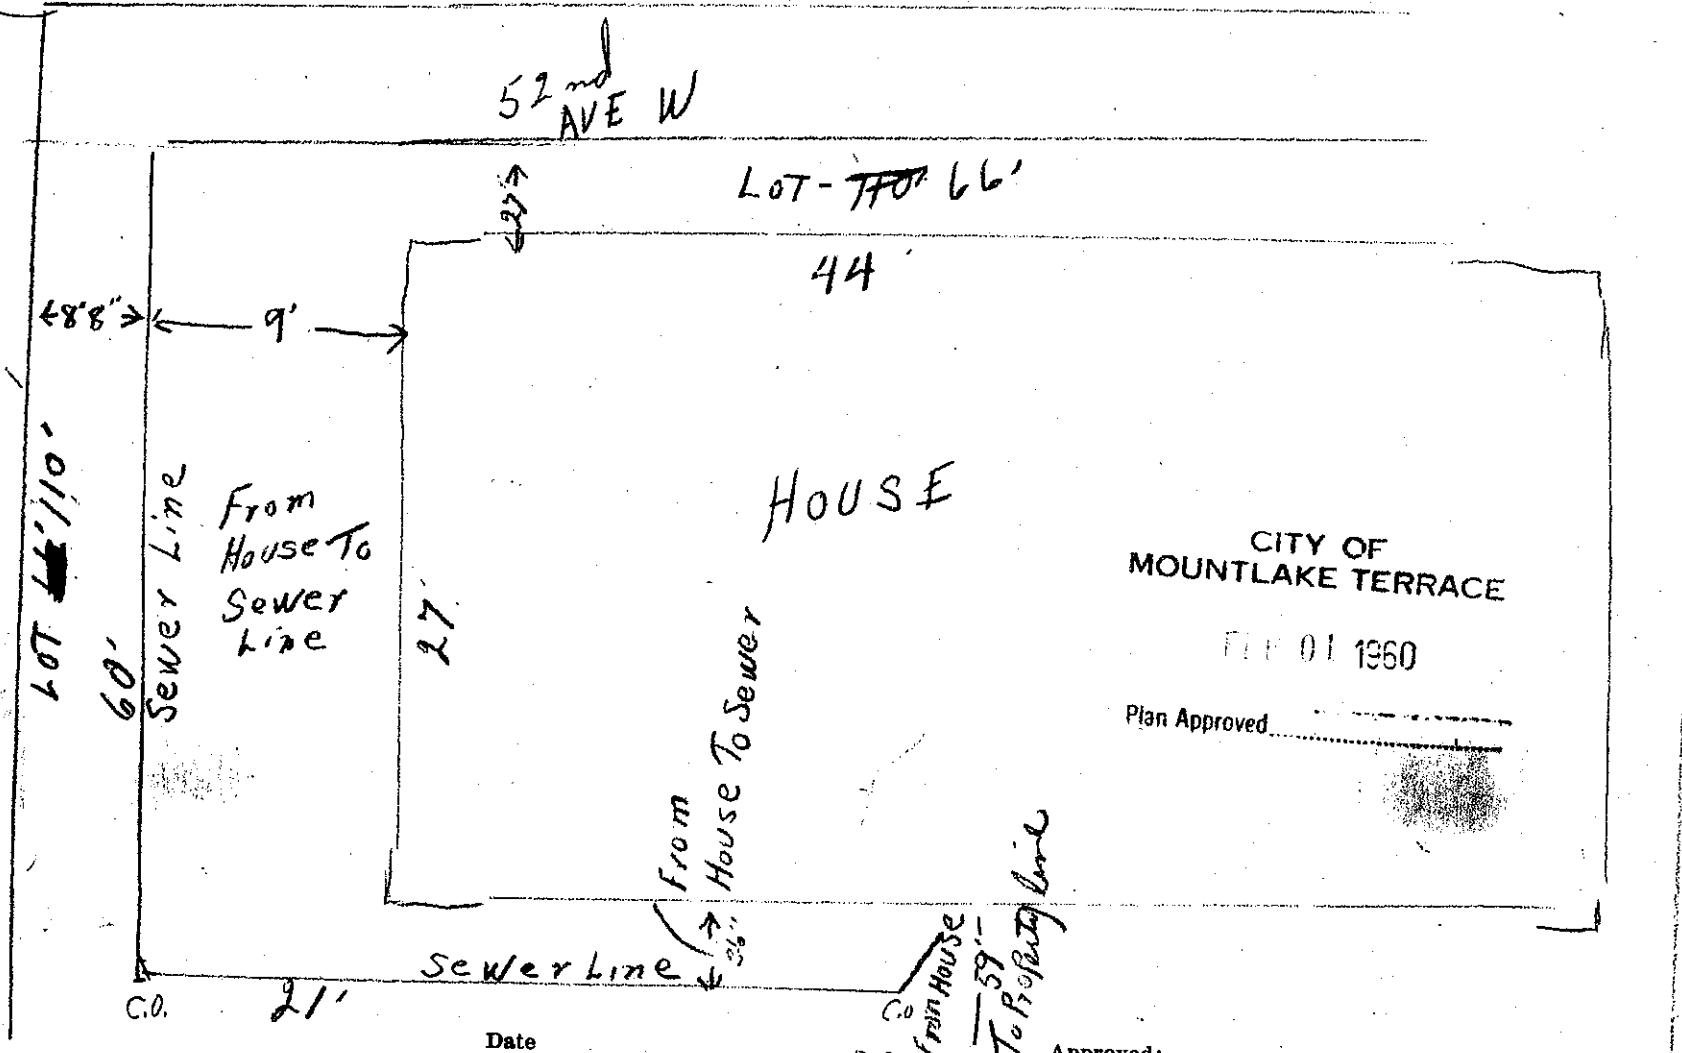AVENUE LOT No. *LOT #2*BLOCK No. *Block 1*NAME ADD. *DANNY PARK ADD.*BACKFILL WORK ORDER ISSUED
SEWER WORK ORDER ISSUEDDEPOSIT, \$10 *10* *1-2-60*
58738

DATE: 2-1-60

The City of Mountlake Terrace

APPLICATION

CARD No.

SIDE SEWER PERMIT

OUTSIDE INSIDE REPAIRS

EASEMENT No. None

OWNER Walter R Engbert

HOUSE No. 24004 - 52nd W.


CONTRACTOR Wingfield

PERMIT No. 736

STREET
AVENUE LOT No. 1

BLOCK No.

NAME ADD Lake Forest Crest

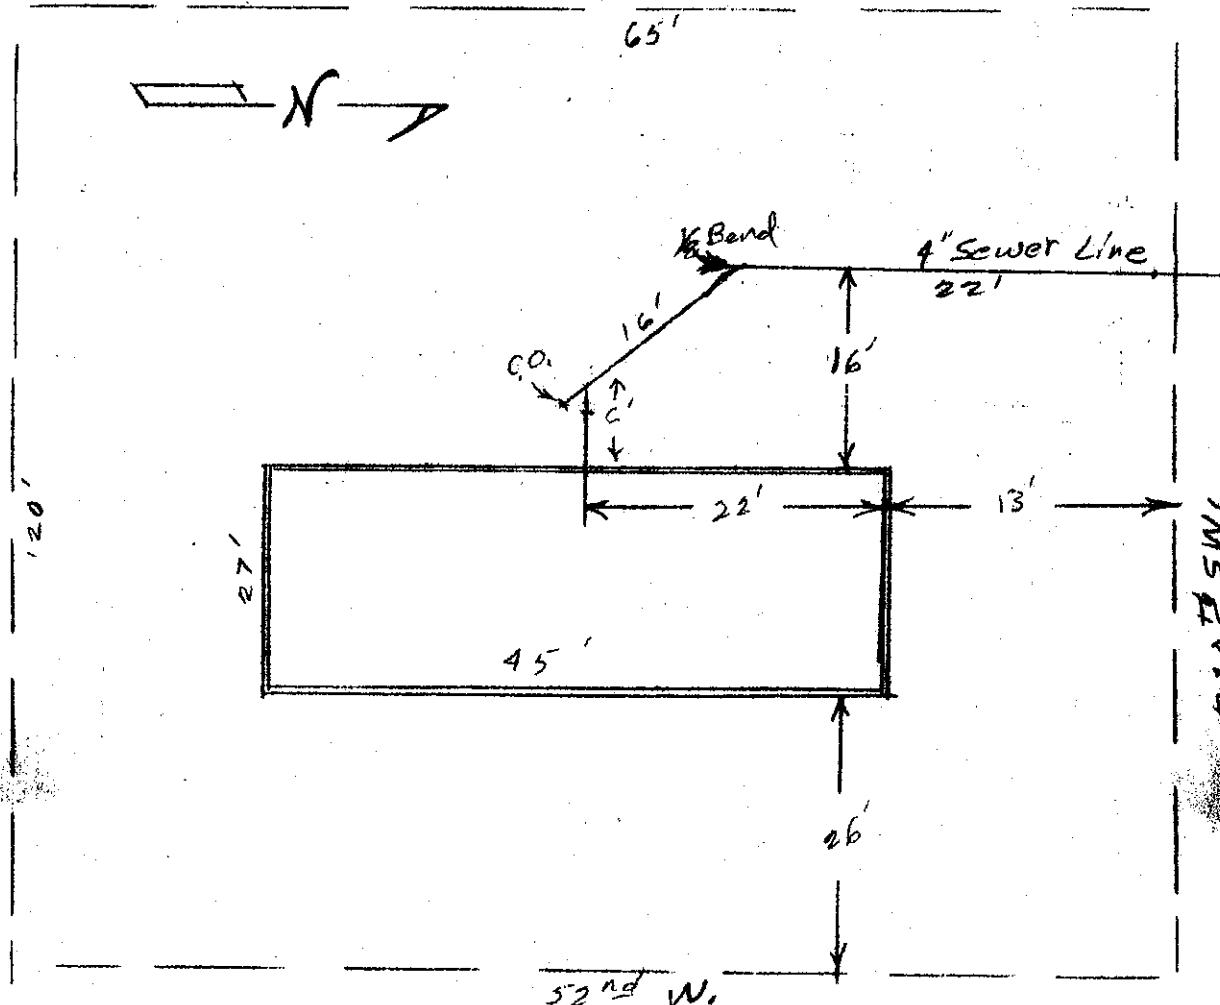

Date

Approved:

BACKFILL WORK ORDER ISSUED

DEPOSIT, \$

SEWER WORK ORDER ISSUED

DATE 4/17/61 BY S. M. Holton

The City of Mountlake Terrace

APPLICATION

for

SIDE SEWER PERMIT

OUTSIDE INSIDE REPAIRS

CARD No.

EASEMENT No.

OWNER *Mr. Scott Jones*

HOUSE No. 29005 52nd Ave W

CONTRACTOR

B & H Const


PERMIT NO. 733

STREET
AVENUE LOT No.

42

BLOCK No.

NAME ADD *Lake Forest Heights*

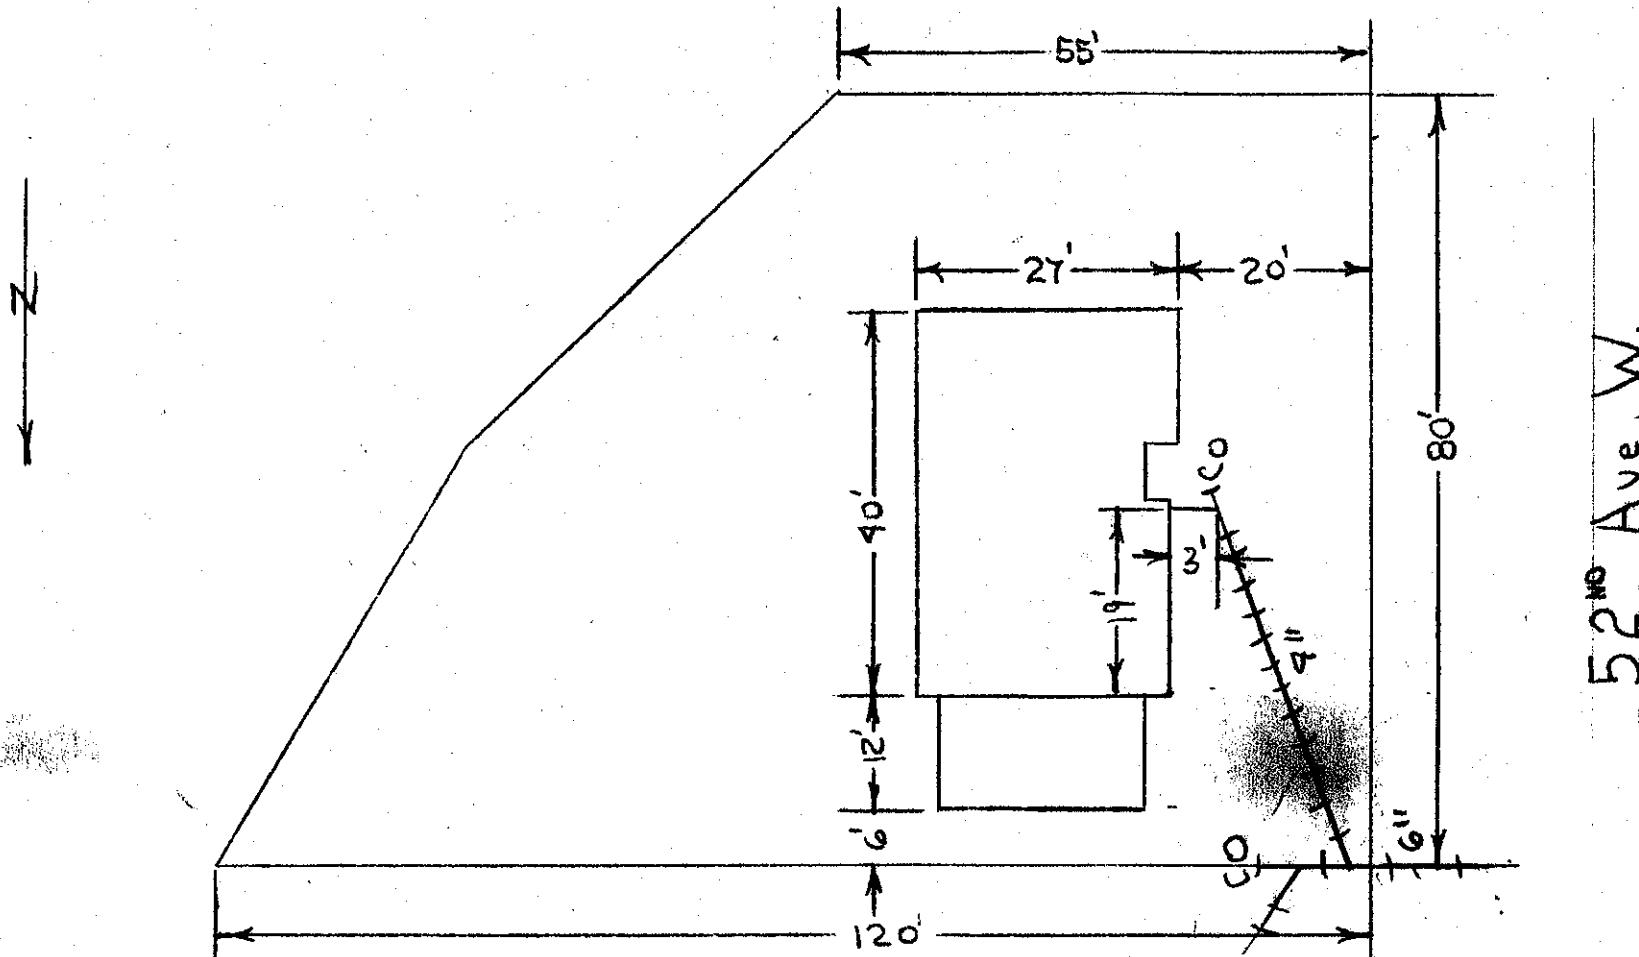

Date

Approved:

BACKFILL WORK ORDER ISSUED

DEPOSIT, \$10.00

4/5/61

SEWER WORK ORDER ISSUED

DATE

4/6/61

BY

J M Holton

The City of Mountlake Terrace

APPLICATION

CARD No.

SIDE SEWER PERMIT

OUTSIDE INSIDE REPAIRS

EASEMENT No.

OWNER: Dell Anderson
HOUSE NO. 24010 - 52 Ave NW

CONTRACTOR:


STREET
AVENUE LOT No.

PERMIT No.

3697

BLOCK No.

NAME ADD: According to plat recorded in
Volume 10 of plat page 107

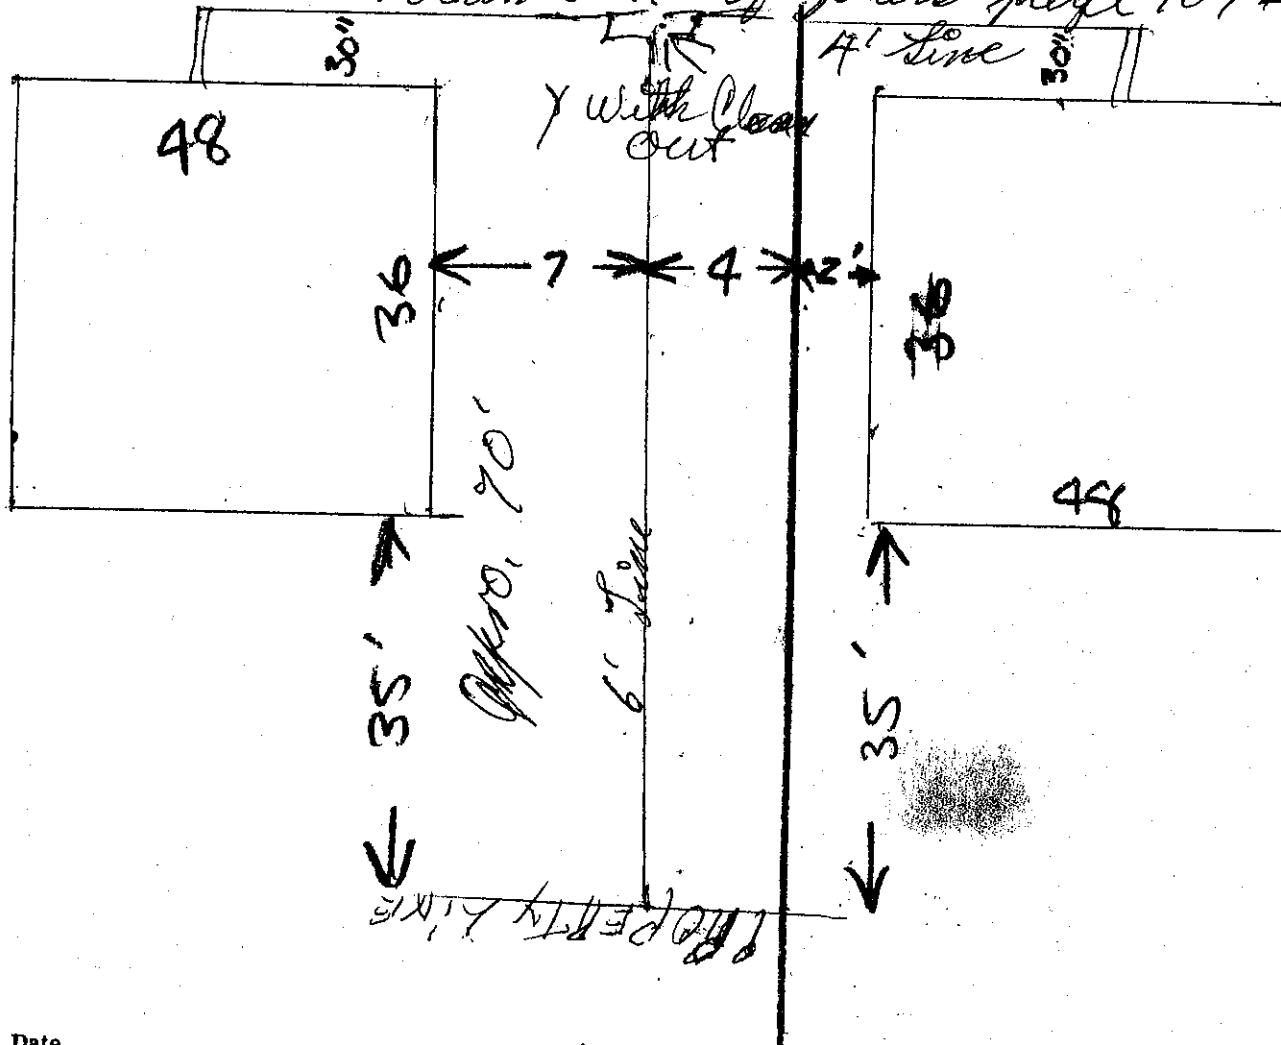

Date

Approved:

BACKFILL WORK ORDER ISSUED

DEPOSIT, \$

SEWER WORK ORDER ISSUED

DATE

BY

The City of Mountlake Terrace

APPLICATION

CARD No.

SIDE SEWER PERMIT

OUTSIDE INSIDE REPAIRS

EASEMENT No.

OWNER MERLIN H. GAY

HOUSE No. 24018-52ND W.

CONTRACTOR


PERMIT No. 3701

STREET

AVENUE LOT No.

(TWO) LAKE FOREST CREST BLOCK No. NORTH HALF OF EAST HALF

NAME ADD

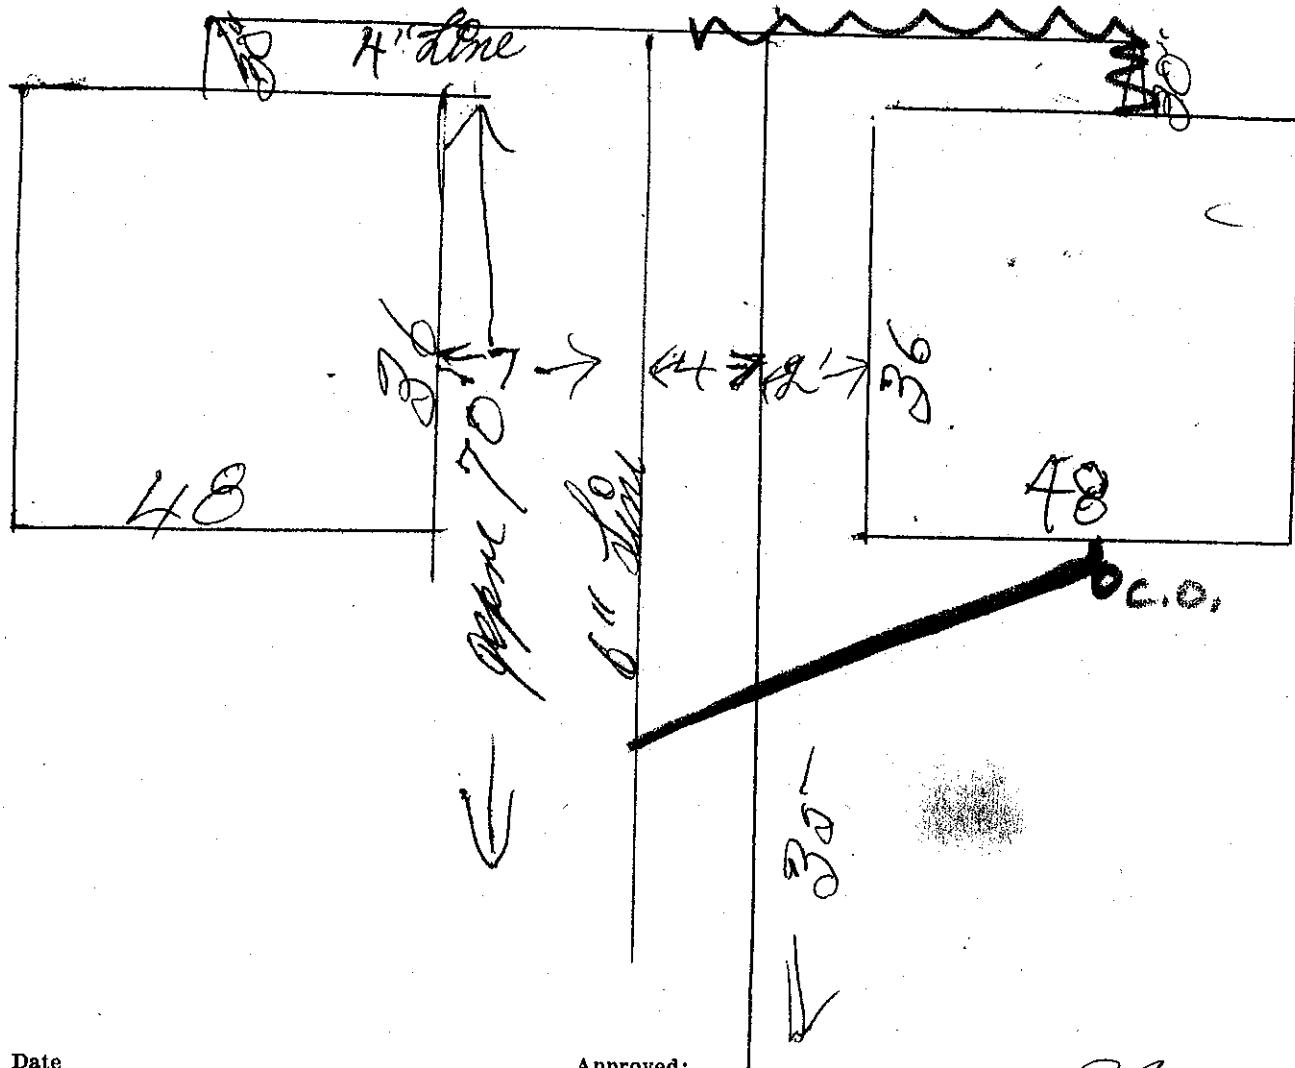

Date

Approved:

BACKFILL WORK ORDER ISSUED

SEWER WORK ORDER ISSUED

DEPOSIT, \$

DATE 1-27-64

BY


R. Bak



CITY OF MOUNTLAKE TERRACE
DEPARTMENT OF COMMUNITY DEVELOPMENT

Side Sewer As-Built
24026 52nd Ave W
U -

revision date
Dec 2002

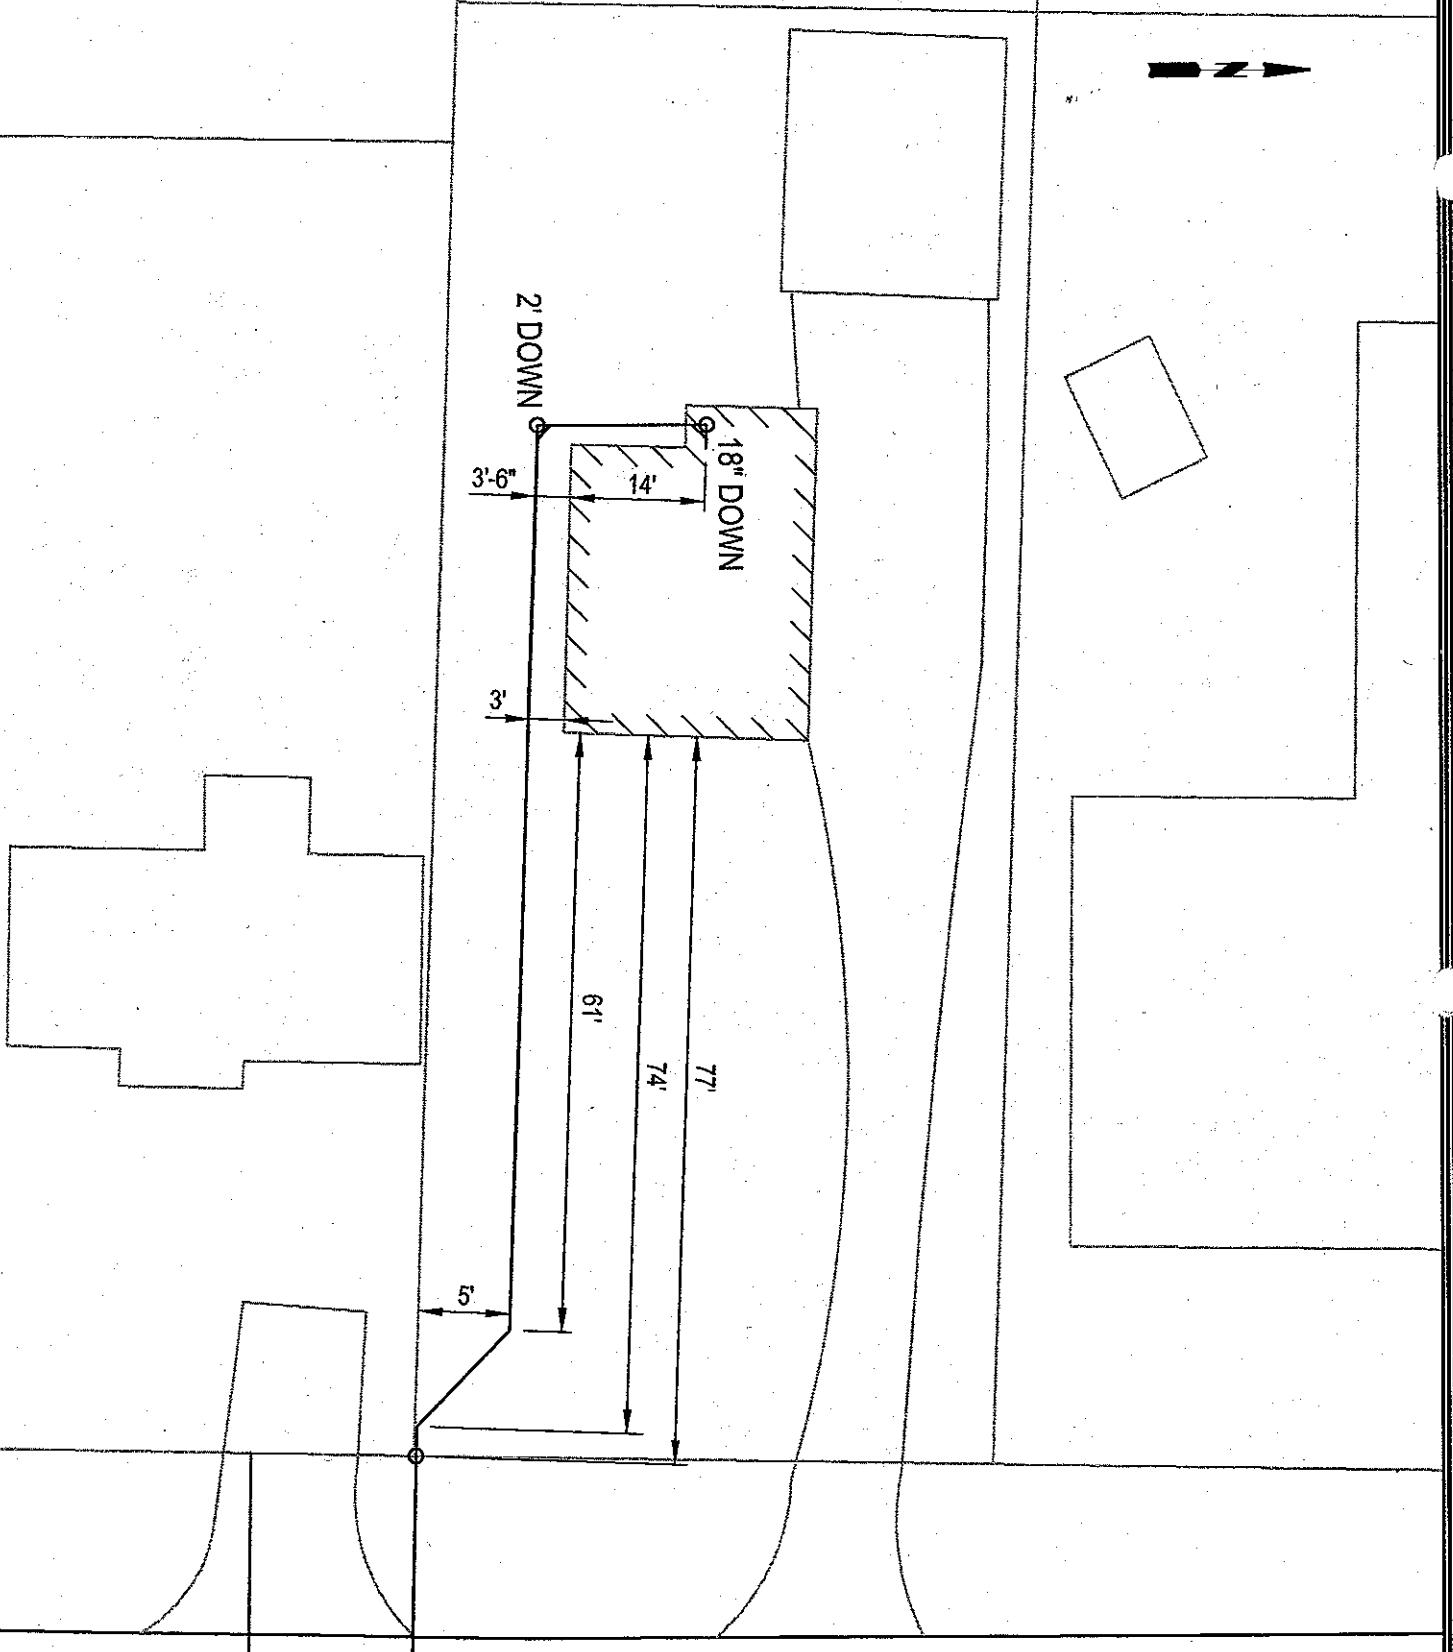

The City of Mountlake Terrace

APPLICATION

CARD No.

SIDE SEWER PERMIT

OUTSIDE INSIDE REPAIRS

EASEMENT NO.

OWNER C D BLACKWELL
HOUSE No. 24100 E. LND.

CONTRACTOR

MARVEL CONSTRUCTION CO. PERMIT No. 685

STREET

AVENUE LOT No.


3

BLOCK No.

NAME ADD.

Lake Forest Crest

301'

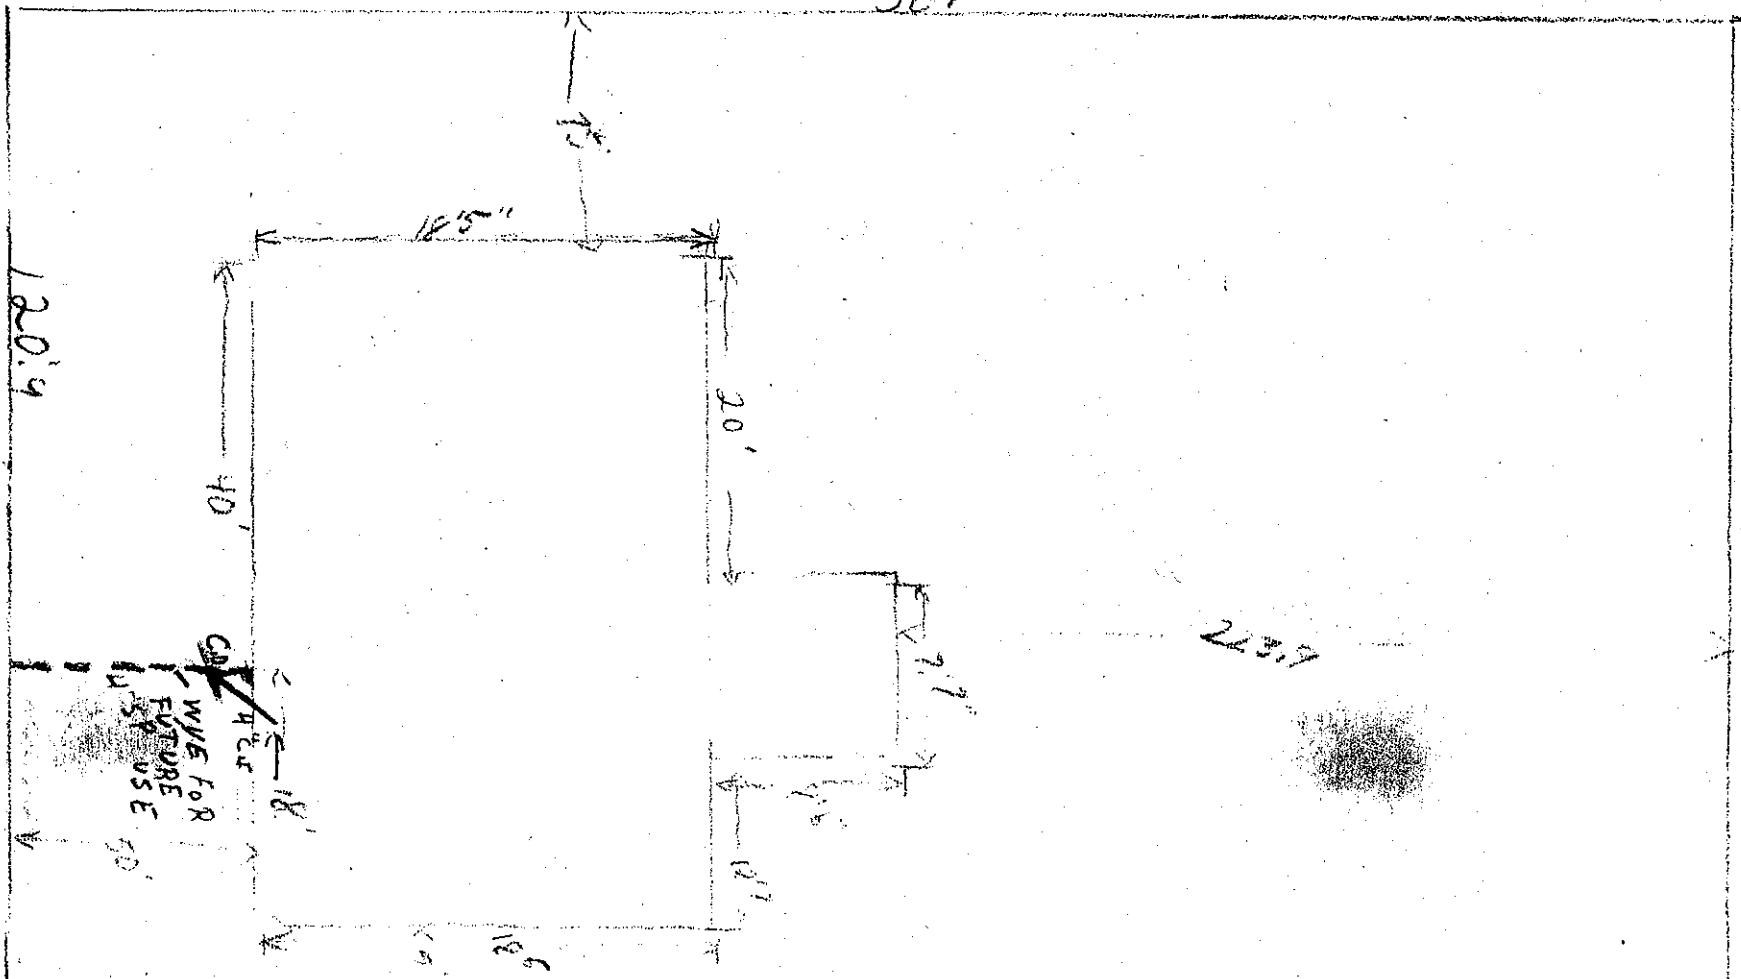

Date

Approved:

BACKFILL WORK ORDER ISSUED

DEPOSIT, \$10.00 2/20/61

SEWER WORK ORDER ISSUED

2187

DATE 2-20-61

BY S. M. Holton

The City Mountlake Terrace

APPLICATION

() or

SIDE SEWER PERMIT

OUTSIDE INSIDE REPAIRS

CARD NO. _____

EASEMENT No. _____

OWNER DON DURDY

CONTRACTOR



PERMIT No. 11-21-85

HOUSE No. 24116

STREET
AVENUE LOT NO. 52ND AV.W.

BLOCK No. _____

NAME ADD

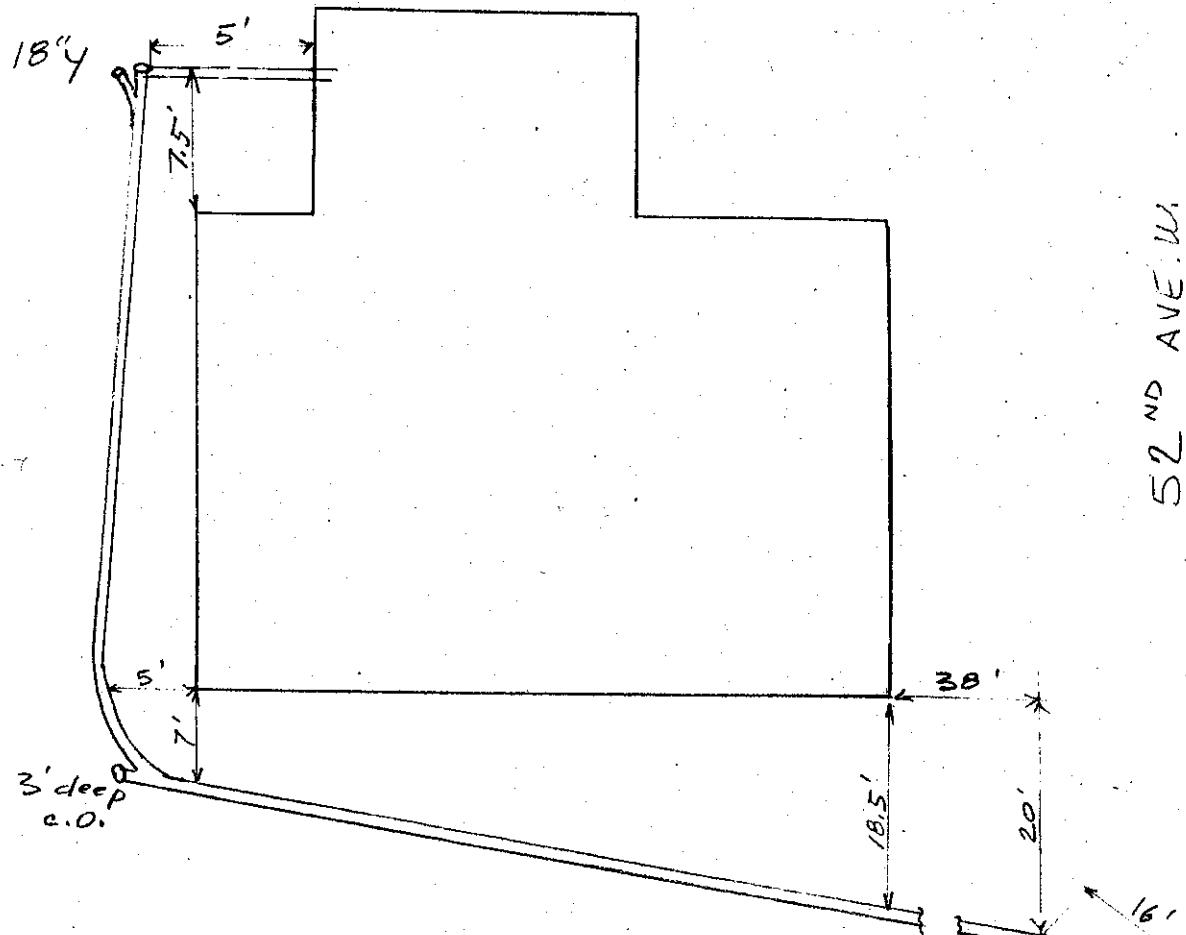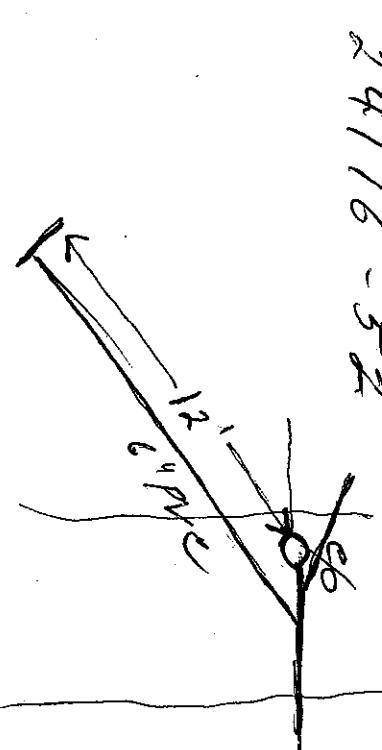

NOT TO SCALE

Date

BACKFILL WORK ORDER ISSUED

SEWER WORK ORDER ISSUED 11-12-85

DEPOSIT, \$ 20.00

582

Approved:


DATE

BY


Ben Main Deacon
24116-52

SIDE SEWER AS BUILT

CITY OF MOUNTLAKE TERRACE

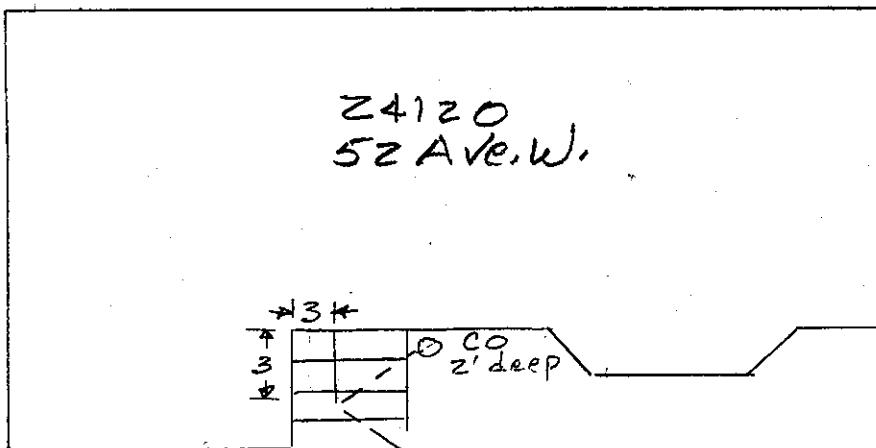

40'
30'
ft

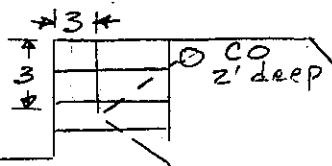

20'
4" PVC

45° Bend
6' PVC
5' deep

45°
Bend

13' → Power Pole 6' West
6" PVC
70° 2A
15' → 0 CO 6' deep

52nd Ave. W. End sidewalk

Back of Sidewalk

OWNER: - Don Durdy
ADDRESS: - 24120 52nd Ave W
CONTRACTOR: - Owner
PERMIT NO.: - 4-95-07
ISSUE DATE: - Mar 2-95
INSPECTED BY: Ben Van Deren
DATE: - Mar. 7, 1995

NOT TO SCALE

~~24120 52nd Ave W~~

House No. 24116 52nd Ave W

The City of Mountlake Terrace

APPLICATION

SIDE SEWER PERMIT

OUTSIDE INSIDE REPAIRS


CARD No. _____

EASEMENT No. _____

OWNER Wade Dixon CONTRACTOR _____ PERMIT NO. _____

HOUSE No. 24206 = 52 West STREET AVENUE LOT No. _____ BLOCK No. _____

NAME ADD

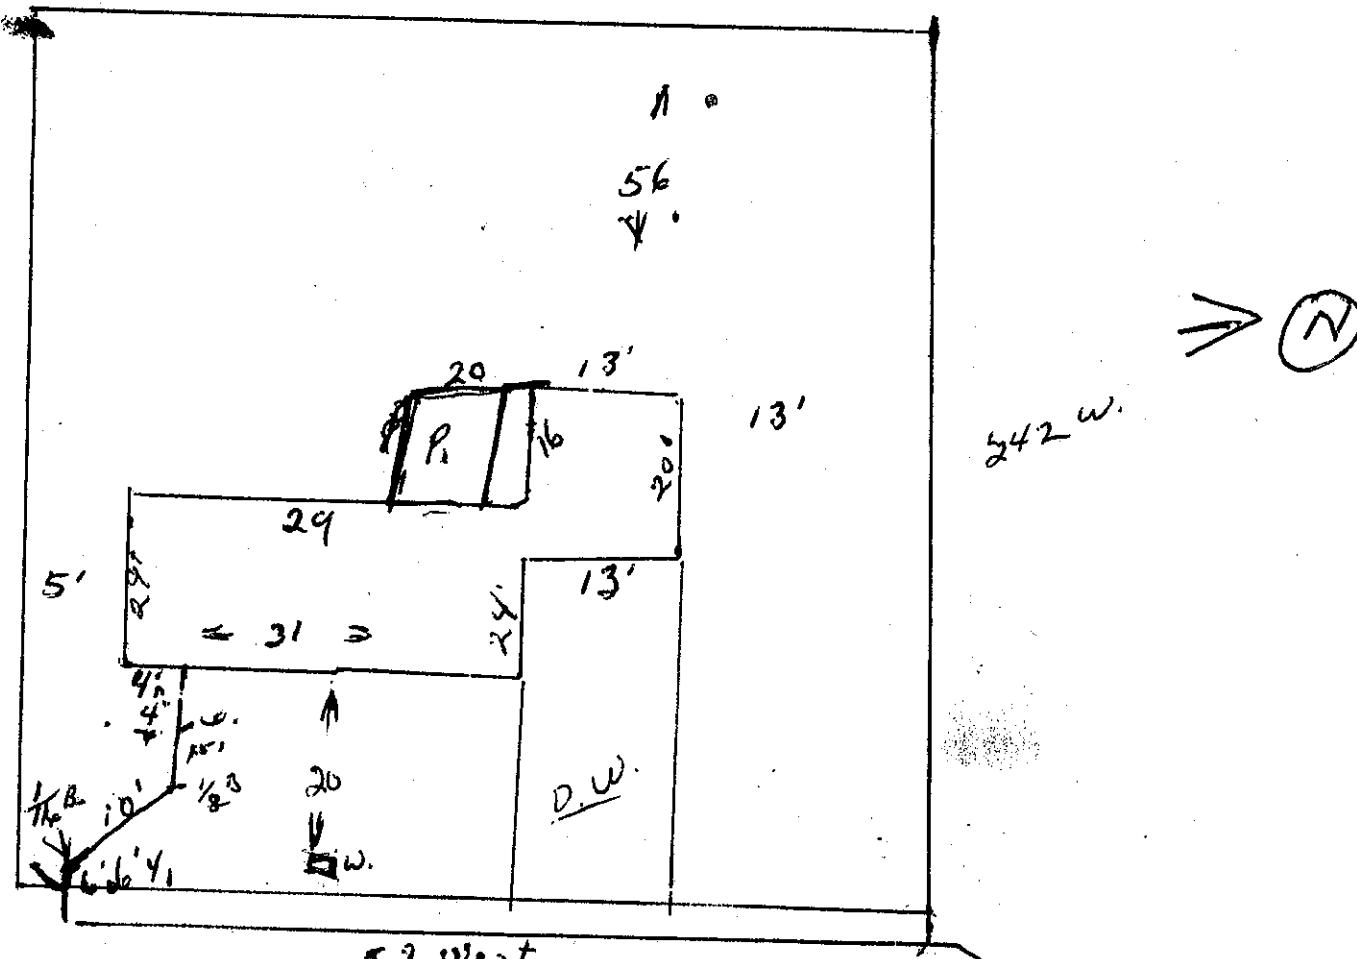

Date

Approved:

BACKFILL WORK ORDER ISSUED _____ DEPOSIT, \$ _____
SEWER WORK ORDER ISSUED _____ DATE _____ BY _____

The City of Mountlake Terrace

APPLICATION

for

SIDE SEWER PERMIT

OUTSIDE INSIDE REPAIRS

CARD No. _____

EASEMENT No. _____

OWNER Clark Homes

HOUSE No. 24215 - 52nd Av


CONTRACTOR North End Septic tank Co. PERMIT No. _____

STREET

AVENUE LOT No. _____

BLOCK No. _____

NAME ADD. _____

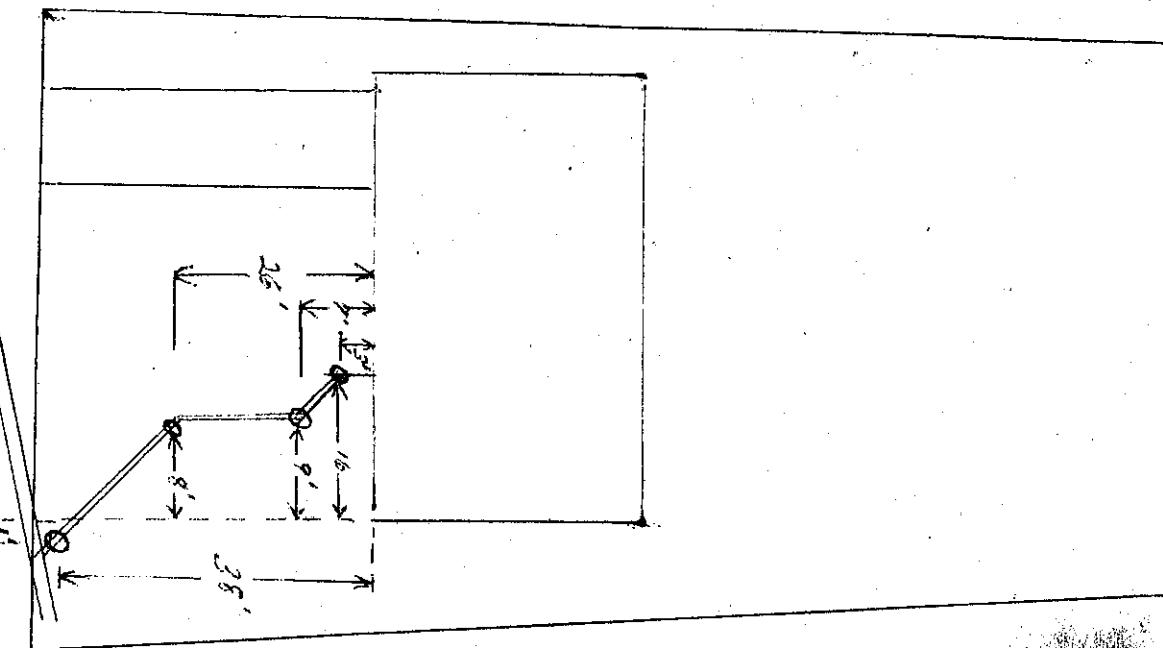

Date

Approved:

BACKFILL WORK ORDER ISSUED

DEPOSIT, \$

SEWER WORK ORDER ISSUED

DATE

BY

The City of Mountlake Terrace

APPLICATION

for

SIDE SEWER PERMIT

OUTSIDE INSIDE REPAIRS

CARD No.....

EASEMENT No.....

OWNER Edna Steckbauer


HOUSE No. 24219 52nd W

CONTRACTOR Tucker CONST Co. PERMIT No. 4012

STREET
AVENUE LOT No. 4481

BLOCK No.

NAME ADD.....

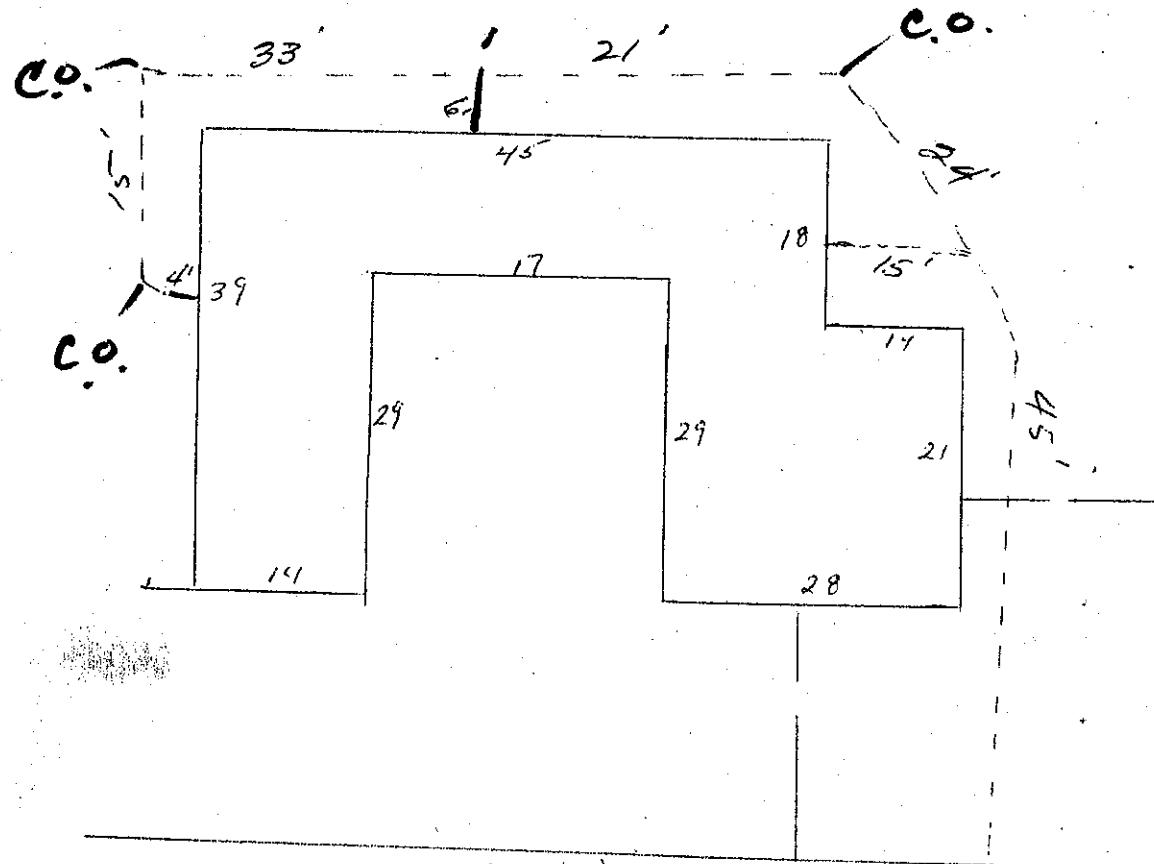

52nd W 52ND AVE

Date

DEPOSIT, \$ 10 -

Approved:

BACKFILL WORK ORDER ISSUED
SEWER WORK ORDER ISSUED

DATE 12-15-65 BY John Gherardi

The City of Mountlake Terrace

SIDE SEWER PERMIT

CARD NO.

OUTSIDE INSIDE REPAIRS

EASEMENT No.

OWNER Bob Wilcoxon

HOUSE NO. 2422 1/2 West

CONTRACTOR

Wingfield

PERMIT No. 3405


STREET

AVENUE LOT NO.

BLOCK No.

NAME ADD.

S. 120' of the W.
200' of the N $\frac{1}{2}$
of the S $\frac{1}{2}$ of the
SW $\frac{1}{4}$ of the SE $\frac{1}{4}$
of Sec 33 T27
R 4 W.M.

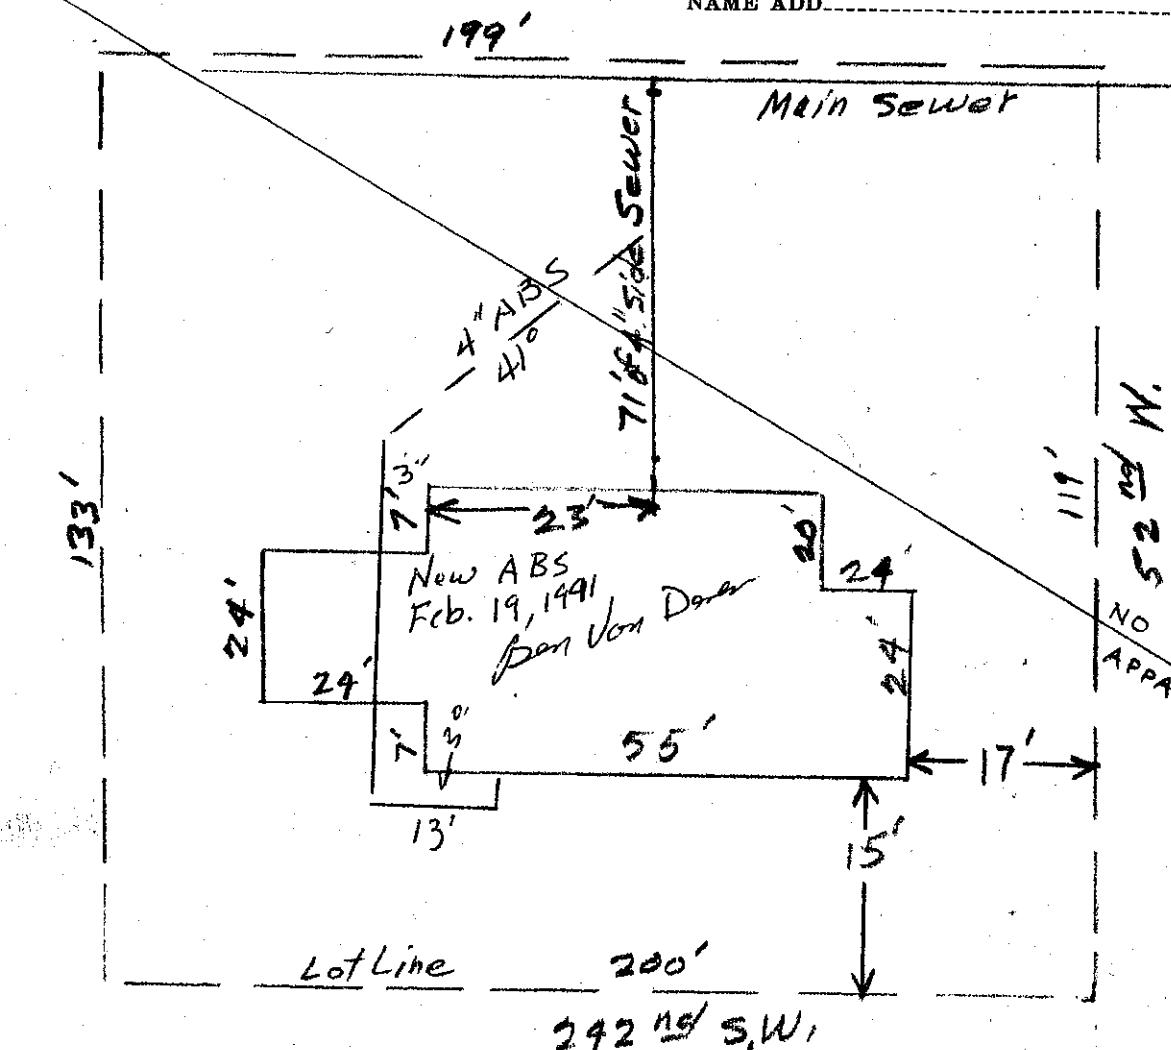

Date

Approved:

BACKFILL WORK ORDER ISSUED

DEPOSIT, \$

SEWER WORK ORDER ISSUED

DATE

BY

Plan Approved

MAR 11 1991