

# SIDE SEWER AS BUILT


# CITY OF MOUNTLAKE TERRACE

OWNER: - FRANK JOHANNES  
 ADDRESS: - 5110 243RD ST. SW  
 CONTRACTOR: - LUTZ BACKHOE  
 PERMIT NO.: - U-93-08  
 ISSUE DATE: - 5/17/93  
 INSPECTED BY: - D.M.S.  
 DATE: - 6/16/93

CENTERLINE 243RD ST. SW

PROPERTY LINE

JOINT SIDE SEWER

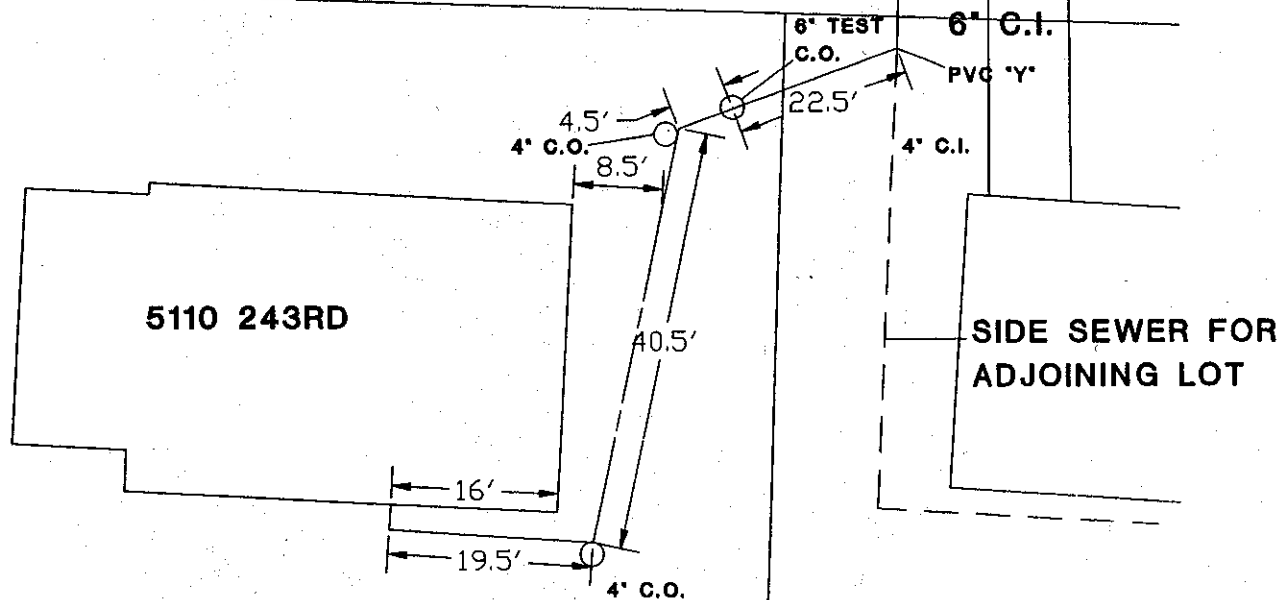

SCALE 1"=10'