

# APPLICATION

The City of Mountlake Terrace

SIDE SEWER PERMIT

CARD No. \_\_\_\_\_


OUTSIDE ☐ INSIDE ☐ REPAIRS ☐

EASEMENT No. \_\_\_\_\_

OWNER Parkwood Homes Inc CONTRACTOR Lynnwood Septic Tank PERMIT No. 4004

HOUSE No. 4509 219th SW STREET 8 AVENUE LOT No. 8 BLOCK No. \_\_\_\_\_

NAME ADD. Parkwood Homes

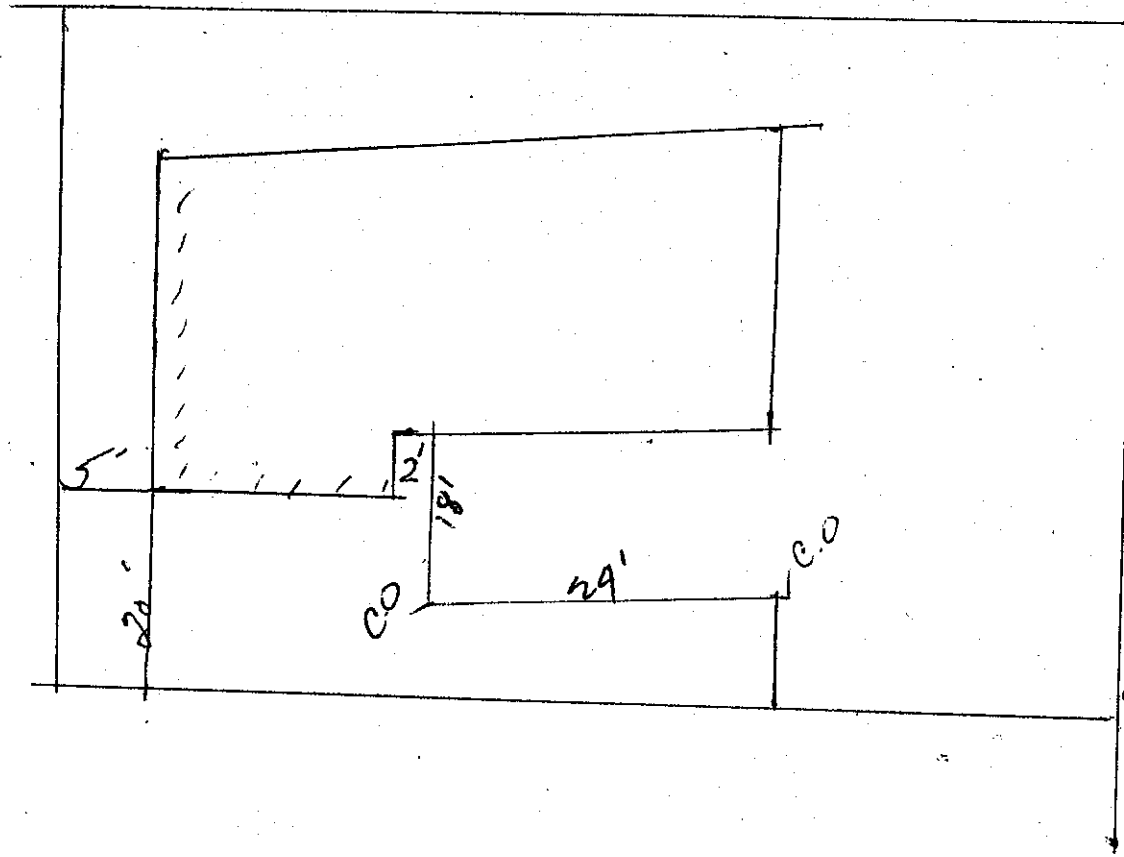

BACKFILL WORK ORDER ISSUED \_\_\_\_\_ Date \_\_\_\_\_ DEPOSIT, \$ \_\_\_\_\_  
SEWER WORK ORDER ISSUED \_\_\_\_\_

Approved: \_\_\_\_\_  
DATE Oct 29, 65 BY CRK