


REVISIONS:
REVISED 55 FROM MH #1 TO MH #2, NO. 1
REVISED 17-5 F.S. SUC. CONNECTIONS BLDG'S "B-F"
REVISED 5 SUC. CONNECTION BLDG'S C-E
6-13-86 LEL
7-17-87 D.J.H.
7-25-87 D.J.H.

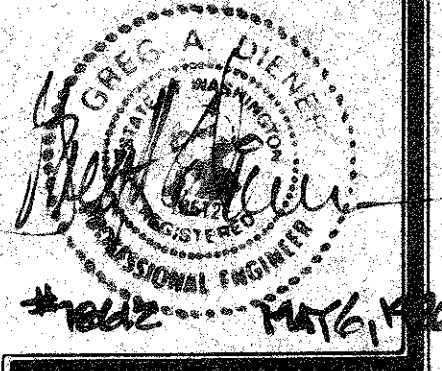


Thomas A. Johnson, AIA
Greg L. Allwine, Arch.

LEGEND

- 8" S.S. NEW SANITARY SEWER MAIN W/LINE SIZE & MANHOLE
- 8" S.S. EXISTING SANITARY SEWER MAIN W/LINE SIZE & MANHOLE
- S.S.V.C. SIDE SERVICE LINE W/6" BUILDING CLEANOUT
- MAIN LINE CLEANOUT (8") (P/A)

SANITARY SEWER NOTES

1. ALL MATERIALS AND WORKMANSHIP SHALL CONFORM TO THE STANDARDS OF THE CITY OF MOUNTLAKE TERRACE AND THE 1984 EDITION OF THE AMERICAN PUBLIC WORKS ASSOCIATION (APWA) STANDARD SPECIFICATIONS.
2. LOCATIONS OF EXISTING UTILITIES ARE APPROXIMATE AND IT SHALL BE THE RESPONSIBILITY OF THE CONTRACTOR TO VERIFY LOCATIONS IN THE FIELD.
3. SANITARY SEWER PIPE SHALL BE PVC CONFORMING TO THE PROVISIONS OF ASTM D3034 OR SDR 35.
4. ALL MANHOLES SHALL HAVE LOCKING LIDS, EXCEPT WHERE LOCATED IN THE PAVED PUBLIC RIGHT-OF-WAY.
5. ALL TRENCH BACKFILL TO BE COMPACTED TO 95% DENSITY PER ASTM D-1557.70.
6. ALL SIDE SEWERS TO BE 6" PVC WITH A MINIMUM SLOPE OF 2%.
7. ALL MANHOLES TO HAVE A MINIMUM OF 0.10' DROP BETWEEN INVERTS.
8. INSPECTION TO BE BY THE CITY OF MOUNTLAKE TERRACE.
9. ESSENTIALLY PARALLEL WATER AND SEWER LINES SHALL HAVE A MINIMUM HORIZONTAL SEPARATION OF AT LEAST 10 FEET.
10. ALL PVC PIPE SHALL HAVE A MINIMUM OF 3 FEET OF COVER.
11. TYPE 1 - 48" MANHOLES PER CITY OF MOUNTLAKE TERRACE STANDARD PLAN #86-21. ALL MANHOLES SHALL HAVE CONCENTRIC CONES AND 3/4" SAFETY STEPS.
12. SANITARY AS-BUILT DRAWING SHOWING LOCATION LENGTH AND ALIGNMENT OF ALL MAIN AND SIDE SANITARY SEWERS SHALL BE PROVIDED TO THE CITY OF MOUNTLAKE TERRACE UPON COMPLETION OF SANITARY SEWER INSTALLATION. CONTRACTOR TO PROVIDE HORIZONTAL FIELD SURVEY OF COMPLETED CONSTRUCTION.

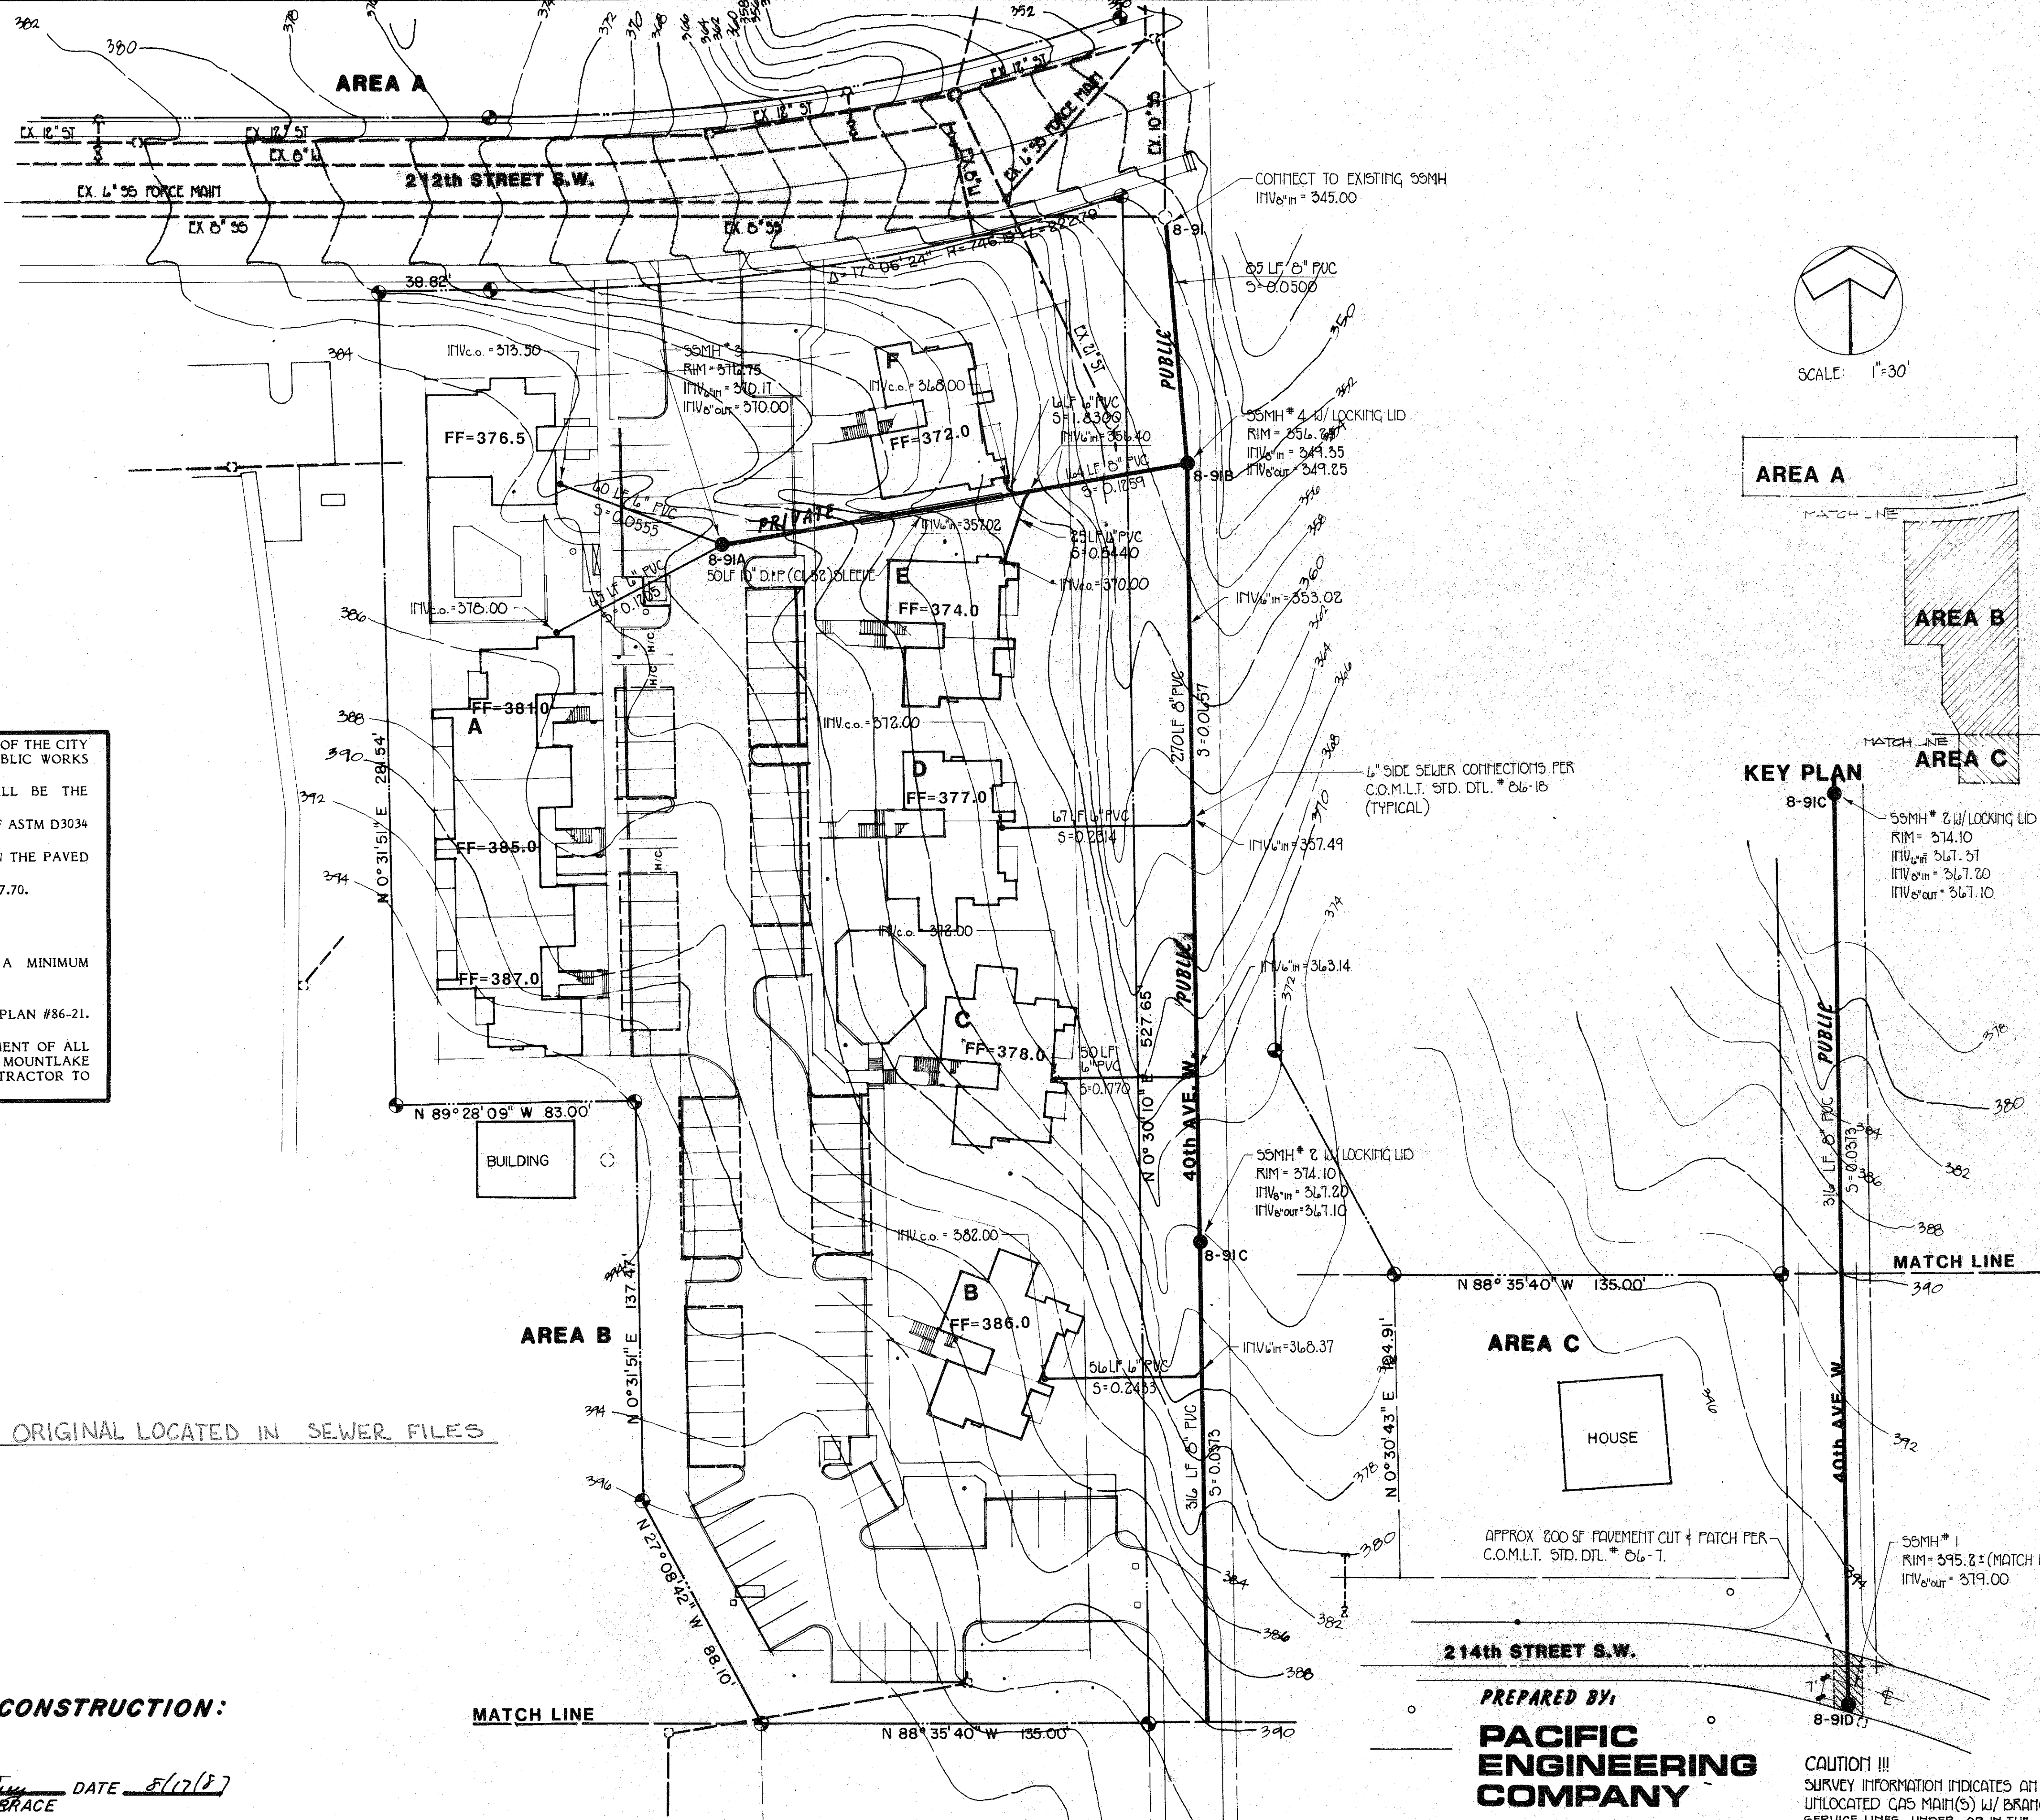

APPROVED FOR CONSTRUCTION:

Cash Rasmussen DATE 5/12/87
CITY OF MOUNTLAKE TERRACE

JohnsonBraund design group

PREPARED BY:
PACIFIC ENGINEERING COMPANY

304 MAIN AVENUE SOUTH
RENTON, WA. 98055
(206) 271-7200/223-5732

architecture.

CAUTION !!!
SURVEY INFORMATION INDICATES AN UNLOCATED GAS MAIN(S) W/ BRANCH SERVICE LINES UNDER, OR IN THE VICINITY OF, 214th ST. S.W. FIELD VERIFY PRIOR TO COMMENCING ANY EXCAVATION IN THIS AREA.

C5

Project No 85-51
Drawn by LEL
Issue date 5-1-86
Latest rev 7-25-87

VICTORIAN WOODS DEVELOPMENT

MOUNTLAKE TERRACE
FOR: LARRY LOEBER
PRIME PROPERTIES
KENNEWICK, WASHINGTON

SANITARY SEWER PLAN (SOUTH)

304 main ave so, suite 200 renton, wa 98055 (206) 271-7200 623-5732