

PAVEMENT SECTION -
(CLASS B & ATB)
BLOCK
TRAFFIC CURB

TOP SOIL


1'-0"

1'-0"

1'-0"

SECTION A-A

N.T.S.

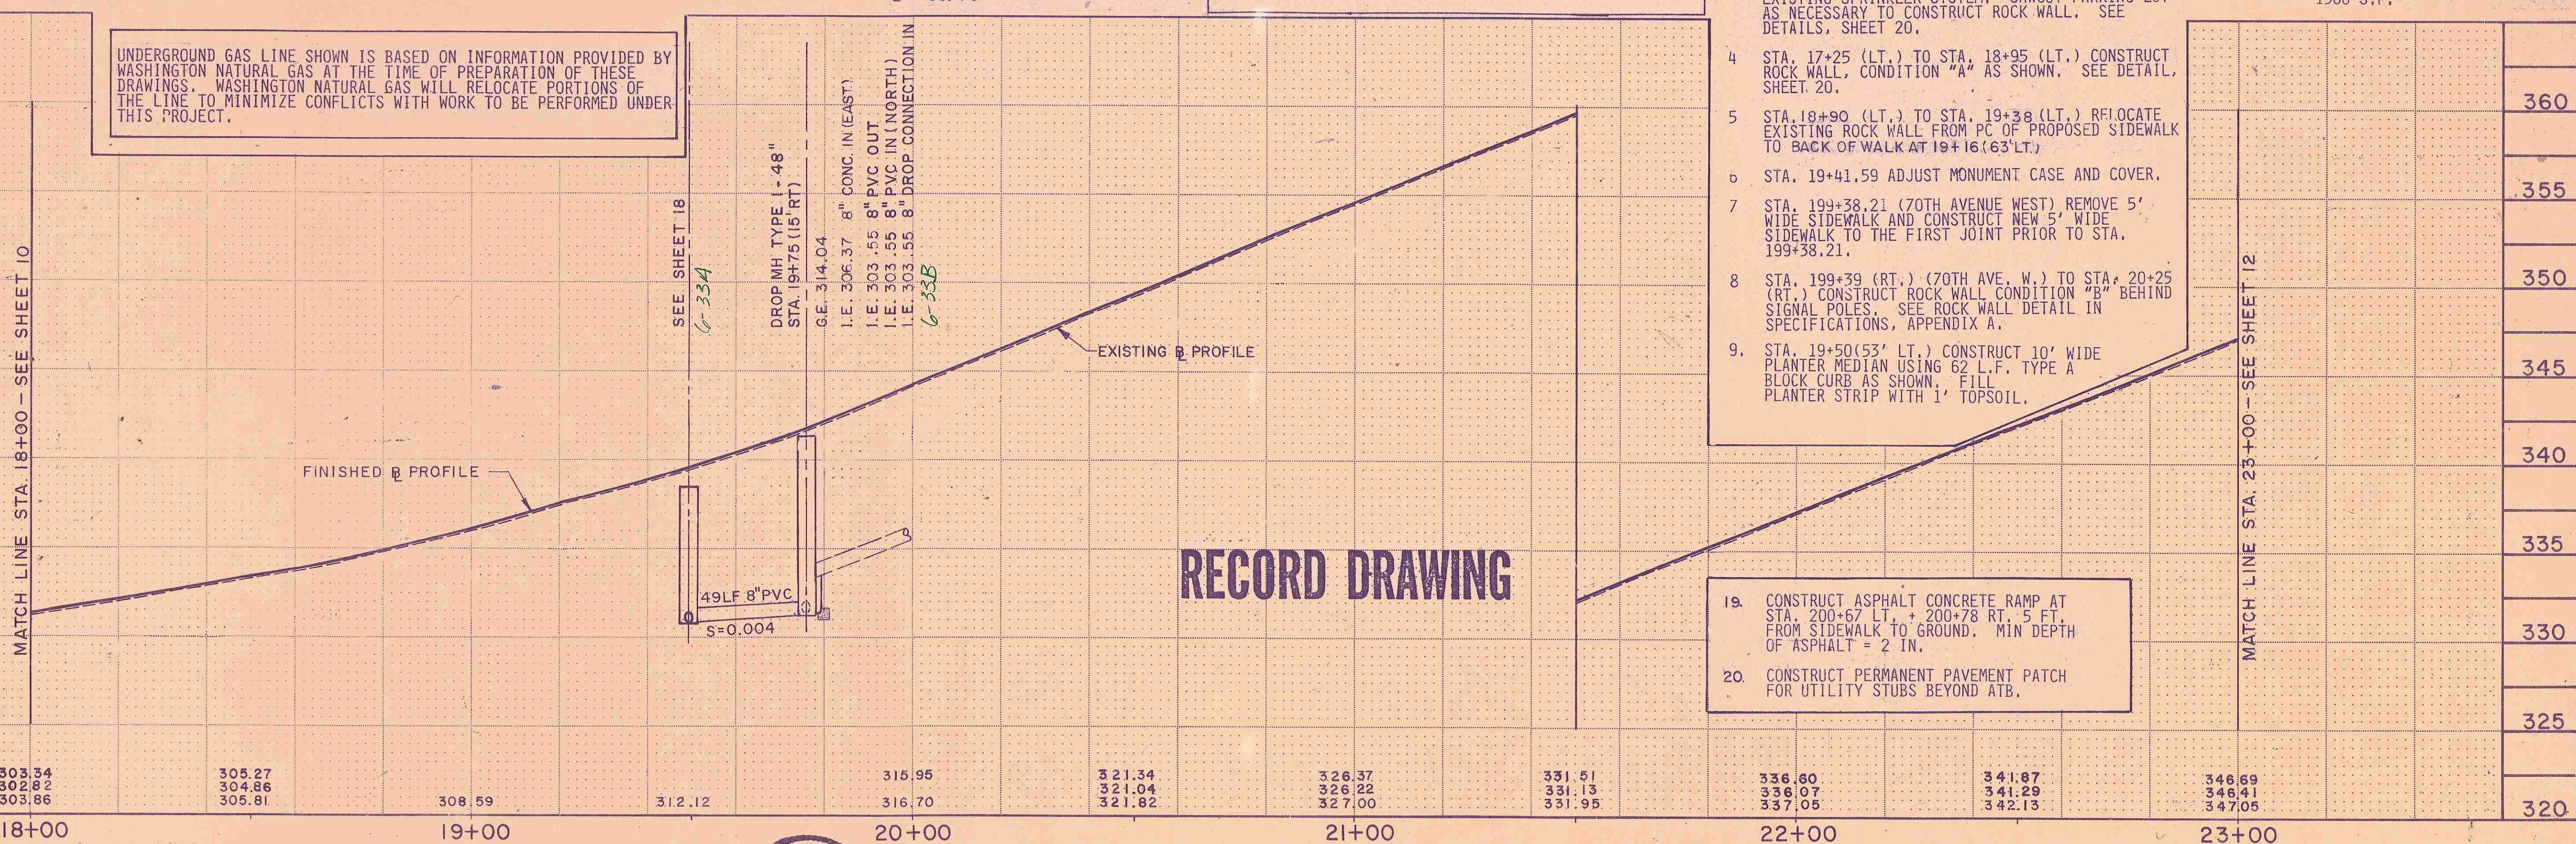

RECORD DRAWING

19. CONSTRUCT ASPHALT CONCRETE RAMP AT STA. 200+67 LT. + 200+78 RT. 5 FT. FROM SIDEWALK TO GROUND. MIN DEPTH OF ASPHALT = 2 IN.
20. CONSTRUCT PERMANENT PAVEMENT PATCH FOR UTILITY STUBS BEYOND ATB.

4/8/87 3/9/86 2/7/86 7/86 No. Date By Ckd. Appr. Revision						REVISION FOR RECORD DRAWING Revised Sidewalk on North Side of 220th & M.H. Invert at 19+75 (15' Rt.) Sewer & Water Revisions Modifications to 70th Ave Intersection / Drop Lane				Approved By: <i>Eugene W. Wright</i> Drawn By: <i>JTB</i> Date: 4-86 Designed By: <i>BH</i> 4-86 Checked By: <i>EW</i> 4-86 Approved By:		ENTRANCO Engineers ENVIRONMENTAL AND TRANSPORTATION CONSULTANTS BELLEVUE EVERETT WASHINGTON		Scale: Horiz. 1"= 20' Vert. 1"= 5' Job No.: 86026 -20		CITY OF MOUNTLAKE TERRACE 220TH STREET SW. STA.18+00 TO STA.23+00 PLAN & PROFILE		Sheet 11 Of 42	
---	--	--	--	--	--	--	--	--	--	--	--	--	--	--	--	---	--	-------------------	--