

PROFILE	SURVEYED	BY	DATE
	PLOTTED		
NOTE BOOK	GRADES CHECKED		
	B. M. & NOTED		
NO.	STRUCTURE NOTATIONS CHK'D		


1. SANITARY SEWERS SHALL BE CONSTRUCTED IN ACCORDANCE WITH THE SPECIFICATIONS FOR THE COMPREHENSIVE DRAINAGE PROJECT FOR THE CITY OF MOUNTAIN LA TERRACE.

2. JOINTS SHALL BE G.I. PIPE, CLASS 150, MECHANICAL JOINT OR TYPED JOINT, COATED INSIDE AND CEMENTED INSIDE. CONSTRUCTION SHALL BE IN ACCORDANCE WITH STANDARDS AND REQUIREMENTS OF THE CITY OF MOUNTAIN LA TERRACE.

8" CONC. SANITARY GLEWER PIPE
460 L.F. TO BE INSTALLED.

4" C.I. WATERMAIN 425 L.F.
TO BE INSTALLED.

6" C.I. WATERMAIN 460 L.F.
TO BE INSTALLED.

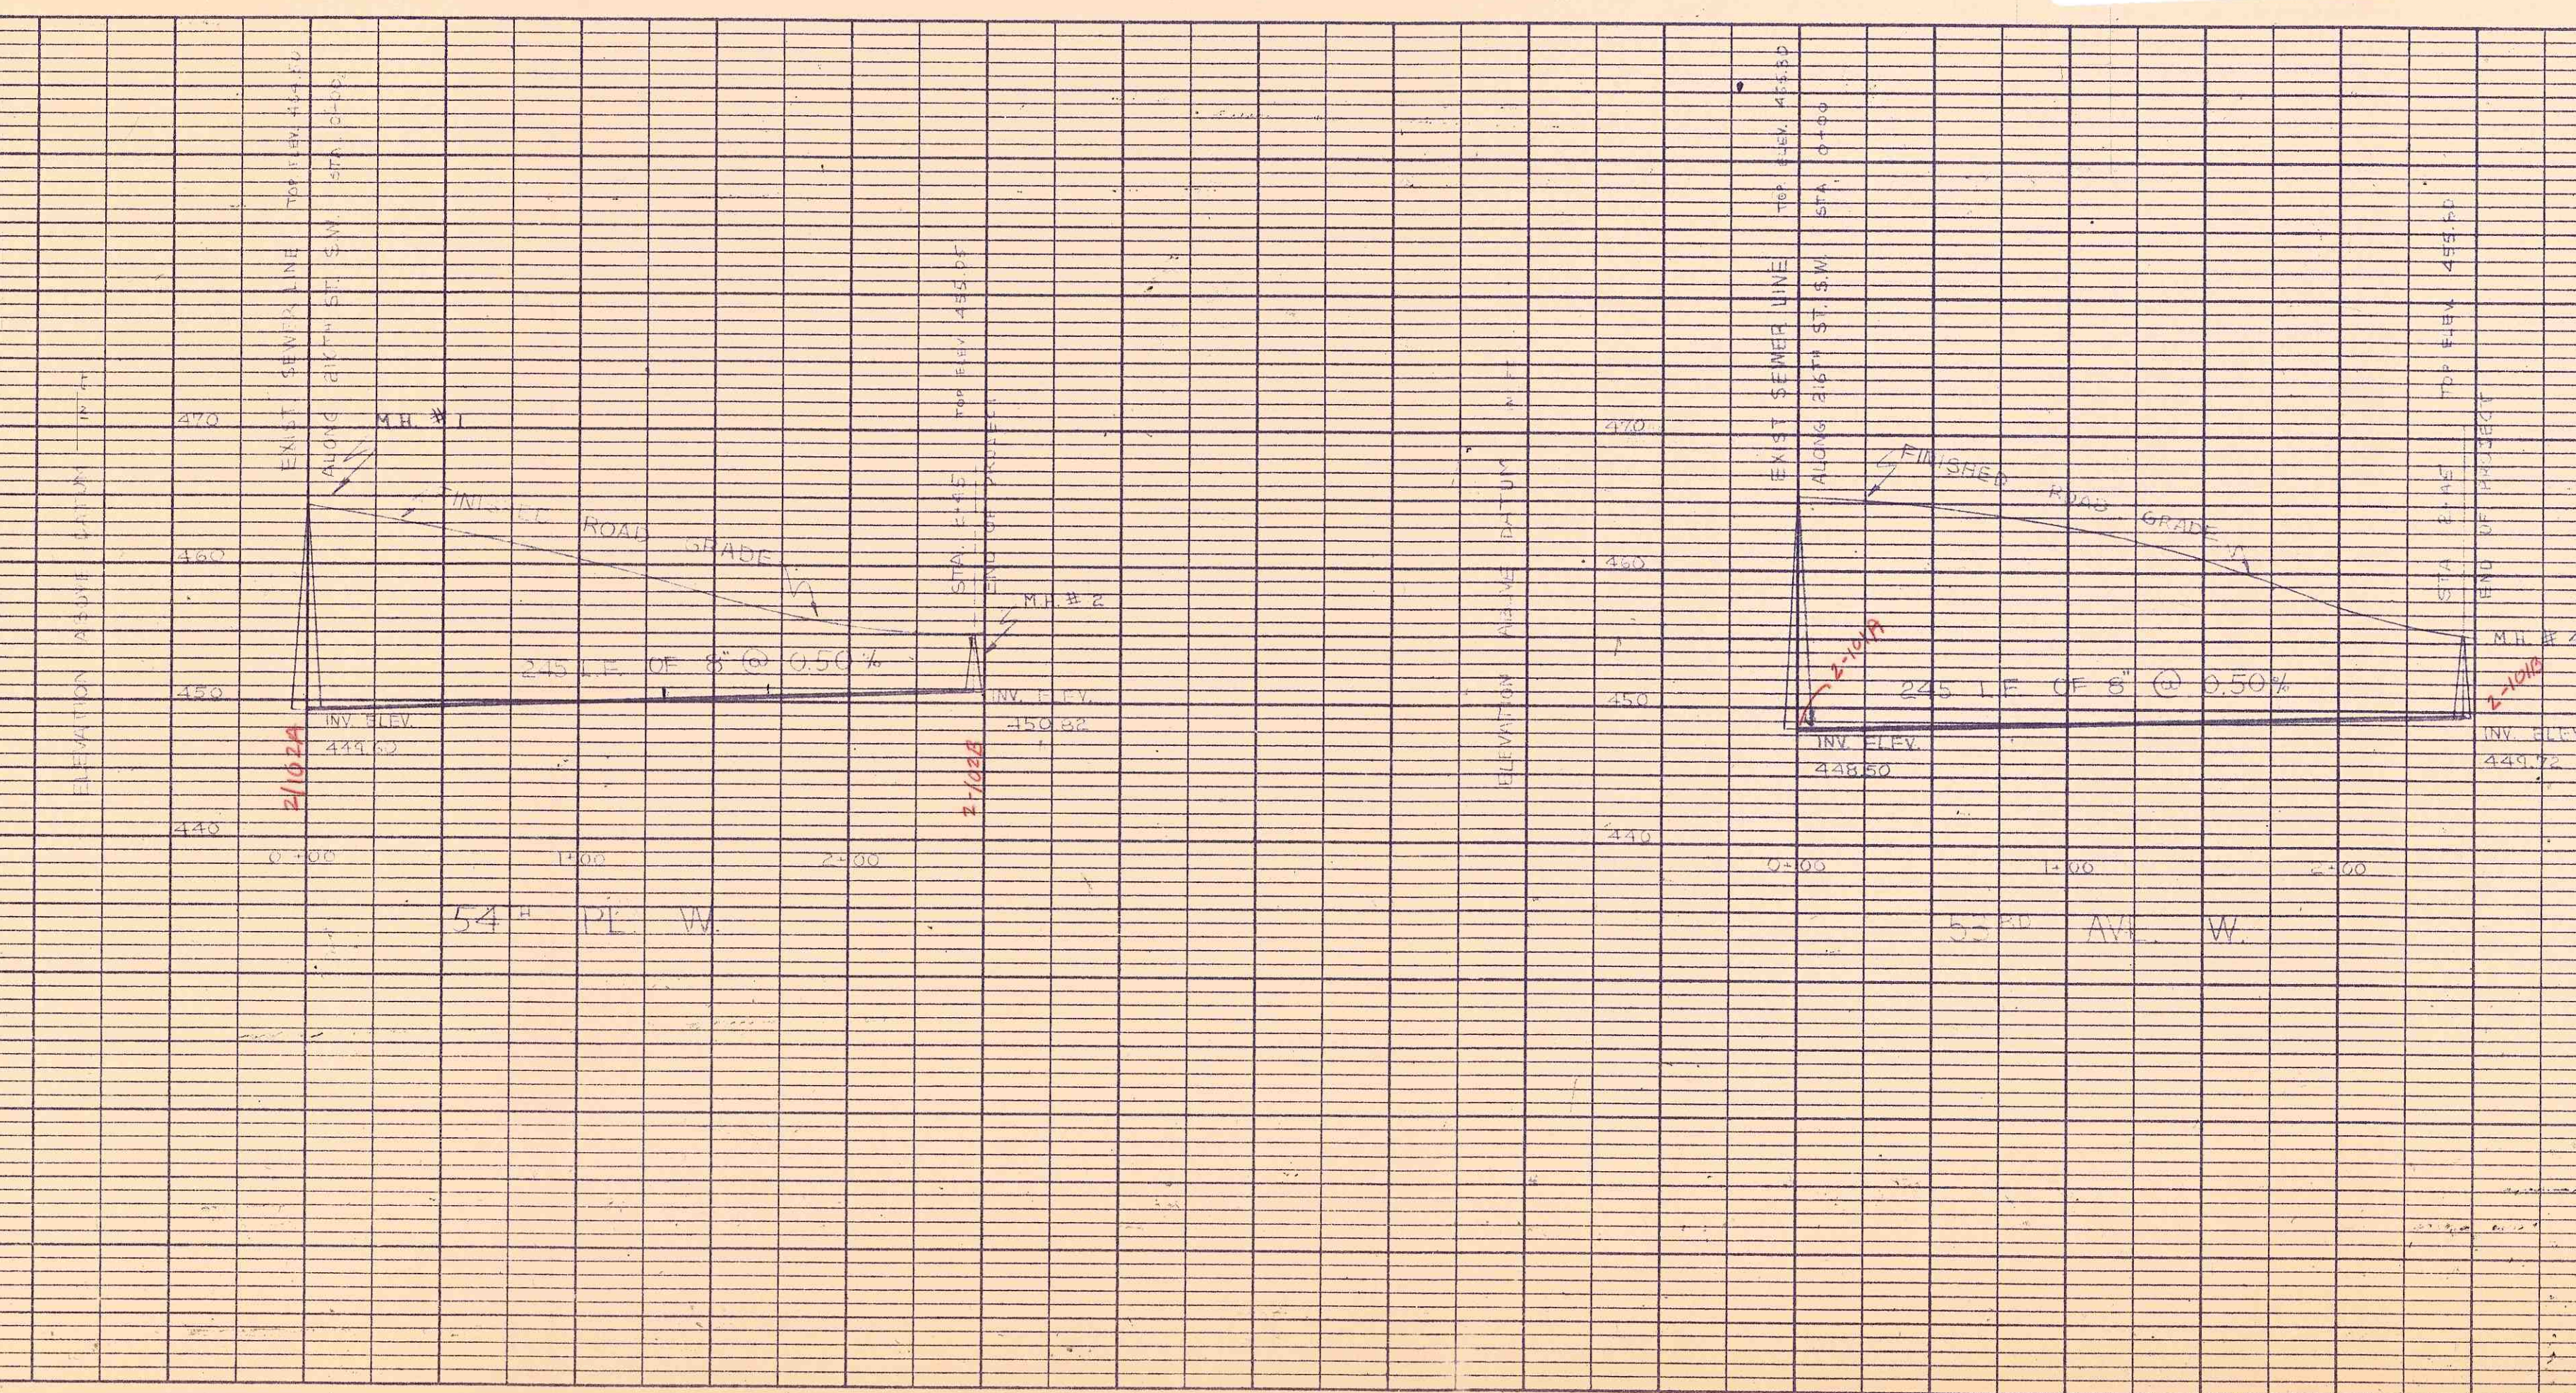

REID, MIDDLETON & ASSOCIATES
CONSULTING ENGINEERS 324 MAIN ST. BIRM.

AS BUILT DRAWING
(SEWERS)

CITY OF MOUNTAIN VIEW, HILLWOOD PARK HO. II.
PLANT PROFILE (SEWER WATERMANS)

2-19-A