

The City of Mountlake Terrace

APPLICATION

for

SIDE SEWER PERMIT

OUTSIDE ☐ INSIDE ☐ REPAIRS ☐

2178

CARD No.

EASEMENT No.

OWNER Elmer V Moss

CONTRACTOR Lynnwood Septic tank PERMIT No. 3195

HOUSE No. 4406


STREET 21

AVENUE LOT No.

BLOCK No.

242 plsn

NAME ADD. Terrace Ridge

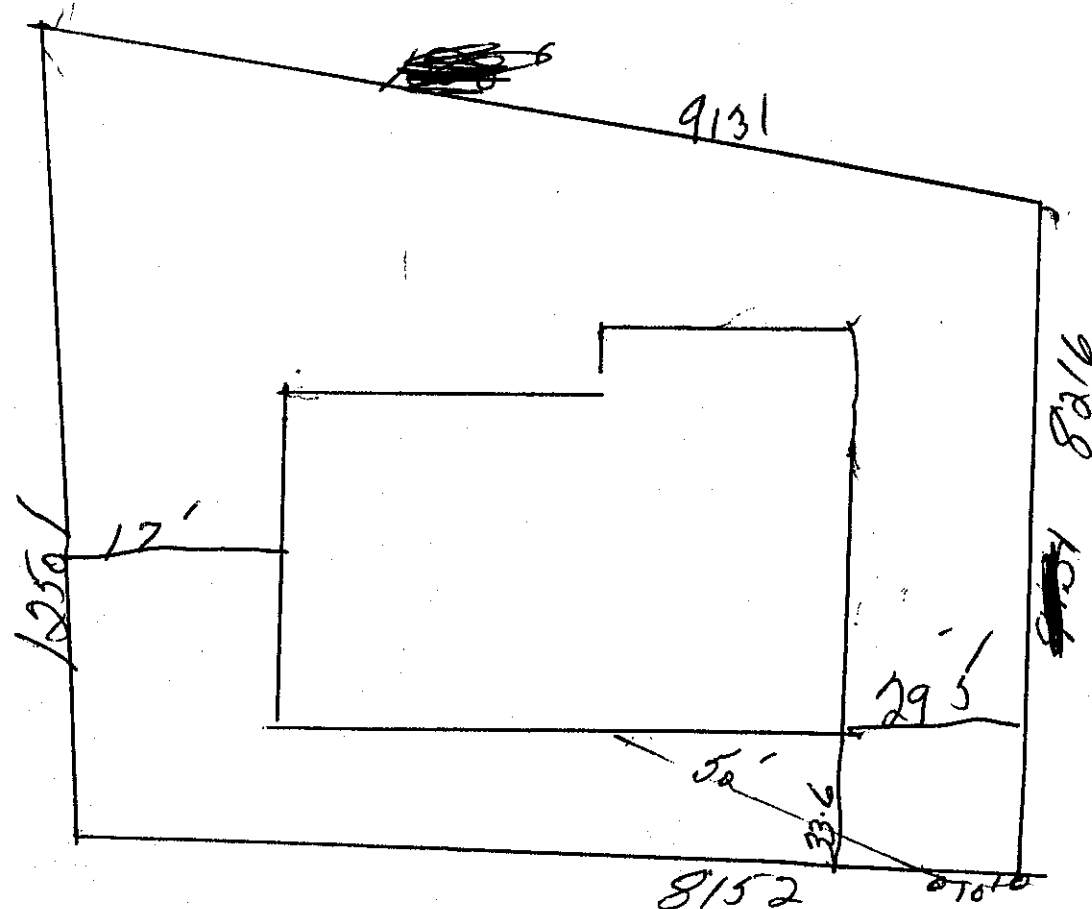

Date

Approved:

BACKFILL WORK ORDER ISSUED DEPOSIT, \$

SEWER WORK ORDER ISSUED

DATE BY