

The City of Mountlake Terrace

# APPLICATION

for

## SIDE SEWER PERMIT

OUTSIDE ☒ INSIDE ☐ REPAIRS ☐


CARD No. \_\_\_\_\_

EASEMENT No. \_\_\_\_\_

OWNER \_\_\_\_\_ CONTRACTOR **LYNNWOOD SEPTIC** PERMIT No. **U-63-75**

HOUSE No. **22302 - 36<sup>TH</sup> W.** STREET \_\_\_\_\_ AVENUE LOT No. **TIMBERLINE #20** BLOCK No. \_\_\_\_\_

21 20 NAME ADD

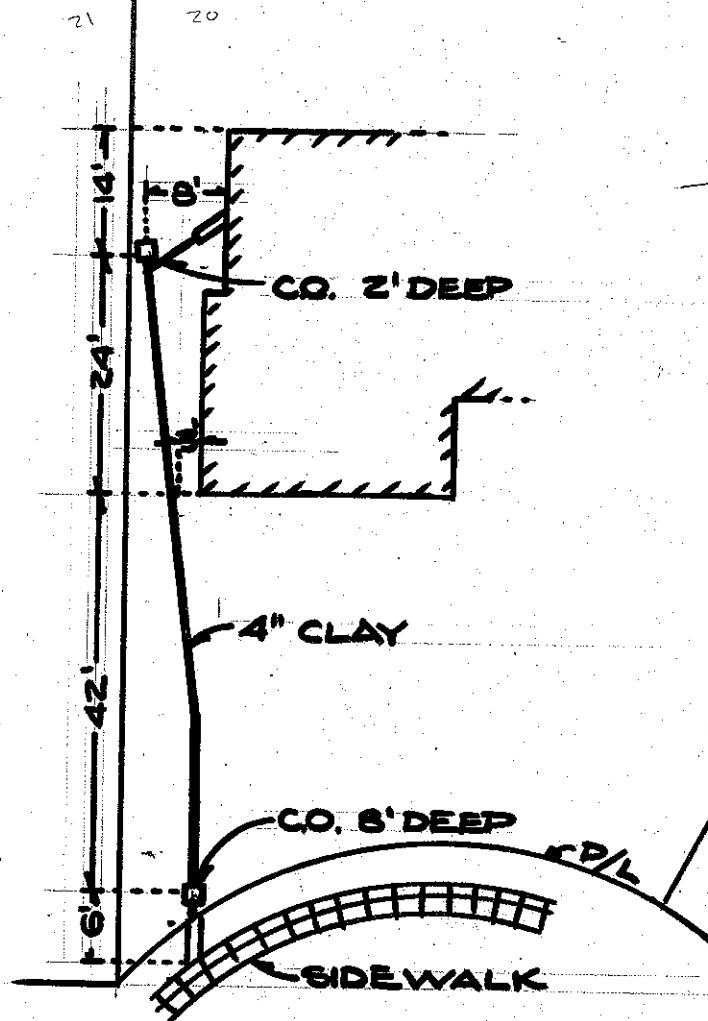

INSPECTED BY  
W. VAN RY ON  
AUGUST 25, 1975

BACKFILL WORK ORDER ISSUED \_\_\_\_\_ Date \_\_\_\_\_ Approved: \_\_\_\_\_  
SEWER WORK ORDER ISSUED \_\_\_\_\_ DEPOSIT, \$ \_\_\_\_\_ DATE \_\_\_\_\_ BY \_\_\_\_\_