

APPLICATION

for

SIDE SEWER PERMIT

CARD No. _____

The City of Mountlake Terrace

OUTSIDE ☐ INSIDE ☒ REPAIRS ☐

EASEMENT No. _____

OWNER Wick Home Inc

CONTRACTOR Lynnwood Septic


PERMIT No. 3706

HOUSE No. 21406 - 54 pl w

STREET
AVENUE LOT No. 1

BLOCK No. _____

NAME ADD. Shanlet

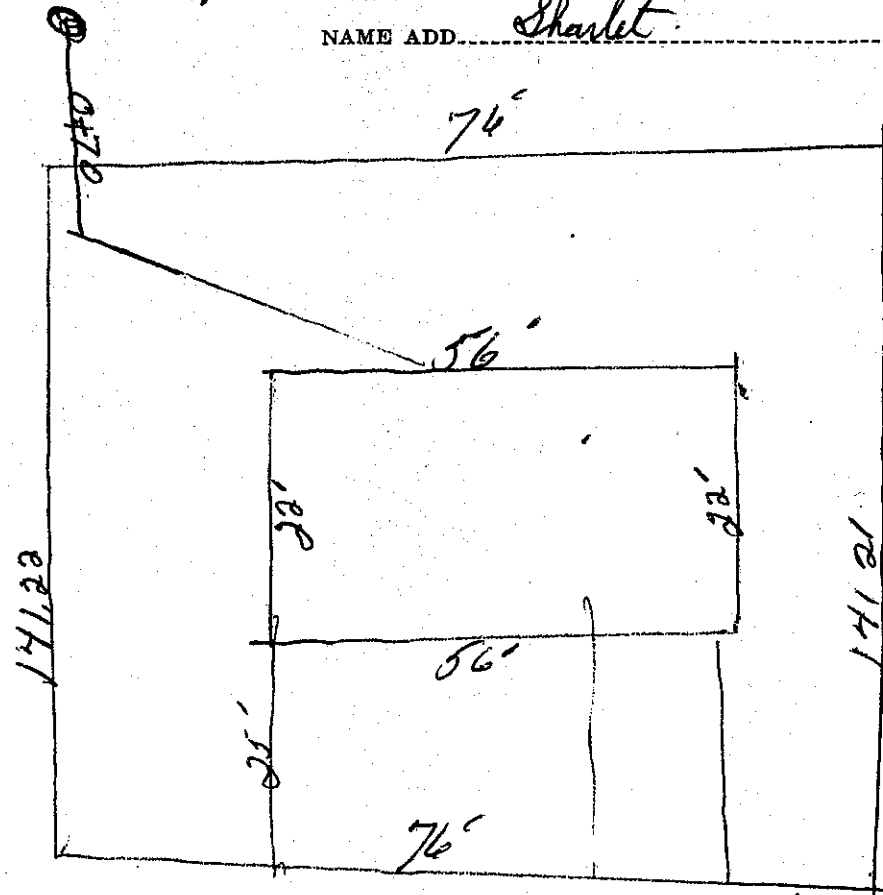

Date _____

Approved: _____

BACKFILL WORK ORDER ISSUED _____ DEPOSIT, \$ _____

SEWER WORK ORDER ISSUED _____

DATE _____ BY _____