



PLOT PLAN - FORCE MAIN & PUMP STATION

1" = 50'

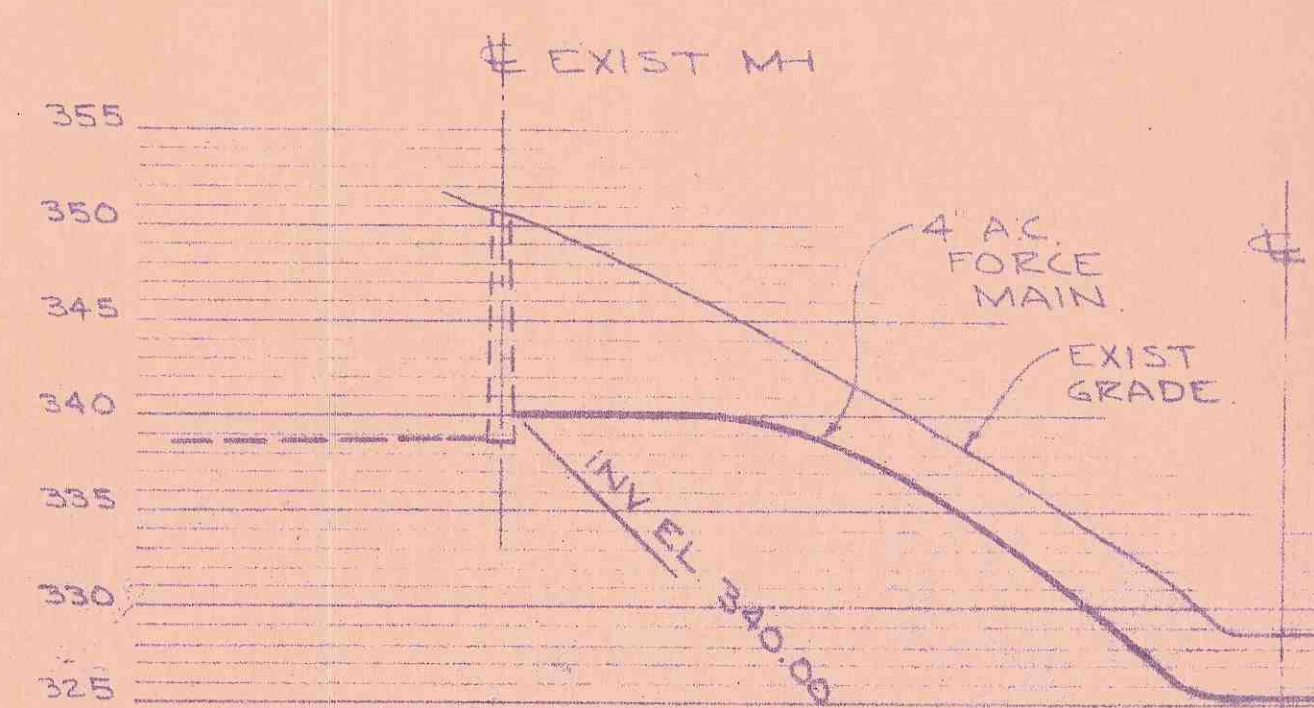


PROFILE - 243RD ST S.W.

HOR SCALE 1" = 50'

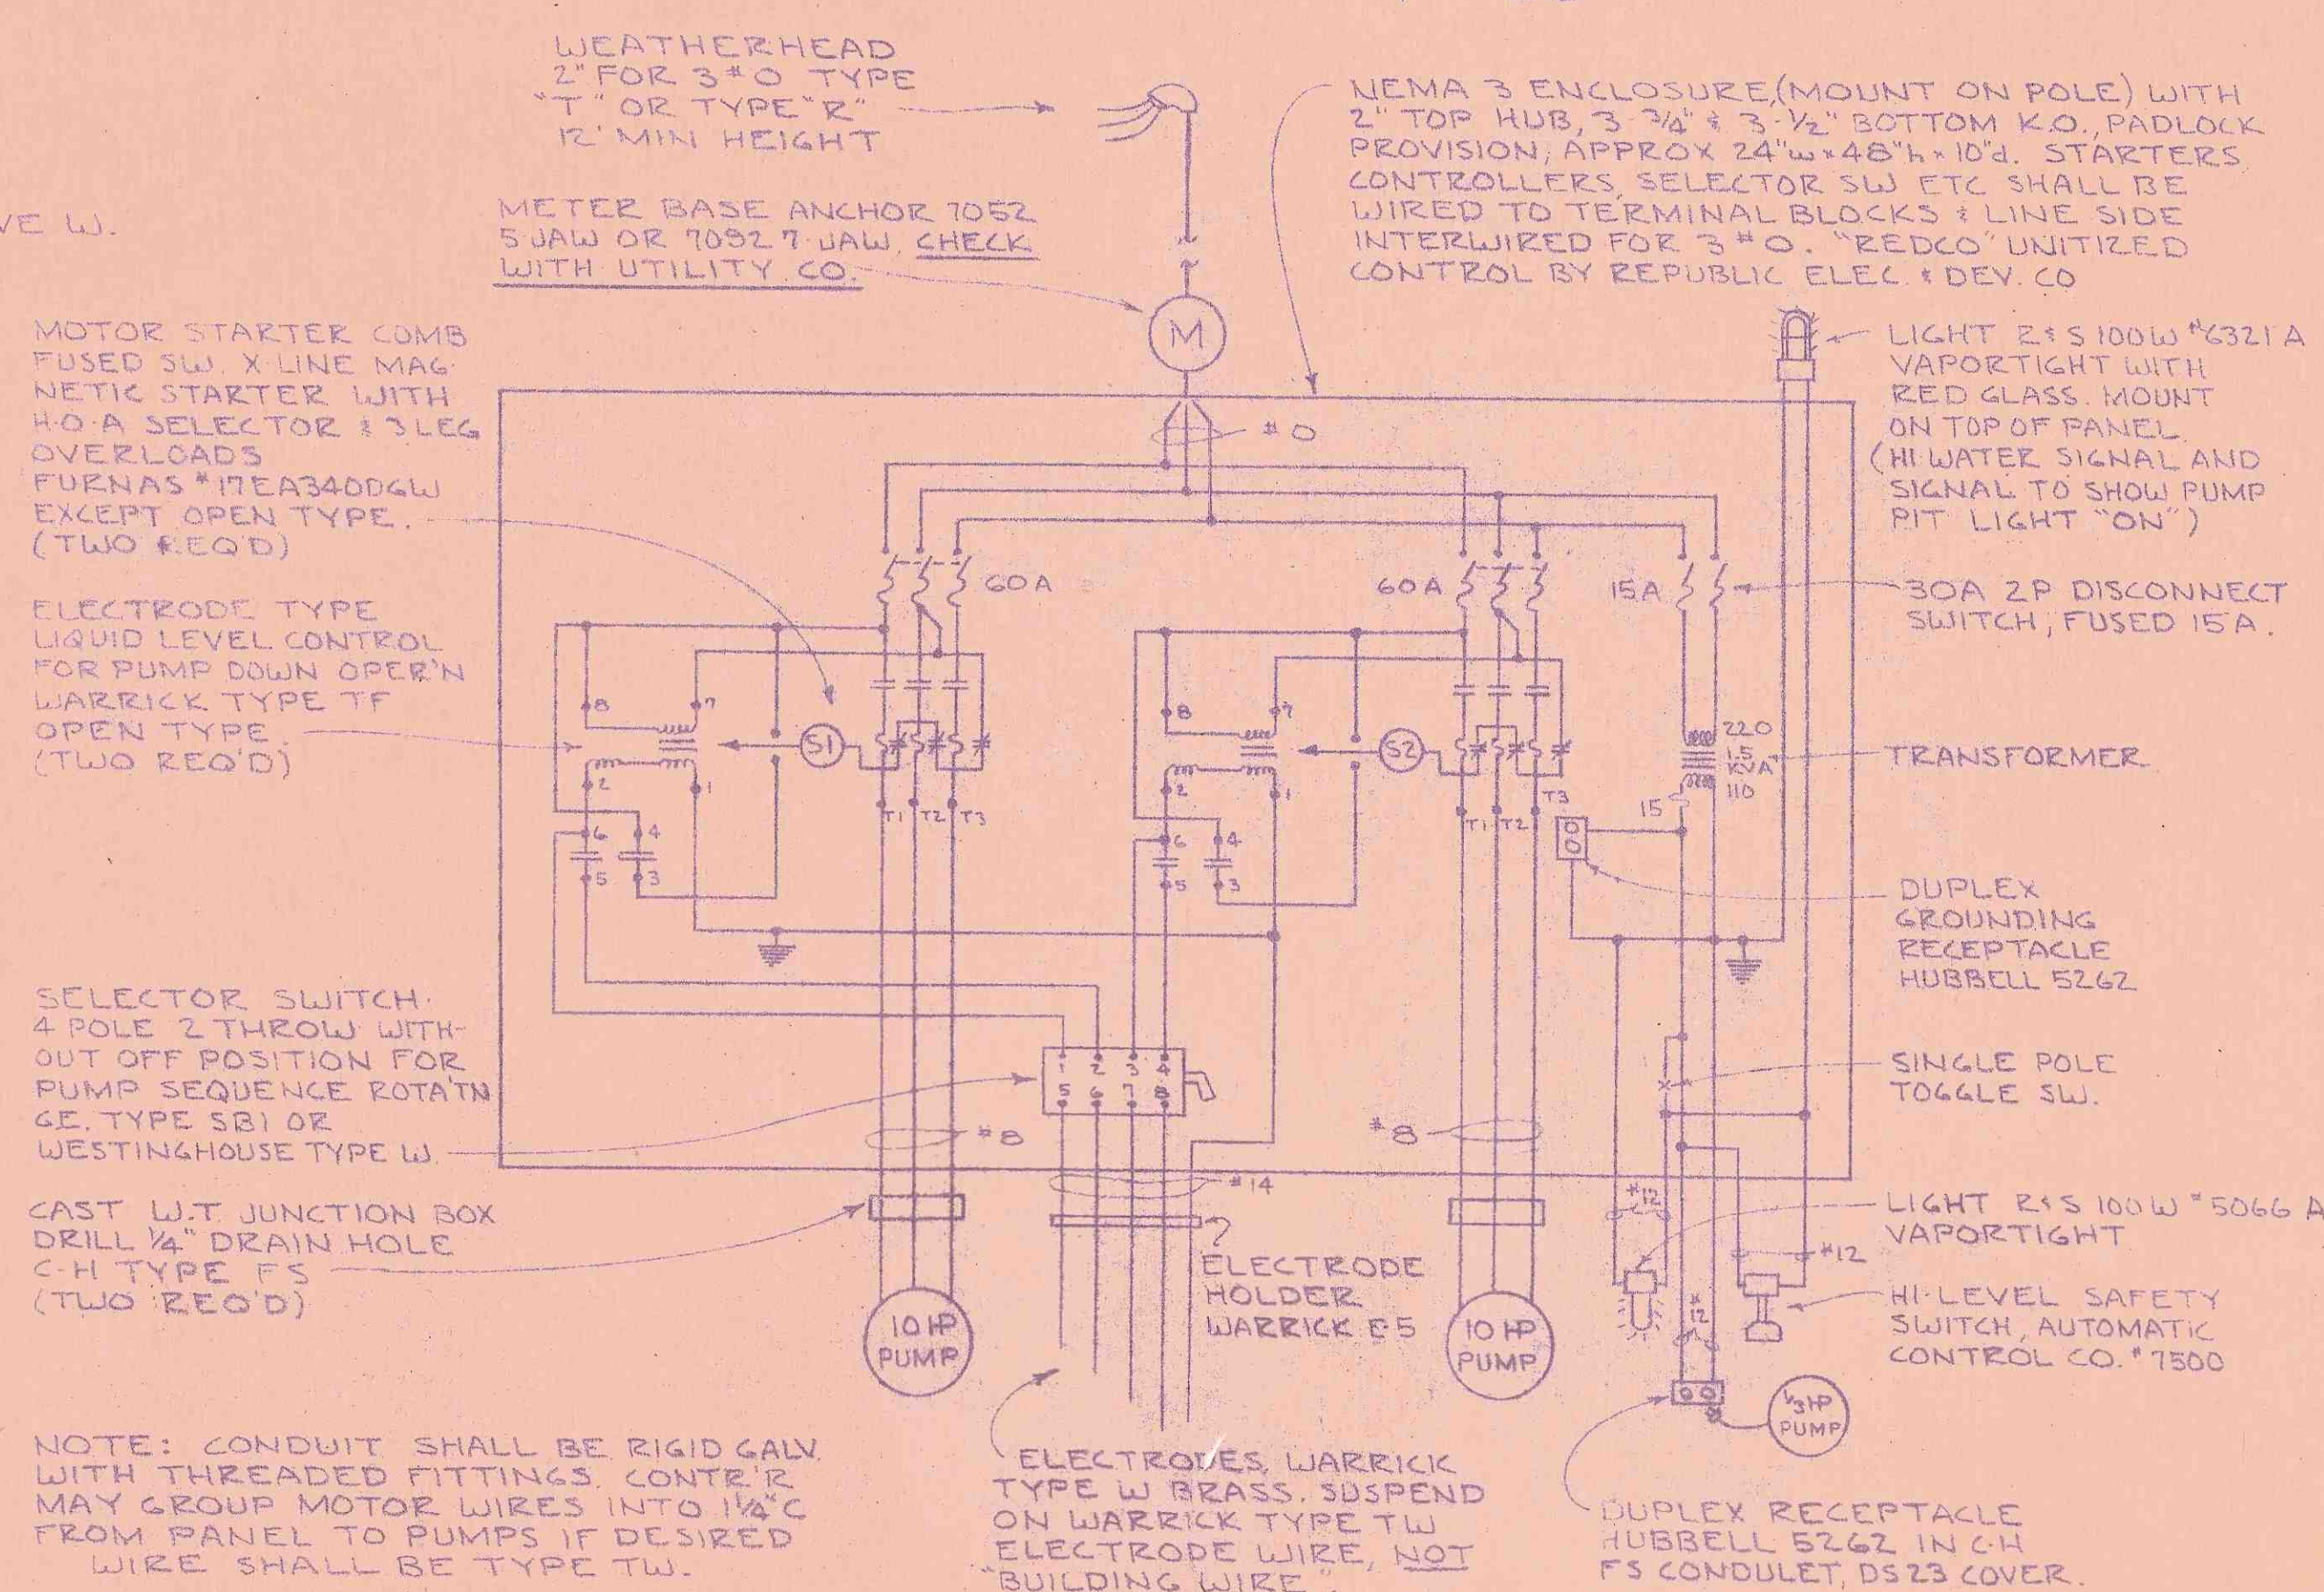

ELECTRICAL SCHEMATIC DIAGRAM

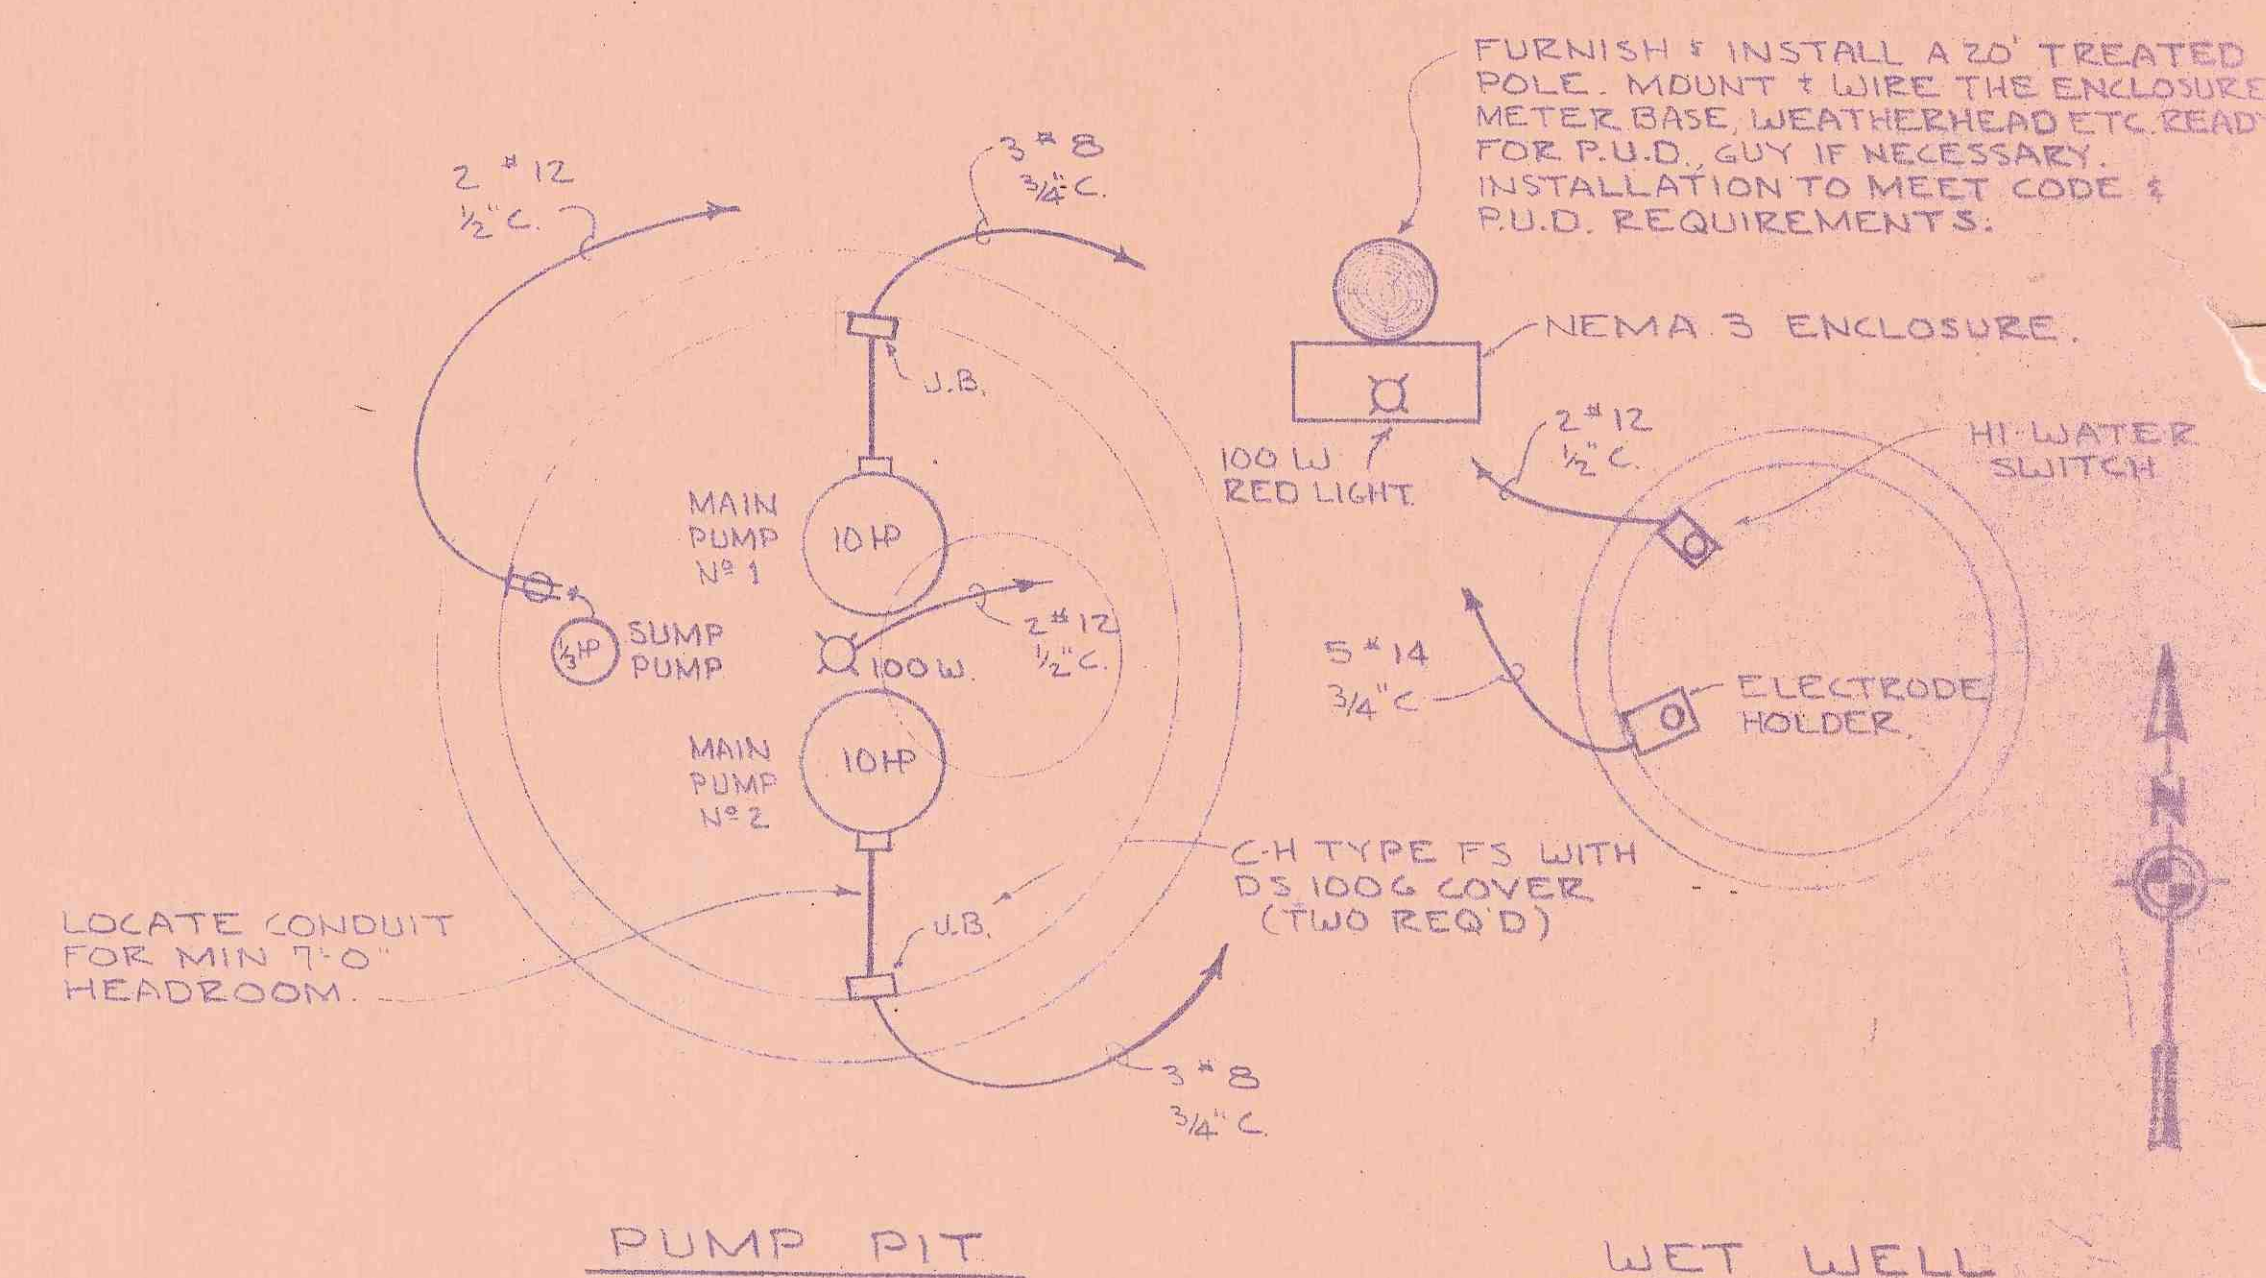

ELECTRICAL PLAN

AS BUILT DRAWING

CITY OF MOUNTLAKE TERRACE		SCALE AS SHOWN
TERRACE RIDGE PUMP STATION		DATE AUG, 1960
PLOT PLAN - ELECTRICAL DETAILS		DESIGN LHM: SKB
JAMES H. REID & ASSOCIATES CONSULTING ENGINEERS 324 MAIN ST. EDMONDS, WASHINGTON		DRAWN KGT
Sewerage Unit 1-18-M		CHECKED LHM
		FILE NO. 5134-01