

APPLICATION

for

SIDE SEWER PERMIT

OUTSIDE ☐ INSIDE ☐ REPAIRS ☐

CARD No. _____

EASEMENT No. _____

The City of Mountlake Terrace

OWNER NORTHWEST ESCROW

CONTRACTOR LYNNWOODA SEPTIC 74-1

PERMIT No. 7477


HOUSE No. 22306

STREET 37TH AVE

AVENUE LOT No. _____ BLOCK No. _____

NAME ADD _____

NORTH

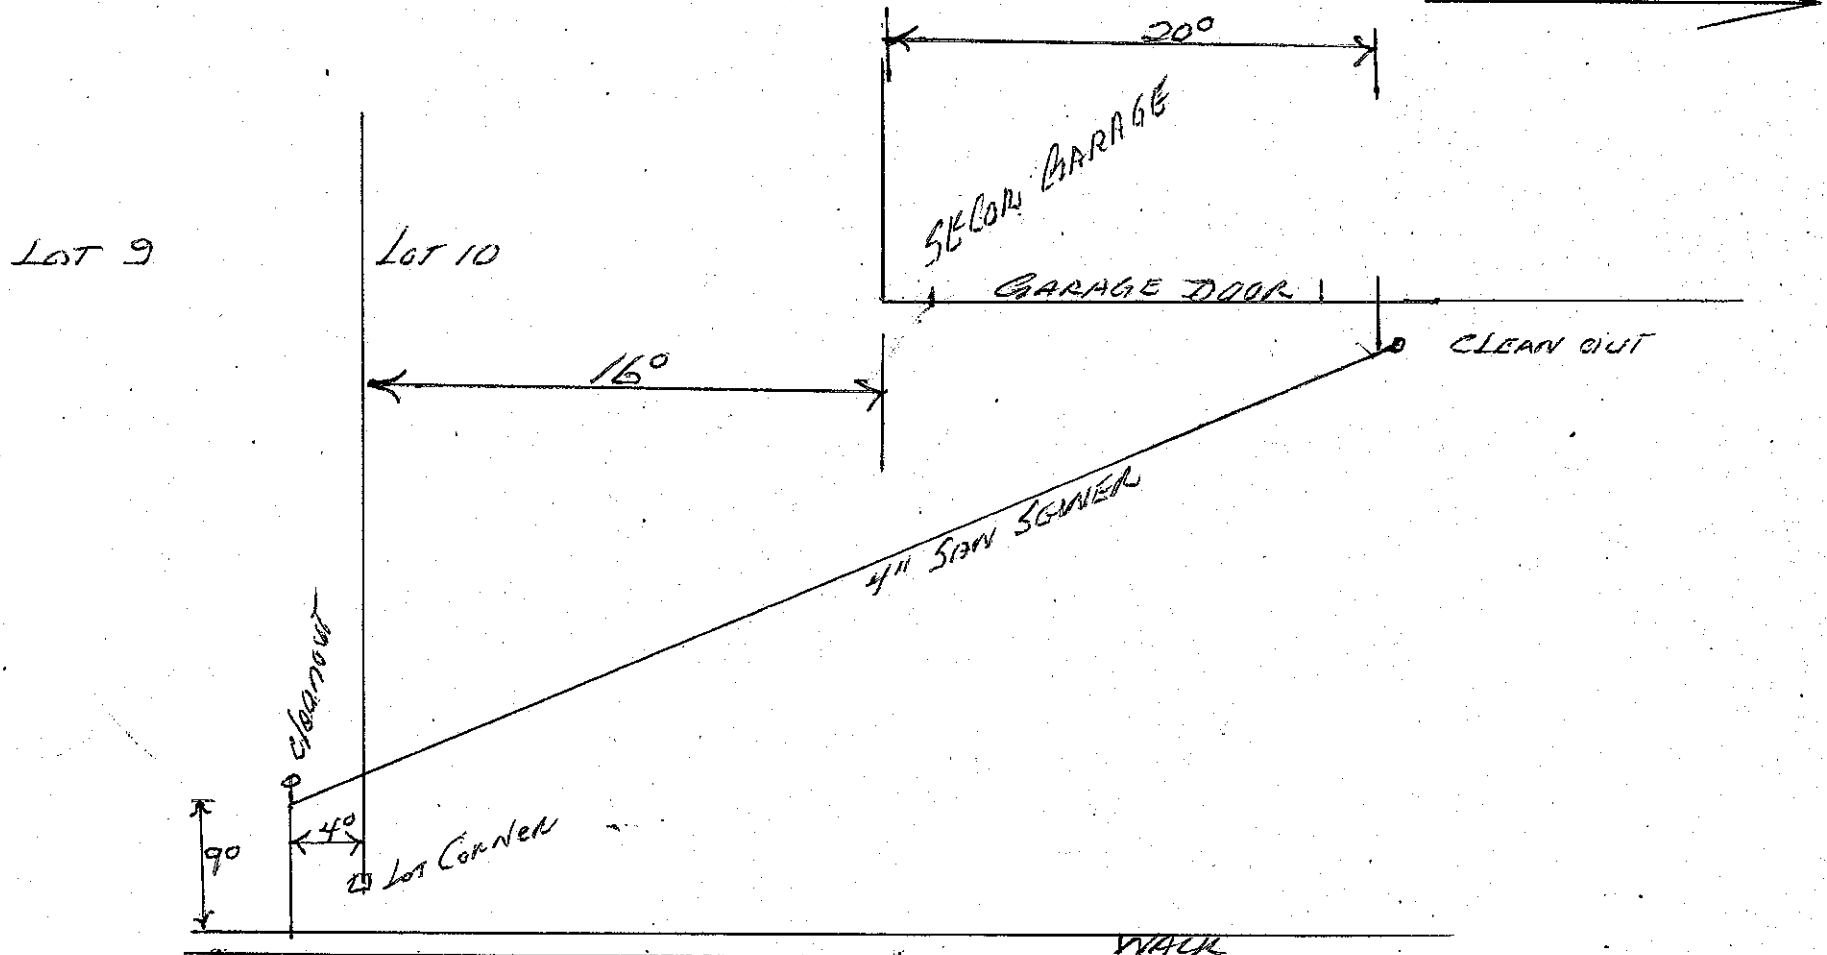

Date

Approved:

BACKFILL WORK ORDER ISSUED 5-3-74 DEPOSIT, \$ _____

SEWER WORK ORDER ISSUED 5-2-74 DATE _____ BY _____