

# APPLICATION

for

SIDE SEWER PERMIT


CARD No. \_\_\_\_\_

The City of Mountlake Terrace

OUTSIDE ☐ INSIDE ☐ REPAIRS ☐

EASEMENT No. \_\_\_\_\_

OWNER David Kerner Inc CONTRACTOR Lynnwood Septic Tank PERMIT No. 4101  
 HOUSE No. 5502 - 214 pl 5 n STREET 16  
 AVENUE LOT No. 16 BLOCK No. \_\_\_\_\_  
 NAME ADDR Hillwood park #10

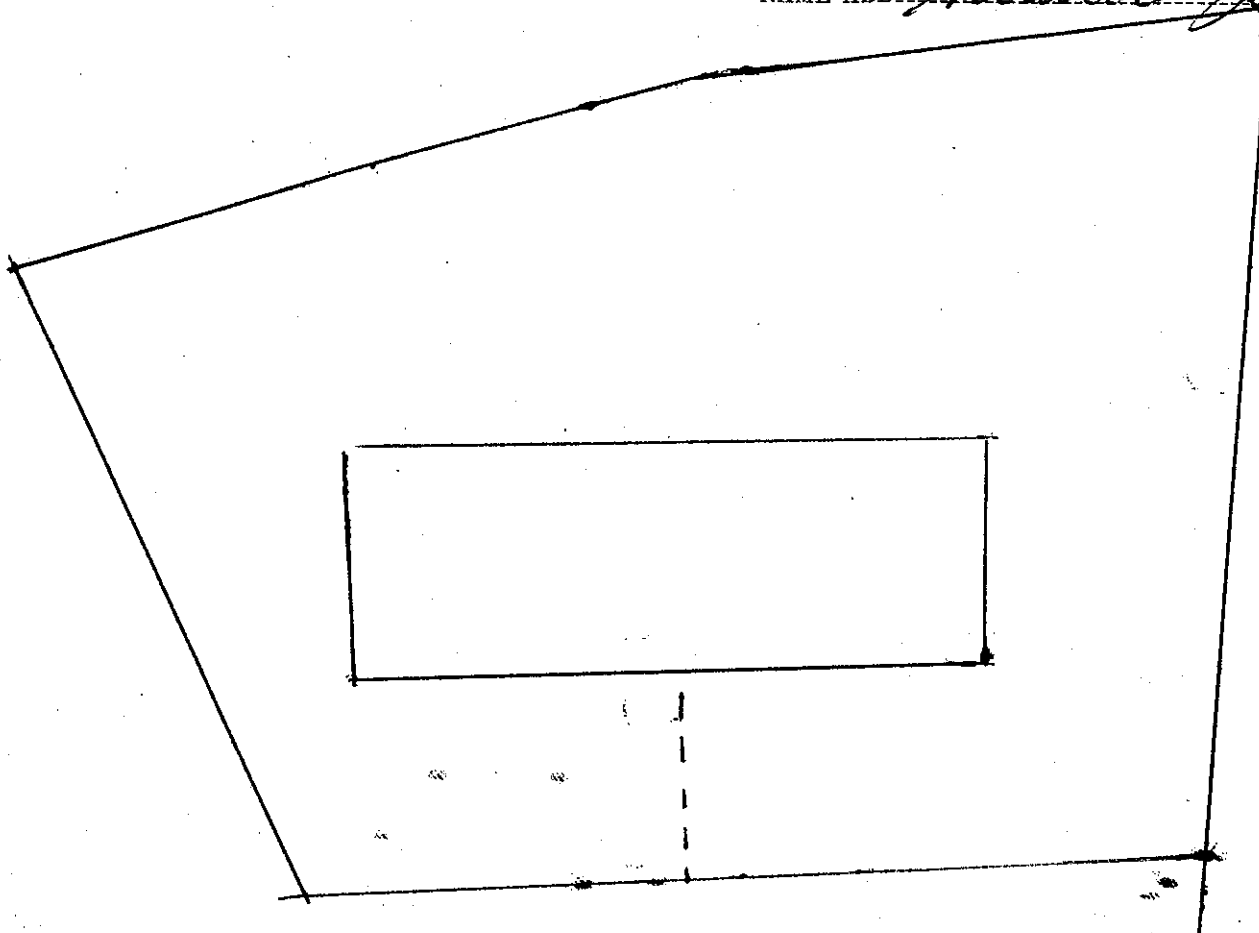

BACKFILL WORK ORDER ISSUED \_\_\_\_\_ Date \_\_\_\_\_ DEPOSIT, \$ 10.00  
 SEWER WORK ORDER ISSUED \_\_\_\_\_

Approved: \_\_\_\_\_  
 DATE \_\_\_\_\_ BY \_\_\_\_\_