

Inspector: *****

Inspector Area:

6308 234 STREET SW

BUILDING PERMIT - ASFR

ISSUED

City / Location: MLT - 6308 234 STREET SW;

Parcel Number: 00524700001900

Description: CONVERT EXISTING 360 SQUARE FOOT GARAGE INTO LIVING SPACE AND CONS

APPLICANT KUEHNE, STEPHEN

425-530-2152

OWNER KUEHNE, STEPHEN

425-530-2152

CONTRACTOR MCALLISTER WORKS LLC

206-228-6186

1100 FOUNDATION WALLS

Requestor: MCALLISTER WORKS LLC

206-228-6186

Action: _____ Comments: _____

1000 FOOTINGS


Requestor: MCALLISTER WORKS LLC


206-228-6186

Action: _____ Comments: _____

Locks, Holds, Notices!

Date	Type	User	Comment
11/08/2007	Notice	PSCHWART	The site is within a critical area. A geotechnical report may be required. See PSE070004.

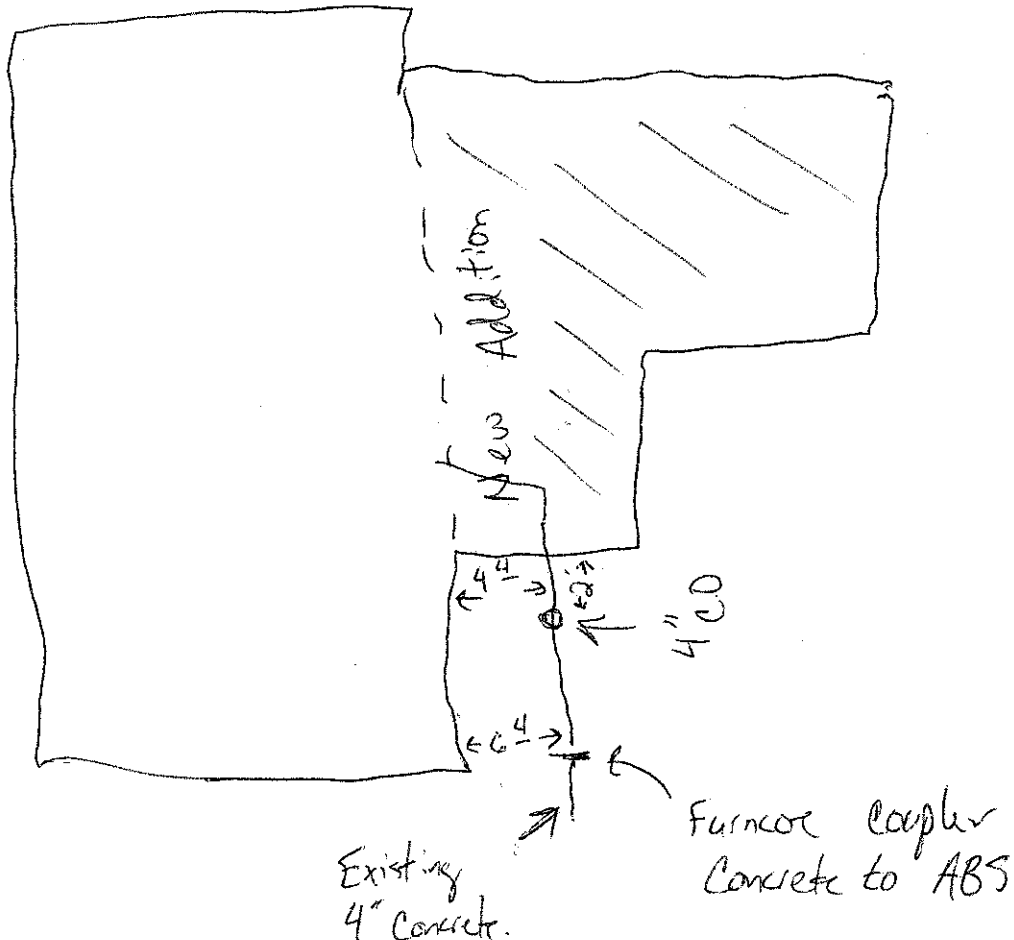

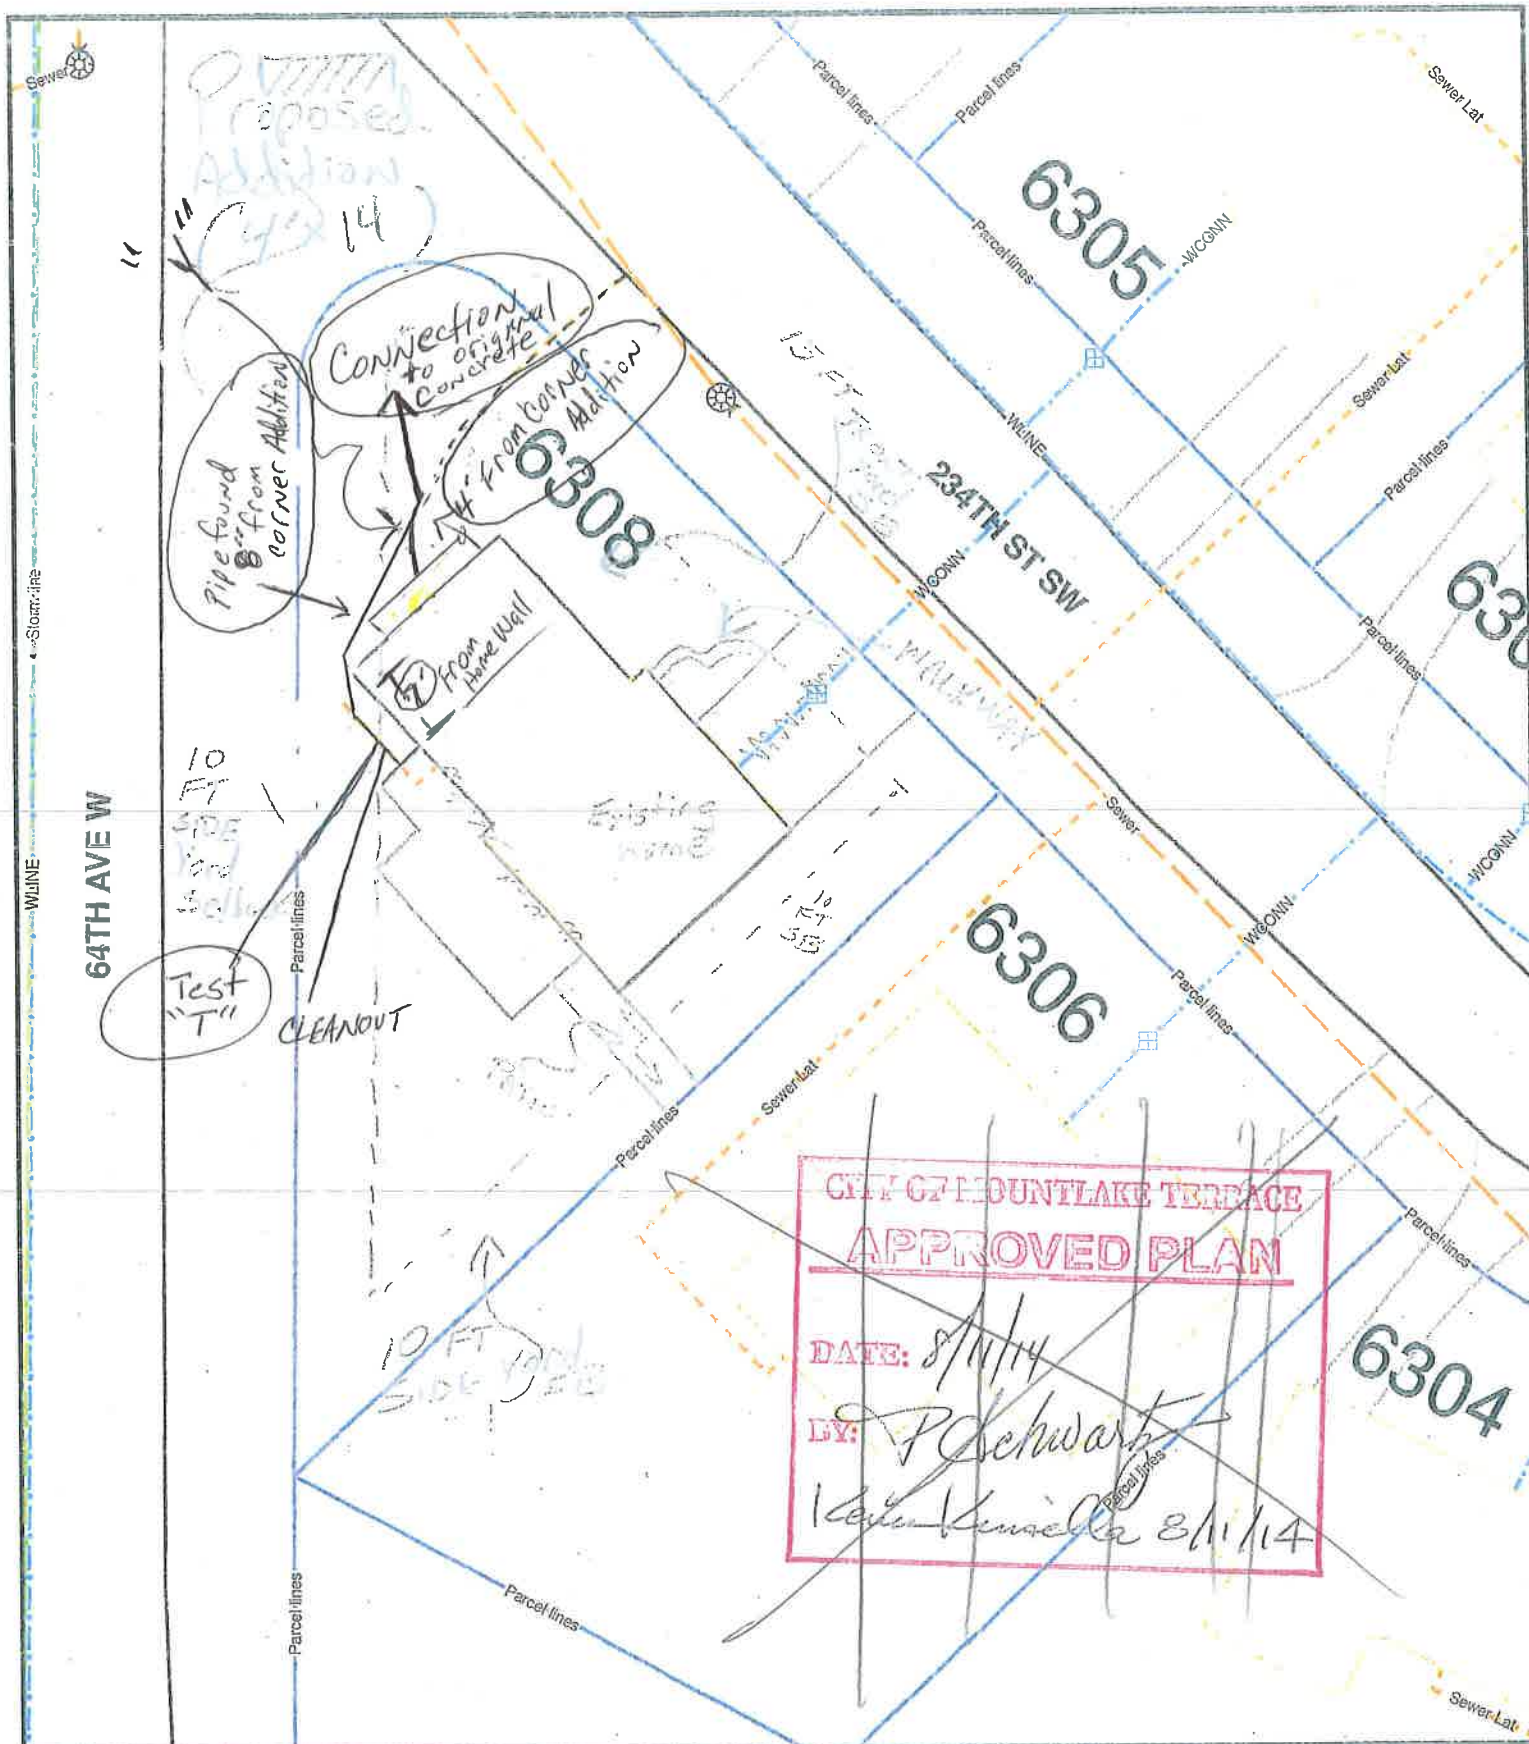

NOTICE: NO WARRANTY OF ACCURACY.
 THE INFORMATION SHOWN ON THIS MAP WAS COMPILED FOR USE BY THE CITY OF MOUNTLAKE TERRACE, ITS EMPLOYEES AND CONSULTANTS. THE CITY OF MOUNTLAKE TERRACE DOES NOT WARRANT THE ACCURACY OF ANYTHING SET FORTH IN THIS MAP. NEITHER THE CITY OF MOUNTLAKE TERRACE NOR ITS EMPLOYEES OR REPRESENTATIVES SHALL BE LIABLE FOR THE INFORMATION GIVEN ON THIS MAP, NOR FOR ANY ORAL REPRESENTATION PROVIDED BASED ON SAID MAP.

TITLE: SIDE SEWER 9/12/14
 "AS BUILT"
 6308 234th Street SW



1 inch = 30 feet

U-14-0046

4
The City of Mountlake Terrace

APPLICATION

for

SIDE SEWER PERMIT


OUTSIDE ☐ INSIDE ☒ REPAIRS ☐

Charles K. Fisher

CARD No.

EASEMENT No. None

OWNER Charles R. Fisher CONTRACTOR self PERMIT No. 1500
HOUSE No. 6308-234th STREET 19
AVENUE LOT No. BLOCK No.
NAME ADDR. Charles R. Fisher 6308-234 SW Div 46

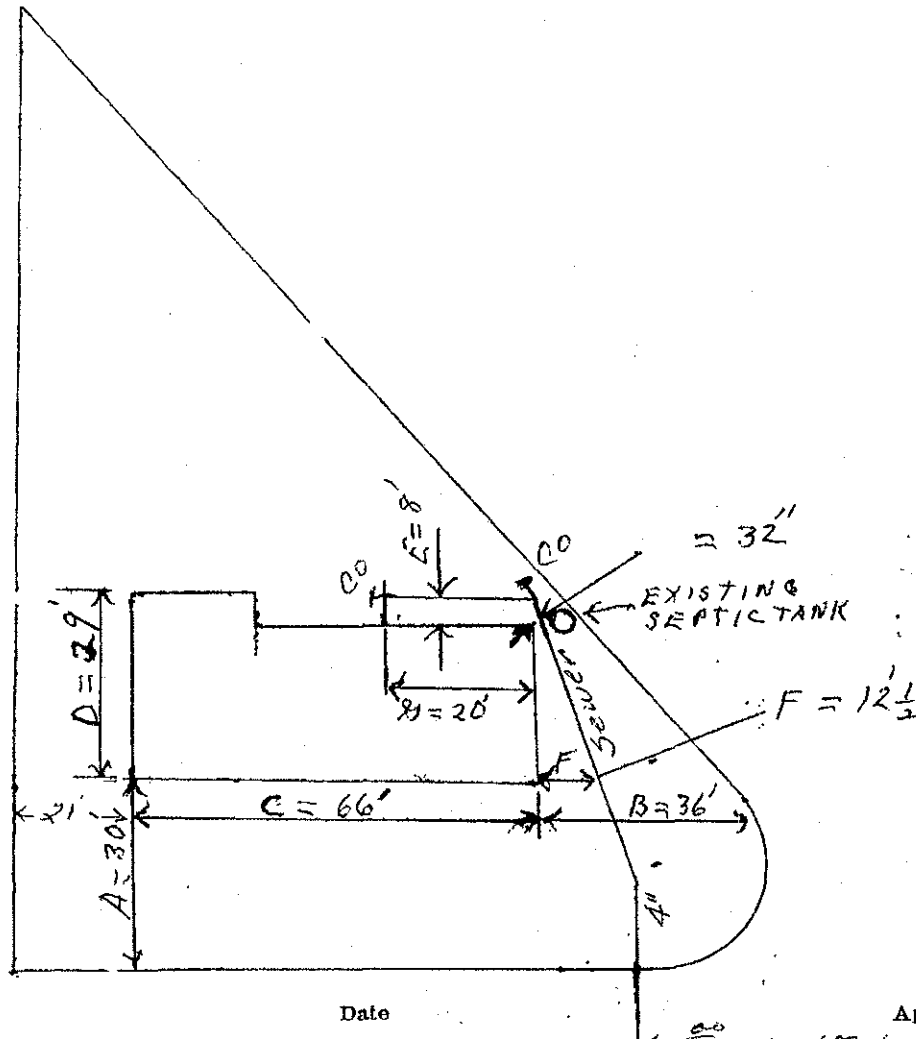

CITY OF
MOUNTLAKE TERRACE

FEB 11 1960

Plan Approved:

BACKFILL WORK ORDER ISSUED _____ DEPOSIT, \$ 10.00 1-15-60
SEWER WORK ORDER ISSUED _____ DATE 2-11-60 BY Scott M. Holton INS & CON