



PLAN	DATE
SURVEYED	BY
NOTED	BY
ADJUSTED	BY
CHECKED	BY
NO	BY

PROFILE	DATE
SURVEYED	BY
NOTED	BY
ADJUSTED	BY
CHECKED	BY
NO	BY

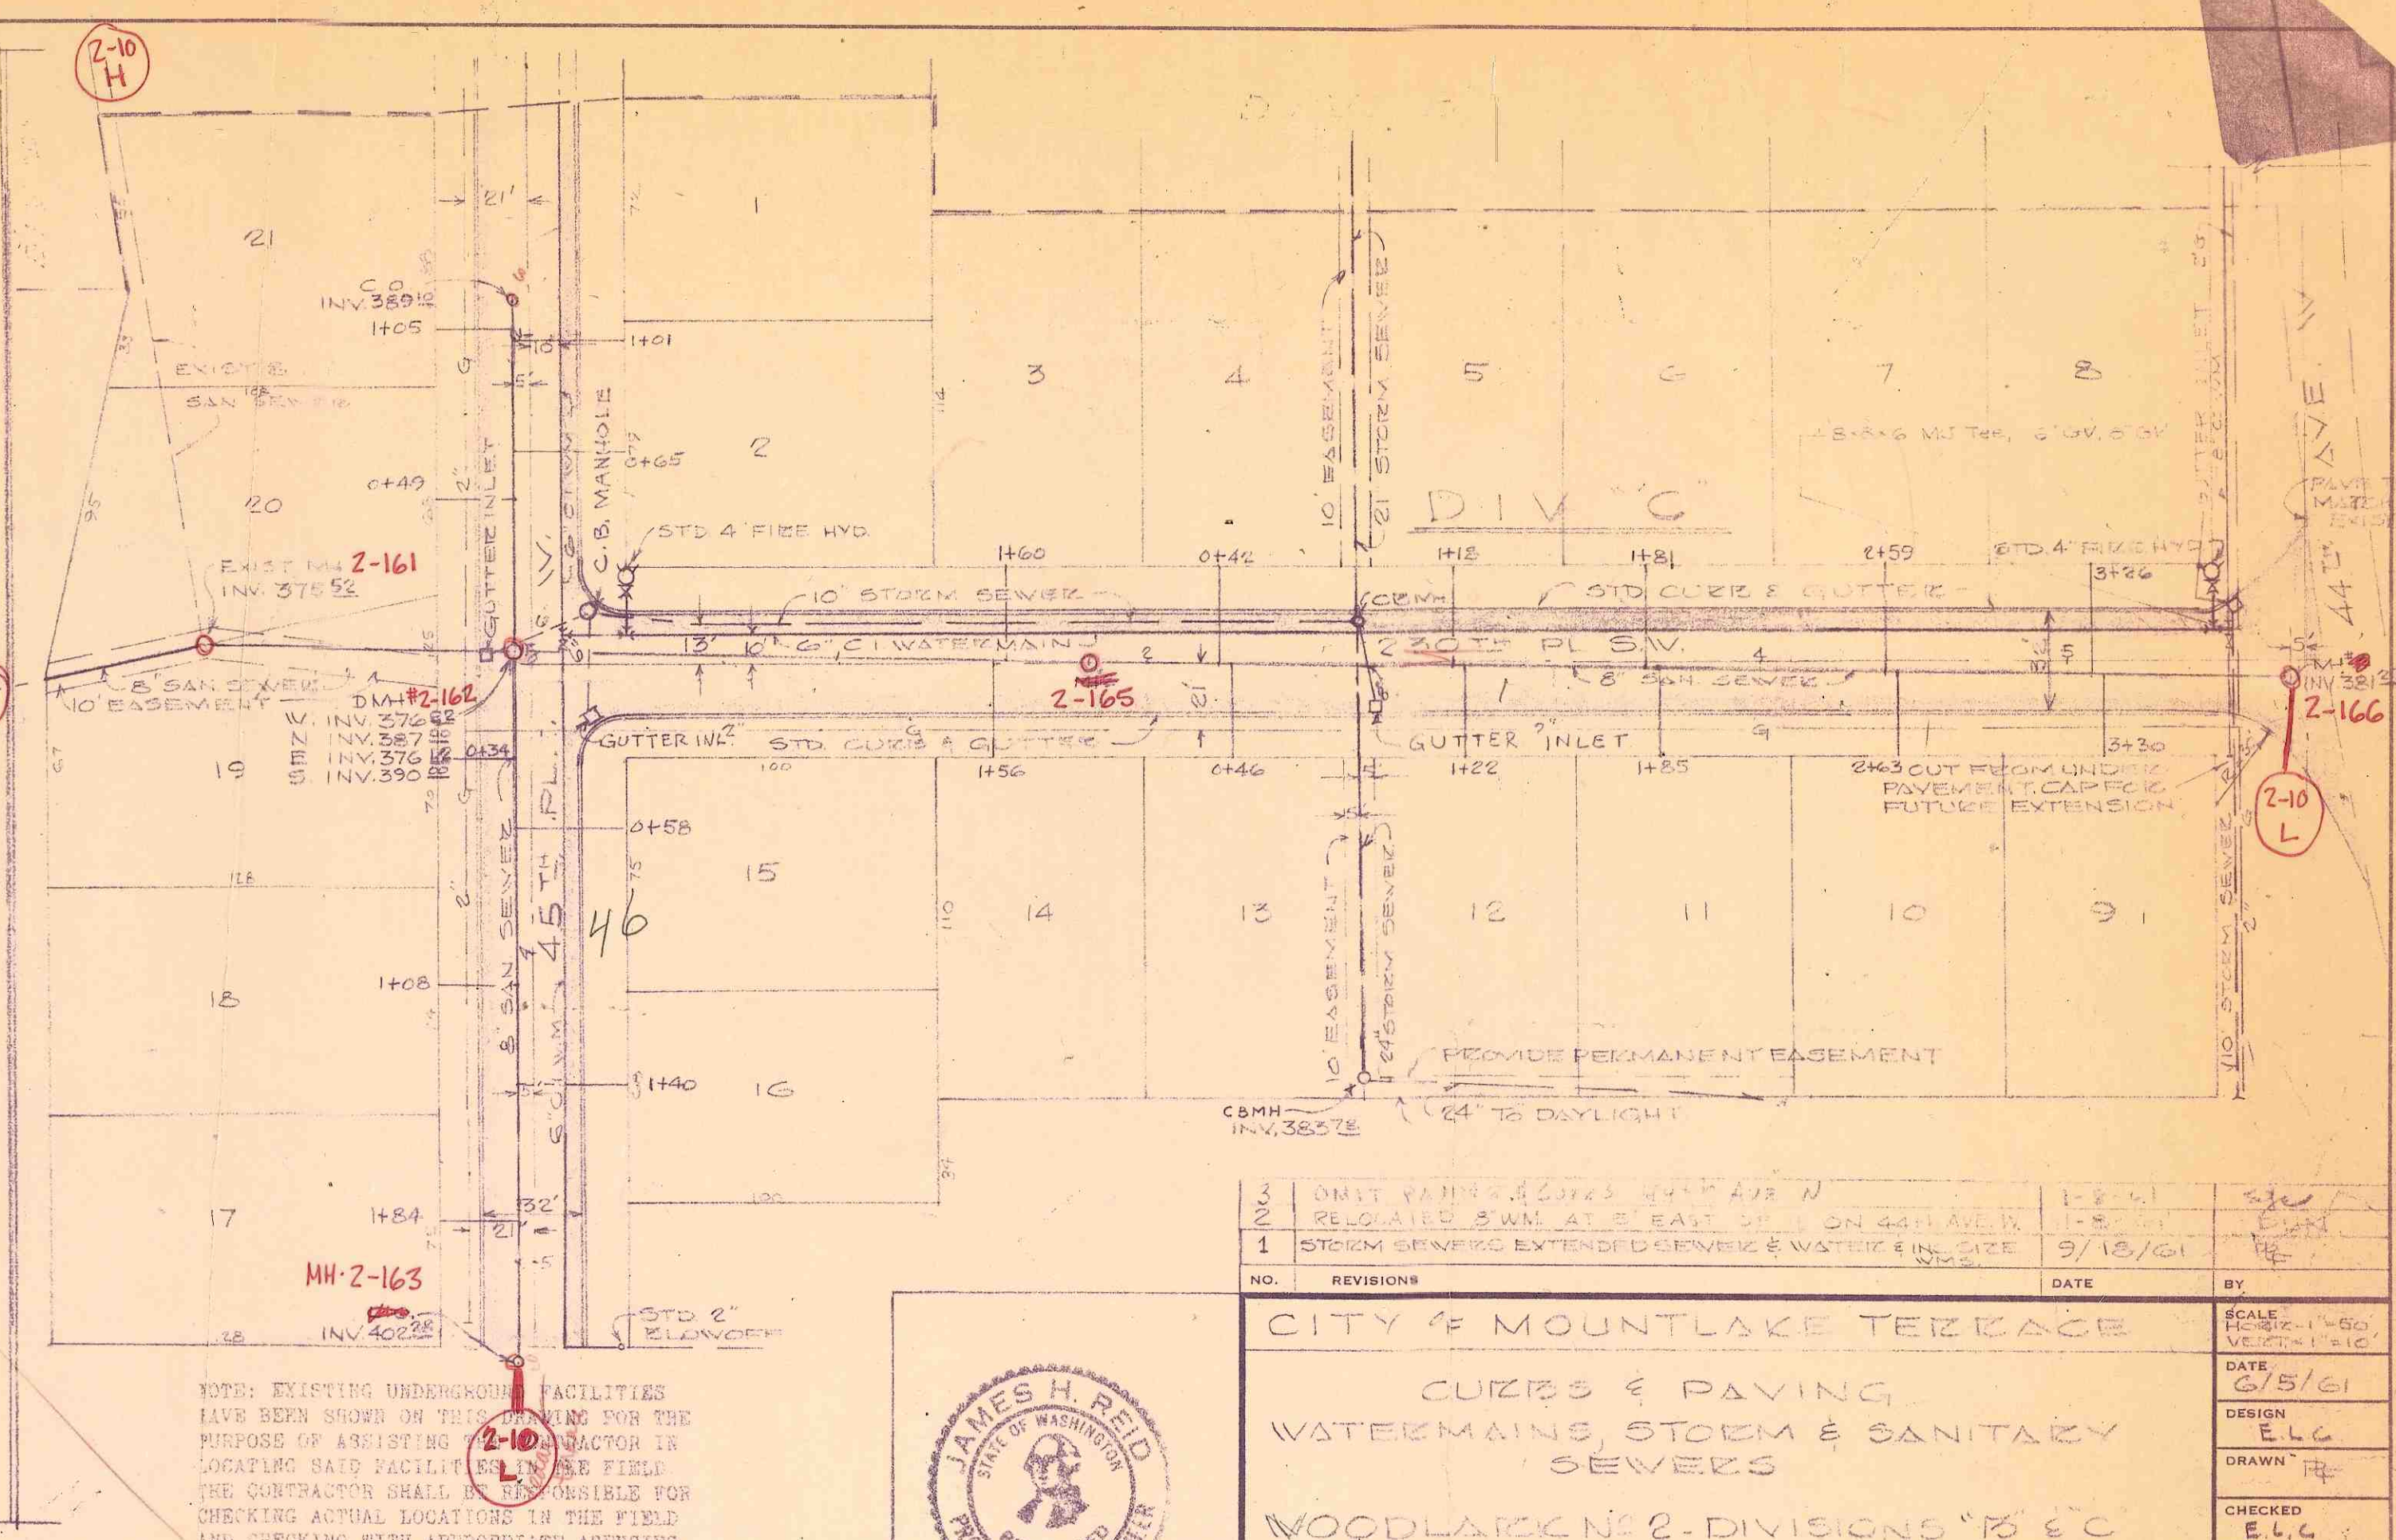

NOTE: EXISTING UNDERGROUND FACILITIES HAVE BEEN SHOWN ON THIS PLAN FOR THE PURPOSE OF ASSISTING THE CONTRACTOR IN LOCATING SAID FACILITIES. THE CONTRACTOR SHALL BE RESPONSIBLE FOR CHECKING ACTUAL LOCATIONS IN THE FIELD AND CHECKING WITH APPROPRIATE AGENCIES THAT MAY HAVE UNDERGROUND FACILITIES WITHIN THE PROJECT LIMITS. THE CONTRACTOR SHALL BE SOLELY RESPONSIBLE FOR ANY DAMAGE TO UNDERGROUND FACILITIES RESULTING FROM THIS PROJECT.

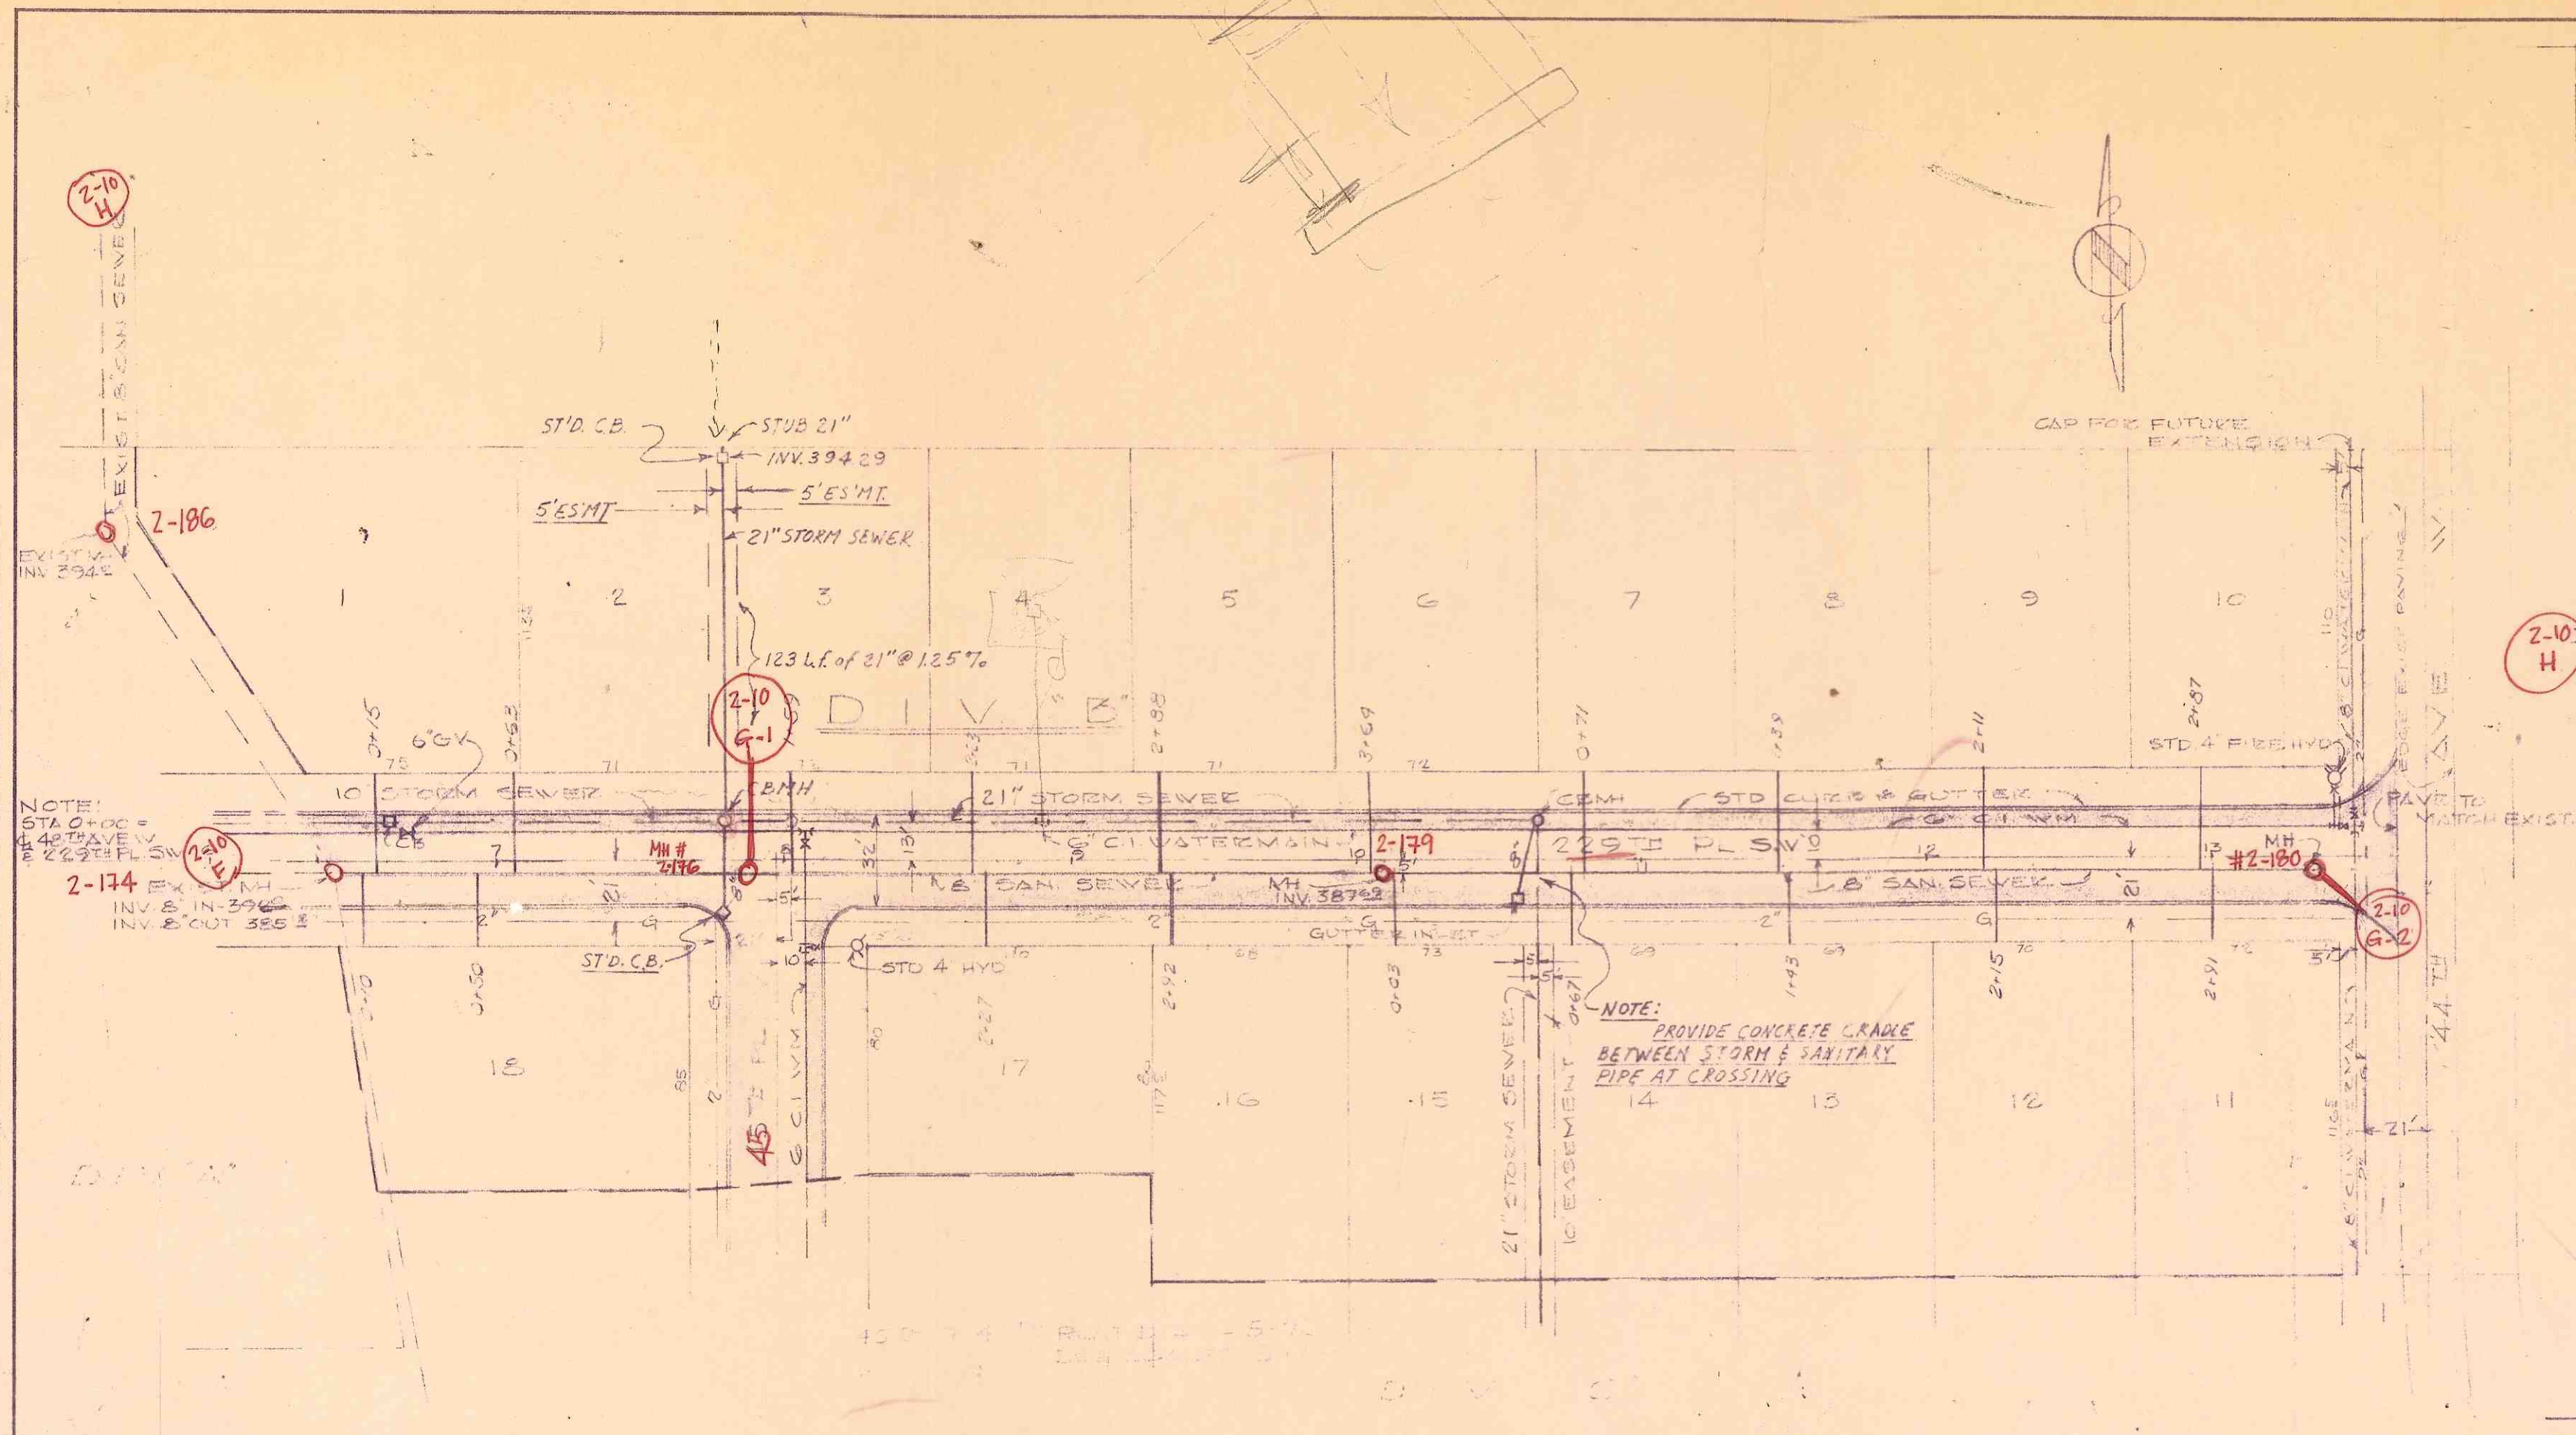

CITY OF MOUNTLAKE TERRACE		DATE	9/15/01
CURBS & PAVING		DESIGN	E.L.G.
WATERMANS, STORM & SANITARY SEWERS		DRAWN	E.L.G.
WOODLAND NO. 2 - DIVISIONS "B" & "C"		CHECKED	E.L.G.
REID, MIDDLETON & ASSOCIATES, INC.		FILE NO.	5.171D
CONSULTING ENGINEERS & LAND SURVEYORS		SHEET	2 OF 2
324 MAIN STREET EDMONDS, WASHINGTON			

Scan Name: scans06298.pdf
Scan Date:

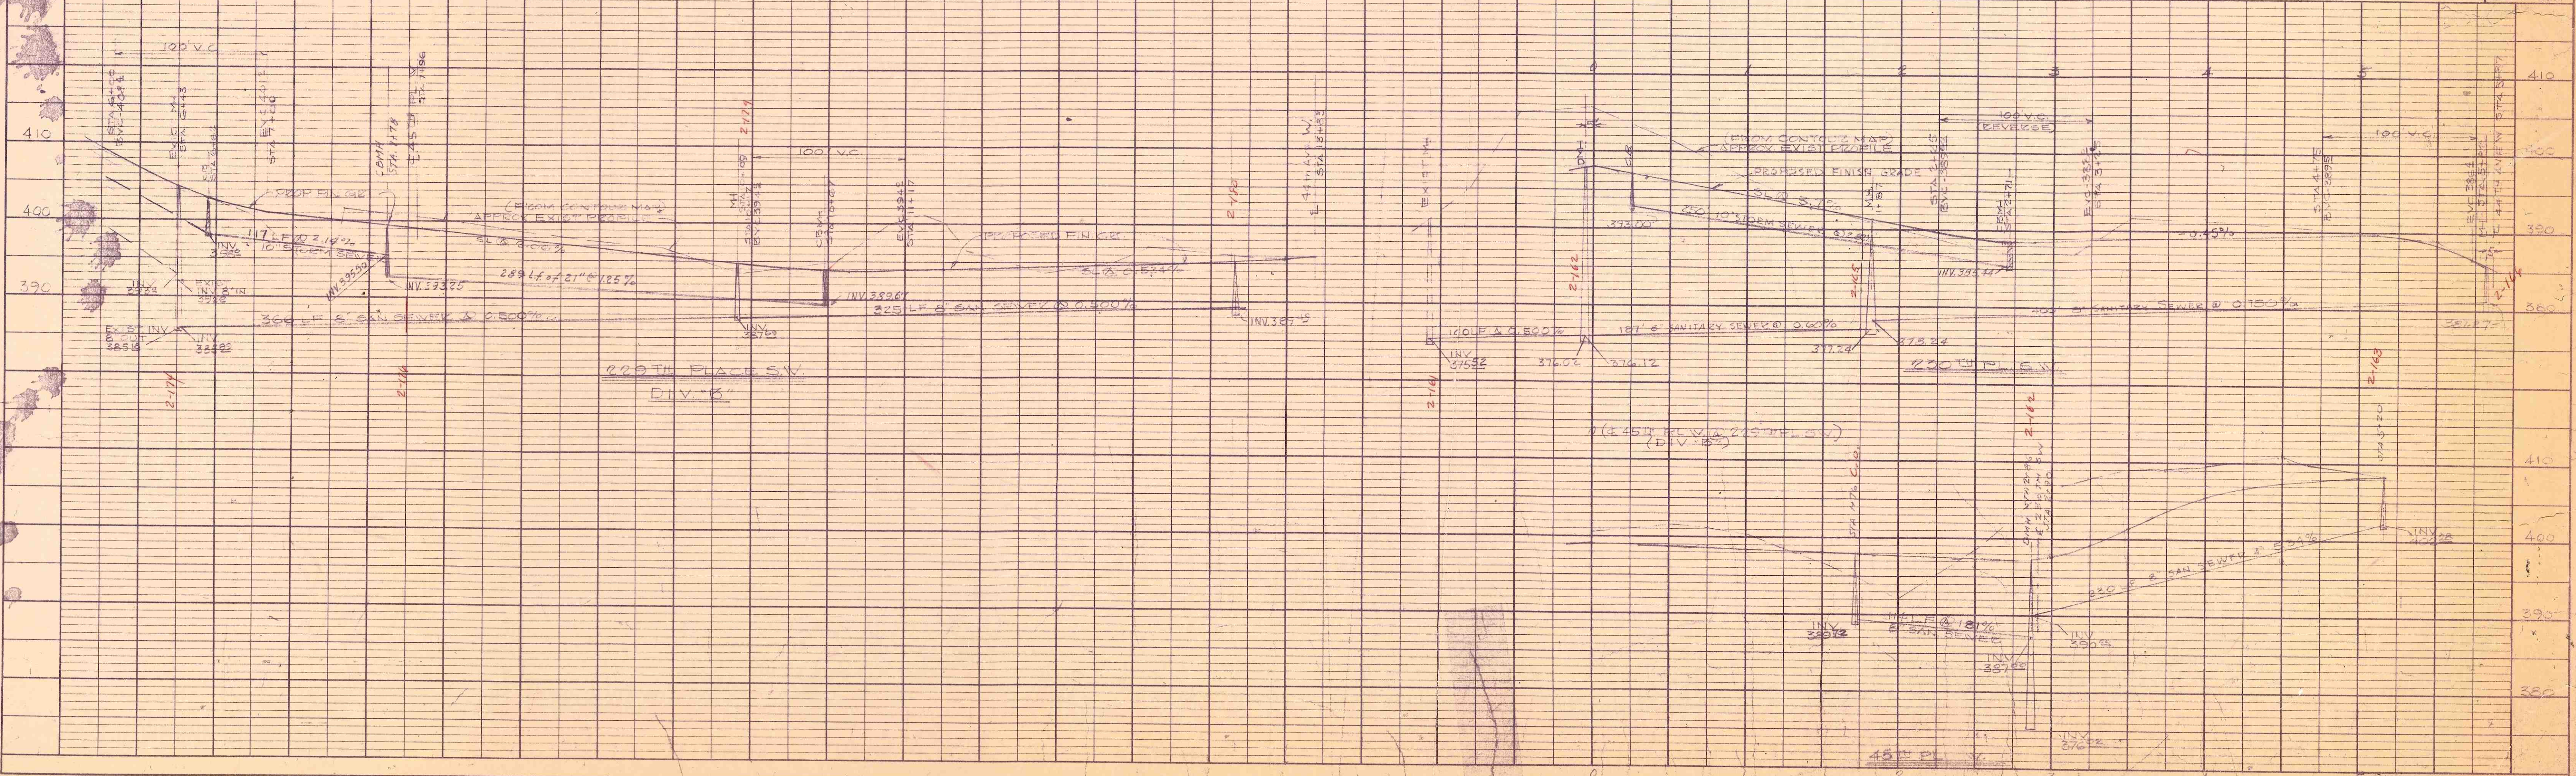


PLATE 1 - PLAN-PROFILE D.P.R. & R.E. STANDARD
100% AGE PROOF VELLUM - MADE AND PRINTED IN U.S.A.
EUGENE DIETZEN CO.

AS BUILT DRAWING
2-10-G