


PLAN	DATE	
	BY	
	SURVEYED	
	NOTE BOOK	

PROFILE	DATE	
	BY	
	SURVEYED	
	NOTE BOOK	

SCALE: 1" = 50'

TBM: 440.04, INV: 216.74 @ 48TH

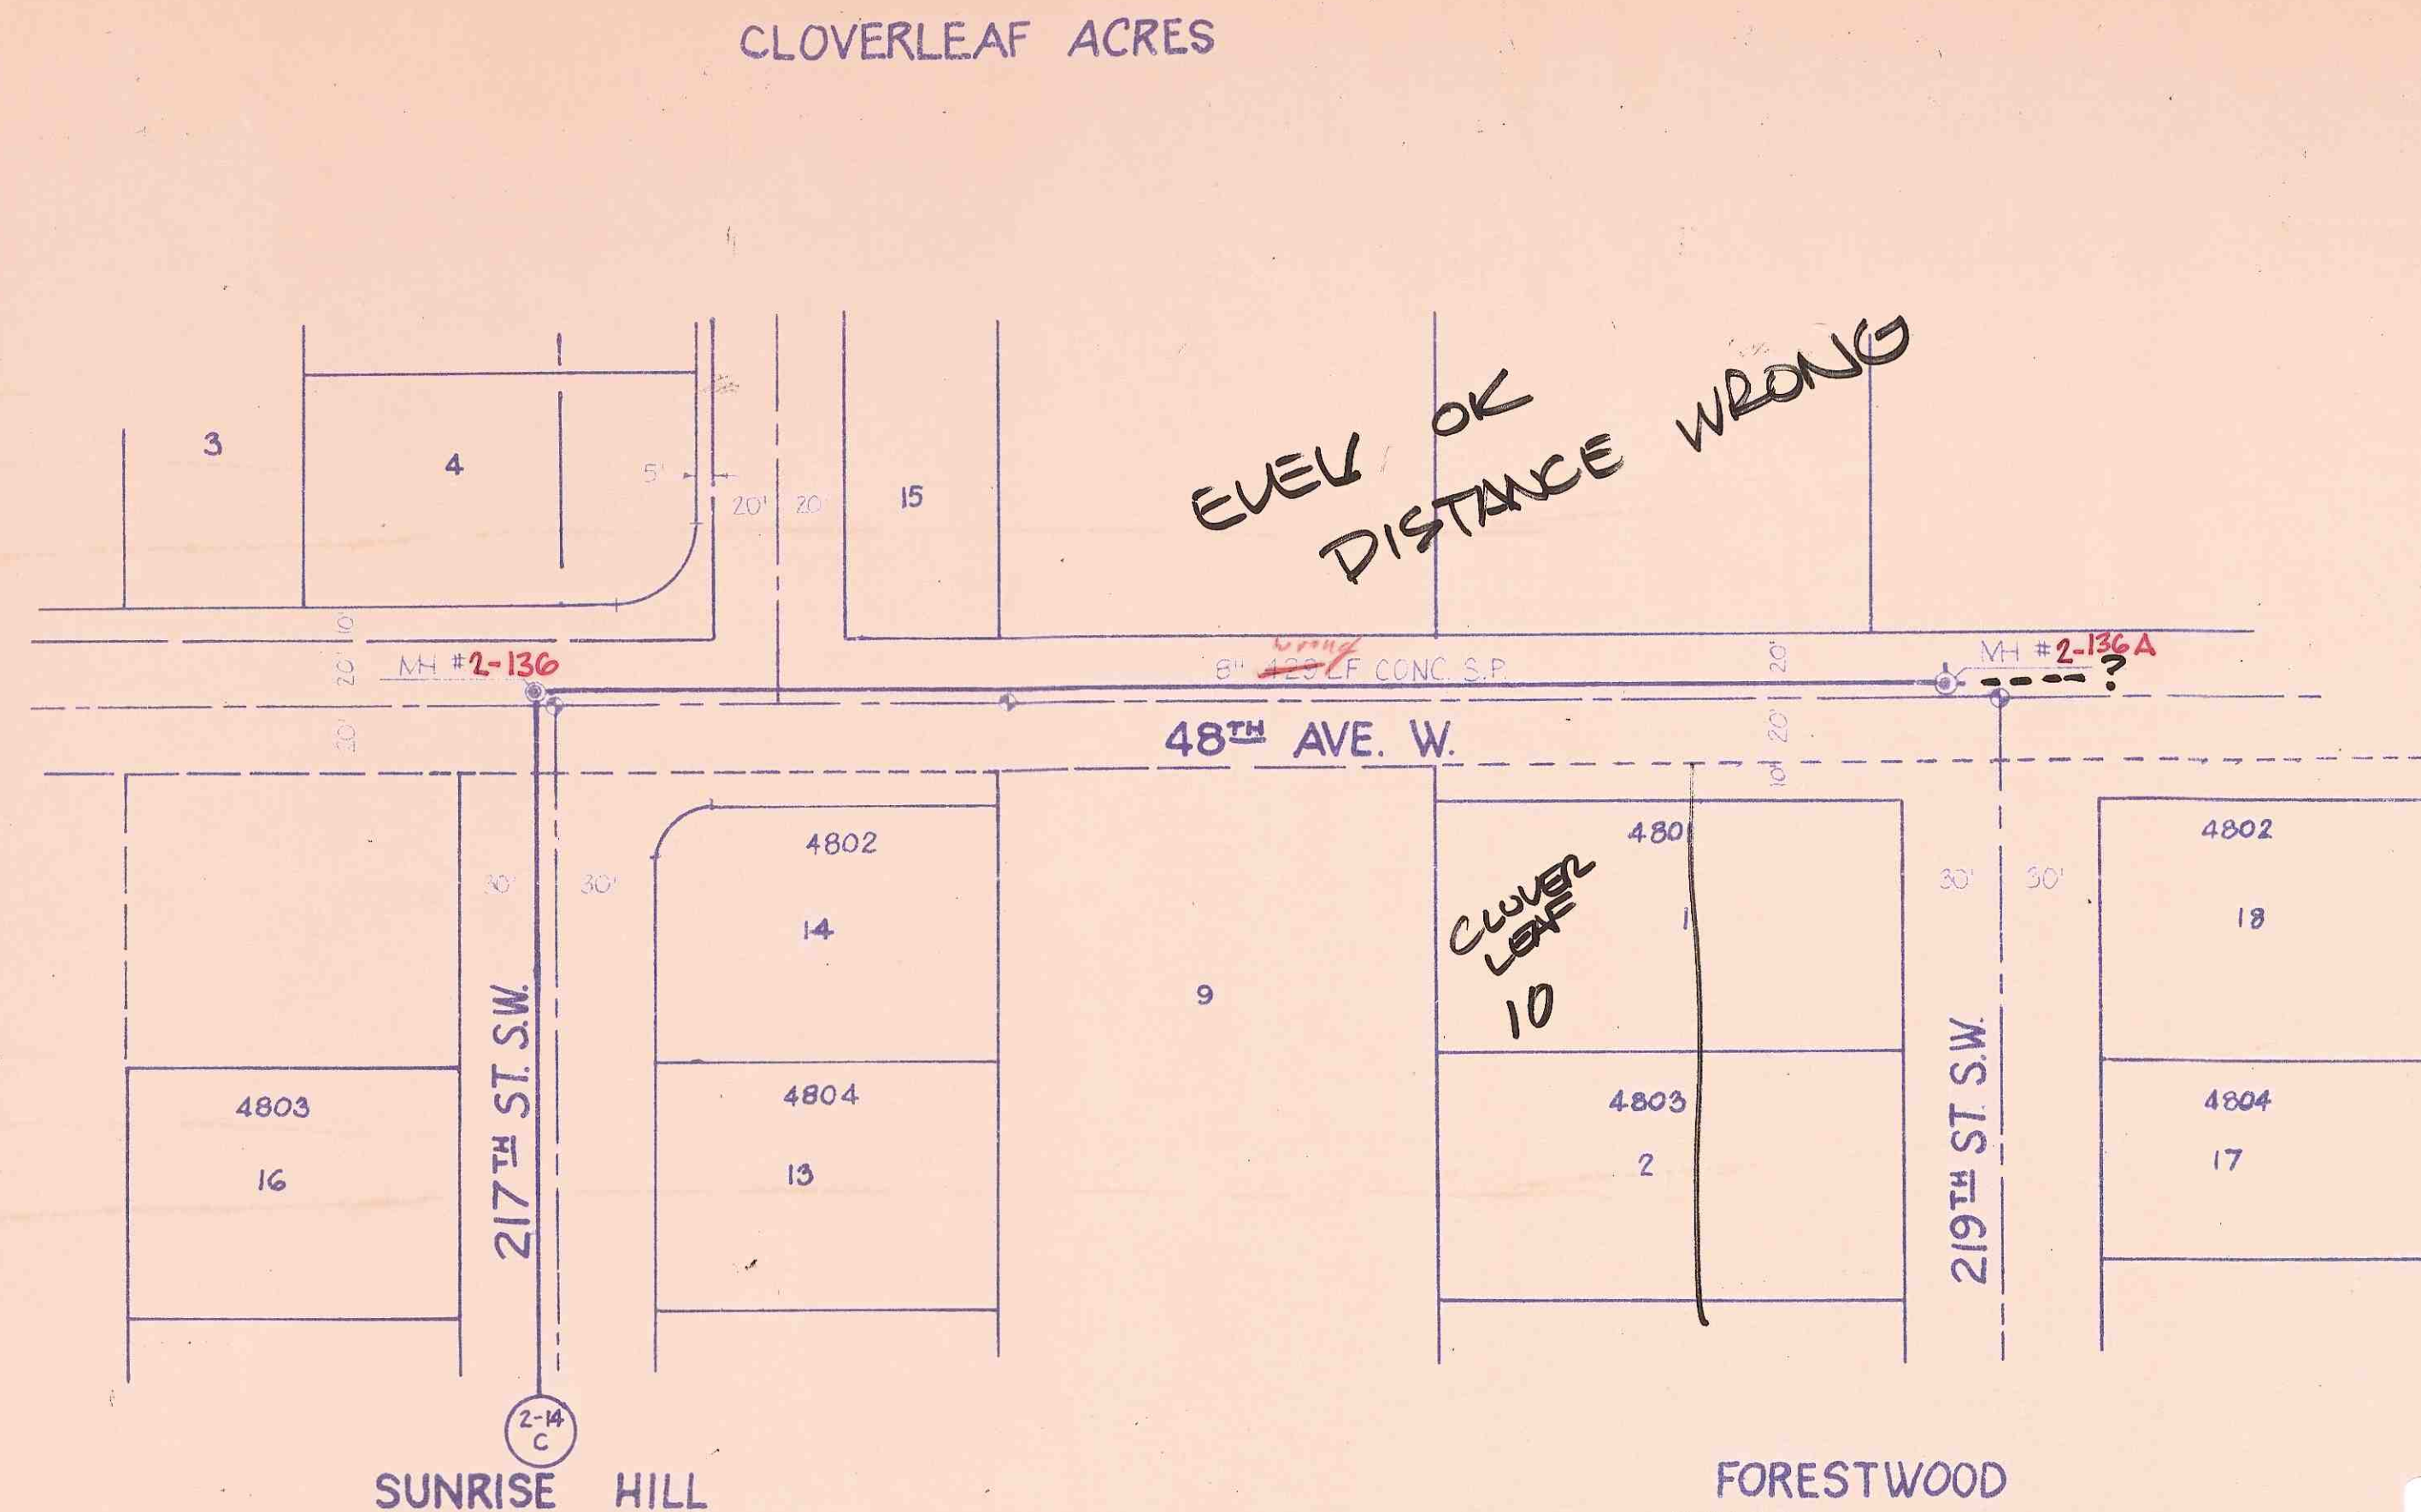

SEWER ASBUILT SURVEY		
CITY OF		
MOUNTLAKE TERRACE		
DRAWN BY <i>Donna Secor</i>	DATE AUG. 9, 1983	SCALE: HOR. 1" = 50' VERT. 1" = 5'
CHECKED BY <i>W. Van Rye</i>		

Scan Name: scans06327.pdf
Scan Date:

