

APPLICATION

CARD No. _____

The City of Mountlake Terrace

SIDE SEWER PERMIT

OUTSIDE ☒ INSIDE ☐ REPAIRS ☐

EASEMENT No. _____

H & H Homes P O Box 644 Lynnwood, Wash 98036

Universal Utility Contractors Inc.

OWNER _____

CONTRACTOR 11/11/ 203rd St N E Woodenville

PERMIT No. 74-18

HOUSE No. 6605


224TH ST SW

STREET

AVENUE LOT No. 8

BLOCK No. _____

NAME ADD Greenridge

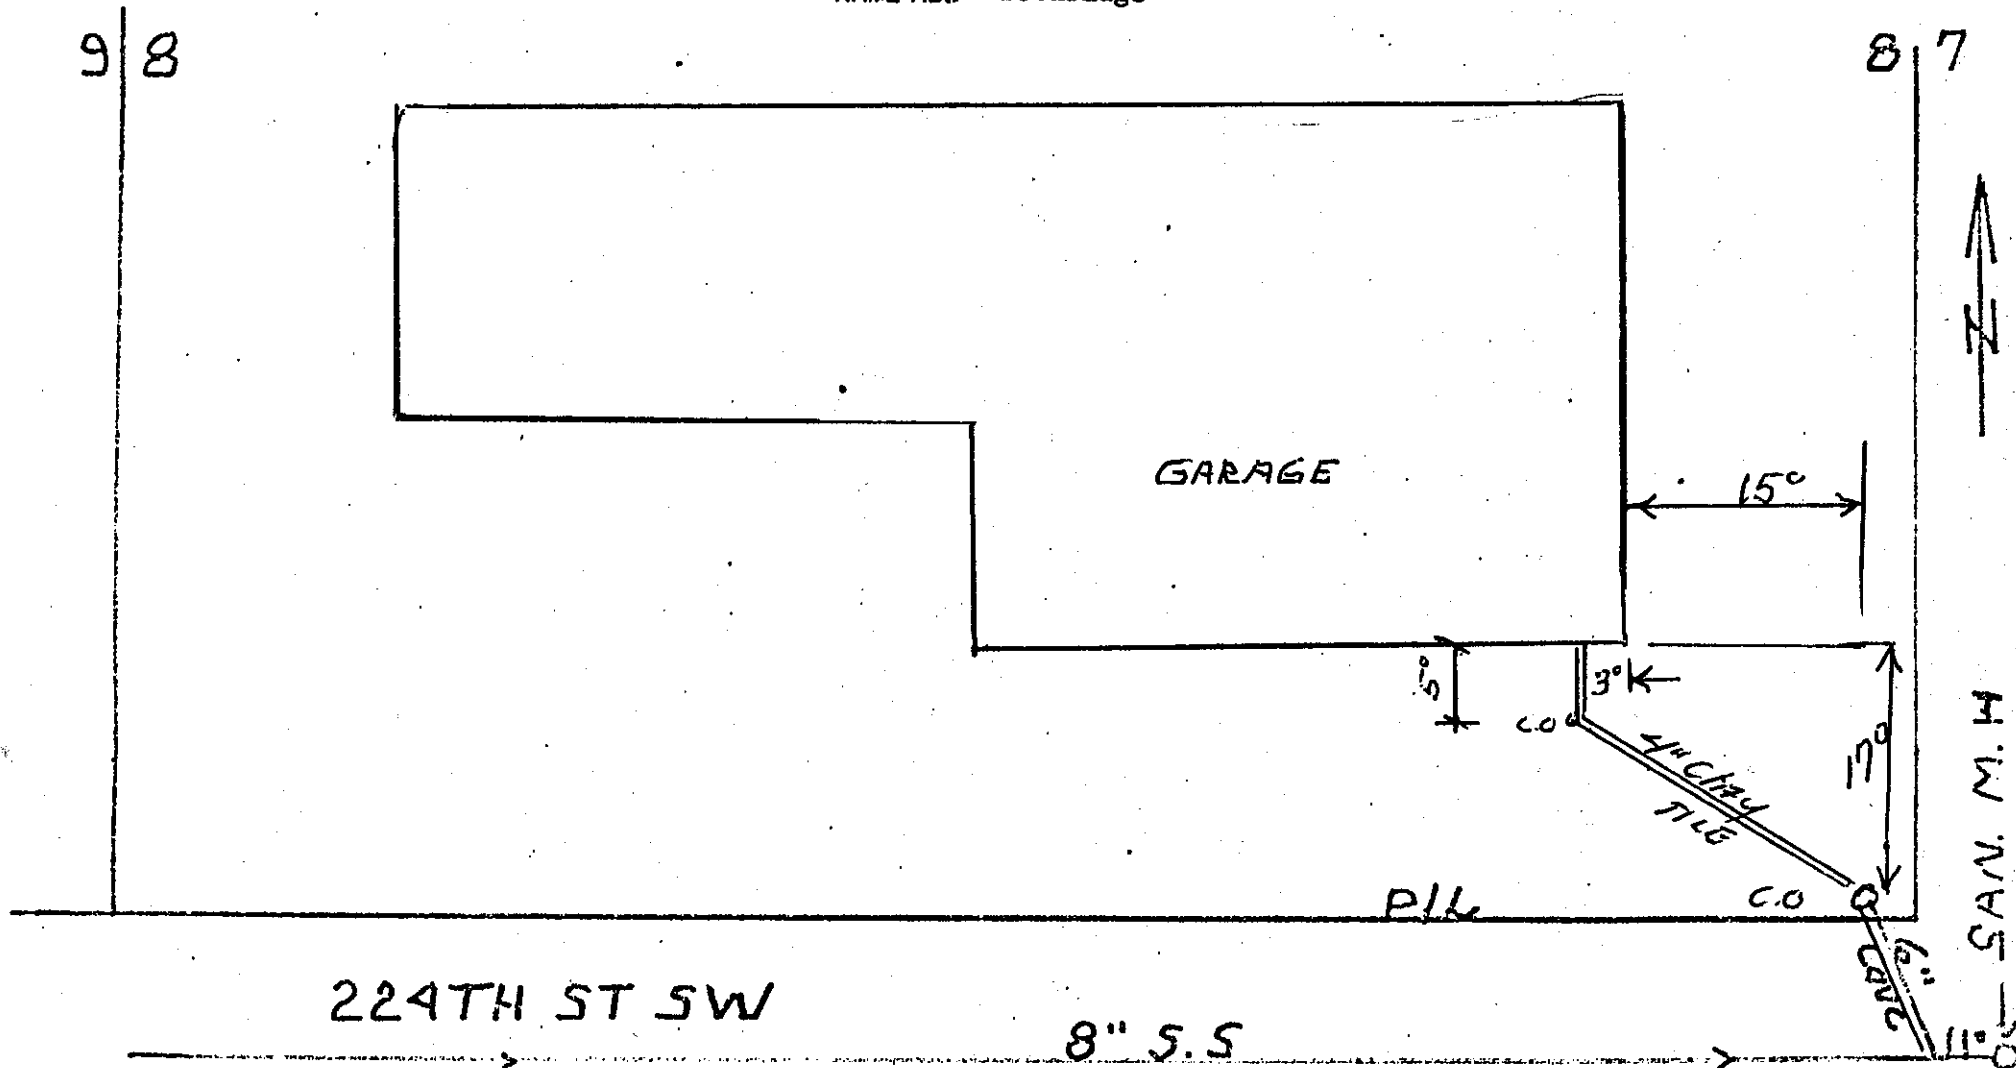

224TH ST SW

8" S.S.

Side Sewer Permit U-8-75 to Lynnwood Septic Tank 2-26-75 issued by Fred H Smith

Date Installation of service side sewer approved 2-26-75 F H Smith

JACKFILL WORK ORDER ISSUED June 14 1974 DEPOSIT, \$ _____

June 20, 1974

SEWER WORK ORDER ISSUED May 16 1974

DATE _____

BY

Fred H. Smith