

The City of Mountlake Terrace

APPLICATION

for

SIDE SEWER PERMIT

OUTSIDE ☐ INSIDE ☐ REPAIRS ☐


CARD No. _____

EASEMENT No. _____

OWNER Nord Home's CONTRACTOR Lynnwood Septic Tank Co. PERMIT No. 4084

HOUSE No. 5505 - 214 pl SW STREET 19 AVENUE LOT No. 19 BLOCK No. _____

NAME ADD. _____

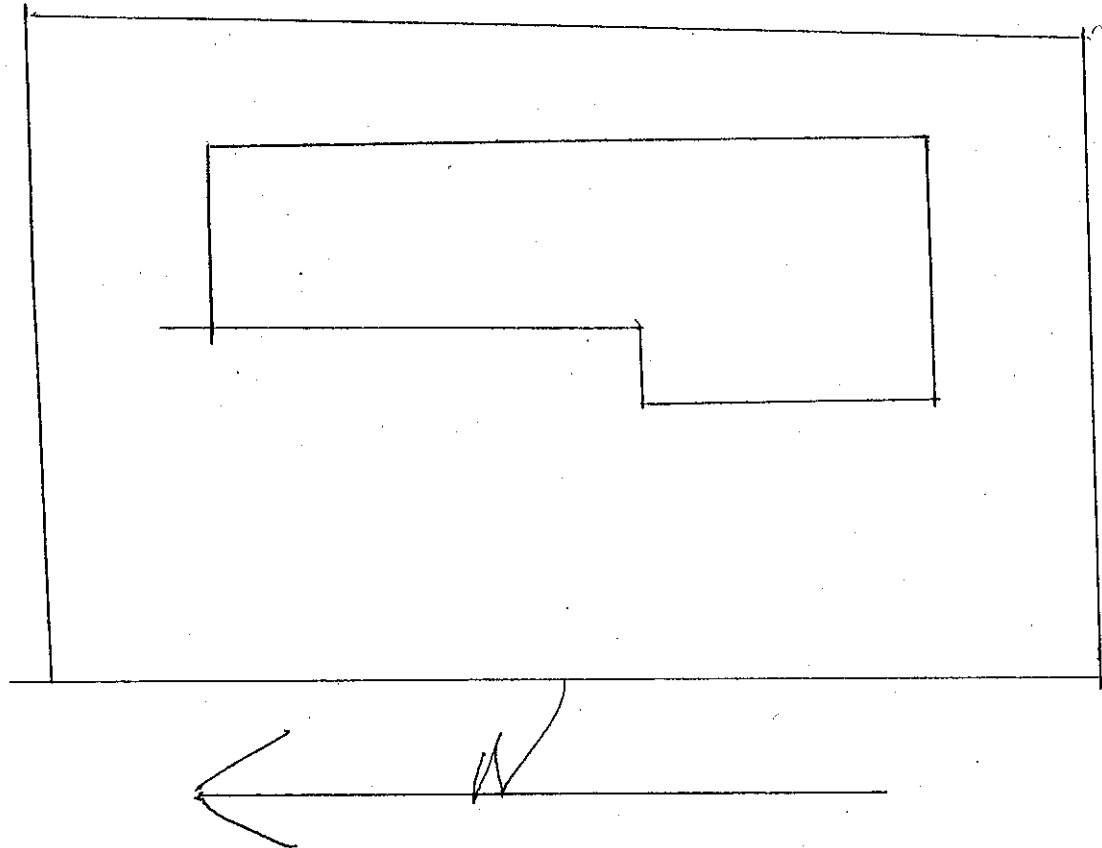

Date

Approved:

BACKFILL WORK ORDER ISSUED _____ DEPOSIT, \$ 10 -

SEWER WORK ORDER ISSUED _____

DATE _____ BY _____

10 -
Joe