

# APPLICATION

for

CARD No. \_\_\_\_\_


The City of Mountlake Terrace

UNIFORM SIDE SEWER PERMIT

OUTSIDE ☐ INSIDE ☐ REPAIRS ☐

EASEMENT No. \_\_\_\_\_

OWNER Jim Hellerstedt CONTRACTOR North End Septic Tank PERMIT No. \_\_\_\_\_  
 HOUSE No. 22310-39 Ave W. STREET \_\_\_\_\_  
 AVENUE LOT No. Lot 2 BLOCK No. A  
 NAME ADD. Cedar Grove # 2

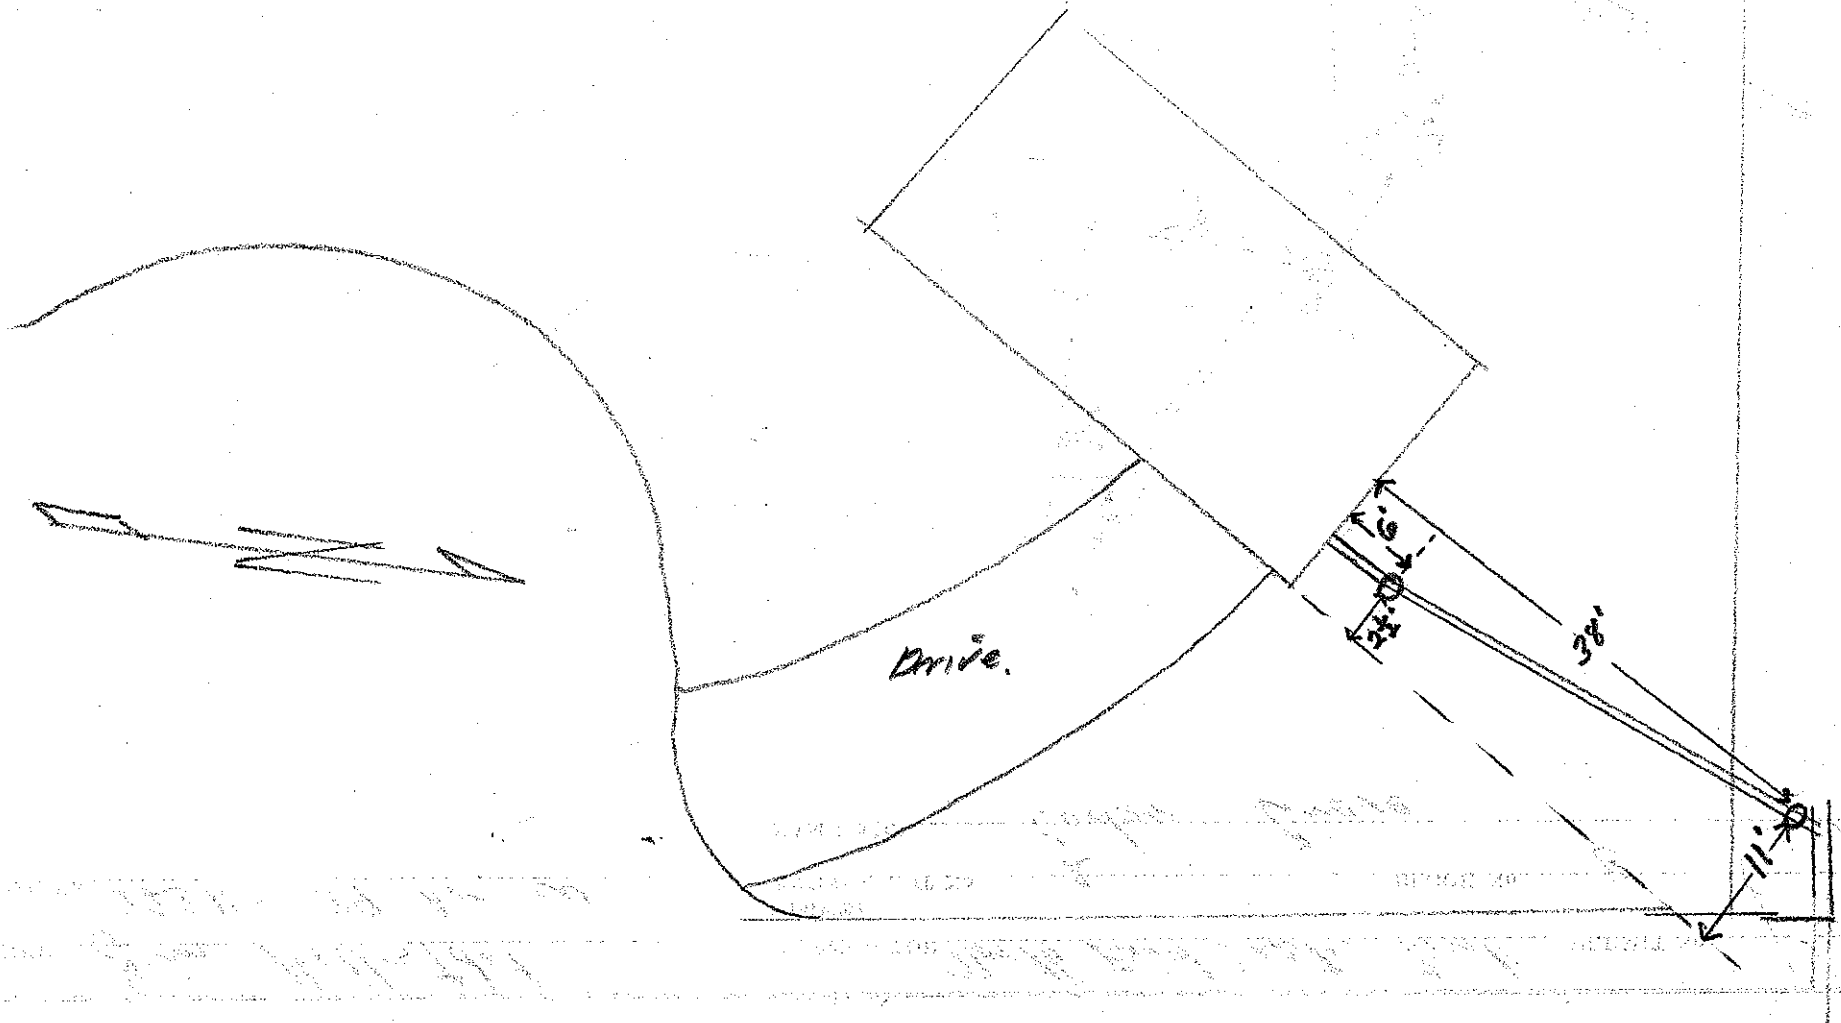

Date \_\_\_\_\_ Approved: \_\_\_\_\_  
 BACKFILL WORK ORDER ISSUED \_\_\_\_\_ DEPOSIT, \$ \_\_\_\_\_  
 SEWER WORK ORDER ISSUED \_\_\_\_\_ DATE \_\_\_\_\_ BY \_\_\_\_\_

UNIFORM