


W 1/2 of SE 1/4, NW 1/4, NW 1/4 SEC. 27, T. 27 N., R. 4 E., W.M.

**HARMSEN &
ASSOCIATES INC.**
ENGINEERS SURVEYORS PLANNERS
17614 - 182ND ST. SE
POST OFFICE BOX 516
MONROE, WA 98272-0516
360-794-7811
206-343-5903
360-794-9087 (FAX)

RECORD DRAWING

AS-BUILT RECORD DRAWING
PREPARED BY HARMSEN AND
ASSOCIATES, INC., MONROE
WASHINGTON 3/18/03
FIELD WORK COMPLETED 2/28/03
AND RECORDED IN FIELD BOOK #721/746
ITEMS NOT MARKED ARE UNCHANGED
OR COULD NOT BE VERIFIED IN THE
AS-BUILT SURVEY.

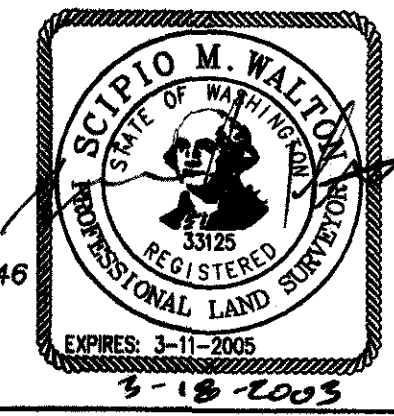


NOTES

1. ALL PIPE SHALL BE SDR-35 PVC UNLESS OTHERWISE SHOWN.
2. ALL MANHOLES PER STD. PLAN #305.
3. CLEANOUTS PER STD. PLAN #303.

VERTICAL DATUM: CITY OF MOUNTLAKE TERRACE

TBM DESCRIPTION: TOP OF SW BONNET BOLT ON EX. HYDRANT ON THE NORTH SIDE OF 214TH STREET SW, 20 FEET EAST OF SITE. ELEV. = 409.85'

TO OBTAIN AN ELEV. FOR THE SITE BENCH MARK BASED ON THE CITY'S 1991 SECOND ORDER VERTICAL DATUM LIST, #44-34, PAGE 13, THE SITE BENCH MARK WOULD BE CORRECTED BY -0.80' WITH AN ELEV. OF 409.05

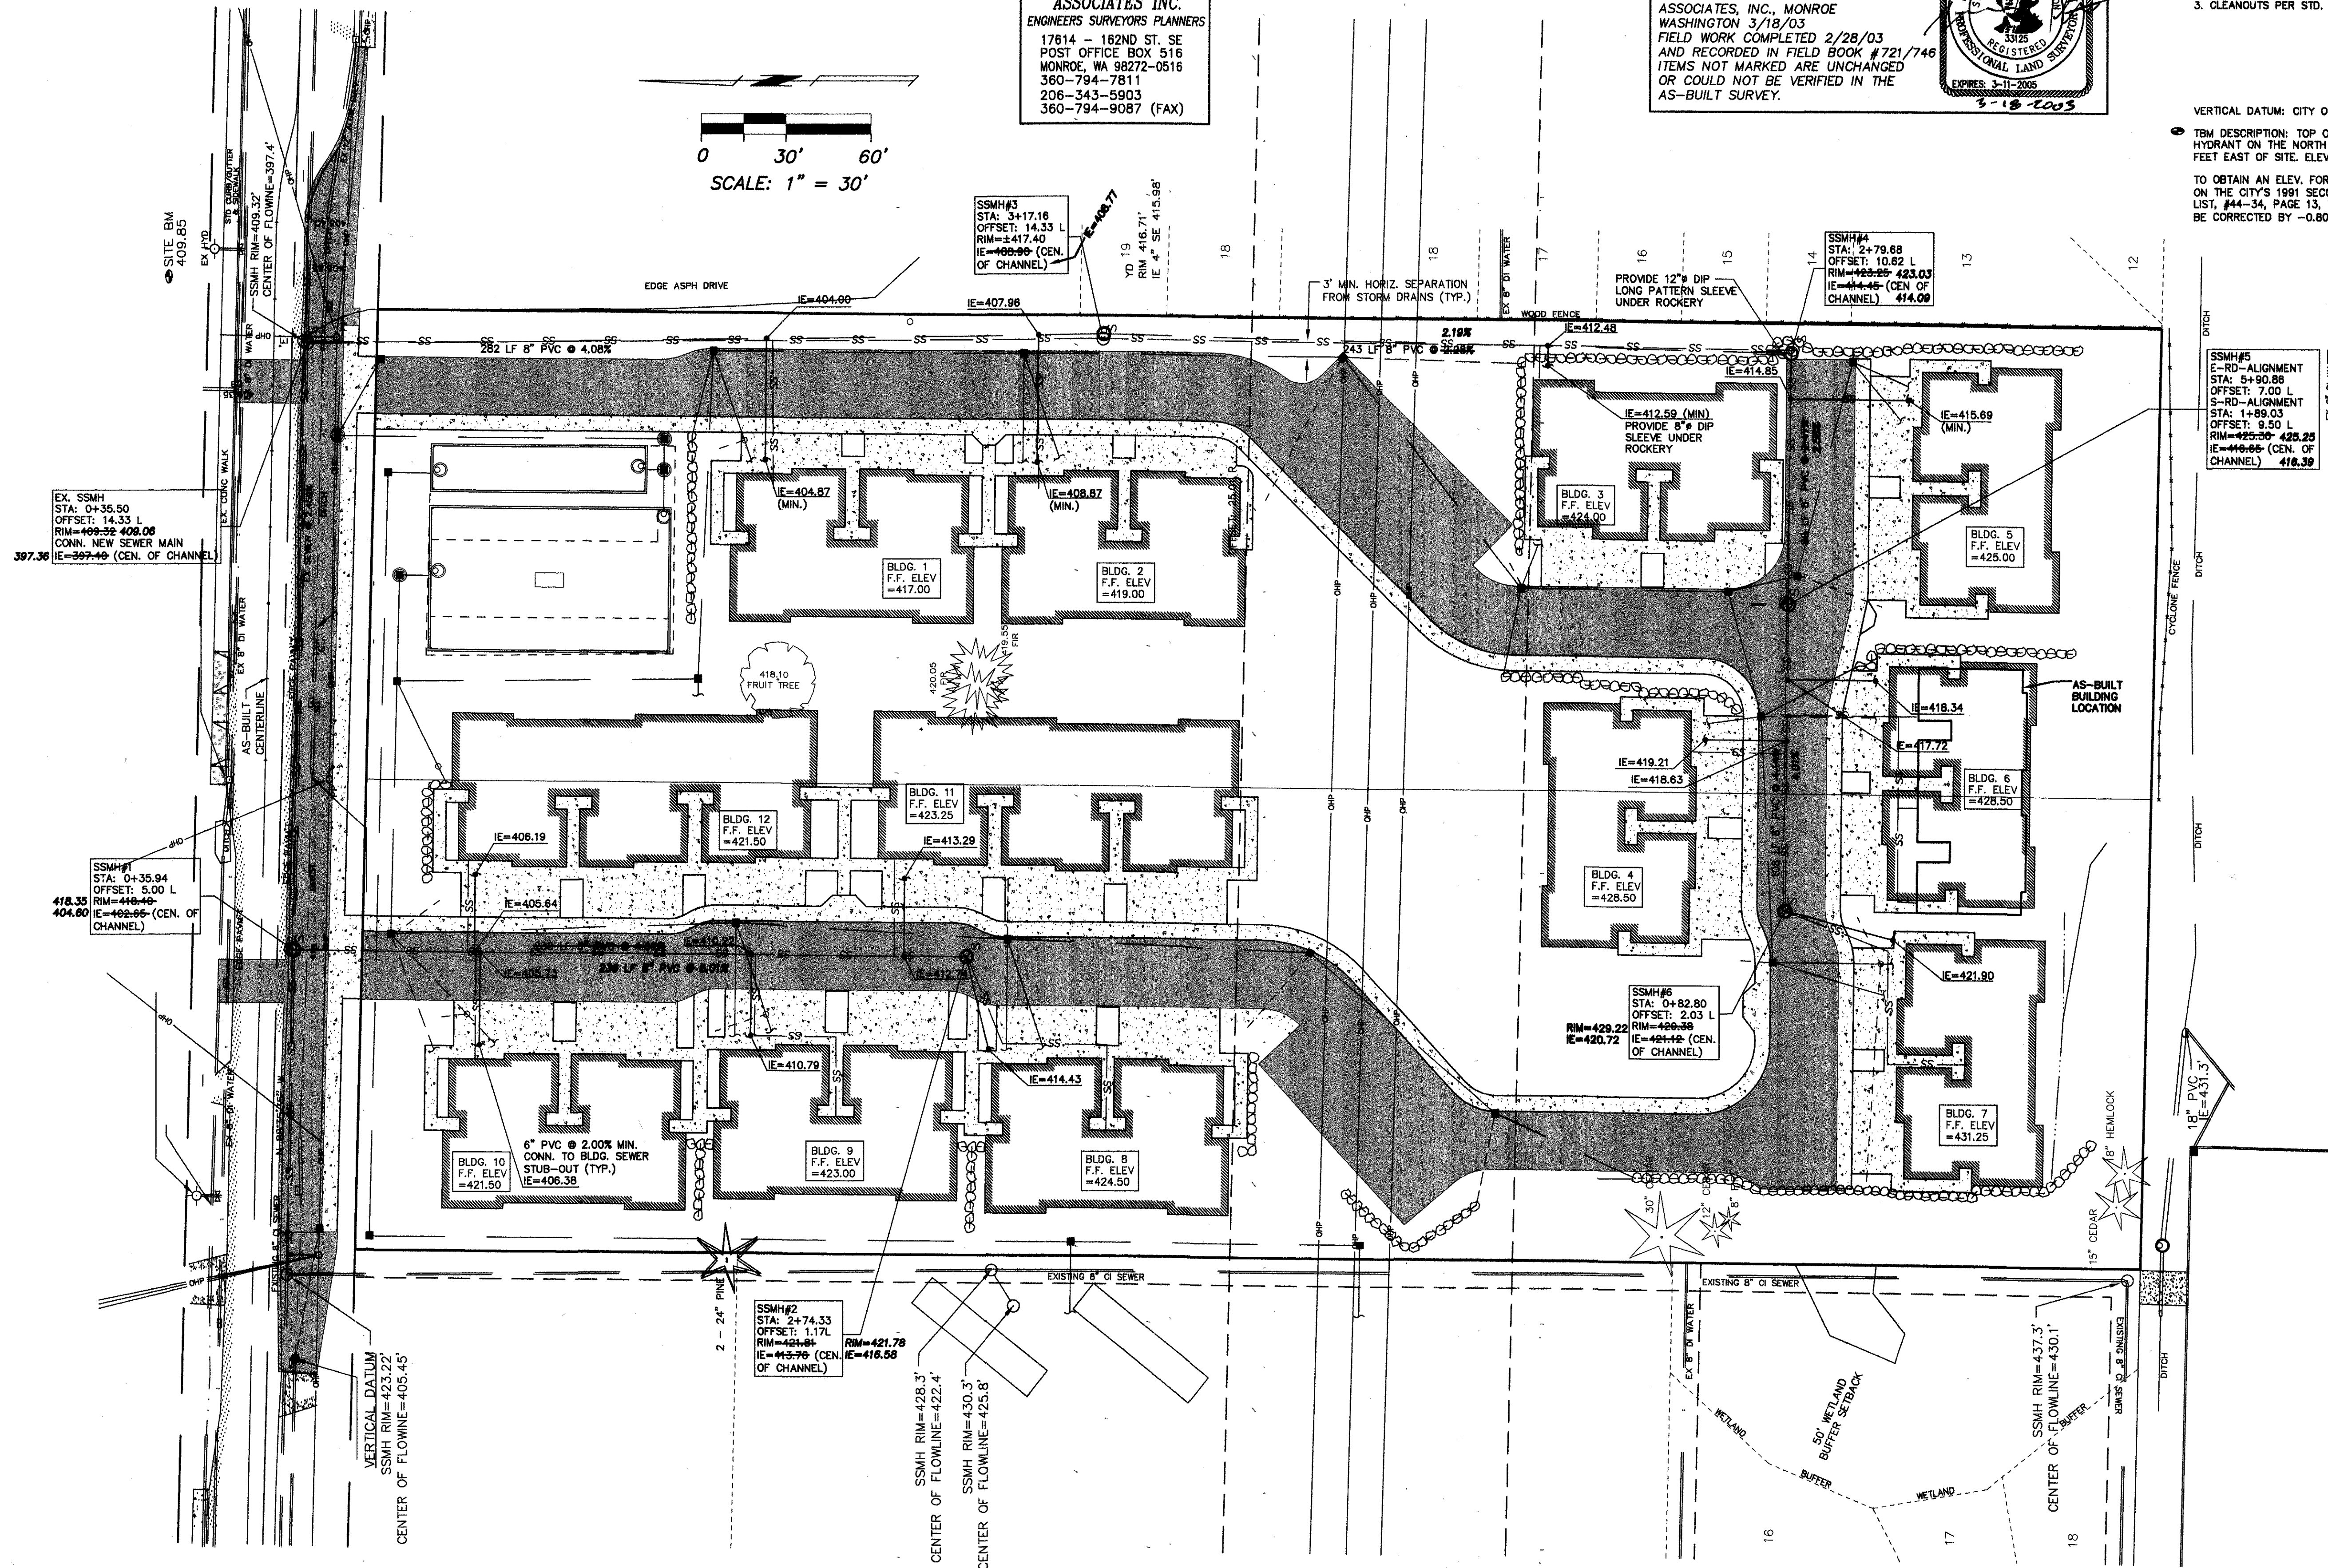

NO.	DATE	BY	APP.	REVISION
1	11/20/03	SP		1.0 CITY COMMENTS
2	12-17-03	AW		2.0 CITY COMMENTS
3	12-21-03	AW		3.0 CITY COMMENTS
4				
5				
6				
7				
8				

KARL BEST & BILL YOUNG
P.O. BOX 1790
SNOHOMISH, WASHINGTON 98290
425-397-0739

BEST/YOUNG TOWNHOUSE VENTURE
SANITARY SEWER PLAN
MOUNTLAKE TERRACE, WASHINGTON

DRS D.R. STRONG Consulting Engineers Inc.
10604 NE 38th PLACE, SUITE 101 KIRKLAND, WA 98033
(425) 827-3063
1-800-862-1402
FAX NO: (425) 827-2423
ENGINEERS • PLANNERS • SURVEYORS

DRAWN **WJS** DATE 10-26-01 SCALE AS SHOWN SHEET C10 OF 12
CHECKED **LJR**