


PROFILE		BY	DATE	DATE		PAGE	
SURVIVED		<i>2/2/57</i>	<i>2/2/57</i>	<i>1116</i>	<i>2-6-57</i>	<i>IMAGING</i>	
PLOTTED		<i>2/2</i>	<i>2/2/57</i>				
GRADES CHECKED				<i>OUTER CORE</i>	<i>2-6-57</i>		
				<i>Sheet first - last</i>	<i>2-6-57</i>		
				<i>SECTION</i>	<i>2-6-57</i>		
NO. OF SECTION NOTATIONS CHECKED				<i>2-6-57</i>	<i>2-6-57</i>		

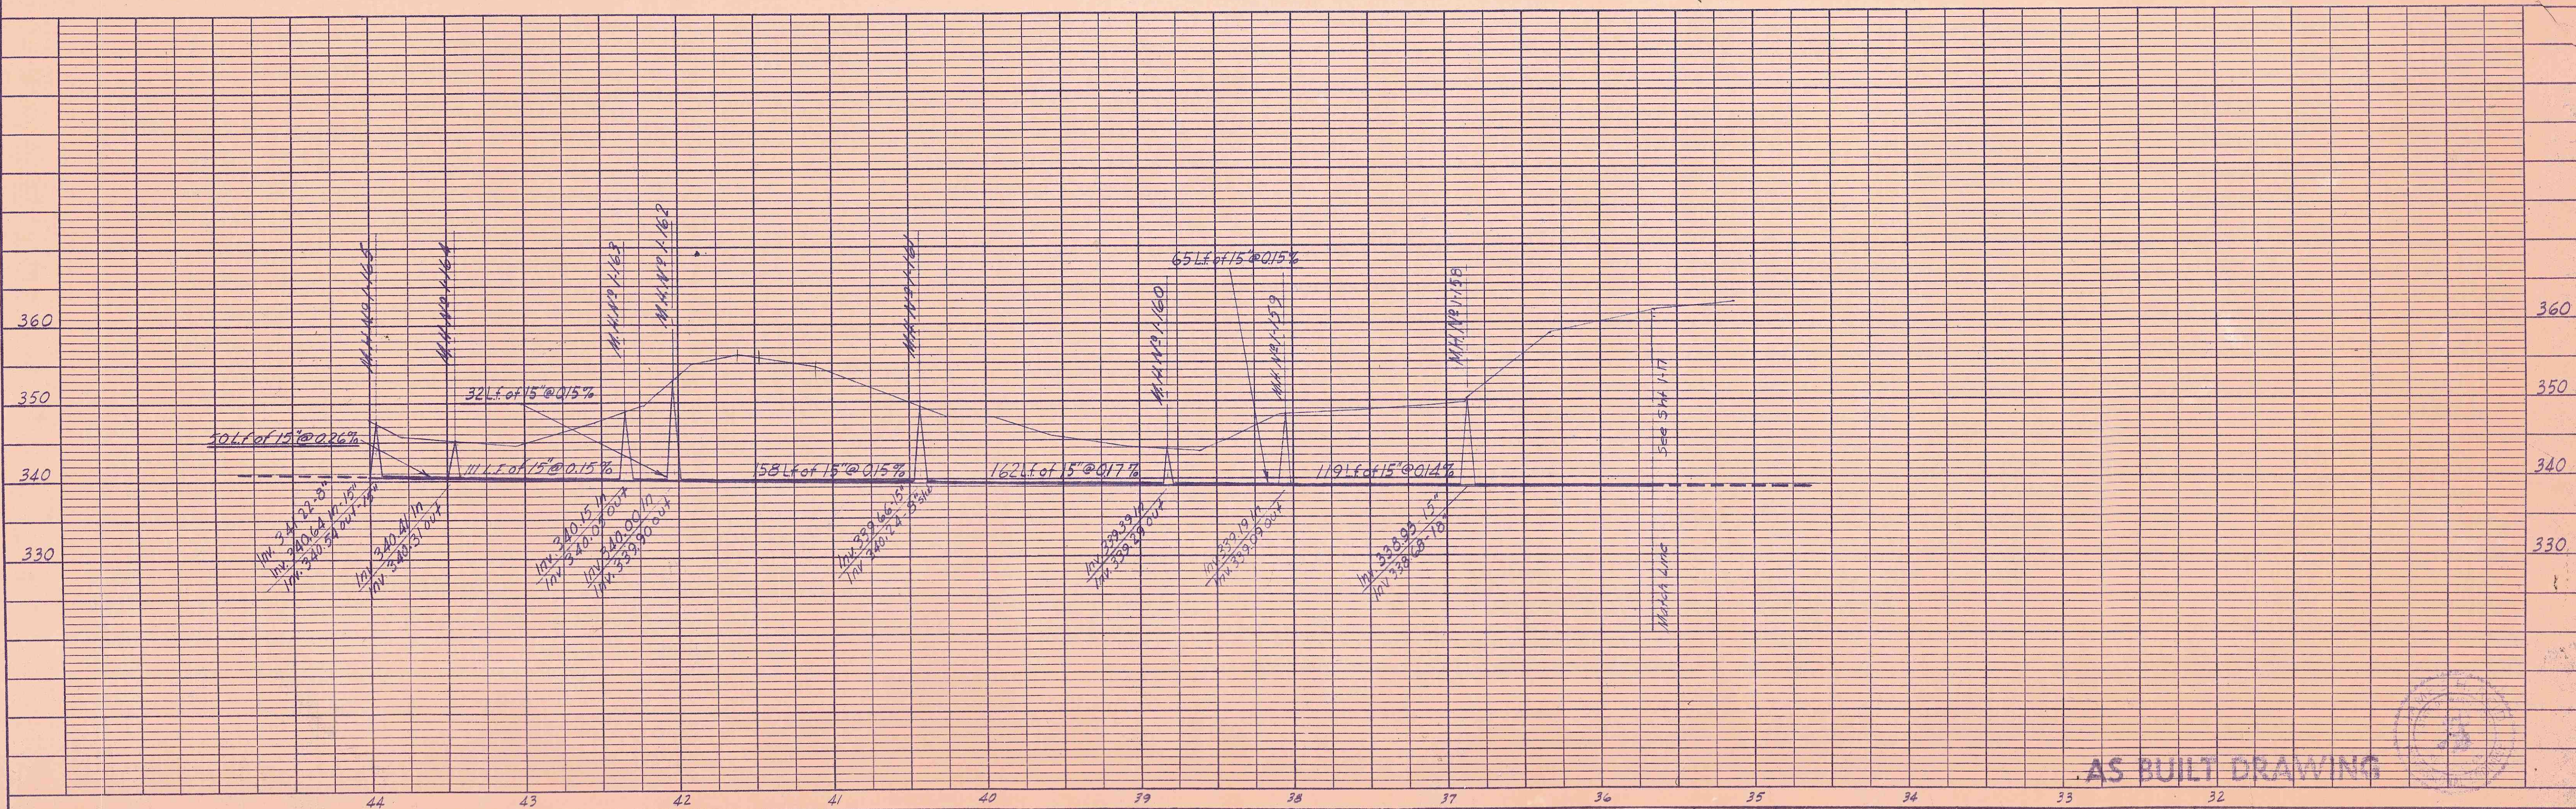

AS BUILT DRAWING

JAMES H. REID & ASSOCIATES
CONSULTING ENGINEERS, 324 MAIN ST., EDMONDS, WASH.

DESIGN L.N.	DRAWN D.P.	CHECKED L.N.	DATE 3-30-59	H. SCALE 1"=50'	FILE NO. 5.50/1-18
				V. SCALE 1"=10'	SHEET 18 OF 26

CITY OF MOUNTLAKE TERRACE
SEWERAGE SYSTEM UNIT