


PROFILE		BY	DATE
NOTE BOOK	SURVEYED _____		
	PLOTTED _____		
	GRADES CHECKED _____		
	B. Ms. NOTED _____		
NO. _____	STRUCTURE NOTATIONS CH'KD _____		

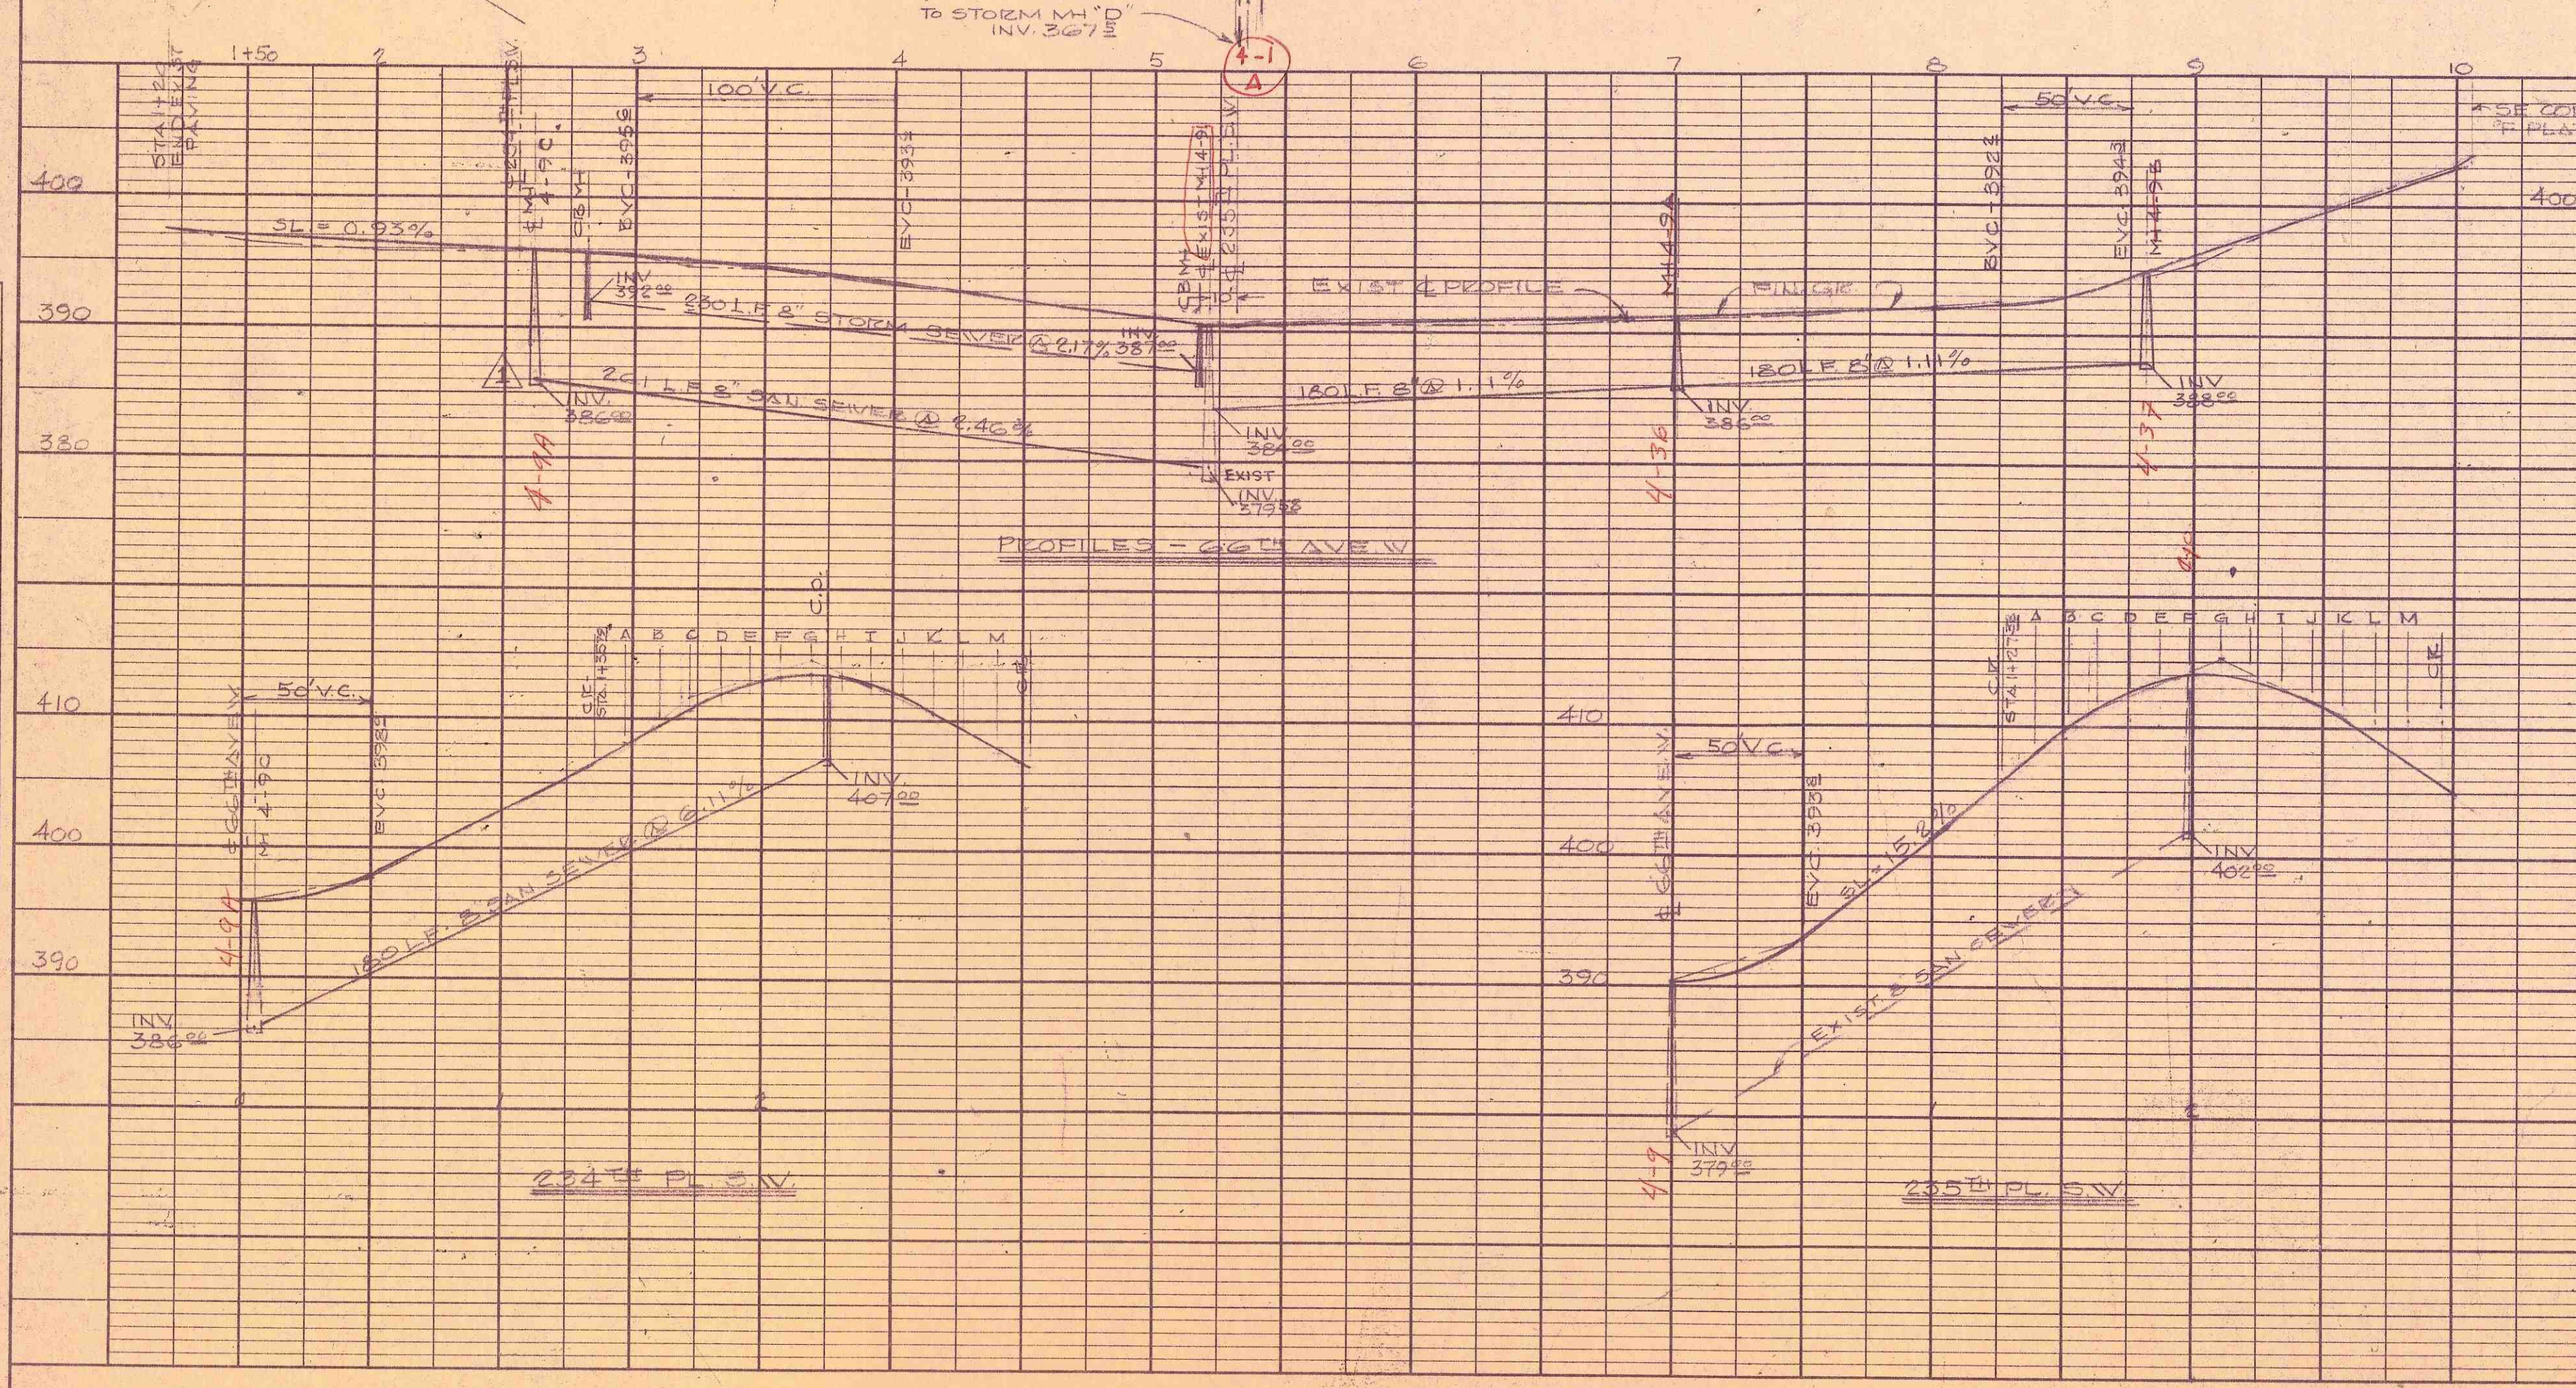

NOTE: EXISTING UNDERGROUND FACILITIES HAVE BEEN SHOWN. THIS DRAWING FOR THE PURPOSES OF ESTIMATING THE CONTRACTOR IS LOCATING SATE FACILITIES IN THE FIELD. THE CONTRACTOR SHALL BE RESPONSIBLE FOR CHECKING ACTUAL LOCATIONS IN THE FIELD AND CHECKING WITH APPROPRIATE AGENCIES THAT MAY HAVE UNDERGROUND FACILITIES WITHIN THE PROJECT LIMITS. THE CONTRACTOR SHALL BE SOLELY RESPONSIBLE FOR ANY DAMAGE TO UNDERGROUND FACILITIES RESULTING FROM HIS OPERATIONS.

Scan Name: scans06522.pdf
Scan Date:

NO.	LOWERED MH 4-9C & SAN SEWER TO MH 4-9	DATE	7/21/61	BY	TR
	REVISIONS				
CITY OF MOUNTLAKE TERRACE					
CULBS & PAVING, 6" & 4" C.I. WATER MAINS, 8" & 10" STORM & 8" SANITARY SEWERS					
BALLINGER TERRACE NO 2					
REID, MIDDLETON & ASSOCIATES, INC. CONSULTING ENGINEERS & LAND SURVEYORS 324 MAIN STREET EDMONDS, WASHINGTON					
SCALE 1" = 20' HORIZ. 1" = 10' VERT.		DATE	7/18/61	DESIGN	TR ✓
				DRAWN	TR ✓
				CHECKED	
				FB	110
				FILE NO.	5.142 D
				SHEET	3 OF 4

AS BUILT DRAWING

PLATE 1-PLAN-PROFILE D.P.R. & R.E. STANDARD
100% AGEPROOF VELLUM—MADE AND PRINTED IN U. S. A.
EUGENE DIETZGEN CO.

5142 D

4-1-B

~~SECRET~~