

APPLI CATION

The City of Mountlake Terrace

SIDE SEWER PERMIT

CARD No. _____


OUTSIDE ☐ INSIDE ☐ REPAIRS ☐

EASEMENT No. _____

OWNER Parkwood Homes Inc CONTRACTOR Lynnwood Septic Tank Co PERMIT No. 3980

HOUSE No. 4508 - 219 SW STREET Lot 10 AVENUE LOT No. 14916 BLOCK No. 14916

NAME ADD. Parkwood Homes

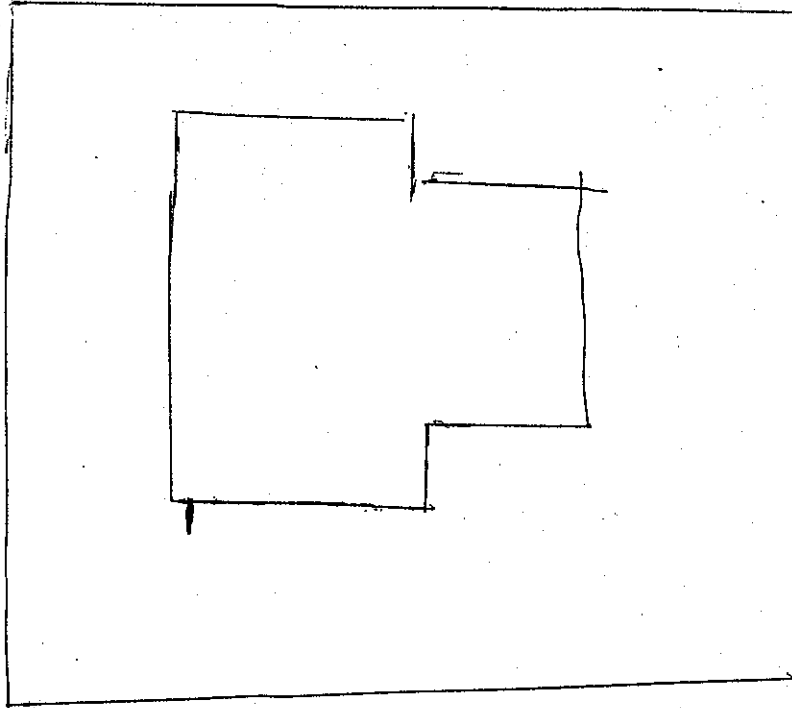

CITY OF
MOUNTLAKE TERRACE

AUG 17

Plan Approved: [Signature]

Date

Approved:

BACKFILL WORK ORDER ISSUED _____ DEPOSIT, \$ _____

SEWER WORK ORDER ISSUED _____

DATE _____ BY _____