

A. J. Co.

CARD No

EASEMENT No. 135-8844

## SIDE SEWER PERMIT

OUTSIDE ☐ INSIDE ☐ REPAIRS ☐

CONTRACTOR Same


PERMIT No. 255

**STREET**

AVENUE LOT No. 15

BLOCK No. 4

NAME ADD. \_\_\_\_\_ *How to*

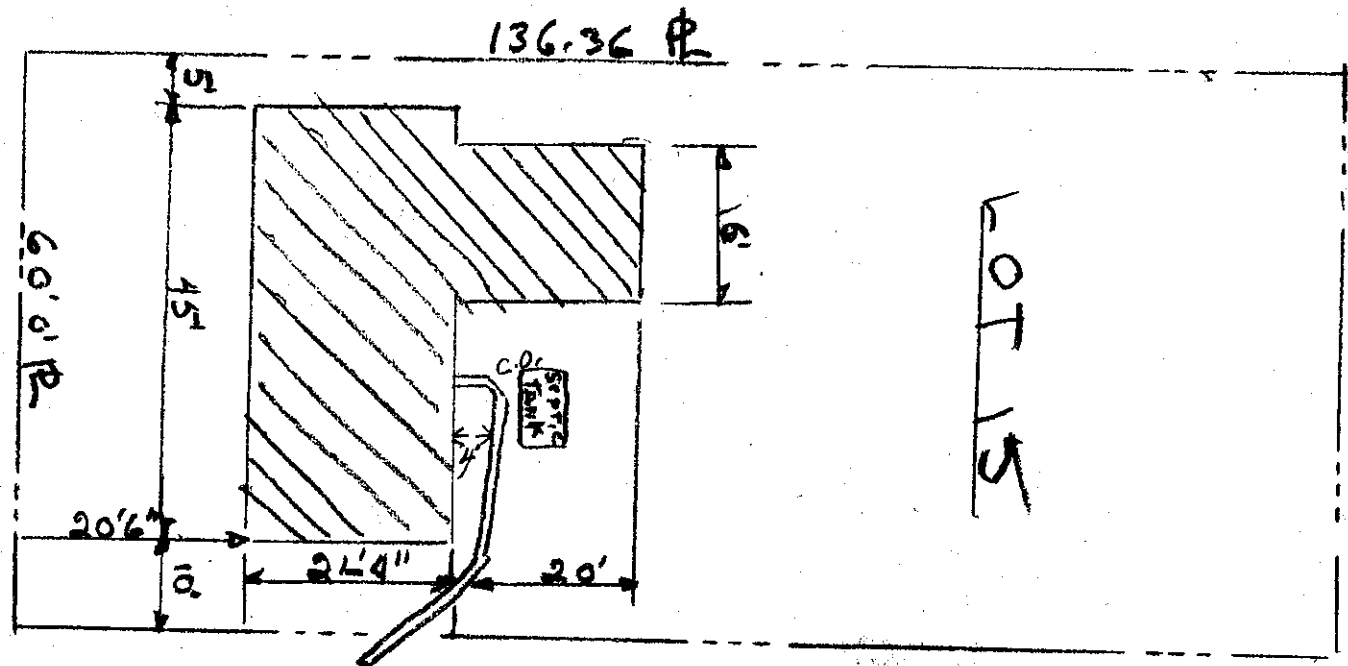

W. 52ND STREET  
SEWER MAIN



Date \_\_\_\_\_

**BACKFILL WORK ORDER ISSUED.**

**SEWER WORK ORDER ISSUED.**

DEPOSIT, \$ 10.00

7/9/00

#1701

Approved:

DATE \_\_\_\_\_

7-14-60

RV

*J. M. H. L.*