

of Mountlake Terrace

APPLICATION

for

SIDE SEWER PERMIT

OUTSIDE INSIDE REPAIRS

CARD No.....

EASEMENT No.....

Hillwood Park Homes

HOUSE No. 21502 - S3 Pl. W.

CONTRACTOR

STREET


AVENUE LOT No. 4

PERMIT No. 2897

BLOCK No.

NAME ADD.

Hillwood Park # 11

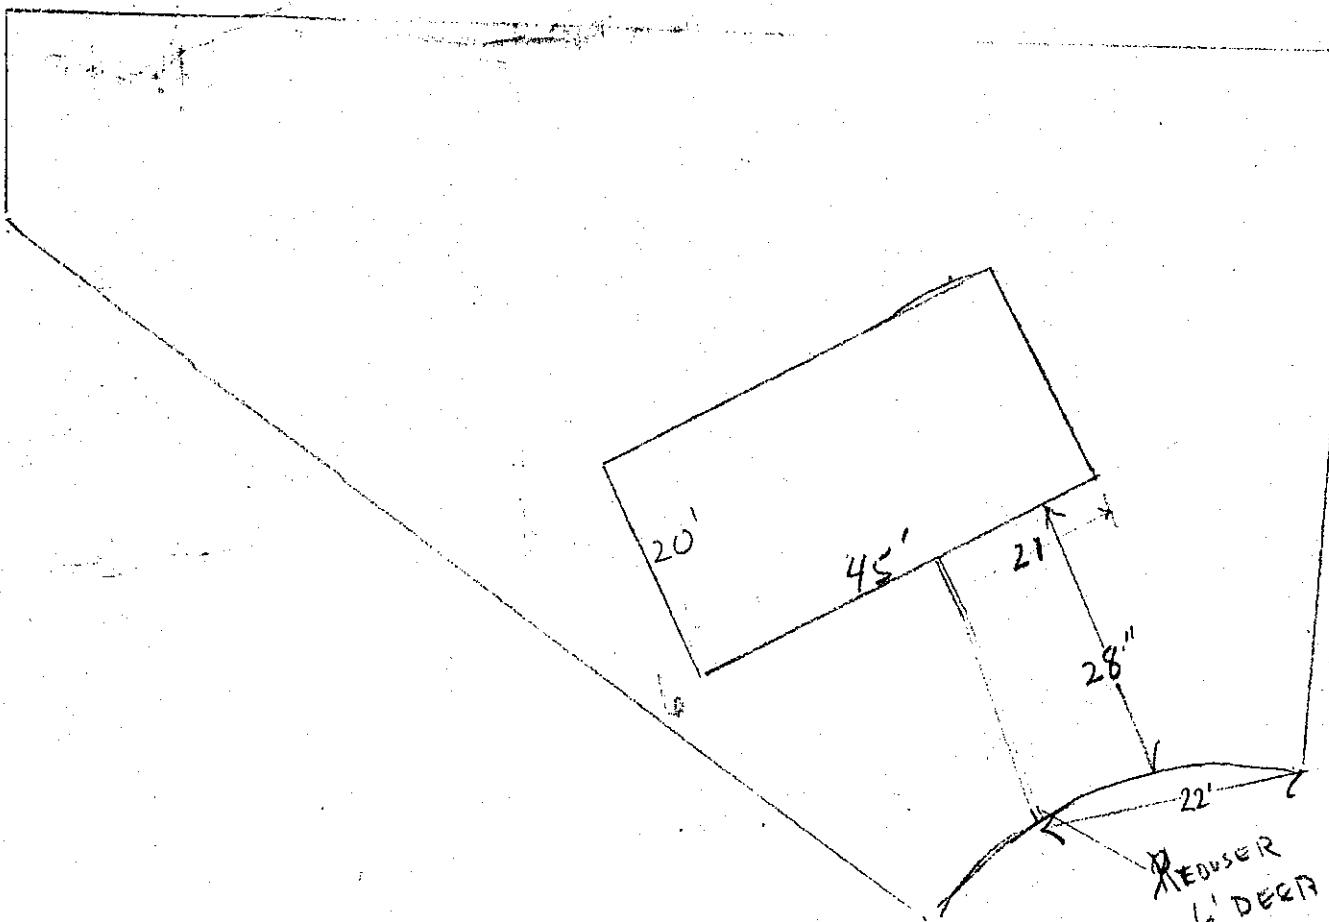

Date

Approved:

BACKFILL WK ORDER ISSUED, DEPOSIT, \$.....
SEWER WORK ORDER ISSUED.....

DATE

BY

City of Mounke Terrace

APPLICATION

for

SIDE SEWER PERMIT

OUTSIDE INSIDE REPAIRS

CARD No. 2103

EASEMENT NO.

OWNER

Hillwood PARK HOMES INC CONTRACTOR ECHO LAKE BOULDER PERMIT No. 2703


HOUSE No. 2193 - 53 PL

STREET
AVENUE LOT NO.

5

BLOCK No.

NAME ADD Hillwood Park #11

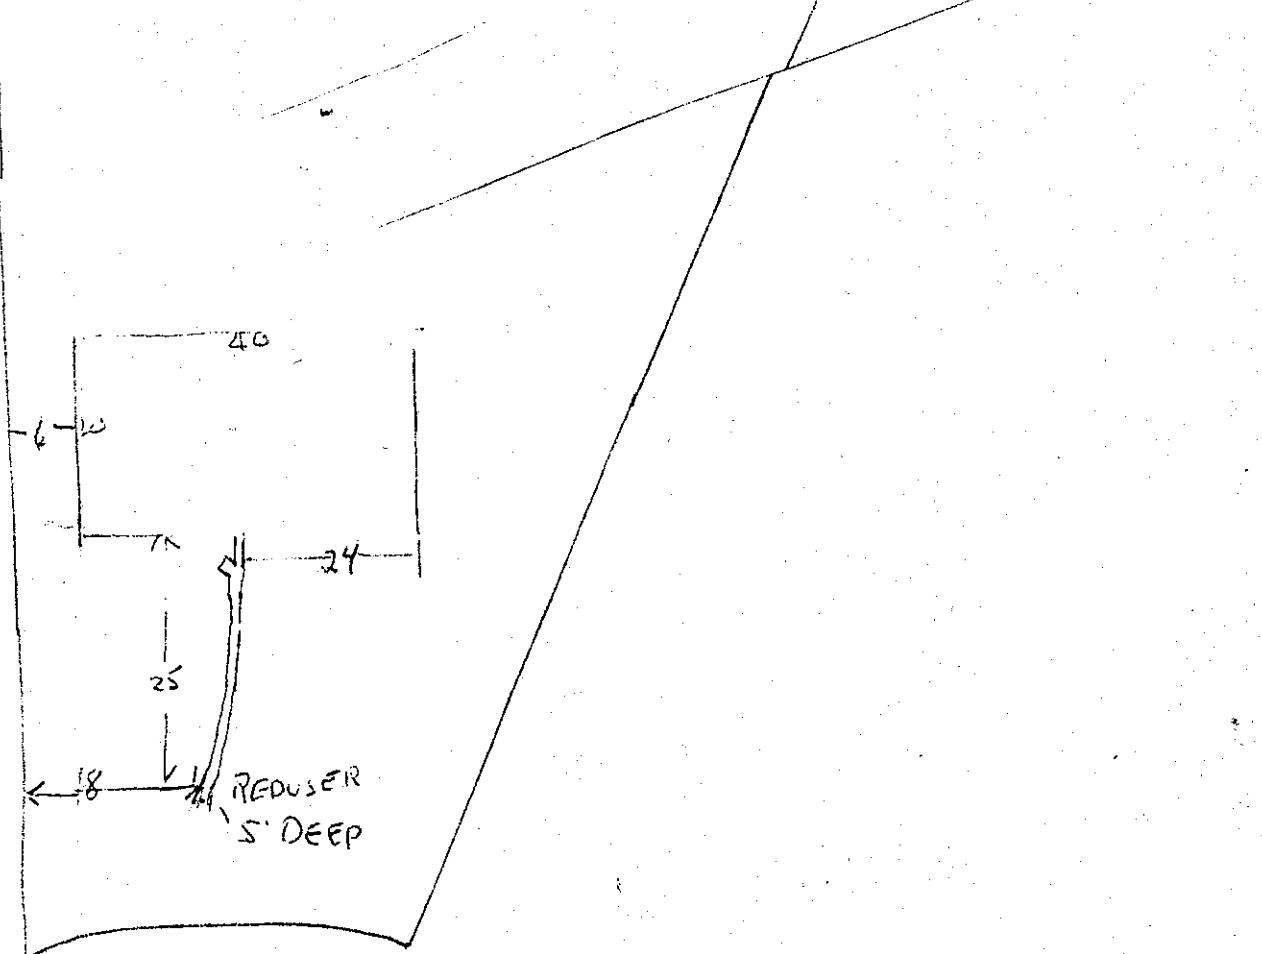

Date

Approved:

BACKFILL WORK ORDER ISSUED

DEPOSIT, \$10.00 4/20/61

SEWER WORK ORDER ISSUED

DATE 4/28/61 BY Scott M. Koltos

The City of Mountlake Terrace

APPLICATION

for

SIDE SEWER PERMIT

OUTSIDE INSIDE REPAIRS


CARD No.....

EASEMENT No.....

OWNER Hillwood Pk Homes CONTRACTOR Echo Lake Builders PERMIT No. 2806
21504

HOUSE No. 21504 STREET 3 AVENUE LOT No. 3 BLOCK No.

NAME ADD. Hillwood Park #11

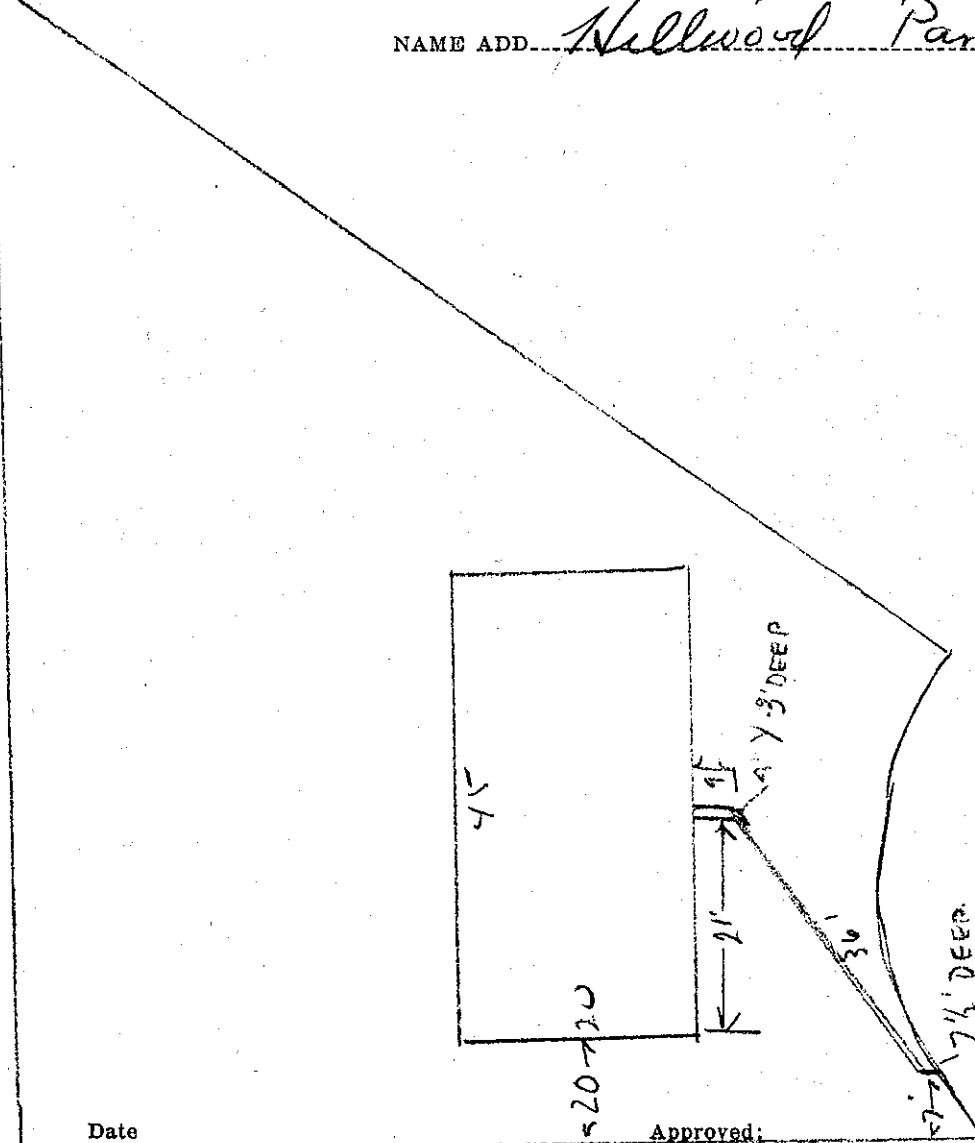

Date

Approved:

BACKFILL WORK ORDER ISSUED
SEWER WORK ORDER ISSUED

DEPOSIT, \$

DATE 7-27-61 BY S.M. Holton

The City of Mountlake Terrace

APPLICATION

for


SIDE SEWER PERMIT

OUTSIDE INSIDE REPAIRS

CARD No. 11

EASEMENT No.

OWNER Hillwood Park Homes Inc. CONTRACTOR ECHO LAKE BUILDERS
HOUSE NO. 21505 - 3 PLW. STREET AVENUE LOT NO. 6 PERMIT NO. 2704
NAME ADD. Hillwood Park # 11

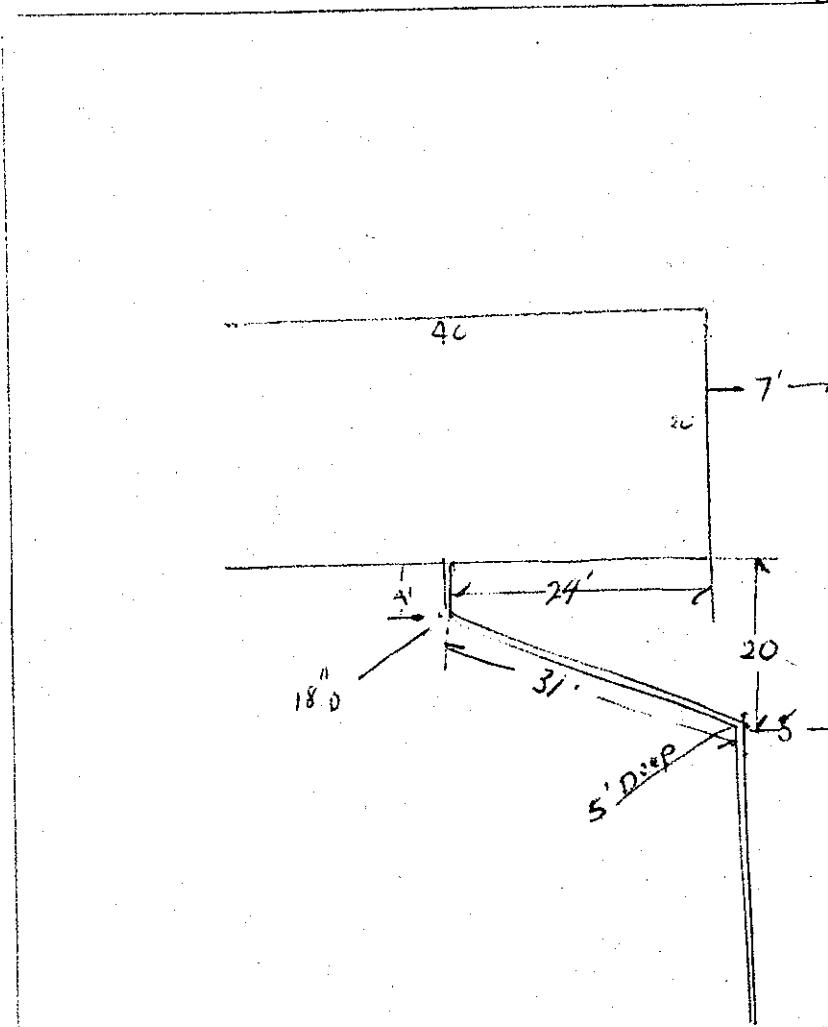

Date

Approved:

BACKFILL WORK ORDER ISSUE
SEWER WORK ORDER ISSUED

DEPOSIT, \$10.00

4/20/61

DATE

4/28/61

BY

Scott M. Holton

APPLICATION

for

SIDE SEWER PERMIT

The City of Mountlake Terrace

CARD No. _____


OUTSIDE INSIDE REPAIRS

EASEMENT No. _____

OWNER

HOUSE No. 21506

Hillwood Pk. Homes CONTRACTOR Echo Lake Builders STREET 2 AVENUE LOT No. NAME ADD. Hillwood Pk. # 11 PERMIT No. 2805

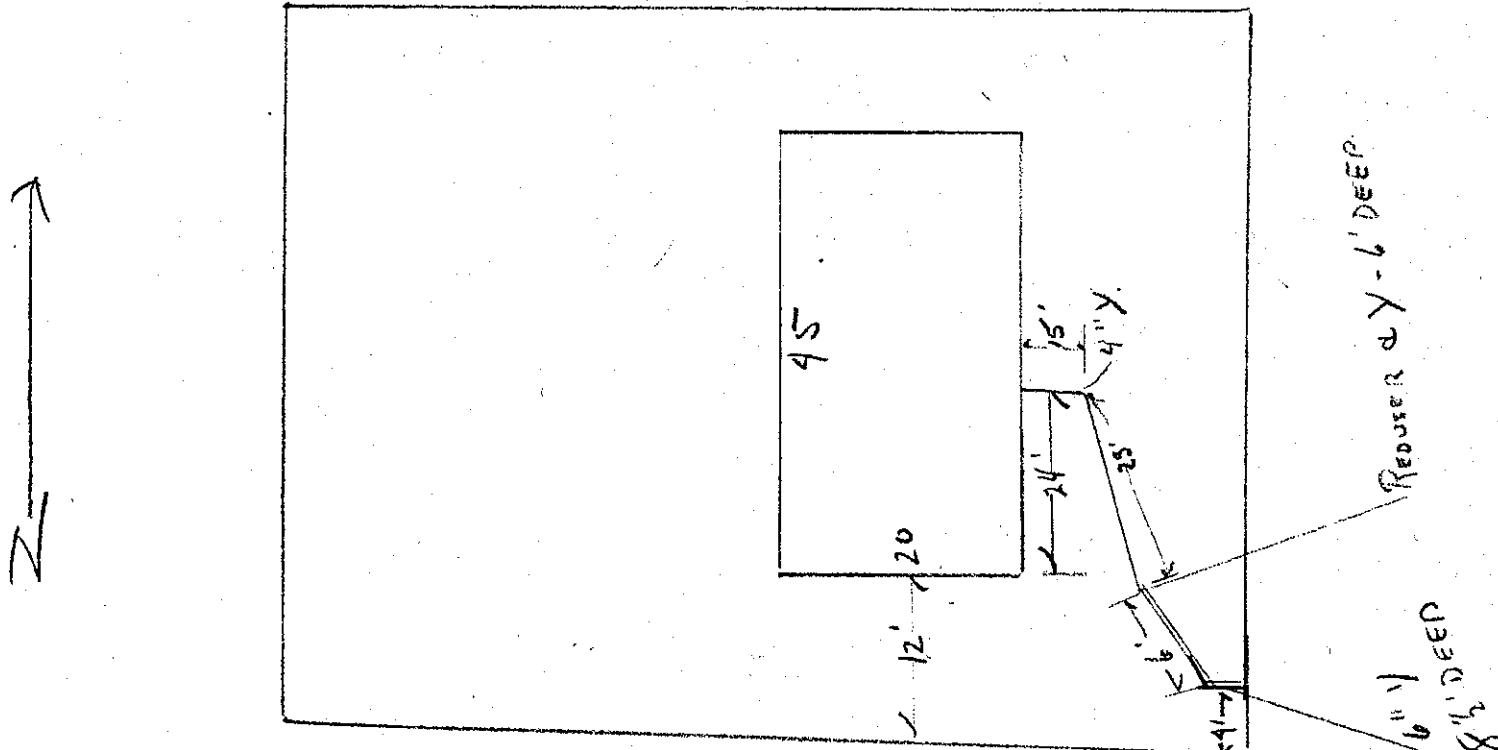

Date

Approved:

BACKFILL WORK ORDER ISSUED

DEPOSIT, \$

SEWER WORK ORDER ISSUED

DATE 7-27-61 BY S. M. Holloway

The City of Mountlake Terrace

APPLICATION


SIDE SEWER PERMIT
OUTSIDE INSIDE REPAIRS

CARD No.

2705

EASEMENT No.....

OWNER Hillwood Park Homes Inc. CONTRACTOR ECHO LAKE BUILDERS PERMIT No. 2705
HOUSE No. 21507 - 53 PL W STREET 7
NAME ADD. Hillwood Park #11 AVENUE LOT No. BLOCK No.

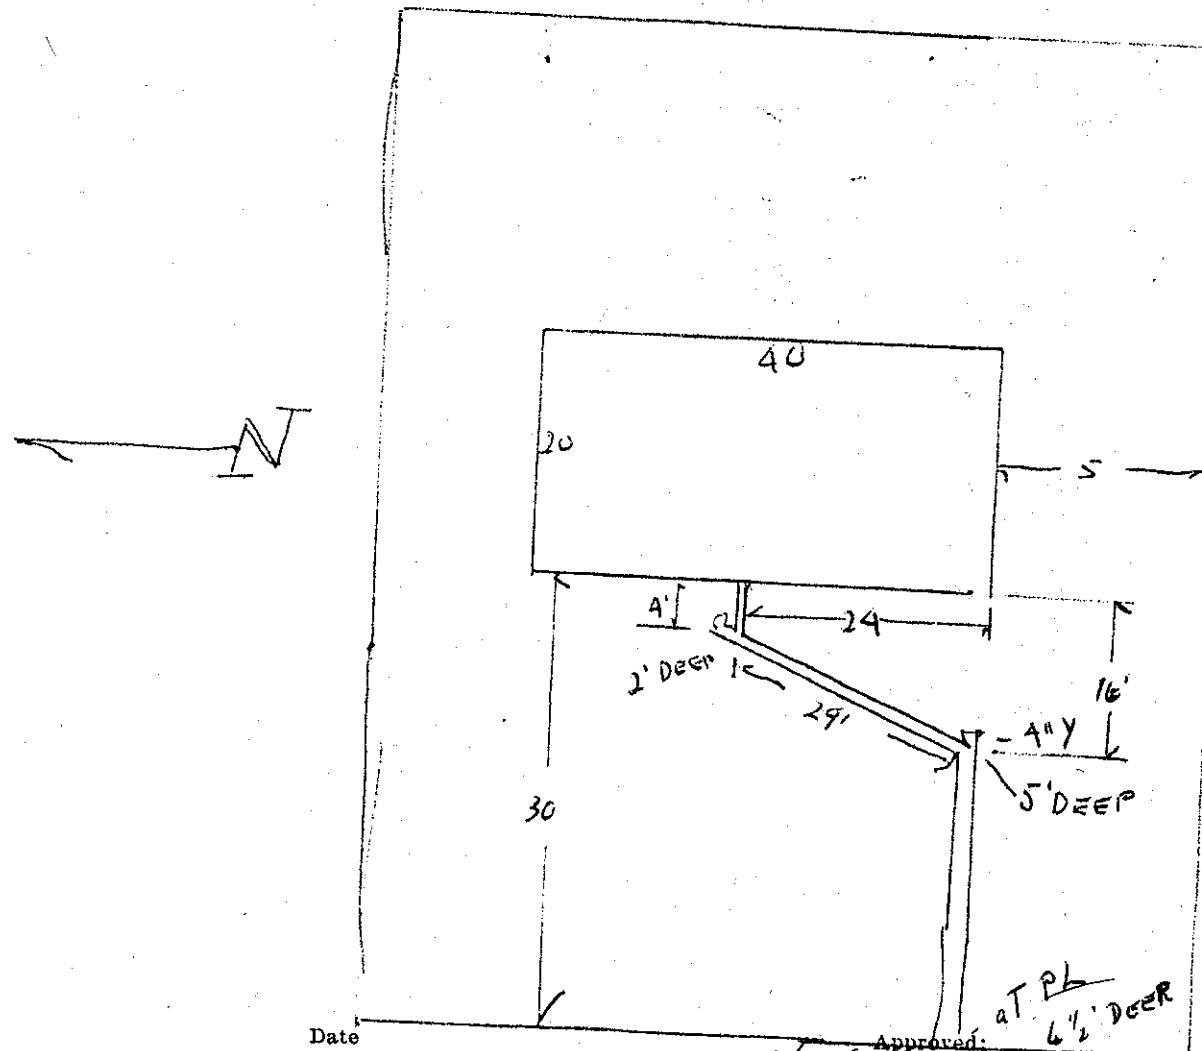

BACKFILL WORK ORDER ISSUED

DEPOSIT, \$10.00

4/26/61

SEWER WORK ORDER ISSUED

DATE 4/28/61 BY Scott M. Holton

APPLICATION

CARD No. _____

The City of Mountlake Terrace

SIDE SEWER PERMIT

OUTSIDE INSIDE REPAIRS

EASEMENT No. _____

OWNER

Hillwood Park Homes
21508

CONTRACTOR

STREET


AVENUE LOT NO.

NAME ADD.

PERMIT No. 2804

BLOCK No. _____

Hillwood Park #11

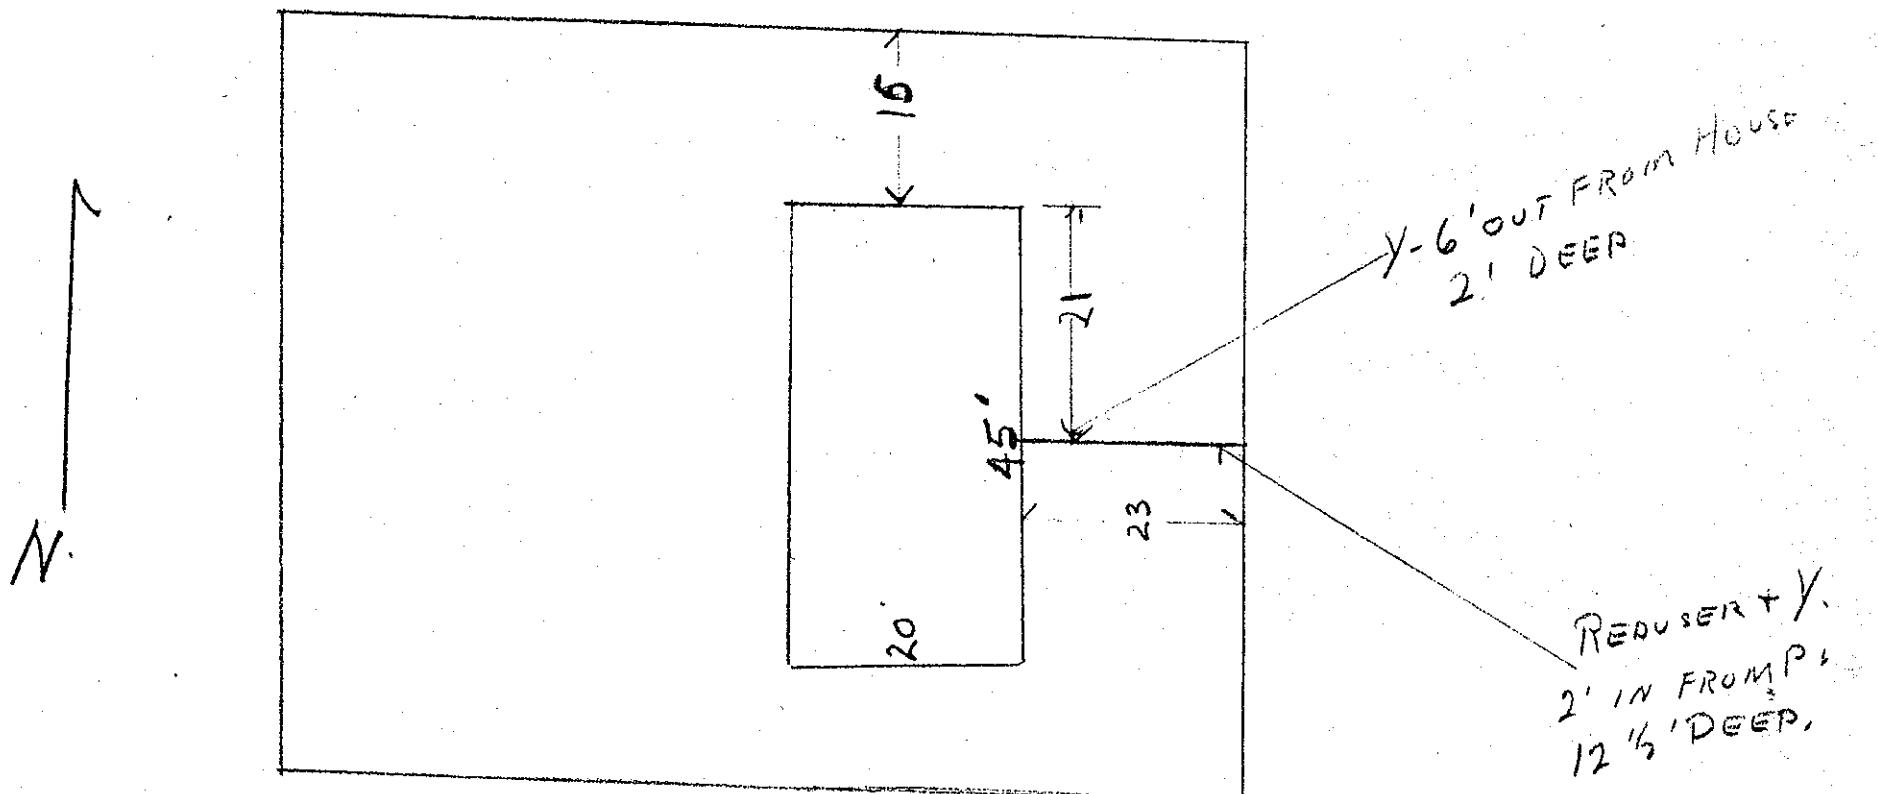

Date

Approved:

BACKFILL WORK ORDER ISSUED

DEPOSIT, \$

SEWER WORK ORDER ISSUED

DATE 7-27-61 BY S. M. Holloway

The City of Mountlake Terrace

APPLICATION

for

SIDE SEWER PERMIT

OUTSIDE INSIDE REPAIRS

CARD No.


2706

EASEMENT No.....

OWNER Hillwood Park Homes Inc. CONTRACTOR Echo Lake Builders PERMIT No. 2706
HOUSE No. 21509 - 53nd STREET
NAME ADD. Hillwood Park # 11

AVENUE LOT No. 8

BLOCK No.....

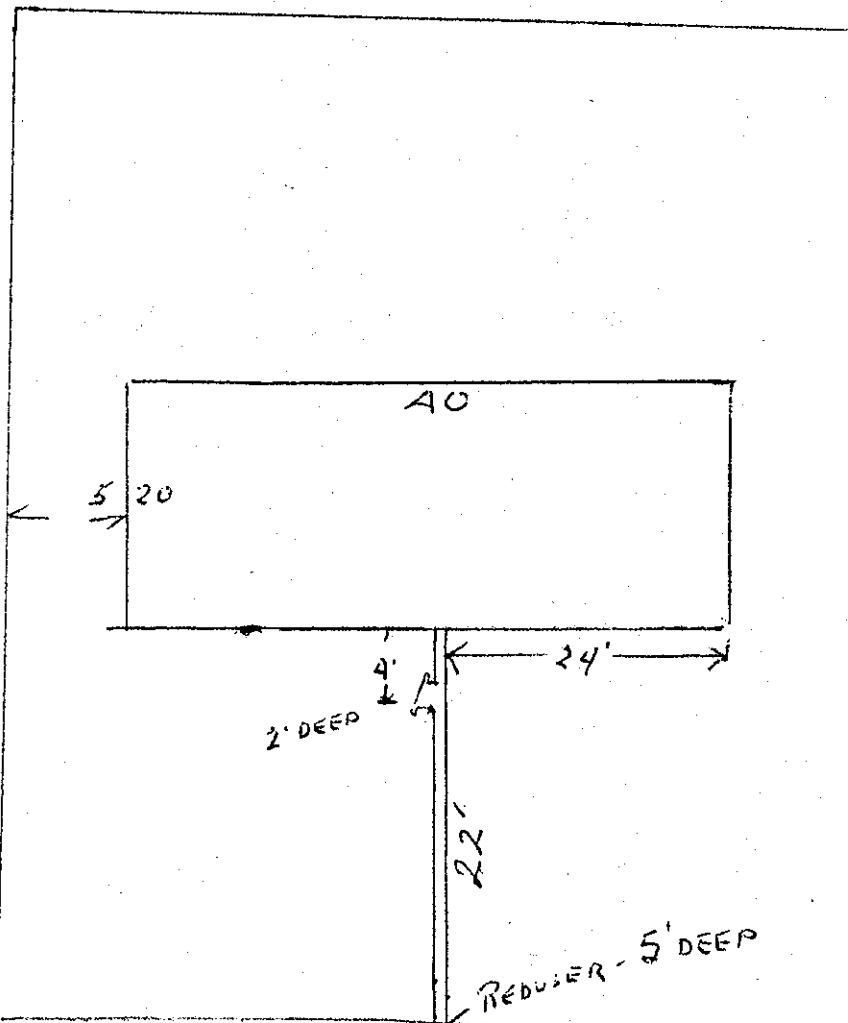

Date

Approved:

BACKFILL WORK ORDER ISSUED
SEWER WORK ORDER ISSUED

DEPOSIT, \$10.00 4/20/61

DATE 4/28/61 BY Scott M Holton

The City of Mountlake Terrace

APPLICATION

CARD No.

SIDE SEWER PERMIT

OUTSIDE INSIDE REPAIRS

EASEMENT No.

OWNER JERRY E ZYLSTRA

HOUSE No. 21603 - 53

CONTRACTOR

PERMIT No.

2673

STREET
AVENUE LOT NO.

BLOCK No.


NAME ADD.

SW 1/4 Lot 1

Seattle Heights Gardens

N

E

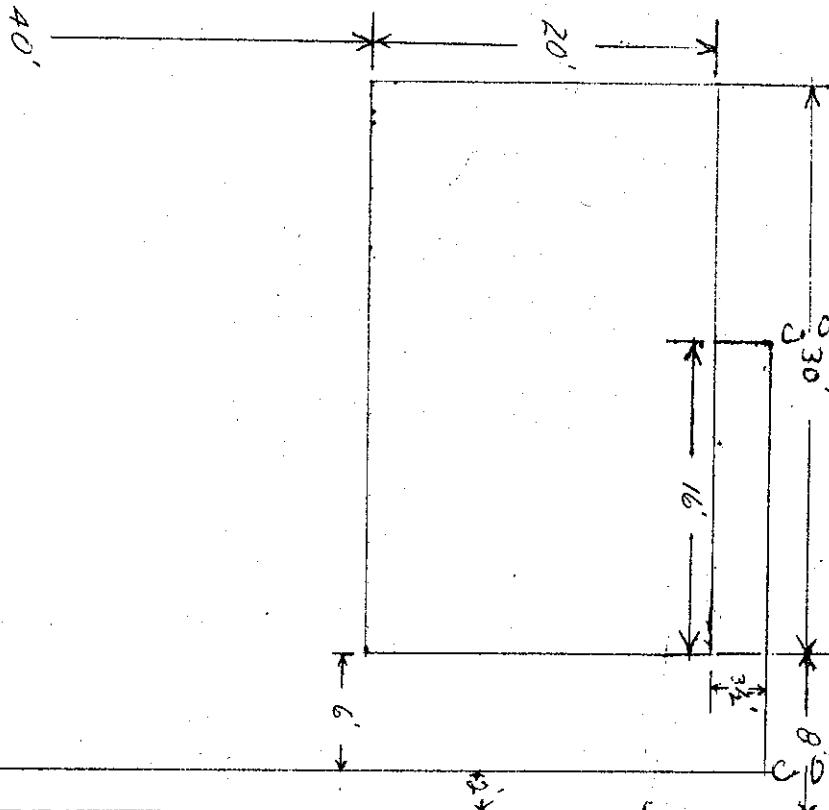

Date

Approved:

BACKFILL WORK ORDER ISSUED

DEPOSIT, \$10.00 5/14/60

SEWER WORK ORDER ISSUED

1455 DATE 7-25-60 BY S. M. Holton NS+CON

APPLICATION

The City of Mountlake Terrace

DA 54TH

CARD No.

SIDE SEWER PERMIT

OUTSIDE INSIDE REPAIRS EASEMENT NO. NoneOWNER Marilyn Danekin
HOUSE No. 21605 W-53

CONTRACTOR

STREET

AVENUE LOT No.

NAME ADD.


Marilyn DanekinPERMIT No. 1390

BLOCK No.

Seattle Heights Gardens

144'

53'

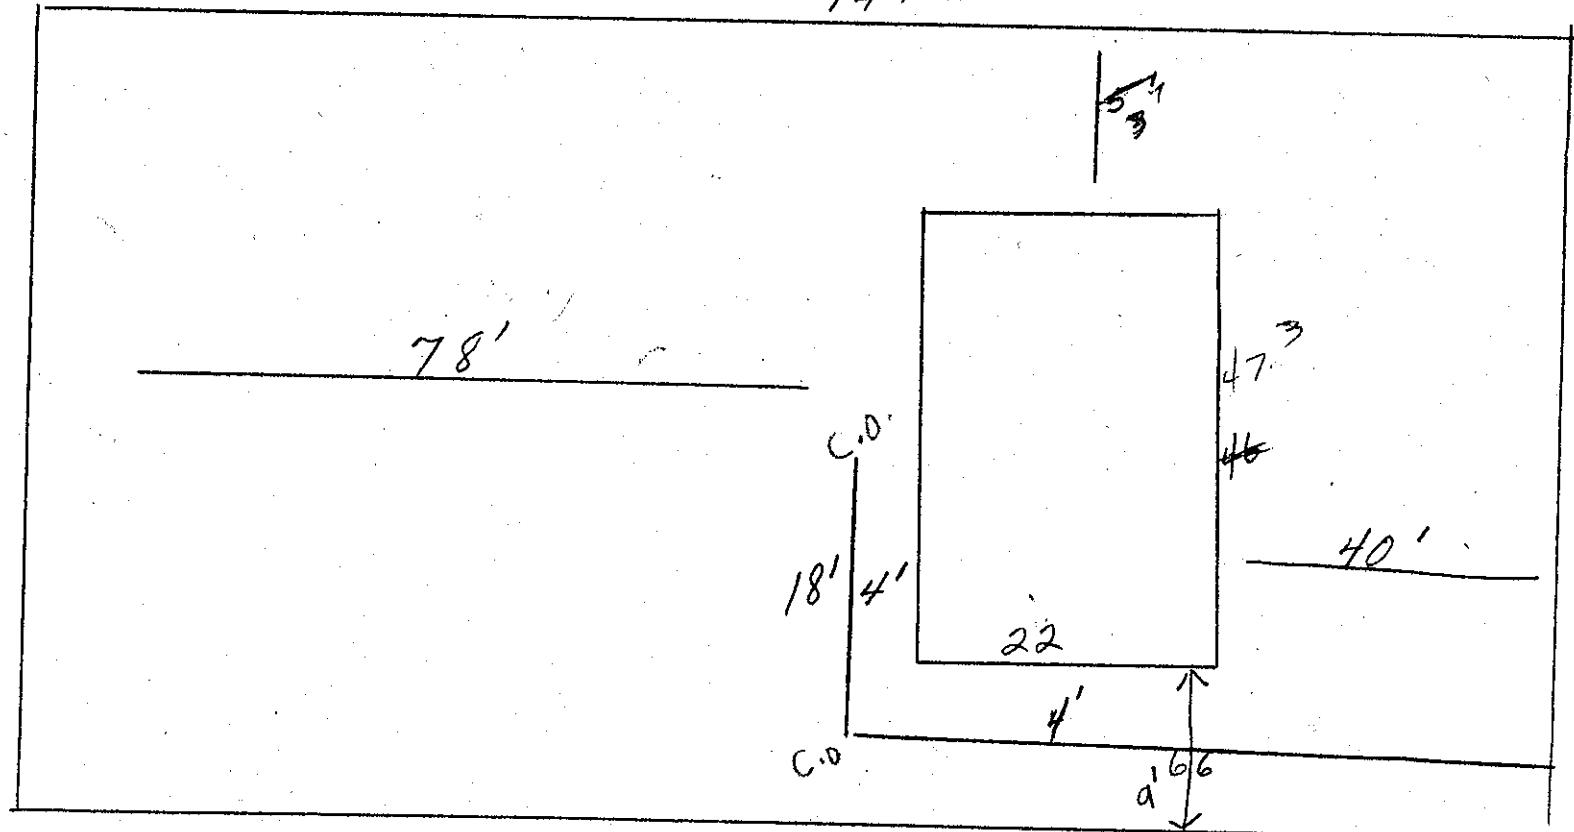

Date

BACKFILL WORK ORDER ISSUED

SEWER WORK ORDER ISSUED

DEPOSIT \$

10,00
#5643
12/30/59 Dg

Approved:

DATE

6/10/60 N.C. 9-30-60

BY L M Holton INST CON

APPLICATION

The City of Mountlake Terrace

SIDE SEWER PERMIT

OUTSIDE INSIDE REPAIRS

CARD No.

EASEMENT No. 135-75-40

OWNER Edwin D. KOUF

HOUSE No. 216 06

CONTRACTOR

PERMIT No. 2597


STREET 53 RD W.

AVENUE LOT No.

BLOCK No.

NAME ADD.

SEIN L. 19. Southern Heighte Developments

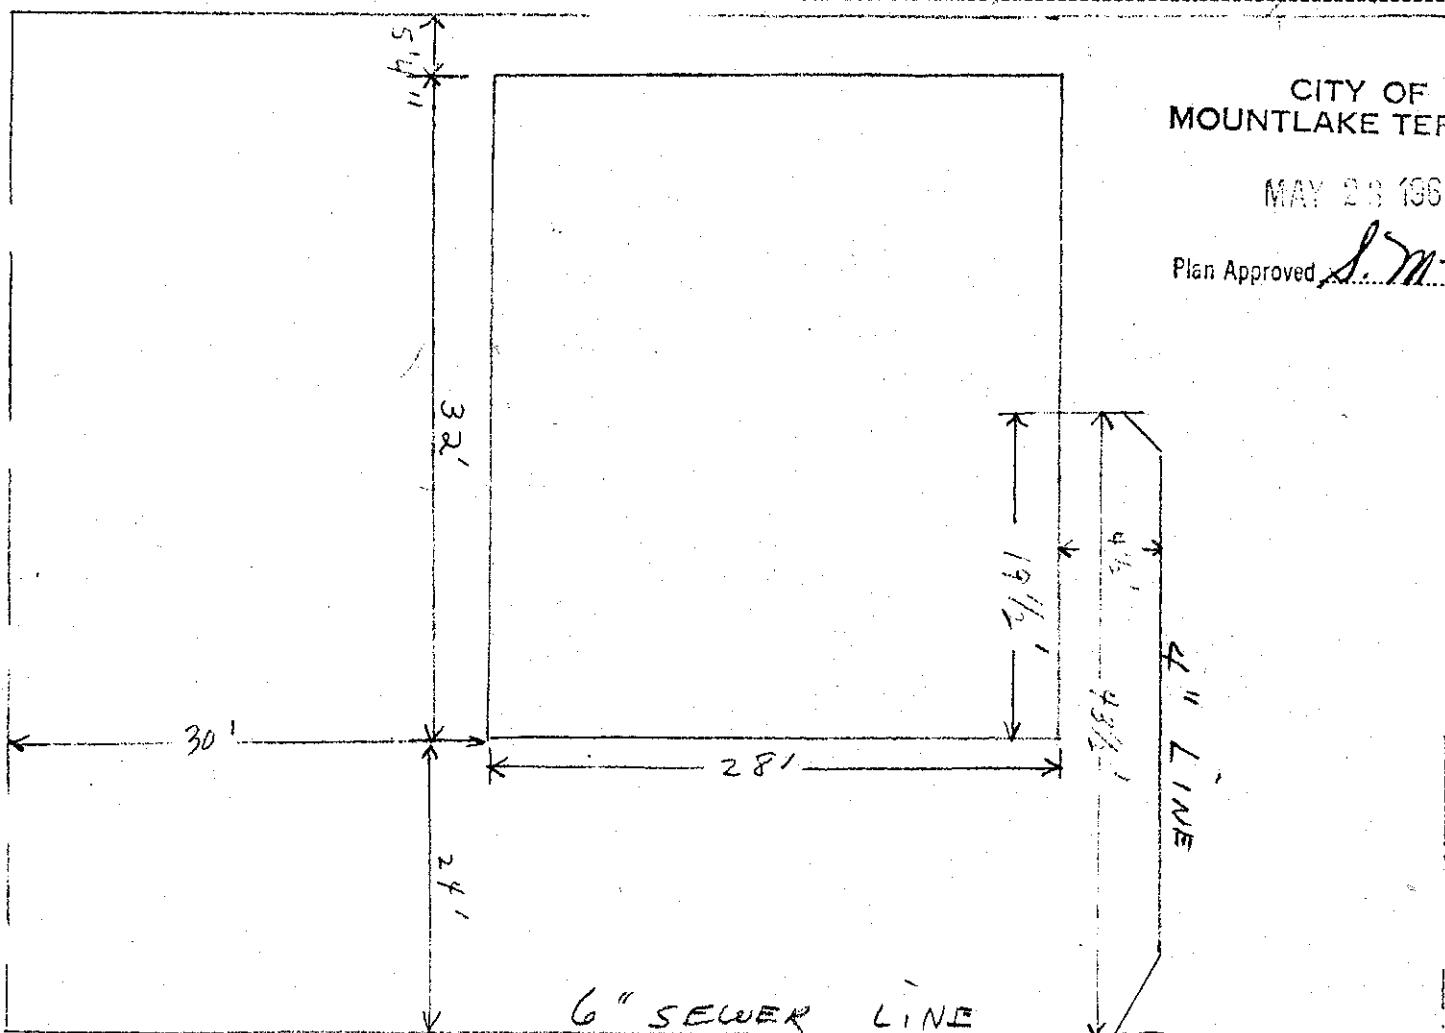

Plan Approved

MAY 23 1960

CITY OF
MOUNTLAKE TERRACE

BACKFILL WORK ORDER ISSUED

DEPOSIT, \$0.20

Approved:

SEWER WORK ORDER ISSUED

5/23/60
1373

DATE 5-23-60 BY S. M. Holton IN ST CON

APPLICATION

CARD No. *10*

The City of Mountlake Terrace

SIDE SEWER PERMIT

OUTSIDE INSIDE REPAIRS

EASEMENT No. _____

OWNER EMERICK ZOMOK
HOUSE No. 21607-53rd WEST

CONTRACTOR

STREET

AVENUE

LOT No.

T & M CONSTRUCTION

PERMIT No. 1358


SOUTH HALF OF WEST HALF

OF LOT 2

BLOCK No.

SEATTLE HEIGHTS
GARDENS

NAME ADD. _____

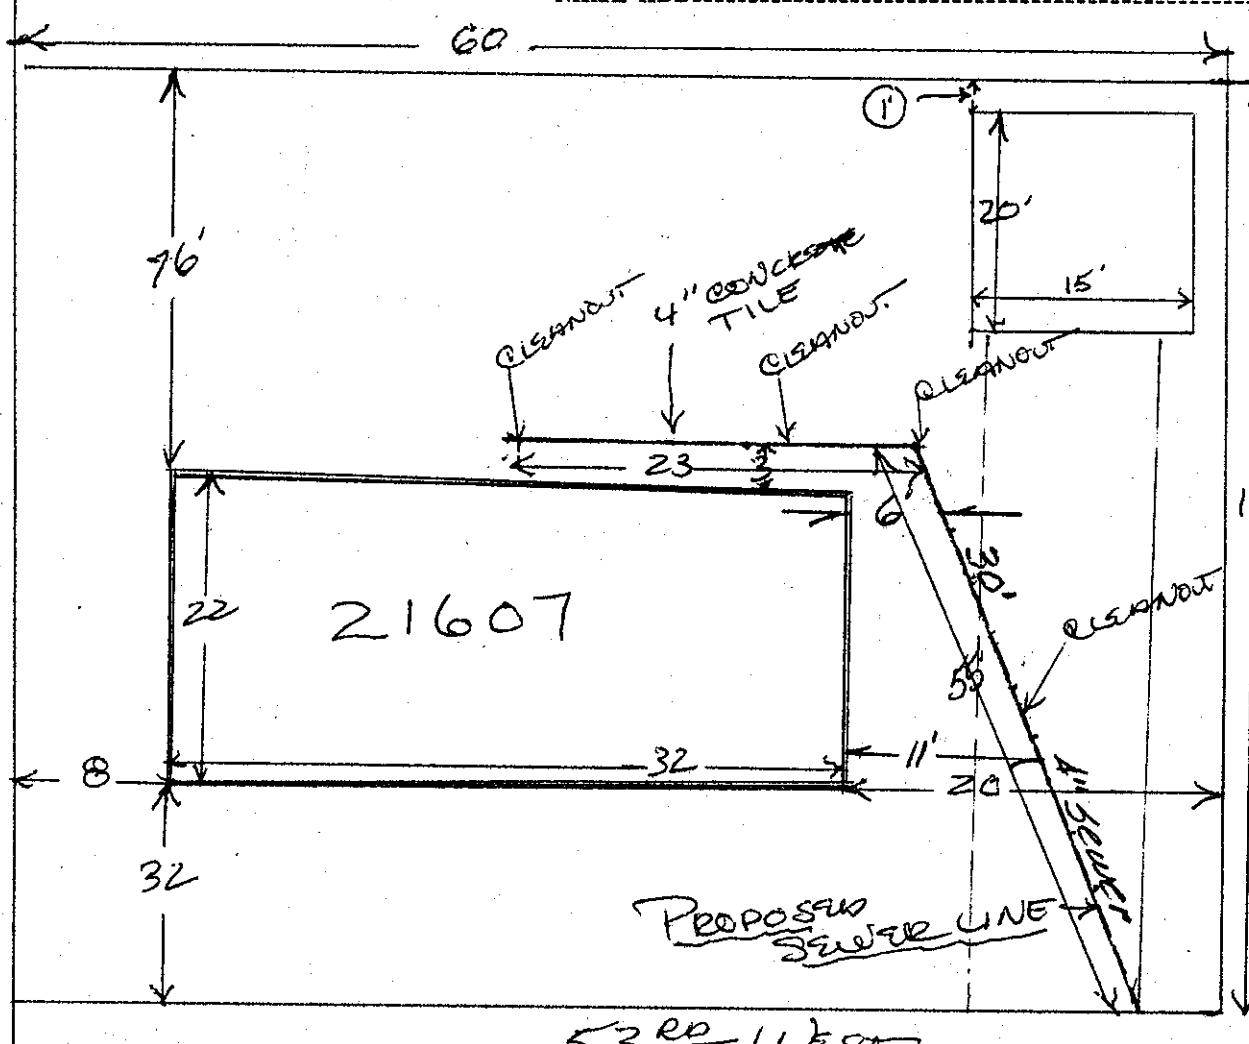

Date

Approved:

BACKFILL WORK ORDER ISSUED

DEPOSIT, \$10 *10.00* 12-8-59

SEWER WORK ORDER ISSUED

5531 DATE 12-9-59 BY

et

Scott W Holton IWS
N.C.

APPLICATION

CARD No. _____

The City of Mountlake Terrace

SIDE SEWER PERMIT

OUTSIDE INSIDE REPAIRS

EASEMENT No. _____

OWNER Carl Blaschka
21608HOUSE No. ~~21608~~ - 53 W.

CONTRACTOR _____

PERMIT NO. 419

STREET

AVENUE LOT NO. NE 1/4


Lot 18

BLOCK NO. _____

NAME ADD.

Seattle Heights Gardens

120'

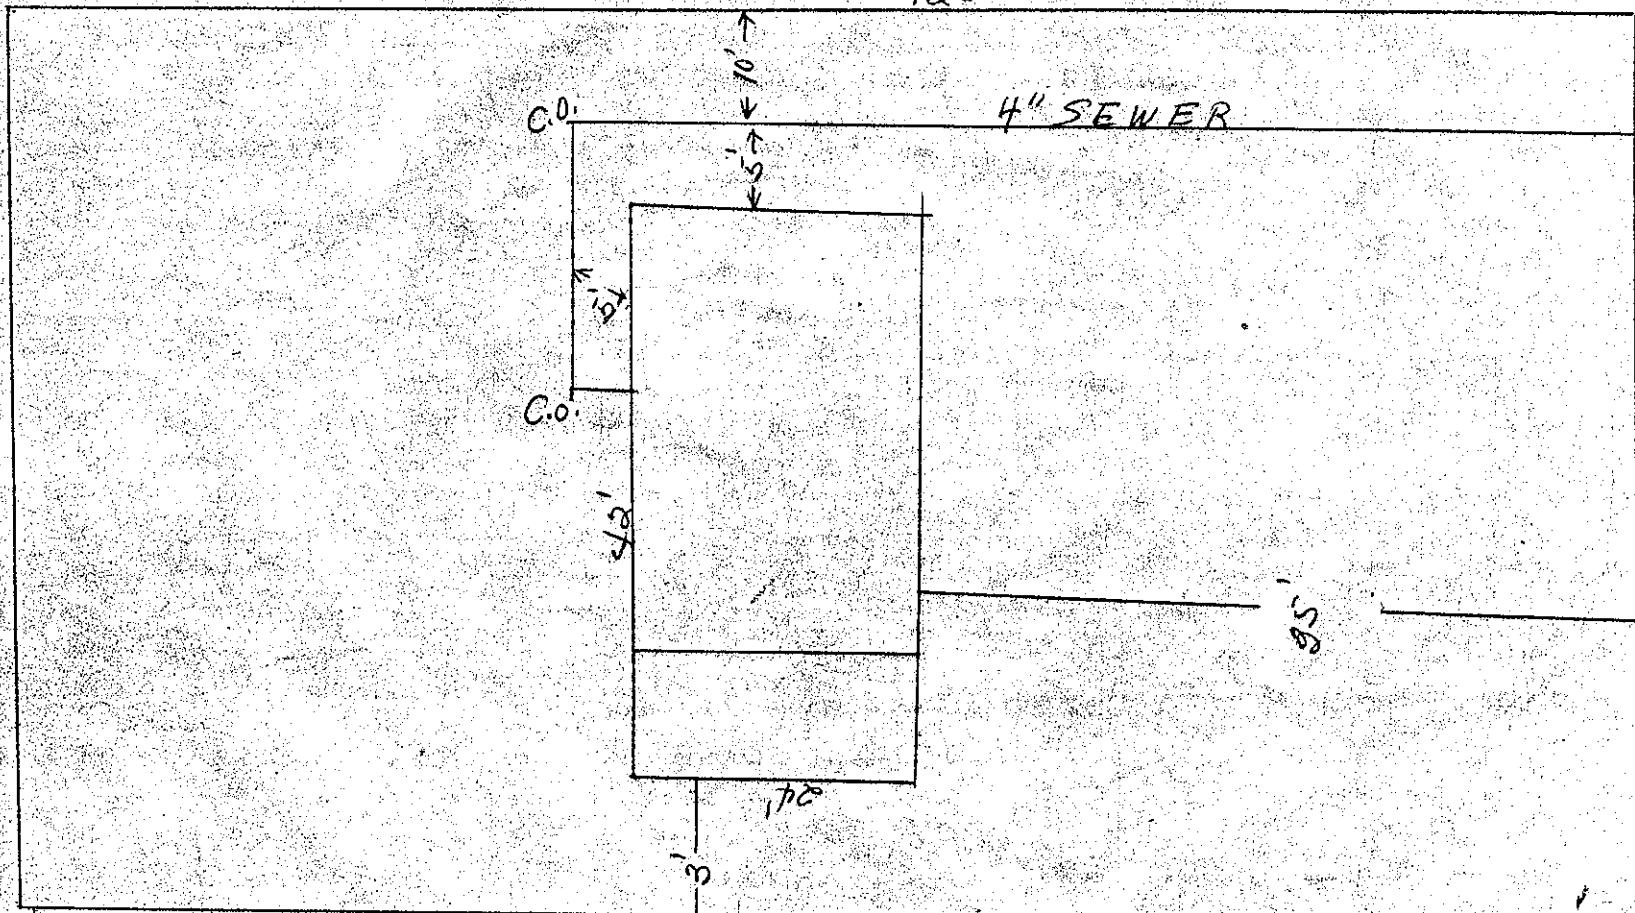

Date

Approved:

BACKFILL WORK ORDER ISSUED

DEPOSIT: \$3/160 10.00
1846

SEWER WORK ORDER ISSUED

DATE 9-8-60

BY

J. M. Holton INS-COM

APPLICATION

The City of Mountlake Terrace


CARD No.

SIDE SEWER PERMIT

OUTSIDE INSIDE REPAIRS

EASEMENT No.

OWNER Munger Homes CONTRACTOR B + M Const PERMIT No. 3109
 HOUSE No. 21609 STREET 53rd Ave W AVENUE LOT No. Block 3 BLOCK No.
 NAME ADD. Seattle Heights Gardens

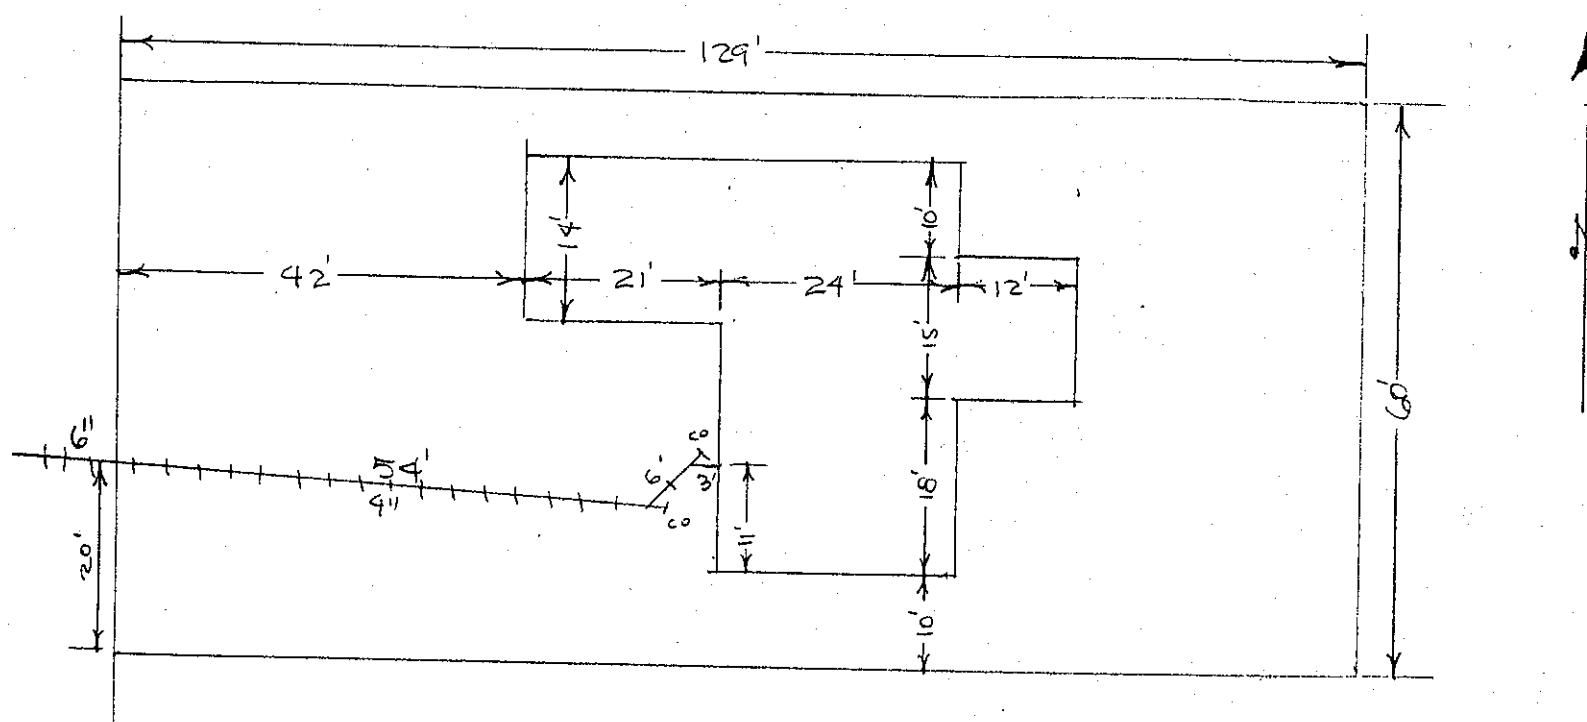CITY OF
MOUNTLAKE TERRACE

Date _____
 BACKFILL WORK ORDER ISSUED _____
 SEWER WORK ORDER ISSUED _____

DEPOSIT, \$ _____

Approved: _____

DATE _____

BY _____ Plan Approved _____

AUG 6 1962

RDS

The City of Mountlake Terrace

APPLICATION

SIDE SEWER PERMIT

OUTSIDE INSIDE REPAIRS

George Wickman
CARD No.

EASEMENT No. 1360453

OWNER George Wickman

HOUSE No. 21700 - 53 W

CONTRACTOR


STREET

AVENUE LOT No. 18 SE 1/4

PERMIT No. 2610

BLOCK No.

NAME ADD. Seattle Heights Gardens

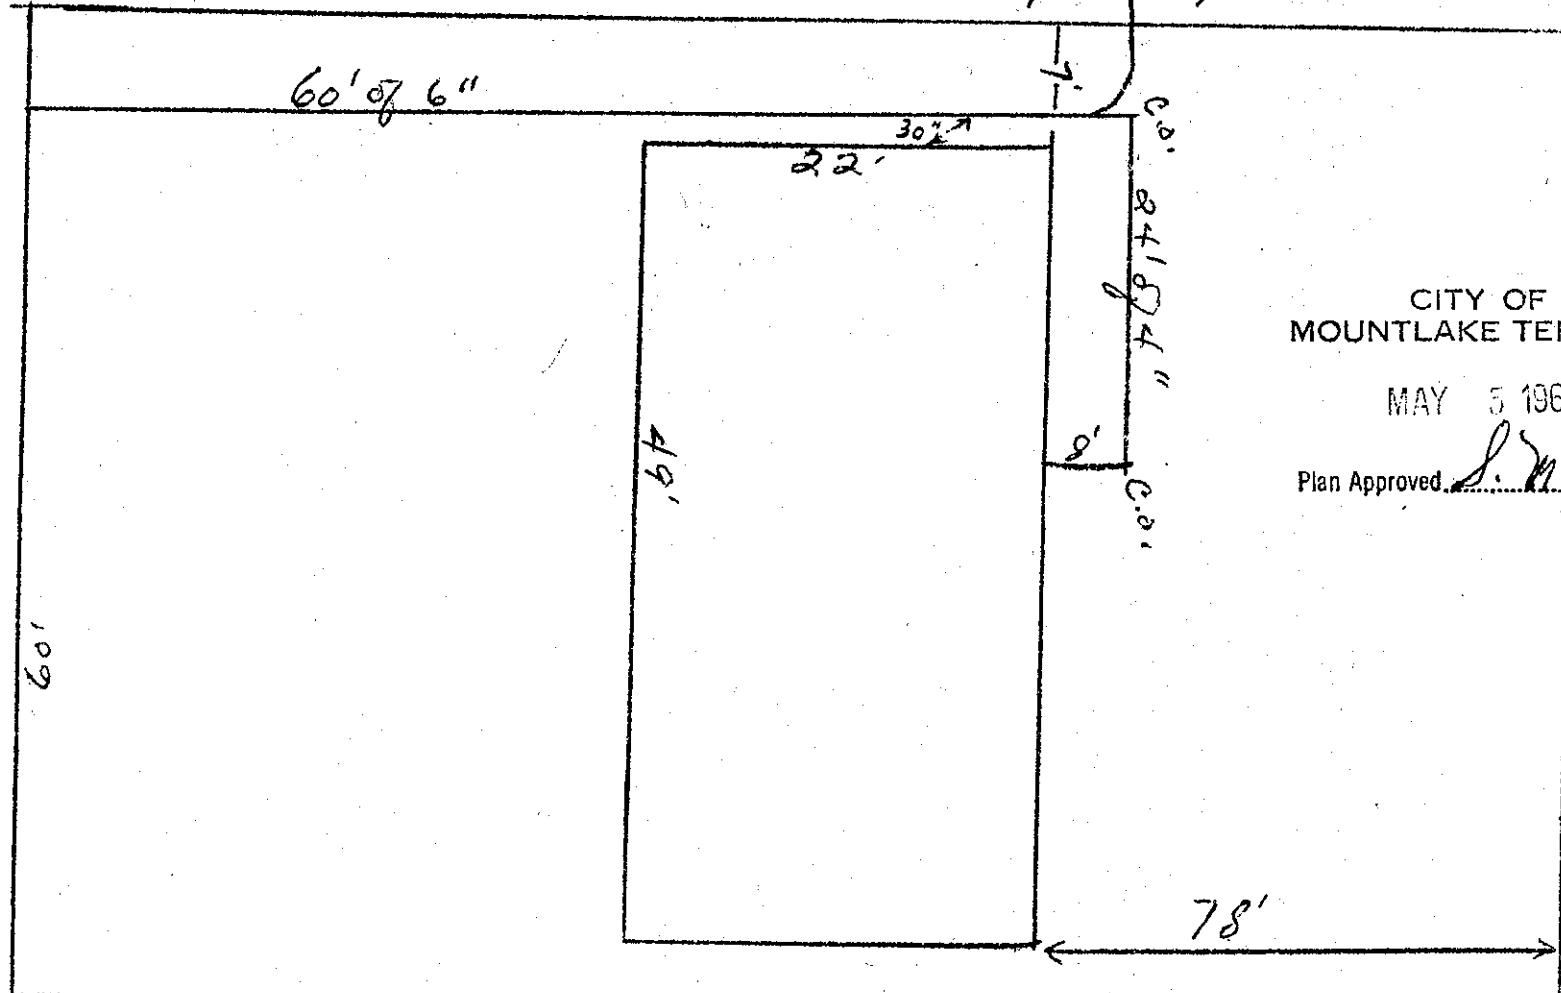

Date

Approved:

BACKFILL WORK ORDER ISSUED

DEPOSIT, \$10.00 5/5/60

SEWER WORK ORDER ISSUED

1385


DATE 5-5-60

BY S. M. Holton IWS

53RD AVE W



DRIVEWAY

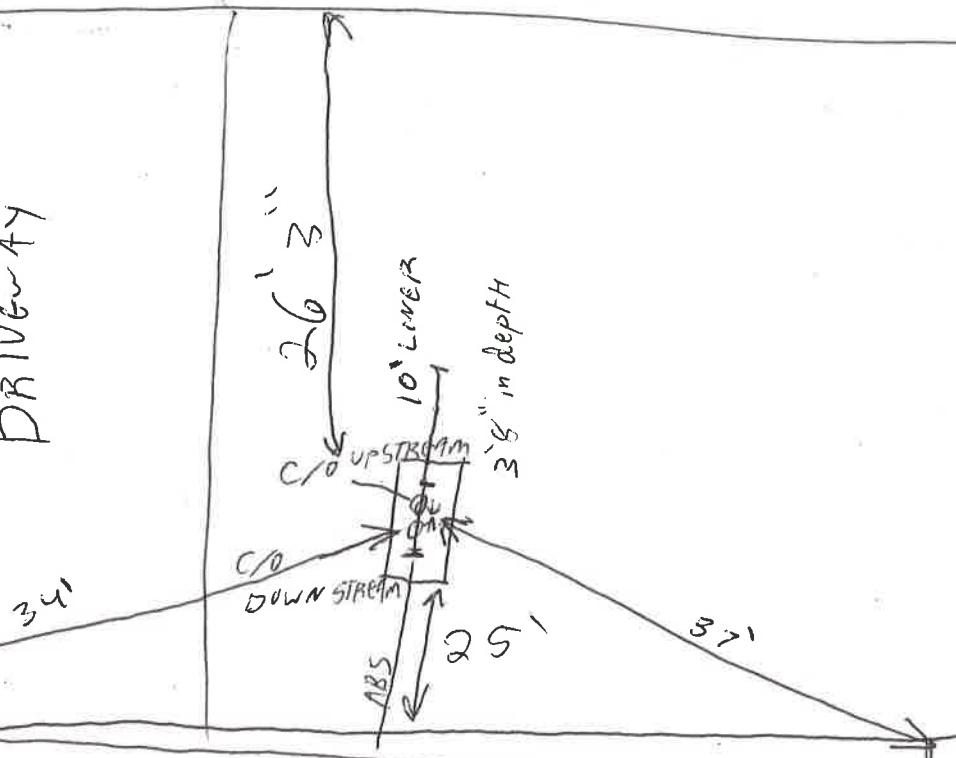

21701-53rd

U-16-0007

21701-53rd



CITY OF MOUNTLAKE TERRACE
DEPARTMENT OF COMMUNITY DEVELOPMENT

Side Sewer As-Built

U- -16-0007

revision date

APPLICATION

The City of Mountlake Terrace

CARD No.

SIDE SEWER PERMIT

OUTSIDE INSIDE REPAIRS

EASEMENT No. None

OWNER Dick Fiedeler

CONTRACTOR

Wingfield

PERMIT No. 569

HOUSE No. 21703 - 53rd W.


STREET

AVENUE LOT No. N.W. 1/4 of 4

BLOCK No. —

NAME ADD.

Seattle Heights Gardens

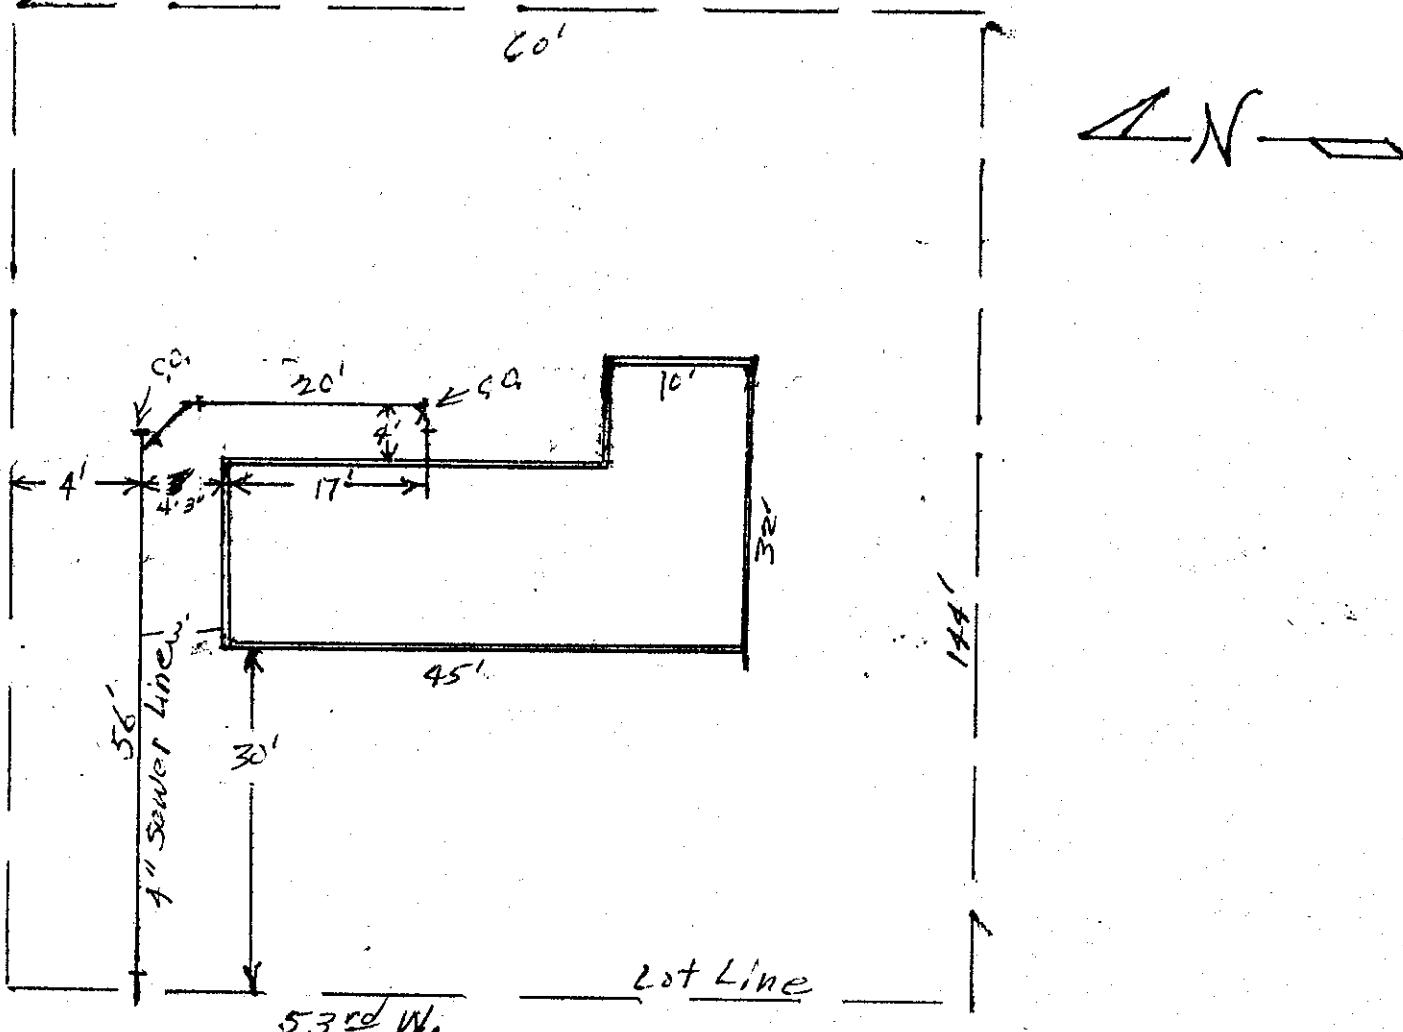

Date

Approved:

BACKFILL WORK ORDER ISSUED

DEPOSIT, \$10.00 11/16/60

SEWER WORK ORDER ISSUED

#2023 DATE 11/17/60 BY Arthur E. Bruckner

The City of Mountlake Terrace

APPLICATION

CARD No.

SIDE SEWER PERMIT

OUTSIDE INSIDE REPAIRS

EASEMENT No.

OWNER R.E. BERGGREN

CONTRACTOR ED WEBER

PERMIT NO. 523


HOUSE No. 21704

STREET
AVENUE LOT No. 53 WEST SE 14th 17

BLOCK No.

NAME ADD.

Hattle Height Gardens

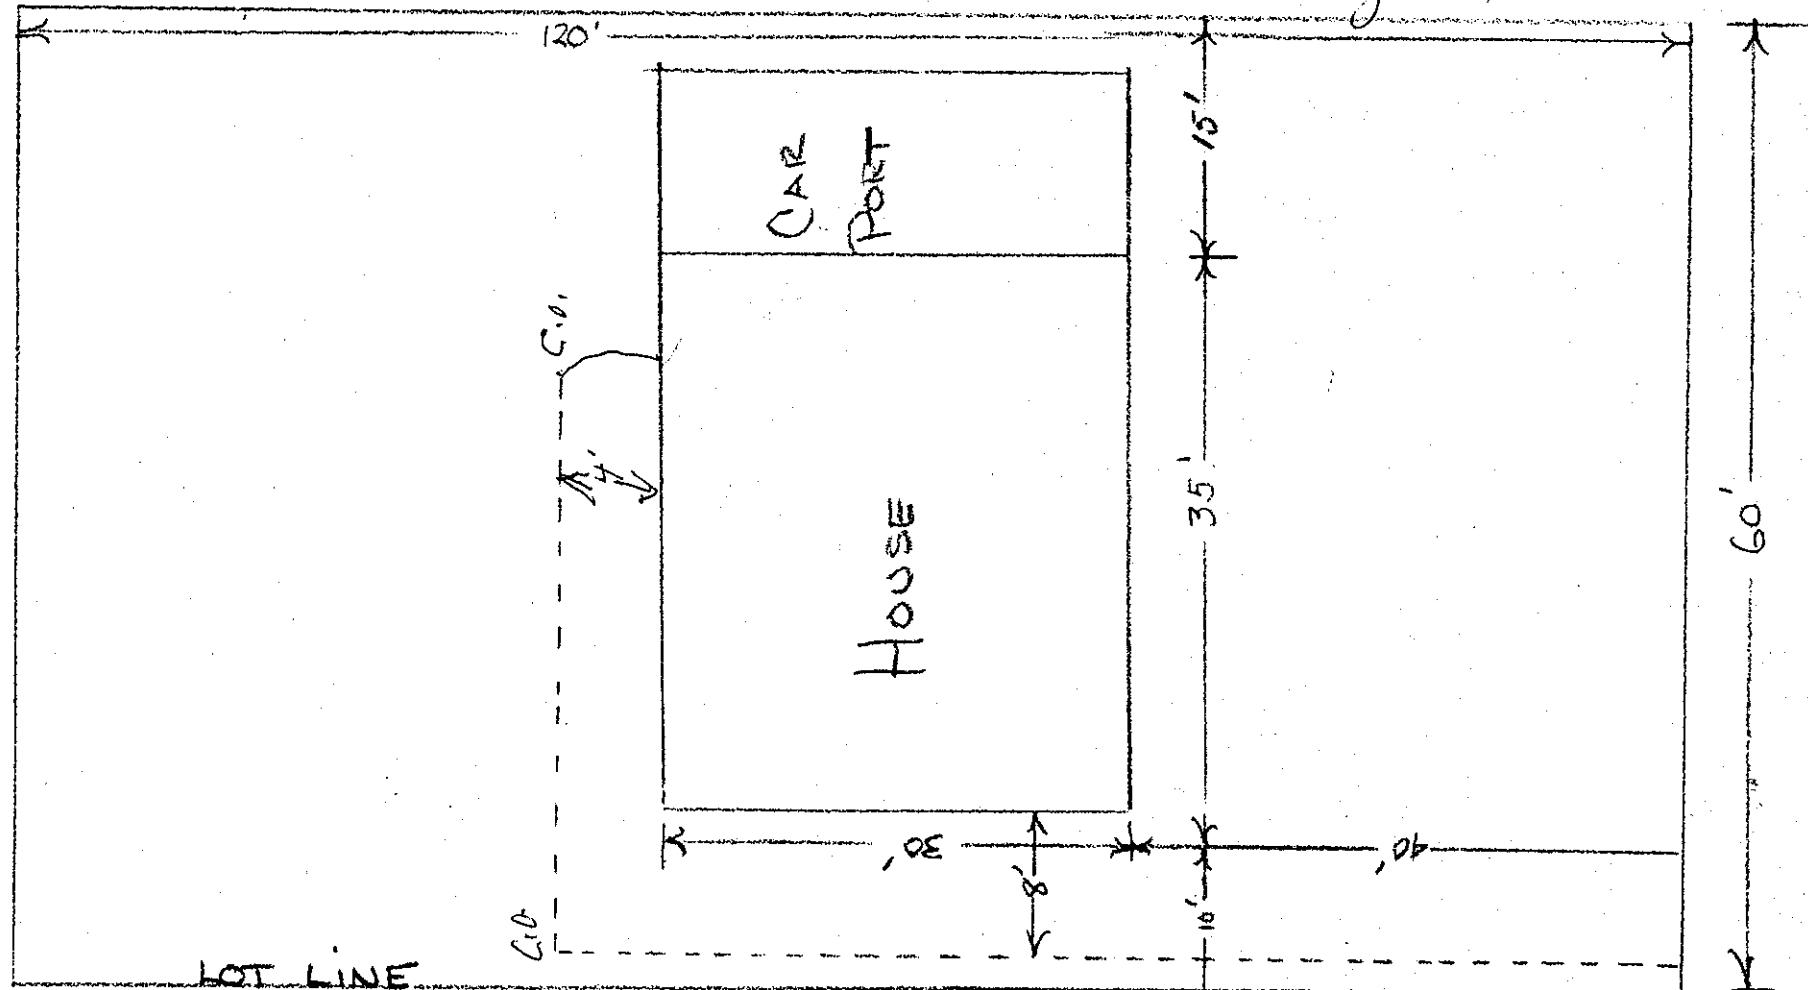

Date

Approved:

BACKFILL WORK ORDER ISSUED

DEPOSIT, \$ 10.00

#1964
10/22/60

SEWER WORK ORDER ISSUED

DATE 11-21-60 BY S.M. Holton

3 N
E S

The City of Mountlake Terrace

APPLICATION

FOR

SIDE SEWER PERMIT

OUTSIDE INSIDE REPAIRS

HEART 3100
CARD No.

BASEMENT No.

OWNER Hesel STICE

HOUSE No. 21705

5300

CONTRACTOR

STREET

AVENUE LOT No.

NAME ADD.


THUNDERBIRD

SWE GARDEN LOT 4

PERMIT No. 109

BLOCK No.

Seattle Heights Gardens

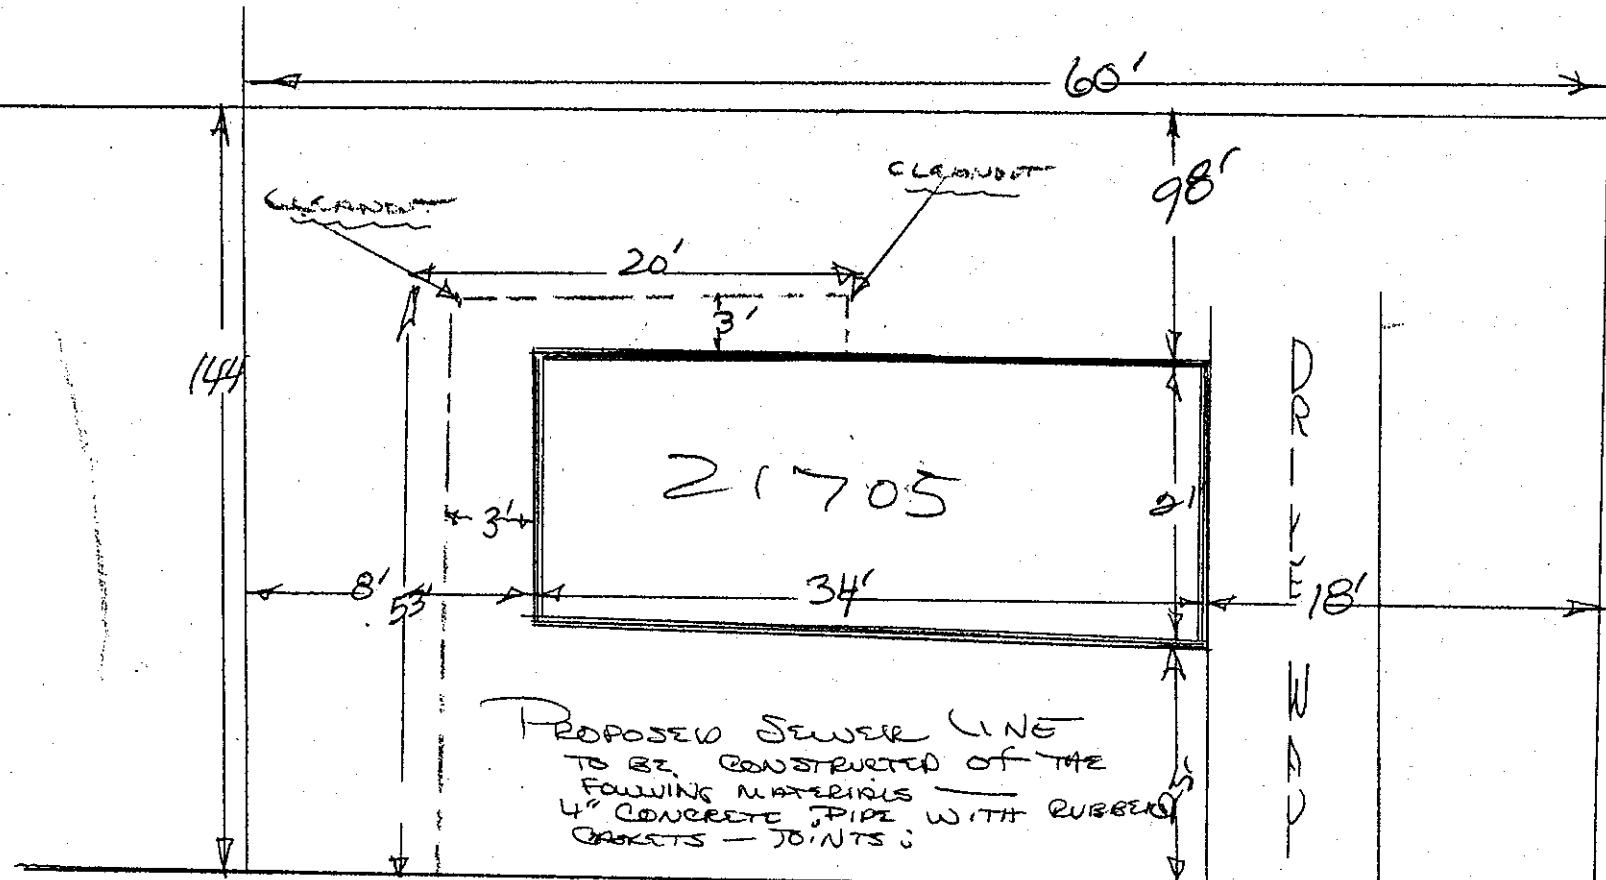

PROPOSED SEWER LINE
TO BE CONSTRUCTED OF THE
FOLLOWING MATERIALS
4" CONCRETE PIPE WITH RUBBER
GASKETS - JOINTS:

Date

BACKFILL WORK ORDER ISSUED
SEWER WORK ORDER ISSUED

Approved:

DEPOSIT, \$10.00 5/26/60

1541

DATE

5/31/60

BY

J. M. Moran

The City of Mountlake Terrace

APPLICATION

CARD No.

SIDE SEWER PERMIT

OUTSIDE INSIDE REPAIRS

EASEMENT No.

Noise

OWNER... Wm. E. Buckholz

HOUSE No. 21706

CONTRACTOR

Owner

PERMIT No. 559

STREET

AVENUE LOT No.


53rd West

BLOCK No.

NAME ADD.

60'

N

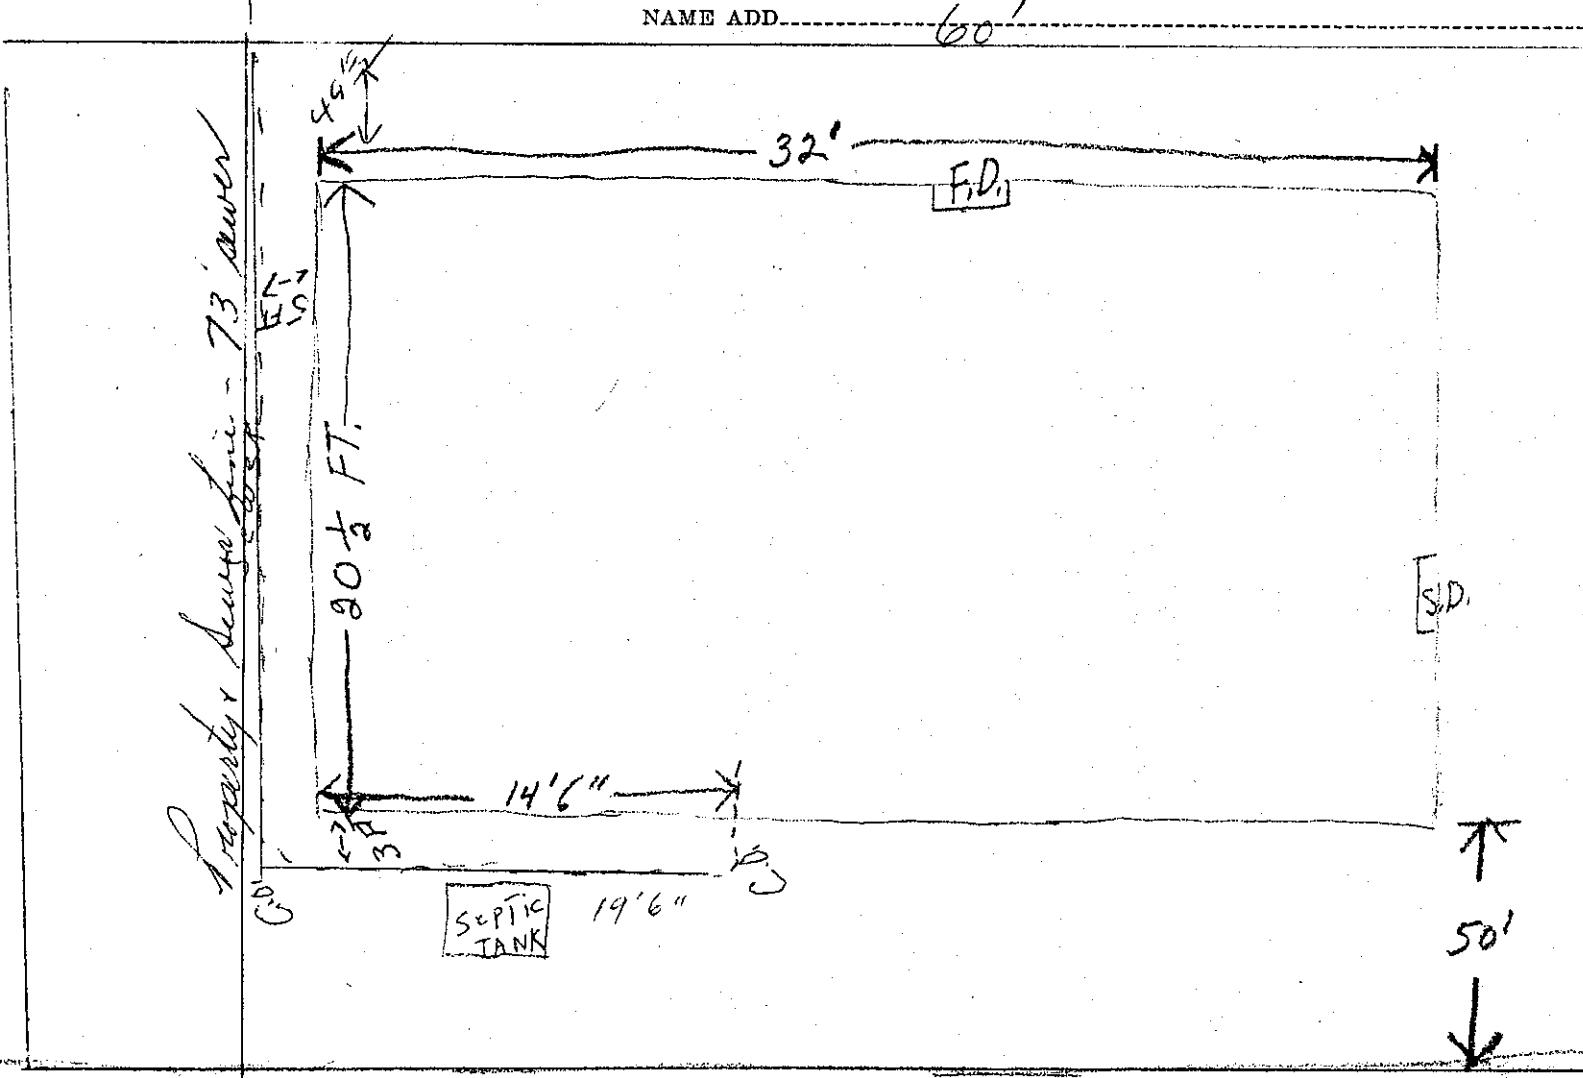

Date

Approved:

BACKFILL WORK ORDER ISSUED
SEWER WORK ORDER ISSUED

DEPOSIT, \$10.00 14/7/60

DATE 11-21-68 BY S. M. Holton

APPLI CATION

CARD No. *V*


The City of Mountlake Terrace

SIDE SEWER PERMIT

OUTSIDE INSIDE REPAIRS EASEMENT No. *1358110*OWNER *G.F. Schefer*HOUSE NO. *21707 - 53rd W.*CONTRACTOR *Wingfield-Brown*PERMIT No. **58*STREET
AVENUE LOT NO. *N $\frac{1}{2}$ of 5 $\frac{1}{2}$ of Lot #5*

BLOCK NO.

NAME ADD.

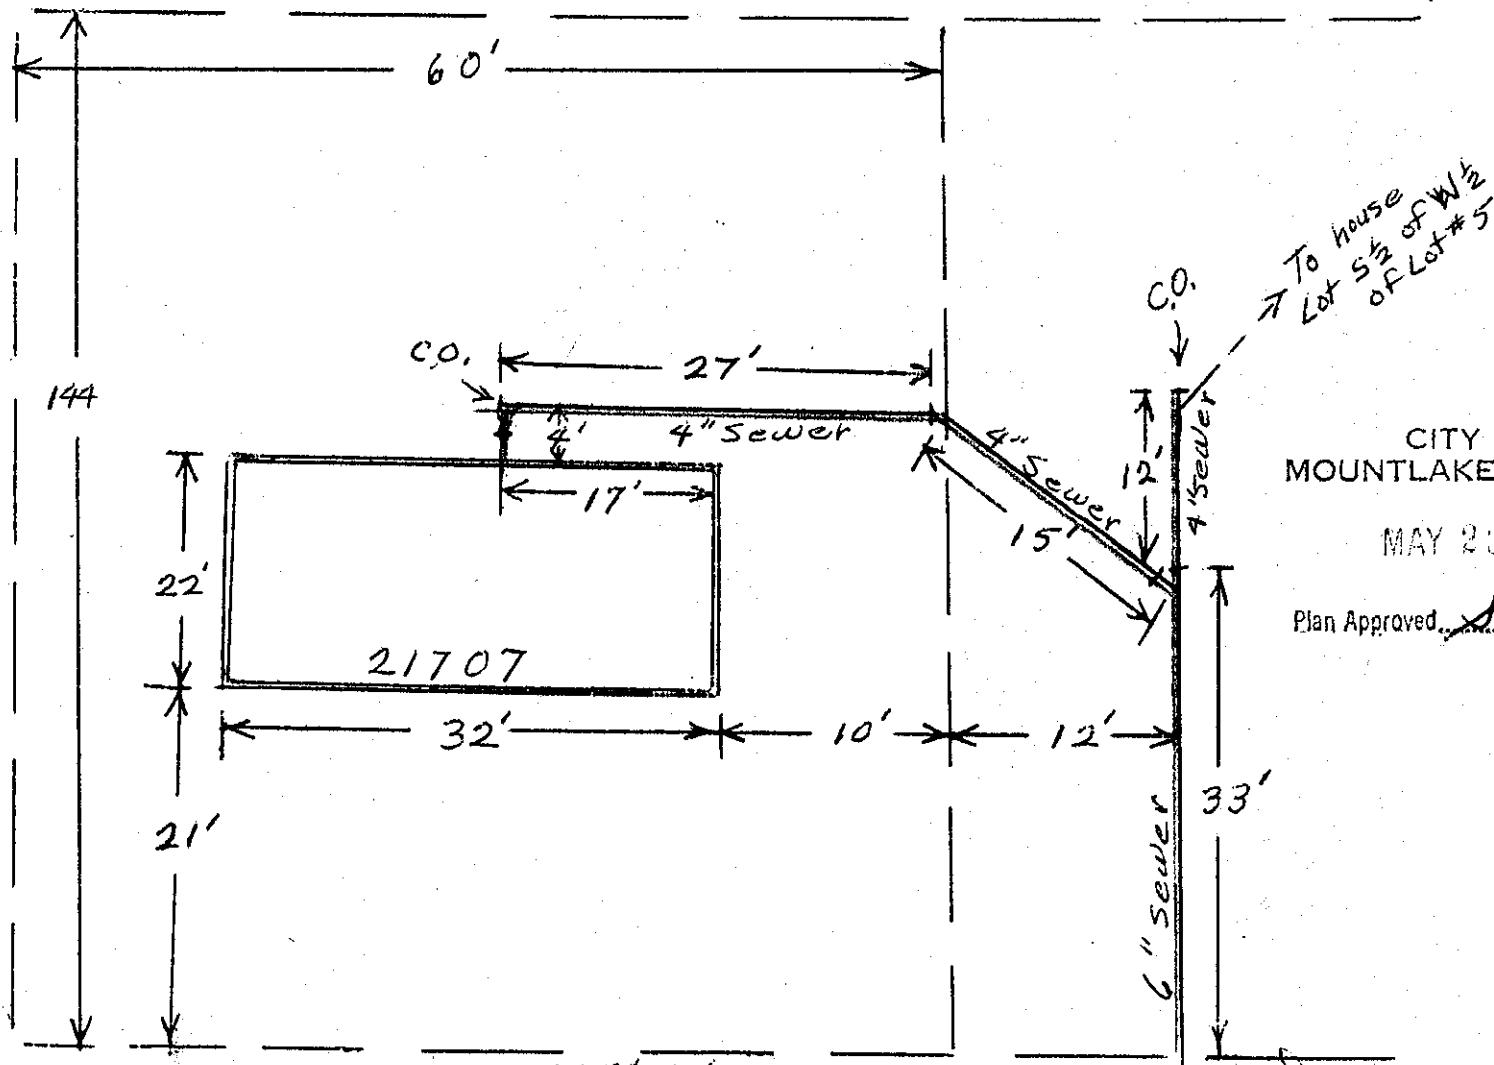Seattle Heights GardensCITY OF
MOUNTLAKE TERRACE

MAY 23 1960

Plan Approved.

*S. McAfee*BACKFILL WORK ORDER ISSUED
SEWER WORK ORDER ISSUED

Date

53rd W.
DEPOSIT, \$10.00

Approved:

Lot Line

1496

DATE *5/23/60*BY *E. M. McAfee*

APPLICATION

TOP

SIDE SEWER PERMIT

OUTSIDE INSIDE REPAIRS

CARD No.

The City of Mountlake Terrace

EASEMENT No. None

~~T.J. FRONT ZON~~OWNER ~~Mark Jones~~HOUSE No. 21801 - 53rd W.

CONTRACTOR

Wing Field

PERMIT No.

446


STREET

AVENUE LOT No. W 90' Trele

BLOCK No.

NAME ADD

Seattle Heights Gardens

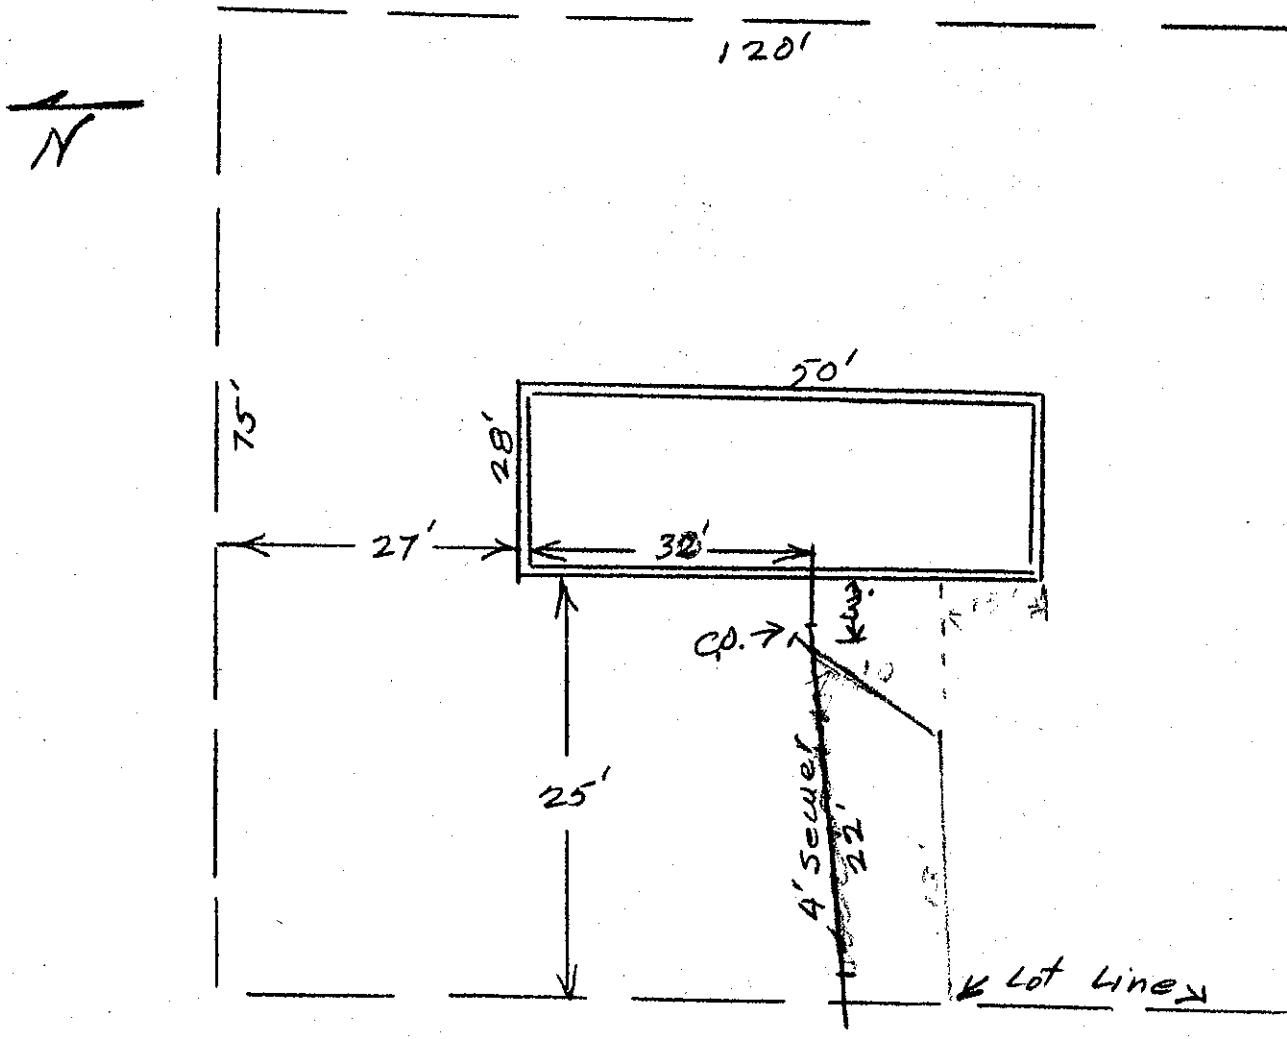

Date

Approved:

BACKFILL WORK ORDER ISSUED

DEPOSIT, \$ 10.00

SEWER WORK ORDER ISSUED

1870

DATE 9-9-60

BY S. M. Holton INSPECTION

9/8/60 BY

9-27-60 INSPECTION

The City of Mountlake Terrace

APPLICATION

CARD No.

SIDE SEWER PERMIT

OUTSIDE INSIDE REPAIRS

EASEMENT No.

OWNER James G. Mariotti

CONTRACTOR Jim Mariotti

PERMIT No. 85

HOUSE No. 21804 W 53rd

STREET


AVENUE LOT No. 14

BLOCK No.

N-E-Corner

NAME ADD. Seattle Height Gardens

LOT LINE

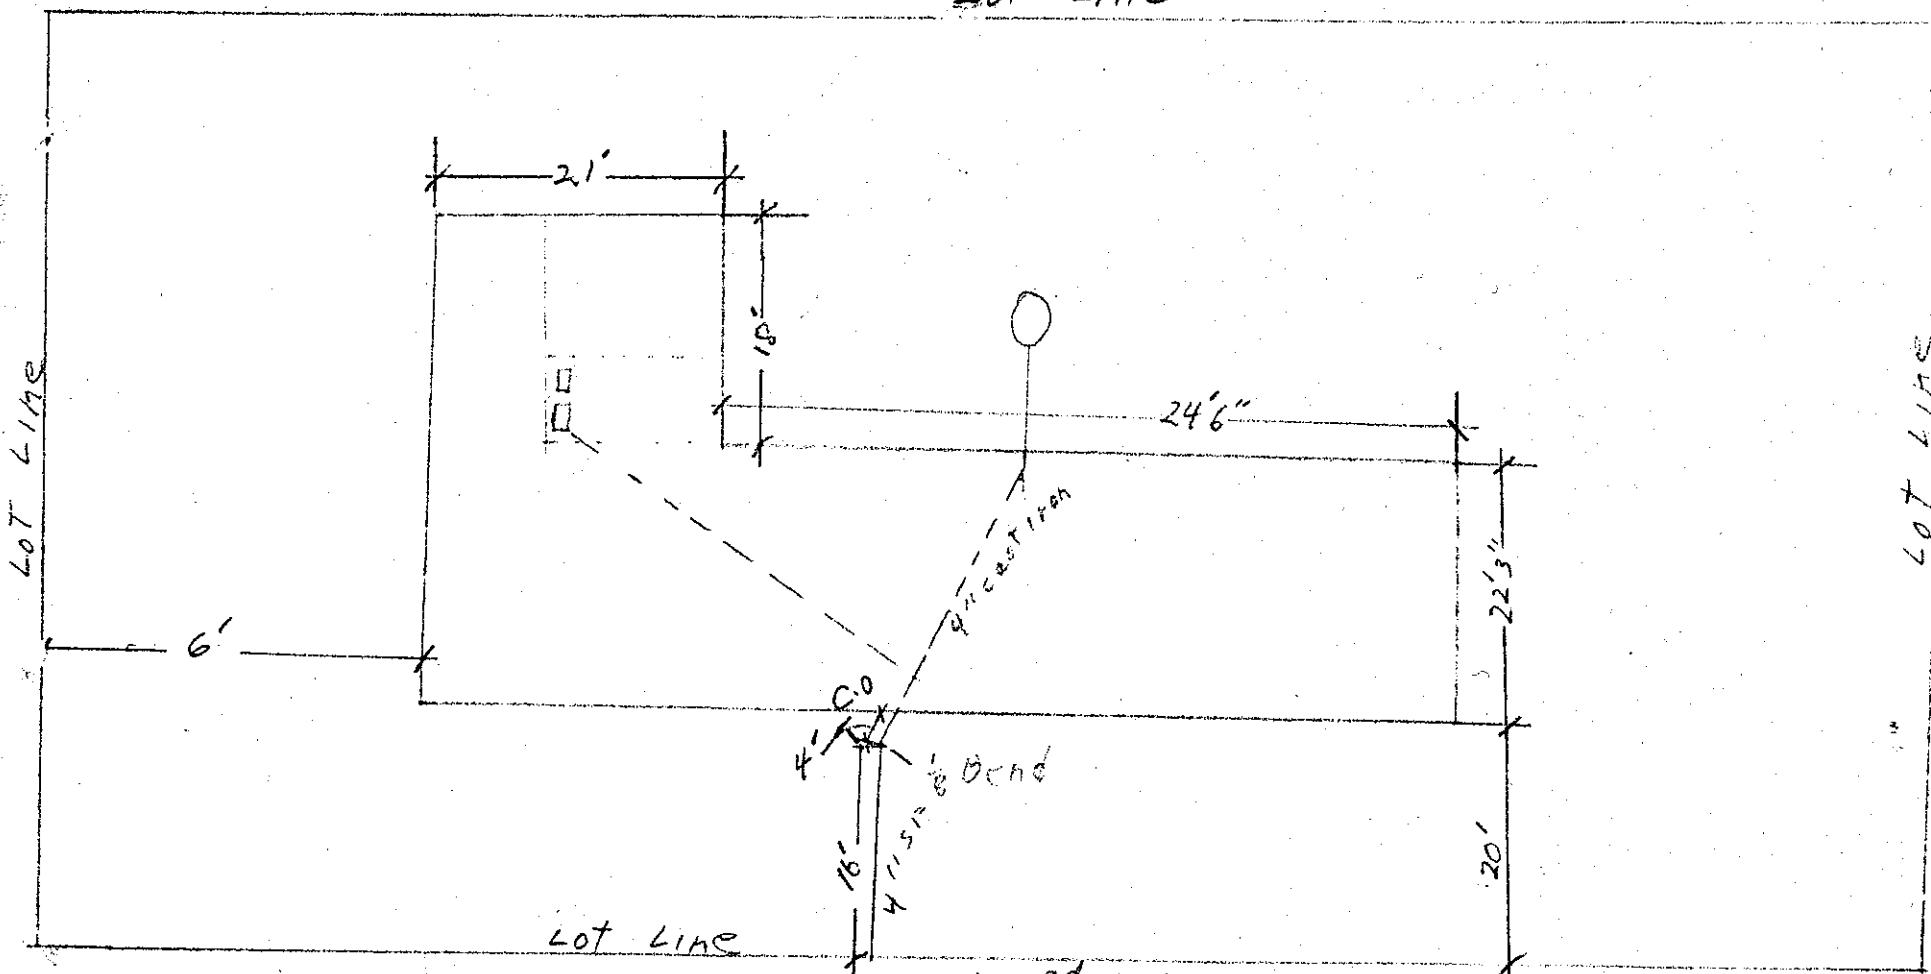

Date

53rd W

Approved:

BACKFILL WORK ORDER ISSUED

DEPOSIT, \$100.00

5/24/60

SEWER WORK ORDER ISSUED

1520

DATE

9-12-60

BY

J.M. Holton INS CON

APPLICATION

The City of Mountlake Terrace

SIDE SEWER PERMIT

OUTSIDE INSIDE REPAIRS

CARD No.

EASEMENT No.

OWNER Mervin R. Dawson
HOUSE No. 21805 - W 53rd

CONTRACTOR self


PERMIT No. 83

STREET
AVENUE LOT No. 7

BLOCK No.

NAME ADD. Seattle Heights Gardens

LOT LINE

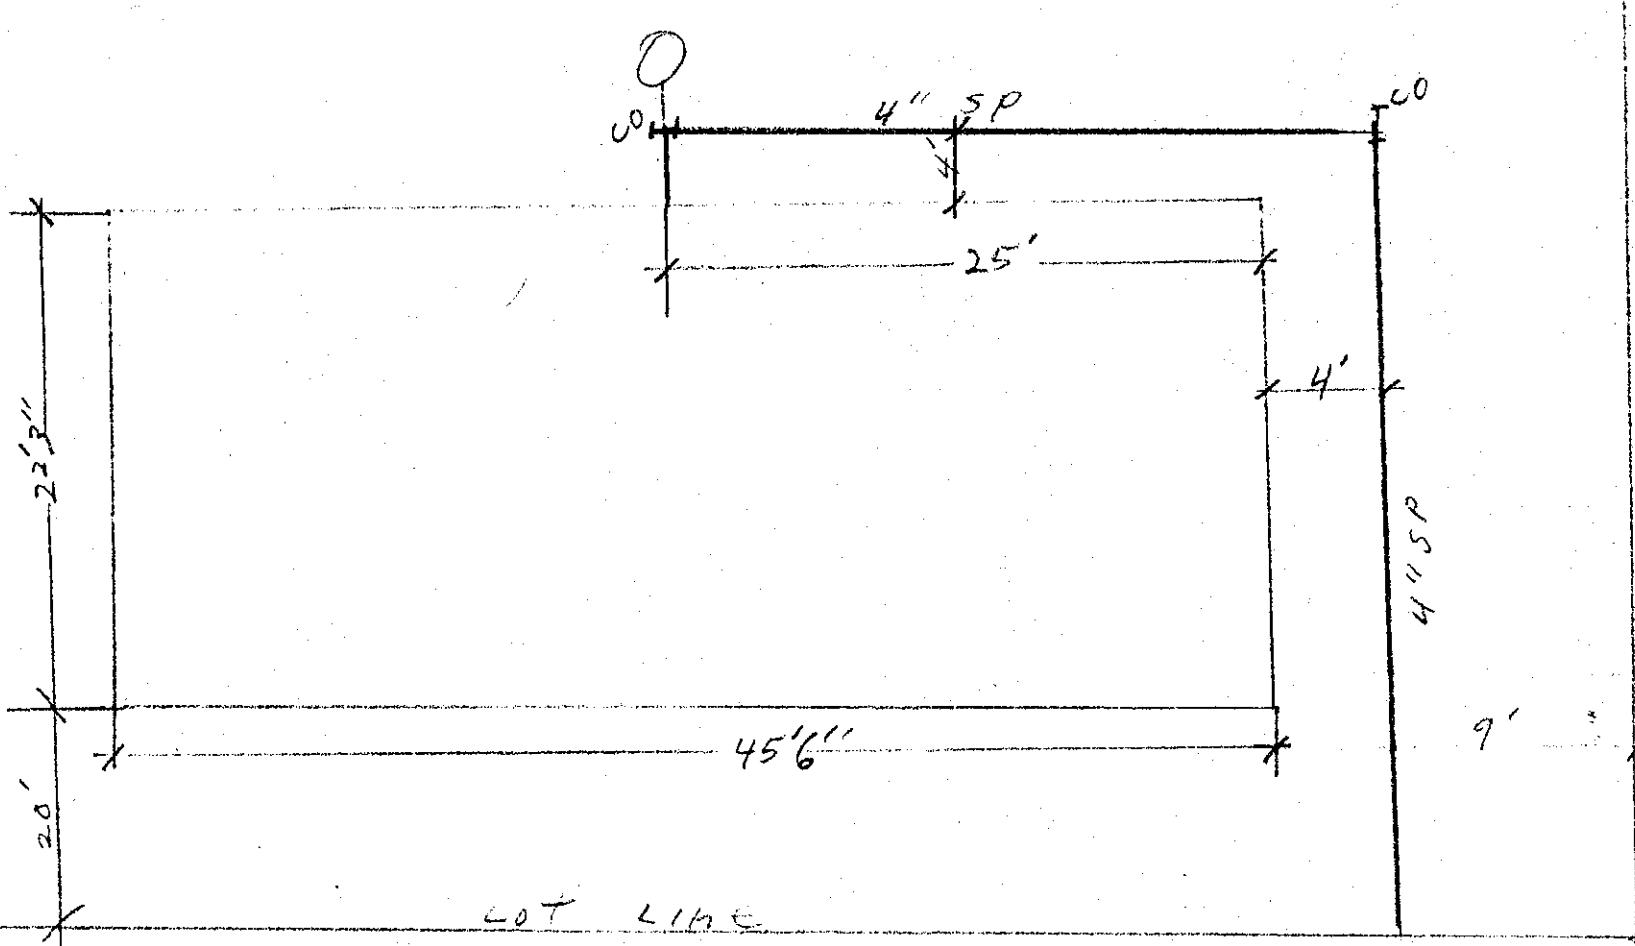

Date

Approved:

BACKFILL WORK ORDER ISSUED
SEWER WORK ORDER ISSUEDDEPOSIT, \$10.00 8/24/60
1520

DATE

8-30-60 BY S. M. Holton NS CON

APPLICATION

W. E. DUNN
CARD No.

The City of Mountlake Terrace

G.C. DILLON

OWNER G. C. DILLONHOUSE NO. 21806 - 53rd WEST

SIDE SEWER PERMIT

OUTSIDE INSIDE REPAIRS

EASEMENT No.

PERMIT No. 2497

CONTRACTOR SELF


STREET

AVENUE LOT No. 1st Str of Lot 14

BLOCK No.

NAME ADD. Seattle Heights Garden

LOT LINE

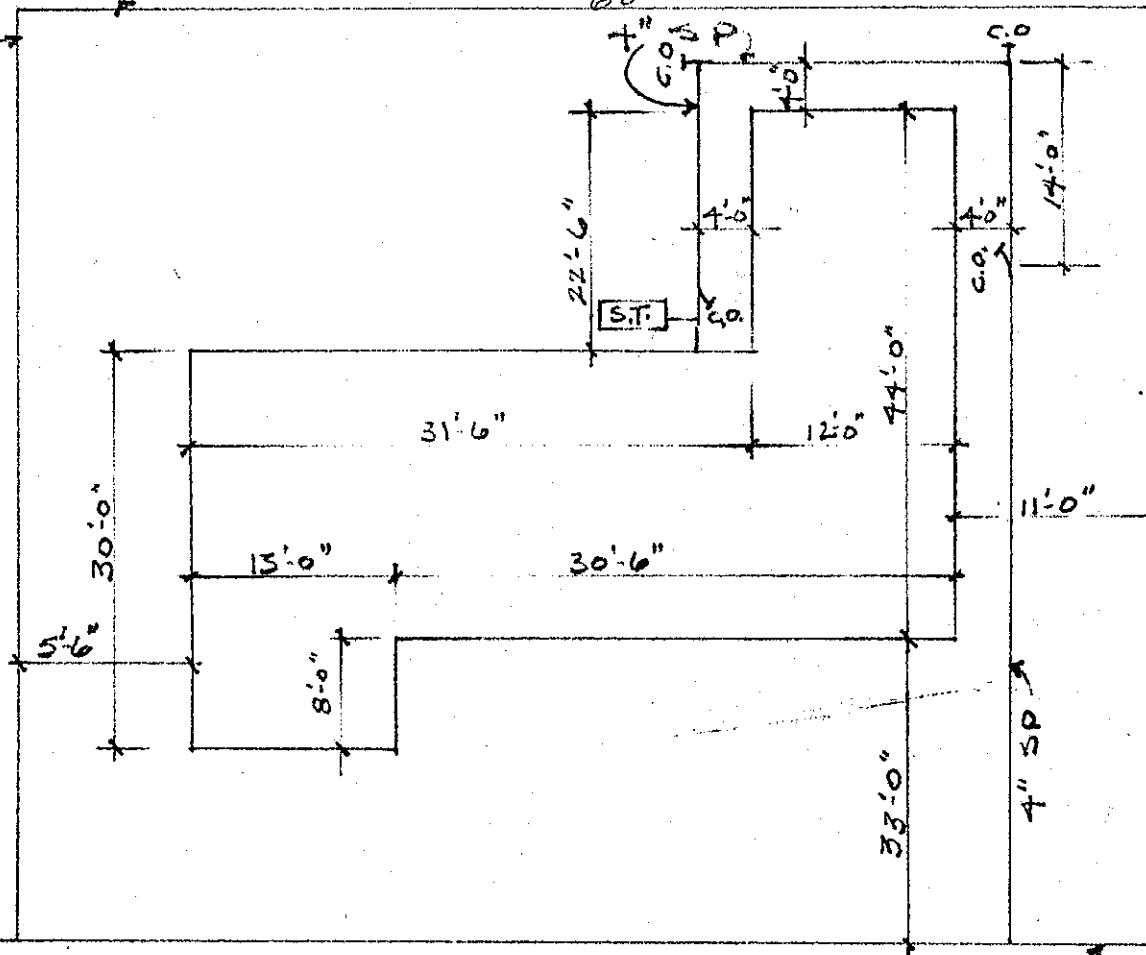CITY OF
MOUNTLAKE TERRACE

APR 26 1960

Plan Approved S. M. Ahern

Date

Approved:

BACKFILL WORK ORDER ISSUED

DEPOSIT, \$10.00

SEWER WORK ORDER ISSUED

rec'd #1284
Dene Freeman

DATE 4-26-60

BY S. M. Holton INSPECTOR

P.C.

APPLICATION

SIDE SEWER PERMIT

The City of Mountlake Terrace

CARD No.

OUTSIDE INSIDE REPAIRS

EASEMENT No.

OWNER Edgar Straight
HOUSE No. 21807 - 53rd W.

CONTRACTOR Self

PERMIT No.


STREET
AVENUE LOT NO.

7

BLOCK No.

NAME ADD. Seattle Heights Gardens

LOT LINE

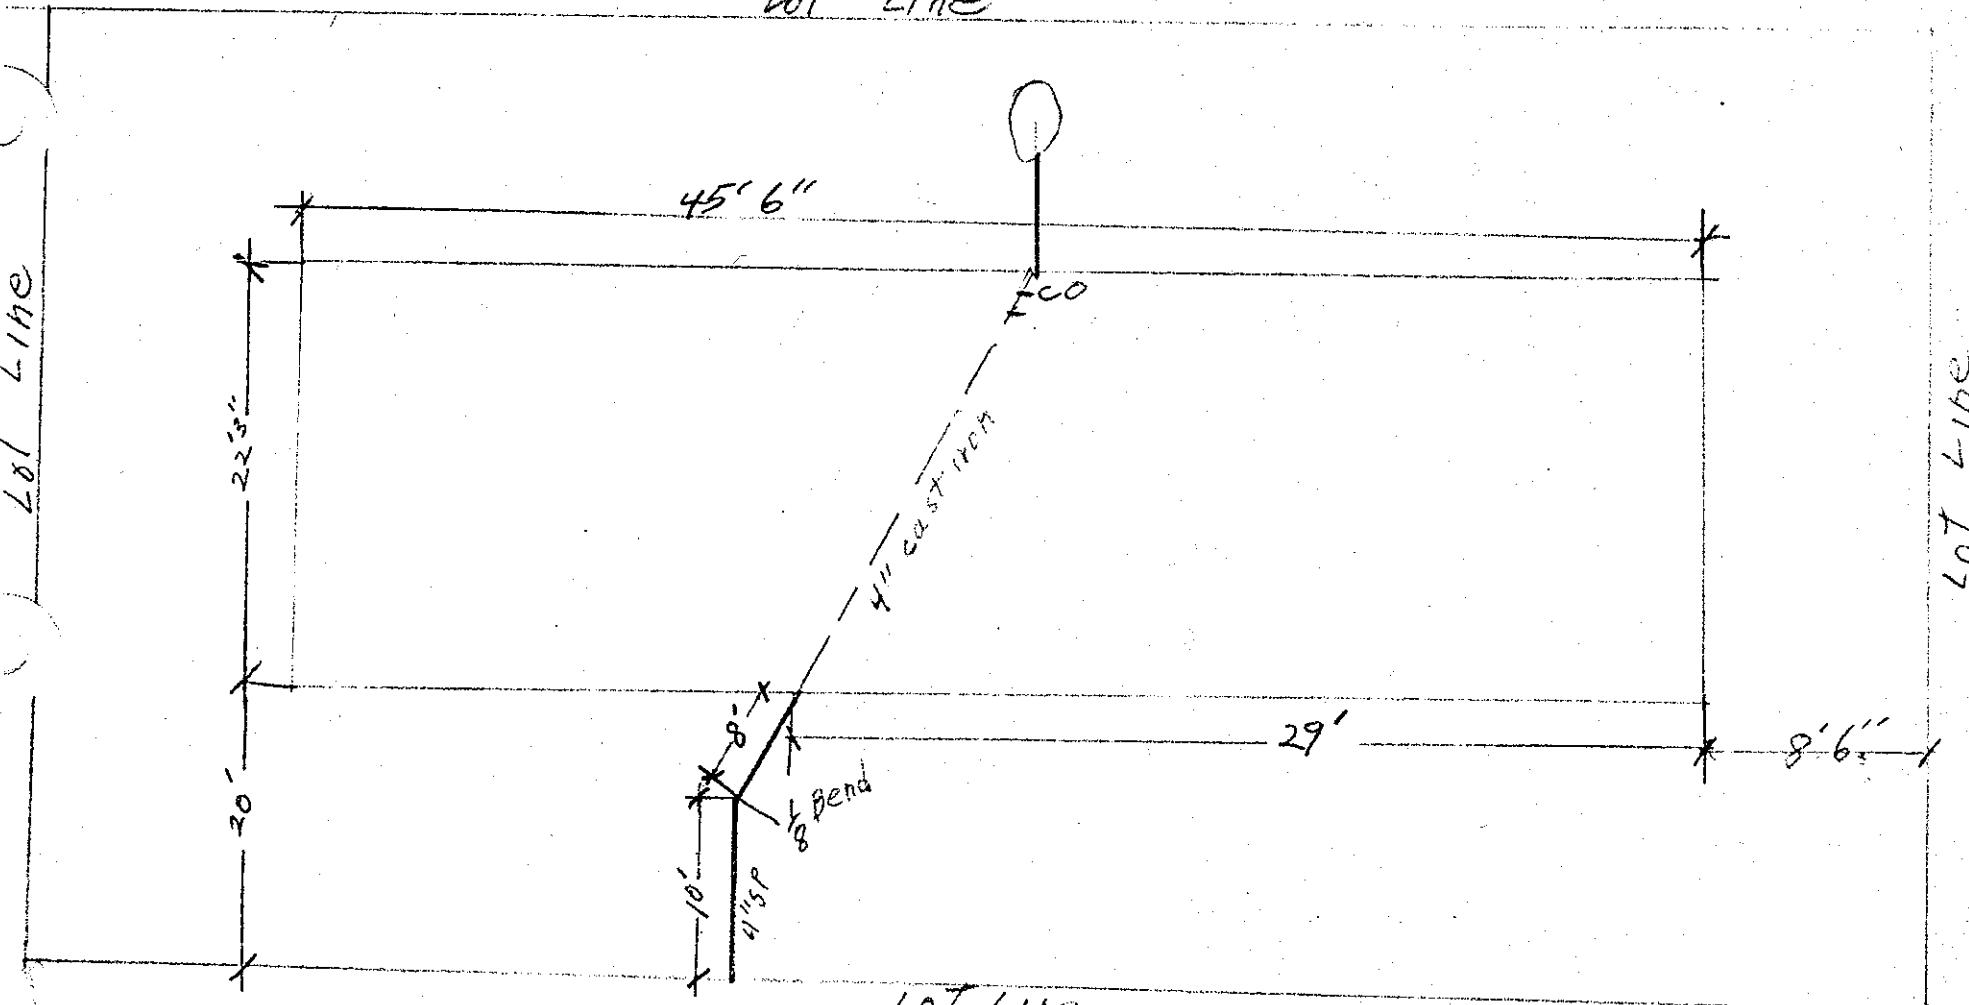

Date

Approved:

BACKFILL WORK ORDER ISSUED

DEPOSIT, \$10.00 5/24/60

SEWER WORK ORDER ISSUED

1520

DATE 8-5-60 BY S. M. Moller MSTRCO

The City of Mountlake Terrace

APPLICATION

FOR

SIDE SEWER PERMIT

OUTSIDE INSIDE REPAIRS

CARD No.

EASEMENT No. None

OWNER Caroline Barnes
HOUSE No. 21507 - 53 W. M.L.T.


CONTRACTOR B. & E.

PERMIT No. 1258

STREET N.E. 1/2 LOT 13
AVENUE LOT No. NE 1/2 LOT 13

BLOCK No.

NAME ADD Seattle Heights gardens

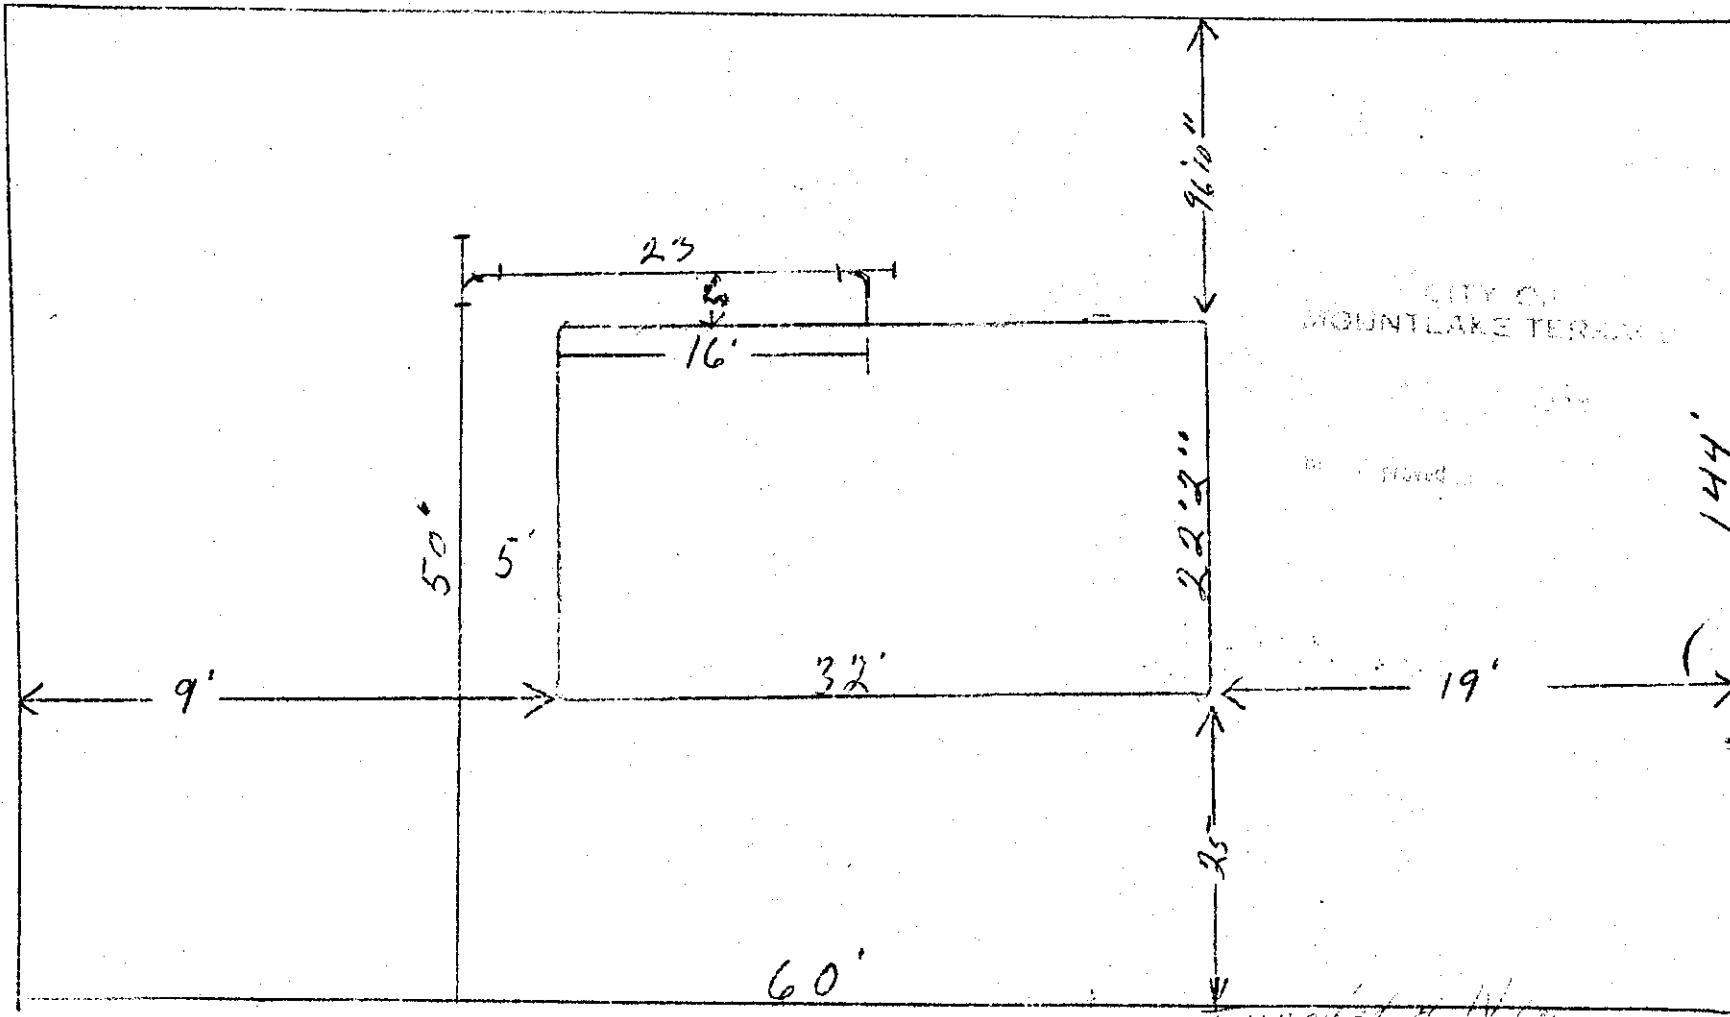

Date

BACKFILL WORK ORDER ISSUED
SEWER WORK ORDER ISSUED

DEPOSIT, \$

10.00
#6418

Approved:

12/3/59

DATE

BY

B. & E.
12/1/59 D 7 past 3-30-60 IN SIGHT SMH

APPLICATION

CARD No. *CV*

The City of Mountlake Terrace

SIDE SEWER PERMIT

OUTSIDE INSIDE REPAIRS EASEMENT No. *Zone*

OWNER LEE Roy VAUGHN

HOUSE No. 21809 53 W.

CONTRACTOR B & M

PERMIT No. 1404

STREET


AVENUE LOT No. NORTH 1/2 OF WEST 1/2 OF LOT 8

BLOCK No.

NAME ADD

600.6

SEATTLE Heights Garden

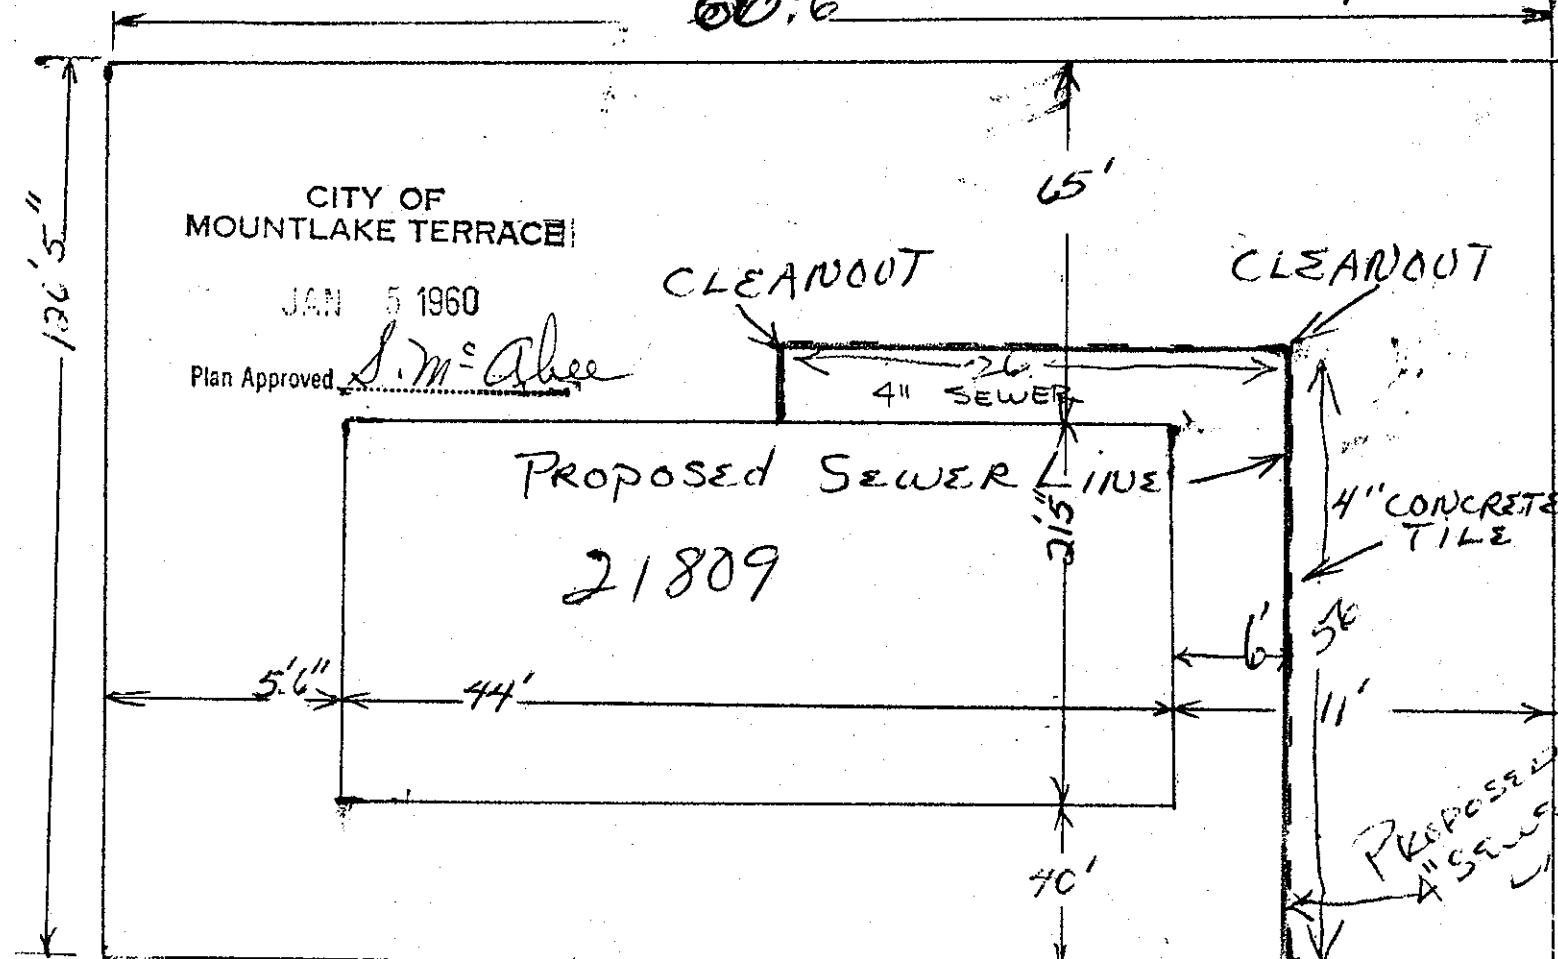

Date

Approved:

BACKFILL WORK ORDER ISSUED
SEWER WORK ORDER ISSUEDDEPOSIT, \$10 *12-30-59*

5649 DATE.

1/5/60

BY

B. Plautz

APPLICATION

CARD No.

The City of Mountlake Terrace

SIDE SEWER PERMIT

OUTSIDE INSIDE REPAIRS

EASEMENT No. 1349459


OWNER Russell J. Freehous
HOUSE No. 2190A - W. 53

CONTRACTOR same

PERMIT No. 2379

STREET AVENUE LOT No. 132 E. Little Gardens BLOCK No. 2190.0

NAME ADD.

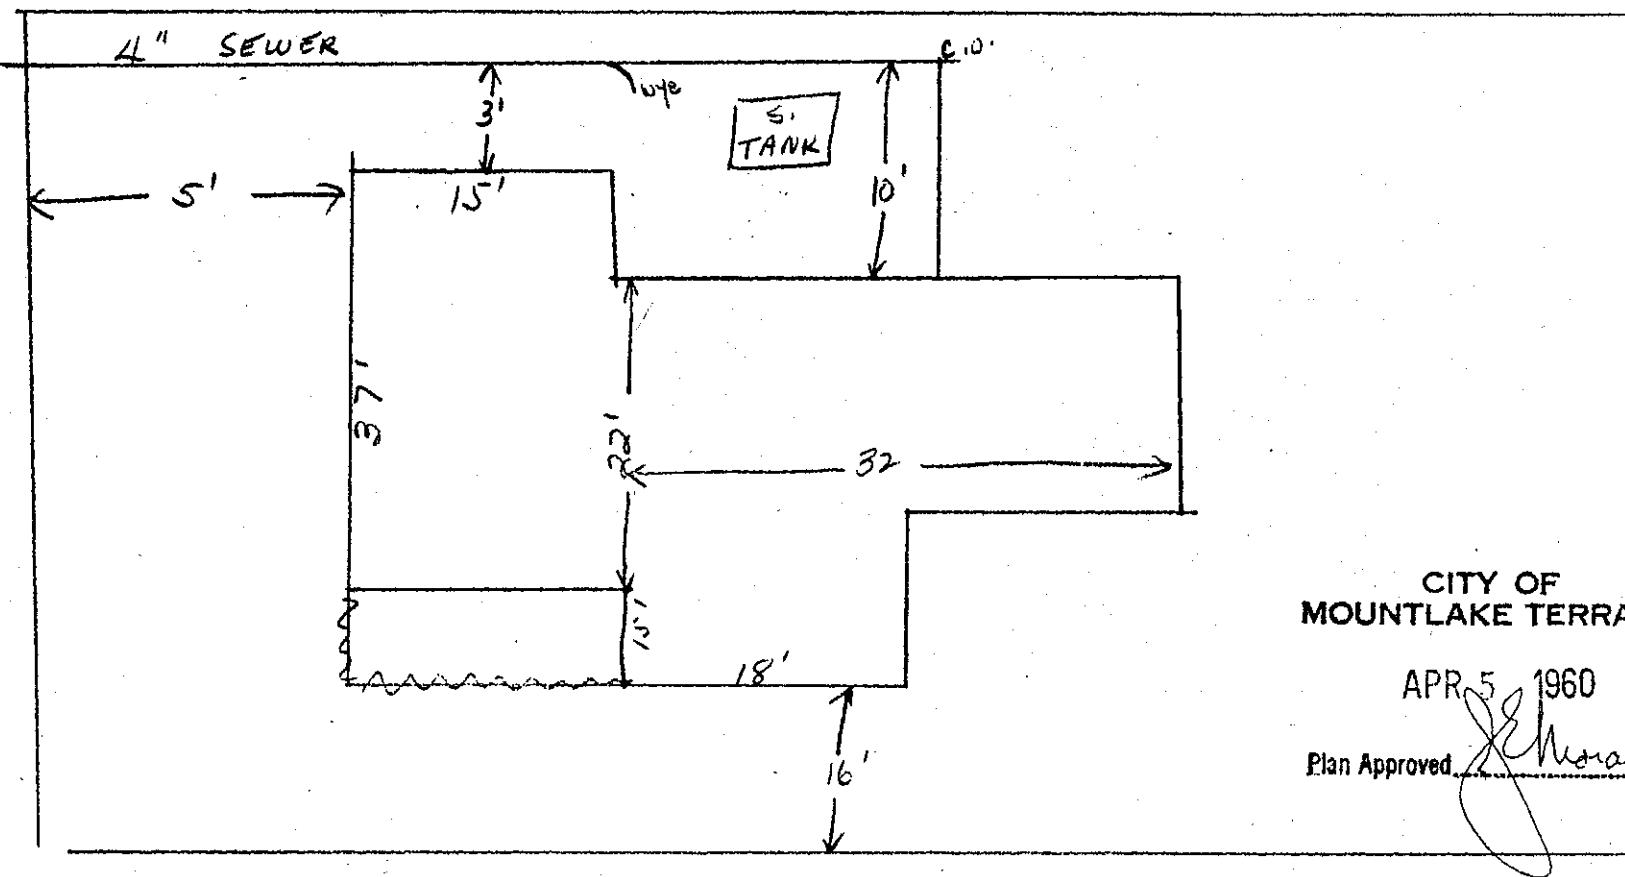

Date

Approved:

BACKFILL WORK ORDER ISSUED

DEPOSIT, \$

SEWER WORK ORDER ISSUED

10.00 4/1/60 DATE 4/5/60

BY

1161

[Signature]

The City of Mountlake Terrace

APPLICATION

SIDE SEWER PERMIT

OUTSIDE INSIDE REPAIRS

CARD No.

1356576

EASEMENT NO. 25676

OWNER E. L. KALAR

HOUSE No. 21901 - 53 W.


CONTRACTOR Top Notch Plumbing PERMIT No. 1323

STREET

AVENUE LOT No.

BLOCK No.

NAME ADD. S 1/2 OF LOT 8 SENTINEL HEIGHTS GARDEN VOL. 9 PG. 10 OF PLATS

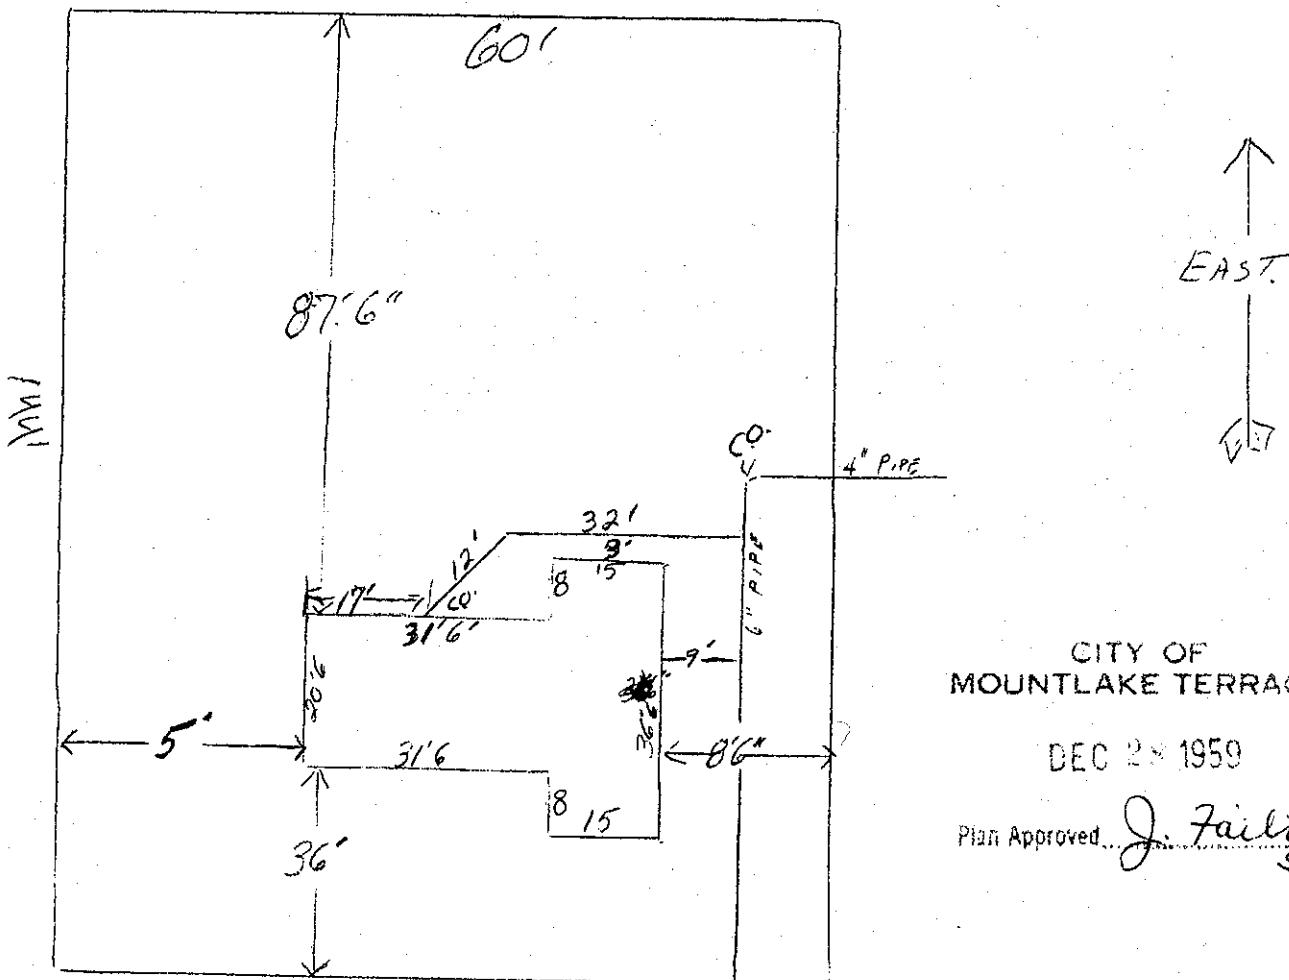

CITY OF
MOUNTLAKE TERRACE

DEC 28 1959

Plan Approved. J. Fairlie
SM

Date

BACKFILL WORK ORDER ISSUED

DEPOSIT, \$10⁰⁰

Approved:

Prepared 9-10-59

SEWER WORK ORDER ISSUED

4448 DATE

BY

et

3-1-60 M/S+C of 8m H

APPLICATION

The City of Mountlake Terrace

SIDE SEWER PERMIT

OUTSIDE INSIDE REPAIRS

CARD No.

EASEMENT No. 1249459

OWNER: Long & Clark
HOUSE No. 21902 West 53


CONTRACTOR

STREET
AVENUE LOT NO.

PERMIT NO. 2123

BLOCK No.

SEATTLE Heights Gardens

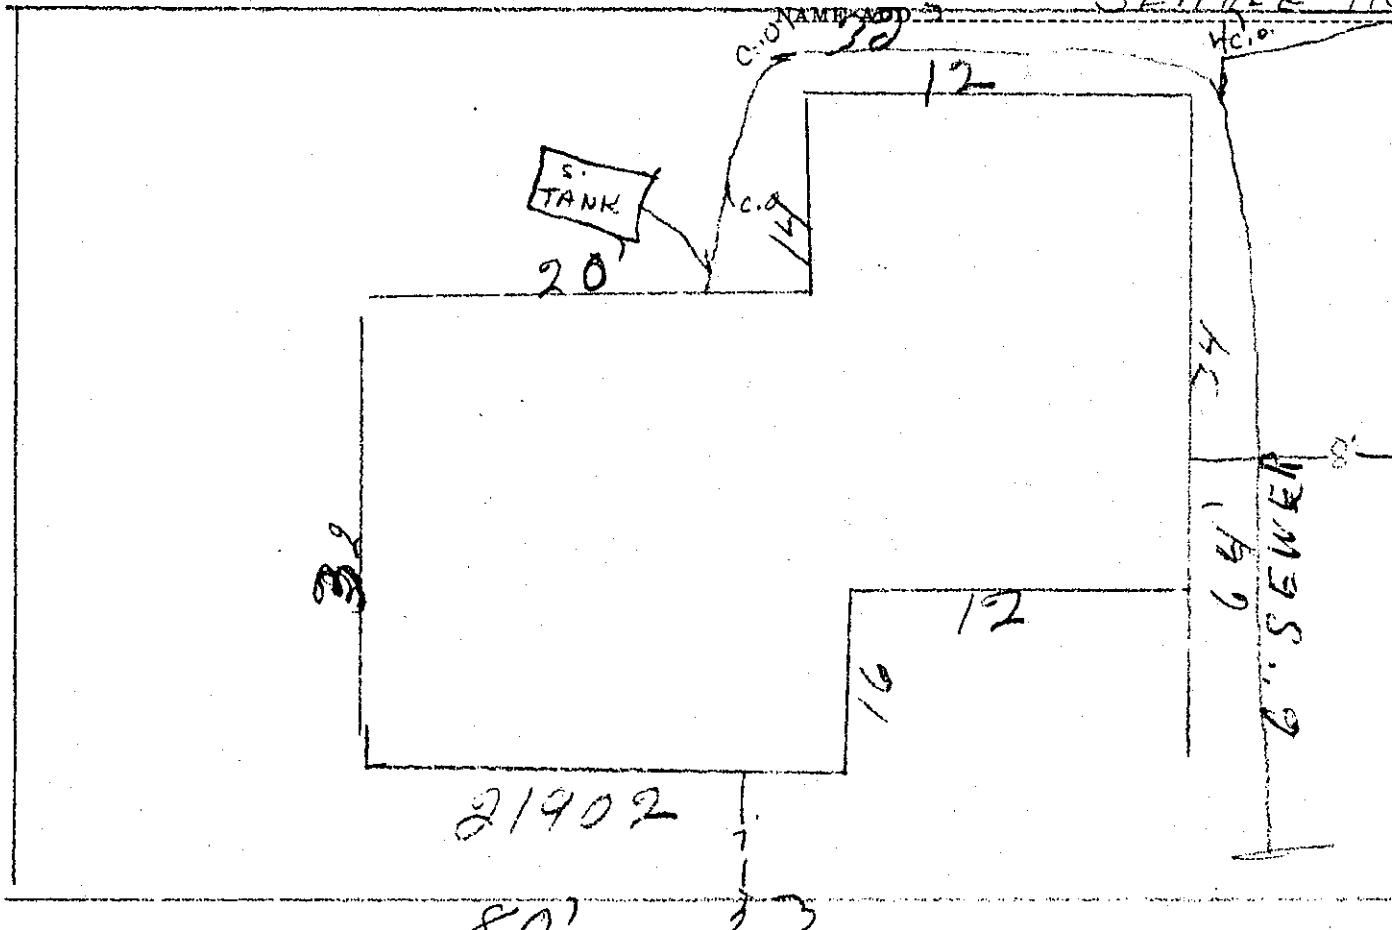CITY OF
MOUNTLAKE TERRACE

MAR 28 1960

Plan Approved.

Date

BACKFILL WORK ORDER ISSUED

DEPOSIT, \$10.00 Approved: 3/22/60

SAW WORK ORDER ISSUED

DATE 3-28-60 BY Scott M. Holton 115-600

The City of Mountlake Terrace

APPLICATION

FOR

SIDE SEWER PERMIT

OUTSIDE INSIDE REPAIRS

B. F. LARK
CARD No.

EASEMENT No. 1356576

OWNER B. F. LARK

HOUSE No. 21903-53.W.

CONTRACTOR Tap Natch Plumbing


PERMIT No. 1325

STREET

AVENUE LOT No.

BLOCK No.

NAME ADD. N 1/2 E LAT 9. SEC THE Hedges GARDEN VOL 9 Pg 16 of PLAT

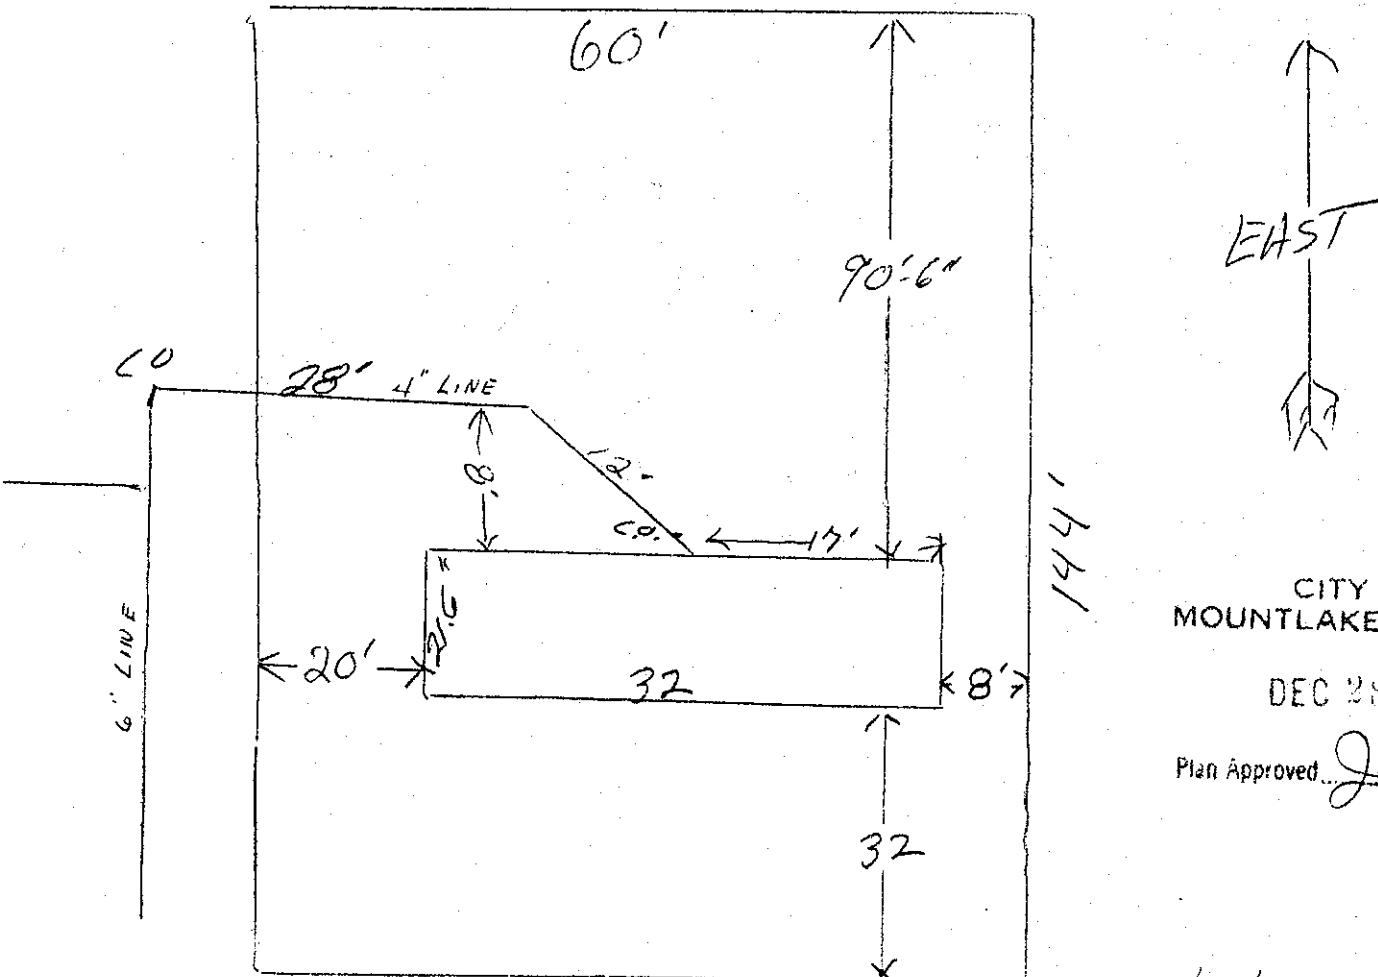

BACKFILL WORK ORDER ISSUED
SEWER WORK ORDER ISSUED

Date

DEPOSIT, \$10.00 12-11-59

Approved:

Inspected

5548 et

DATE 12/28/59 BY Ed. J. Lark

3-1-60 INST CON 8 mth.

APPLICATION

The City of Mountlake Terrace

CARD No.

SIDE SEWER PERMIT

OUTSIDE INSIDE REPAIRS

EASEMENT No. 1379-510

OWNER Mrs. Ladie Shaw
HOUSE No. 21905 53W

CONTRACTOR Evergreen Const.


PERMIT No. 1526

STREET

AVENUE LOT NO. 6, half of W. half of lot #9

BLOCK NO.

NAME ADD Seattle Heights Gardens

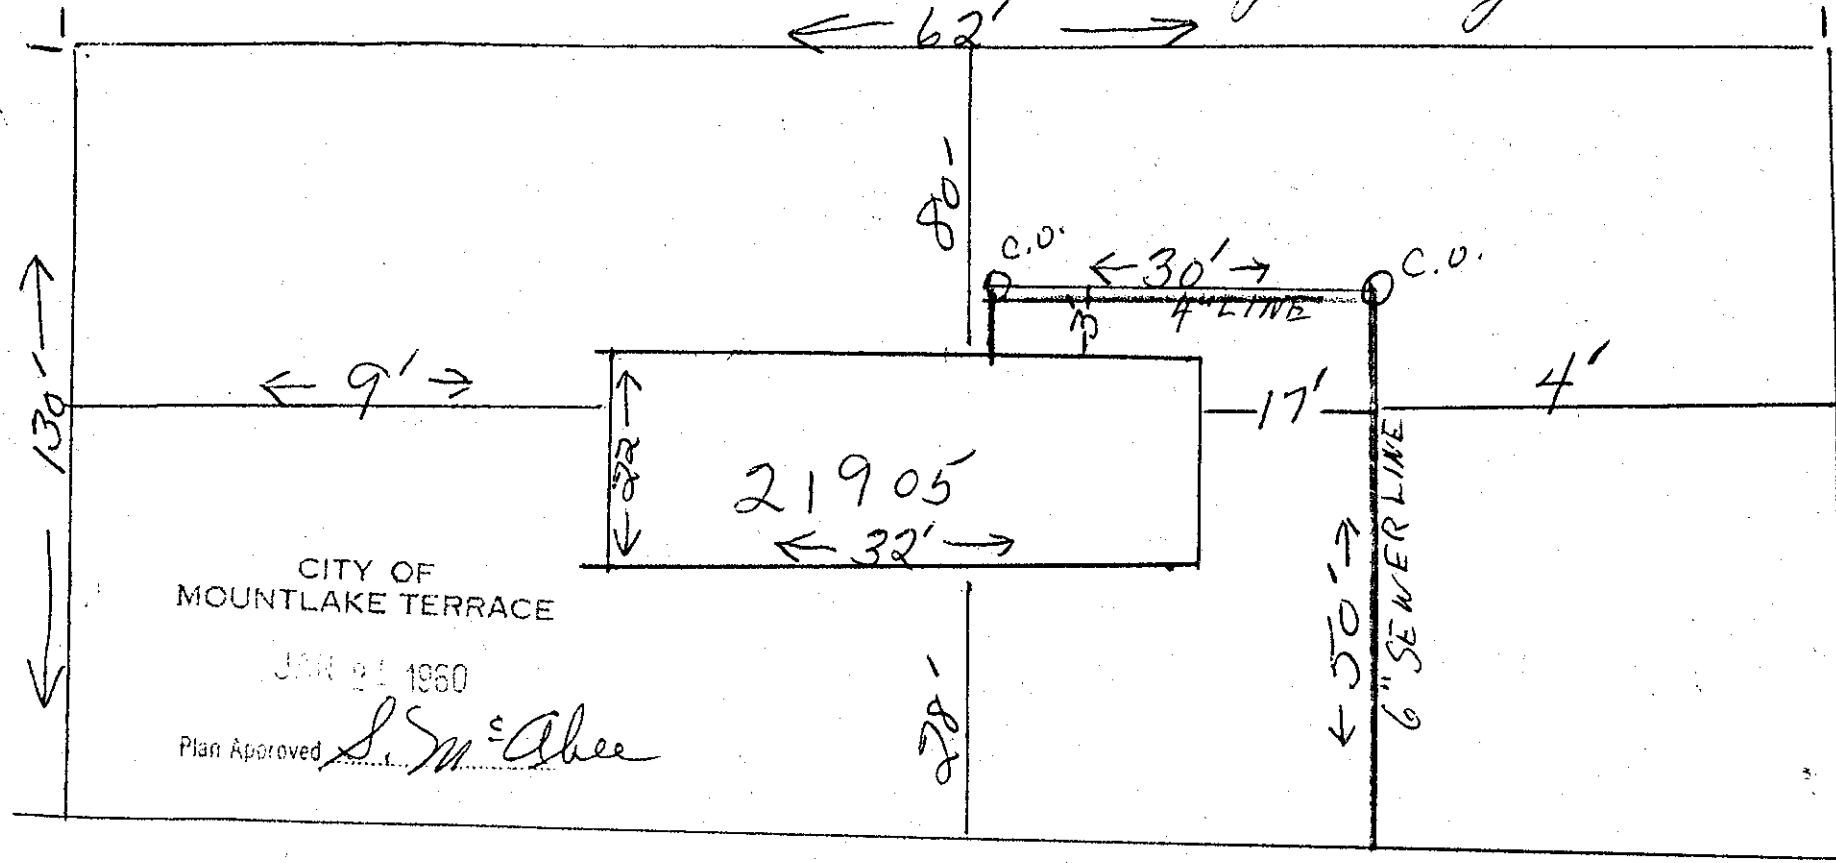CITY OF
MOUNTLAKE TERRACE

JAN 21 1960

Plan Approved

S. M. Ghee

← 53 W →

Date

Approved:

BACKFILL WORK ORDER ISSUED
SEWER WORK ORDER ISSUEDDEPOSIT, \$10⁰⁰
1-20-60
5816

DATE 1-21-60 BY

1-21-60 Scott M Holton INST INC

APPLICATION

CHARLOTTE
C. J. Johnson
CARD No.

The City of Mountlake Terrace

Charlotte

SIDE SEWER PERMIT

OUTSIDE INSIDE REPAIRS

EASEMENT NO.

1379510

OWNER Mrs. S. Fredrickson
HOUSE No. 21907

CONTRACTOR Evergreen Const.

PERMIT NO.

53 W


STREET

AVENUE LOT NO. N. Hill of Weatherby lot #10

BLOCK NO.

NAME ADD.

Seattle Heights Gardens

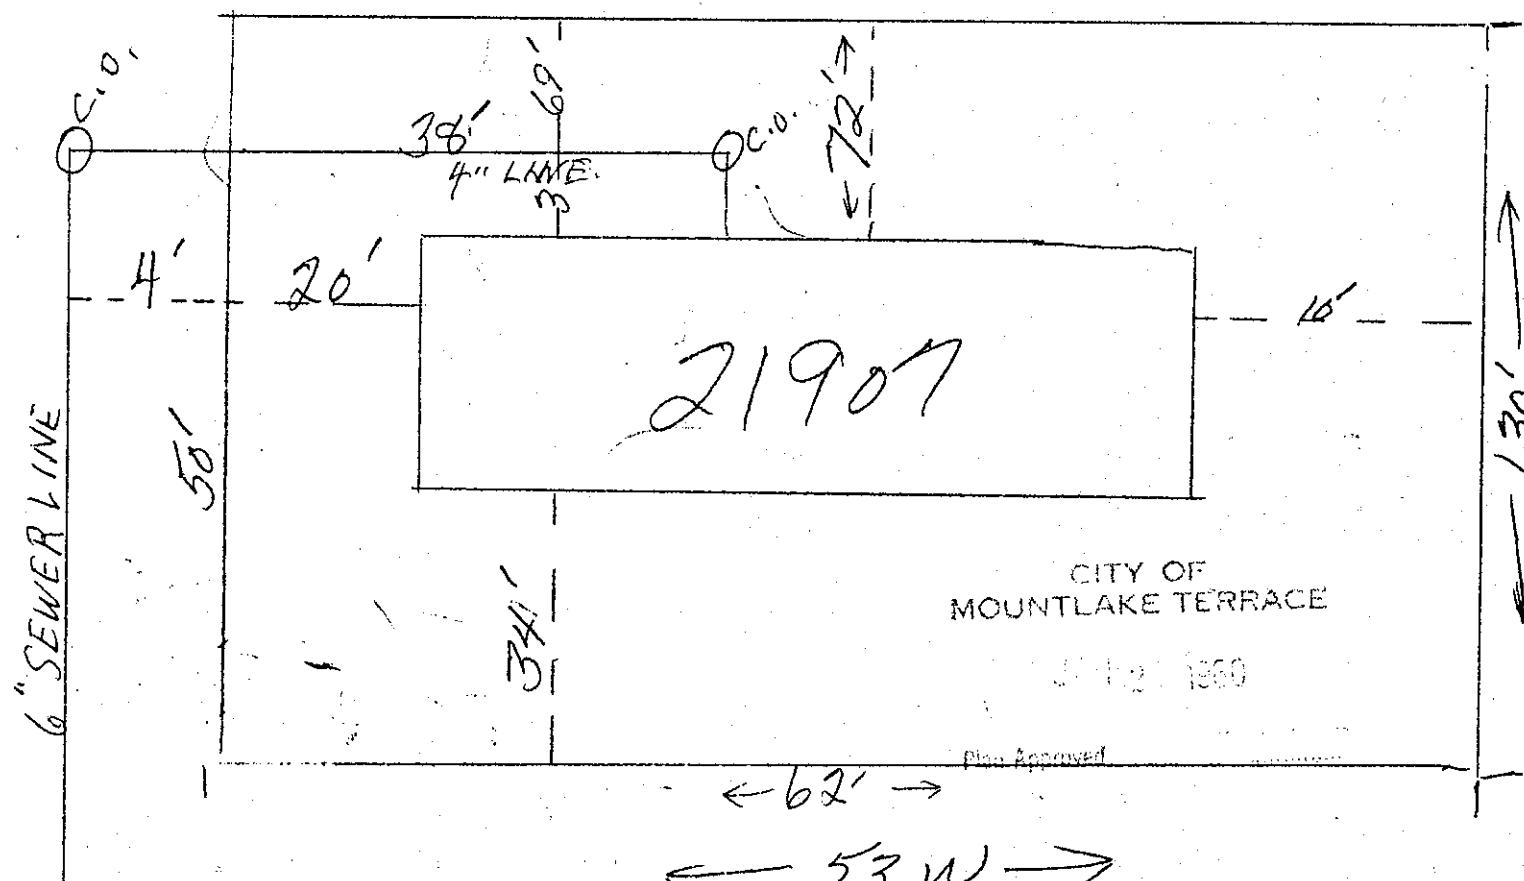

Date

Approved:

BACKFILL WORK ORDER ISSUED
SEWER WORK ORDER ISSUED

DEPOSIT, \$10.00

1-20-60

5817

DAN

J. J. Conn.
3/14/60

1-21-60 Scott & Holton INSTALLED

APPLICATION

The City of Mountlake Terrace

W. O. LANDIN

CARD No.

SIDE SEWER PERMIT

OUTSIDE INSIDE REPAIRS

EASEMENT No.

OWNER William O. Landin

HOUSE No. 2210 E - 53 Ave W

CONTRACTOR

PERMIT No. 2088

STREET
AVENUE LOT No.

2


BLOCK No.

2

NAME ADD. Morrison's Ace Tractor

North

53 Ave W

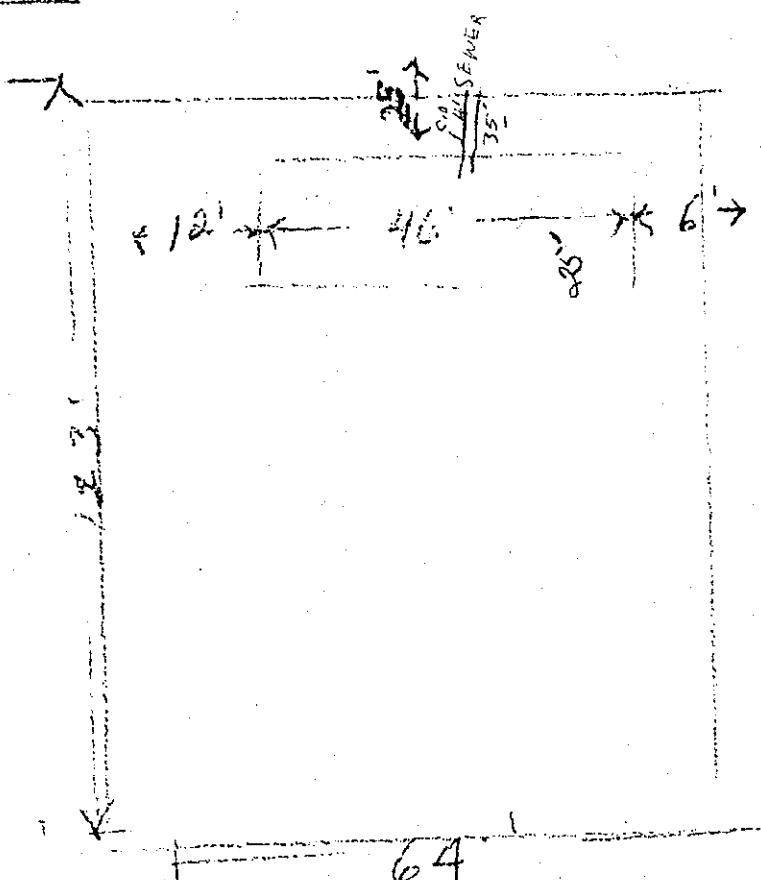

North 64' of So 190'
of the East 1/2 of lot 2
Block 2 Morrison's Ace
Tractor

CITY OF
MOUNTLAKE TERRACE

MAR 23 1960

Plan Approved

Date

BACKFILL WORK ORDER ISSUED
SEWER WORK ORDER ISSUED

DEPOSIT, \$10.00

Approved:

3/21/60

926

DATE 3-23-60

BY Scott M Holton, Inspector

The City of Mountlake Terrace

APPLICATION

K. G. Heit
CARD No.

SIDE SEWER PERMIT

OUTSIDE INSIDE REPAIRS

EASEMENT No.

1387376

OWNER... Kenneth Q. Heidt
HOUSE No. 22103 53rd W.

CONTRACTOR

Top Notch Plumbing PERMIT No. 2638


STREET
AVENUE LOT No.

40

BLOCK No.

NAME ADD.

M.L.T. #22

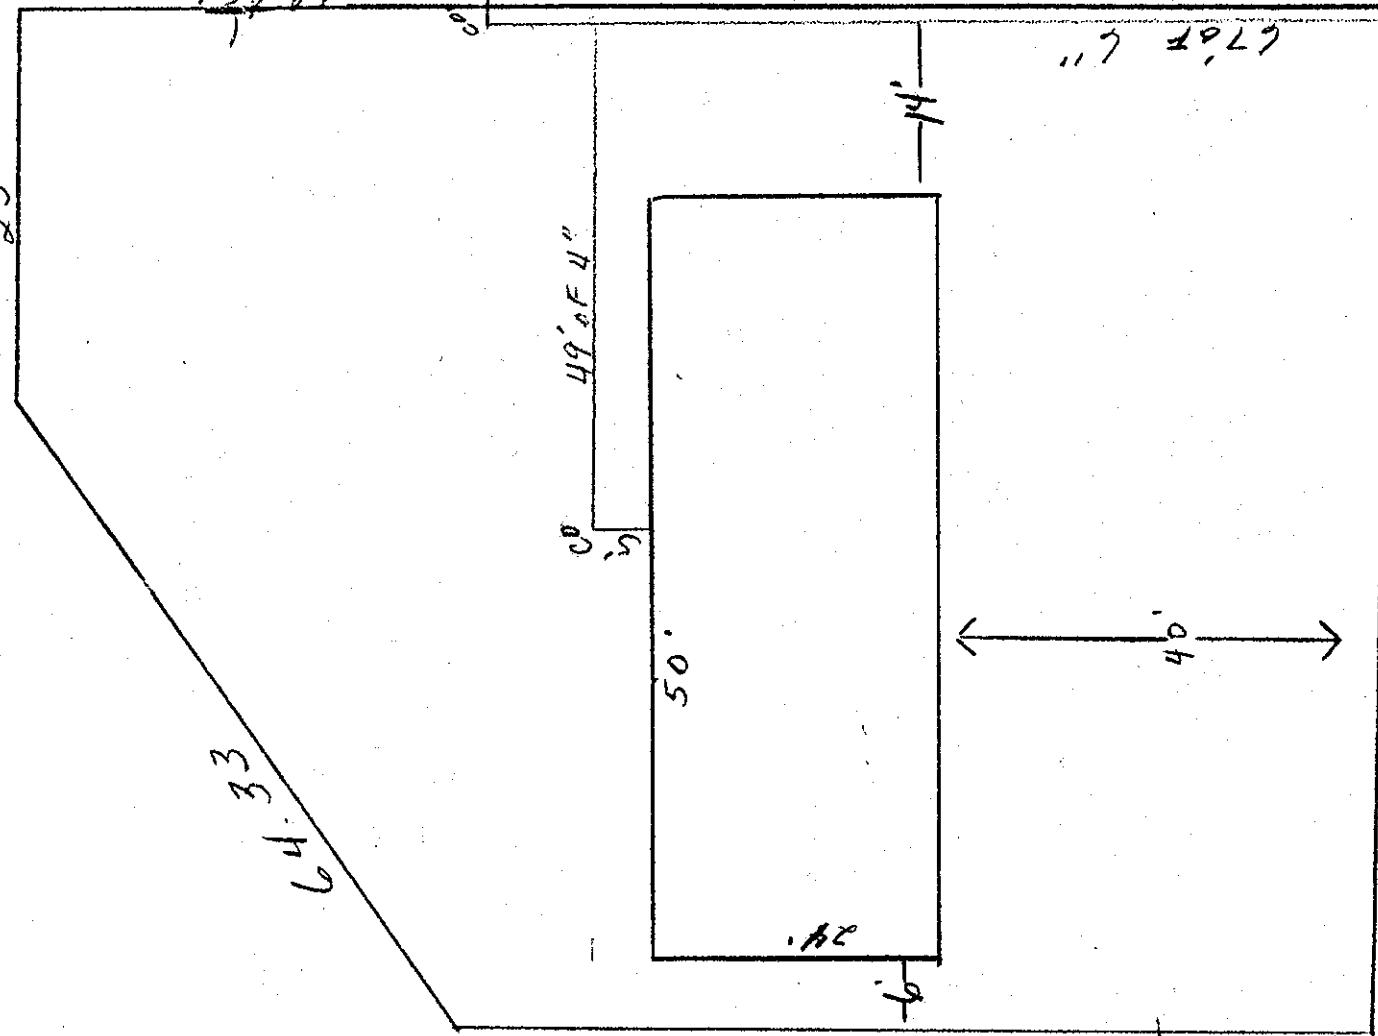

Date

Approved:

BACKFILL WORK ORDER ISSUED
SEWER WORK ORDER ISSUED

DEPOSIT \$10.00 857/60

1418

DATE 5-10-60

BY

J. M. Holton INST CON

APPLICATION

SIDE SEWER PERMIT

The City of Mountlake Terrace

CARD No.

OUTSIDE INSIDE REPAIRS

EASEMENT No.....

OWNER HERBERT DIEBERT
HOUSE No. 22104 53 W.

CONTRACTOR E E OLELS


PERMIT No. 2711

STREET

AVENUE LOT No.

BLOCK No.

NAME ADD. Blk 8 1/2 Lot 2 Blk 2, Morrison Ave Ter.

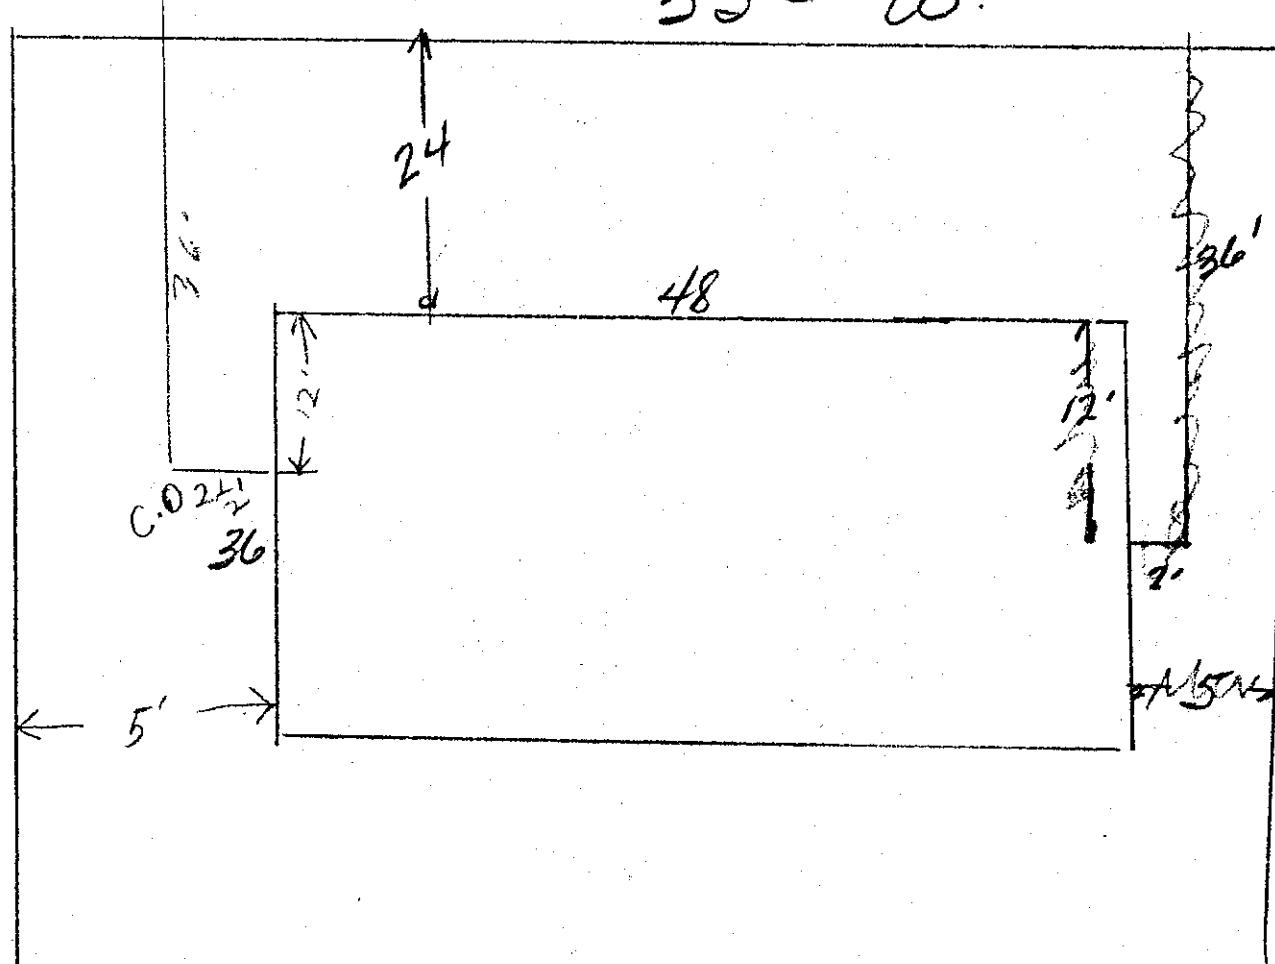53RD W.

Date

Approved:

BACKFILL WORK ORDER ISSUED
SEWER WORK ORDER ISSUED

DEPOSIT, \$1000 5/9/61

DATE 5/9/61 BY S. M. Holton

APPLICATION

The City of Mountlake Terrace

SIDE SEWER PERMIT

OUTSIDE INSIDE REPAIRS U.G. INVESTMENT
CARD No. (1)

1387376

EASEMENT No.

OWNER: Willis Q. Nesbitt
HOUSE No. 22105 53rd W.

CONTRACTOR:

Top Notch Plumbing PERMIT No. 2639

STREET

AVENUE LOT No.

39

BLOCK No.

NAME ADD:

M.H.T. #22


138.87

28'

pr E-G-90182

2nd and sand

pr E-G-80122 rev

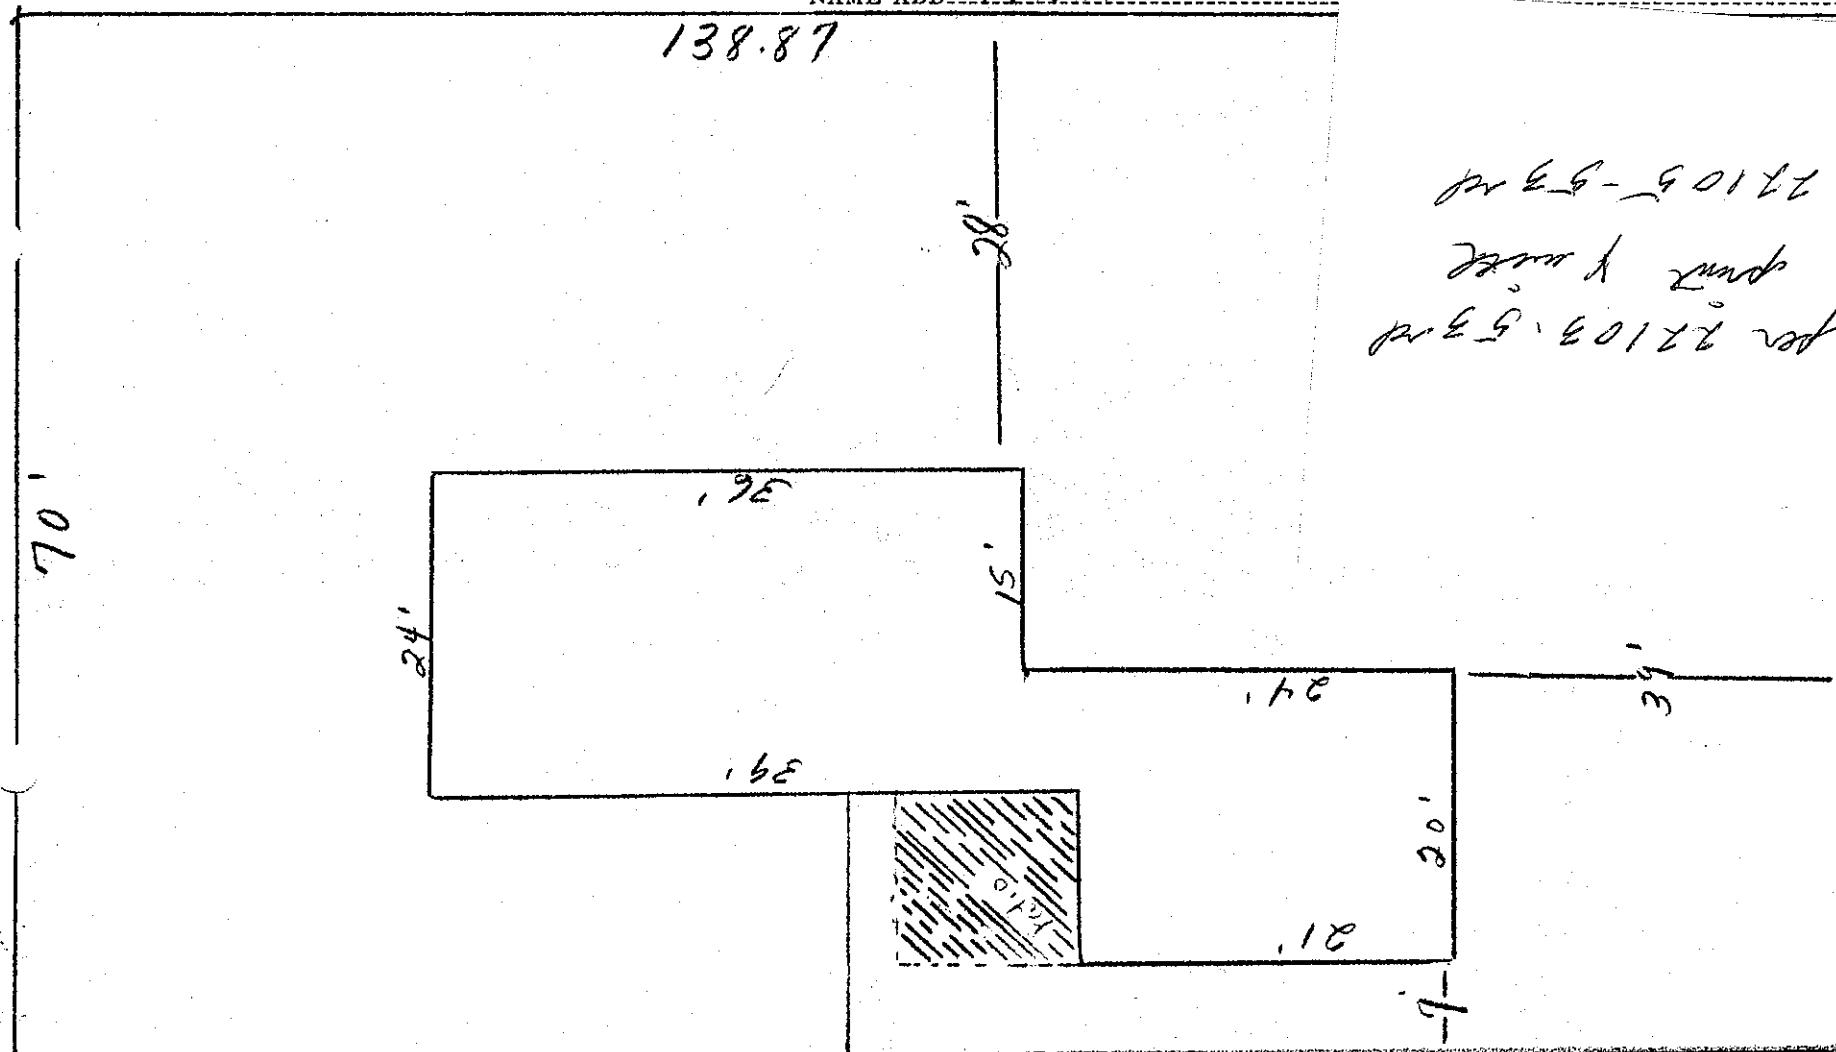

Date

Approved:

67'0" 6"

BACKFILL WORK ORDER ISSUED

DEPOSIT, \$10.00 5/9/60

SEWER WORK ORDER ISSUED

1418

DATE 5-10-60

BY S.M. Holton

APPLICATION


The City of Mountlake Terrace

SIDE SEWER PERMIT

OUTSIDE INSIDE REPAIRS

UHSCHAU HOMES

CARD No.

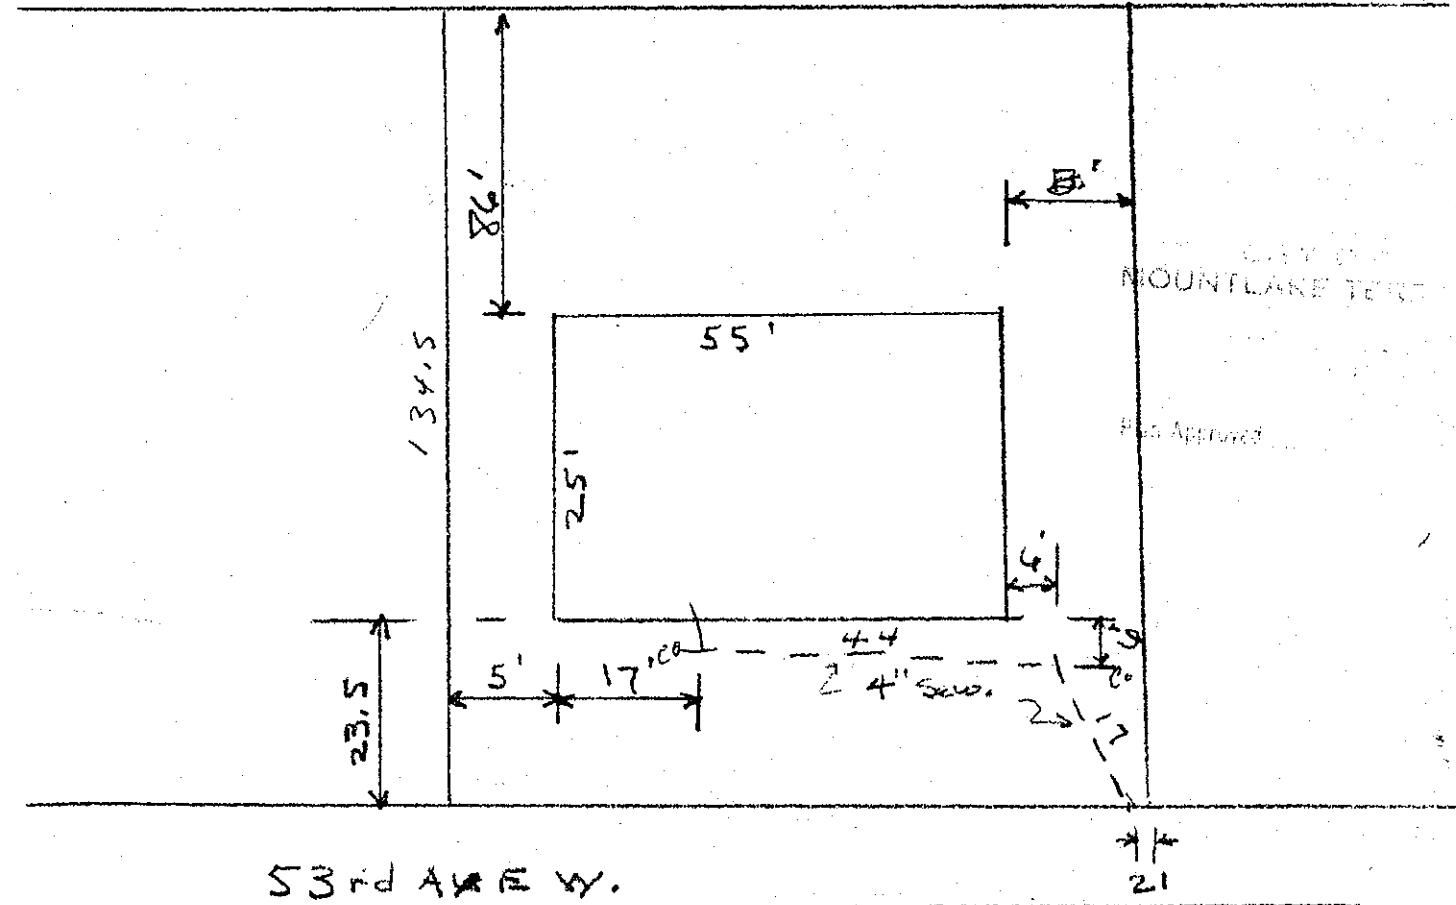EASEMENT No. NoneOWNER Conrad HornerCONTRACTOR L.O. FRANKLIN & CO. PERMIT NO. 1491HOUSE NO. 22106 53rd W.STREET S. 63' AVENUE LOT No. East Half of Lot 2 BLOCK No. 2NAME ADD. Morrison Acres Tract K

Date

Approved:

BACKFILL WORK ORDER ISSUED

DEPOSIT, \$10.00

1-13-60

SEWER WORK ORDER ISSUED

5767

DATE 1-20-60

BY Scott M. Holton INC + CO

The City of Mountlake Terrace

APPLICATION

for

SIDE SEWER PERMIT

OUTSIDE INSIDE REPAIRS

(2) CARD No.

EASEMENT No.

OWNER William R Manus

HOUSE NO. 22107-53 U.

CONTRACTOR Owner


PERMIT NO. 1032

STREET 22107 - 53 West, - MOUNTLAKE TERRACE

AVENUE LOT NO. THIRTY-EIGHT C.S.P. BLOCK NO.

Plat of Mountlake Terrace Dev. No 22 according to plat
NAME ADD.

Plat recorded in volume 14 of plats, page 39, records
of said County.

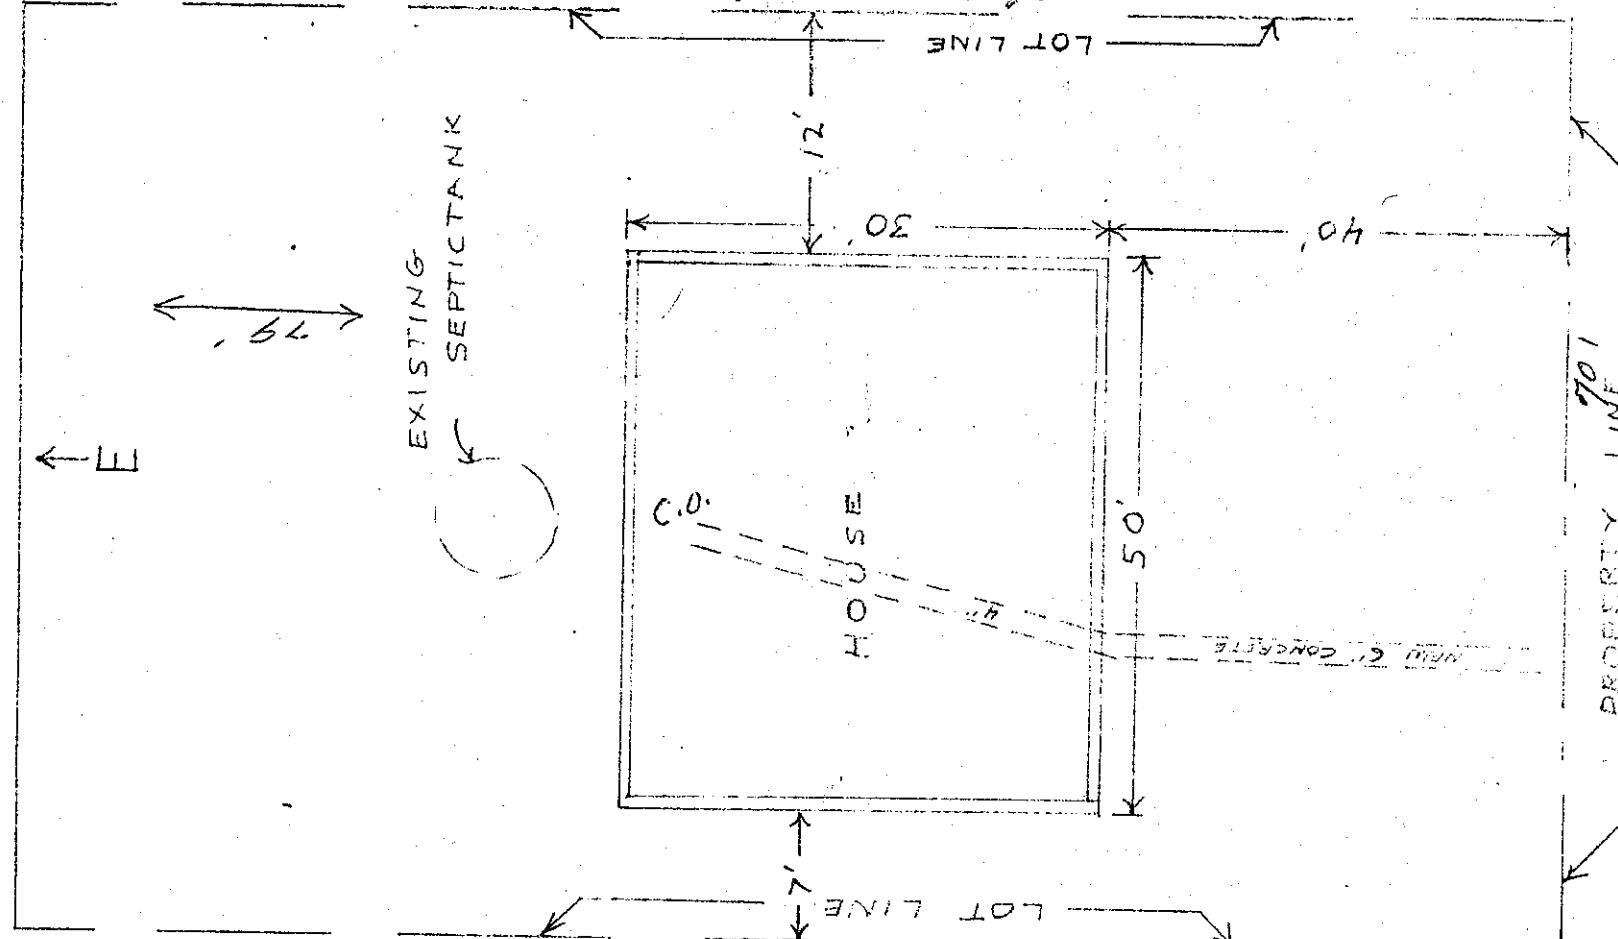

Date

BACKFILL WORK ORDER ISSUED

DEPOSIT, \$ 10.00

Approved:

SEWER WORK ORDER ISSUED

10/26/59

DATE

10/27/59

By

5242 Alyost 1 10-20-60 INST CON SMTA

SEWER MAIN


APPLICATION

The City of Mountlake Terrace

SIDE SEWER PERMIT

OUTSIDE INSIDE REPAIRS K JOHNSON
CARD No. EASEMENT No. 1396151OWNER George SchiessCONTRACTOR Wilson & Mertz Inc. PERMIT No. 146HOUSE No. 22108 22nd St.

STREET

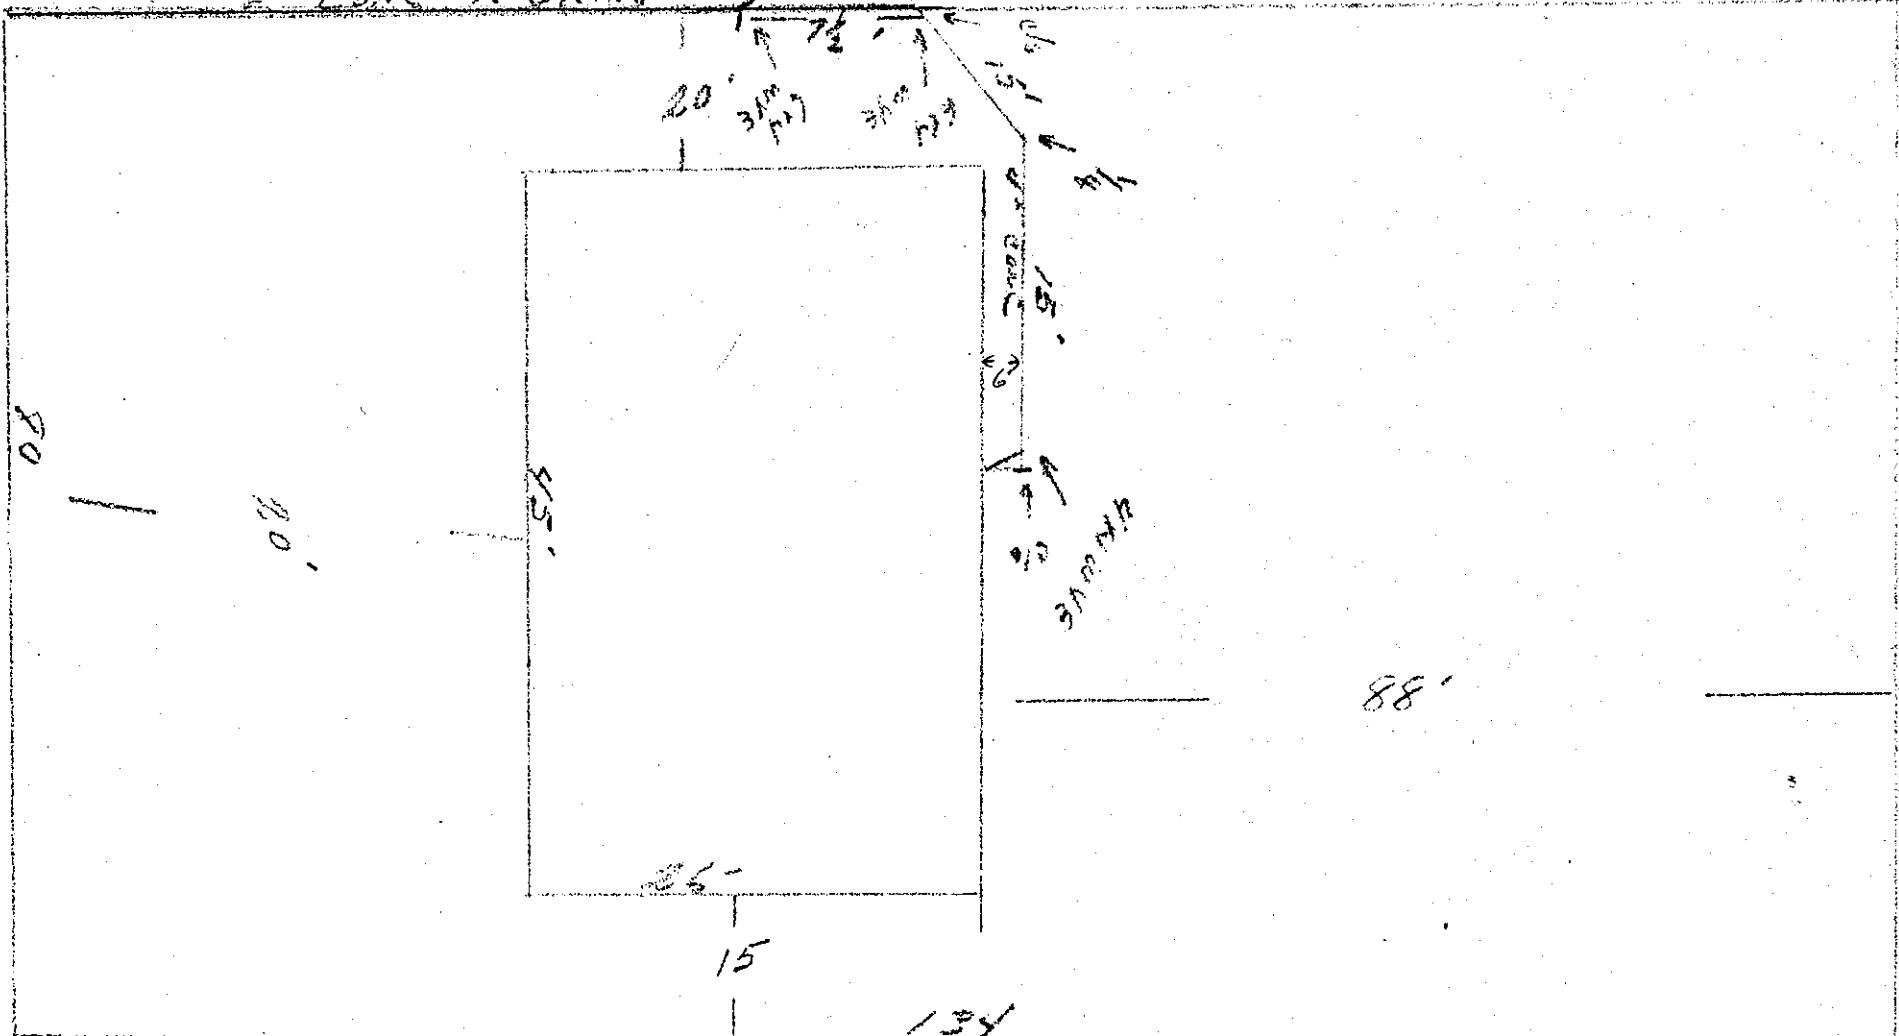AVENUE LOT No. 1BLOCK No. NAME ADD Donald Pack

Date

Approved:

BACKFILL WORK ORDER ISSUED

DEPOSIT, \$ 10,00

SEWER WORK ORDER ISSUED

5-31-60

#1578

DATE 6-17-60BY S. M. Holtom, NSC CON

APPLICATION

CARD No.

The City of Mountlake Terrace

SIDE SEWER PERMIT

OUTSIDE INSIDE REPAIRS

EASEMENT No. 135.01.50

OWNER DONALD F. SMITH

HOUSE No. 22109 52nd St. W.

CONTRACTOR Self

STREET


AVENUE LOT No. 33

PERMIT No. 1830

NAME ADD.

138

BLOCK No.

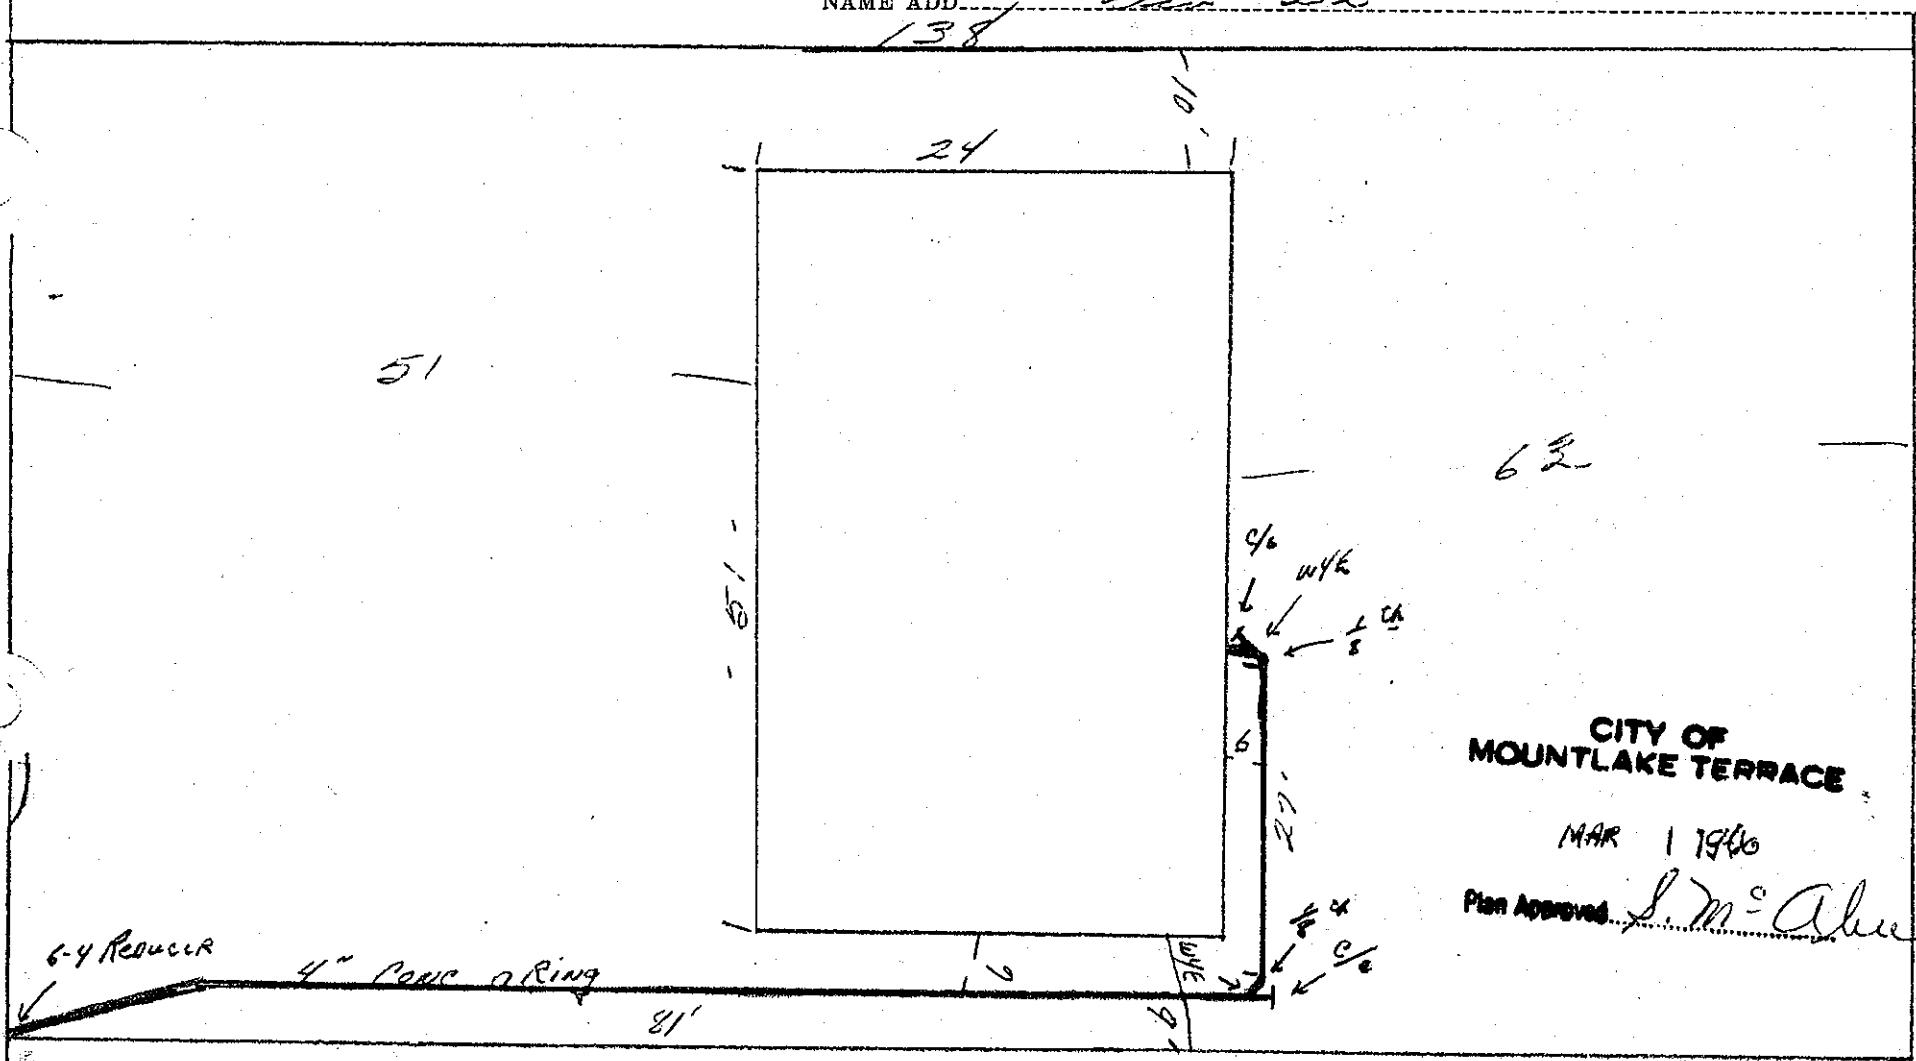CITY OF
MOUNTLAKE TERRACE

MAR 1 1960

Plan Approved S. McAllee

BACKFILL WORK ORDER ISSUED

Date

DEPOSIT, \$40.00 2-29-60

Approved:

SEWER WORK ORDER ISSUED

696 Et DATE 3/1/60

BY J. McLean, insp. N.C.

APPLICATION
FOR

SIDE SEWER PERMIT

The City of Mountlake Terrace

OUTSIDE INSIDE REPAIRS

CARD No.

EASEMENT No. 1396151

OWNER Helen Donnell
HOUSE No. 22200 - 53rd W.

CONTRACTOR Wingfield


PERMIT No. 2812

STREET #
AVENUE LOT NO. 2

BLOCK NO.

NAME ADD.

Donnell Park

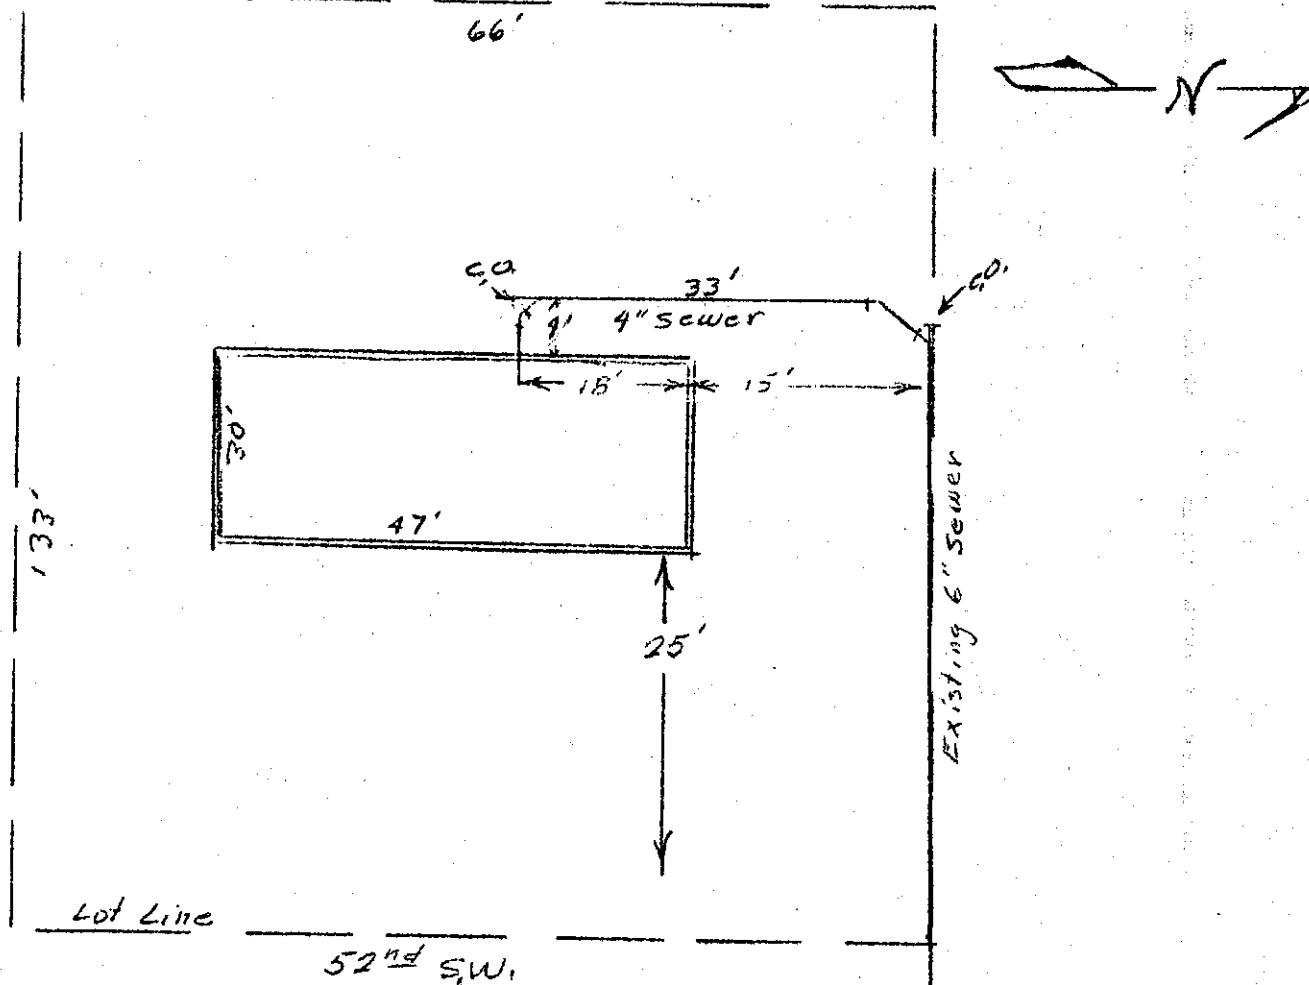

Date

DEPOSIT, \$

10⁰⁰

Approved:

BACKFILL WORK ORDER ISSUED
SEWER WORK ORDER ISSUED

DATE 8-7-61 BY S. M. Holton

8/4/61, Ag 1

The City of Mountlake Terrace

APPLICATION
FOR

SIDE SEWER PERMIT

OUTSIDE INSIDE REPAIRS

Newell

CARD No.

EASEMENT No. 1350150

OWNER

Newell

HOUSE No.

22203

53W

CONTRACTOR

Rainier Const

PERMIT No.

1808

STREET

#36

AVENUE LOT NO.

BLOCK No.

NAME ADD.

Div # 22


CITY OF
MOUNTLAKE TERRACE

FEB 19 1960

Plan Approved

J. Fairlie

SM

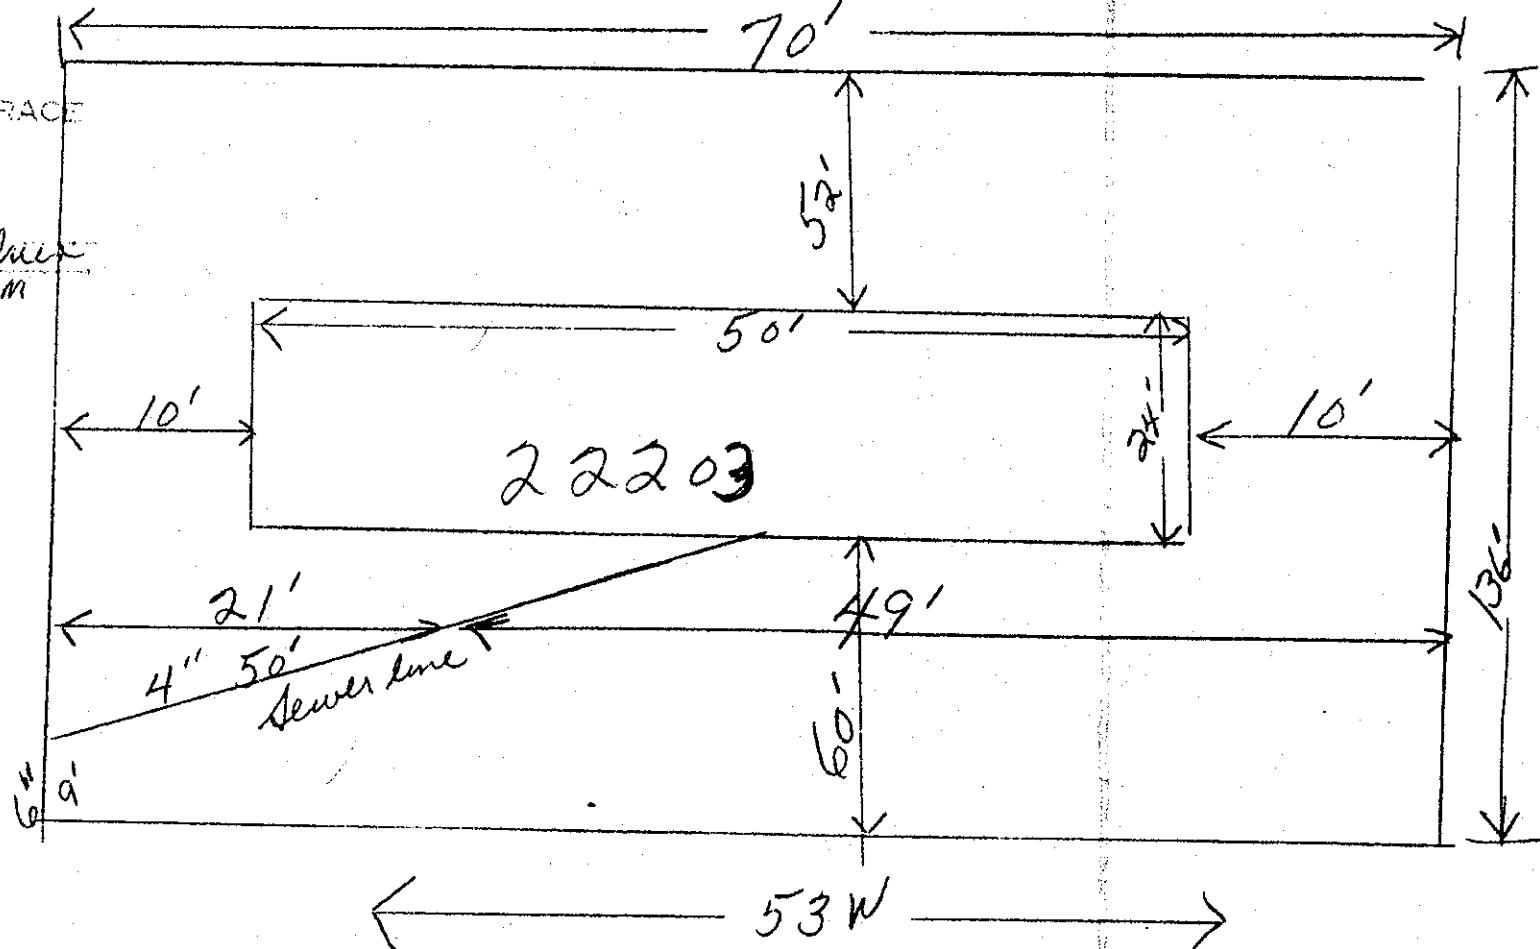

Date

Approved:

BACKFILL WORK ORDER ISSUED
SEWER WORK ORDER ISSUED

DEPOSIT, \$ 10.00

2/26/60

677

DATE

BY

Alvarez and Sons

APPLICATION

JAMES A. G. Grazini
CARD No.

The City of Mountlake Terrace

SIDE SEWER PERMIT

OUTSIDE INSIDE REPAIRS

EASEMENT No. 1374990

OWNER James A & Penelope J.S. GRAZINI
HOUSE No. 22204 53rd W.

CONTRACTOR OWNER

STREET AVENUE LOT No. Lot - 5

PERMIT No. 1401

BLOCK No.


NAME ADD.

Lot line

130'
26'

Donnell Park

"

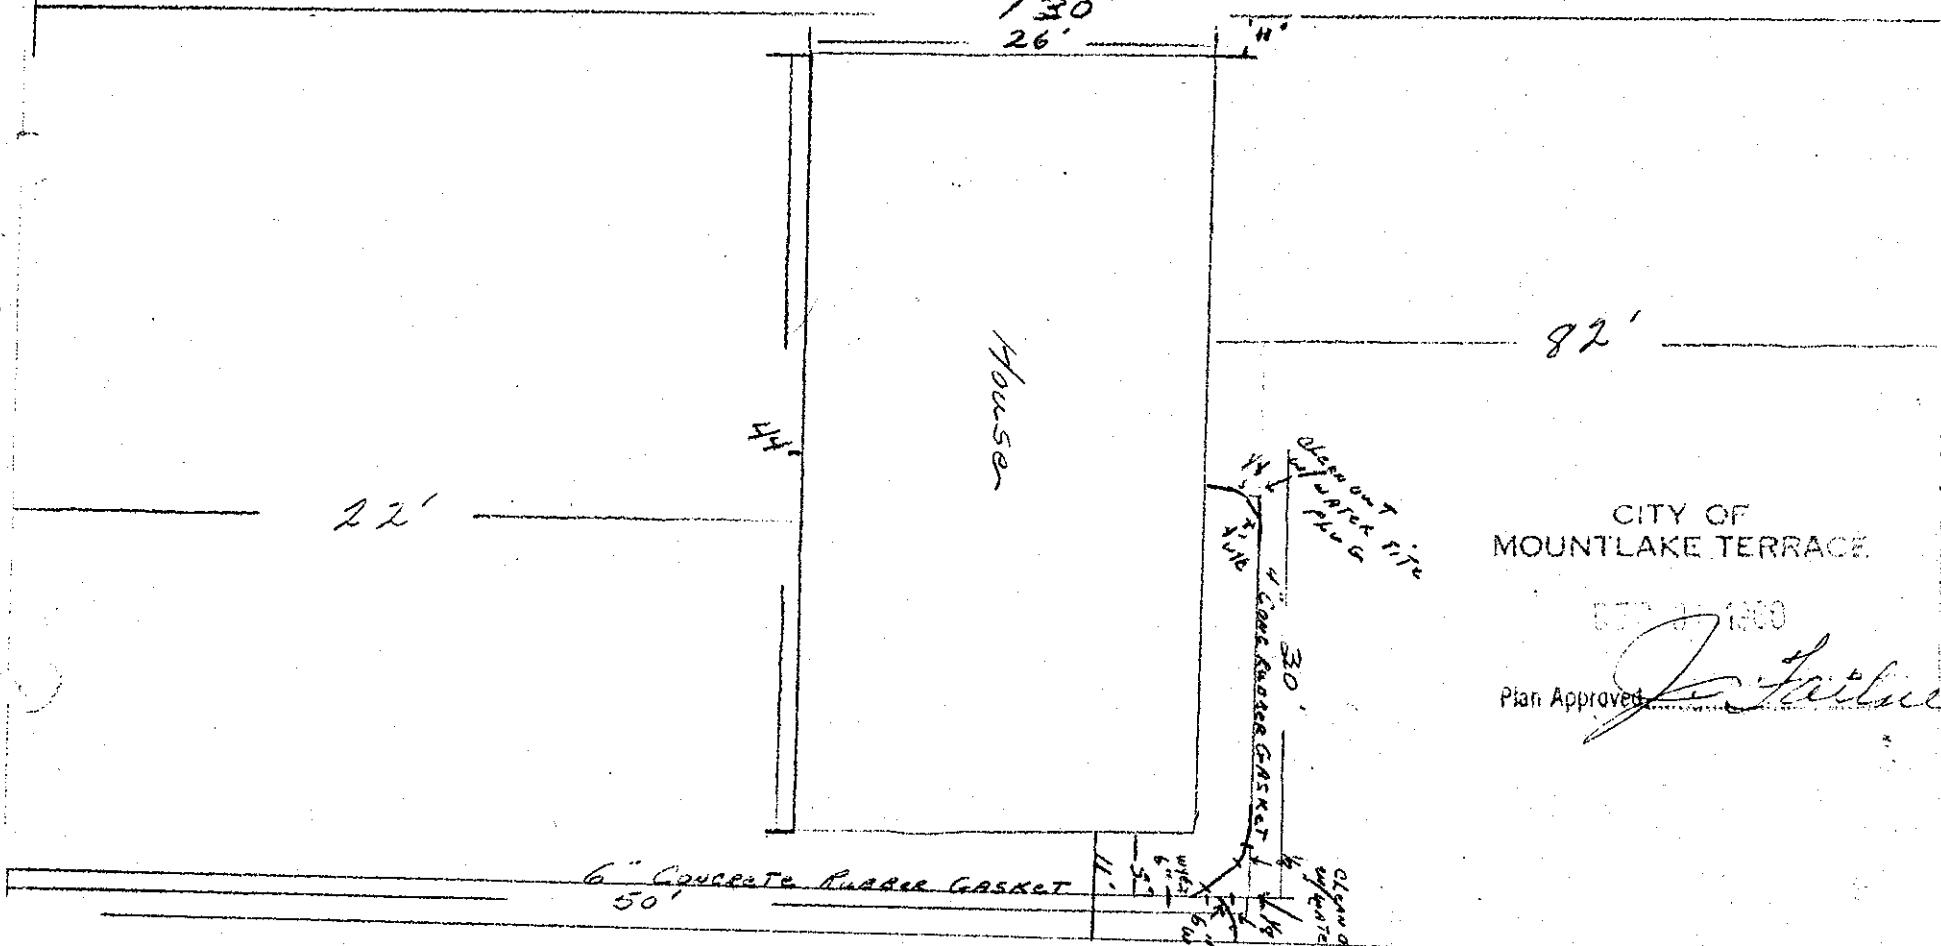CITY OF
MOUNTLAKE TERRACE

3/22/60

Plan Approved

Date

Approved:

BACKFILL WORK ORDER ISSUED

DEPOSIT, \$10.00

SEWER WORK ORDER ISSUED

Rec# 5047

DATE 12-31-59

BY S. Cottam Holtzman INS
3/22/60 J. Parker Comm.

The City of Mountlake Terrace

APPLICATION

FOR
SIDE SEWER PERMIT

OUTSIDE INSIDE REPAIRS

CARD No.

EASEMENT No.

1296

OWNER J.D. RASK

CONTRACTOR

OWNER

PERMIT No.

HOUSE NO. 22205 53rd Av.

STREET


AVENUE LOT No.

35

BLOCK No.

NAME ADD.

MOUNTLAKE TERR. DIV 22

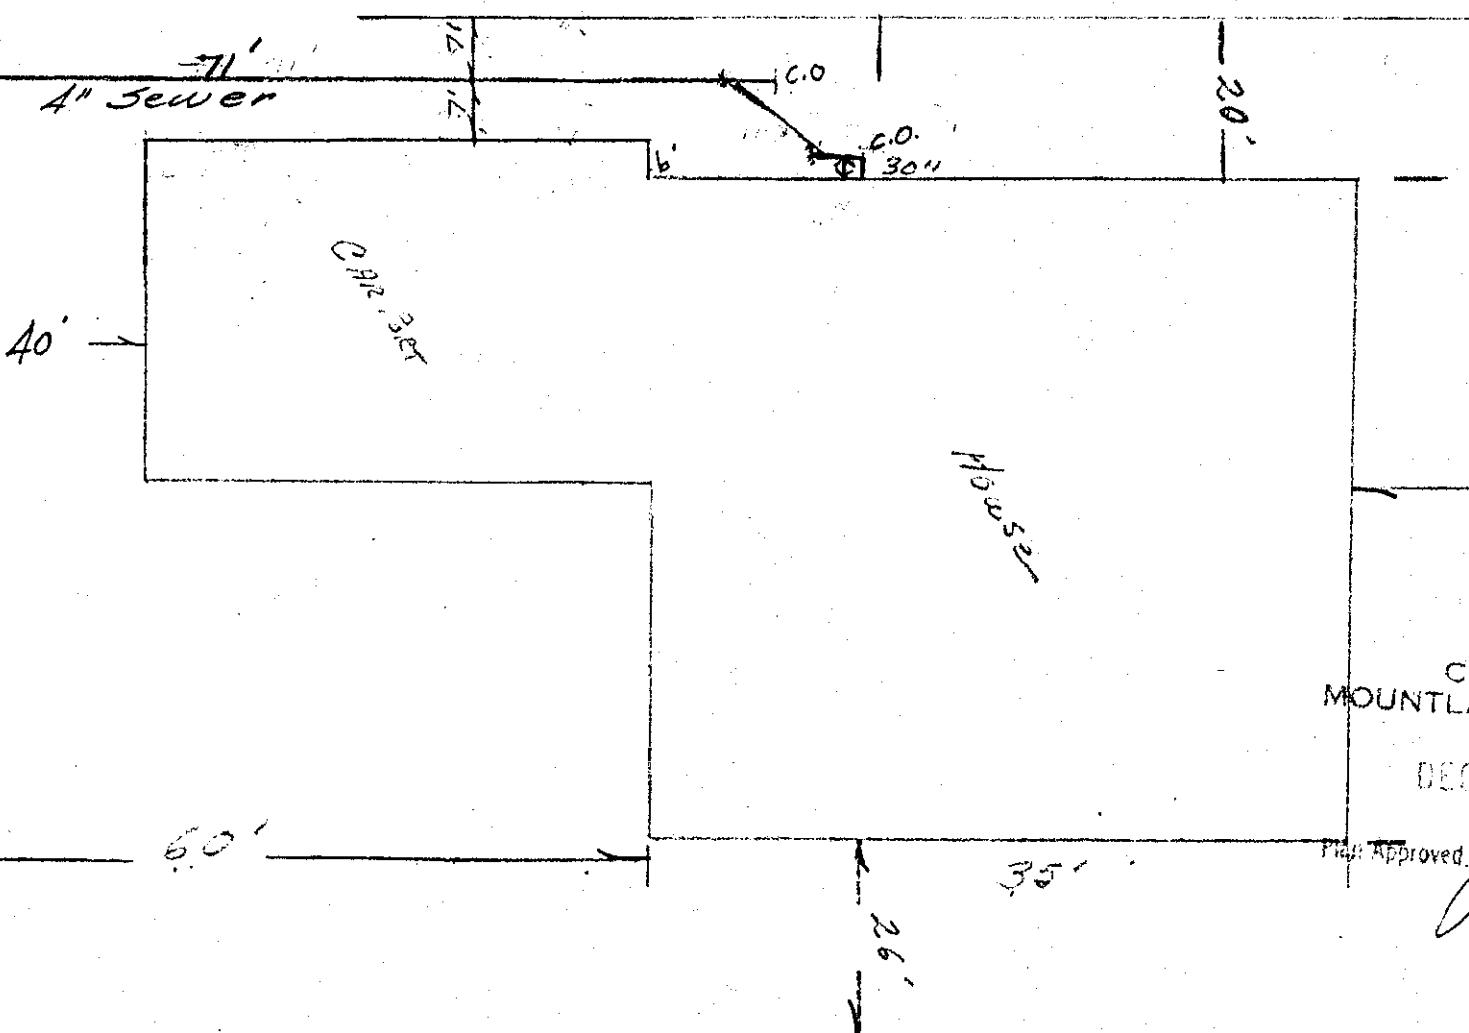

CITY OF
MOUNTLAKE TERRACE

DEC 1959

Plan Approved

J. Faulner
8/27/59

Date

138-6

Approved:

BACKFILL WORK ORDER ISSUED

DEPOSIT \$ 10.00

SEWER WORK ORDER ISSUED

5518
12/7/58

DATE 12-8-59

BY Scott McHoltton, M/S
NC

APPLI

The City of Mountlake Terrace

CARD No.

SIDE SEWER PERMIT

OUTSIDE INSIDE REPAIRS

EASEMENT No.

OWNER H.A. Donnell

CONTRACTOR Wingfield

PERMIT No. 743

HOUSE NO. 22206 - 53rd W,


STREET

AVENUE LOT No.

BLOCK No.

NAME ADD.

Donnell Park add.

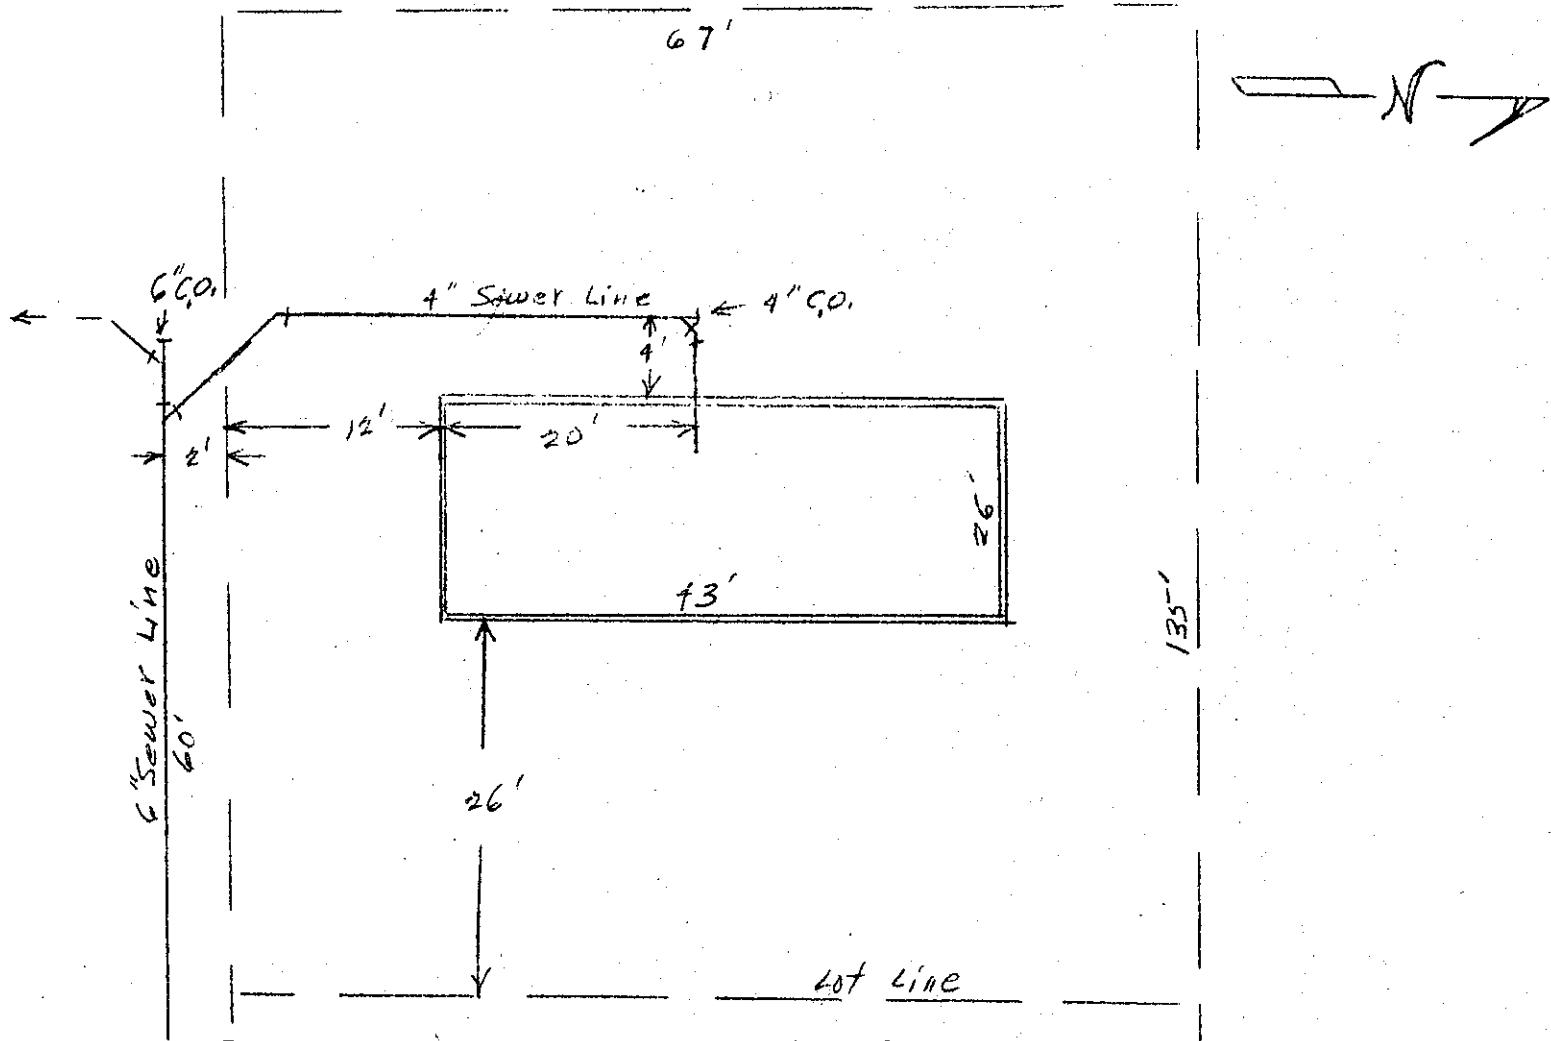

Date

Approved:

BACKFILL WORK ORDER ISSUED

DEPOSIT, \$

SEWER WORK ORDER ISSUED

DATE 4/13/61 BY S.M. Holton

APPLICATION

SIDE SEWER PERMIT

The City of Mountlake Terrace

CARD No.....

OUTSIDE INSIDE REPAIRS

EASEMENT No.....

OWNER H.A. Donnell

HOUSE No. 22208 - 53rd W.


CONTRACTOR Wingfield

PERMIT No. 745

STREET
AVENUE LOT No.

BLOCK No.

NAME ADD. Donnell Park Add.

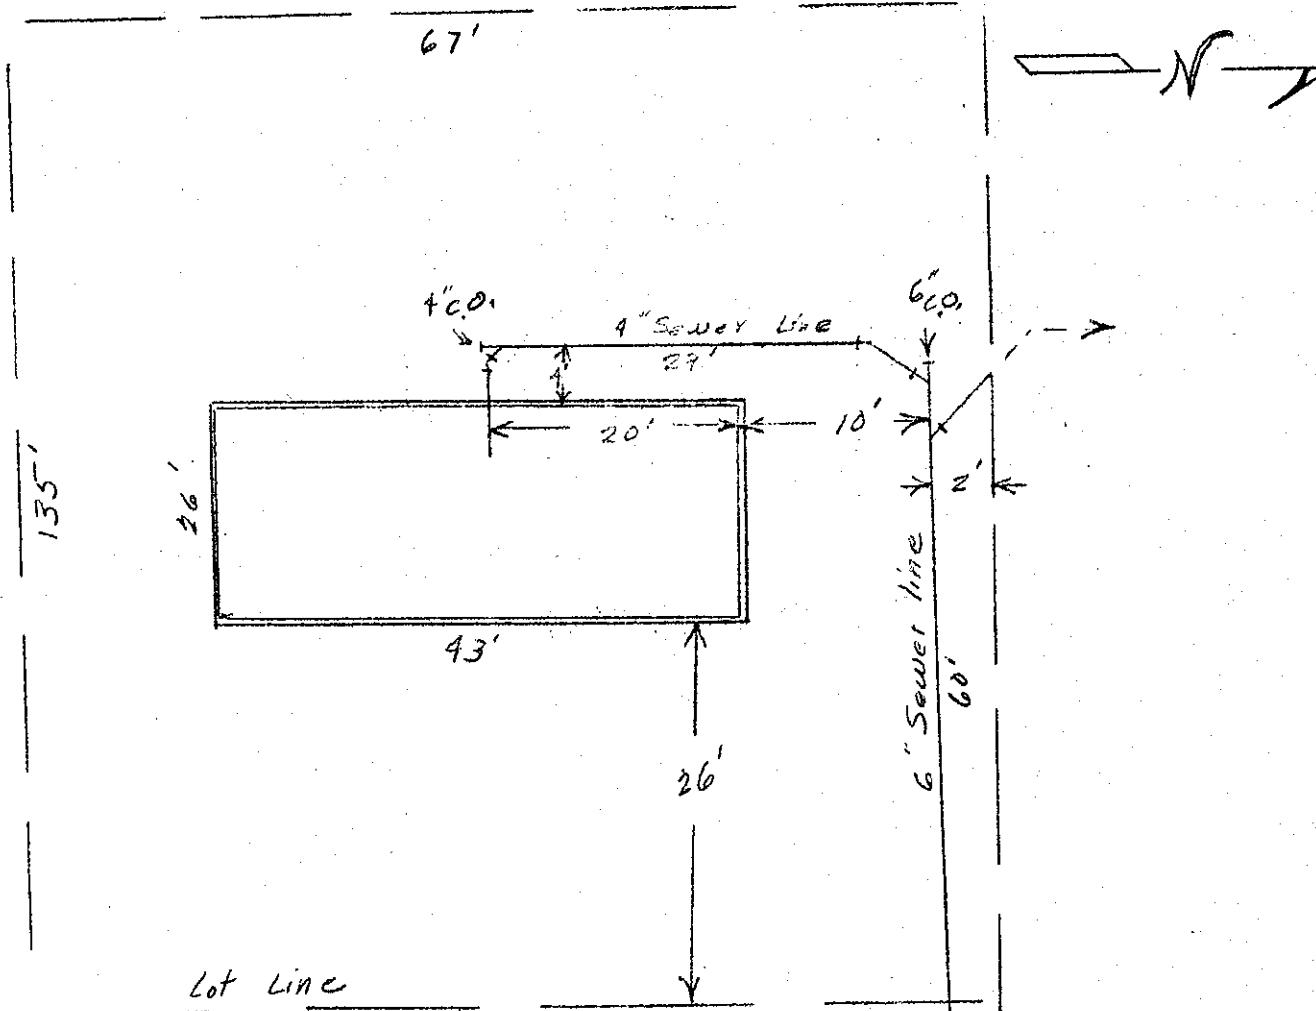

Approved:

DATE 4/13/61 BY S.M. Holton

BACKFILL WORK ORDER ISSUED..... DEPOSIT, \$.....

SEWER WORK ORDER ISSUED.....

The City of Mountlake Terrace

APPLICATION

Dell Jackson
CARD No.

SIDE SEWER PERMIT

OUTSIDE INSIDE REPAIRS

EASEMENT No. 1355926

OWNER Dell Jackson

HOUSE No. 22209 53 W

CONTRACTOR Rainier Const.

PERMIT No. 1862


STREET

AVENUE LOT No. 33

BLOCK No.

NAME ADD.

Div. # 22

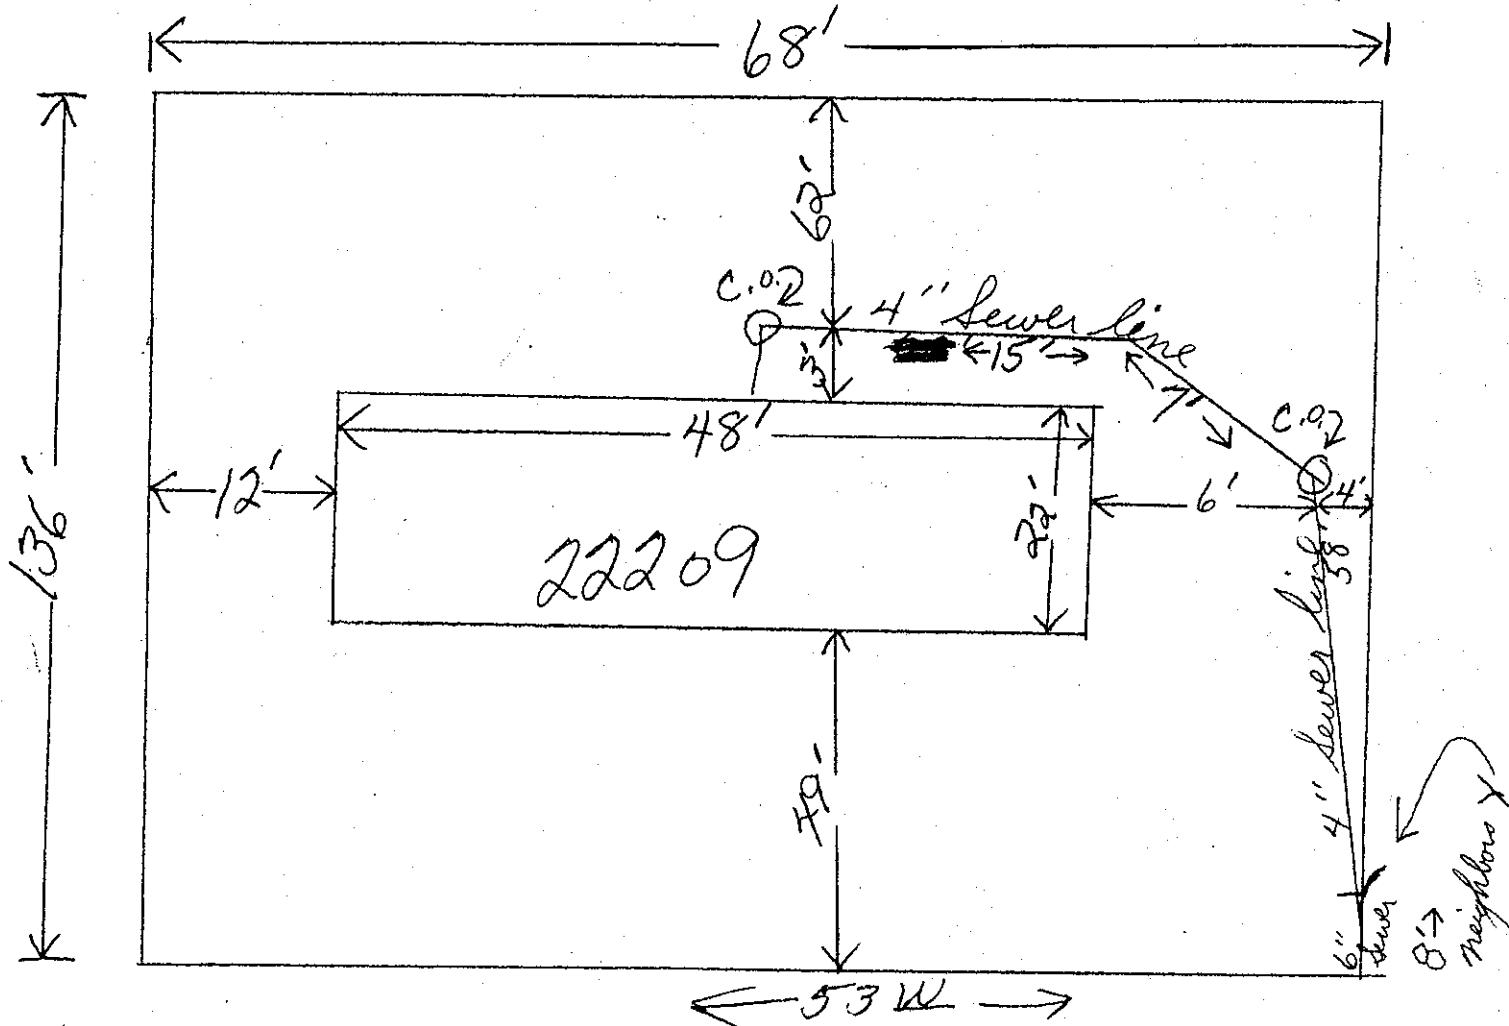

Date

Approved:

BACKFILL WORK ORDER ISSUED

DEPOSIT \$10.00

SEWER WORK ORDER ISSUED

3/4/60

#727

DATE 3-4-60

BY Scott M Holton INS CON

APPLICATION

100

CARD No.

The City of Mountlake Terrace

SIDE SEWER PERMIT

OUTSIDE INSIDE REPAIRS

EASEMENT No.

OWNER Allen Peerson
HOUSE No. 22310 53rd W.

CONTRACTOR

Schell


PERMIT No.

2173STREET
AVENUE LOT No.7

BLOCK No.

Diamond Park

NAME ADD.

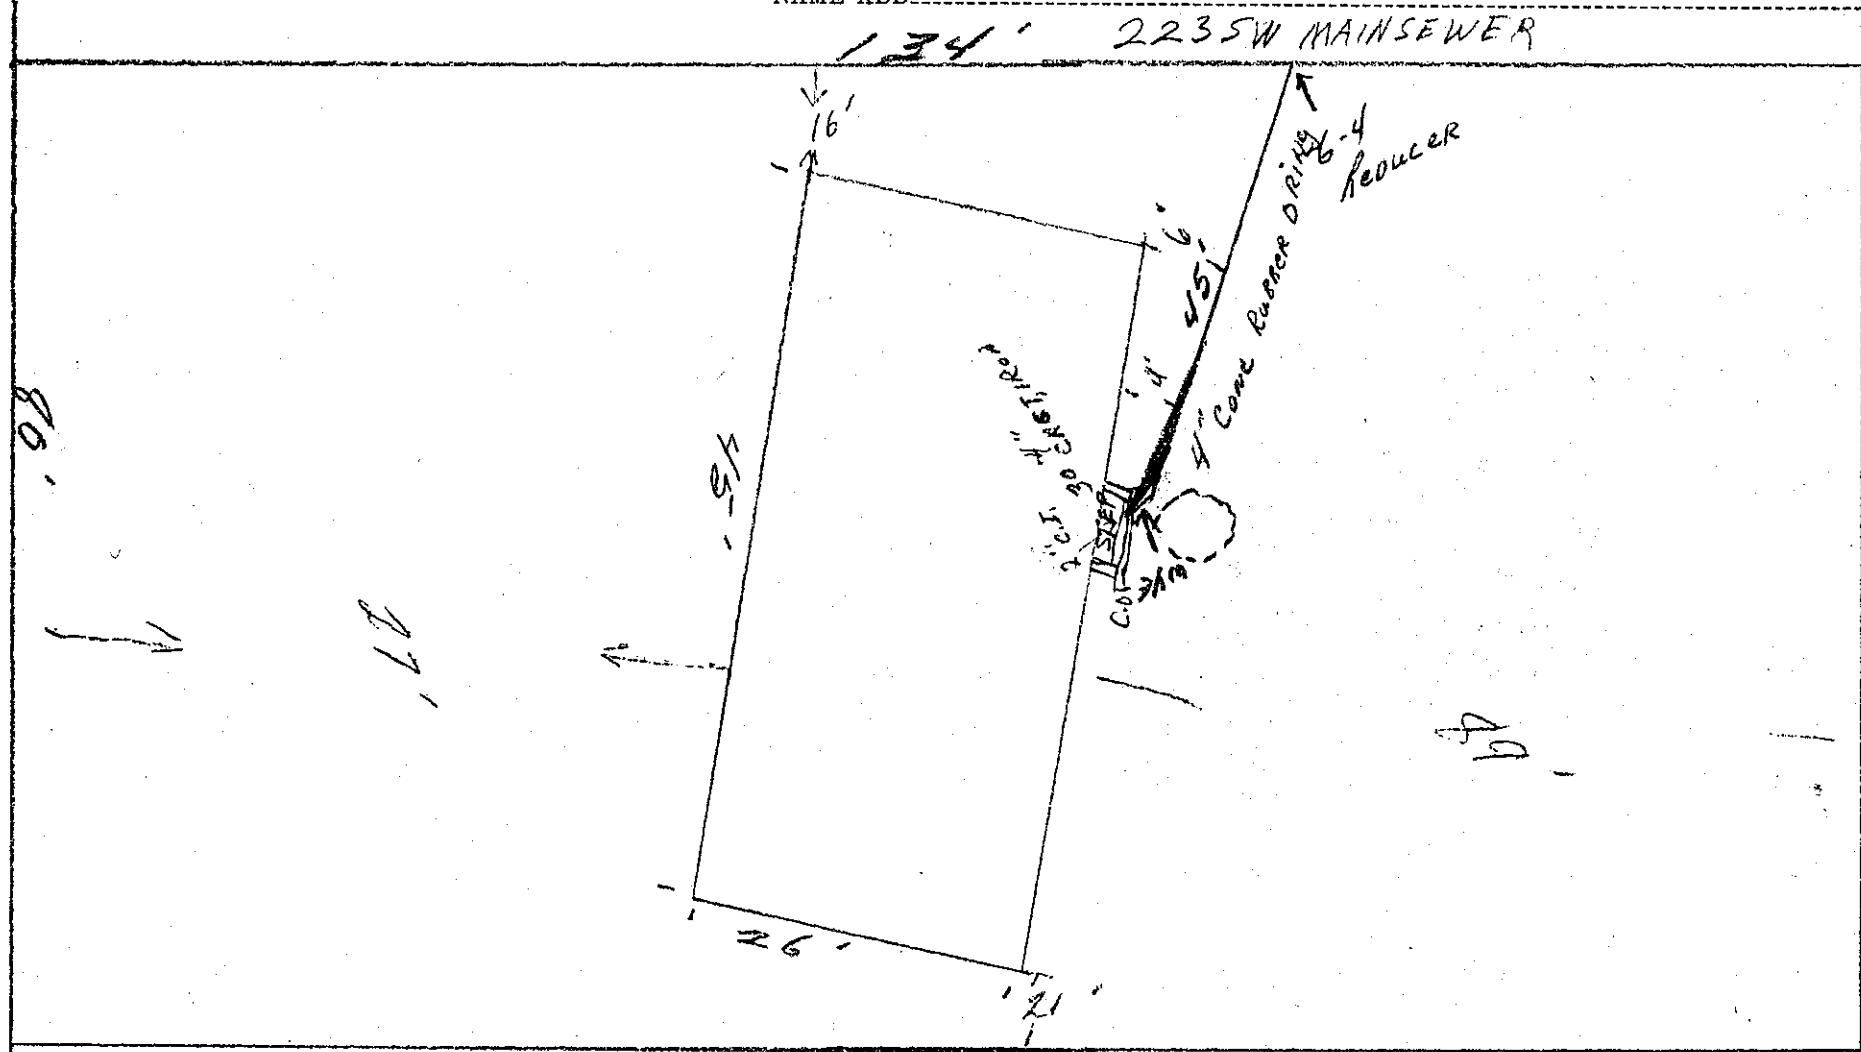134' 223 SW MAINSEWER

Date

Approved:

BACKFILL WORK ORDER ISSUED
SEWER WORK ORDER ISSUED

DEPOSIT, \$10.00 3/25/60

989

DATE 7-21-60

BY 8 m 21 ft 14

The City of Mountlake Terrace

APPLICATION

CARD No.

SIDE SEWER PERMIT

OUTSIDE INSIDE REPAIRS

EASEMENT No. 1355-926

OWNER Charles R Sunby

HOUSE No. 22211 - 53

CONTRACTOR

PERMIT No. 2398

STREET


AVENUE LOT NO.

32

NAME ADD.

BLOCK No.

M.L.T. div. 22

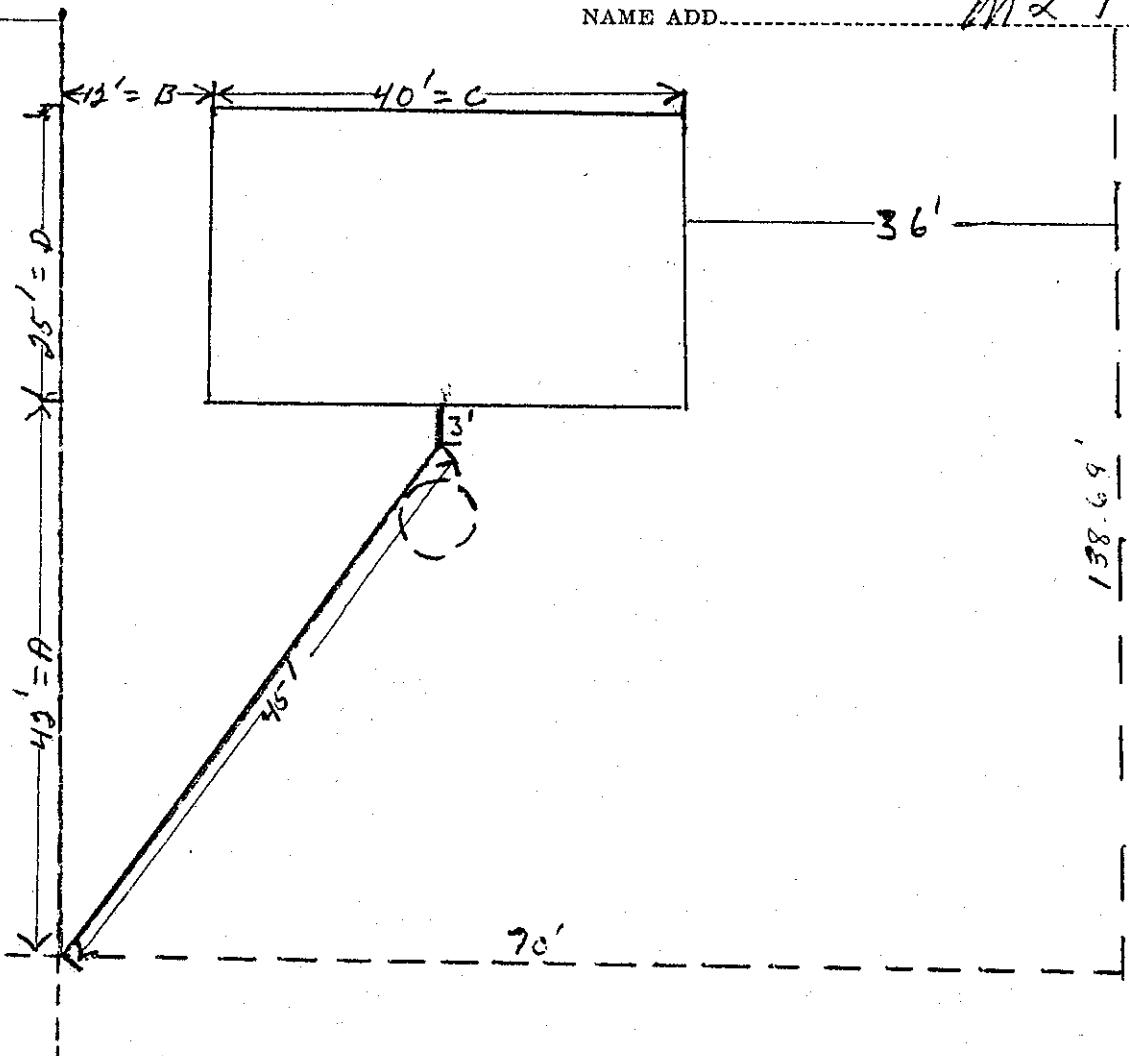

138-69
CITY OF
MOUNTLAKE TERRACE

APR 5 1960

Plan Approved

J. Failes

Date

Approved:

BACKFILL WORK ORDER ISSUED

DEPOSIT, \$10.00 4/4/60

SEWER WORK ORDER ISSUED

118.3


DATE 4/4/60

BY

J. Failes

SIDE SEWER AS BUILT

CITY OF MOUNTLAKE TERRACE

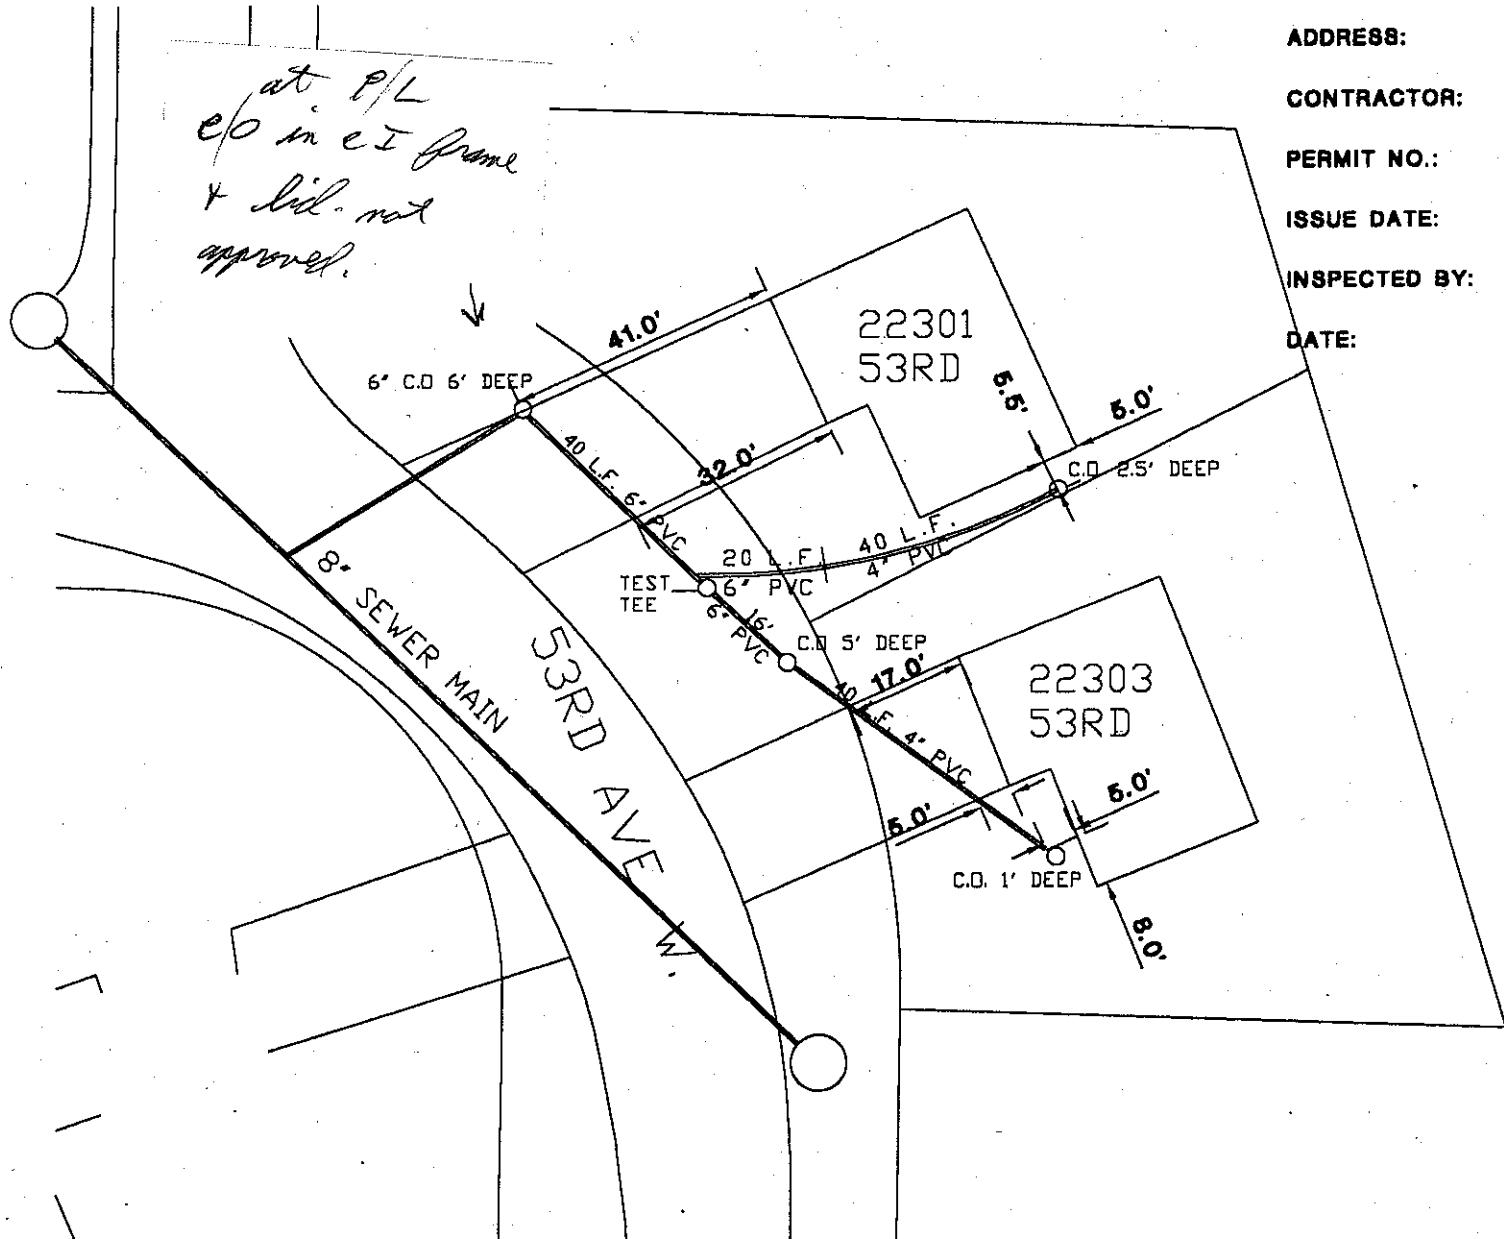

OWNER: - Viking Properties
ADDRESS: - 22301 53rd Ave. W.
CONTRACTOR: - Viking Properties
PERMIT NO.: - U-95-01
ISSUE DATE: - 1-5-95
INSPECTED BY: - B.V.D.
DATE: - 1-10-95

NOT TO SCALE

APPLICATION

SIDE SEWER PERMIT

The City of Mountlake Terrace

OUTSIDE INSIDE REPAIRS

DEN SANDBURG

CARD No.

None

EASEMENT No.

OWNER BEN SANDBURG

CONTRACTOR

EVERGREEN CONST.

PERMIT No. 1315


HOUSE NO. 22302 53 W.

STREET
AVENUE LOT No.

BLOCK No.

NAME ADD.

Row. 22

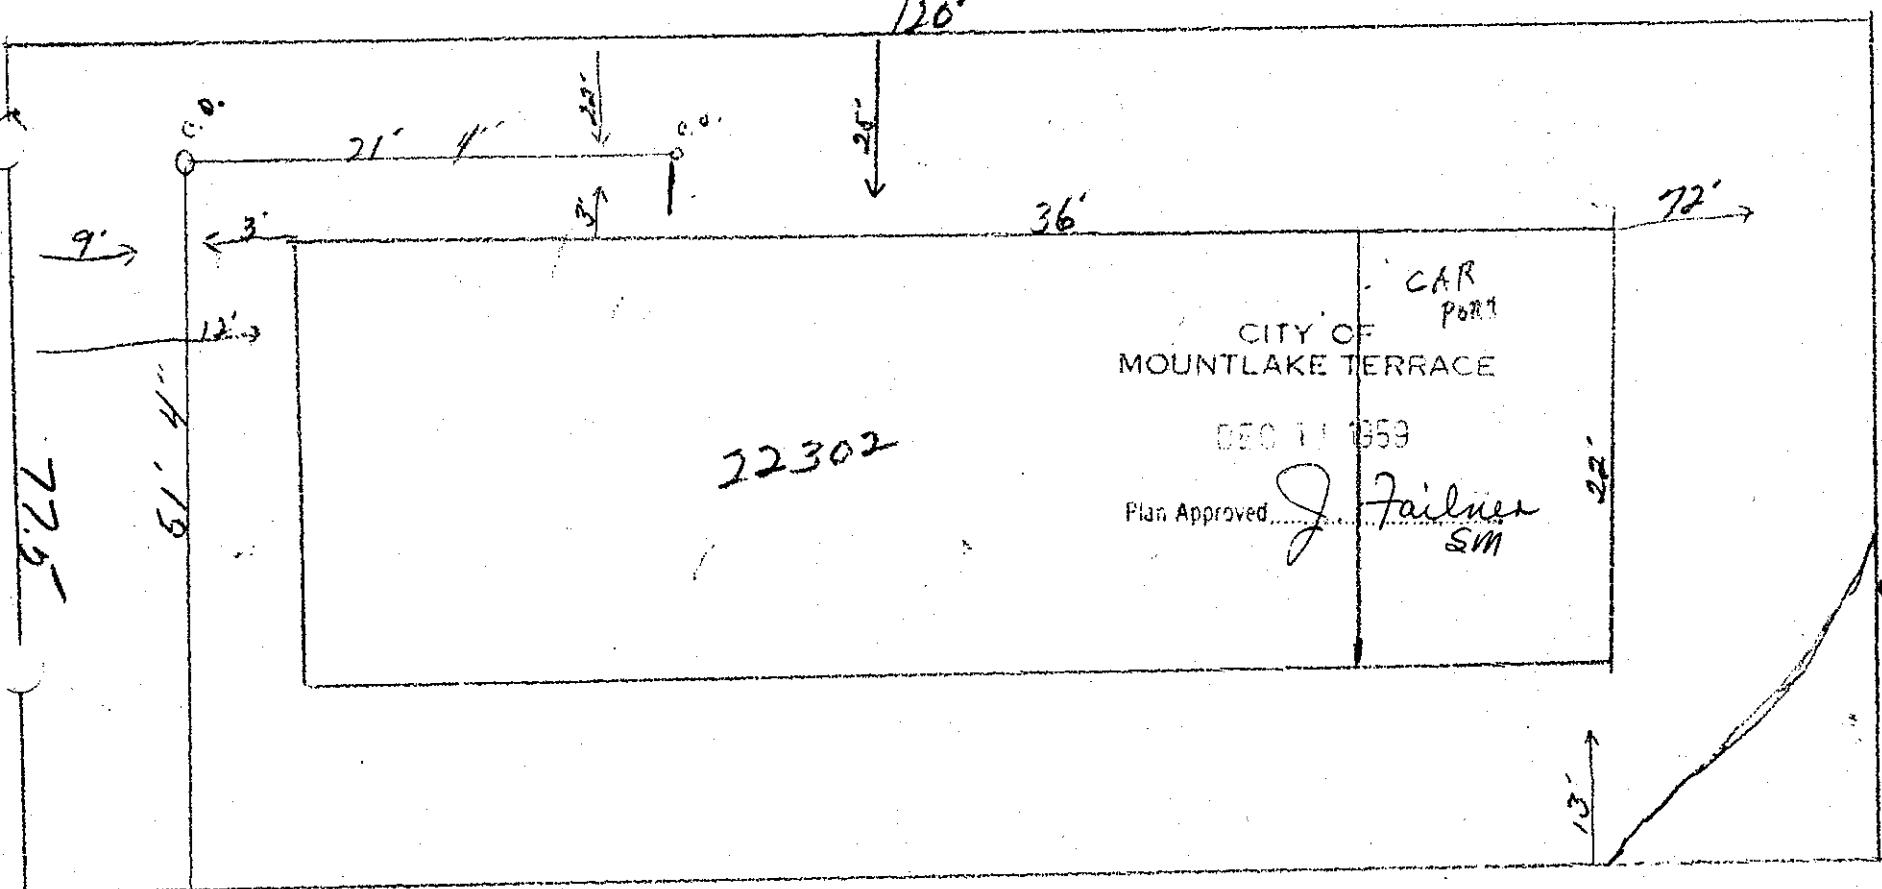

53 W.

BACKFILL WORK ORDER ISSUED

Date

Approved:

12-2-59

SEWER WORK ORDER ISSUED

DEPOSIT, \$ 10.00

5538 DATE

12/11/1959


BY

et

Connected 3-1-60

SIDE SEWER AS BUILT

CITY OF MOUNTLAKE TERRACE

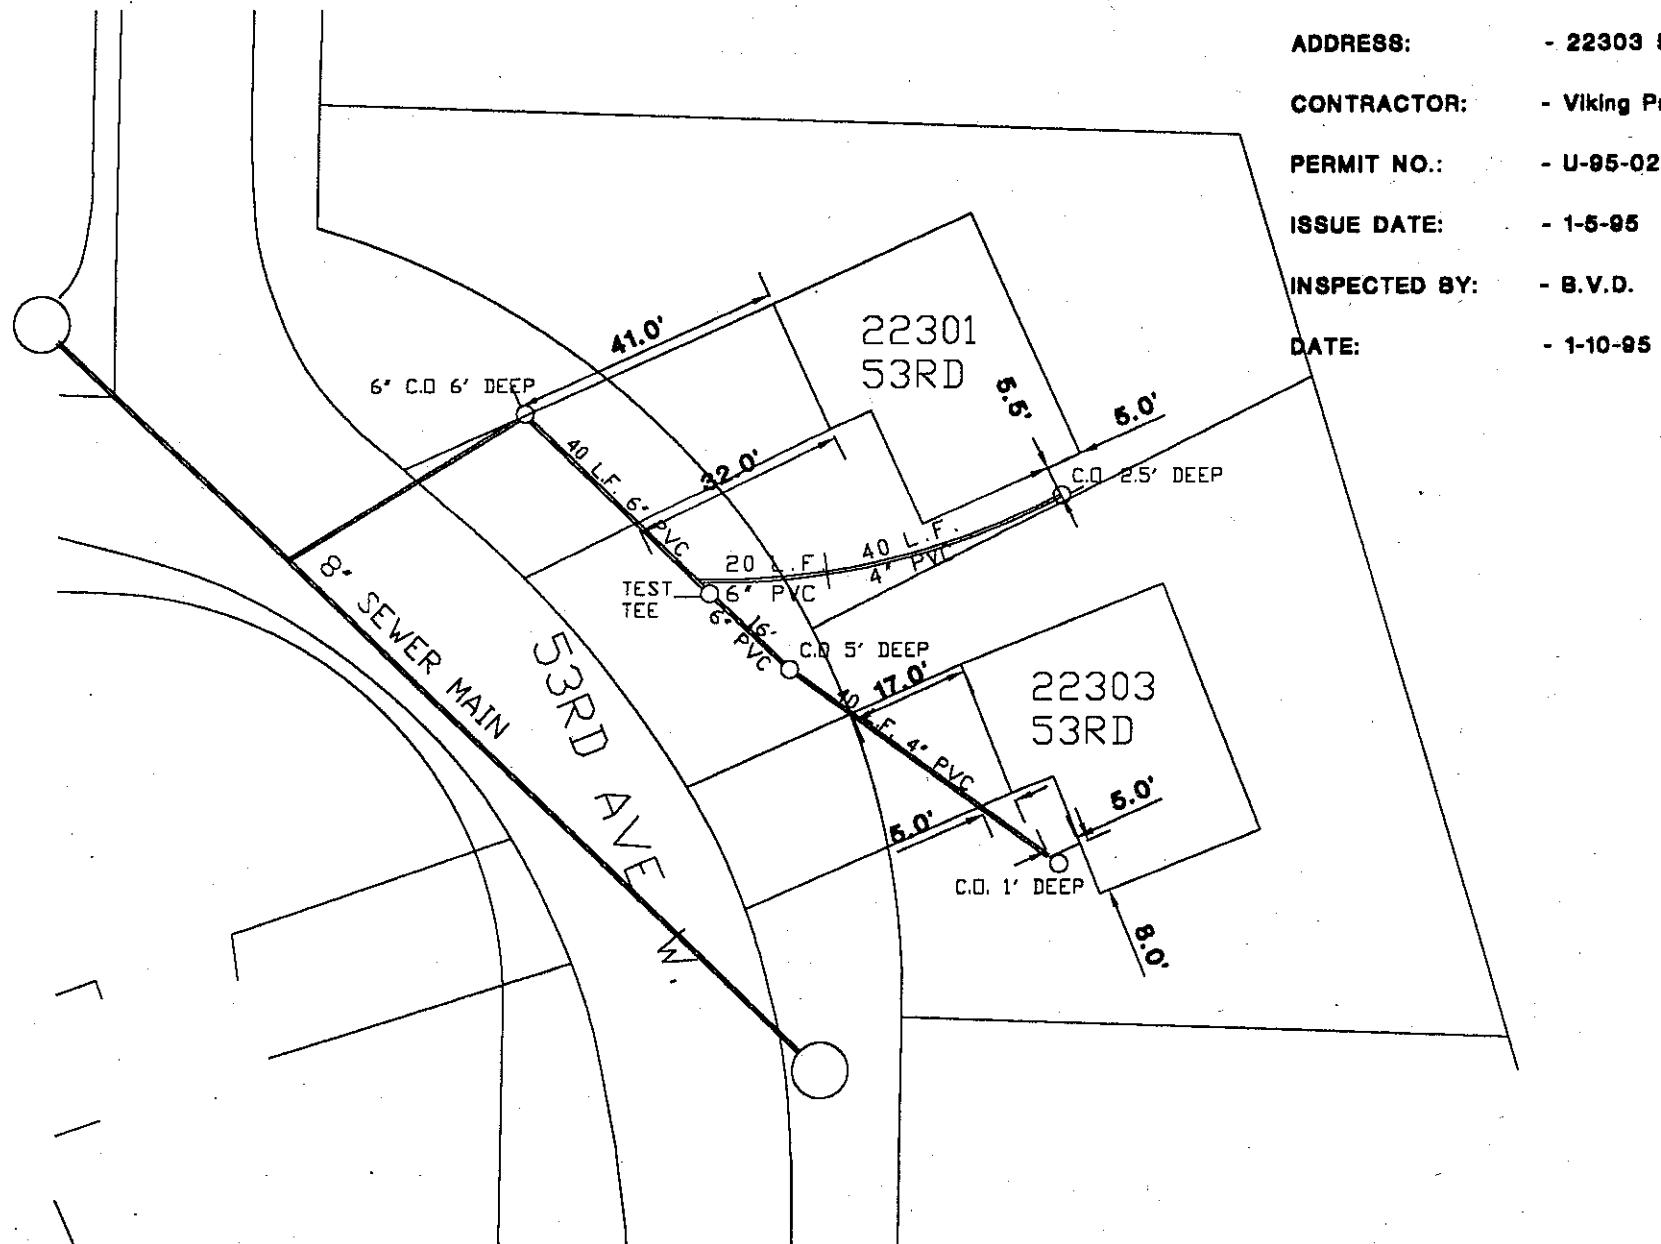

APPLETON

CARD No.

The City of Mountlake Terrace

SIDE SEWER PERMIT

OUTSIDE INSIDE REPAIRS

EASEMENT No. 1357205


OWNER Lee W. Markley

HOUSE No. 22304 53 1/2

CONTRACTOR THUNDERBIRD CONST. PERMIT No. 24100

STREET AVENUE LOT NO. Lot 48 Div 22 BLOCK NO.

NAME ADD.

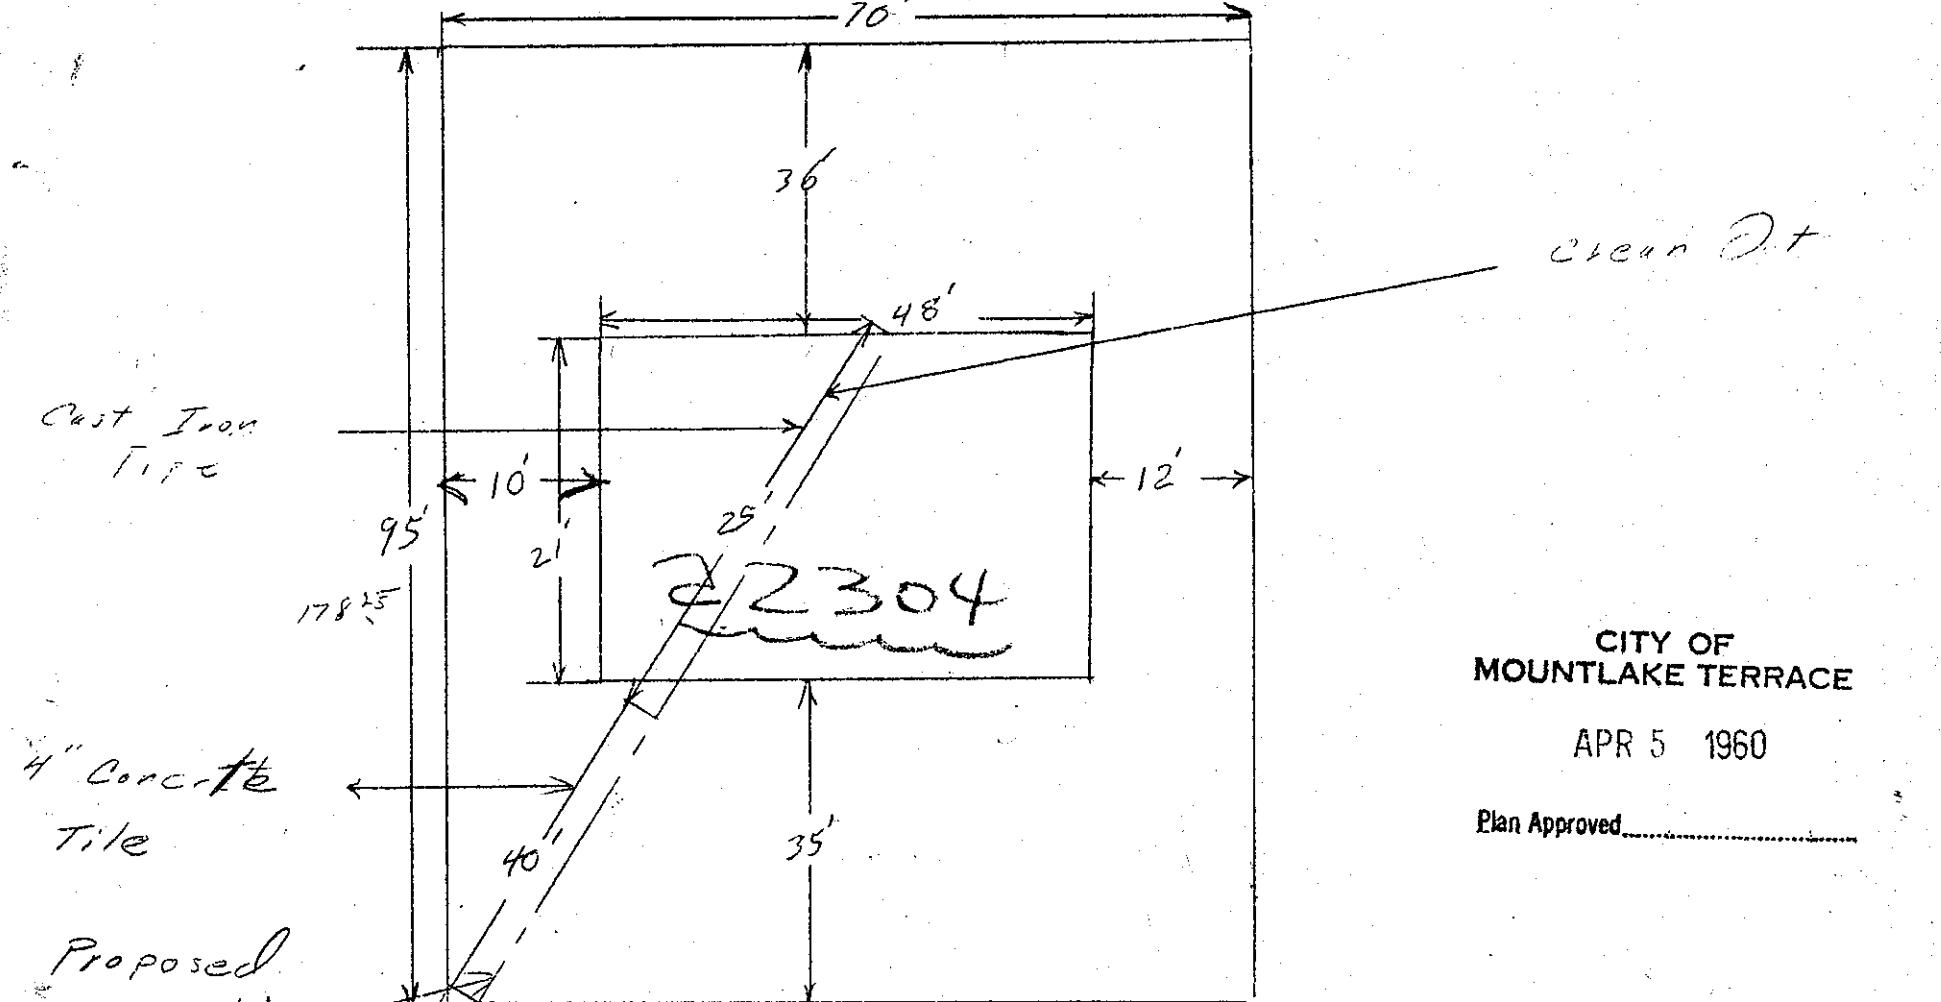

Date

53-2400

Approved:

BACKFILL WORK ORDER ISSUED

DEPOSIT, \$70.00

SEWER WORK ORDER ISSUED

4/4/60
#1185

DATE

4/6/60

BY

D. K. Koenig

APPLICATION

CARD No.

The City of Mountlake Terrace

SIDE SEWER PERMIT

OUTSIDE INSIDE REPAIRS

EASEMENT No.

None

OWNER Allen Petersen Corp

CONTRACTOR Top Hatch Plumb


PERMIT No. 1289

HOUSE No. 22305 53 W

STREET AVENUE LOT No. 28

BLOCK No.

NAME ADD. Div 22

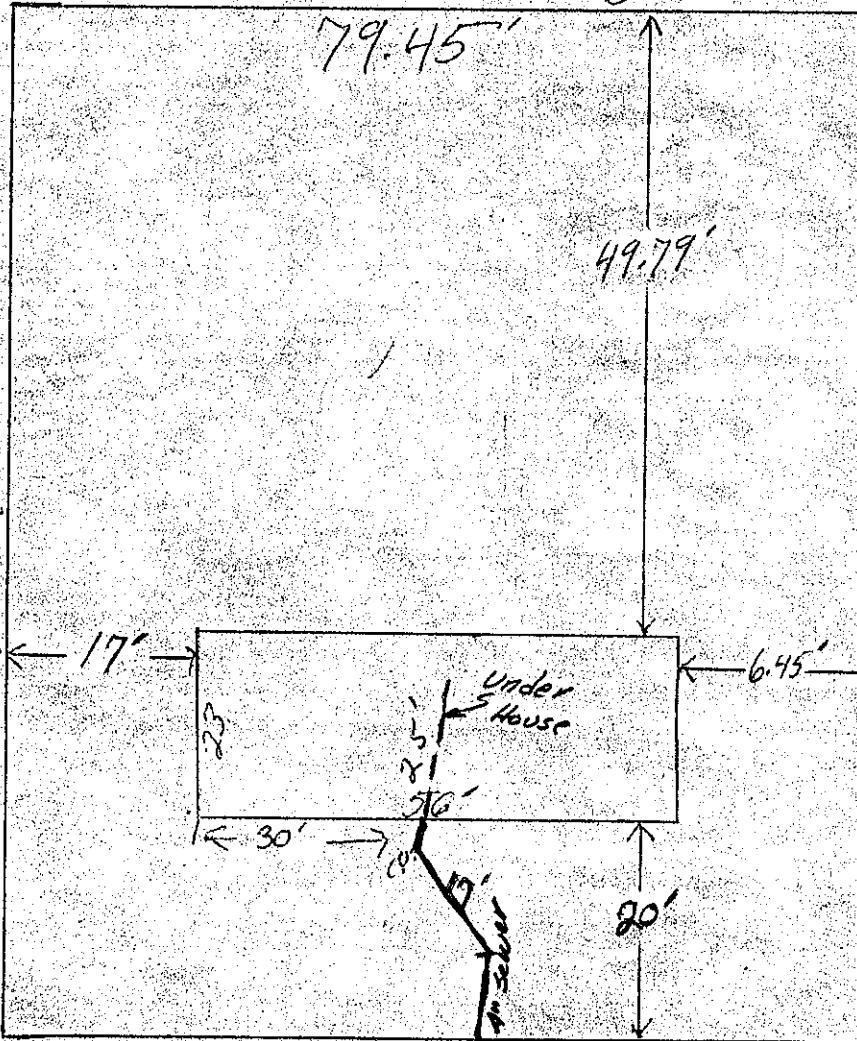

CITY OF MOUNTLAKE TERRACE

DEC 8 1959

Plan Approved

*J. Foeken
SMH*

Date

Approved:

BACKFILL WORK ORDER ISSUED
SEWER WORK ORDER ISSUED

DEPOSIT \$10.00

Rec. #5511 DATE 12-8-59 BY Scott m Holton IWS
12/7/59 - Deposit + CON.

The City of Mountlake Terrace

APPLICATION

CARD No.

SIDE SEWER PERMIT

OUTSIDE INSIDE REPAIRS

EASEMENT No. 1357205

OWNER Glenn R. Carlson
HOUSE No. 22306 - 53 West

CONTRACTOR Owner


PERMIT No. 139

STREET AVENUE LOT NO. 47

BLOCK No.

NAME ADD. DIV. 22

180-21

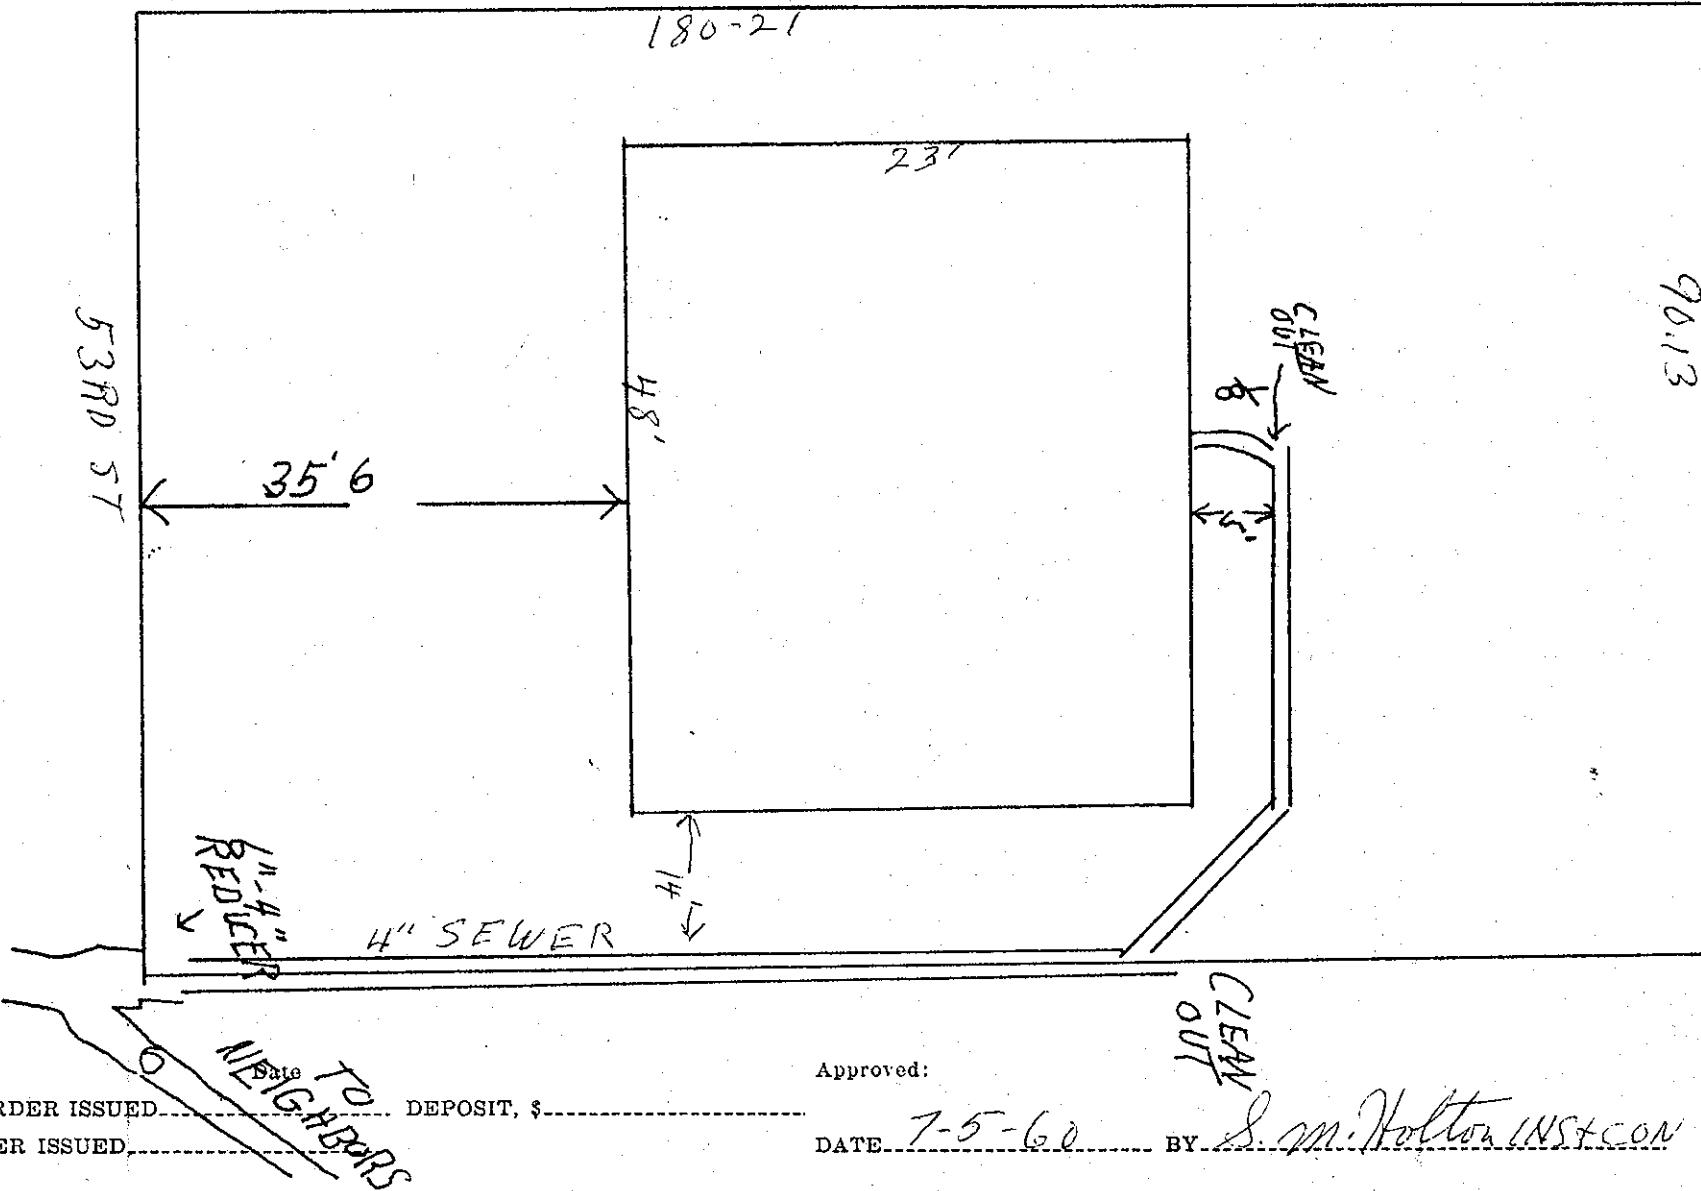

BACKFILL WORK ORDER ISSUED
SEWER WORK ORDER ISSUED

DEPOSIT, \$

Approved:

DATE 7-5-60

BY

S. M. Holton INST CON

TO
NEIGHBORS

APPLICATION

The City of Mountlake Terrace

CARD No.

SIDE SEWER PERMIT


OUTSIDE INSIDE REPAIRS EASEMENT No. None

OWNER Allen Peterson Corp.
22307
 HOUSE No. 22303 53 W.

CONTRACTOR Troy Match Plumbing PERMIT No. 1290

STREET
AVENUE LOT NO. 28

BLOCK NO.

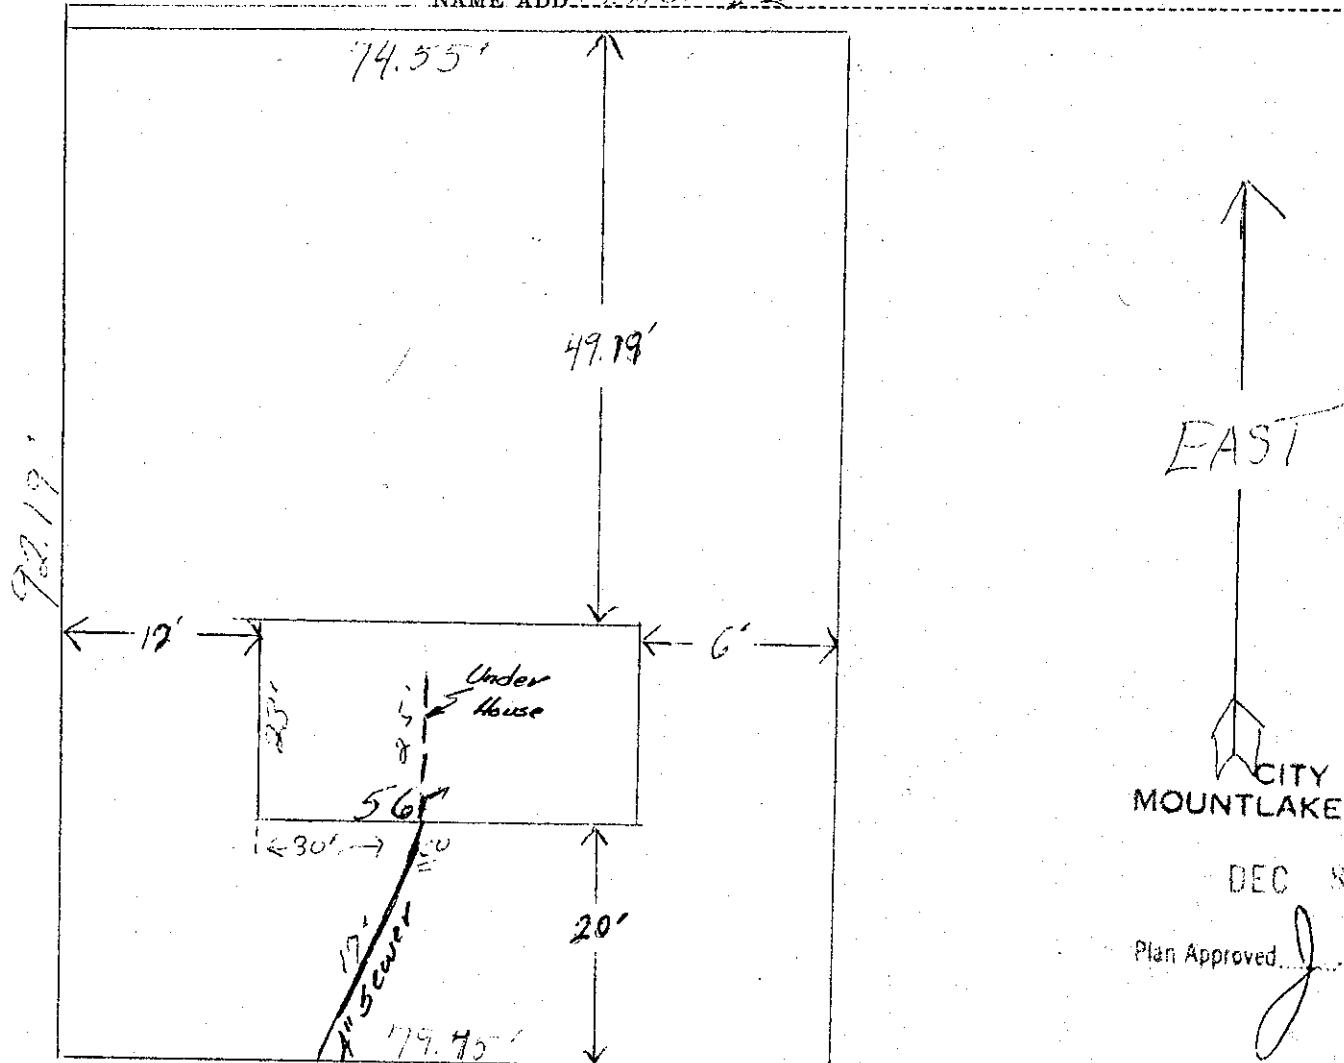NAME ADD. 2nd flr

DEC 8 1959

Plan Approved.

*J. Fairnes
SMH.*BACKFILL WORK ORDER ISSUED
SEWER WORK ORDER ISSUEDDEPOSIT \$ 10.00~~\$55.00~~

Approved:

DATE 12-8-59

12/7/59 - Object

BY Scott M Holton 1915

+ CO N.

APPLICATION

CARD No. *V*

The City of Mountlake Terrace

SIDE SEWER PERMIT


OUTSIDE INSIDE REPAIRS EASEMENT NO. *None*OWNER *Allen Peterson Coop.*
32401 -
HOUSE No. *22907 53 W*CONTRACTOR *Tap Notch Plumbering*PERMIT No. *1288*

STREET

AVENUE LOT No. *27*

BLOCK No.

NAME ADD.

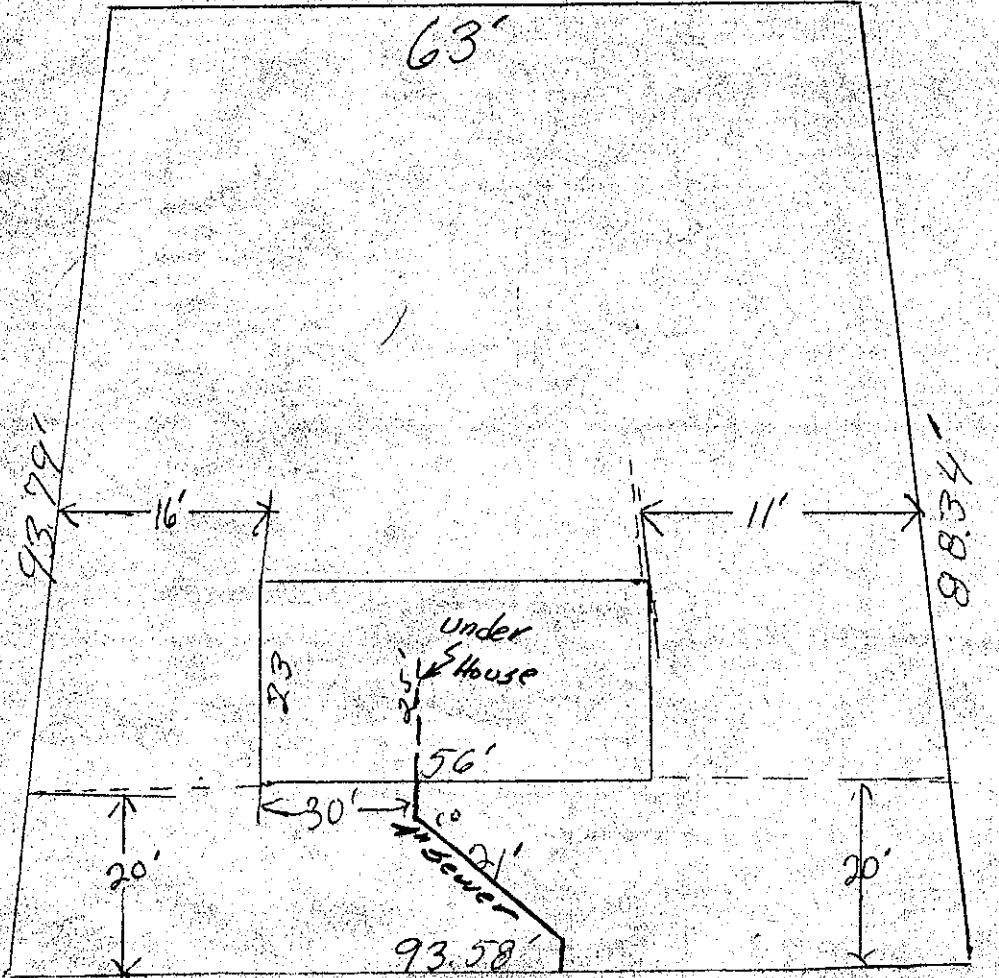Division 22CITY OF
MOUNTLAKE TERRACE

DEC 8 1959

Plan Approved:

*J. Fairnes
8mo.*

Date

Approved:

10.00

DEPOSIT:

BACKFILL WORK ORDER ISSUED

SEWER WORK ORDER ISSUED

5510 DATE 12-8-59 BY *Scott M Holton IWS*

Dated 12/8/59

fcst.

APPLICATION


The City of Mountlake Terrace

MOUNTLAKE TERRACE
CITY OFCARD No. *7401*

SIDE SEWER PERMIT

OUTSIDE INSIDE REPAIRS EASEMENT No. *None*OWNER Allen Peterson Case
22403
HOUSE NO. *12307-53 NW*CONTRACTOR Top Notch Plumbing PERMIT No. *1287*STREET AVENUE LOT No. *26*

BLOCK No.

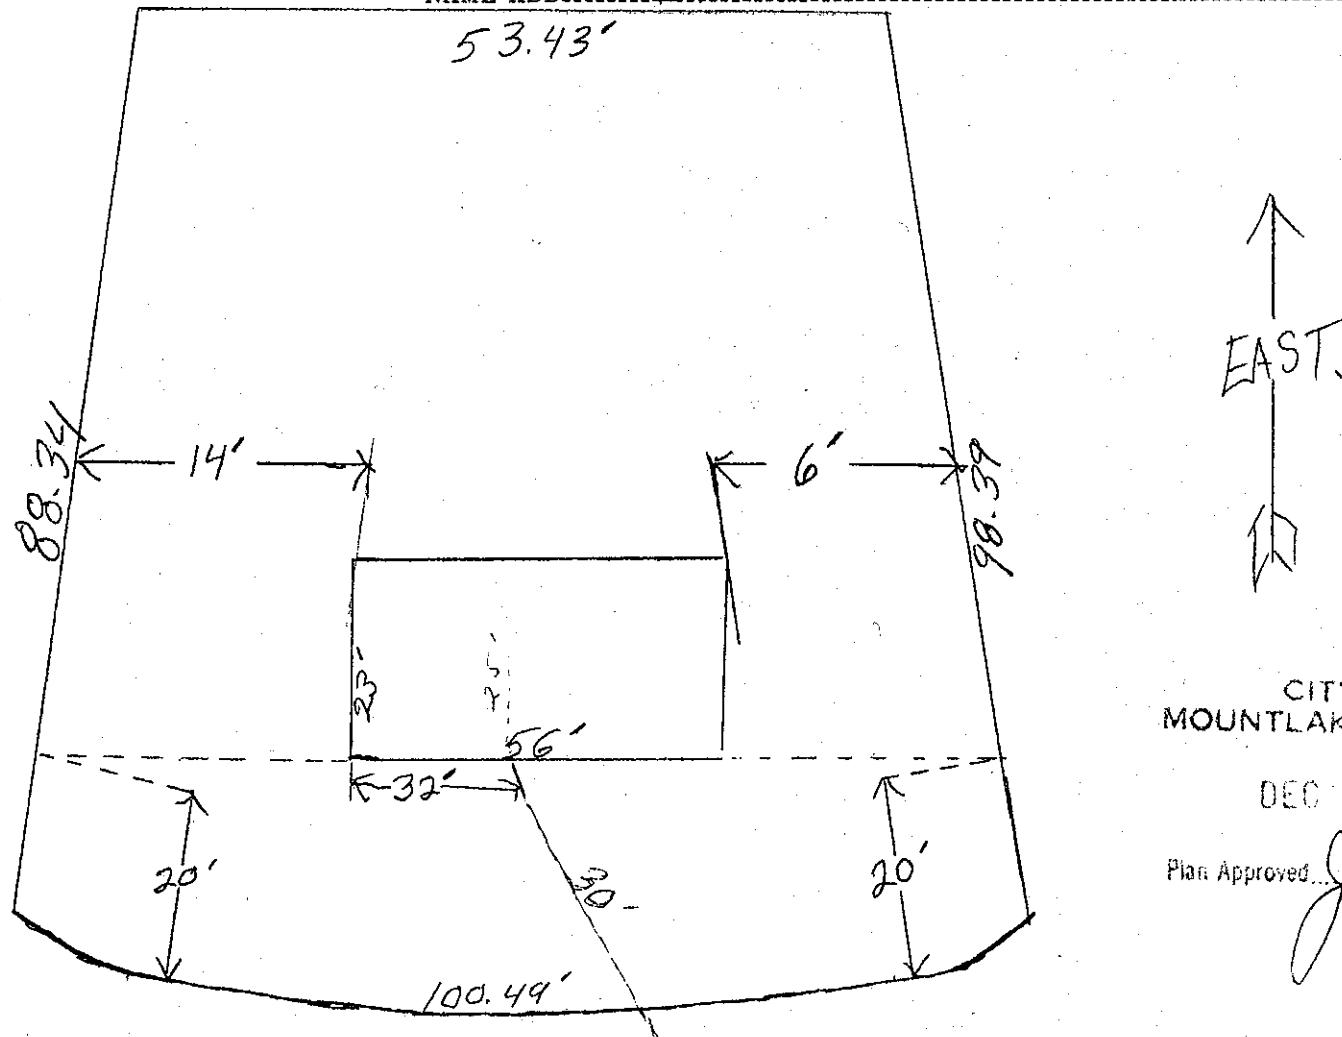NAME ADD. *DIV. 22**53.43'*CITY OF
MOUNTLAKE TERRACE

DEC 8 1959

Plan Approved

*J. Jacobs
8 M.G.H.*

BACKFILL WORK ORDER ISSUED

DEPOSIT, \$

10.00

Approved:

SEWER WORK ORDER ISSUED

*#5510**12/3/59*DATE *12-8-59*

BY

Scott M. Holton 105

The City Mountlake Terrace

SIDE PERMIT
OUTSIDE INSIDE REPAIRS

CARD No.

EASEMENT No.

OWNER Ormond & Ustals
HOUSE No. 22404-53rd west


CONTRACTOR Self

STREET 616
AVENUE LOT NO. 616

NAME ADD. Ormond & Ustals 22404-53rd west
Div. 4

PERMIT No. 128

BLOCK No. 1

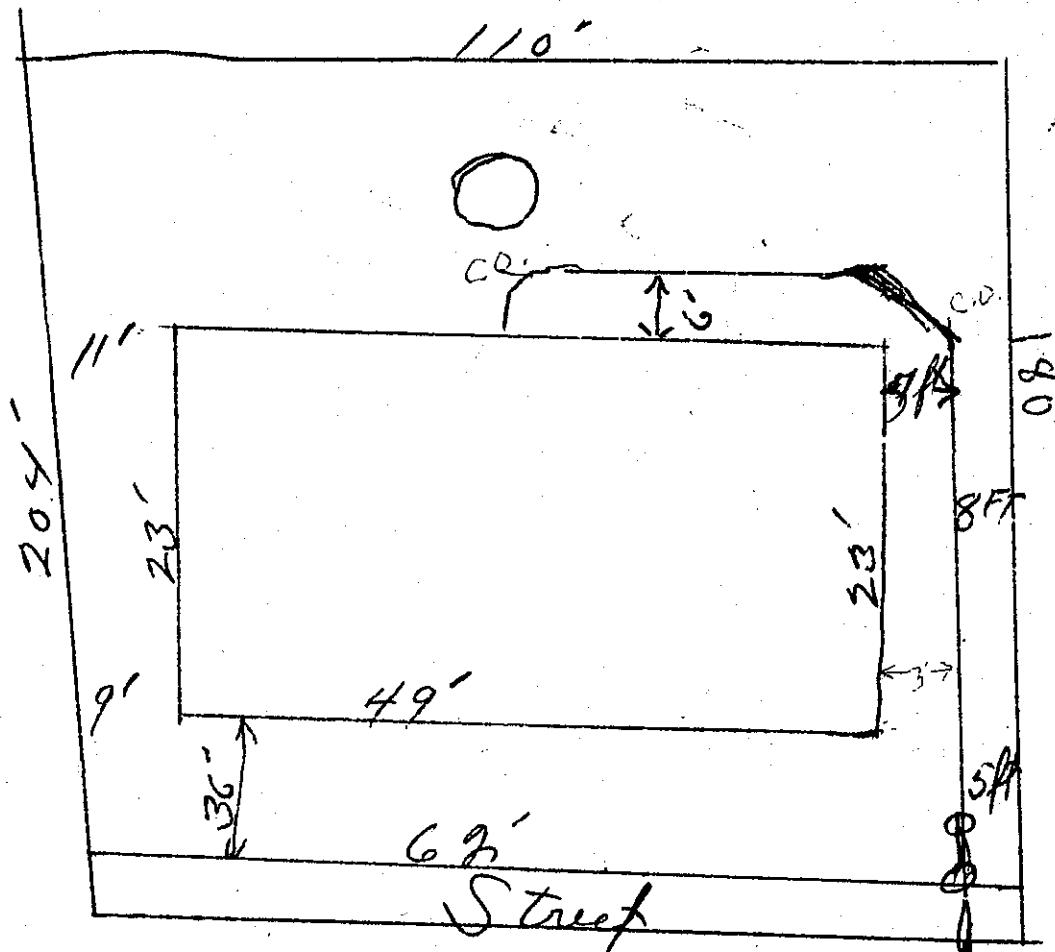

Date

DEPOSIT, \$ 10.00
#75014

Approved:

BACKFILL WORK ORDER ISSUED

SEWER WORK ORDER ISSUED

DATE 7-1-68

BY S. M. Holton INS CO

APPLICATION

CARD No.....

The City of Mountlake Terrace

SIDE SEWER PERMIT


OUTSIDE INSIDE REPAIRS

EASEMENT No.....

OWNER L. Wheeler
 HOUSE No. 22406 53W
 CONTRACTOR Evergreen
 STREET 45
 AVENUE LOT No.
 BLOCK No. Mt. Lk. Terrace Dist. 22

PERMIT No. 1543

NAME ADD.

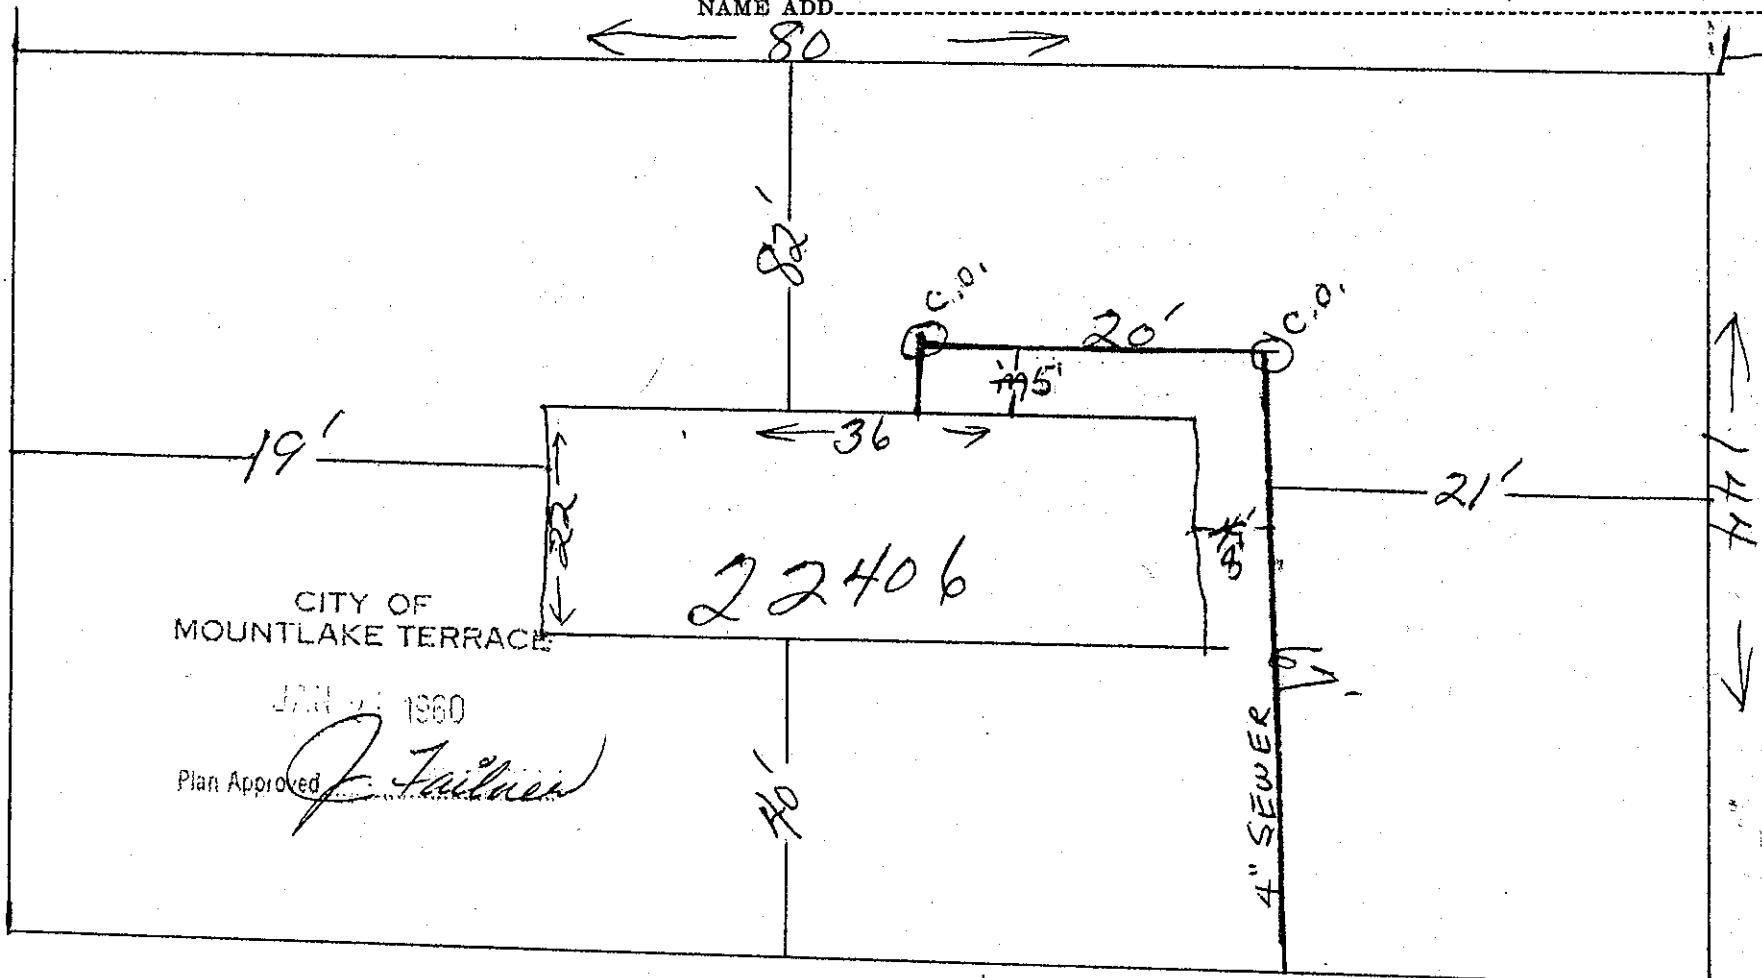

Date

BACKFILL WORK ORDER ISSUED
SEWER WORK ORDER ISSUED

DEPOSIT, \$10.00

1/21/60
#557

Approved:

DATE 1-22-60 BY

N.C.

Scott M Holton H.S.C.

APPLICATION

The City of Mountlake Terrace

SIDE SEWER PERMIT

OUTSIDE INSIDE REPAIRS

CARD No.

EASEMENT No. ✓

OWNER

CONTRACTOR

PERMIT NO.

HOUSE NO.


STREET

AVENUE LOT No.

BLOCK No.

NAME ADD

22

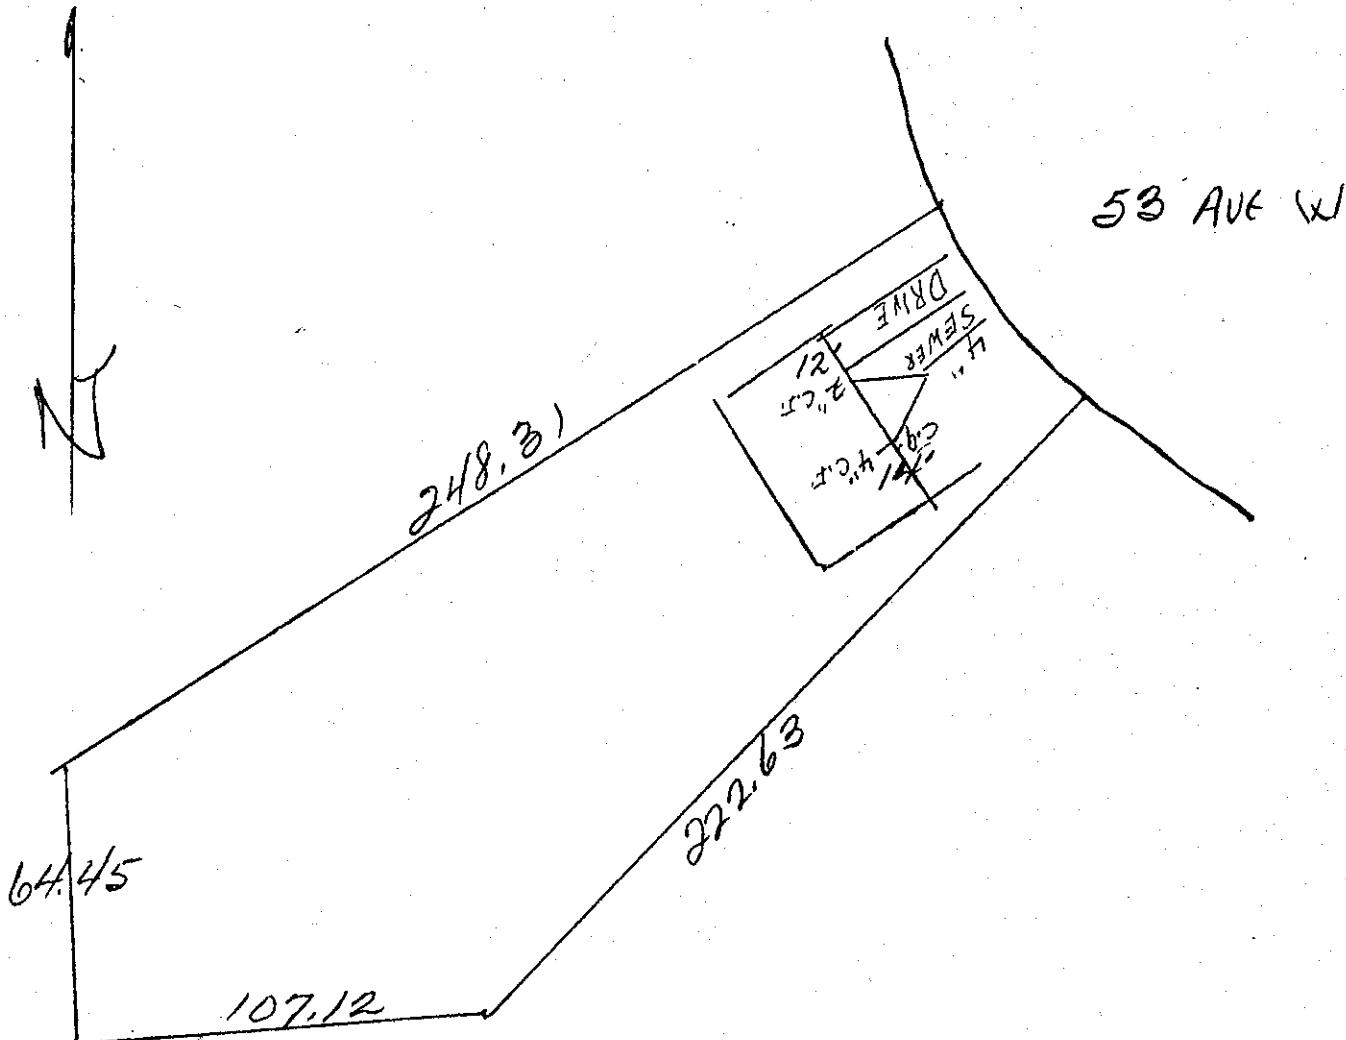

Date

Approved:

BACKFILL WORK ORDER ISSUED

DEPOSIT, \$

10.00

SEWER WORK ORDER ISSUED

#1857
9/2/60 84

DATE 10-6-60

BY S. M. Hilton INS+CON

APPLICATION

CARD NO.

The City of Mountlake Terrace

SIDE SEWER PERMIT

OUTSIDE INSIDE REPAIRS

EASEMENT No.

OWNER MILTON W. & PATRICIA M. WRIGHT
HOUSE No. 22412 - S-3 W.

CONTRACTOR

Jeff TORNOTCH

PERMIT No. 911


580

STREET

AVENUE LOT No. 42

BLOCK No. 22

NAME ADD.

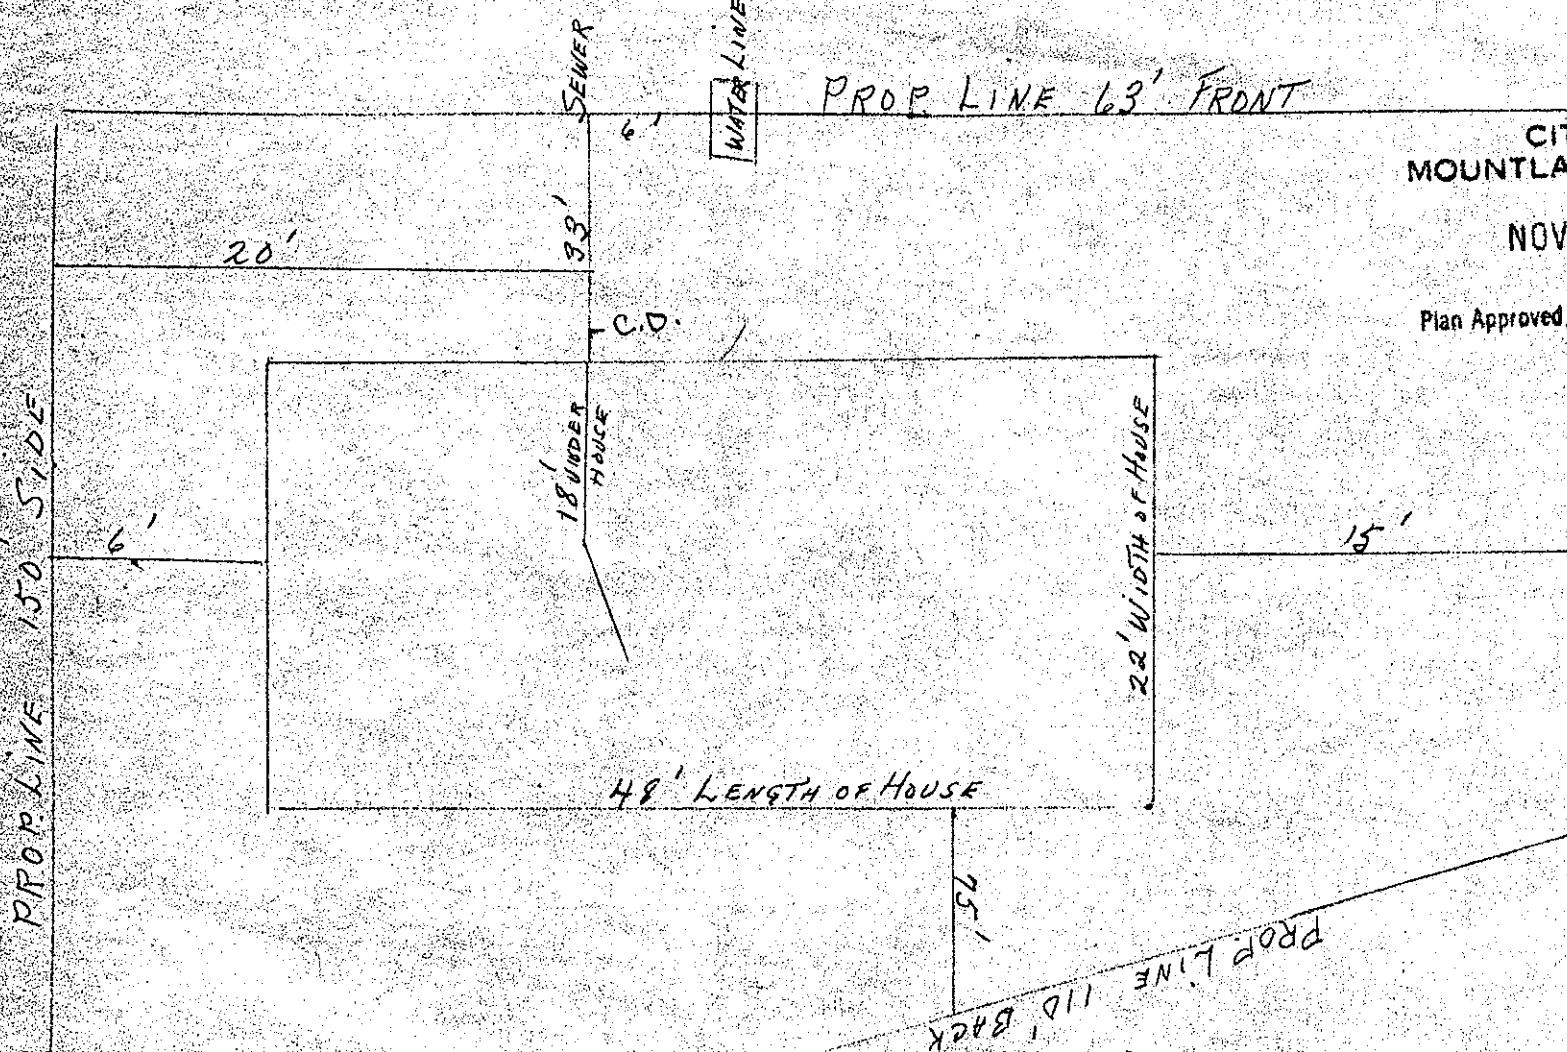CITY OF
MOUNTLAKE TERRACE

NOV 24 1959

Plan Approved

J. Fairless
sm

PROPLINE 10' DEEP

Date

Approved:

BACKFILL WORK ORDER ISSUED

DEPOSIT \$ 10.00

SEWER WORK ORDER ISSUED

9/25/59
#377

DATE 12-12-60

BY

S. M. Holton INST CON

The City of Mountlake Terrace

APPLICATION

CARD No.

SIDE SEWER PERMIT

OUTSIDE INSIDE REPAIRS

EASEMENT No.

OWNER

J. R. Andersson

HOUSE No. 22414 - 53 W

CONTRACTOR

Self

PERMIT No.

STREET
AVENUE LOT NO.

41

BLOCK NO.

NAME ADD


DIV. #22

CITY OF
MOUNTLAKE TERRACE

APR 26 1960

Plan Approved,

S. M. Ahern

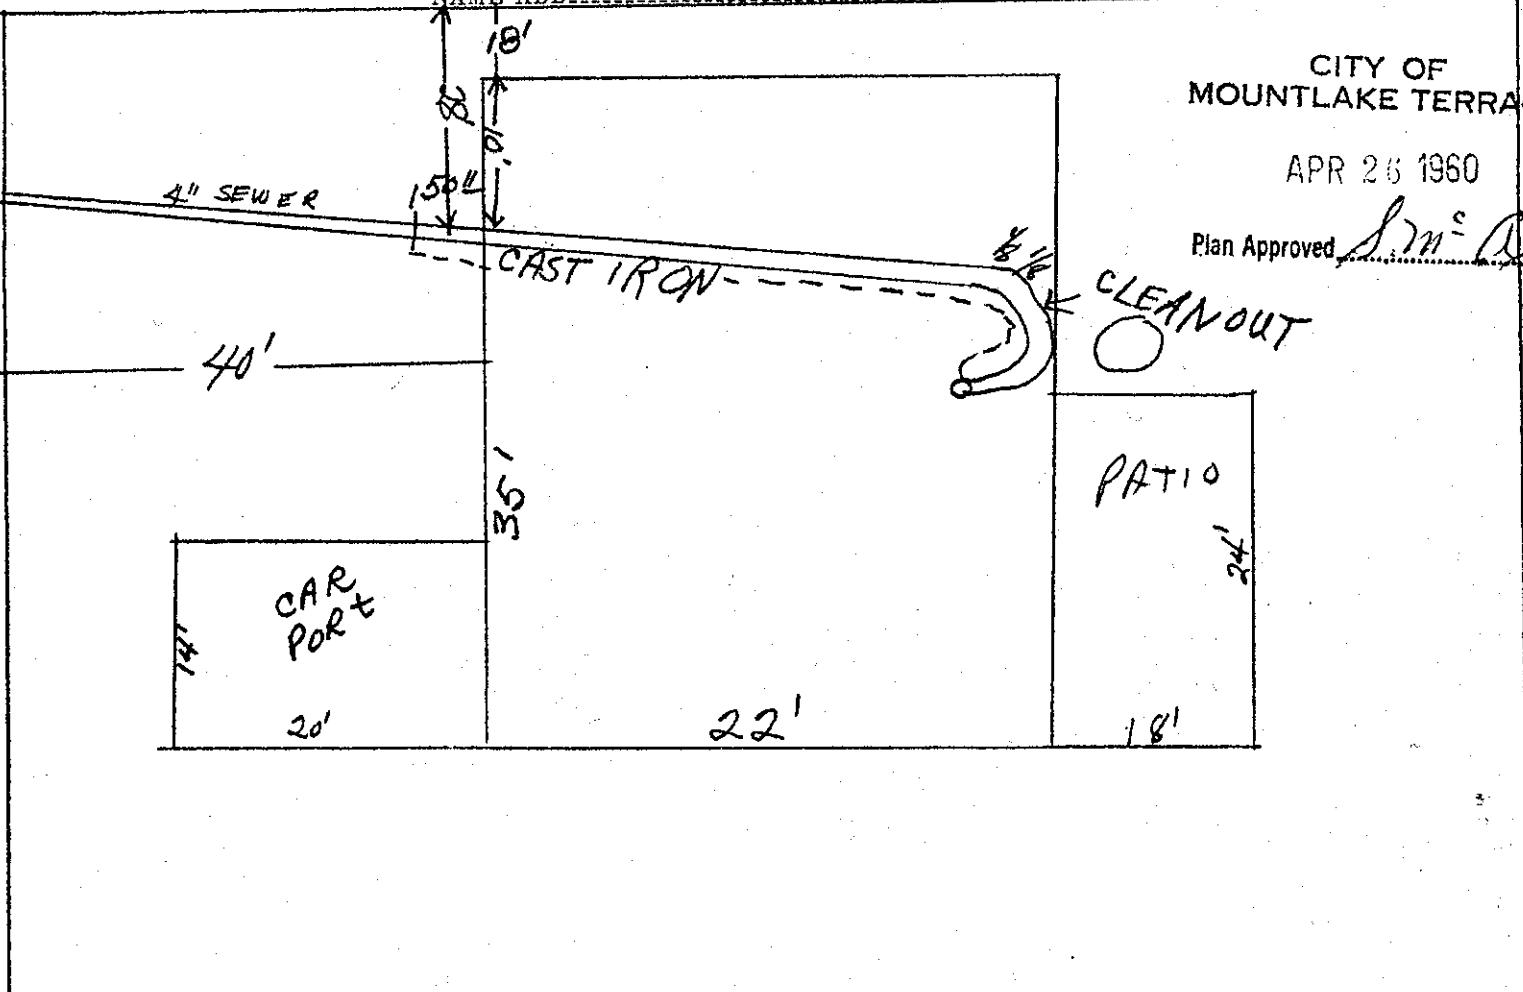

Date

Approved:

BACKFILL WORK ORDER ISSUED

DEPOSIT, \$10.00 4/23/60

SEWER WORK ORDER ISSUED

DATE 4-26-60 BY S. M. Holton / KST CON

1313

APPLICATION

The City of Mountlake Terrace

F. E. Cooper
CARD No.

SIDE SEWER PERMIT

OUTSIDE INSIDE REPAIRS

EASEMENT No. 135-8667

OWNER ALFRED E. COOPER

HOUSE No. 22801 53rd ST

CONTRACTOR R.D. Johnson Const. Co. PERMIT No. 1535

STREET


AVENUE LOT No. 1

BLOCK No. 2

NAME ADD.

Div. 12

60'

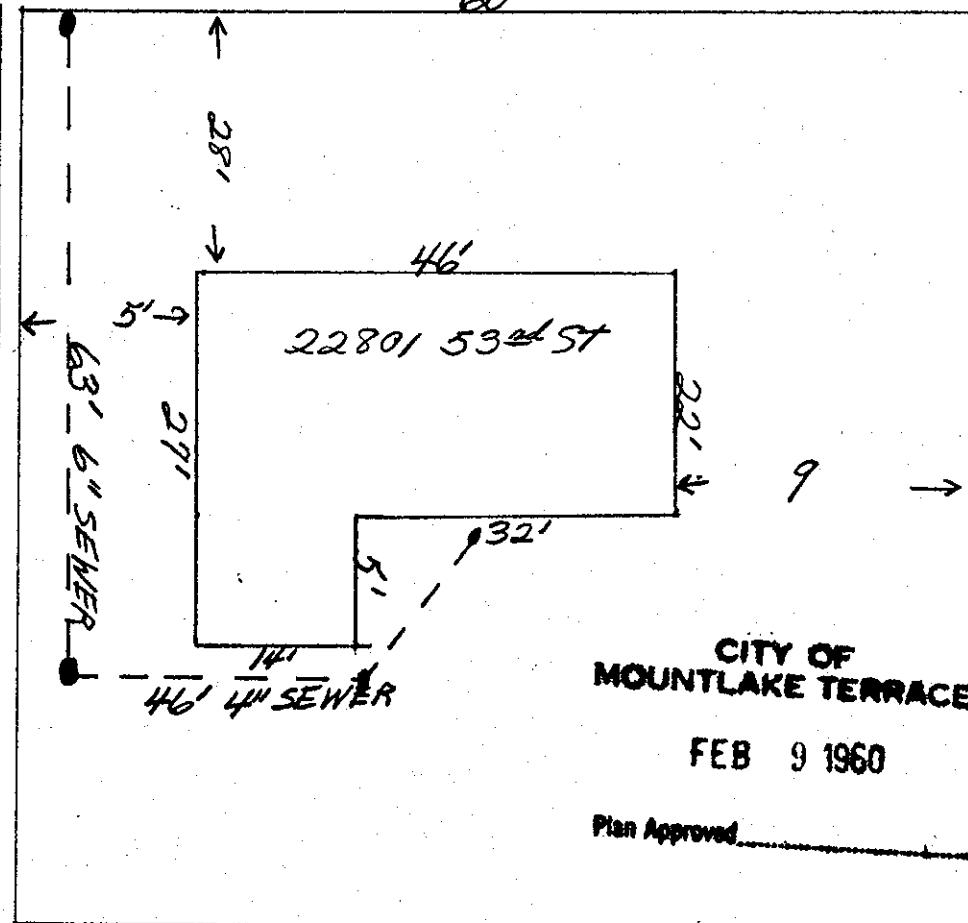22803 53rd St.

Date

Approved:

BACKFILL WORK ORDER ISSUED

DEPOSIT, \$10.00 1-20-60

SEWER WORK ORDER ISSUED

5818

DATE 2-10-60 BY Scott M Holton WSTCON

et

The City of Mountlake Terrace

APPLICATION

SIDE SEWER PERMIT
OUTSIDE INSIDE REPAIRS

Oscar

Parell

CARD No.

EASEMENT No. 13586~~6~~7

OWNER OSCAR PARELL

HOUSE No. 22803 53~~W~~ ST


CONTRACTOR R.R. Johnson Const. Co.

PERMIT No. 1536

STREET AVENUE LOT No. 2

BLOCK No. 2

NAME ADD.

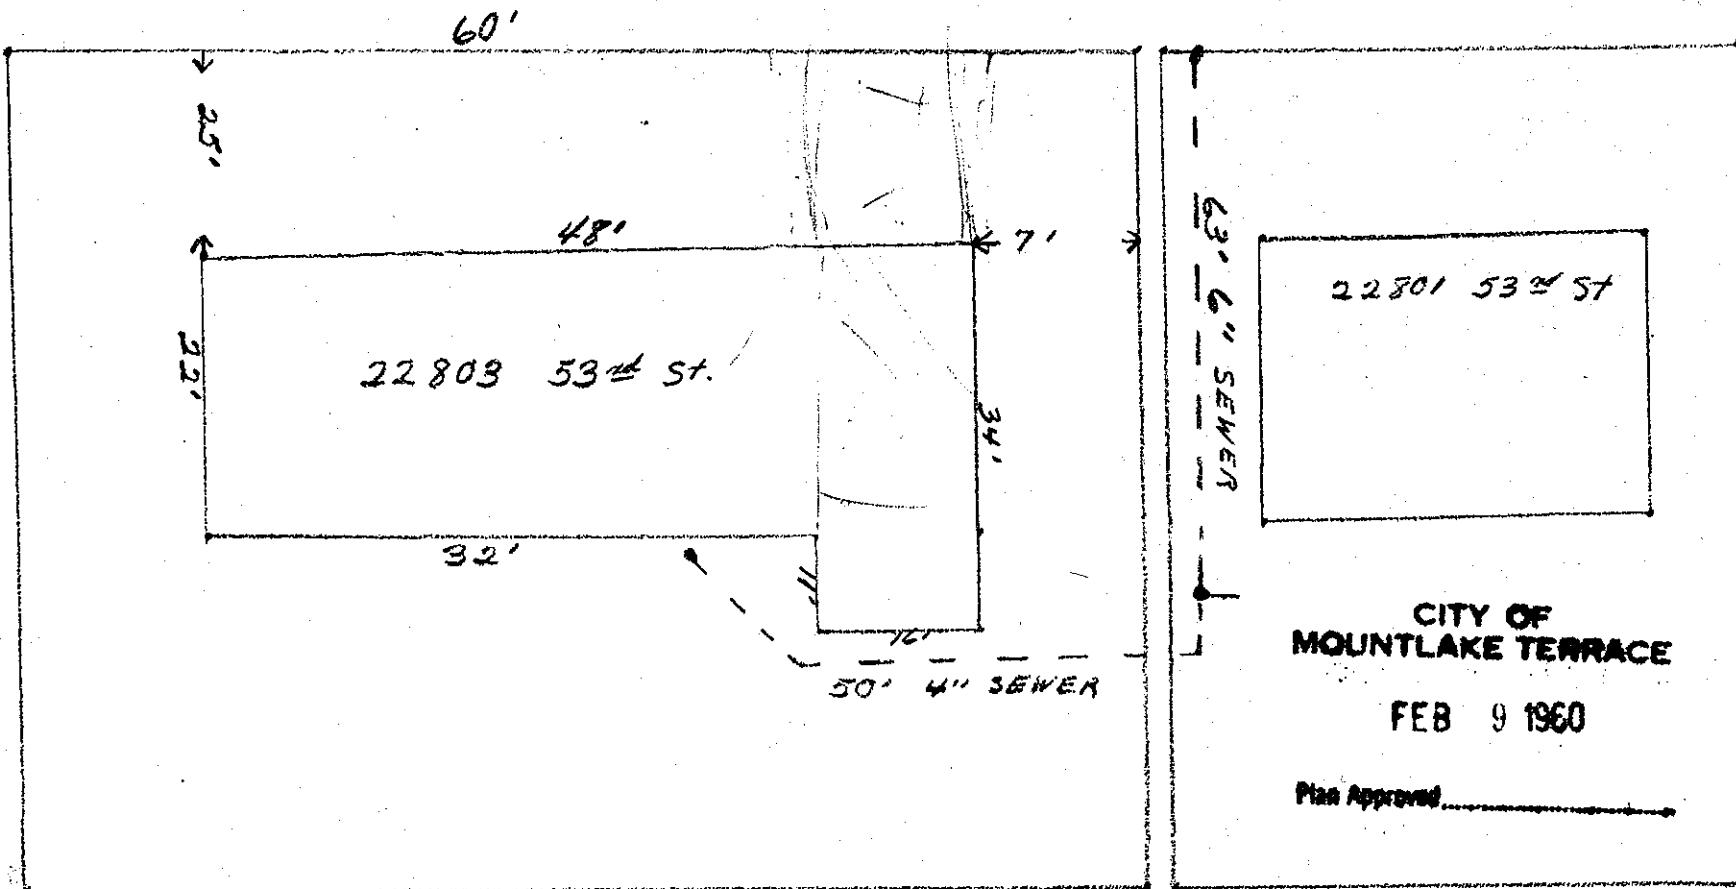

CITY OF
MOUNTLAKE TERRACE

FEB 9 1960

Plan Approved

BACKFILL WORK ORDER ISSUED
SEWER WORK ORDER ISSUED

Date

DEPOSIT, \$10.00
1-20-60
5818

Approved:

DATE 2-10-60 BY Scott M Holton/MS/CON

APPLICATION


The City of Mountlake Terrace

CARD No. *(initials)*

SIDE SEWER PERMIT

OUTSIDE INSIDE REPAIRS EASEMENT No. *1377075*OWNER *Donald & Joan H. Smith*
HOUSE No. *72804 69 53rd St.*

CONTRACTOR _____

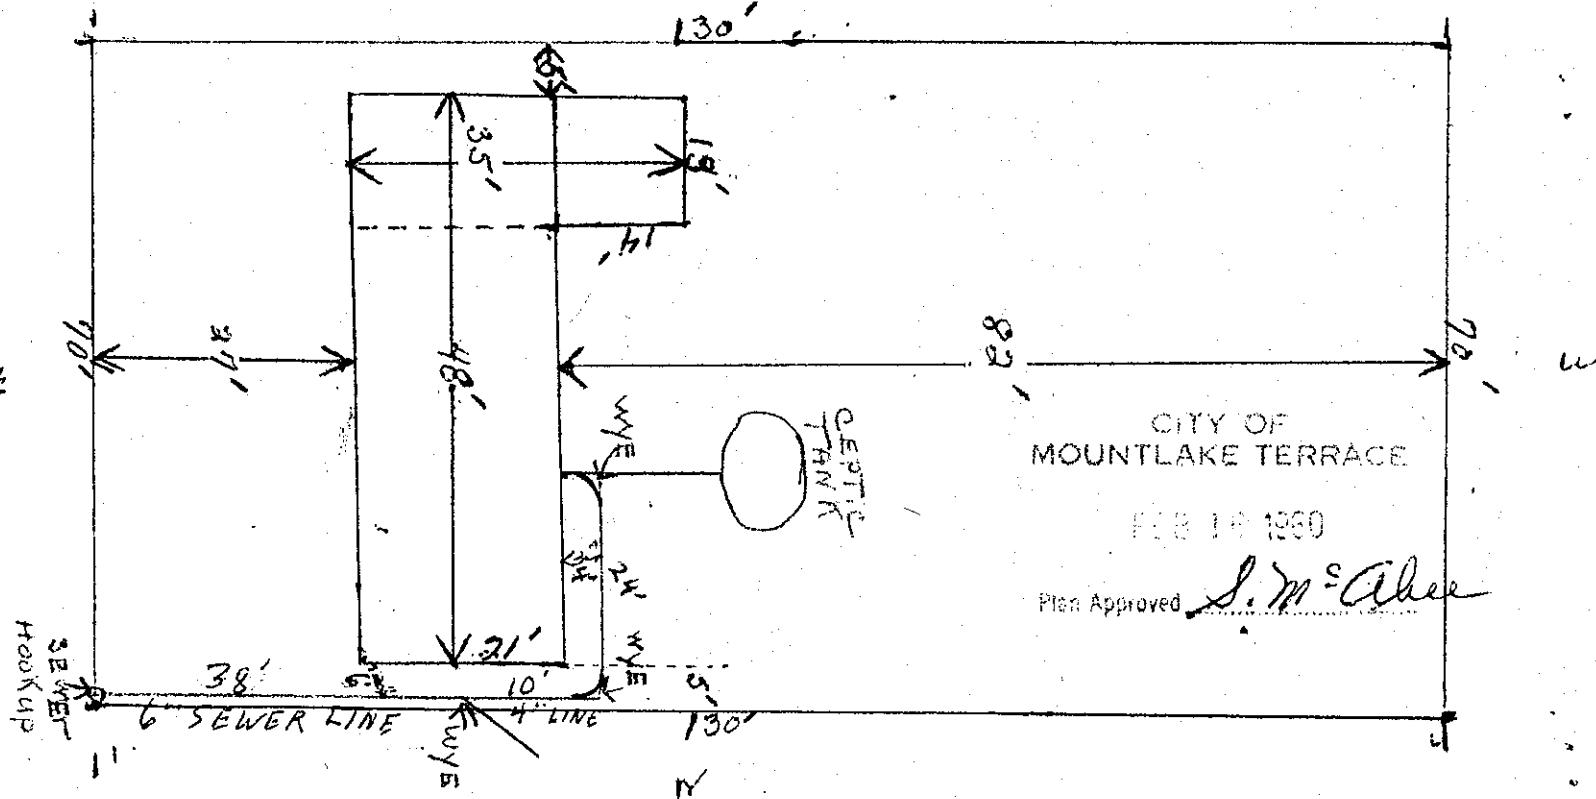STREET
AVENUE LOT No. *19*PERMIT No. *1591*BLOCK No. *I*NAME ADD *Unit 12*

Date

Approved:

BACKFILL WORK ORDER ISSUED
SEWER WORK ORDER ISSUEDDEPOSIT, \$ *10⁰⁰* *1-28-60*5877 DATE *2-16-60*

BY

S. Scott M Holton INSTR CON

APPLICATION

SIDE SEWER PERMIT

The City of Mountlake Terrace

CARD No.

OUTSIDE INSIDE REPAIRS

EASEMENT No.

None

OWNER Robert J. Green

HOUSE No. 22805 - 53rd W

CONTRACTOR

Self

PERMIT No.

1732

STREET


AVENUE LOT No.

3

BLOCK No.

NAME ADD.

Div. 12

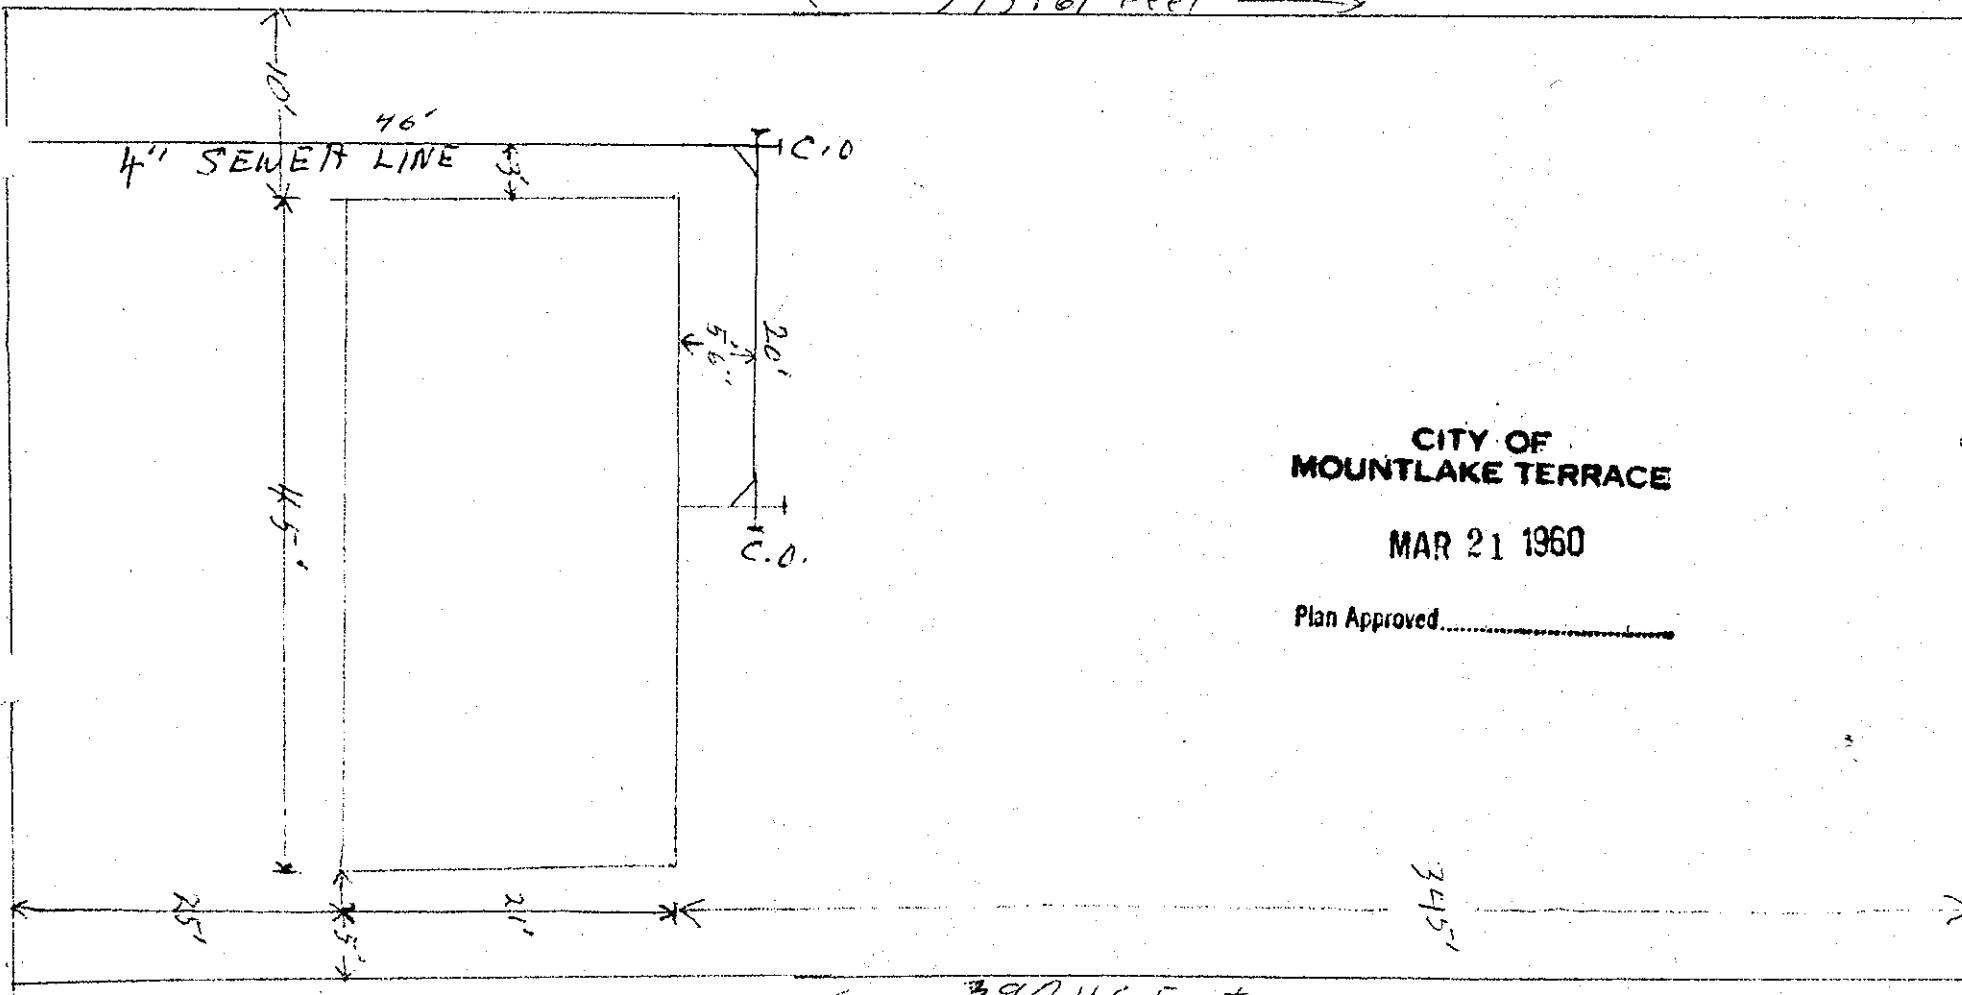 \leftarrow 393.61 Feet \rightarrow 

Date

Approved:

BACKFILL WORK ORDER ISSUED

DEPOSIT, \$ 100.00

SEWER WORK ORDER ISSUED

#6058

DATE 3-21-60

BY

Scott Holton INSTCON

3/15/60 89

The City of Mountlake Terrace

APPLICATION

HIREVIT DELINAN

CARD No.

SIDE SEWER PERMIT

OUTSIDE INSIDE REPAIRS

EASEMENT No. 1369298

OWNER Alfreda Silikas
HOUSE No. 22806 - 53 W.

CONTRACTOR B. and C.

STREET


AVENUE LOT NO. 18

DIV 12

BLOCK NO. 1

PERMIT NO. 1202

NAME ADD.

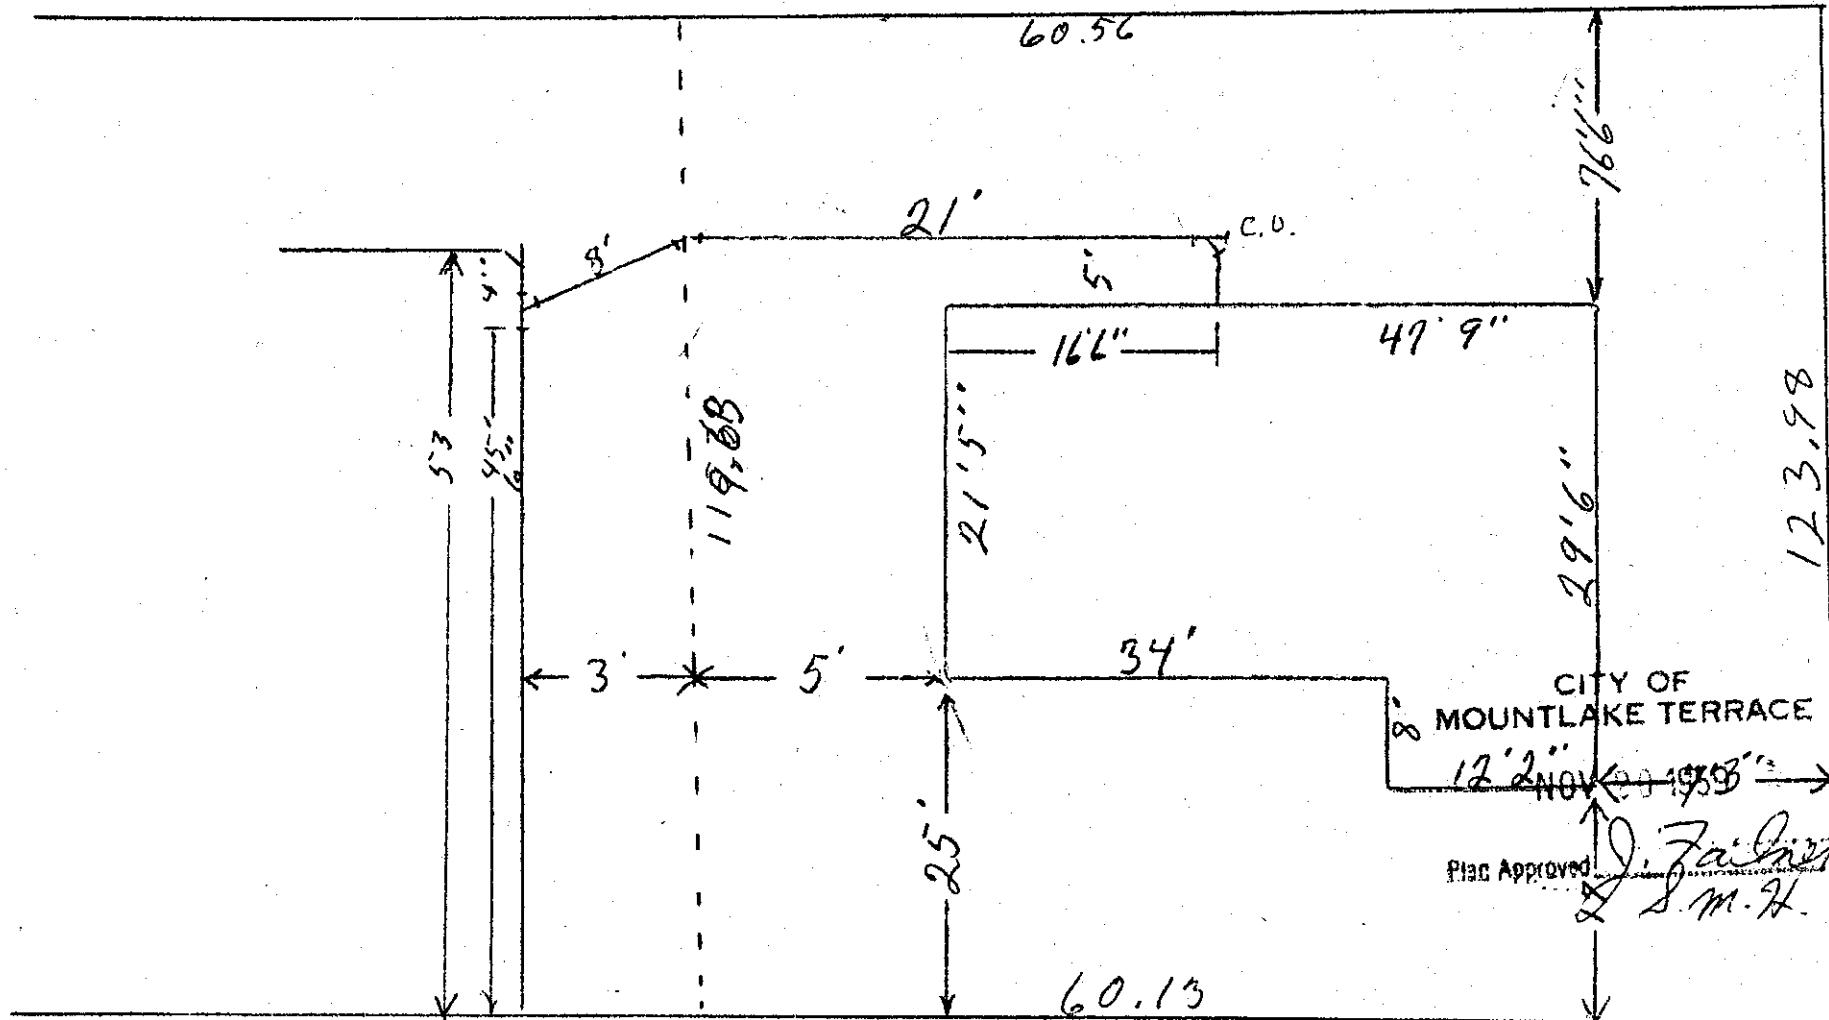

Date

Approved:

BACKFILL WORK ORDER ISSUED
SEWER WORK ORDER ISSUED

DEPOSIT, \$10.00

5424

DATE 11-20-59 BY

Scott M. Holtos INS
11/20/59 Dated 1-15-60 INS+CON SMP V.C.

APPL TION

The City of Mountlake Terrace

CARD No.

SIDE SEWER PERMIT

OUTSIDE INSIDE REPAIRS

EASEMENT No. 1356293

OWNER Mrs. Juanita Pyle
HOUSE No. 22807 53rd W.


CONTRACTOR T & M Conat.

PERMIT No. 990

STREET AVENUE LOT No. 4

BLOCK No. 2

NAME ADD. Div. #12

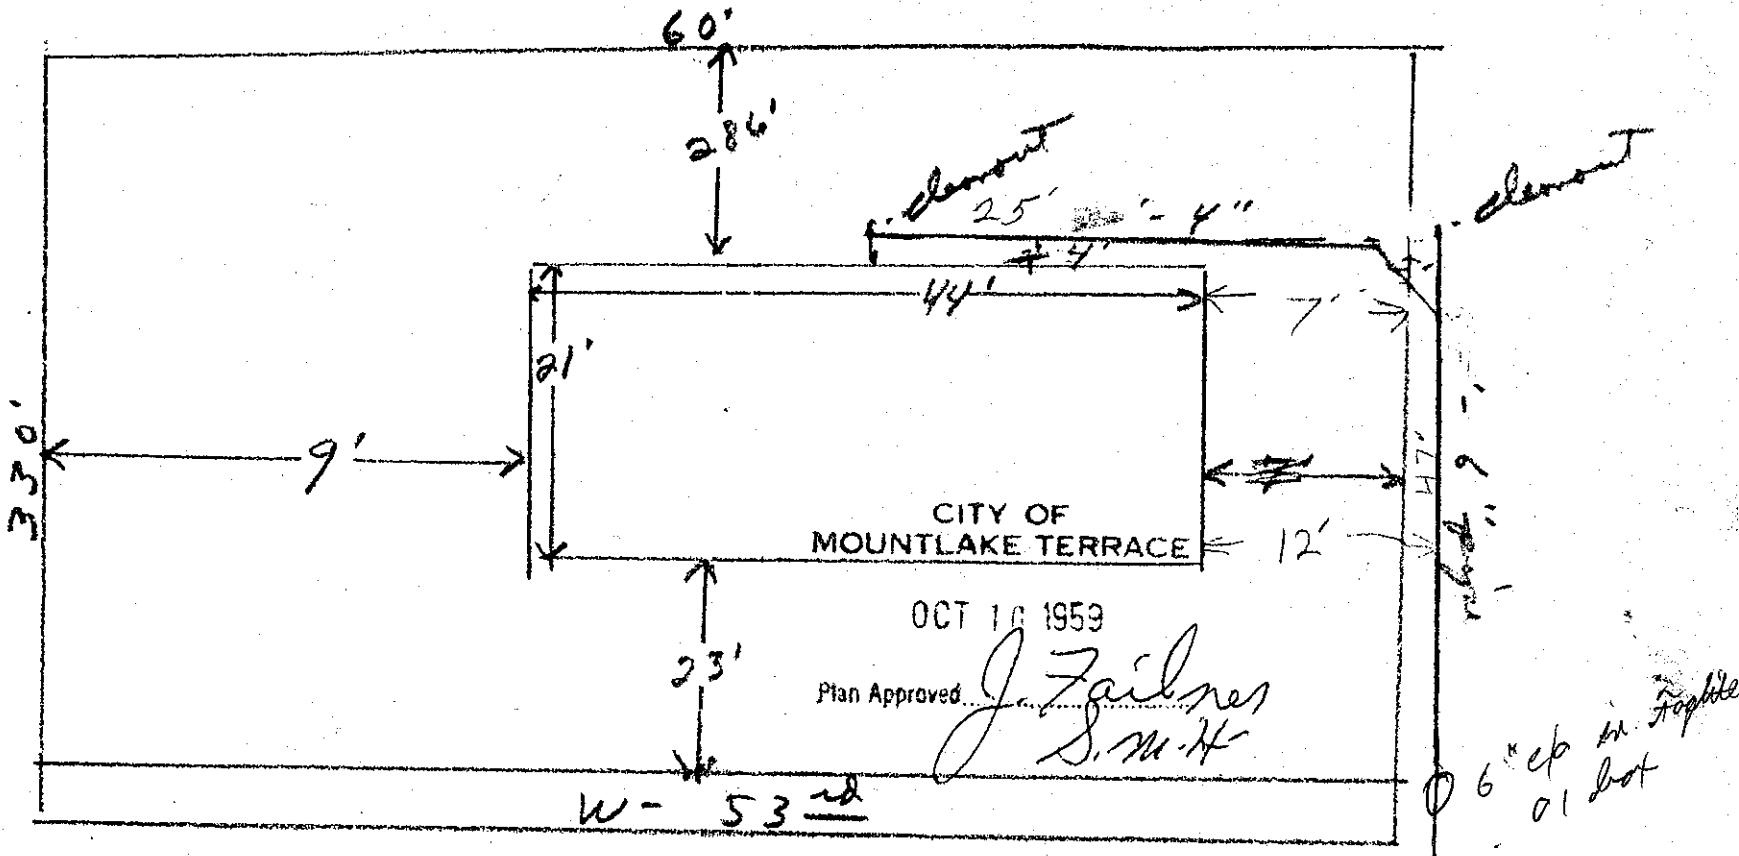

Date

Approved:

BACKFILL WORK ORDER ISSUED

DEPOSIT, \$ 10.00

SEWER WORK ORDER ISSUED

Reg. 5181
By sat-

DATE 10-16-59 BY

Scott M Holton M/S
N.C.

The City of Mountlake Terrace

APPLICATION

KEN YAKUM

CARD No.

SIDE SEWER PERMIT

OUTSIDE INSIDE REPAIRS

EASEMENT No. 136, 92, 98

OWNER Ken Yakum

HOUSE No. 22808 - 53.W.

CONTRACTOR B. and E.

PERMIT No. 1203


STREET

AVENUE LOT No. 19

DIV-12

BLOCK No. 1

NAME ADD.

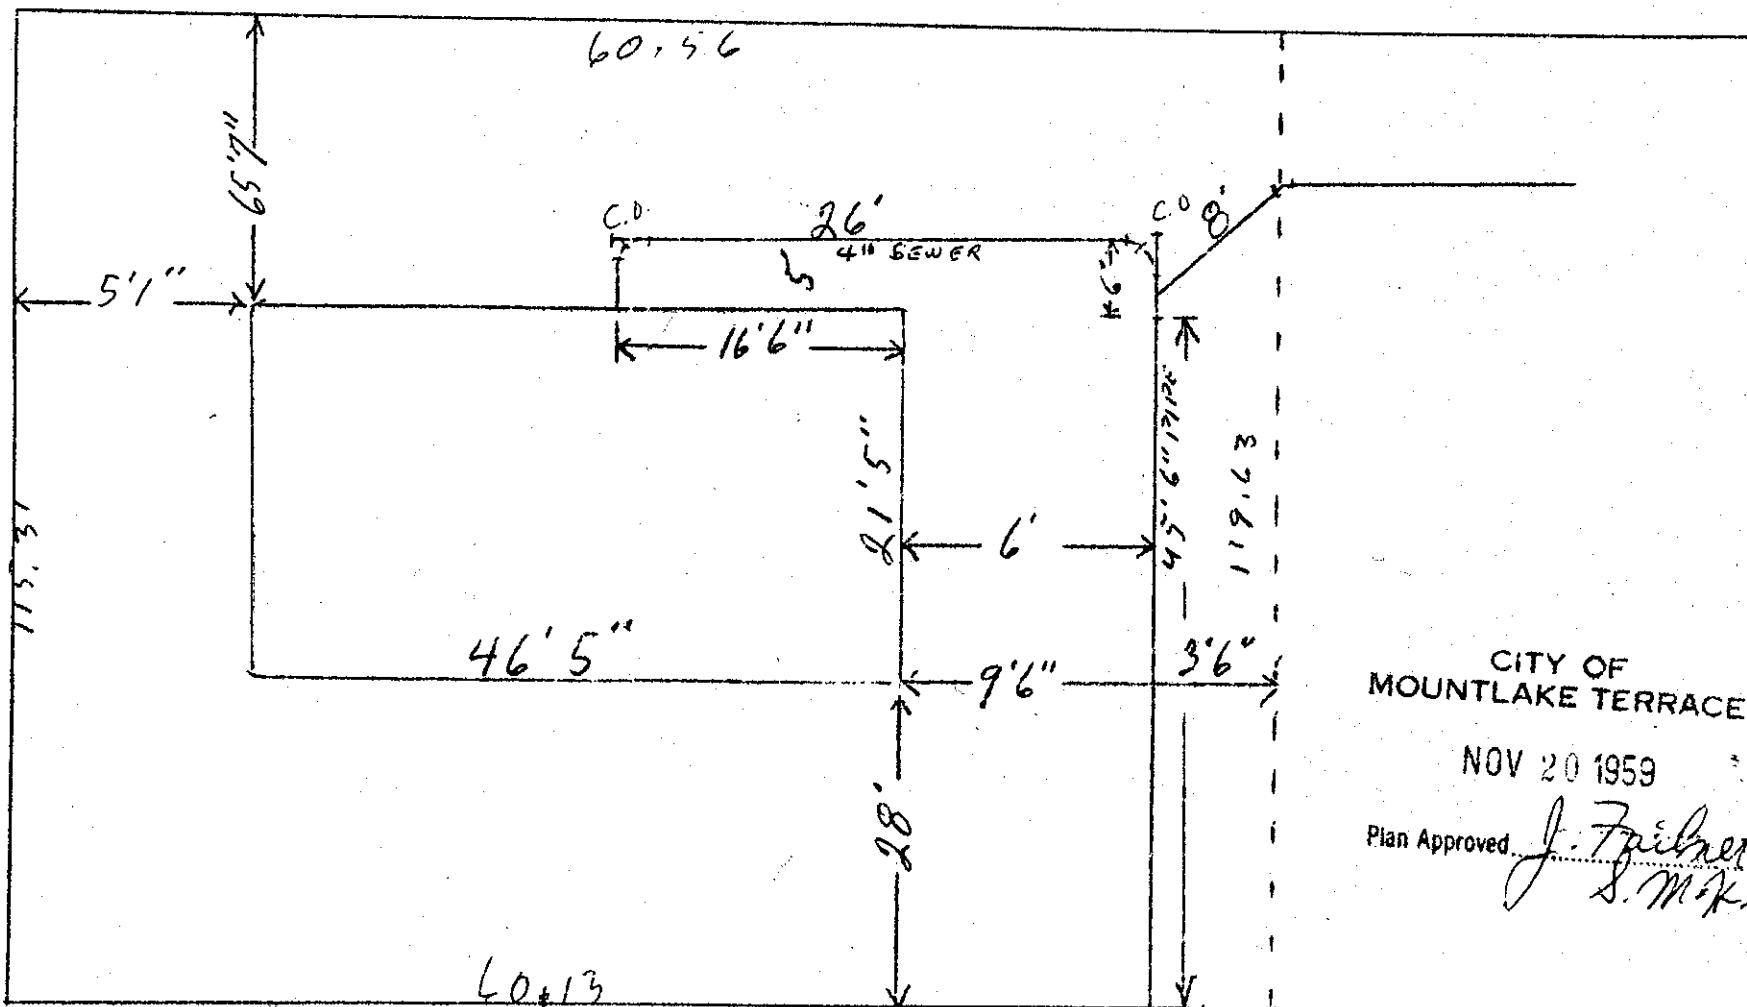

Date

Approved:

BACKFILL WORK ORDER ISSUED
SEWER WORK ORDER ISSUED

DEPOSIT, \$10.00

Reg. 5424 DATE 11-20-59 BY Scott M Holton IWS
11/20/59 Dated 1-14-60 INS+CON 8m/H C.C.

APPLICATION

CARD No.

The City of Mountlake Terrace

SIDE SEWER PERMIT

OUTSIDE INSIDE REPAIRS

EASEMENT No. 1356293

OWNER Robert R. Schultz

HOUSE NO. 22809 - W - 53rd


CONTRACTOR T + M Conat.

PERMIT No. 989

STREET
AVENUE LOT No. 5

BLOCK No. 2

NAME ADD. Div 12.

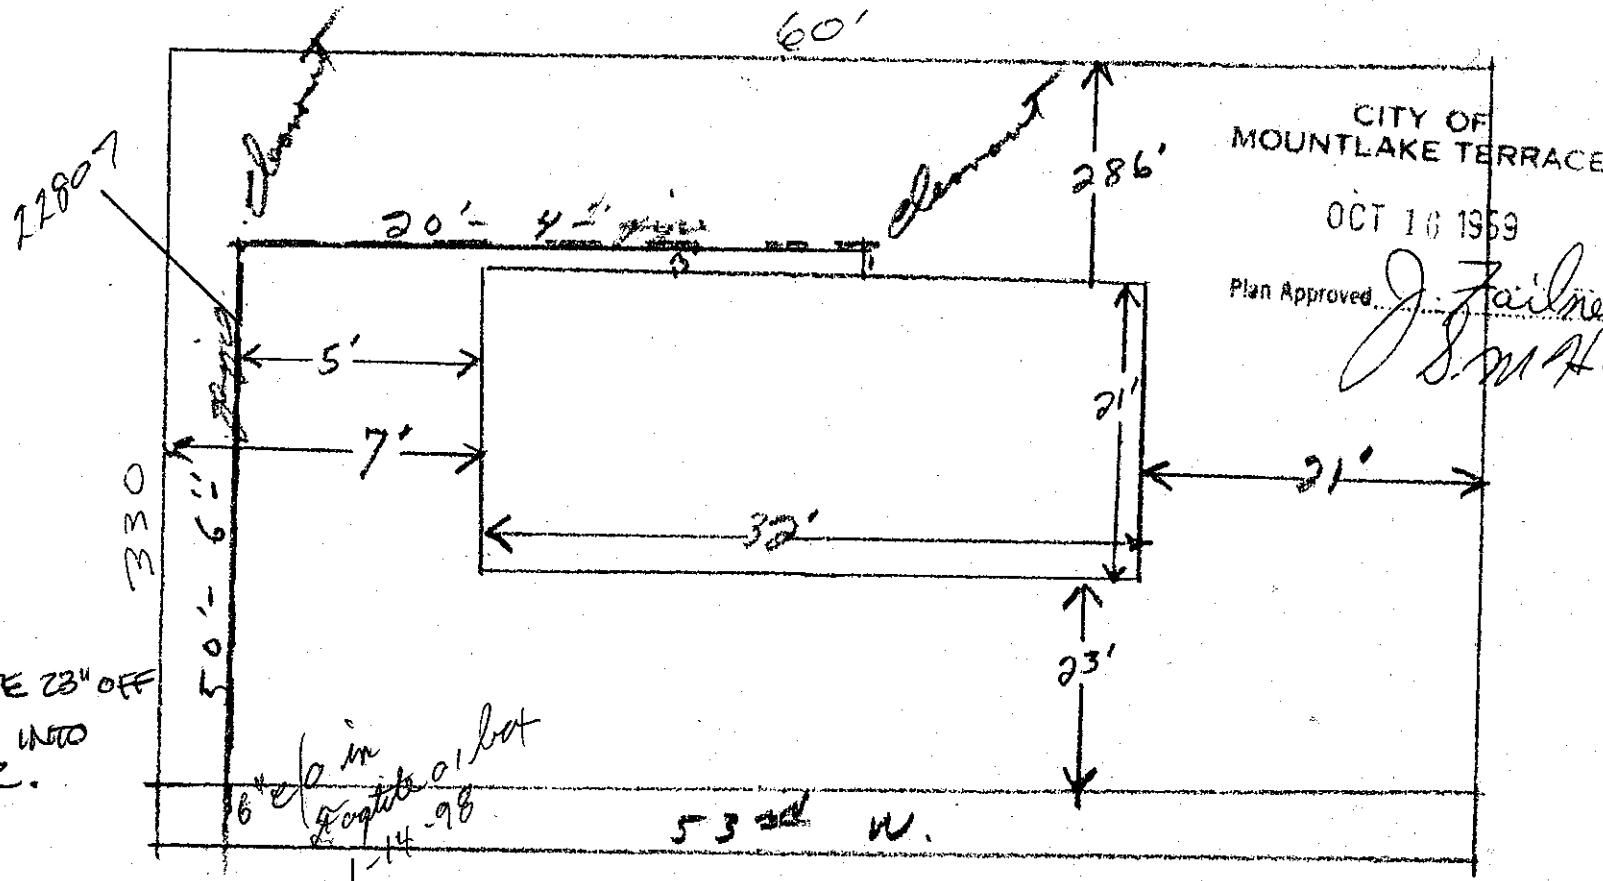

Date

Approved:

BACKFILL WORK ORDER ISSUED
SEWER WORK ORDER ISSUED

DEPOSIT, \$ 10,00

Rec. 5181

DATE 10-16-59 BY

Scott M Holton N.C.

Aug 10/5/59

APPLICATION

ED CREESEY
CARD No.

The City of Mountlake Terrace


SIDE SEWER PERMIT

OUTSIDE INSIDE REPAIRS

EASEMENT No.

Guy STICKLY REALTY - BELLEVUEOWNER ED or Dolly CREESEYCONTRACTOR selfPERMIT No. 2582HOUSE No. 22810 - 53 W.STREET AVENUE LOT No. 22810 - 53 WBLOCK No. 11

NAME ADD.

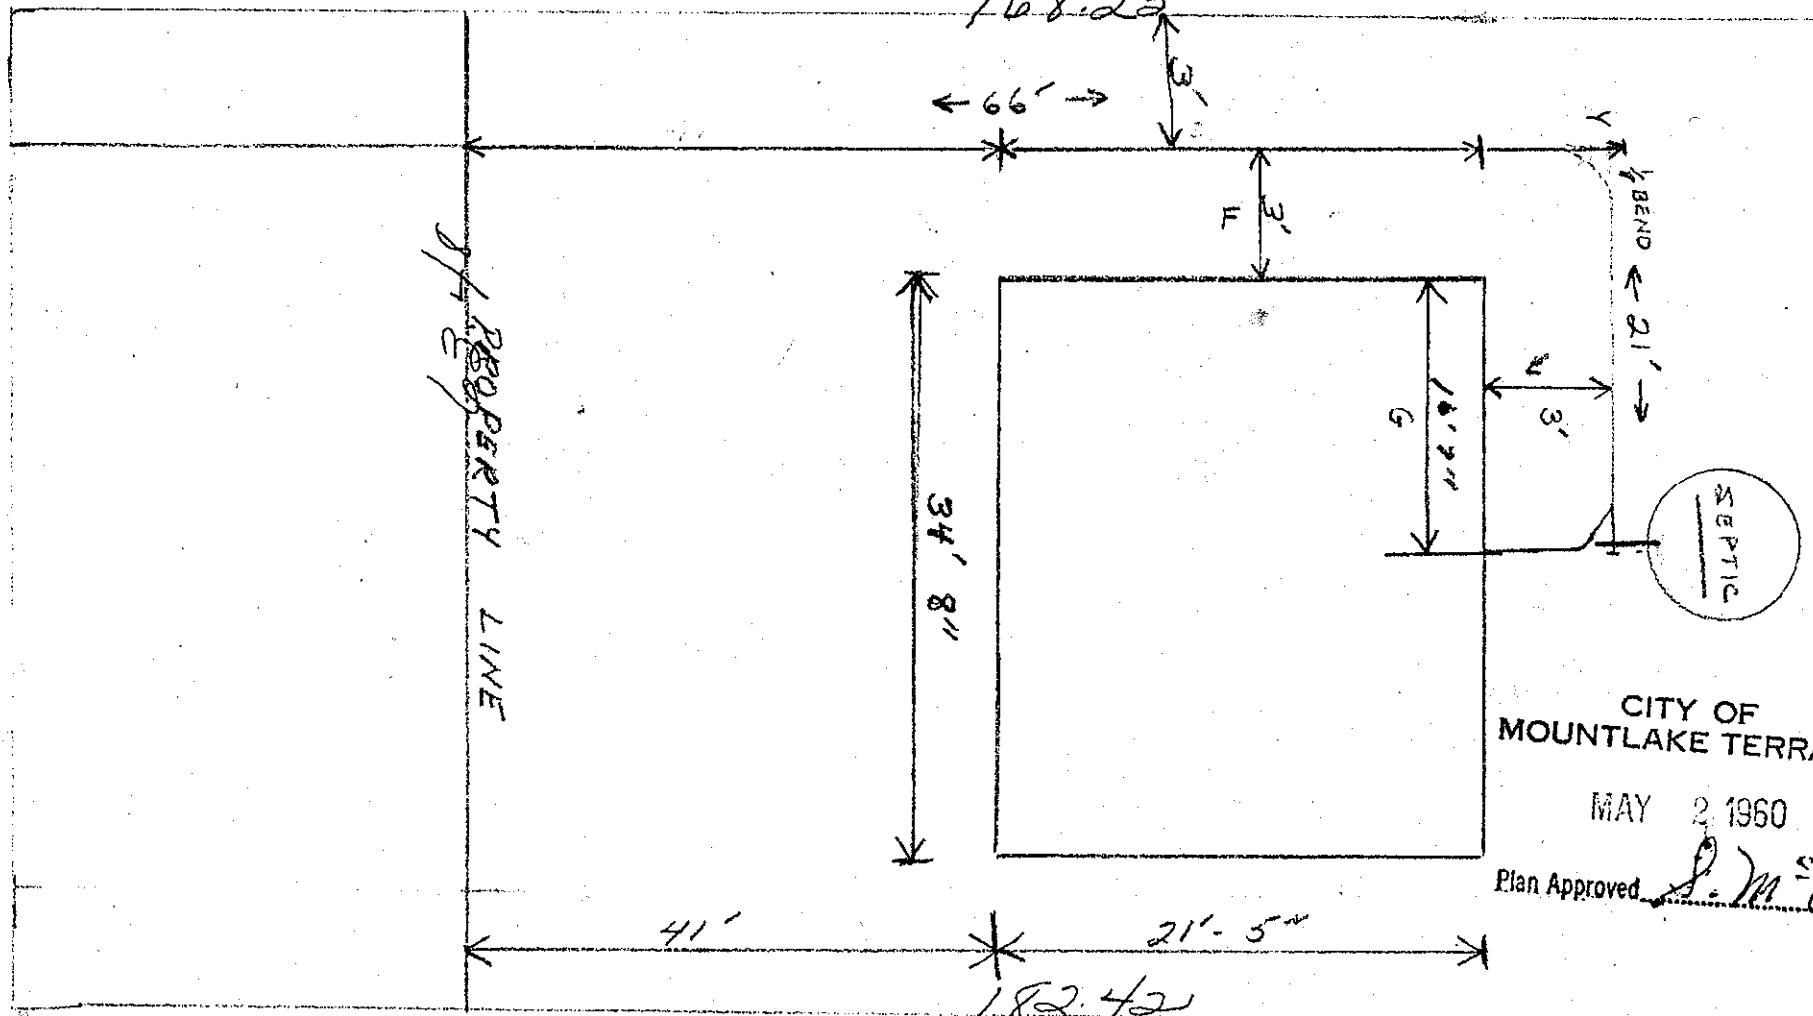168-25 slid 1st 16

Date

Approved:

BACKFILL WORK ORDER ISSUED

DEPOSIT, \$ 10.00

SEWER WORK ORDER ISSUED

DATE 5-2-60 BY S. M. Holton MSTRCON

Rec'd # 1358

Reeni Freeman

The City of Mountlake Terrace

APPLICATION

M. E. HENDERSON

CARD No.

1389061

SIDE SEWER PERMIT

OUTSIDE INSIDE REPAIRS

EASEMENT No.

2214

OWNER Morris E Anderson

HOUSE NO. 22902 4153-18


CONTRACTOR *self*

PERMIT No.

STREET AVENUE LOT No. 15

BLOCK No. 1

NAME ADD *Sec 12*

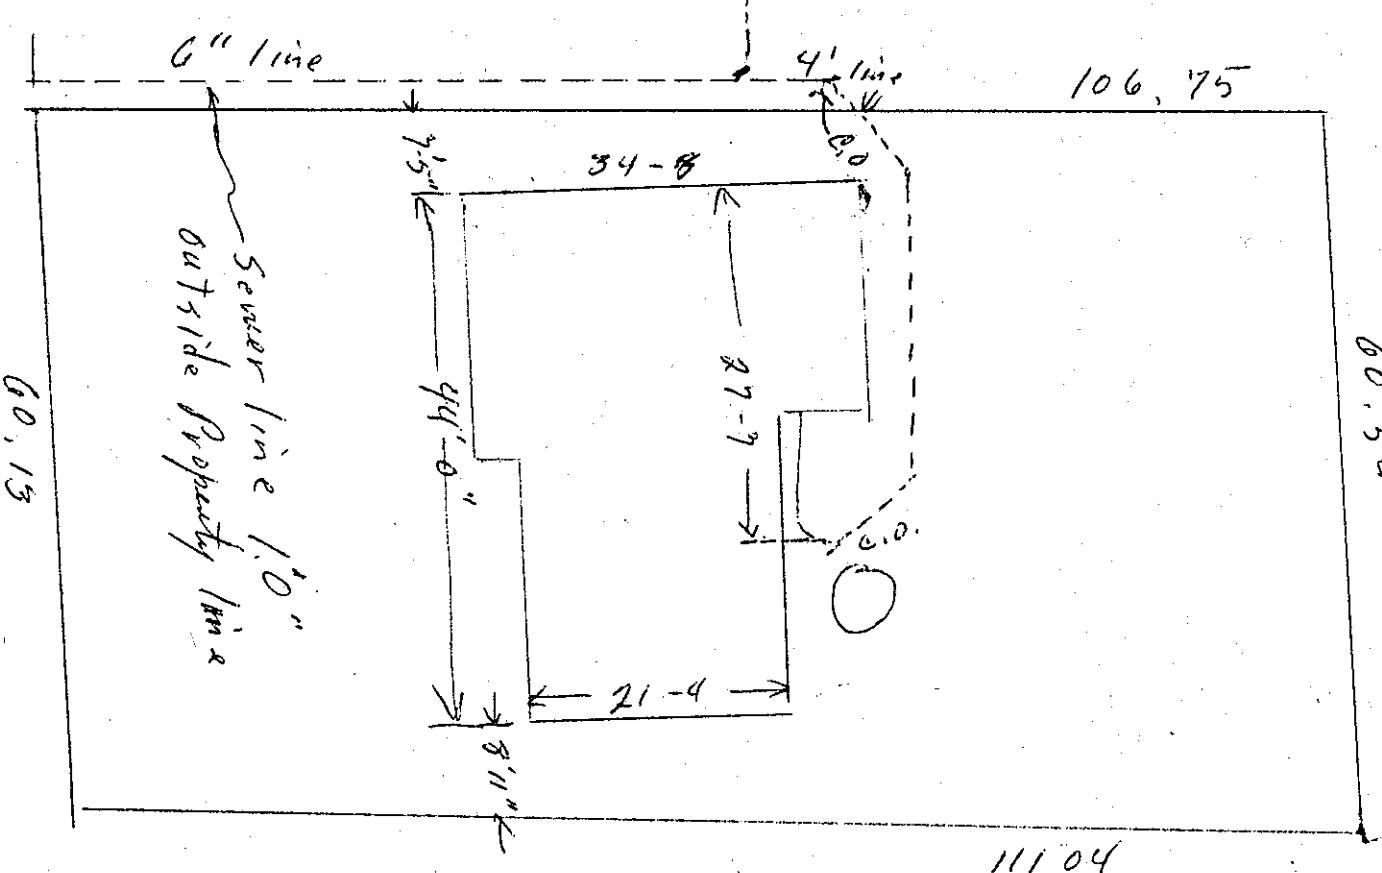

Date

10⁰⁰

Approved:

BACKFILL WORK ORDER ISSUED

DEPOSIT, \$

SEWER WORK ORDER ISSUED

rec 1023

DATE 4/4/60

BY

J. Moran supervisor

The City of Mountlake Terrace

APPLICATION

for

SIDE SEWER PERMIT

OUTSIDE INSIDE REPAIRS

CARL B. DEMING
CARD No.

EASEMENT No.

OWNER CARL B. DEMING

CONTRACTOR NONE

PERMIT No. 2389


HOUSE No. 22903

STREET
AVENUE LOT No. 53 RD. AVE. W. 7

BLOCK No. 2

NAME ADD. Alexis 12

75' 8>

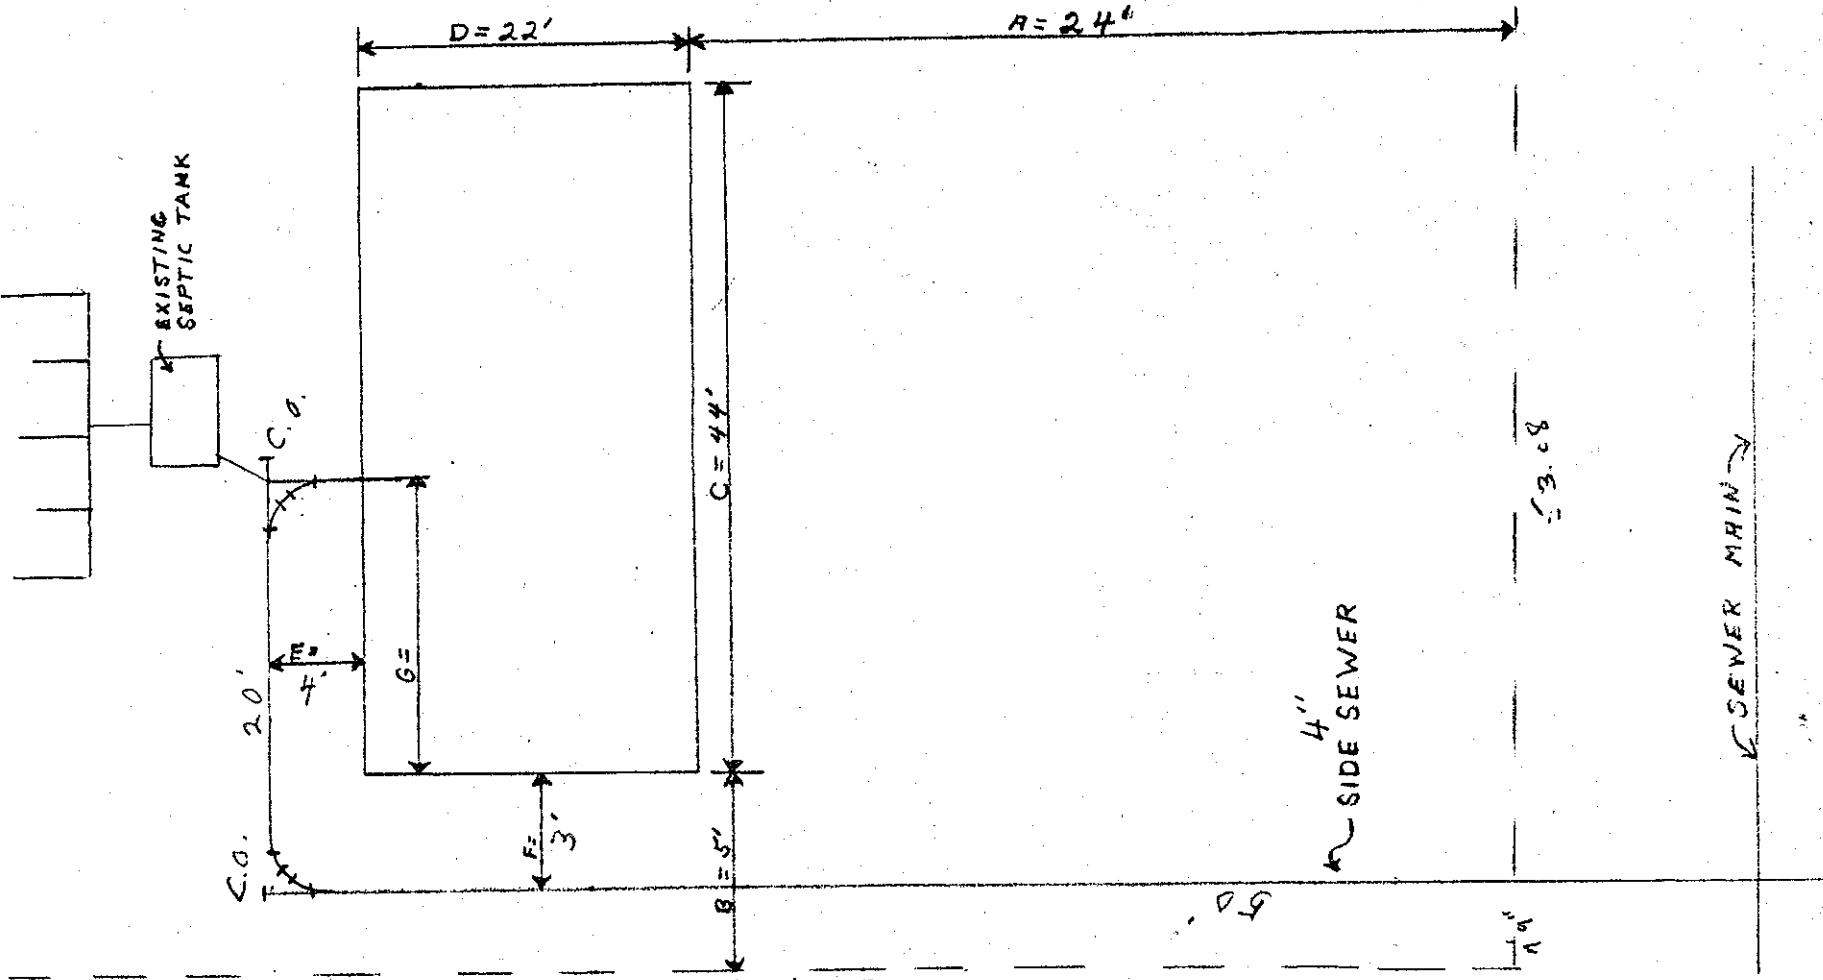

Date

10/88

Approved:

BACKFILL WORK ORDER ISSUED

DEPOSIT, \$

SEWER WORK ORDER ISSUED

DATE 10.00 6-28-66 BY J.M. Holton INST+CON

412/60 44
412/60 44

APPLICATION

The City of Mountlake Terrace

CARD No.

SIDE SEWER PERMIT

OUTSIDE INSIDE REPAIRS

EASEMENT No. 1389061

OWNER Daniel Taylor
HOUSE No. 22904 W 53rdCONTRACTOR *see*

PERMIT No. 2213

STREET

AVENUE LOT No.

14


BLOCK No. 1

NAME ADD. *Dan Taylor*

103, 91

CITY OF
MOUNTLAKE TERRACE

APR 4 1960

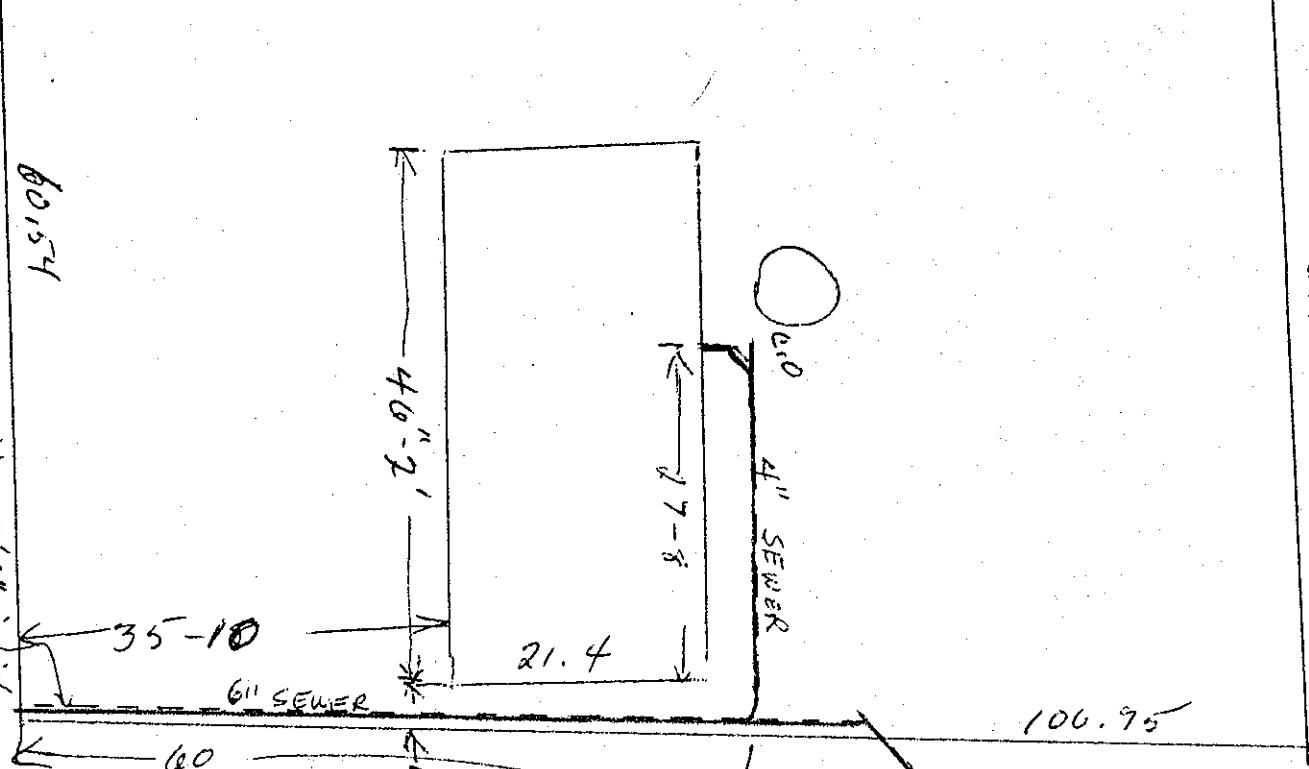Plan Approved. *S. M. Ahee*

BACKFILL WORK ORDER ISSUED

SEWER WORK ORDER ISSUED

DEPOSIT, \$

100

Approved:

DATE

4/4/60

BY

*rec 1023
Reeni Farmer**J. M. Morris - wip + lsm*

The City of Mountlake Terrace

APPLICATION

TOP

SIDE SEWER PERMIT

OUTSIDE INSIDE REPAIRS

CARD No.

EASEMENT No.

OWNER H.T. COOKE

HOUSE No. 22906 W/ 53RD

CONTRACTOR THUNDERPIKE CONST

STREET

AVENUE LOT No. 44 13


PERMIT No. 2104

MCT DIV 12

BLOCK No.

NAME ADD.

60

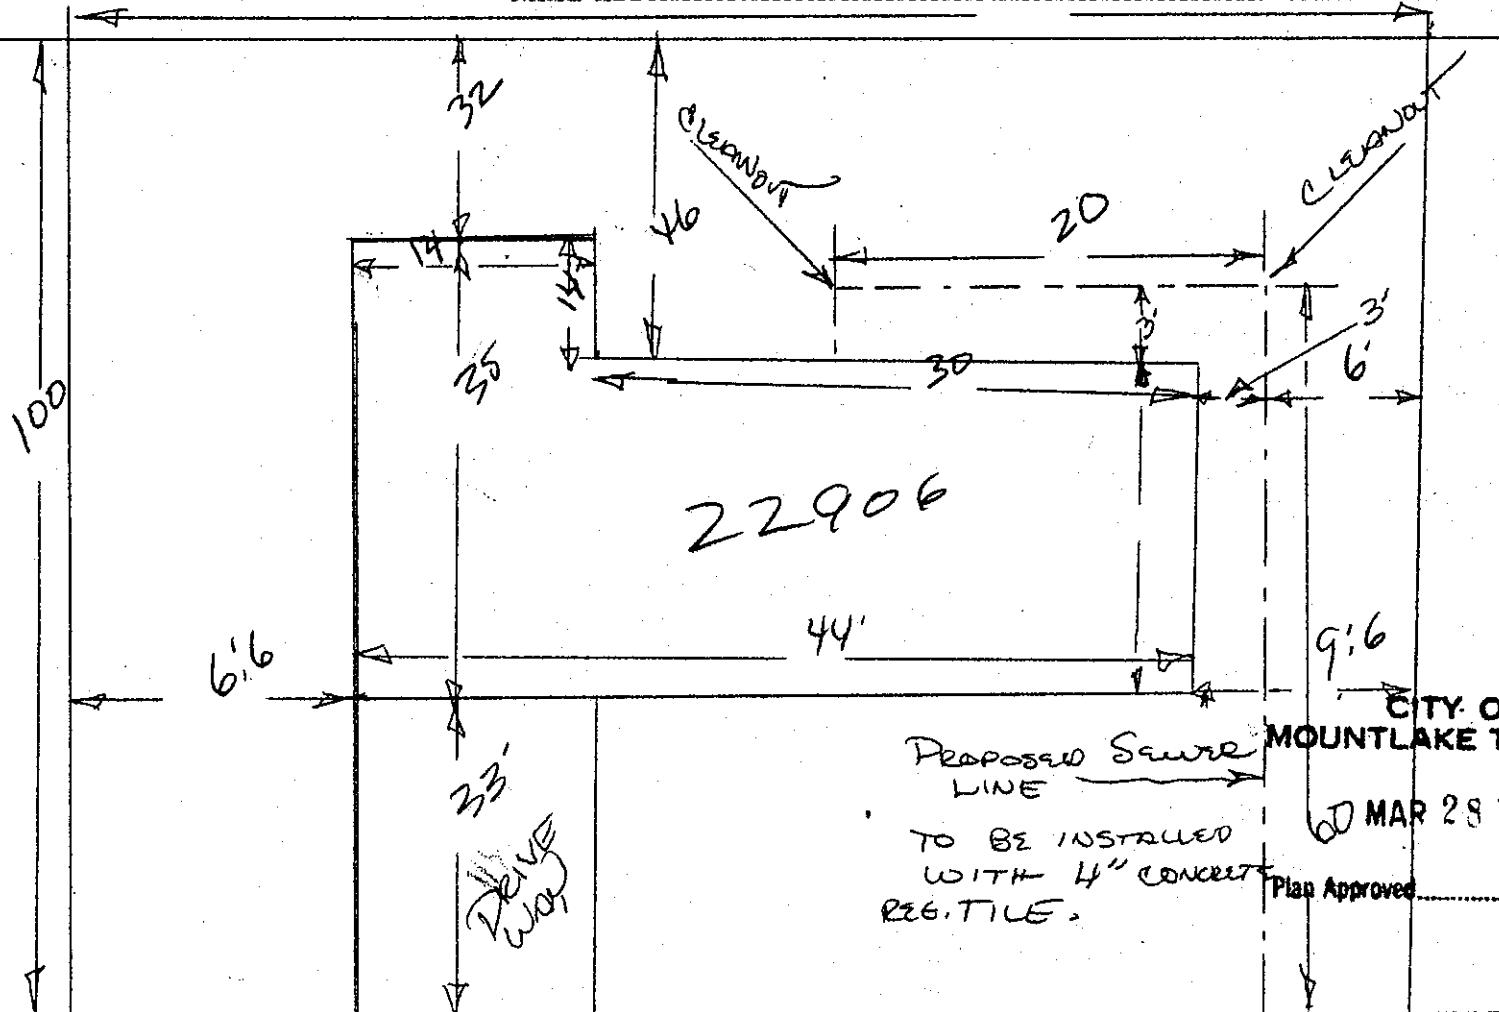

BACKFILL WORK ORDER ISSUED
SEWER WORK ORDER ISSUED

Date

DEPOSIT, \$10.00

Approved:

3/24/60

937

DATE

3-28-60 BY Scott M Holton MSc

The City of Mountlake Terrace

APPLICATION

for

SIDE SEWER PERMIT

OUTSIDE INSIDE REPAIRS

CARD No.

EASEMENT No.

OWNER: RICHARD L DUBOIS


HOUSE No. 22908 53 W

CONTRACTOR: SUBURBAN SEPTIC SERVICE PERMIT No. 384

STREET
AVENUE LOT No. 12

BLOCK No. 1

NAME ADD: MOUNTLAKE TERRACE DIV #12

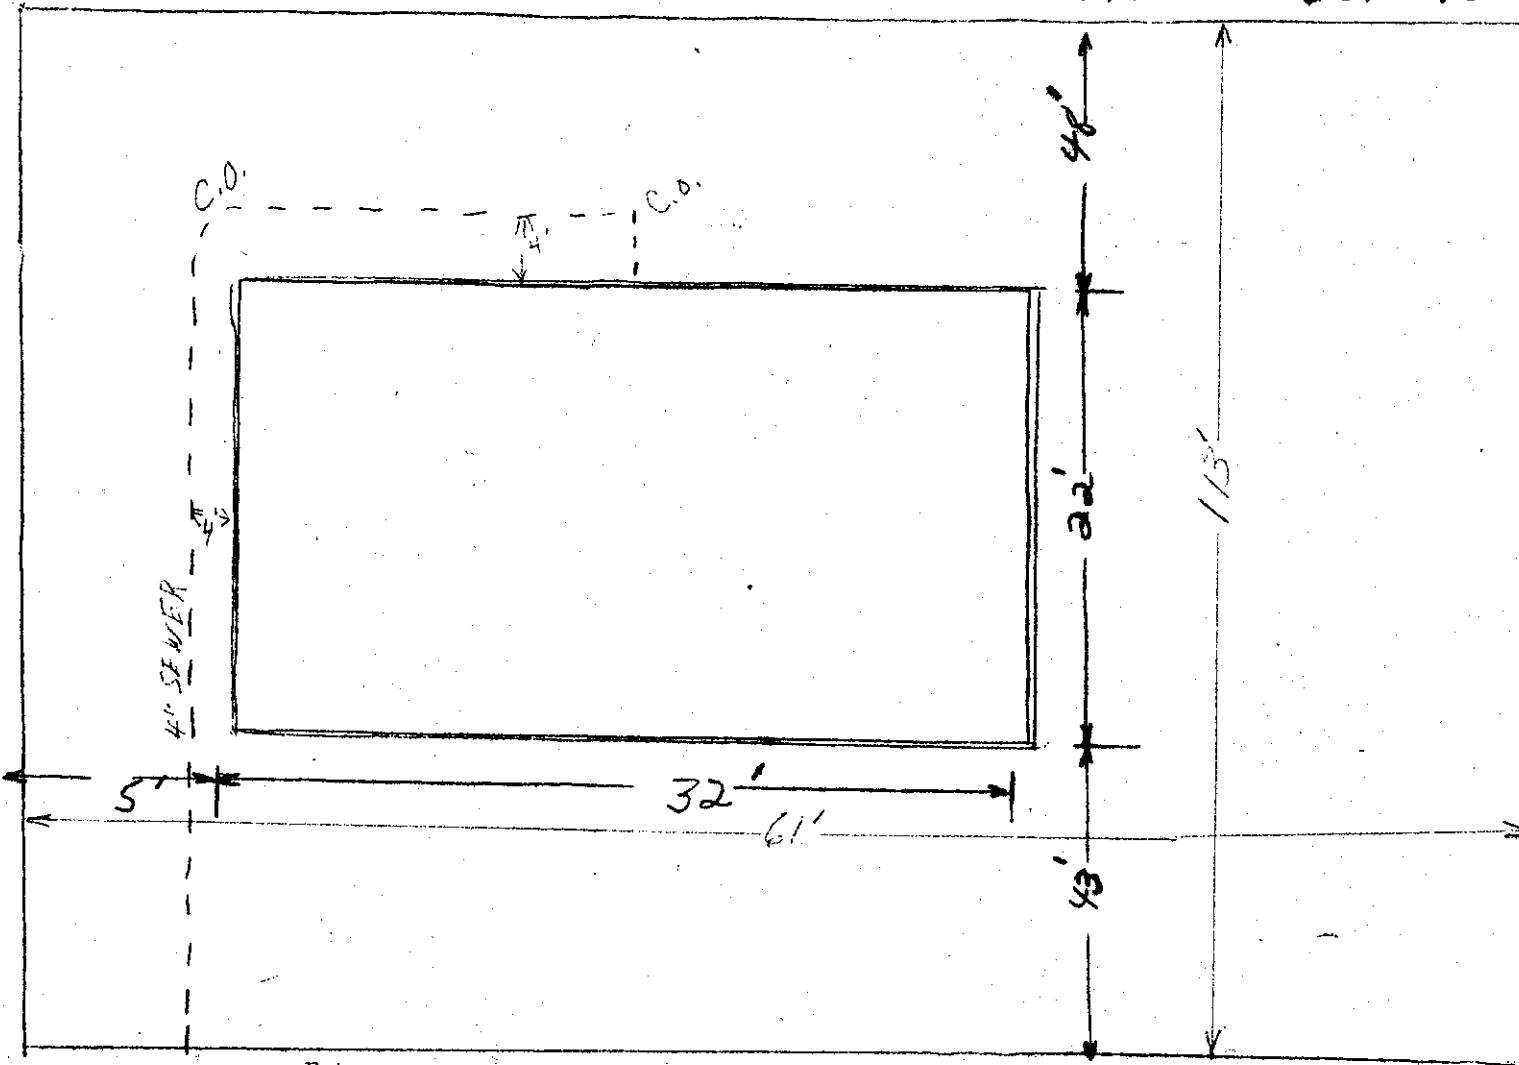

Date

Approved:

BACKFILL WORK ORDER ISSUED

SEWER WORK ORDER ISSUED

DEPOSIT, \$ 10.00

8/17/60
#1813

DATE 8-17-60

BY

J. M. Holte INST CON

The City of Mountlake Terrace

APPLICATION
FOR

F. D. Huddleston
CARD No.

SIDE SEWER PERMIT

OUTSIDE INSIDE REPAIRS

EASEMENT No.

OWNER FRED D HUDDLESTON

HOUSE No. 22909 W 53rd

CONTRACTOR

SELF

PERMIT No. 2188

STREET


AVENUE LOT No. 14

BLOCK No. 2

EXISTING SEPTIC TANK

NAME ADD.

D. J. 12

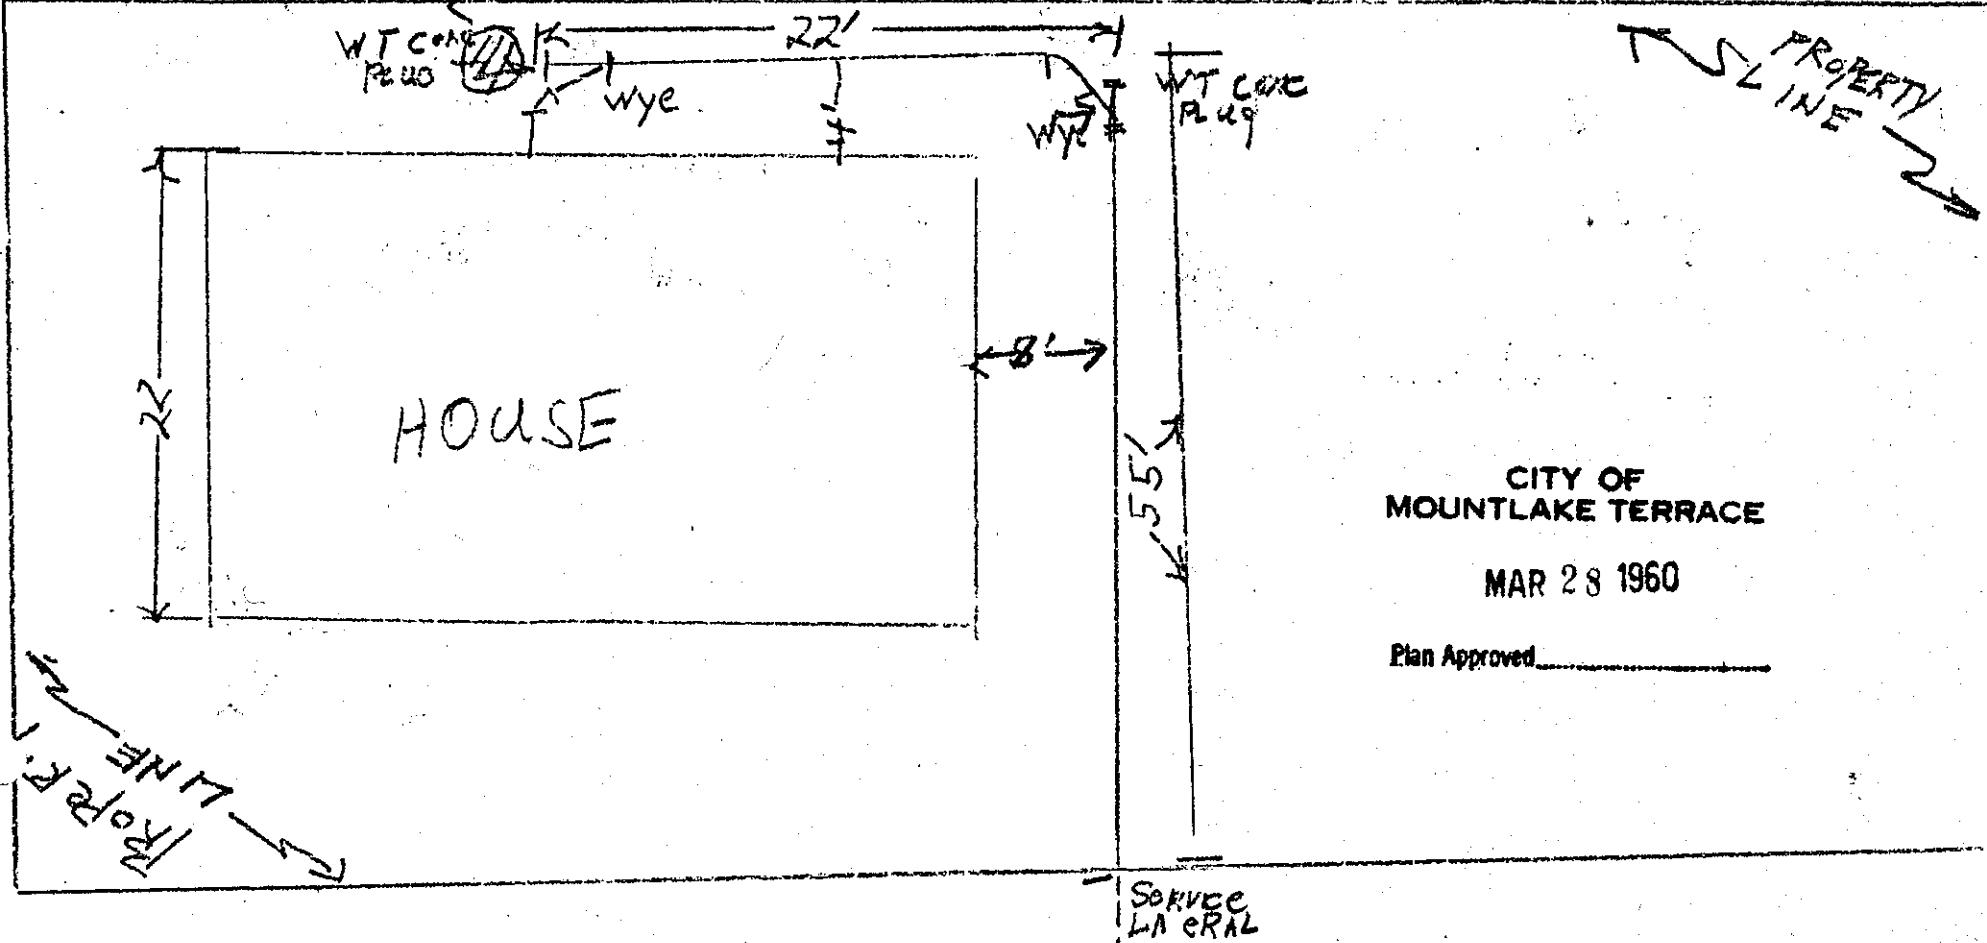

SEWER MAIN

Date

BACKFILL WORK ORDER ISSUED

DEPOSIT, \$10.00

Approved: 3/25/60

SEWER WORK ORDER ISSUED

1002

DATE 3-29-60

BY

Scott McFallon NSFC-OR

The City of Mountlake Terrace

APPLICATION


SIDE SEWER PERMIT

OUTSIDE INSIDE REPAIRS

M. F. DROZDOWSKI
CARD No.

EASEMENT No.

OWNER MAX F DROZDOWSKI CONTRACTOR R. D. Johnson PERMIT No. 2369
HOUSE No. 7871 23001 STREET 53 Ave W. LOT 1
AVENUE LOT No. 53 BLOCK No. 61
NAME ADD. D. J. D.

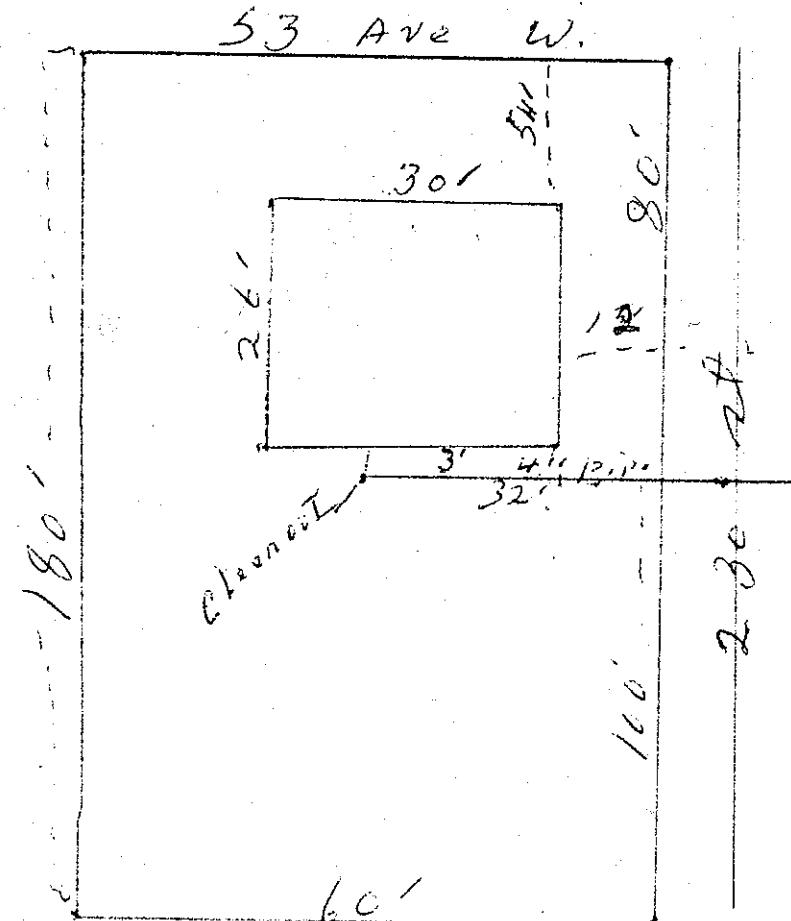

CITY OF
MOUNTLAKE TERRACE

APR 5 1960

Plan Approved *J. Fairiner*

Date

Approved:

BACKFILL WORK ORDER ISSUED

DEPOSIT, \$10.00

4/1/60

SEWER WORK ORDER ISSUED

1153

DATE

4/5/60 BY *J. Fairiner*

APPLICATION

The City of Mountlake Terrace

SIDE SEWER PERMIT

OUTSIDE INSIDE REPAIRS

CARD No.

EASEMENT No.

None

OWNER H. Light

HOUSE No. 23003 53rd Av.

CONTRACTOR WINGFIELD - BROWN


PERMIT NO. 917

STREET AVENUE LOT No. LOT 2

BLOCK No. 3

NAME ADD.

Dec 12

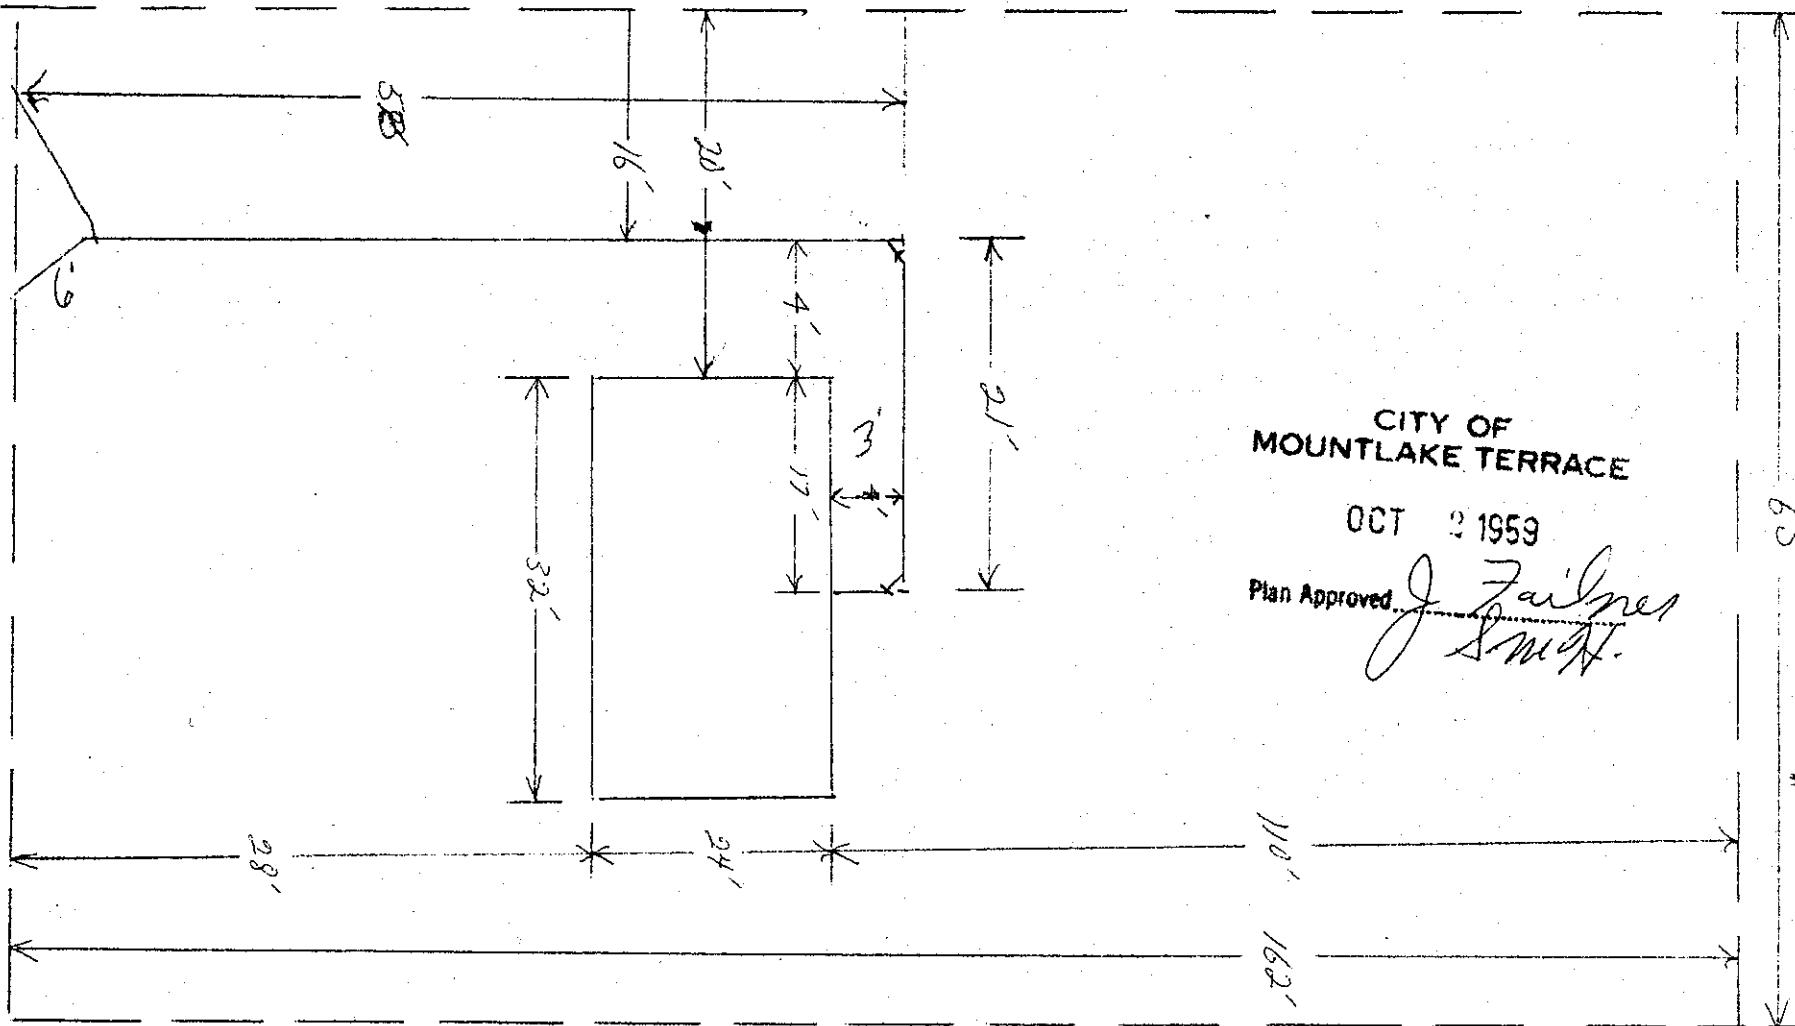CITY OF
MOUNTLAKE TERRACE

OCT 3 1959

Plan Approved.

*J. Fairnes
Smith*

Date

Approved:

BACKFILL WORK ORDER ISSUED

DEPOSIT, \$100.00

SEWER WORK ORDER ISSUED

Rec. \$500.00

DATE 10-3-59

BY Scott M. Holton INS.

9/28/59 Dyer

1-8-60 INS CON SMH N.C.

The City of Mountlake Terrace

APPLICATION

for

SIDE SEWER PERMIT

OUTSIDE INSIDE REPAIRS

DALE MASON
CARD No.

EASEMENT No. 1378216

OWNER DALE MASON

HOUSE No. 23004 5350

CONTRACTOR

STREET

AVENUE LOT No. Lot 19


PERMIT No.

1143

BLOCK No. 4

NAME ADD. DIV 12

60.01

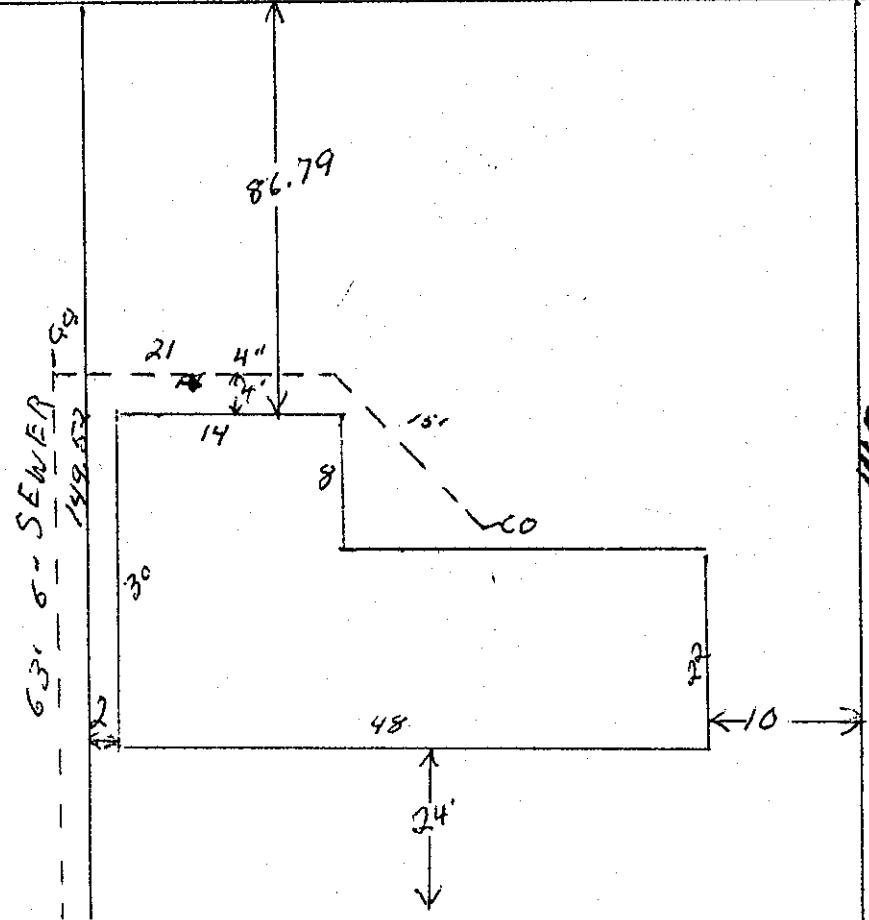

CITY OF
MOUNTLAKE TERRACE

FEB 23 1960

Plan Approved

60.89

N

Date

Approved:

BACKFILL WORK ORDER ISSUED

DEPOSIT \$ 10 ~~over~~ 2-18-60

SEWER WORK ORDER ISSUED

607
et
DATE 2-23-60

BY Scott M. Holloman NSC on

The City of Mountlake Terrace

APPLICATION

FOR

SIDE SEWER PERMIT

OUTSIDE INSIDE REPAIRS


Barbara Bell Osborne

CARD No.

EASEMENT No. 1357050

OWNER Barbara Bell Osborne CONTRACTOR Wingfield - Brown PERMIT NO. 910
HOUSE No. 23005 STREET AVENUE LOT No. W 53rd Lot 3 BLOCK No. 3

NAME ADD.

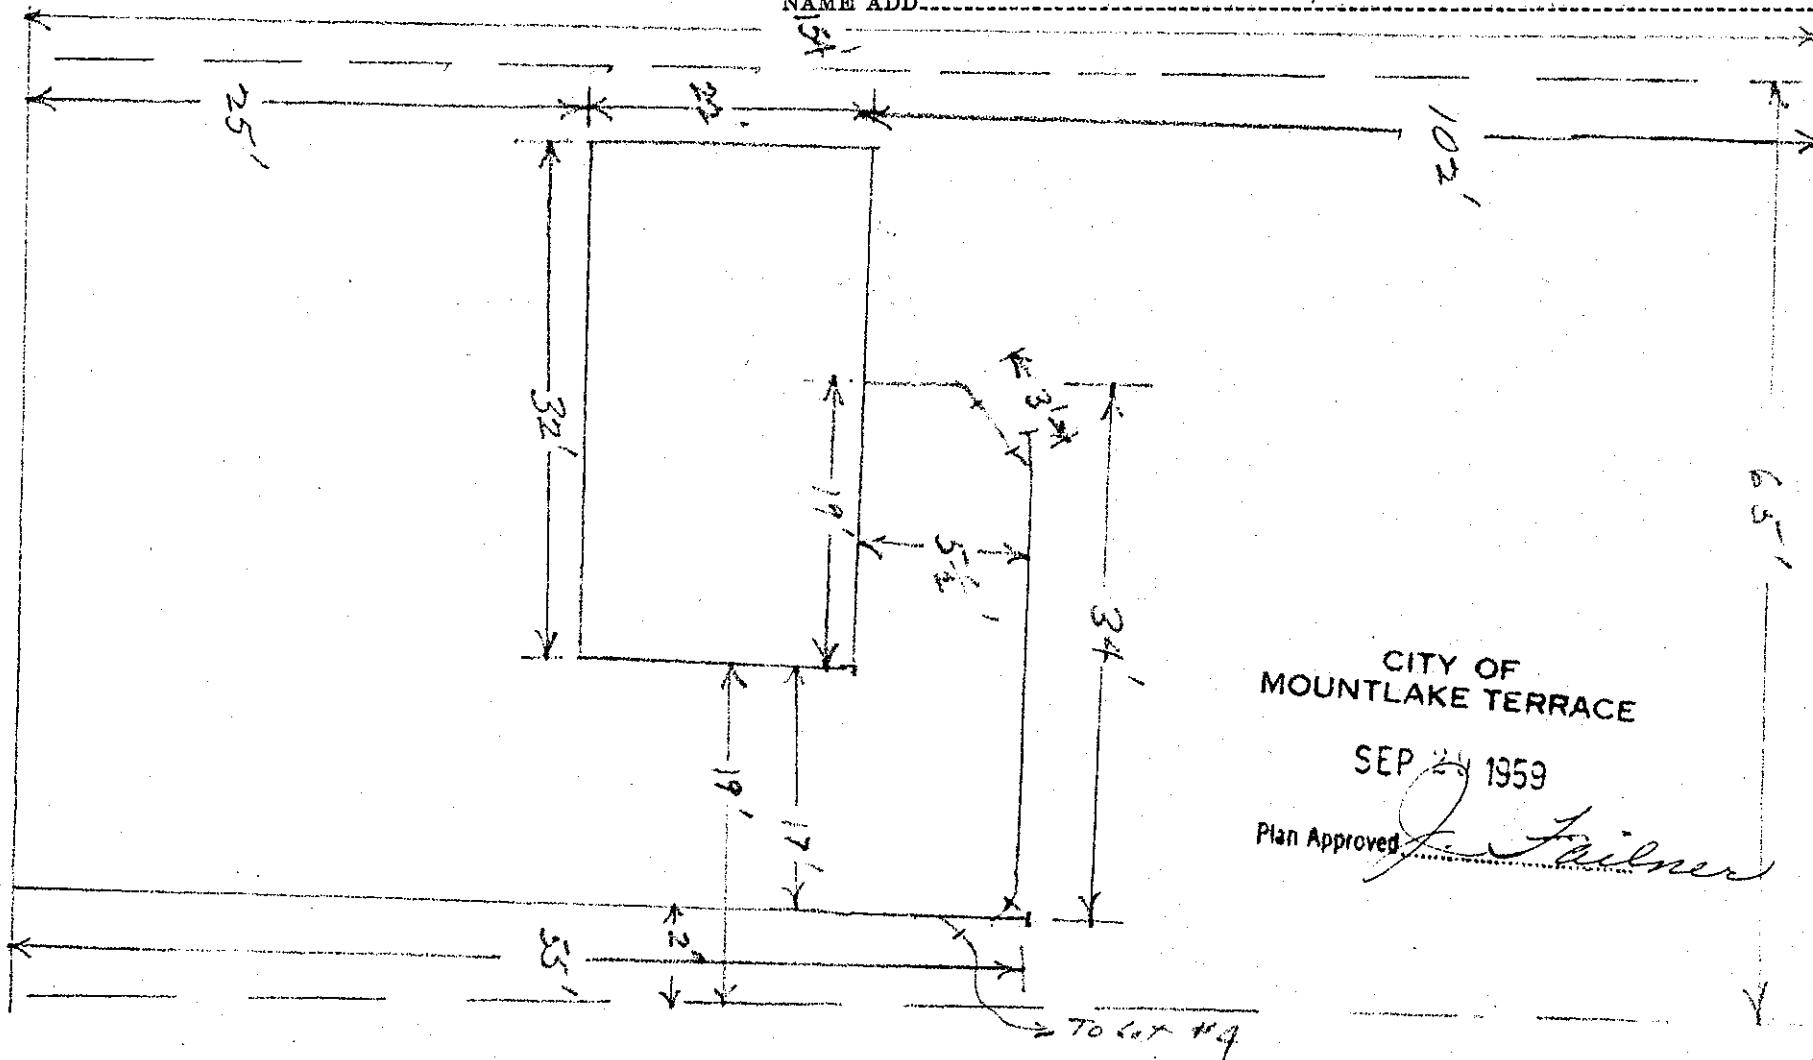

CITY OF
MOUNTLAKE TERRACE

SEP 24 1959

Plan Approved

T. K. Palmer

Date

Approved:

BACKFILL WORK ORDER ISSUED

DEPOSIT, \$ 10.00

SEWER WORK ORDER ISSUED

Rec. 4989

DATE

9-29-59 BY Scott M. Holton INC.

9/25/59 Day

1-8-60 INST CON & MFT.

N.C.

APPLICATION

CARD No.

The City of Mountlake Terrace

SIDE SEWER PERMIT

OUTSIDE INSIDE REPAIRS

EASEMENT No. 1378216

OWNER RUTH THORNLYNCH

HOUSE No. 23006 53RD

CONTRACTOR


PERMIT No. 1144

STREET AVENUE LOT No. 107 18

BLOCK No. 4

NAME ADD. Pix 12

60.01

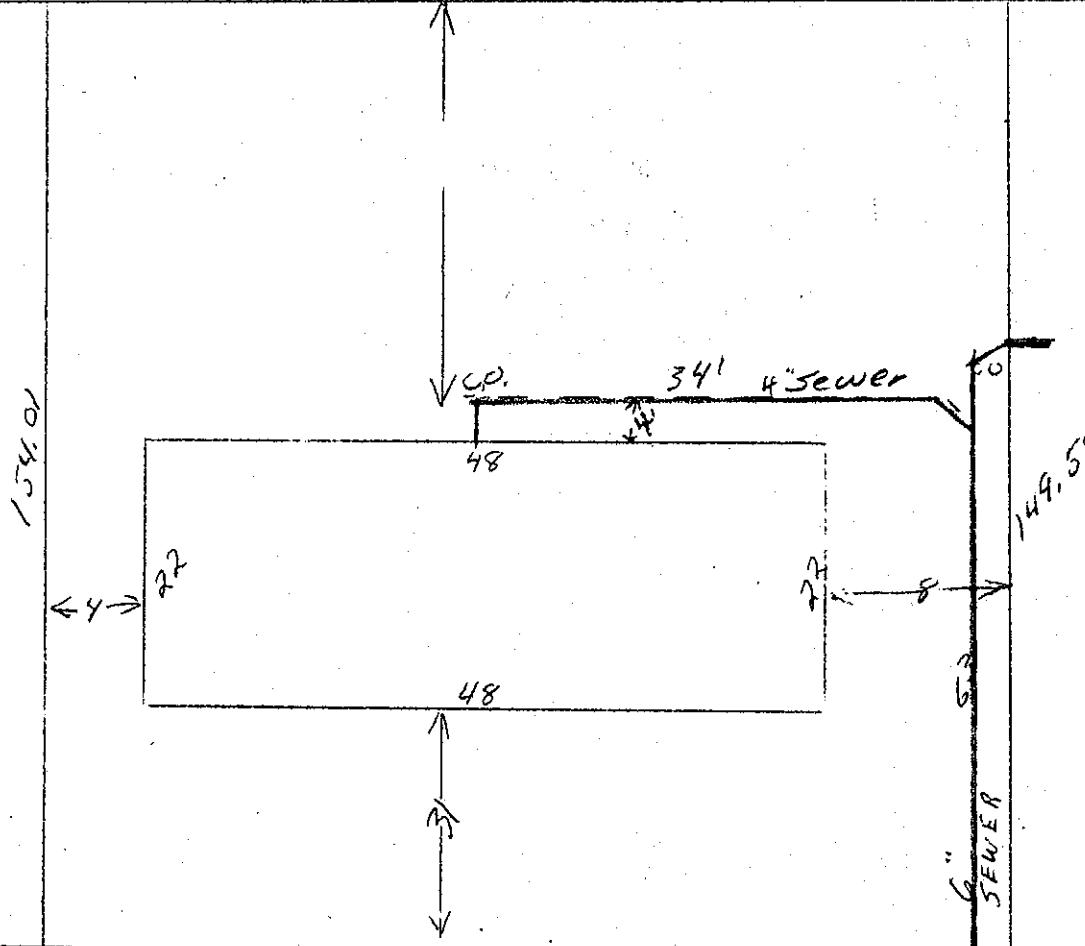CITY OF
MOUNTLAKE TERRACE

Plan Approved.

J. Fairiner
SM

60.32

Date

53RD

Approved:

BACKFILL WORK ORDER ISSUED

DEPOSIT, \$10 - ~~50~~

2-18-60

SEWER WORK ORDER ISSUED

608

DATE

2-23-60 BY S. Scott m. Holton INSTEON

APPLICATION

SIDE SEWER PERMIT

The City of Mountlake Terrace


OUTSIDE INSIDE REPAIRS

DAVID W. OSBORNE

CARD NO.

EASEMENT No. 1357050

OWNER David W. Osborne CONTRACTOR Wingfield - Brocini PERMIT No. 909
 HOUSE No. 23007 STREET AVENUE LOT No. W. 53rd Lot #4 BLOCK No. 3

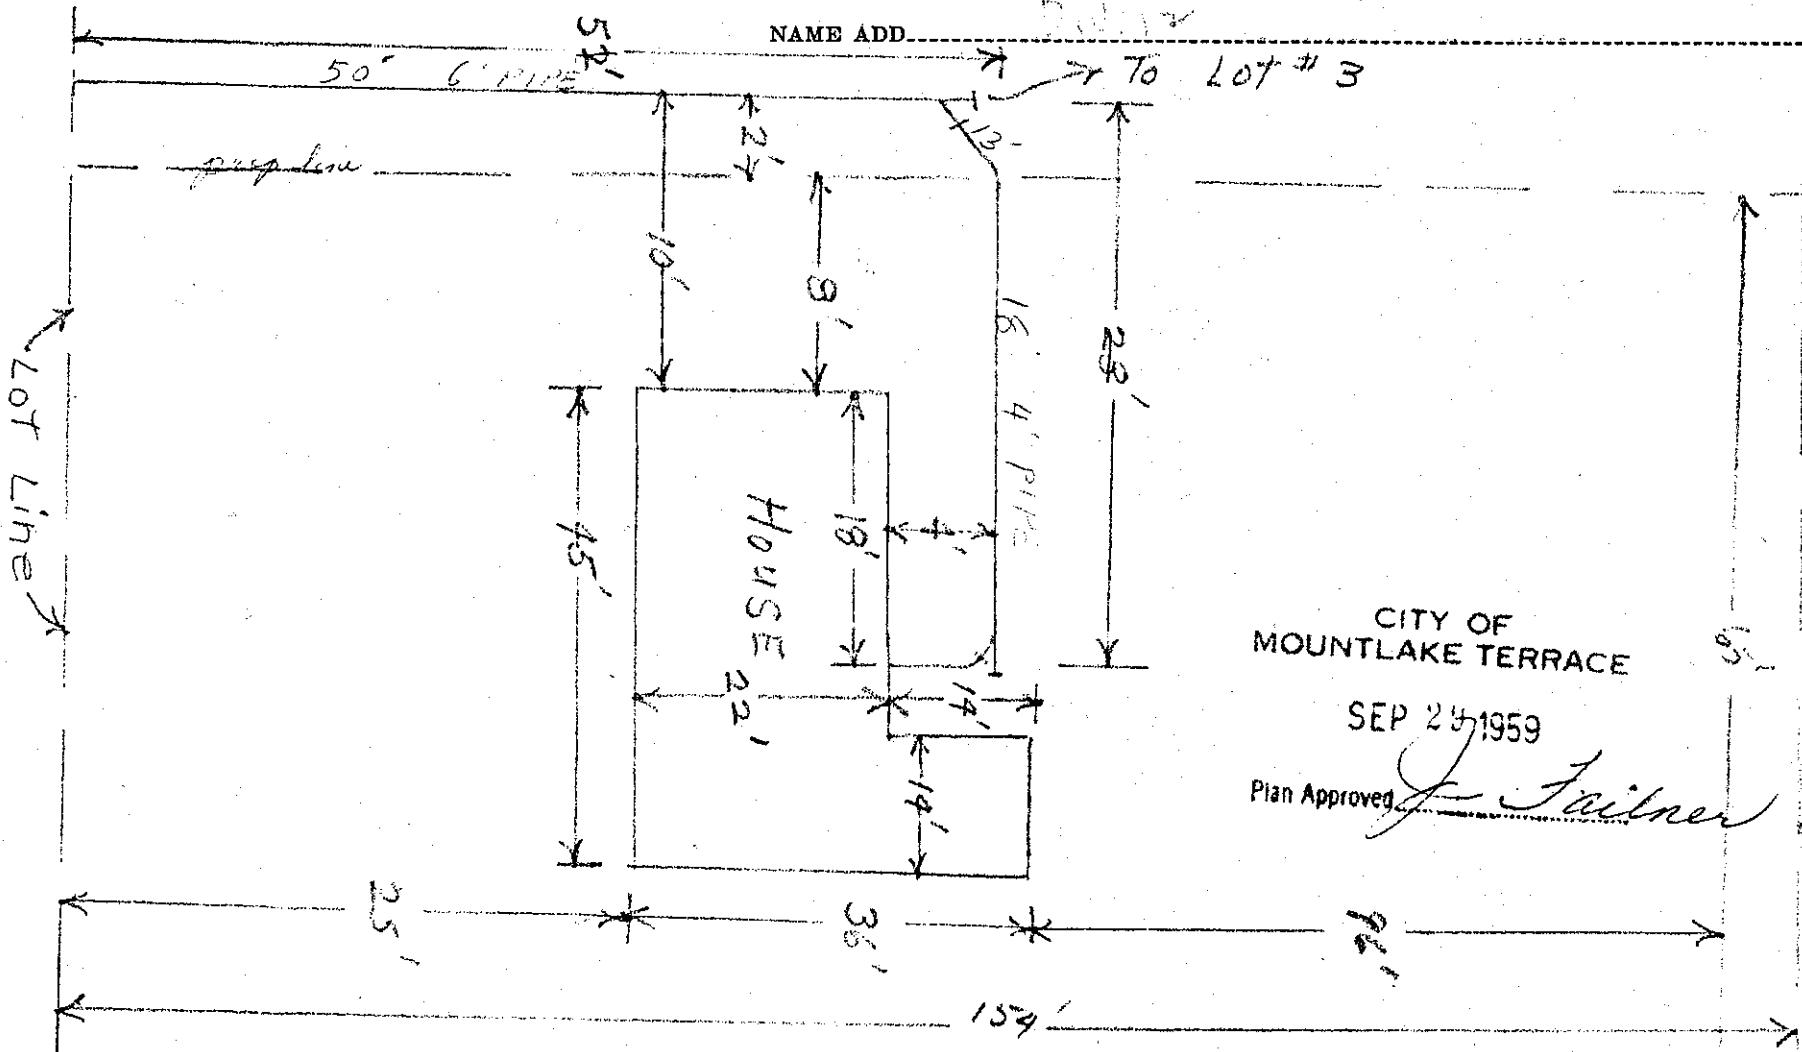CITY OF
MOUNTLAKE TERRACESEP 24 1959
Plan Approved *J. Fairner*BACKFILL WORK ORDER ISSUED
SEWER WORK ORDER ISSUED

Date

DEPOSIT, \$

10.00

9/25/59

Approved:

DATE

9-29-59 BY Scott M. Holton INS
1-8-60 INST CON 8 MTH N.C.
Rec. 4989

APPLICATION
FOR

SIDE SEWER PERMIT

OUTSIDE INSIDE REPAIRS HIRAM THOMAS,
CARD No.

The City of Mountlake Terrace

EASEMENT No. 1359672

OWNER Hiram Thomas

HOUSE NO. 23008 53 rd

CONTRACTOR Wingfield - Brown PERMIT No. 885

STREET
AVENUE LOT No.


17

BLOCK No.

4

NAME ADD.

Dwelling

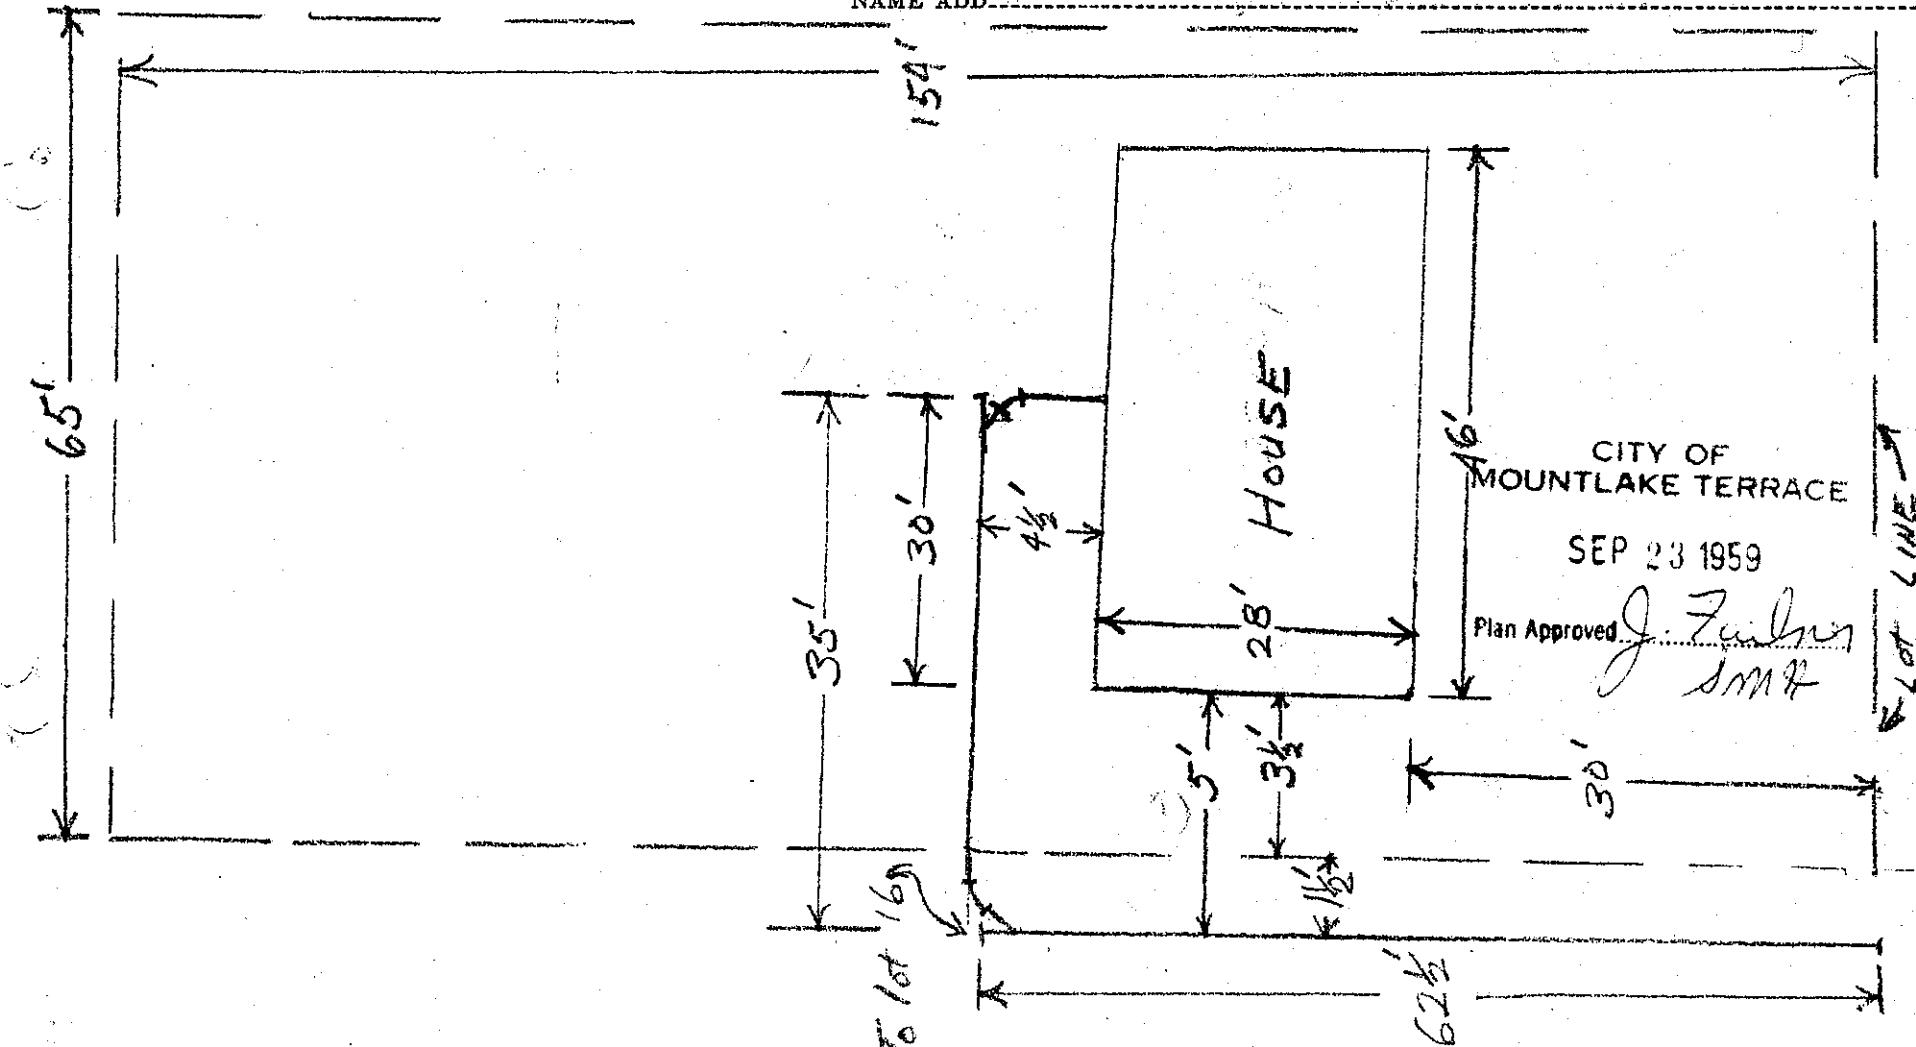

Date

BACKFILL WORK ORDER ISSUED

DEPOSIT, \$ 10.00

SEWER WORK ORDER ISSUED

9/23/59
#365

Approved:

DATE

9-23-59 BY Scotton Holton INS.

1-4-60 INS + CON. S.M.H.

N.C.

APPLICATION

SIDE SEWER PERMIT

The City of Mountlake Terrace

OUTSIDE INSIDE REPAIRS CARD No. *✓*EASEMENT No. 1358182OWNER L.D. WilliamsHOUSE NO. 2300953rd W.CONTRACTOR Wingfield-BrownPERMIT No. 916


STREET

AVENUE LOT No.

LOT #5

BLOCK No. F3

NAME ADD.

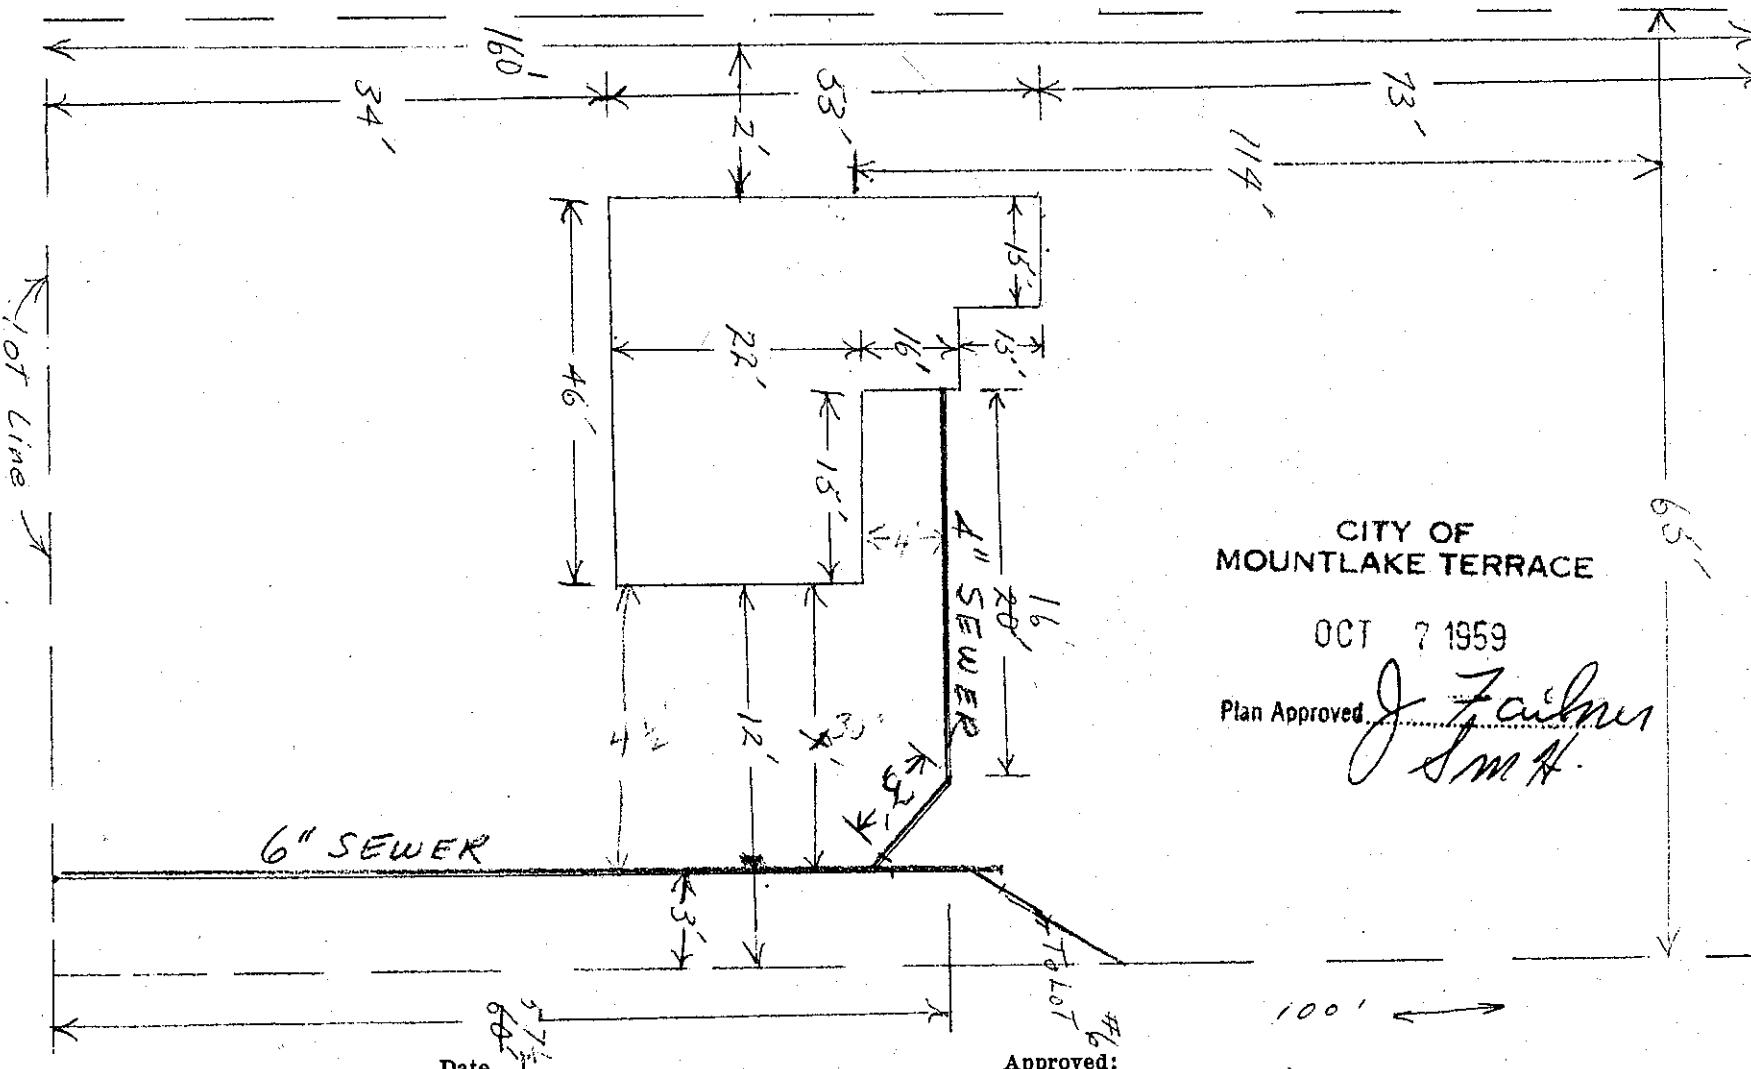Dw 12CITY OF
MOUNTLAKE TERRACE

OCT 7 1959

Plan Approved

*J. Faulkner
S.M.H.*

Approved:

DATE

BACKFILL WORK ORDER ISSUED

DEPOSIT, \$100.00

SEWER WORK ORDER ISSUED

9/28/59 Rec. 500 8
Dgast10-8-59 Scott M. Holton INS
N.C.

APPLICATION

INT'L

SIDE SEWER PERMIT

OUTSIDE INSIDE REPAIRS

The City of Mountlake Terrace

FRANCIS KERTZMAN

CARD No.

EASEMENT No. 1359672

OWNER Francis Kertzman

CONTRACTOR

Wingfield-Brown

PERMIT No. 881

HOUSE No. 23010

53 rd


STREET

AVENUE LOT No.

16

BLOCK No.

4

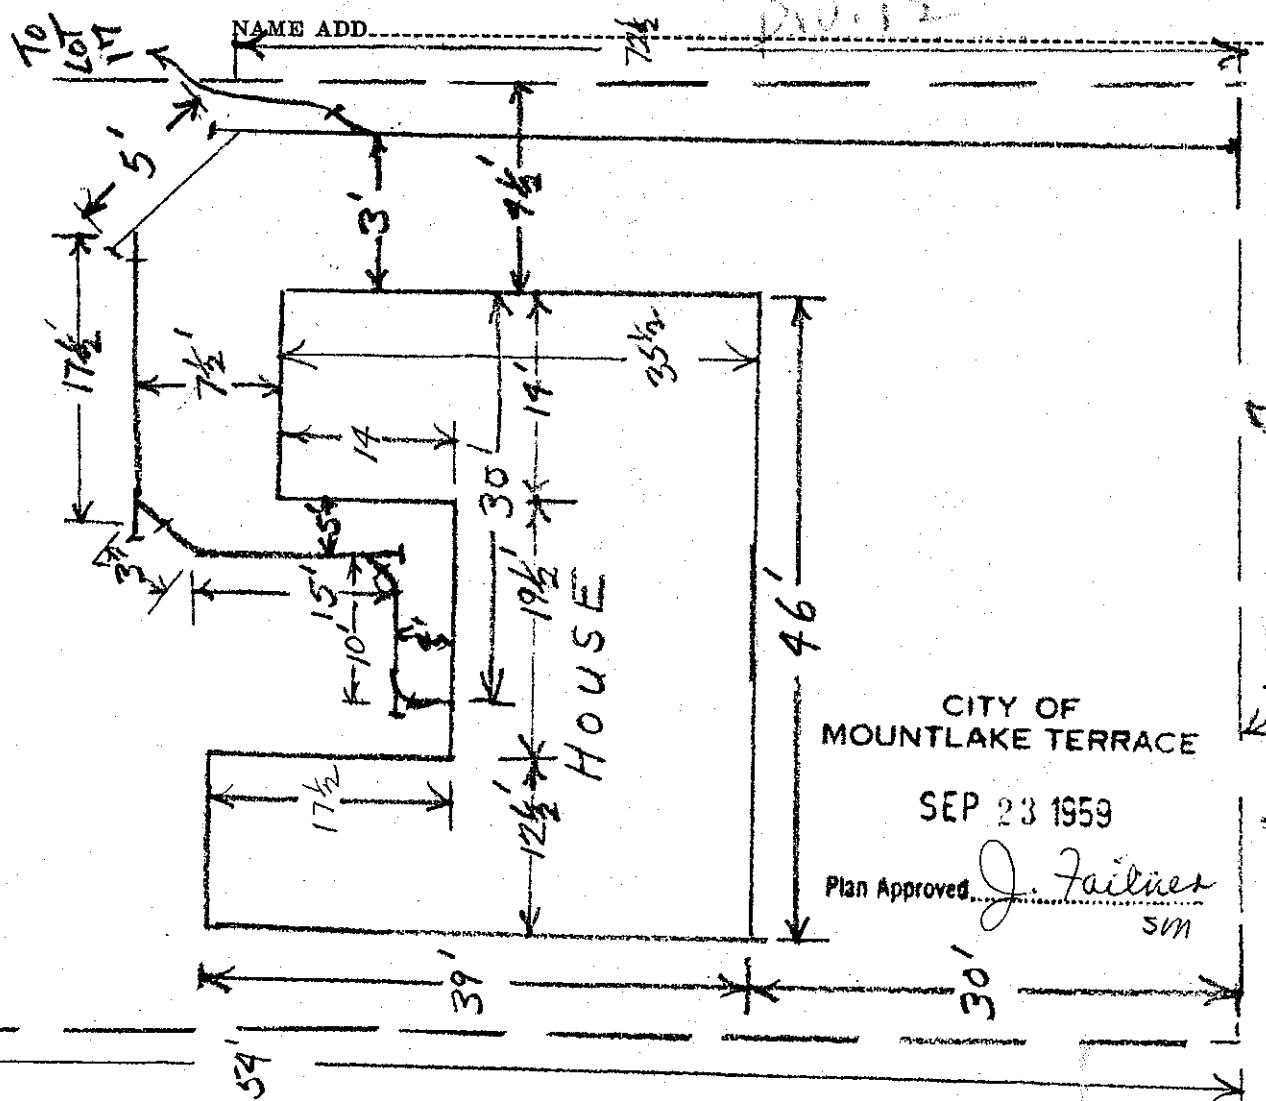

BACKFILL WORK ORDER ISSUED

Date

DEPOSIT, \$ 10,00

SEWER WORK ORDER ISSUED

9/21/59
#364

DATE

9-23-59 BY Scott M Holton INS.

N.C.

APPLICATION

J.H. MCCRACKEN

CARD No.

The City of Mountlake Terrace

SIDE SEWER PERMIT

OUTSIDE INSIDE REPAIRS

EASEMENT No. 1358182

OWNER J.H. M^cCracken

CONTRACTOR Wingfield - Brown


PERMIT No. 915

HOUSE NO. ~~2304~~ 2310 1/2 - 53rd W.STREET
AVENUE LOT No. #6

#3

NAME ADD.

Dir. 12

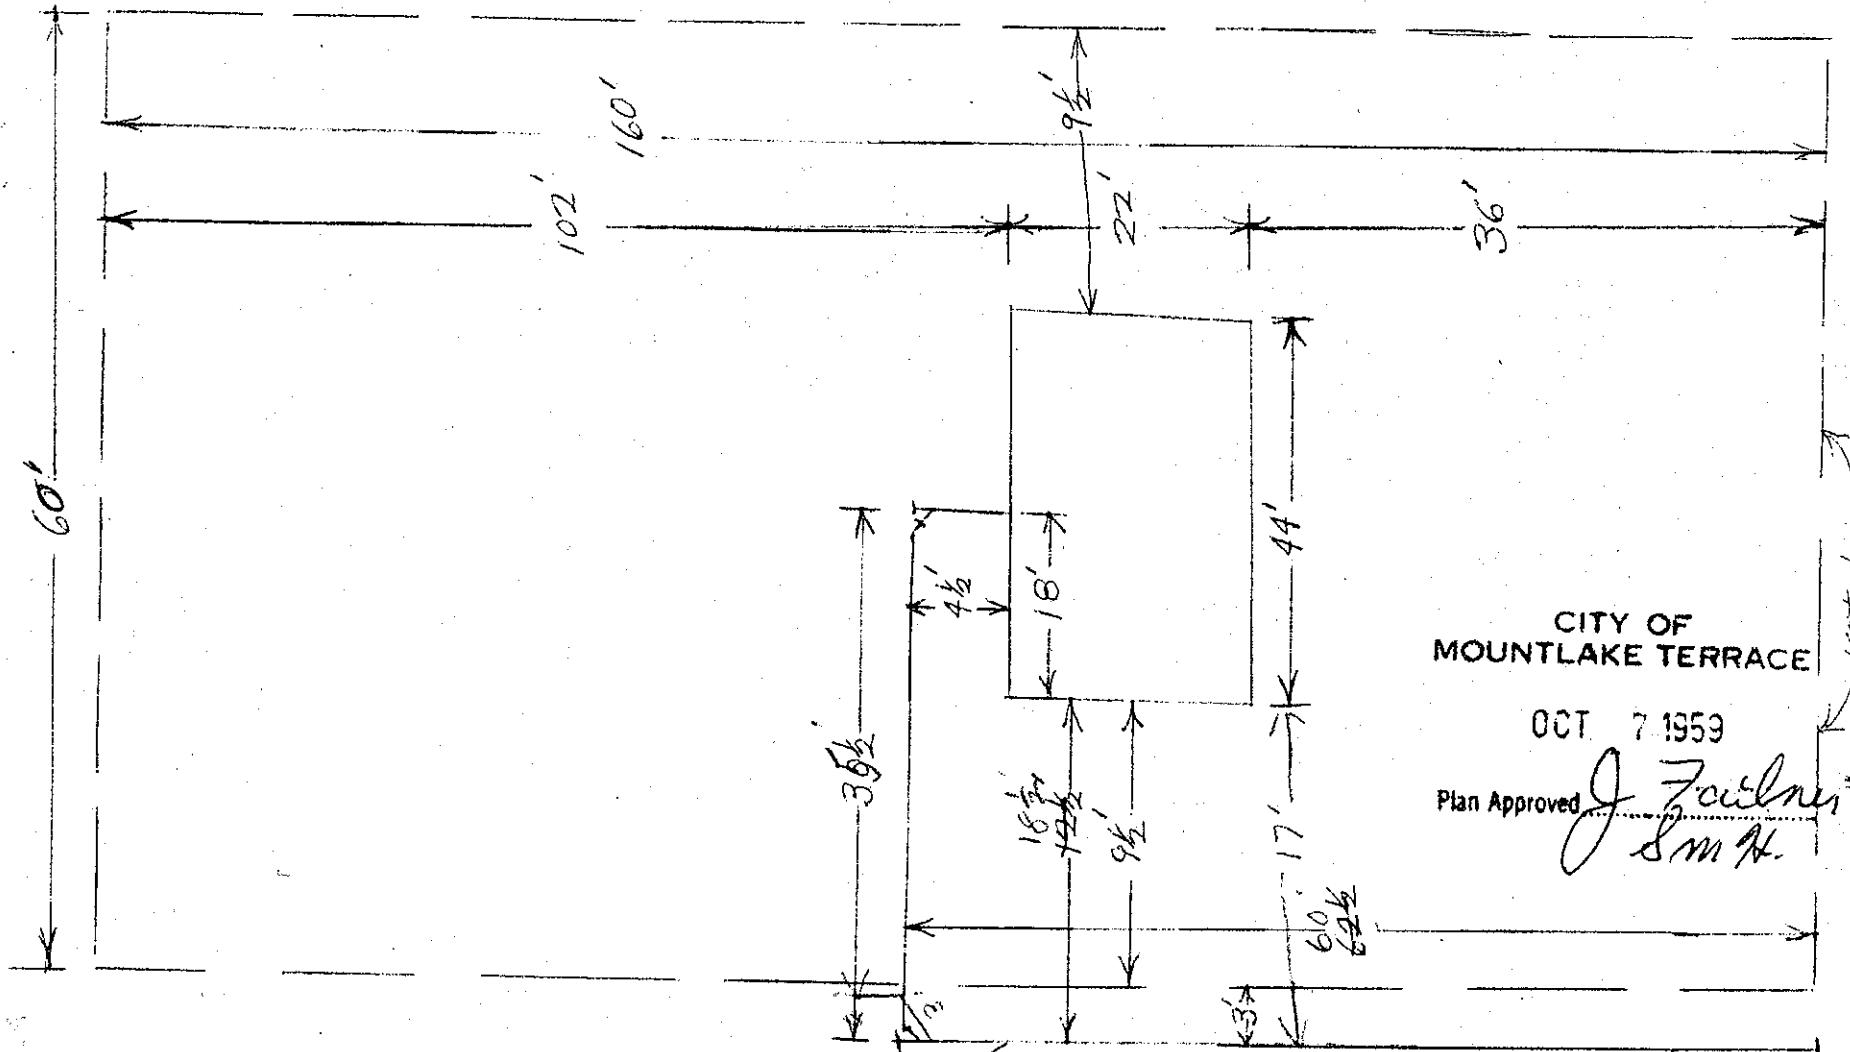CITY OF
MOUNTLAKE TERRACE

OCT. 7 1959

Plan Approved

J. Faulkner
S.M.H.

Date

5-# 107 01

Approved:

BACKFILL WORK ORDER ISSUED

DEPOSIT, \$10.00

SEWER WORK ORDER ISSUED

9/28/59 Rec. 5008

Dept

DATE

10-8-59 BY Scott M Holton MS
1-8-60 INST CON S.M.H. N.C.

APPLICATION
TOP

SIDE SEWER PERMIT

OUTSIDE INSIDE REPAIRS

CARD No.

The City of Mountlake Terrace

EASEMENT No.

OWNER ART WILLIAMS


CONTRACTOR WINGFIELD BROWN

PERMIT No. 8.91

HOUSE No. 23102

STREET AVENUE LOT No. 53rd AVE. LOT 15 BLOCK No. 4 DIV. 12

NAME ADD.

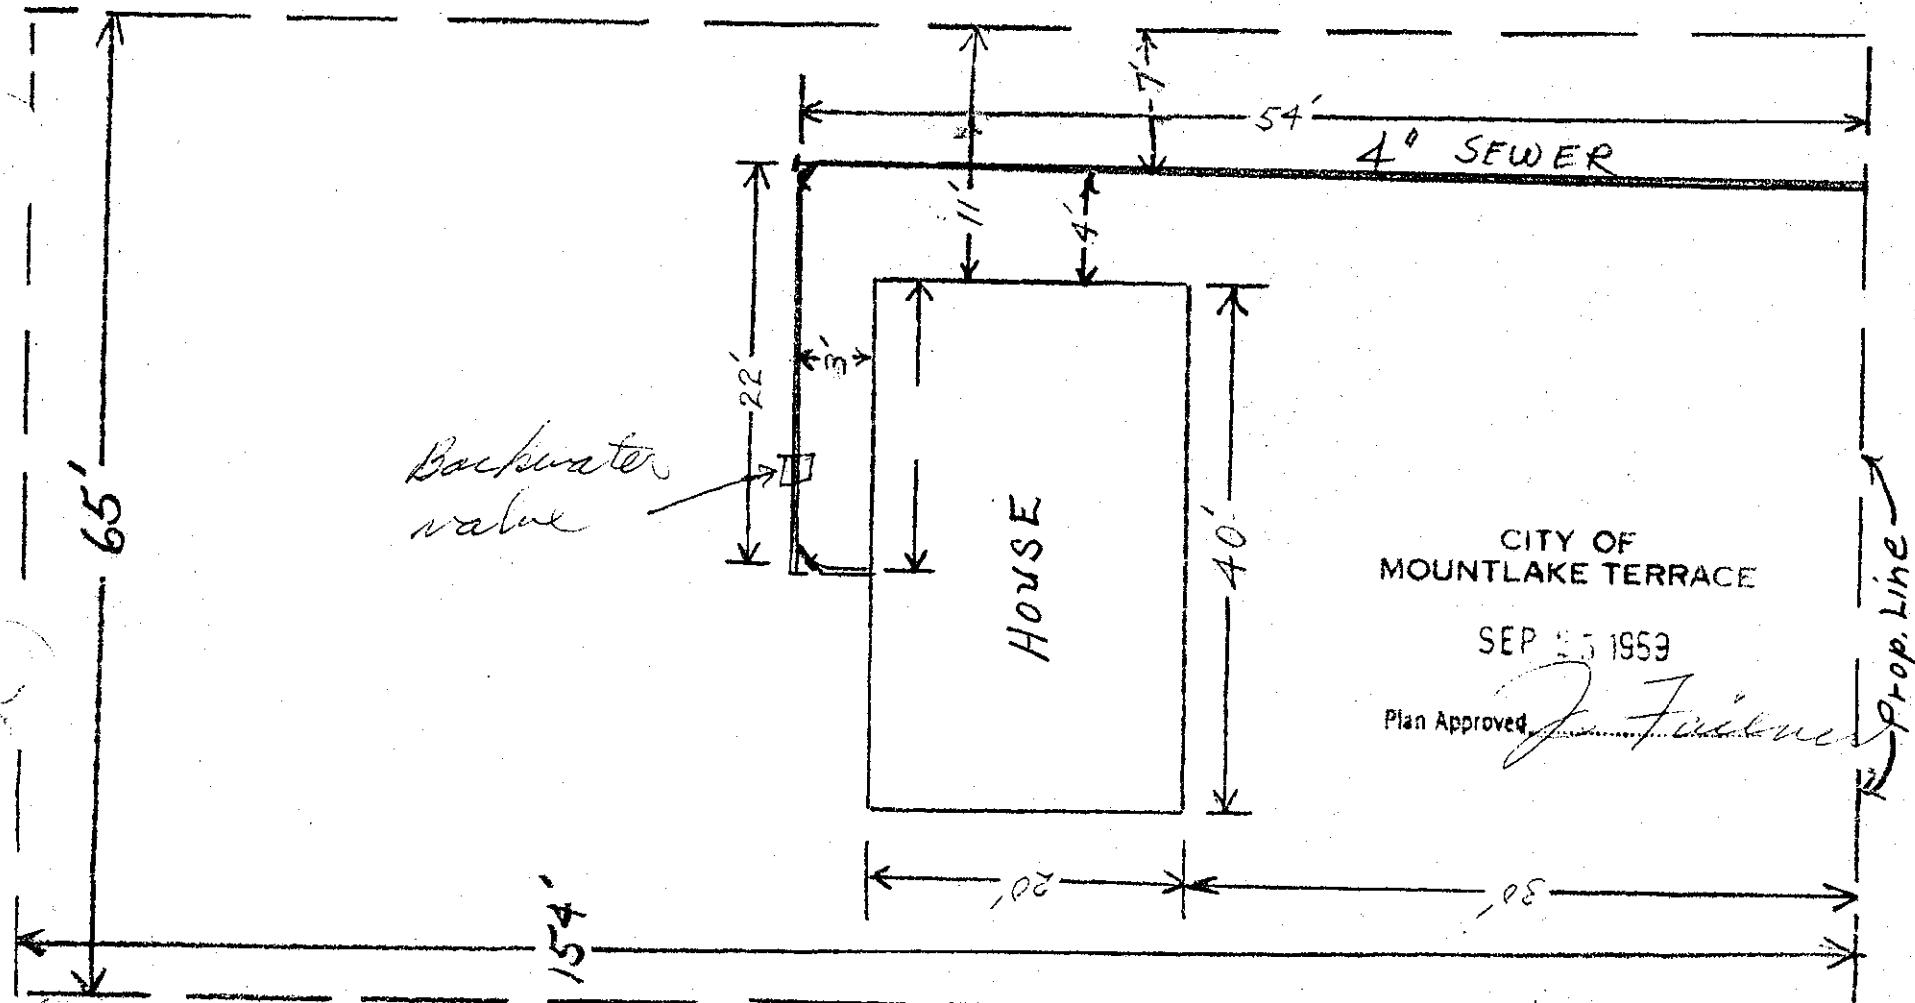BACKFILL WORK ORDER ISSUED
SEWER WORK ORDER ISSUED

Date

DEPOSIT, \$ 10.00

Approved:

9-23-59
Rec. # 4970DATE 9-25-59 BY Scott M Holton INS.
M.C.

PA 5-1209
The City of Mountlake Terrace

APPLICATION

SIDE SEWER PERMIT

OUTSIDE INSIDE REPAIRS

K.L. DRAFTING
CARD No.

EASEMENT No. 435-77-46

OWNER Robert L. Beattie
HOUSE No. 23103 - 53rd W.

CONTRACTOR Wingfield-Brown


PERMIT No. 1998

STREET
AVENUE LOT No. 7

BLOCK No. 3

NAME ADD.

Div. # 12

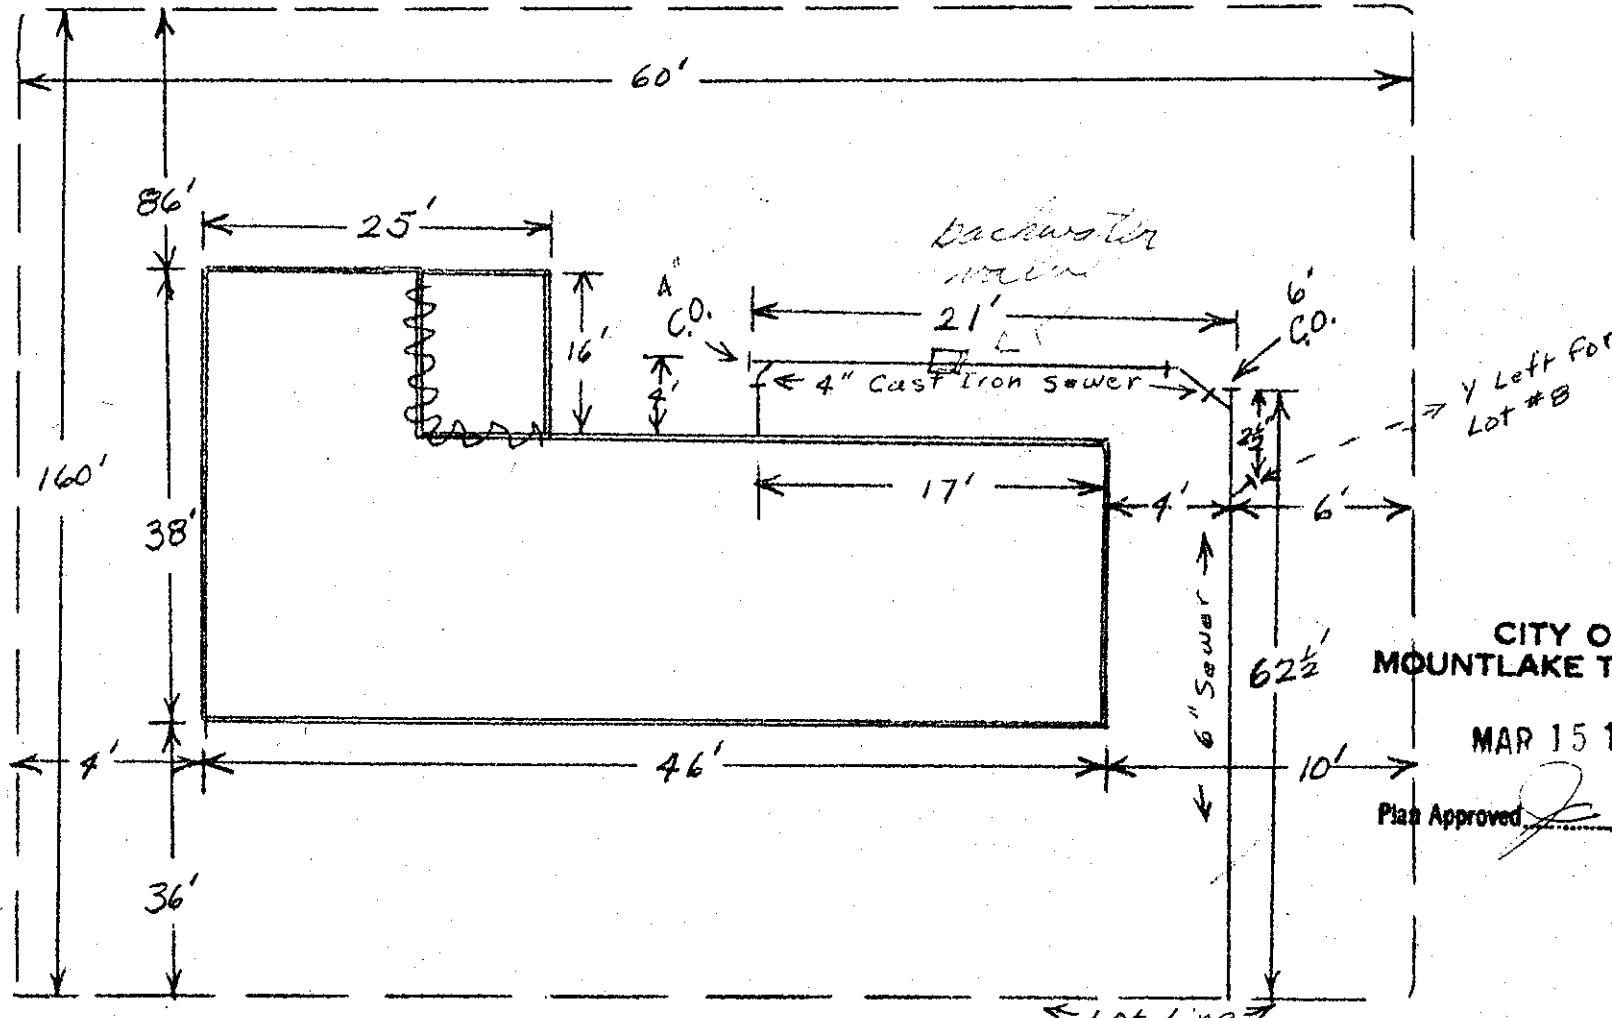

Date

Approved:

BACKFILL WORK ORDER ISSUED

DEPOSIT, \$ 10.00

SEWER WORK ORDER ISSUED

3/15/60
77844

DATE 3-21-60

BY

Scott M. Holton INC & CO

APPLICATION

FOR

SIDE SEWER PERMIT

OUTSIDE INSIDE REPAIRS

CARD NO.

The City of Mountlake Terrace

EASEMENT No.

OWNER Theda R. Cullen

CONTRACTOR WINGFIELD-BROWN


PERMIT No. 938

HOUSE No. 2310 1/2

STREET
AVENUE LOT No. 14

BLOCK No. 14

NAME ADD. D. v. 13

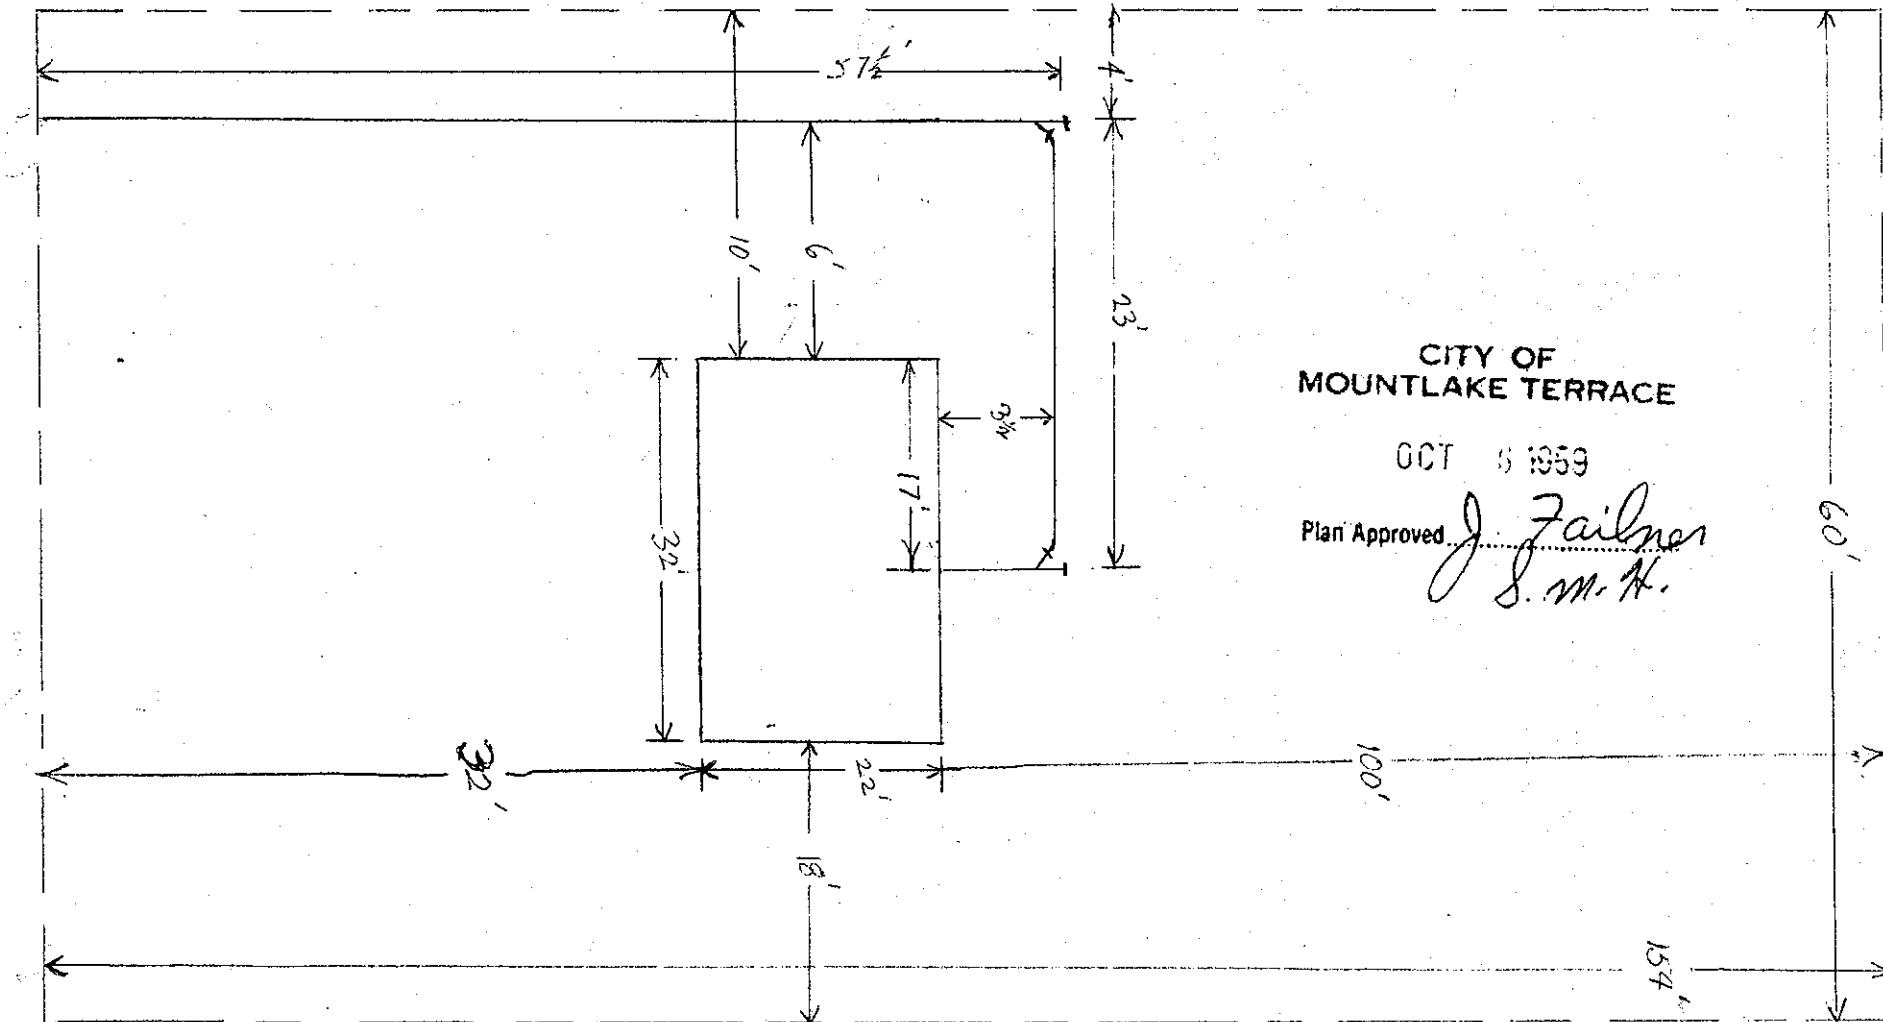

Date

Approved:

BACKFILL WORK ORDER ISSUED

DEPOSIT, \$10⁰⁰

10-3-59

SEWER WORK ORDER ISSUED

5059

DATE 10-6-59 BY Scott m Holton IWS

1-4-60 INST CON 8220ft.

N.C.

APPROVAL

CARD No.

The City of Mountlake Terrace

GRAVATTI

OWNER Keith Jones

HOUSE NO. 23105-53 1/2

NAME ADD.

SIDE SEWER PERMIT


OUTSIDE INSIDE REPAIRS

EASEMENT No. 135774C

PERMIT No. 385

CONTRACTOR B+E

STREET AVENUE LOT No. 8 DIV 12 BLOCK No. 3

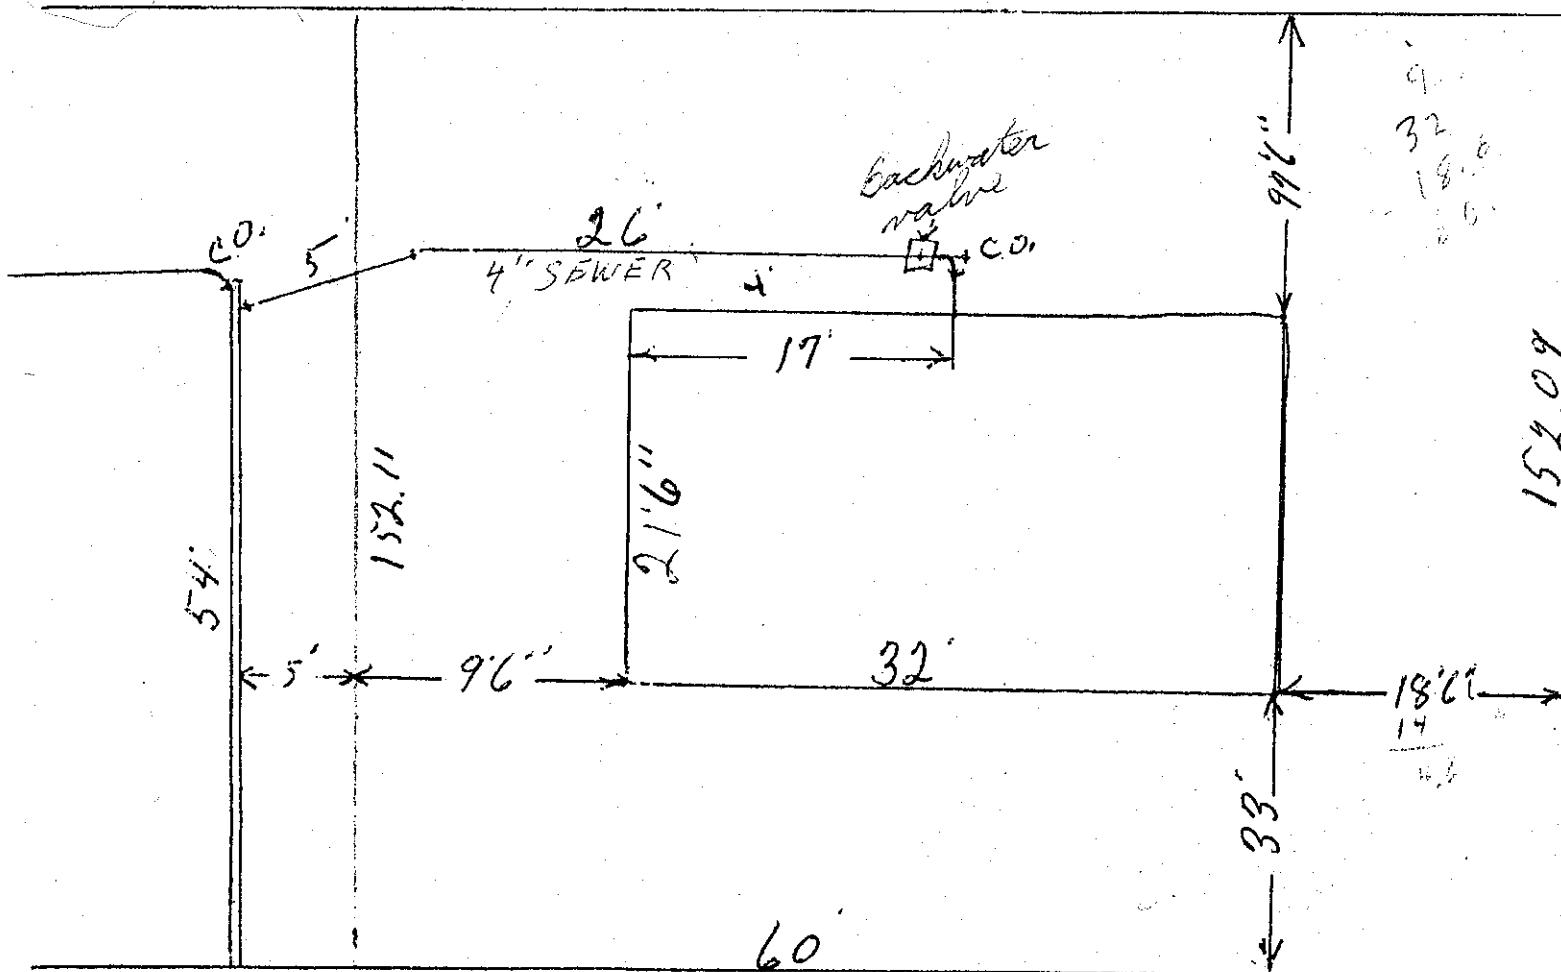

Date

Approved:

BACKFILL WORK ORDER ISSUED
SEWER WORK ORDER ISSUED

DEPOSIT, \$ 10.00

8/17/60
#1814

DATE 8-18-60 BY J. M. Holton

The City of Mountlake Terrace

APPLICATION

SIDE SEWER PERMIT

OUTSIDE INSIDE REPAIRS

LEO MILLER

CARD No.

EASEMENT No. 1355629

OWNER LEO MILLER

HOUSE No. 23106 W-53RD AVE.


CONTRACTOR

STREET
AVENUE LOT No. 13

PERMIT No. 2244

BLOCK No. 4

NAME ADD. D. V. L. L.

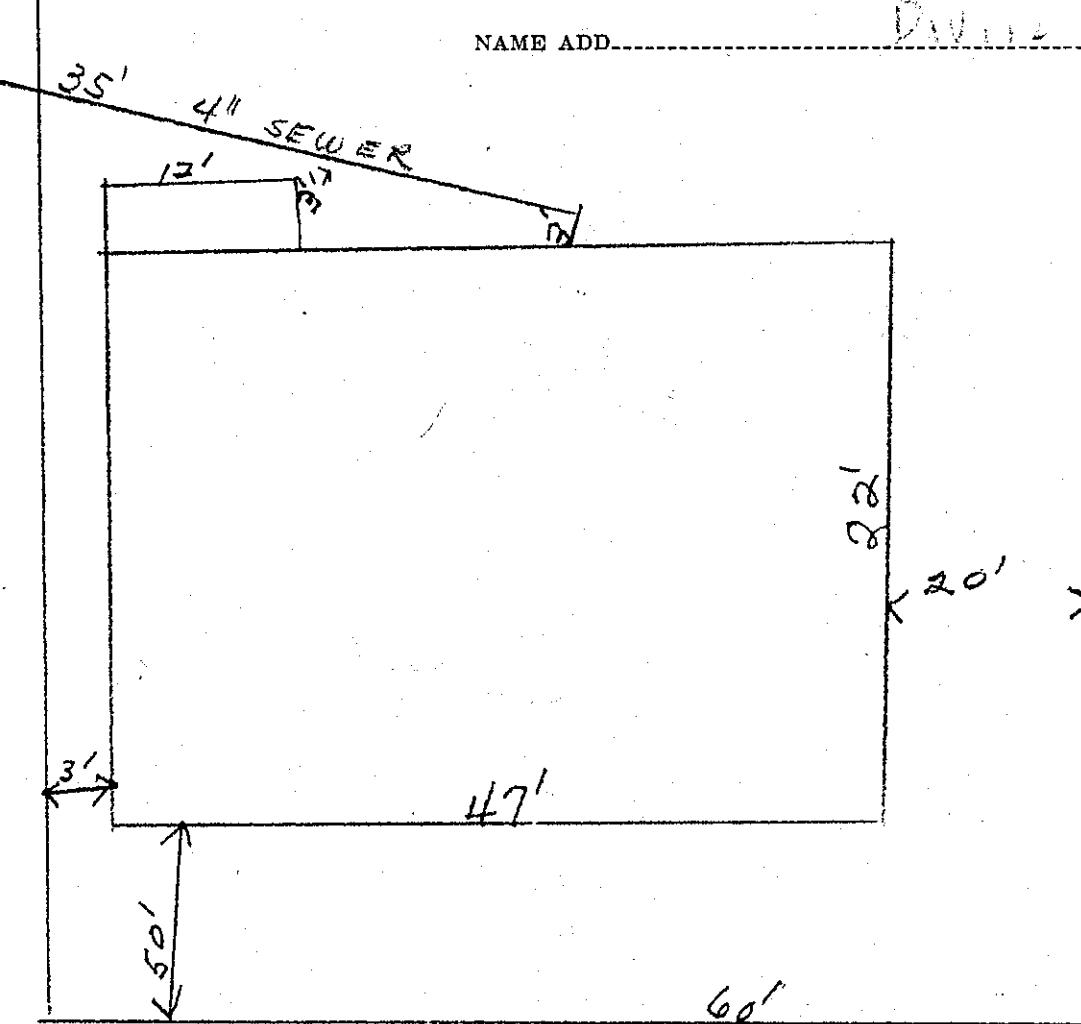

Date

Approved:

BACKFILL WORK ORDER ISSUED

DEPOSIT, \$10.00

3/28/60

SEWER WORK ORDER ISSUED

1048

DATE 4/7/60

BY

J. Fairless
SM

APPLI JION

SIDE SEWER PERMIT

The City of Mountlake Terrace

OUTSIDE INSIDE REPAIRS

CARD No.....

EASEMENT NO. 1358749

OWNER F. G. CURRIE

HOUSE No. 23107-53rd WEST

CONTRACTOR Hale Construction


STREET
AVENUE LOT No.

NAME ADD.

PERMIT No. 962

9
BLOCK No. 3

D.V.12

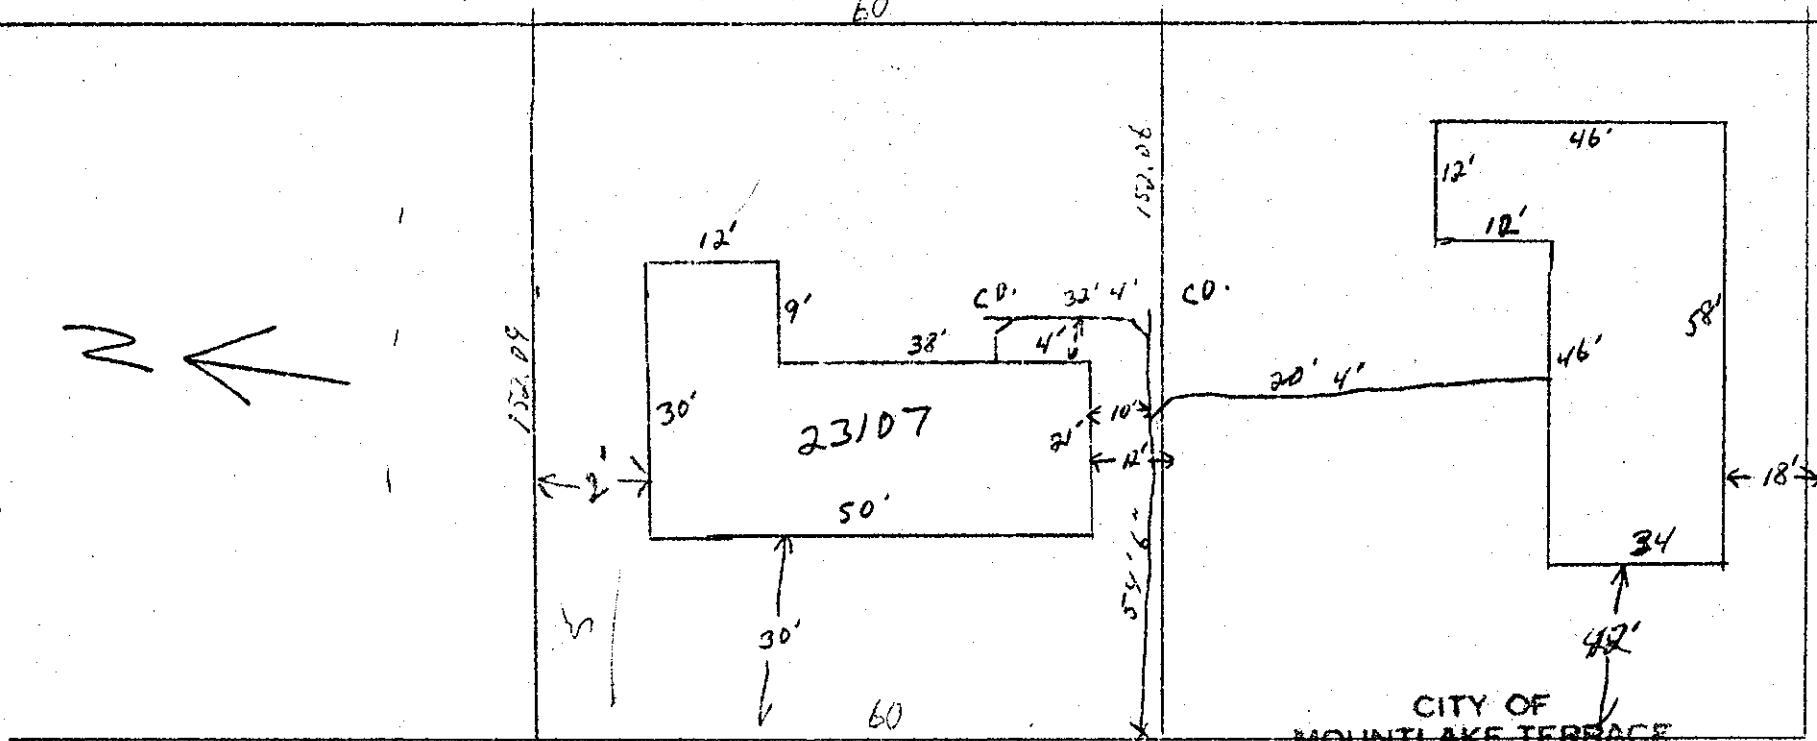CITY OF
MOUNTLAKE TERRACE

53rd W.

OCT 12 1959

Plan Approved:

B. Fairiner
J. Gray, M. C.

Date

Approved:

BACKFILL WORK ORDER ISSUED

DEPOSIT, \$ 10.00

Rec 5/32

SEWER WORK ORDER ISSUED

DATE

BY

J. Fairiner
J. Fairiner
St. Yost 1959 1-21-59 NS CON 8m H.

APPLICATION

SIDE SEWER PERMIT

The City of Mountlake Terrace

CARD No. *O✓*OUTSIDE INSIDE REPAIRS EASEMENT No. *1365629*OWNER *ALLEN MILLER*
HOUSE No. *23108* 53rd WESTCONTRACTOR *Miller*PERMIT NO. *2243*STREET
AVENUE LOT No. *12*BLOCK No. *4*NAME ADD.
*LOT LINE**sliv. 12*CITY OF
MOUNTLAKE TERRACE

APR 5 1960

Plan Approved *J. Laitner*CITY OF
MOUNTLAKE TERRACE

APR 7 1960


Plan Approved *J. Laitner*

PROPERTY LINE

SEWER MAIN

Date

DEPOSIT, \$10.00 3/28/60

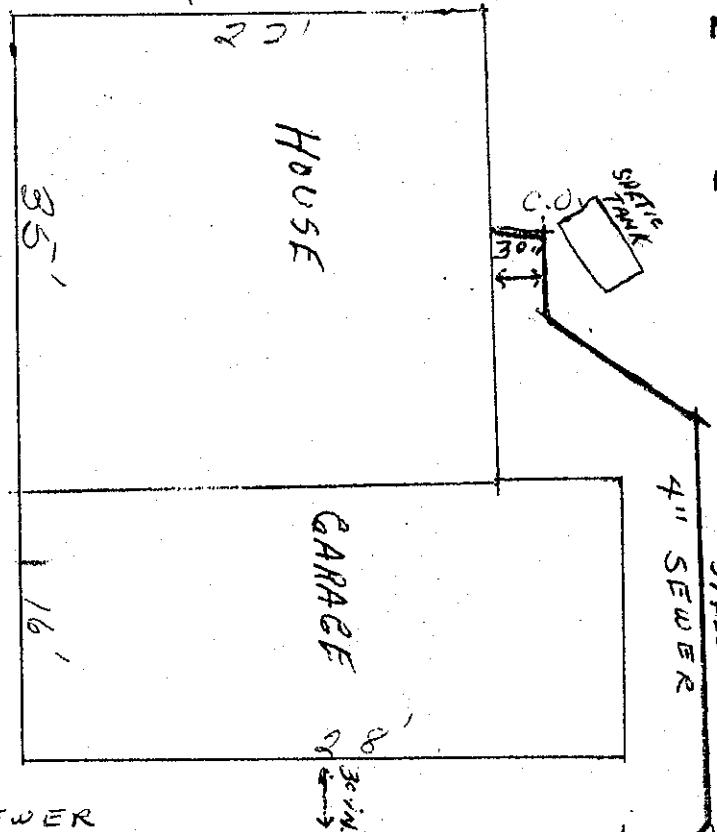BACKFILL WORK ORDER ISSUED
SEWER WORK ORDER ISSUEDLOT LINE
Approved:

23108-5340. CONNECTION

1047 DATE *4/5/60* BY *J. Laitner*

The City of Mountlake Terrace

APPLICATION

CARD No.

SIDE SEWER PERMIT

OUTSIDE INSIDE REPAIRS

EASEMENT NO.

1353638

OWNER E. L. SARKILLATTI
HOUSE No. 23205 53 RD W


CONTRACTOR HALE CONST.

PERMIT No. 2071

STREET AVENUE LOT No. 3

BLOCK No.

NAME ADD. BLK 1X0 6

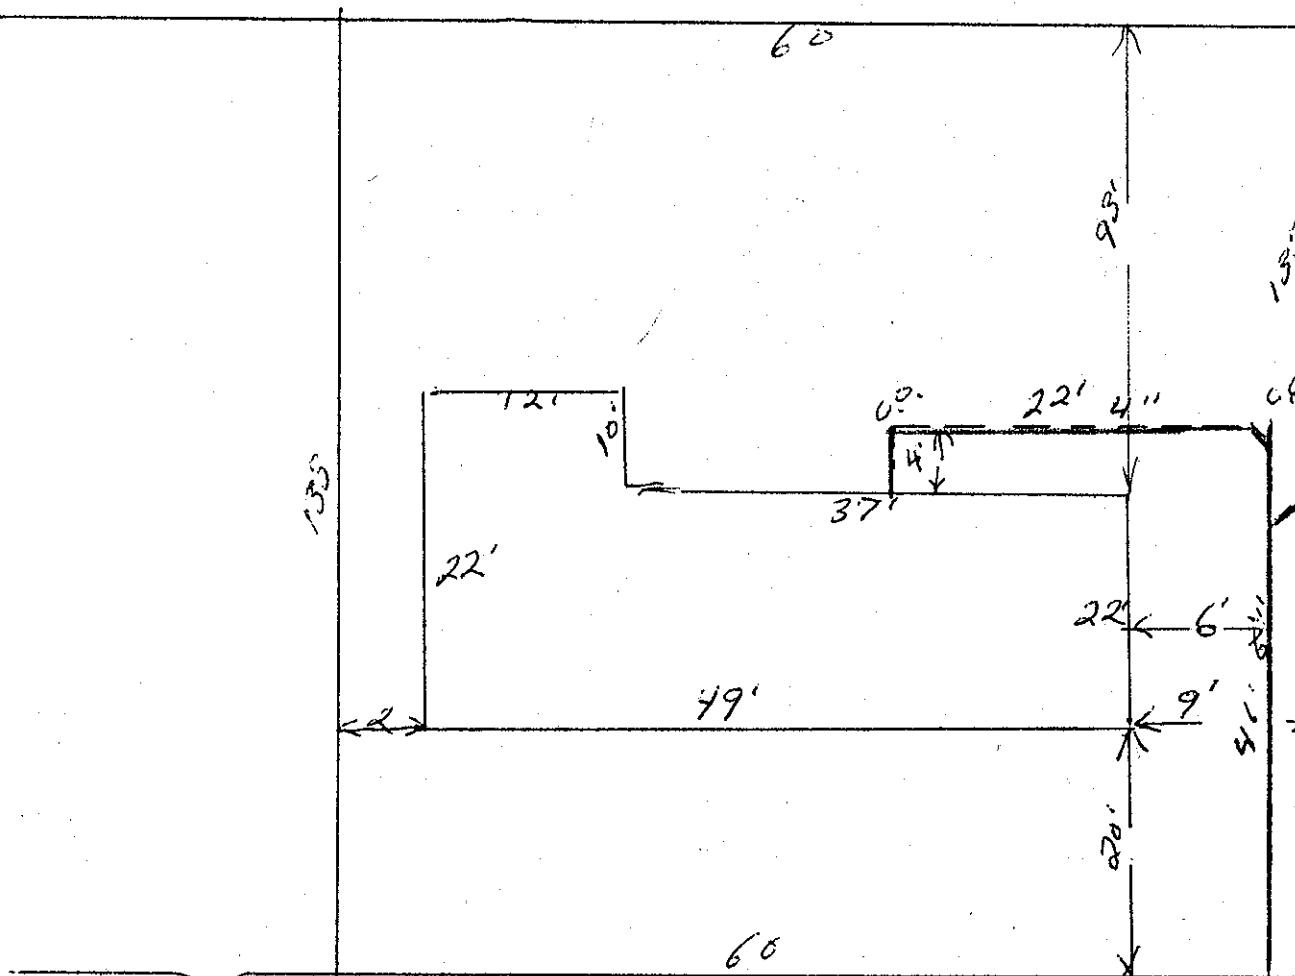

CITY OF
MOUNTLAKE TERRACE

MAR 21 1960

Plan Approved

S. M. Abee

Date

53 RD

Approved:

BACKFILL WORK ORDER ISSUED
SEWER WORK ORDER ISSUED

DEPOSIT, \$ 100.00

DATE 3-21-60 BY J. Cottrell Holton INS + CON
RECEIVED
RENI FREEMAN

APPLI CATION

CARD No. 5

The City of Mountlake Terrace

SIDE SEWER PERMIT

OUTSIDE INSIDE REPAIRS

EASEMENT No. 1353638

OWNER T D SHINERMAN


HOUSE No. 23207 53RD W

CONTRACTOR HALE CONSTRUCTION PERMIT No. 7072

STREET AVENUE LOT No. 4

BLOCK No.

NAME ADD. DIV. NO. 6

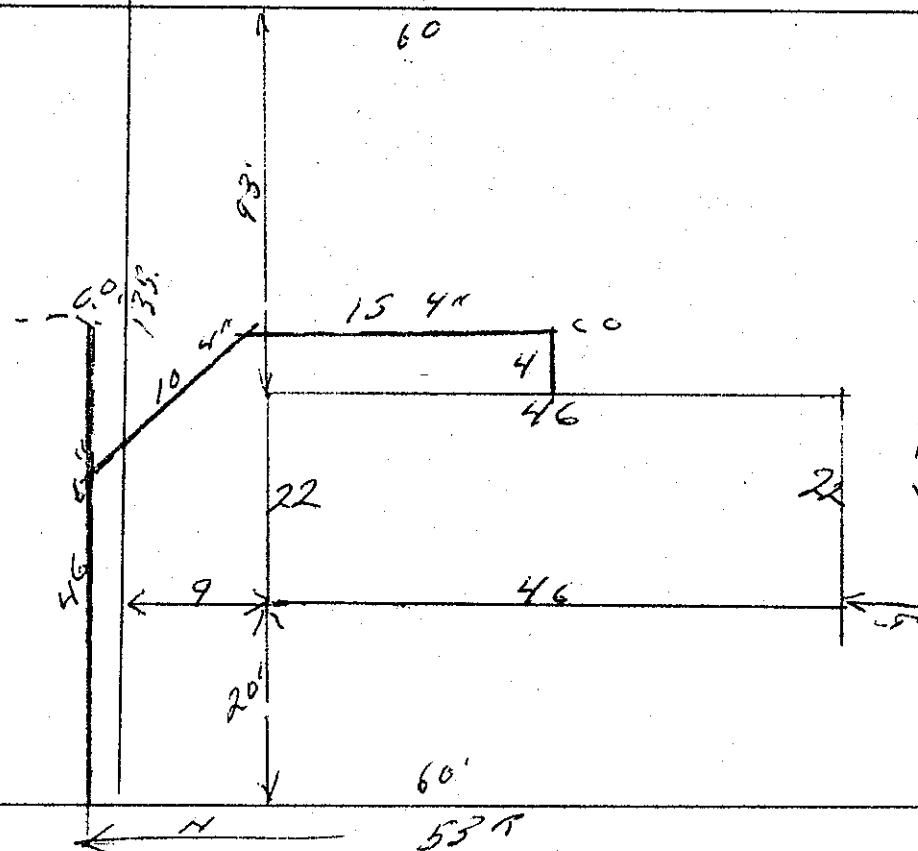

Date

DEPOSIT, \$ 10.00

Approved:

BACKFILL WORK ORDER ISSUED.

SEWER WORK ORDER ISSUED.

DATE 3-21-60 BY

rec 912
Rene Freeman

Scott M Holton

APPLICATION

115-5 USE

CARD No.

The City of Mountlake Terrace

SIDE SEWER PERMIT

OUTSIDE INSIDE REPAIRS

EASEMENT No. 1390874

OWNER Thomas L. Guss

CONTRACTOR B & E


PERMIT No. 106

HOUSE NO. 23209 - 53rd W.

STREET AVENUE LOT No. 5 DIV 6

BLOCK No. 4

NAME ADD.

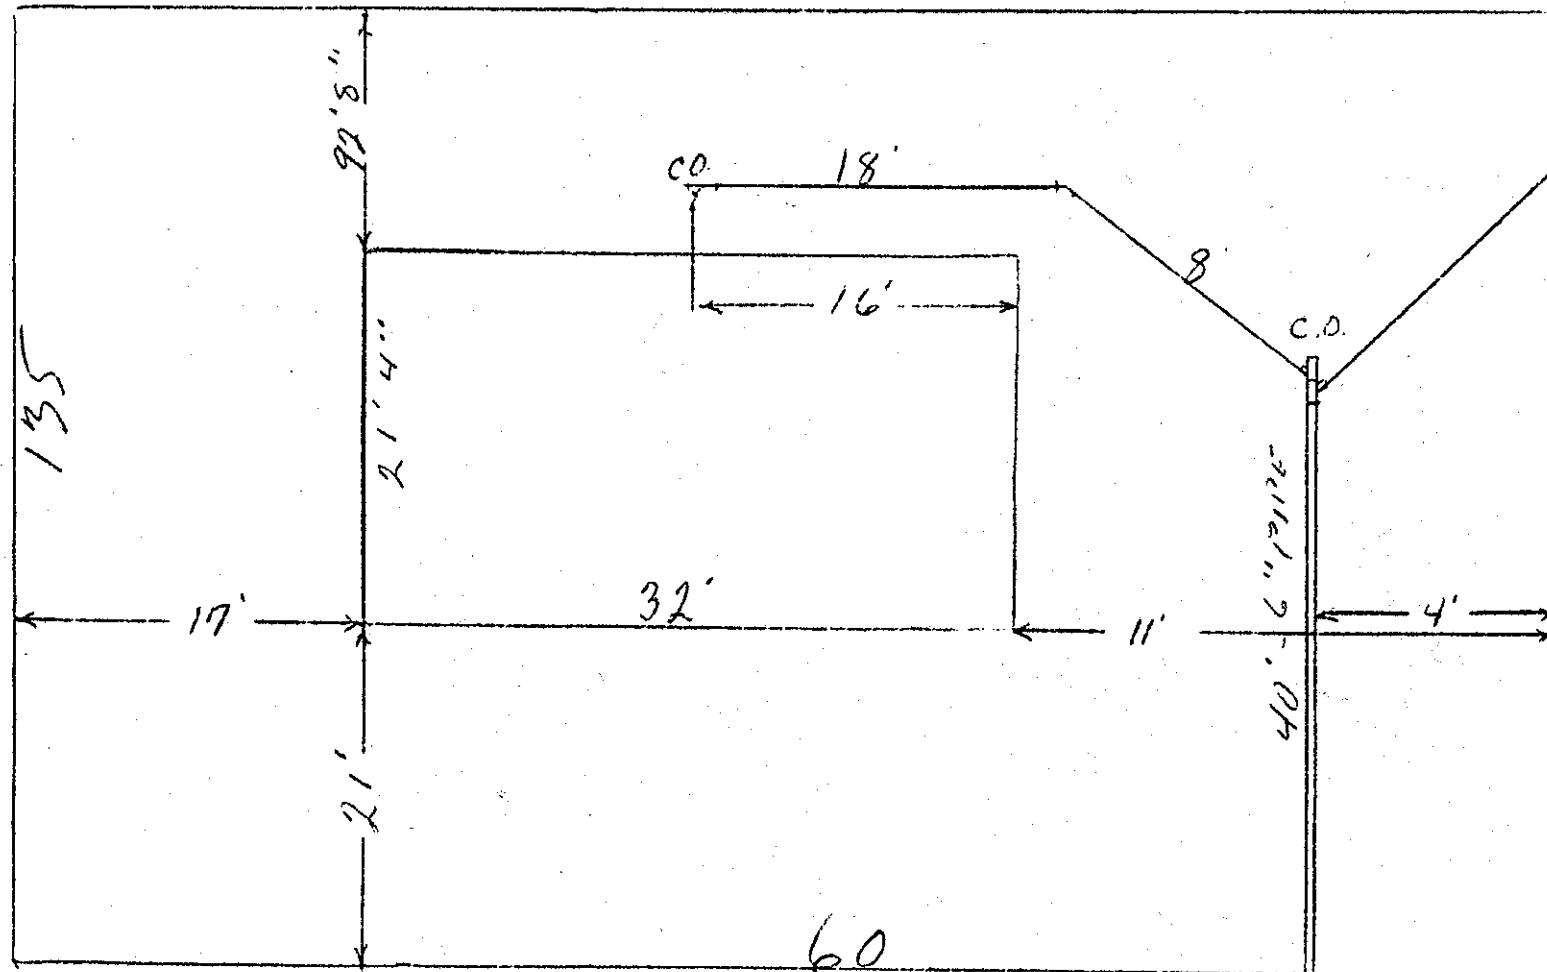

Date

Approved:

BACKFILL WORK ORDER ISSUED

DEPOSIT, \$10.00

Approved:

SEWER WORK ORDER ISSUED

1540

Approved:

DATE

5/27/60

BY

J. E. Mervin

APPLICATION

CARD No. ✓

The City of Mountlake Terrace

SIDE SEWER PERMIT

OUTSIDE INSIDE REPAIRS

EASEMENT No.

1390874

OWNER John J. Yanda
HOUSE No. 23301 - 53rd Av.

CONTRACTOR B & E

PERMIT NO. 107

STREET AVENUE LOT No. 6 DIV 6


BLOCK No. 4

NAME ADD.

CITY OF MOUNTLAKE TERRACE

MAY 27 1960

Plan Approved, S. M. Ahee

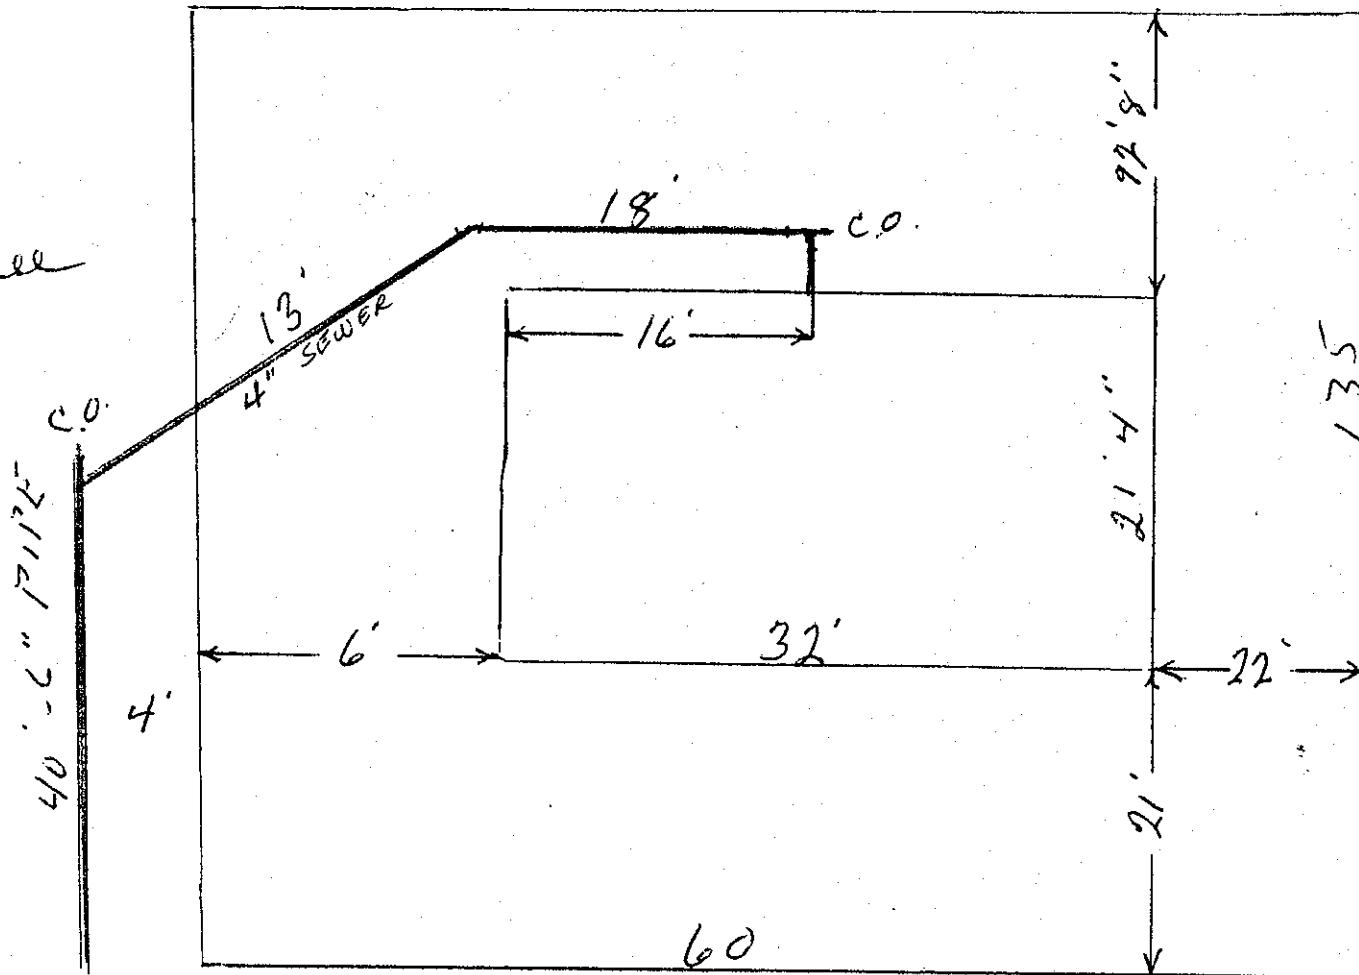

Date

BACKFILL WORK ORDER ISSUED

DEPOSIT, \$10.00

Approved:

SEWER WORK ORDER ISSUED

1548

DATE 5/26/60

BY

J. M. Ahee

The City of Mountlake Terrace

APPLICATION

for


SIDE SEWER PERMIT

OUTSIDE INSIDE REPAIRS

CARD NO.

EASEMENT No.

OWNER Duff D. Smith CONTRACTOR Self PERMIT No. 1794
HOUSE No. 23302 - 53rd STREET 10
NAME ADD. Mountlake Terrace DIV. No 6
AVENUE LOT No. BLOCK No. 3

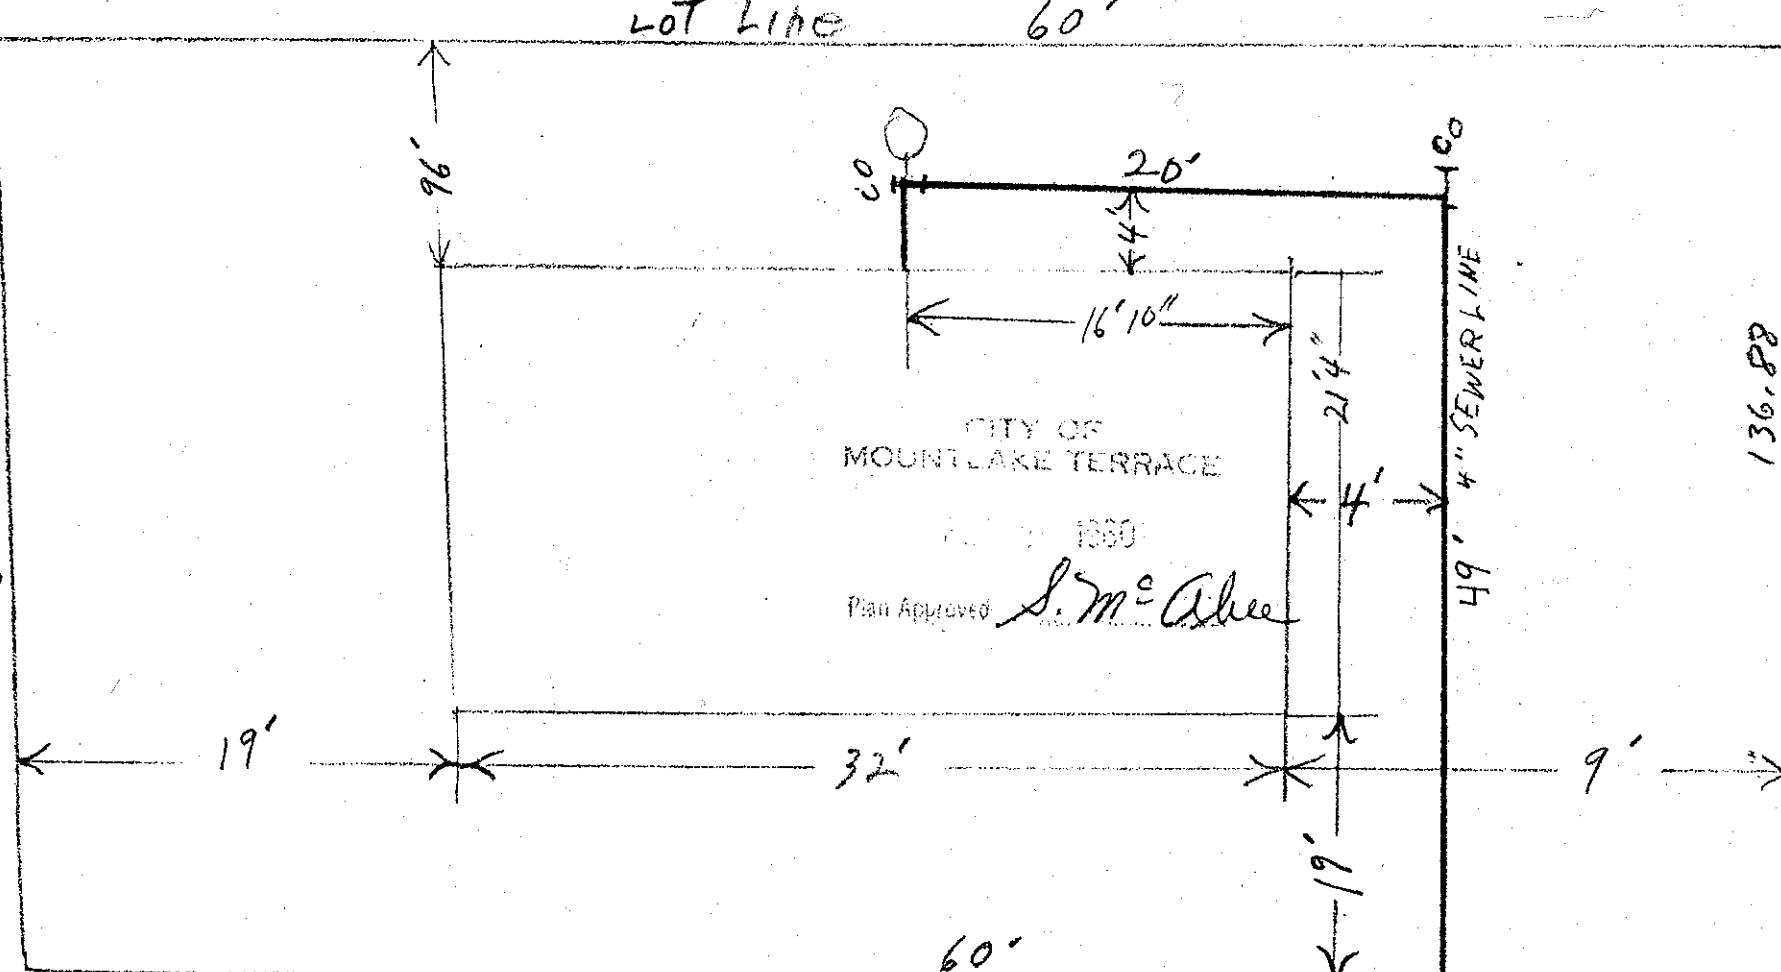

Date

Approved:

BACKFILL WORK ORDER ISSUED

DEPOSIT, \$10⁰⁰ 2-25-60

SEWER WORK ORDER ISSUED

663

DATE 2-26-60 BY Scott on Holton INST CO

The City of Mountlake Terrace

APPLICATION
for

SIDE SEWER PERMIT
OUTSIDE INSIDE REPAIRS

ALLEN DAVENPORT

CARD No.

1353786

EASEMENT No.

OWNER ALLEN DAVENPORT
HOUSE No. 23303 - 53 RD W

CONTRACTOR LO FRANKLIN CO


PERMIT No. 1013

STREET
AVENUE LOT NO. 7

BLOCK No. 4

NAME ADD.

DIV 6

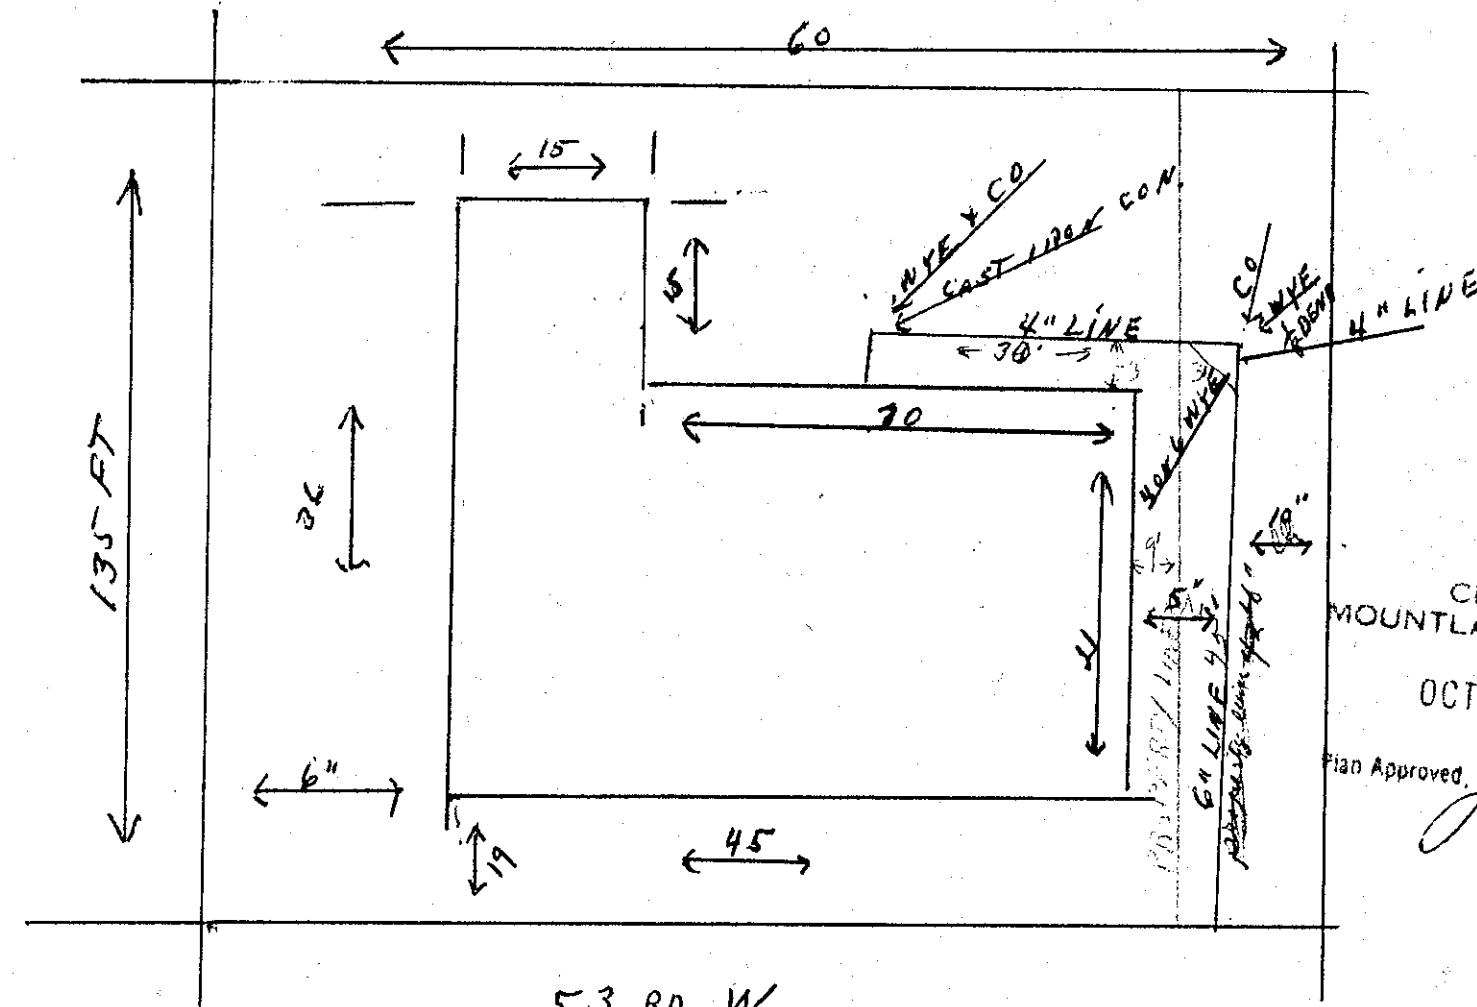

Date

Approved:

BACKFILL WORK ORDER ISSUED
SEWER WORK ORDER ISSUED

DEPOSIT, \$

10.00

Rec 5224

DATE 10-23-59

BY Scott M Holton

Agmt 10/22/59

1-13-60 INST CON S.M.H.

The City of Mountlake Terrace

APPLICATION
for

SIDE SEWER PERMIT

OUTSIDE INSIDE REPAIRS

L1690 MANLEY

CARD No.

EASEMENT No. 13 53786

OWNER Lloyd Manley

HOUSE No. 23305 53 W

CONTRACTOR


L.O. FRANKLIN

PERMIT No. 1014

STREET
AVENUE LOT No. 8

BLOCK No. 4

NAME ADD Div #6

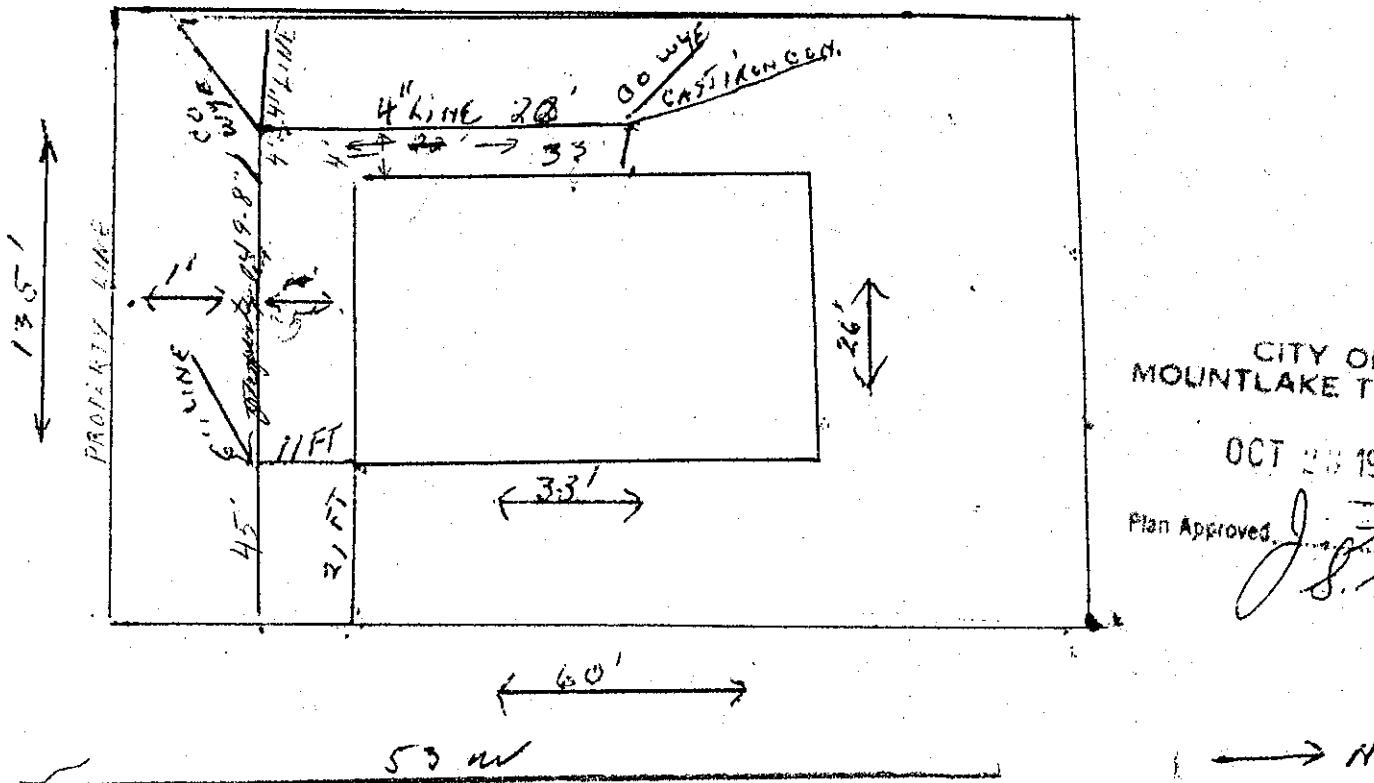

CITY OF
MOUNTLAKE TERRACE

OCT 23 1959

Plan Approved,

J. Franklin
J.S.M.A.

Date

Approved:

BACKFILL WORK ORDER ISSUED
SEWER WORK ORDER ISSUED

DEPOSIT, \$ 10.00

Rec. 5224 DATE 10-23-59 BY Scott M Holton INS
Digit 10/23/59 1-13-60 INST CON 8m9N.
N.C.

APPLICATION

SIDE SEWER PERMIT
 OUTSIDE INSIDE REPAIRS

The City of Mountlake Terrace

Phillip Morris
CARD No.

EASEMENT No. 1354175

OWNER Phillip Morris

HOUSE No. 23306 53 W

CONTRACTOR

L. O. FRANKLIN


PERMIT No. 1037

STREET

AVENUE LOT No. 8

BLOCK No. 3

NAME ADD DLU 6

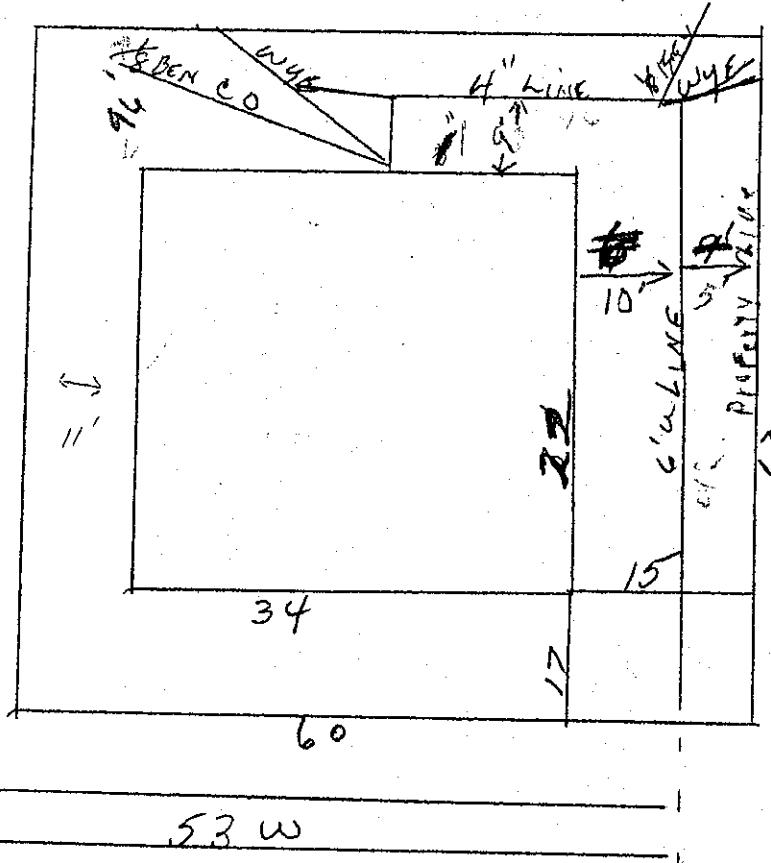

CITY OF
MOUNTLAKE TERRACE

OCT 30 1959

Plan Approved.

J. Zalmer
J. S. Mifflin

BACKFILL WORK ORDER ISSUED
SEWER WORK ORDER ISSUED

Date

DEPOSIT, \$ 10.00

Approved:

Rec 5252 DATE 10-30-59 BY Scott on Holton
 Augst 10/27/59 1-19-60 INST CON SMT

APPLICATION

The City of Mountlake Terrace

SIDE SEWER PERMIT

OUTSIDE INSIDE REPAIRS

Chester Chpso

CARD No.

EASEMENT No. 1381191

OWNER Chester Chpso

HOUSE NO. 23307 53 W

CONTRACTOR R. D. Johnson Const Co

PERMIT NO. 1652

STREET


AVENUE LOT No.

9

BLOCK No.

NAME ADD.

6

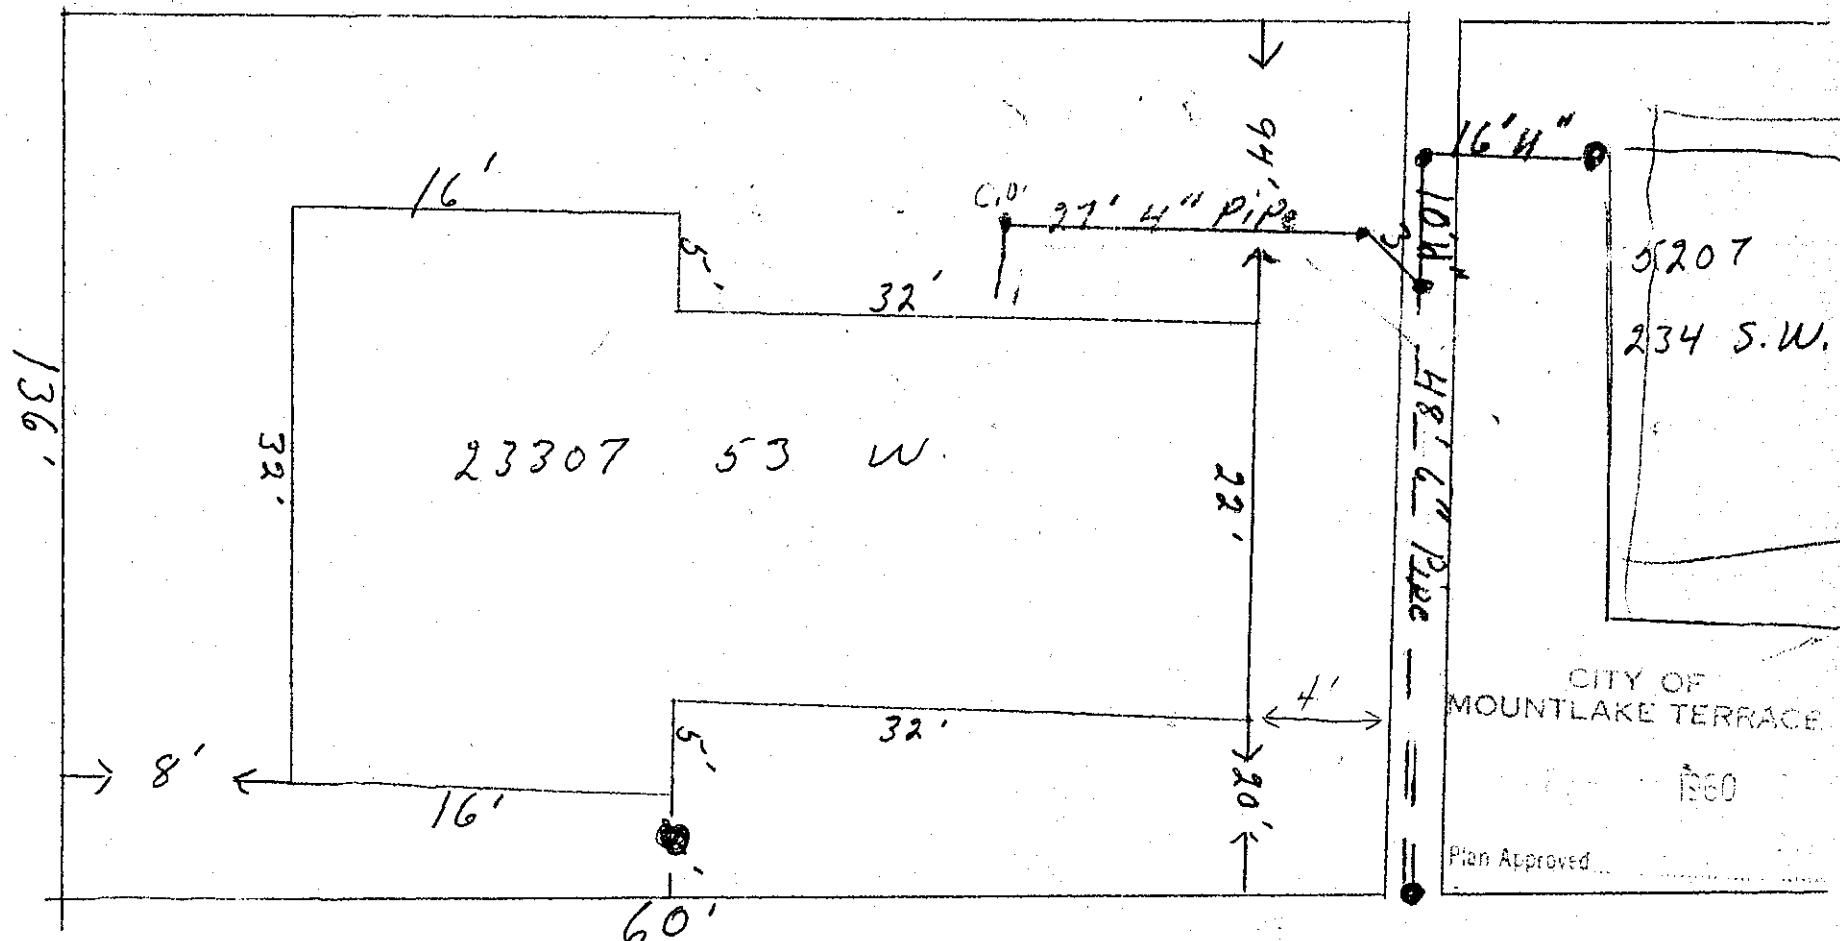

Date

BACKFILL WORK ORDER ISSUED

DEPOSIT, \$ 10.00

SEWER WORK ORDER ISSUED

5929

2/4/60

2/4/60

Approved:

DATE 2-9-60

BY

Scott M Holton INSTCON

APPLICATION

The City of Mountlake Terrace

FILE NO. 1066ER

CARD NO.

SIDE SEWER PERMIT

OUTSIDE INSIDE REPAIRS

EASEMENT No. 1356890


OWNER Harry F Taggek
 HOUSE No. 23308 53 W

CONTRACTOR L.O. Franklin
 STREET AVENUE LOT No. 7

NAME ADD. D 14 6

BLOCK No. 3

PERMIT No. 966

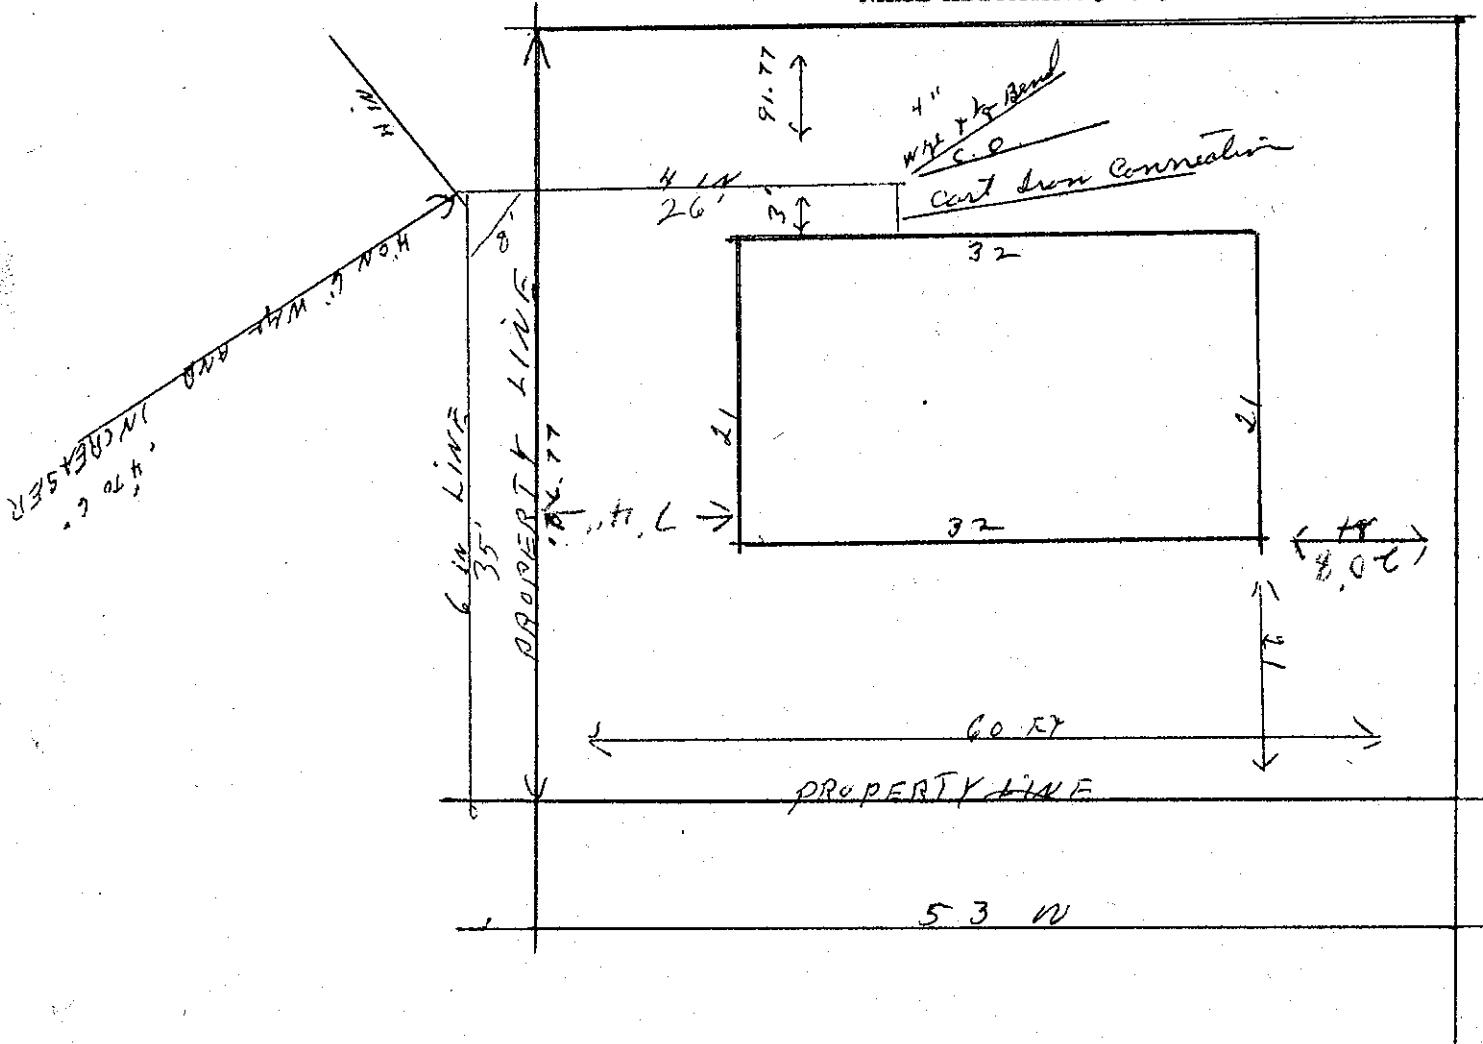CITY OF
MOUNTLAKE TERRACE

OCT 13 1959

Plan Approved

Date

Approved:

BACKFILL WORK ORDER ISSUED
SEWER WORK ORDER ISSUED

DEPOSIT, \$10.00

Rec. 5126

DATE 10-21-59 BY

10ynt 10/9/59

1-18-60 INST C ON SMTN

N.C.

The City of Mountlake Terrace

APPLICANT
for

H. E. Needham
CARD No.


SIDE SEWER PERMIT

OUTSIDE INSIDE REPAIRS

EASEMENT No. 1353205

OWNER Hubert I Needham CONTRACTOR self PERMIT No. 2132
HOUSE No. 23403 - 53rd STREET
AVENUE LOT No. #2 BLOCK No. 3
NAME ADD. Mountlake Terrace DIV. 7

lot line 60

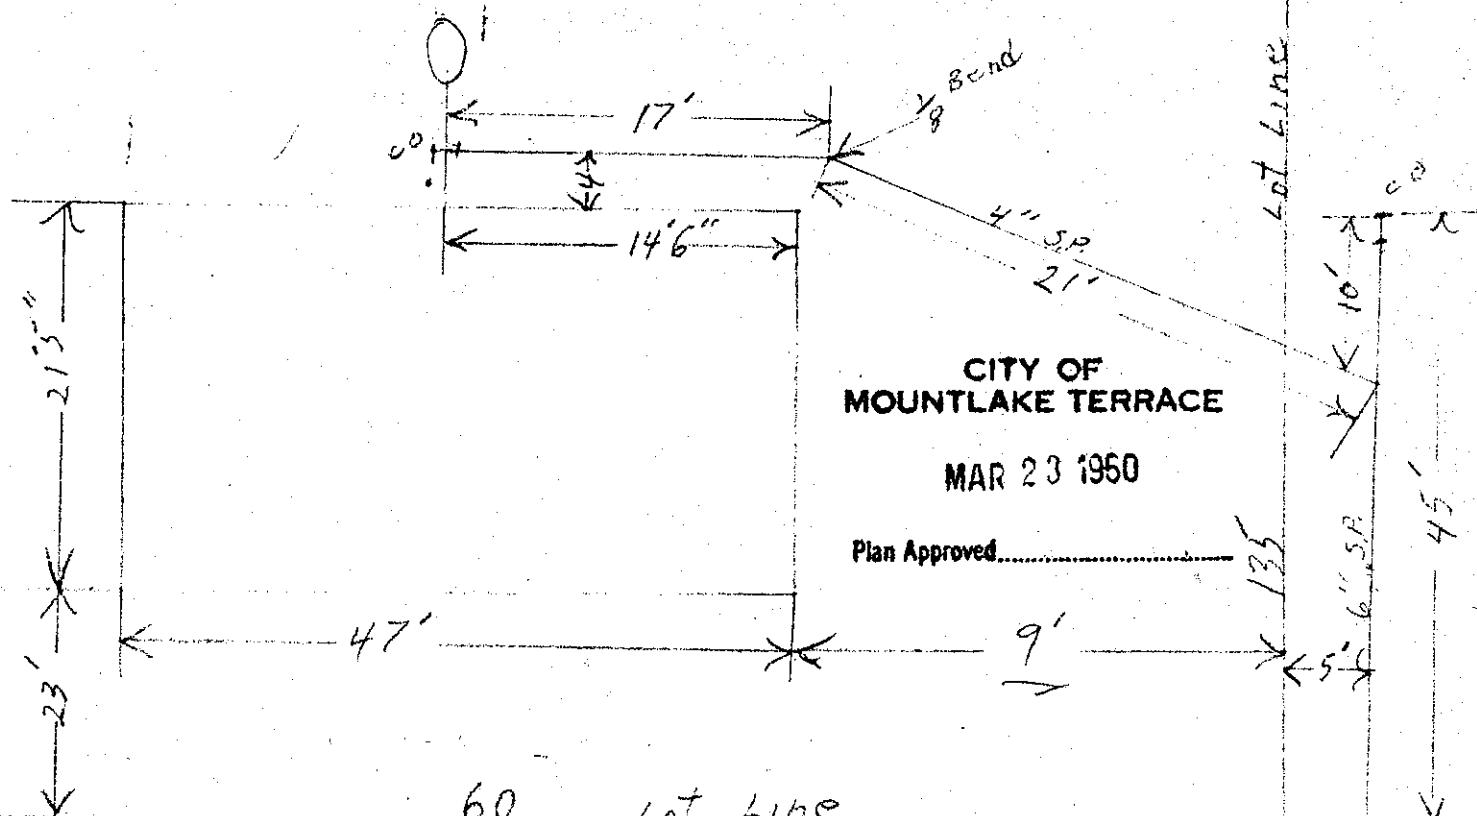

Date

53-205

Approved:

DEPOSIT, \$10.00 3/23/60

BACKFILL WORK ORDER ISSUED
SEWER WORK ORDER ISSUED

957

DATE 3-23-60

BY Scott M Holton INSTCON

APPLICATION

FOR

SIDE SEWER PERMIT

OUTSIDE INSIDE REPAIRS

(2) CARD No.

EASEMENT No. 1357956

The City of Mountlake Terrace

OWNER

RICHARD V. RAVENHORST

HOUSE NO.

23404 - 53RD AVE WEST,

CONTRACTOR

PERMIT No. 821


STREET

AVENUE LOT NO.

1814

BLOCK NO. 2

NAME ADD

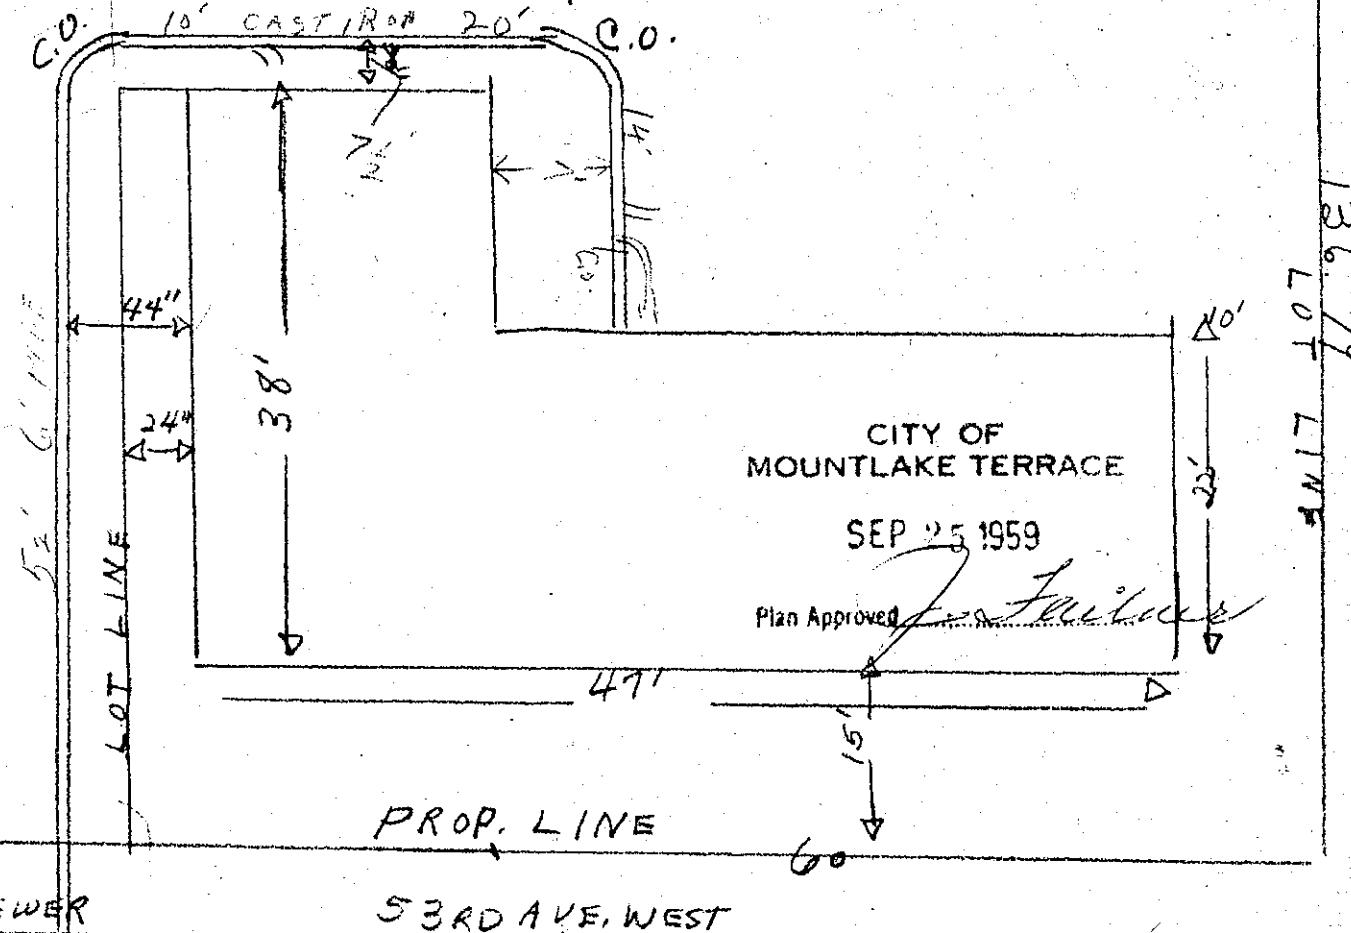

Date

Approved:

BACKFILL WORK ORDER ISSUED

DEPOSIT \$

10 10-9-59

SEWER WORK ORDER ISSUED

DATE 10-9-59

BY

Scott M Holton INS
#4473 8-22-60 INS+CON 8MPL N.C.

The City of Mountlake Terrace

APPLICATION

CARD No.

SIDE SEWER PERMIT

OUTSIDE INSIDE REPAIRS

EASEMENT No. 1353205

OWNER Mrs. Evelyn Zimmerman

HOUSE No. 23405 - 53rd

CONTRACTOR Self


PERMIT No. 2131

STREET Avenue Lot No. 3

BLOCK No. 3

NAME ADD. Mountlake Terrace Div. 7
LOT LINE

60

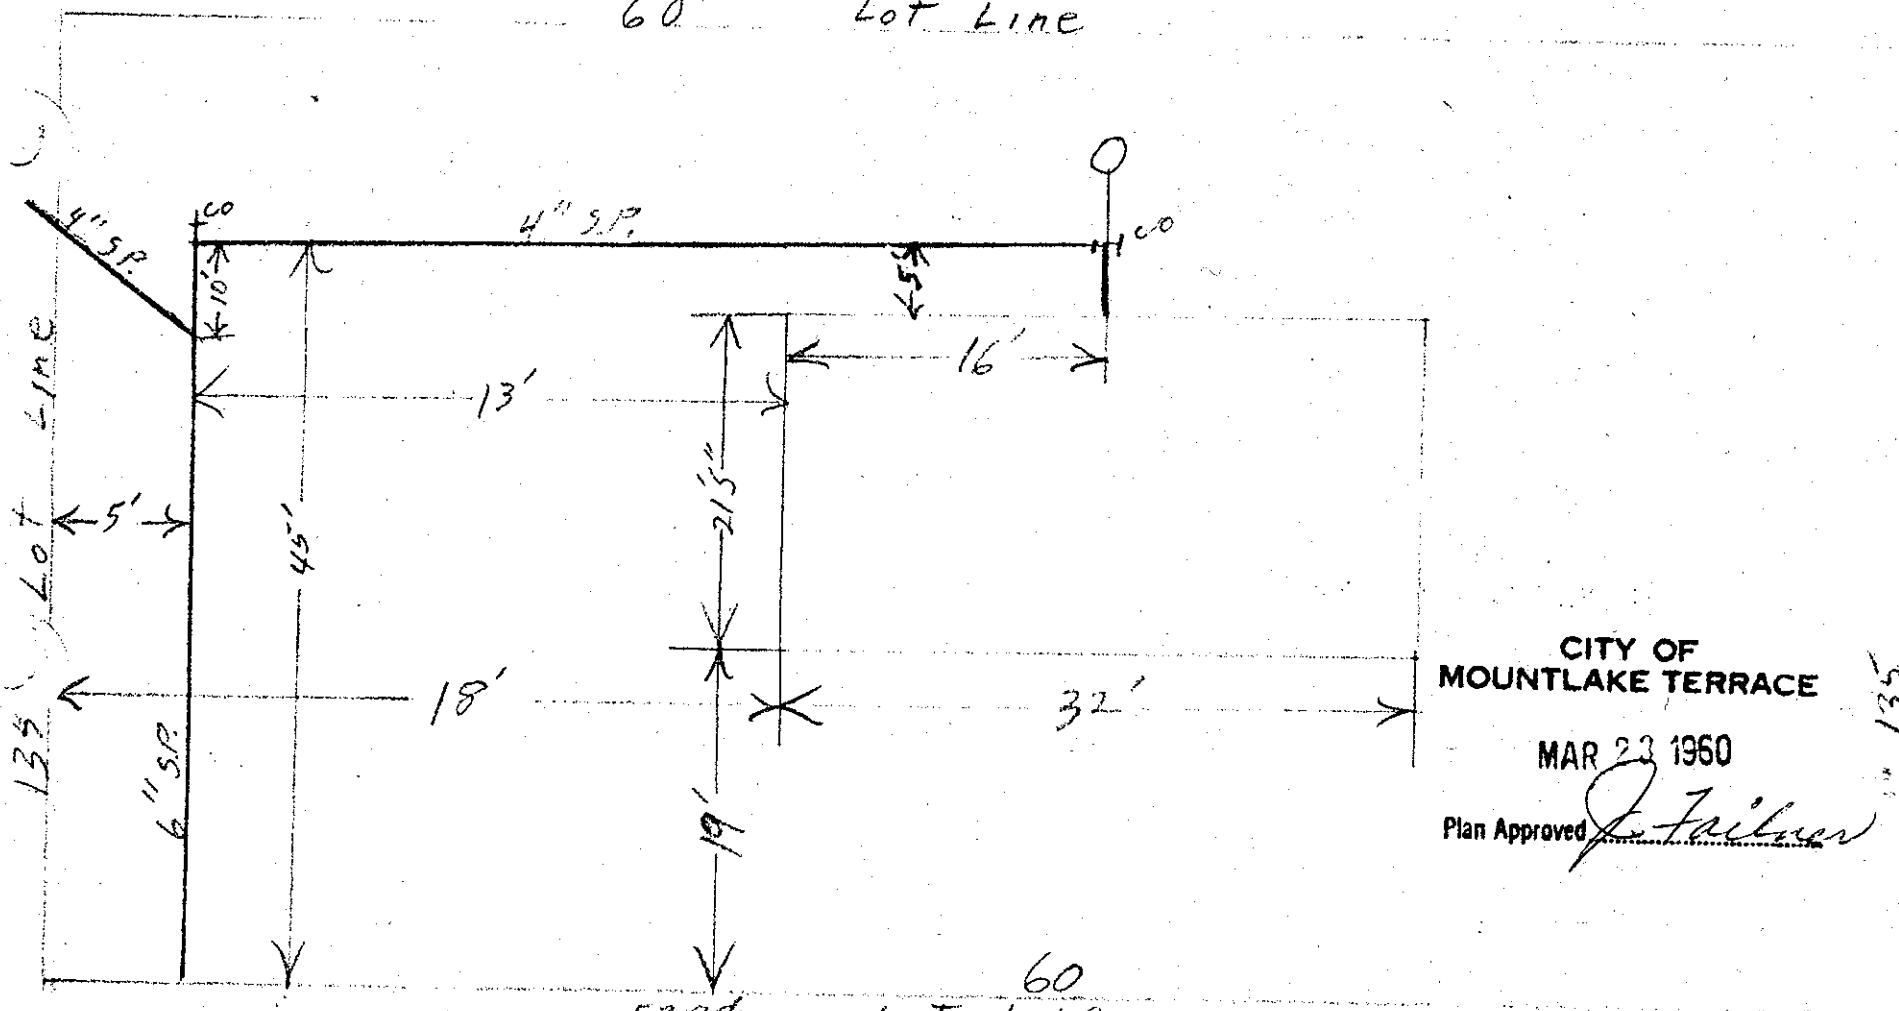

CITY OF
MOUNTLAKE TERRACE

MAR 23 1960

Plan Approved

J. Failler

BACKFILL WORK ORDER ISSUED

Date

DEPOSIT, \$10.00 3/23/60

Approved:

SEWER WORK ORDER ISSUED

957

DATE

3-23-60

BY

Scott M Holton INSTCON

APPLICATION

The City of Mountlake Terrace

SIDE SEWER PERMIT

OUTSIDE INSIDE REPAIRS

CARD No.....


EASEMENT No. 135.725.6 ✓

OWNER: Dowsing L. Lowell
HOUSE No. 234 86 W. 53rd.

CONTRACTOR: Gordon E. Bartlett Inc. PERMIT No. 889

STREET: 18 19 AVENUE LOT No. BLOCK No. 2

NAME ADD: 114 1/2

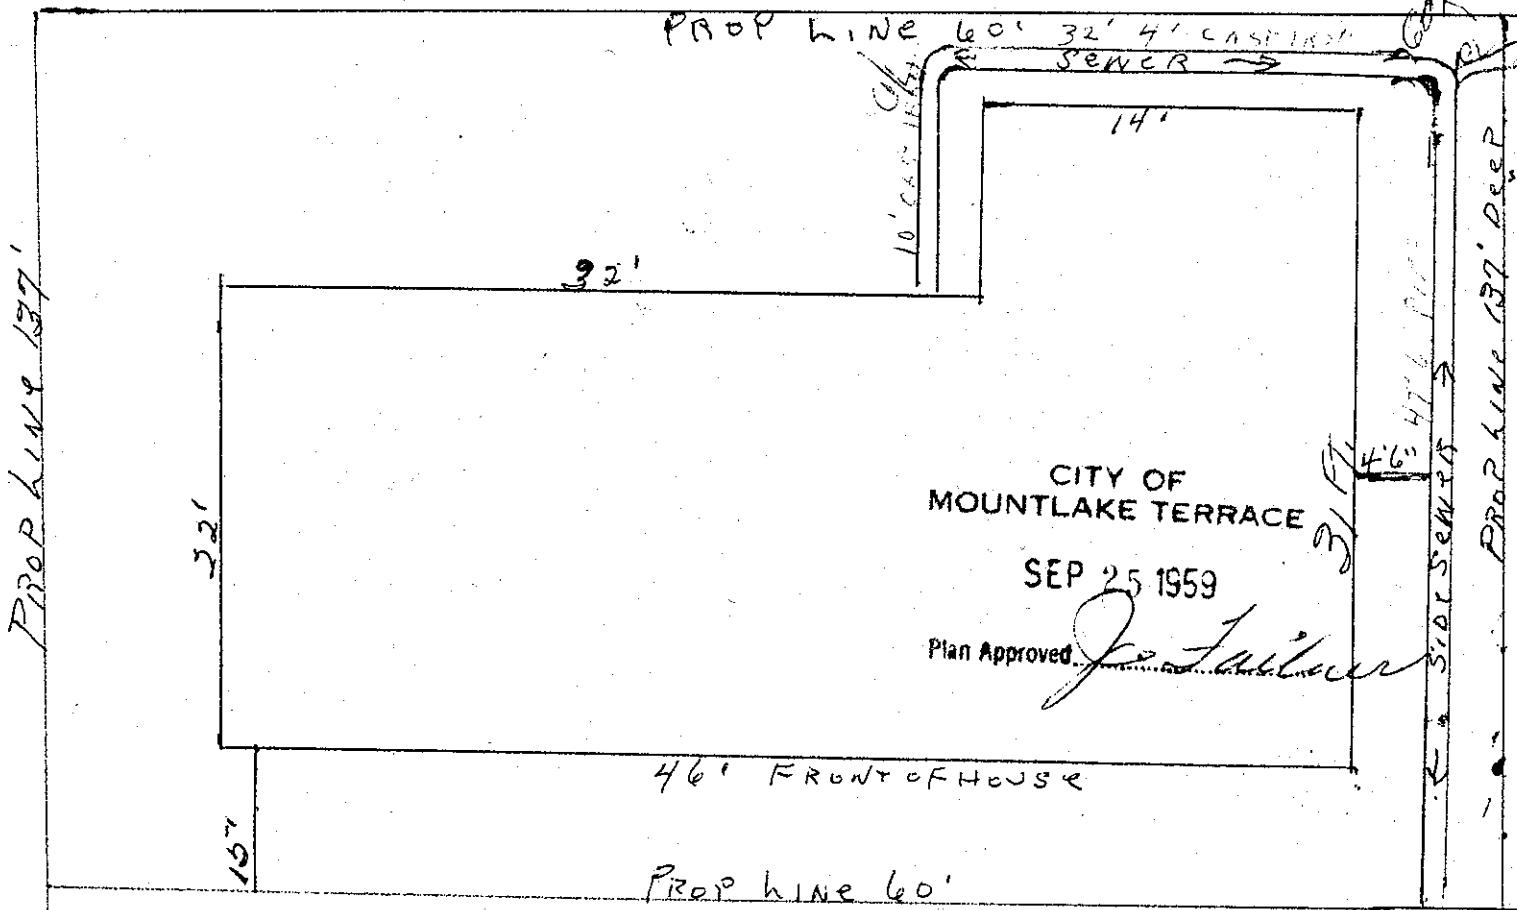

Date

Approved:

BACKFILL WORK ORDER ISSUED
SEWER WORK ORDER ISSUEDDEPOSIT, \$10⁰⁰

9-23-59

4965

DATE

9-26-59 BY Scott M. Hutton INS.

8-22-60 INS CONSMH N.C.

The City of Mountlake Terrace

APPLICATION

to

SIDE SEWER PERMIT

OUTSIDE INSIDE REPAIRS

CARD NO.

EASEMENT No.

OWNER..... K. W. MAYNE, JR.
HOUSE No..... 23407 - 53RD WEST

CONTRACTOR.....

OWNER.....

PERMIT No.....

STREET
AVENUE LOT No.....


4

BLOCK No.....

3

NAME ADD.....

MOUNTLAKE TERRACE

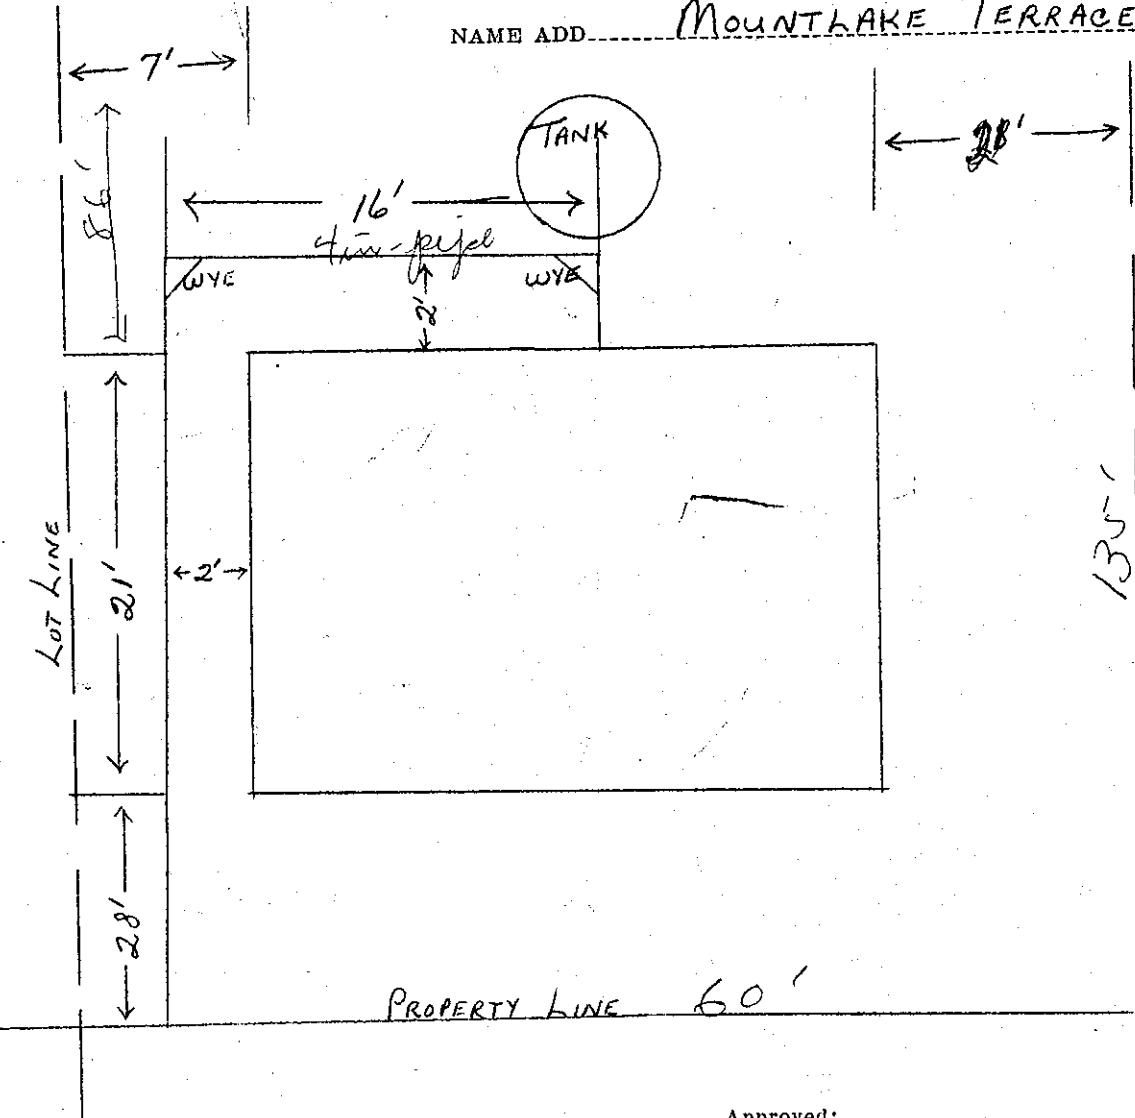

Date

Approved:

BACKFILL WORK ORDER ISSUED.....

DEPOSIT, \$10 ~~50~~

2-27-60

SEWER WORK ORDER ISSUED.....

686 DATE 5/27/60

BY

N. Murray

(2)

APPLICATION

PR 6-5432

PISCONNECT

MARVIN D. CADWALLADER

CARD No.

The City of Mountlake Terrace

SIDE SEWER PERMIT

OUTSIDE INSIDE REPAIRS

EASEMENT No. 1357408 ✓


OWNER MARVIN D CADWALLADER

HOUSE No. 23409 West 53

CONTRACTOR Gordon E. Bartlett, Inc. PERMIT No. 1187

STREET 5 AVENUE LOT No. 3 BLOCK No. 3

NAME ADD. M.L.T. #7

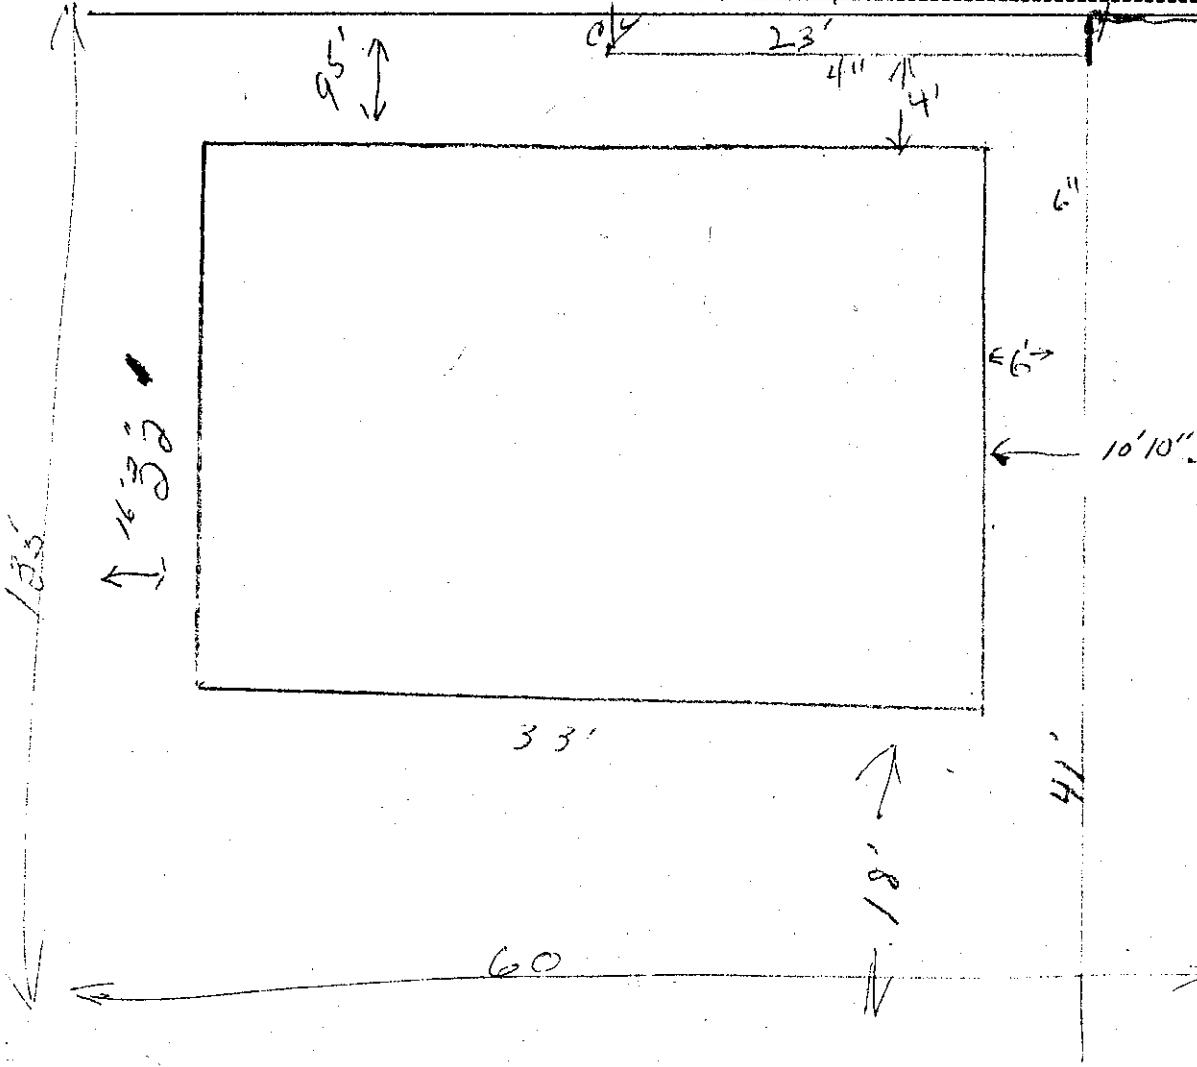

CITY OF
MOUNTLAKE TERRACE

NOV 23 1959

Plan Approved

J. Gaines
SMK.

BACKFILL WORK ORDER ISSUED

Date

DEPOSIT, \$ 10.00

Approved:

SEWER WORK ORDER ISSUED

DATE 11-23-59 BY Scott M Holtz

11/19/59 Rec 5413 deposit 8-24-60 INS+CON SMK

APPLICATION

The City of Mountlake Terrace

SIDE SEWER PERMIT

OUTSIDE INSIDE REPAIRS

8-0643

CARD No.

EASEMENT No. 1352314 ✓

OWNER Glenn D. Koontz

CONTRACTOR


PERMIT No. 840

HOUSE No. 23410 - 53 Ave W.

STREET AVENUE LOT No. 16

BLOCK No. 2

NAME ADD. 1207

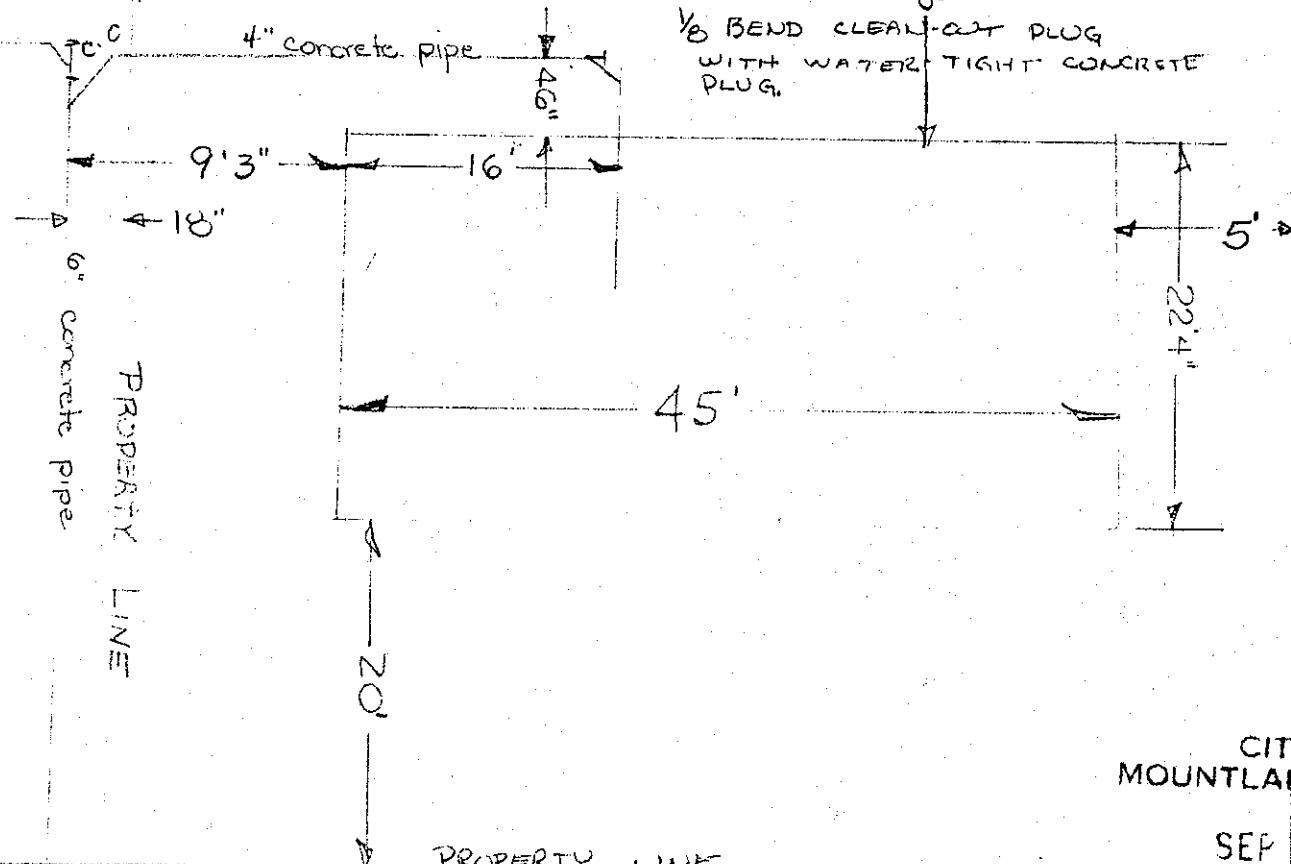WATER-TIGHT
CONCRETE PLUGCITY OF
MOUNTLAKE TERRACE

SEP 15 1960

Plan Approved

J. Stalmer
for

BACKFILL WORK ORDER ISSUED

SEWER WORK ORDER ISSUED

Date

DEPOSIT, \$ 10.00

Approved:

9-15-59

REC.# 4853

DATE 9/15/59 BY J. Stalmer 1960

8-18-60 INS + CON 8m 2

APPLICATION
FOR

SIDE SEWER PERMIT

OUTSIDE INSIDE REPAIRS (2) N. E. WEST UPER
CARD NO.

The City of Mountlake Terrace

EASEMENT No. 1351408 ✓

OWNER N. E. Westover

HOUSE NO. 23501 W 53rd

CONTRACTOR Gordon E. Bartlett, Inc. PERMIT NO. 1188


STREET
AVENUE LOT NO. 6

BLOCK NO. 3

NAME ADD. Mountlake terrace, Div 7

c/o

93' ↓

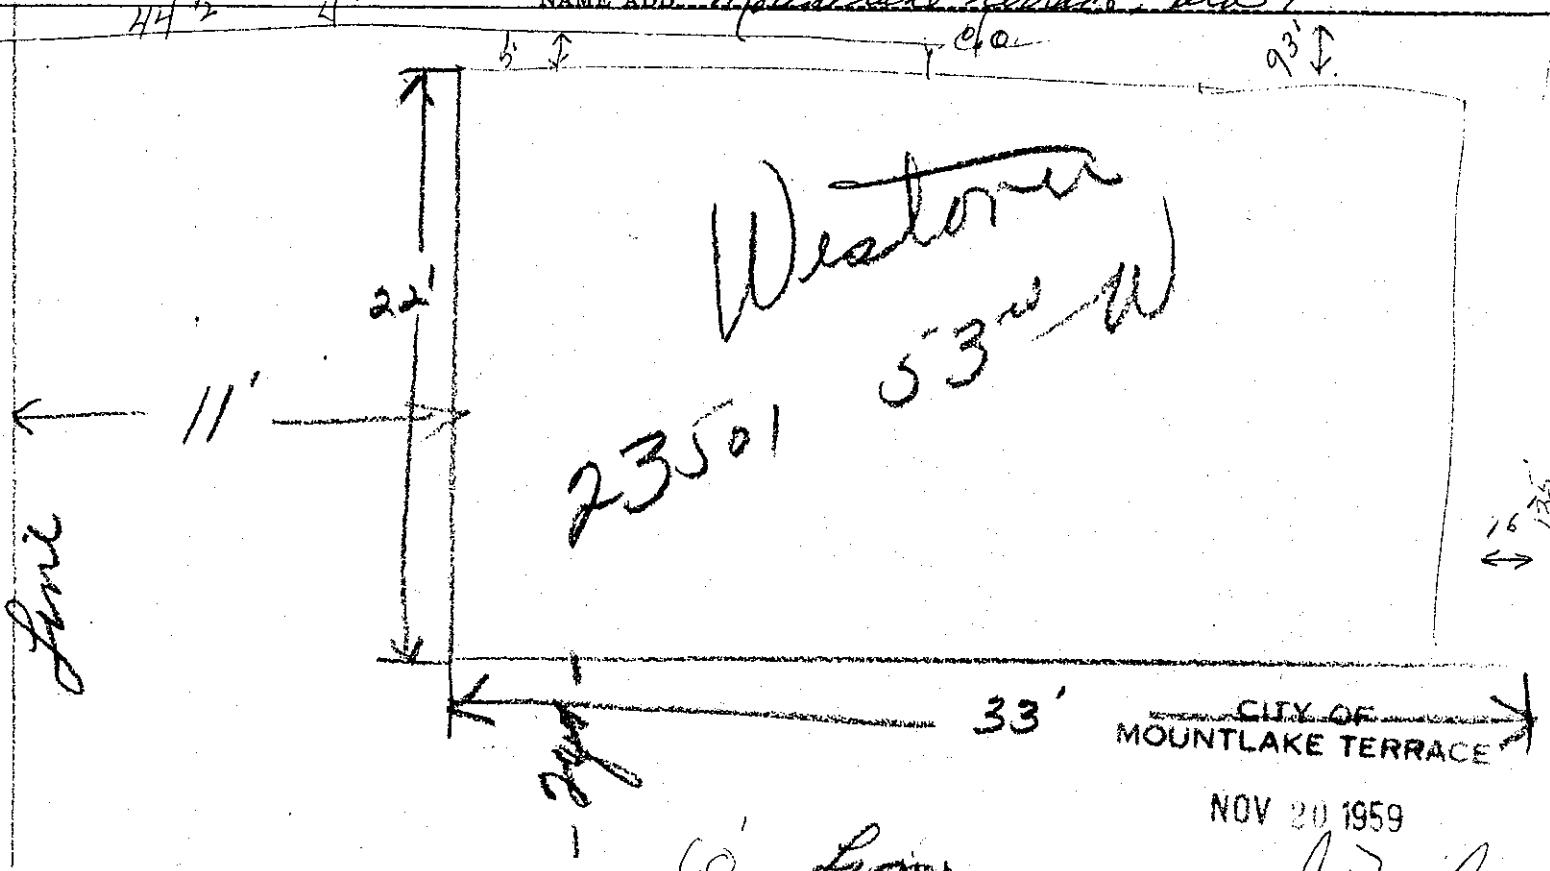

Date

Approved:

BACKFILL WORK ORDER ISSUED

DEPOSIT, \$ 10.00

SEWER WORK ORDER ISSUED

DATE 11-23-59 BY Scott M. Holton M/S
11/19/59 Dyer
Rec 5413 8-17-60 S.M.H. INS+CON
8-17-60 S.M.H. INS+CON
N.C.

APPLICATION
FOR

The City of Mountlake Terrace

SIDE SEWER PERMIT

OUTSIDE INSIDE REPAIRS

② ROGER L. KIRK

CARD No.

EASEMENT No.

135231ef

OWNER: ROGER L. KIRK

HOUSE NO. 23502 - 53W

CONTRACTOR

PERMIT NO. 843

STREET

AVENUE LOT NO. 53 WEST


15

BLOCK NO. 2

NAME ADD.

Dw 7

PROPERTY LINE

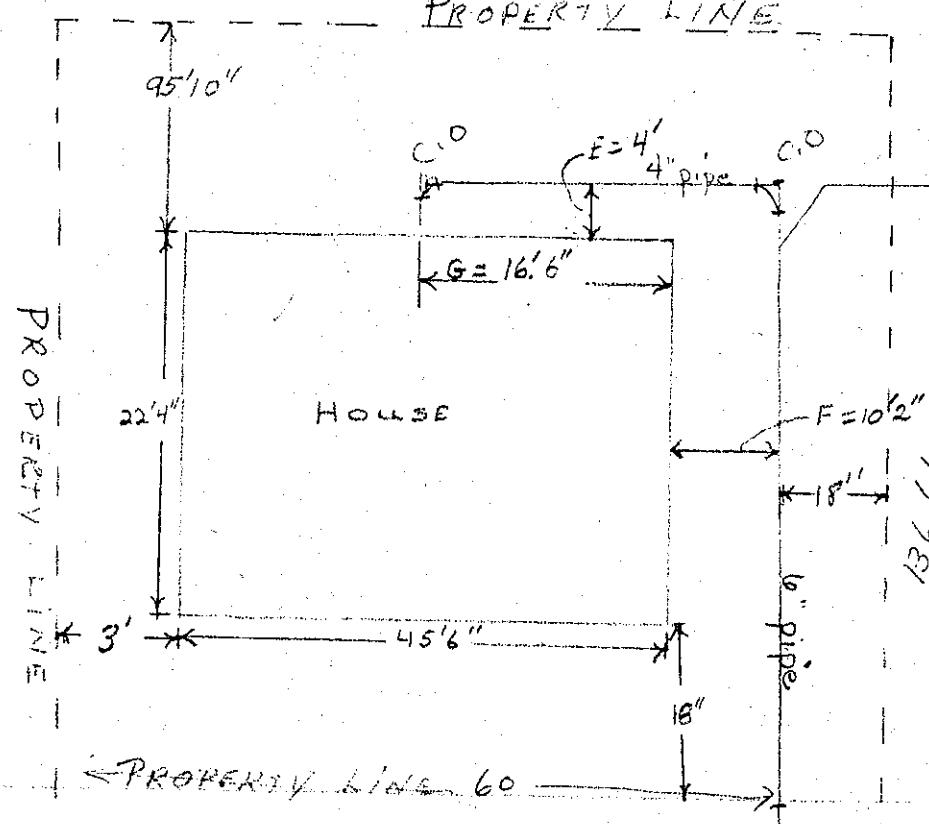CITY OF
MOUNTLAKE TERRACE

SEP 15 1959

Plan Approved

Date

Approved:

BACKFILL WORK ORDER ISSUED

DEPOSIT, \$10 ⁰⁰

9-15-59

SEWER WORK ORDER ISSUED

4901 DATE

9/14/59

BY

Vellman & Sons Inc.
8-18-60 INS+COK S.M.H.

APPL. UON

JOHN JACOBSON

CARD No.

The City of Mountlake Terrace

SIDE SEWER PERMIT

OUTSIDE INSIDE REPAIRS


EASEMENT No. 1350203

OWNER John Jacobson
HOUSE No. 23503 - 53 10

CONTRACTOR Brand E 6304-222 M.L.T. PERMIT No. 869

STREET AVENUE LOT No. 7 - DIV 7 BLOCK No. 3

NAME ADD.

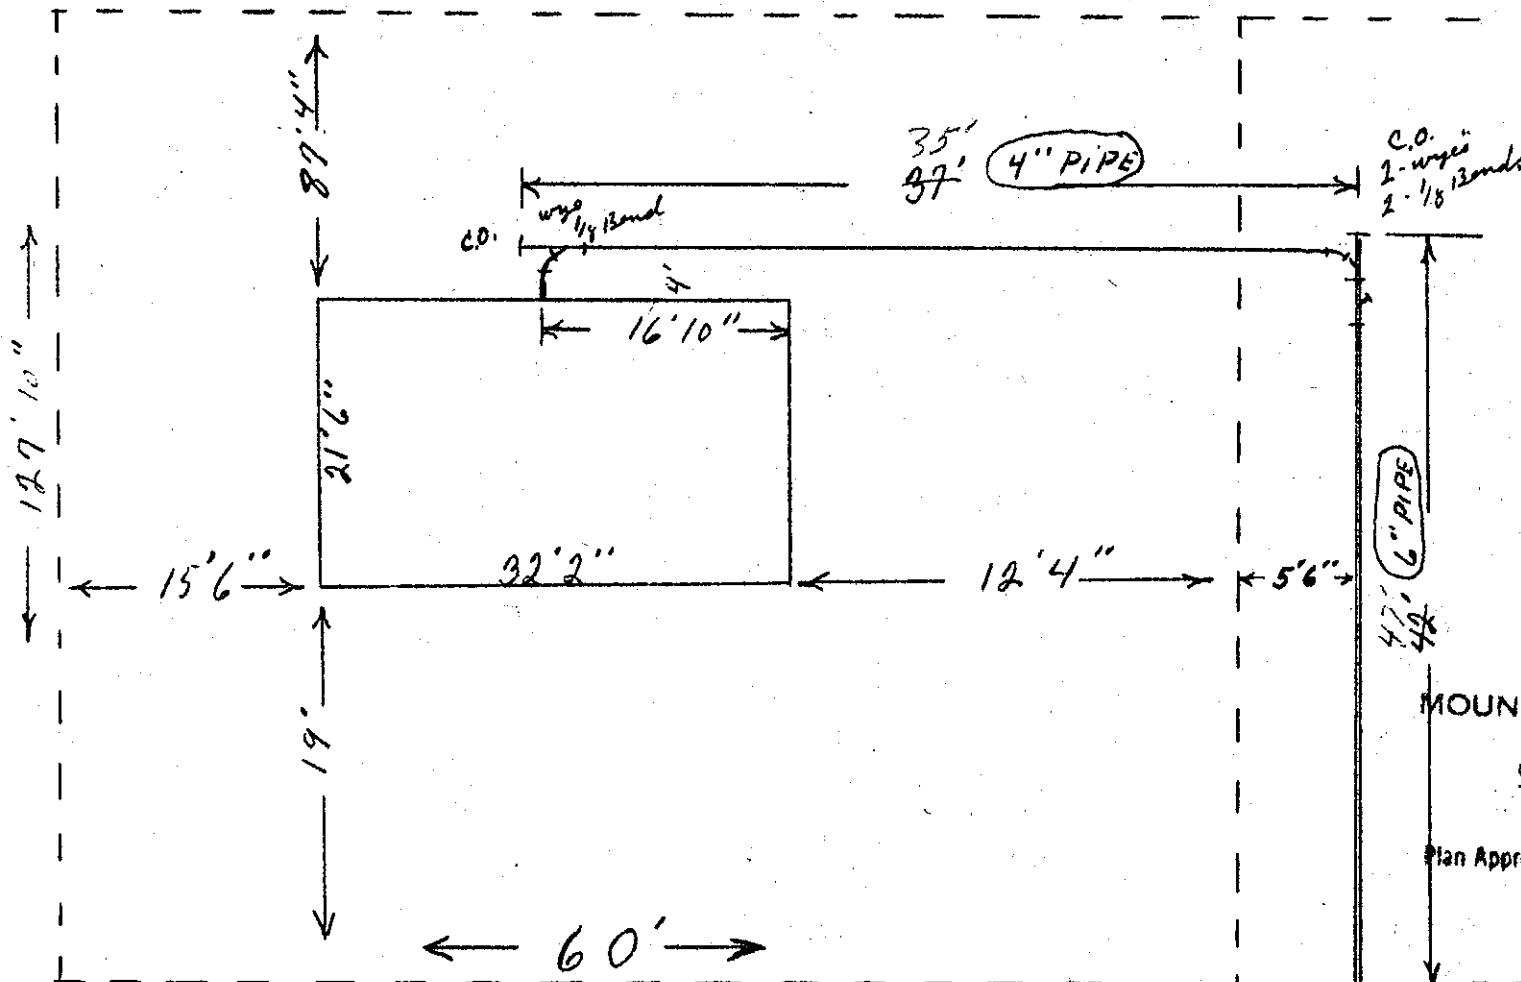

CITY OF
MOUNTLAKE TERRACE

SEP 22 1959

Plan Approved

J. Failes

Date

DEPOSIT, \$10.00

Approved:

BACKFILL WORK ORDER ISSUED
SEWER WORK ORDER ISSUED

DATE 9-22-59 BY Scott M Holton INS.
4737 2-2-60 INST CON Sm H. N.C.

APPLICATION

The City of Mountlake Terrace

CARD No.

SIDE SEWER PERMIT

OUTSIDE INSIDE REPAIRS

EASEMENT No. 1356288

OWNER RICHARD V. RAVENHORST

HOUSE No. 23504 - 53RD WEST

CONTRACTOR

none

PERMIT No.

820

STREET

AVENUE LOT No.

14

BLOCK No.


2

NAME ADD.

7

LOT LINE

135.59

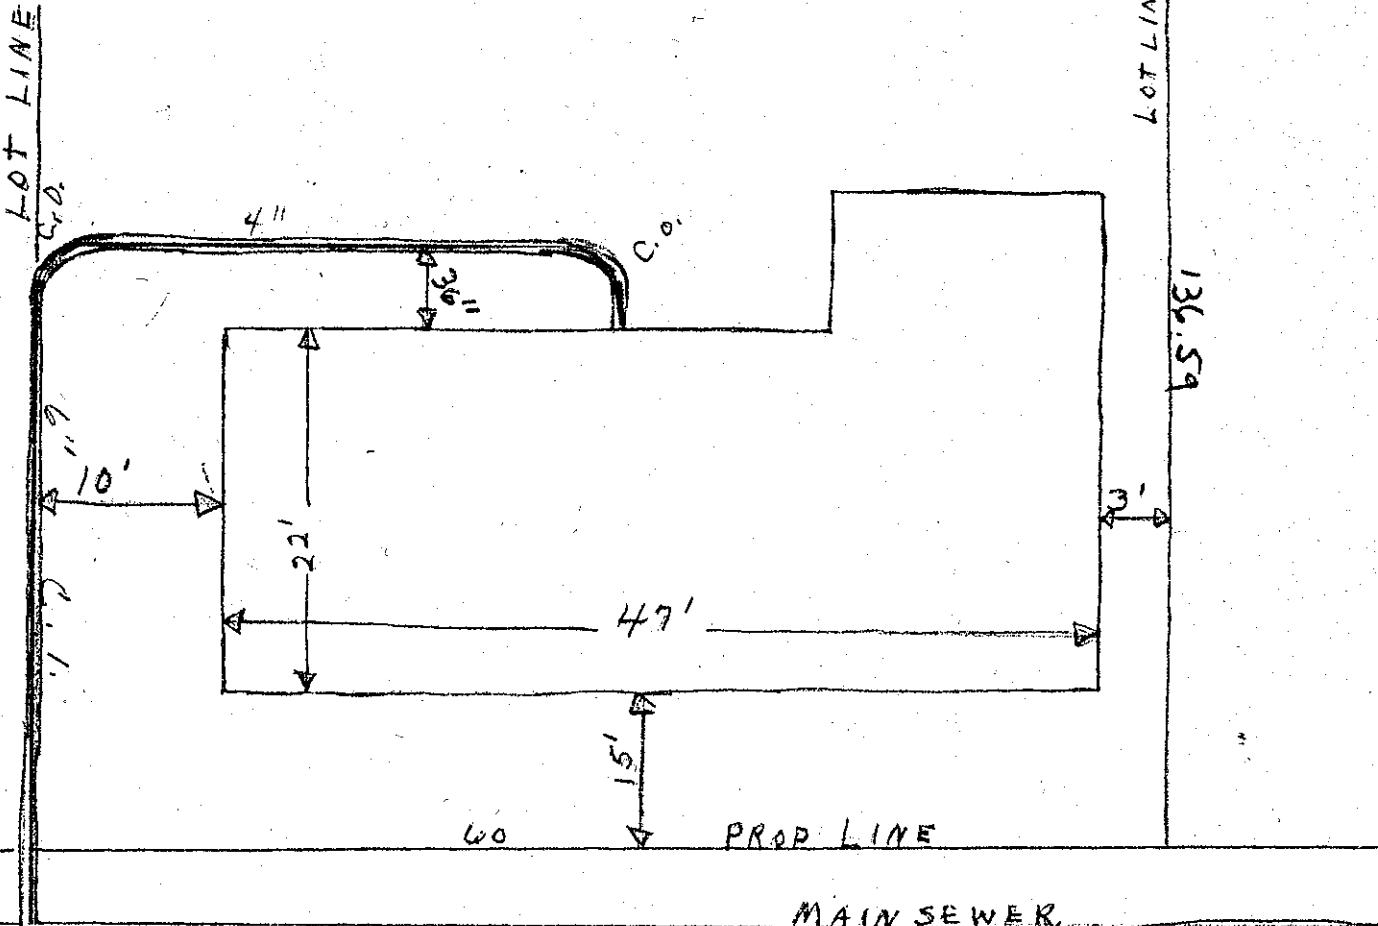

Date

BACKFILL WORK ORDER ISSUED

SEWER WORK ORDER ISSUED

DEPOSIT, \$10~~00~~

9-10-59

Approved:

#4473 DATE 4/4/60

BY

J. Morris, Inspector
Com

APPLICATION

SIDE SEWER PERMIT

The City of Mountlake Terrace

OUTSIDE INSIDE REPAIRS


CARD No.

EASEMENT No. 1350203

OWNER E. J. Shoemaker
HOUSE No. 23505-53^wCONTRACTOR B. and E. Const. 6304-222^s M.L.T. PERMIT No. 870

STREET AVENUE LOT No. S DIV. 7 BLOCK No. 3

NAME ADD.

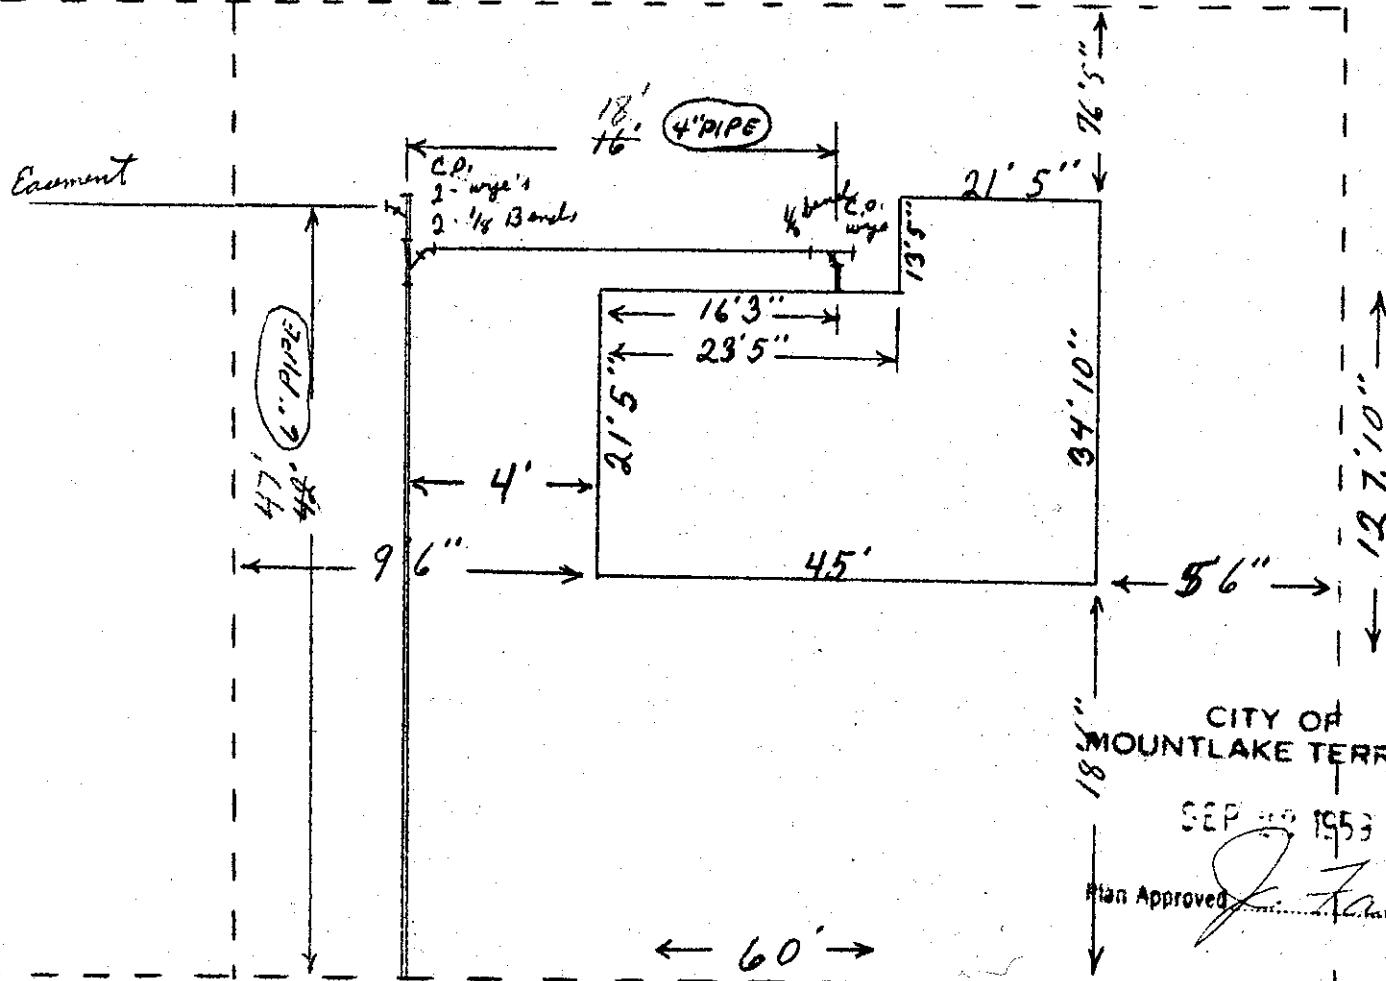

Date

Approved:

BACKFILL WORK ORDER ISSUED

DEPOSIT, \$ 10⁰⁰

SEWER WORK ORDER ISSUED

9/22/59

DATE

9-22-59 BY Scott M Holton IWS

#4937

2-2-60 INST CON SMAH

N.C.

The City of Mountlake Terrace

APPLICATION

SIDE SEWER PERMIT

OUTSIDE INSIDE REPAIRS

TIM PEREG
CARD No.

EASEMENT No. 1356288

OWNER Tim Dereg

CONTRACTOR

Self

PERMIT No.

HOUSE NO. 23506-53rd West MT STREET

STREET


AVENUE LOT No. 13

2

BLOCK No.

NAME ADD.

Property line

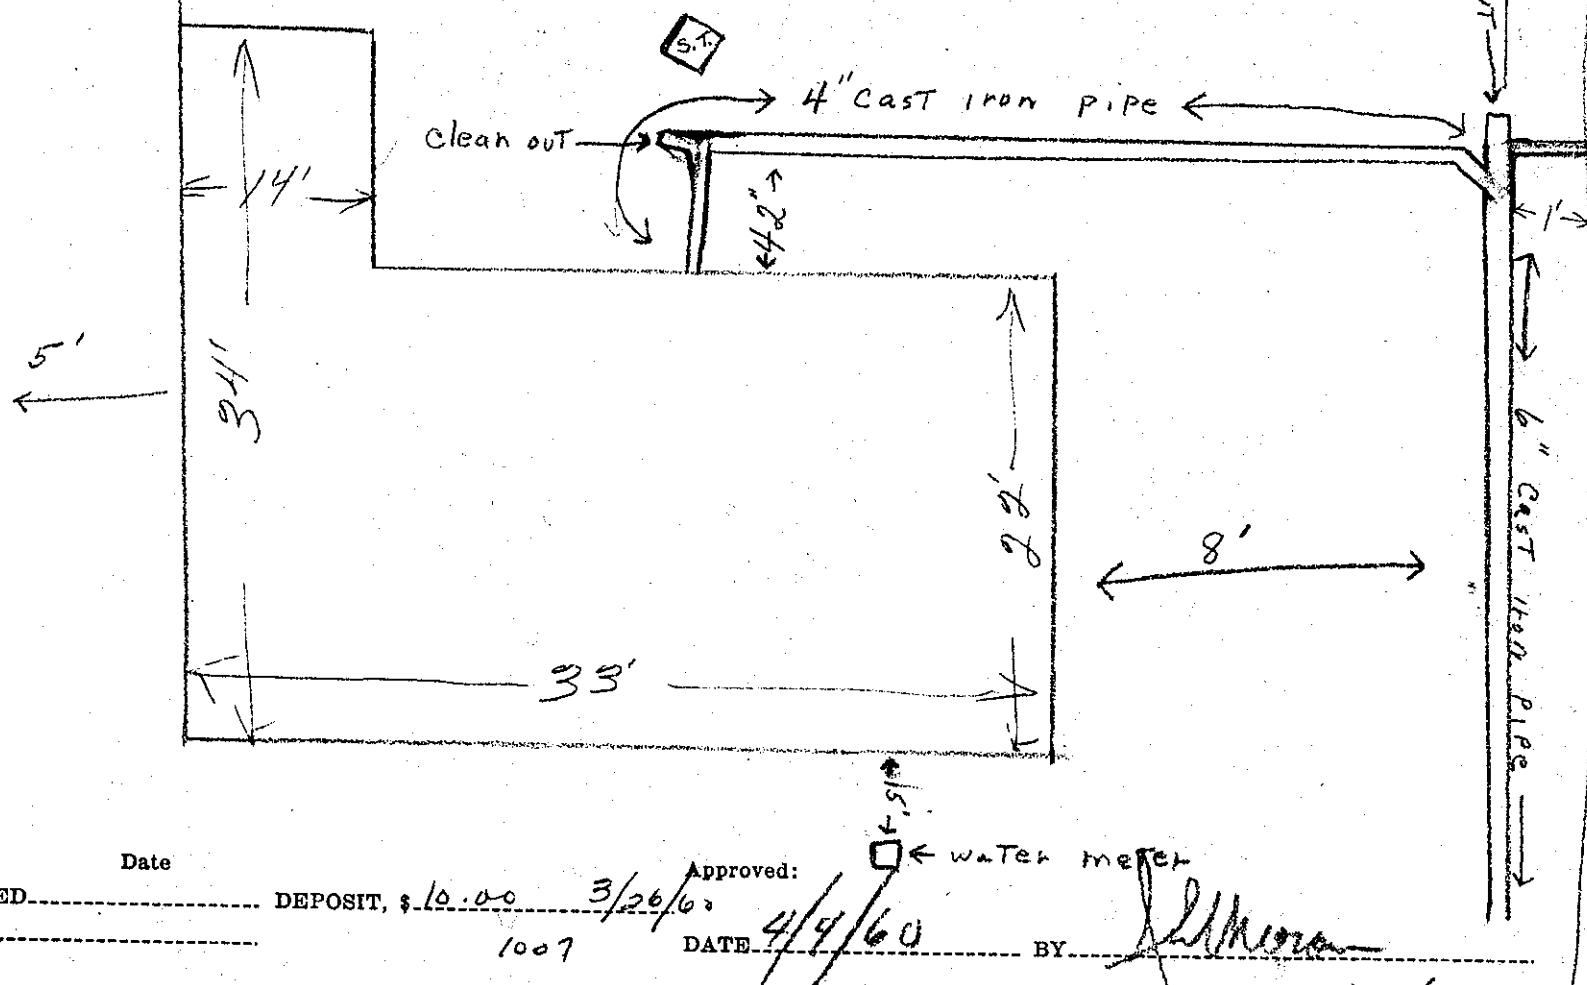

Date

BACKFILL WORK ORDER ISSUED
SEWER WORK ORDER ISSUED

DEPOSIT, \$10.00

3/26/60

Approved:

1007

DATE 4/4/60

BY

Self

msb + com

APPLICATION

The City of Mountlake Terrace

CARD No.

SIDE SEWER PERMIT


OUTSIDE INSIDE REPAIRS

EASEMENT No. 1350739

OWNER *C. J. Salaliss*CONTRACTOR *Gordon E. Bartlett, Inc.* PERMIT NO. 1193

HOUSE NO. 23507 53 W.

STREET AVENUE LOT NO. 9 BLOCK NO. 3

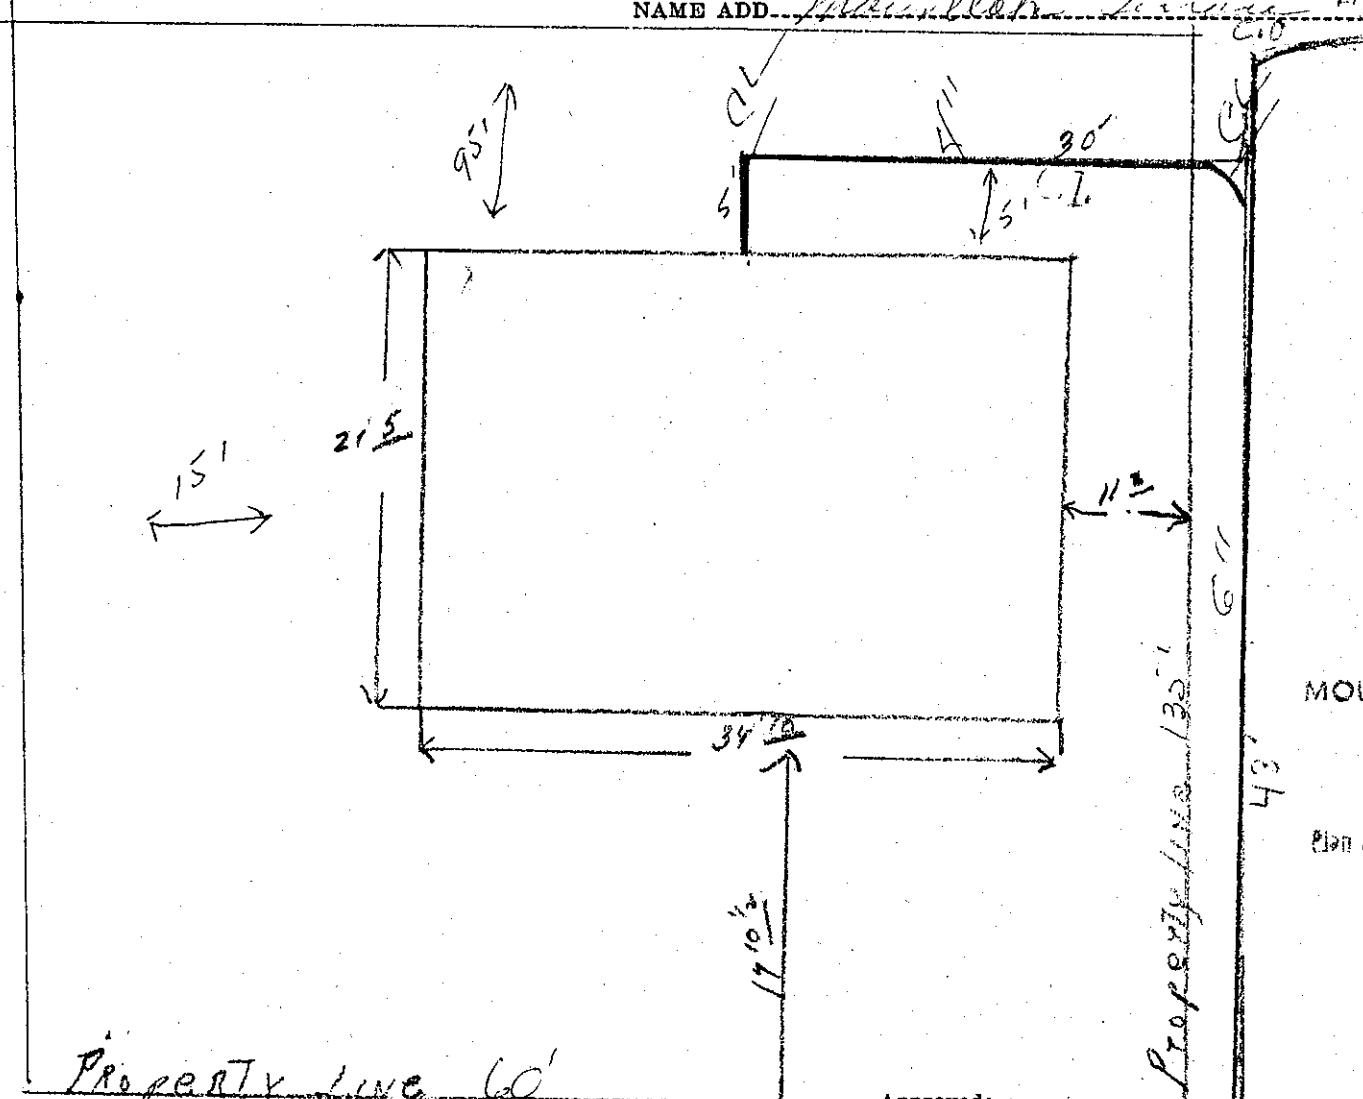NAME ADD. *Mountlake Terrace 117*CITY OF
MOUNTLAKE TERRACE

NOV 20 1959

Plan Approved.

J. Fidler SMY

BACKFILL WORK ORDER ISSUED

DEPOSIT, \$ 10.00

Approved:

Rec. 5416 DATE 11-23-59

SEWER WORK ORDER ISSUED

11/19/59 Deposit

BY

Scott M Holton 115 N.C.

The City of Mountlake Terrace

APPLICATION

SIDE SEWER PERMIT

OUTSIDE INSIDE REPAIRS

CARD No.

EASEMENT No.

August Klemmager

OWNER August Klemmager

HOUSE No. 23508 53 W


CONTRACTOR L.O. FRANKLIN

STREET AVENUE LOT No. 12

NAME ADD. 211 7

PERMIT NO. 1048

BLOCK No. 21

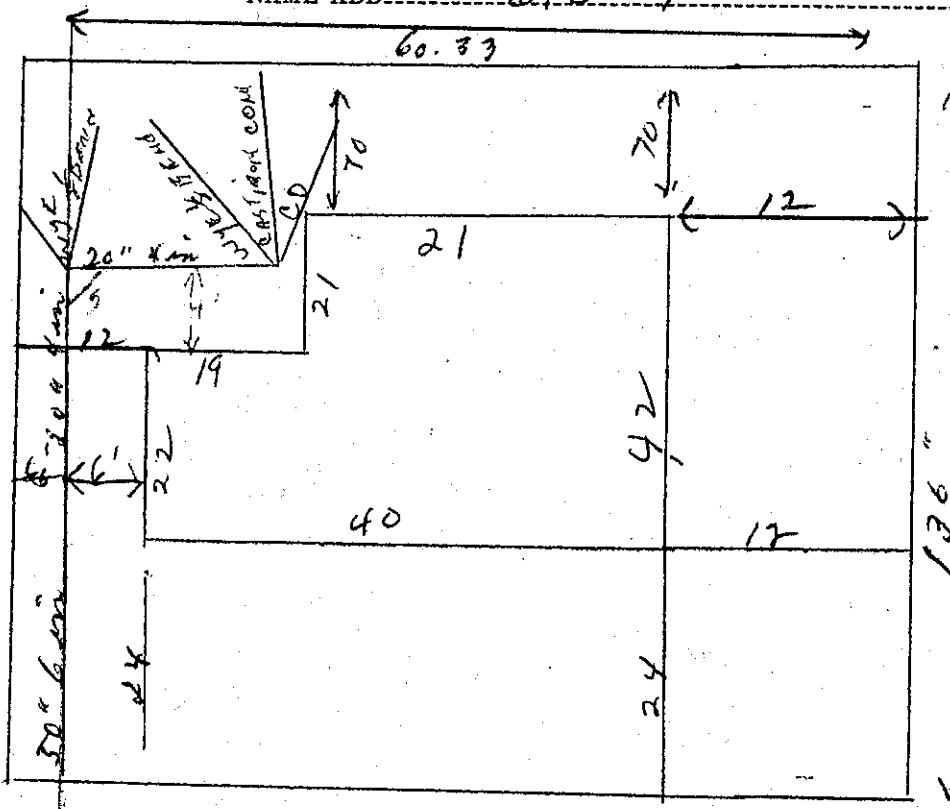

CITY OF
MOUNTLAKE TERRACE

NOV 2 1959

Plan Approved

J. Z. [Signature]
S. M. H.

53 W

N

Date

DEPOSIT, \$ 10.00

Approved:

BACKFILL WORK ORDER ISSUED
SEWER WORK ORDER ISSUED

10/29/59

DATE

11-2-59 Scott M Holton INS
Rec. 5265 - August 1-18-60 INS CON S.M.H. N.C.

The City of Mountlake Terrace

APPLICATION

SIDE SEWER PERMIT

OUTSIDE INSIDE REPAIRS

Christ KNUDSEN

CARD No.

EASEMENT No.

OWNER Christ KNUDSEN
HOUSE No. 2360 1/2 53rd Ave S

CONTRACTOR

STREET


AVENUE LOT No. 1

PERMIT No. 2506

BLOCK No.

NAME ADD.

KNUDSEN 1/2 53rd

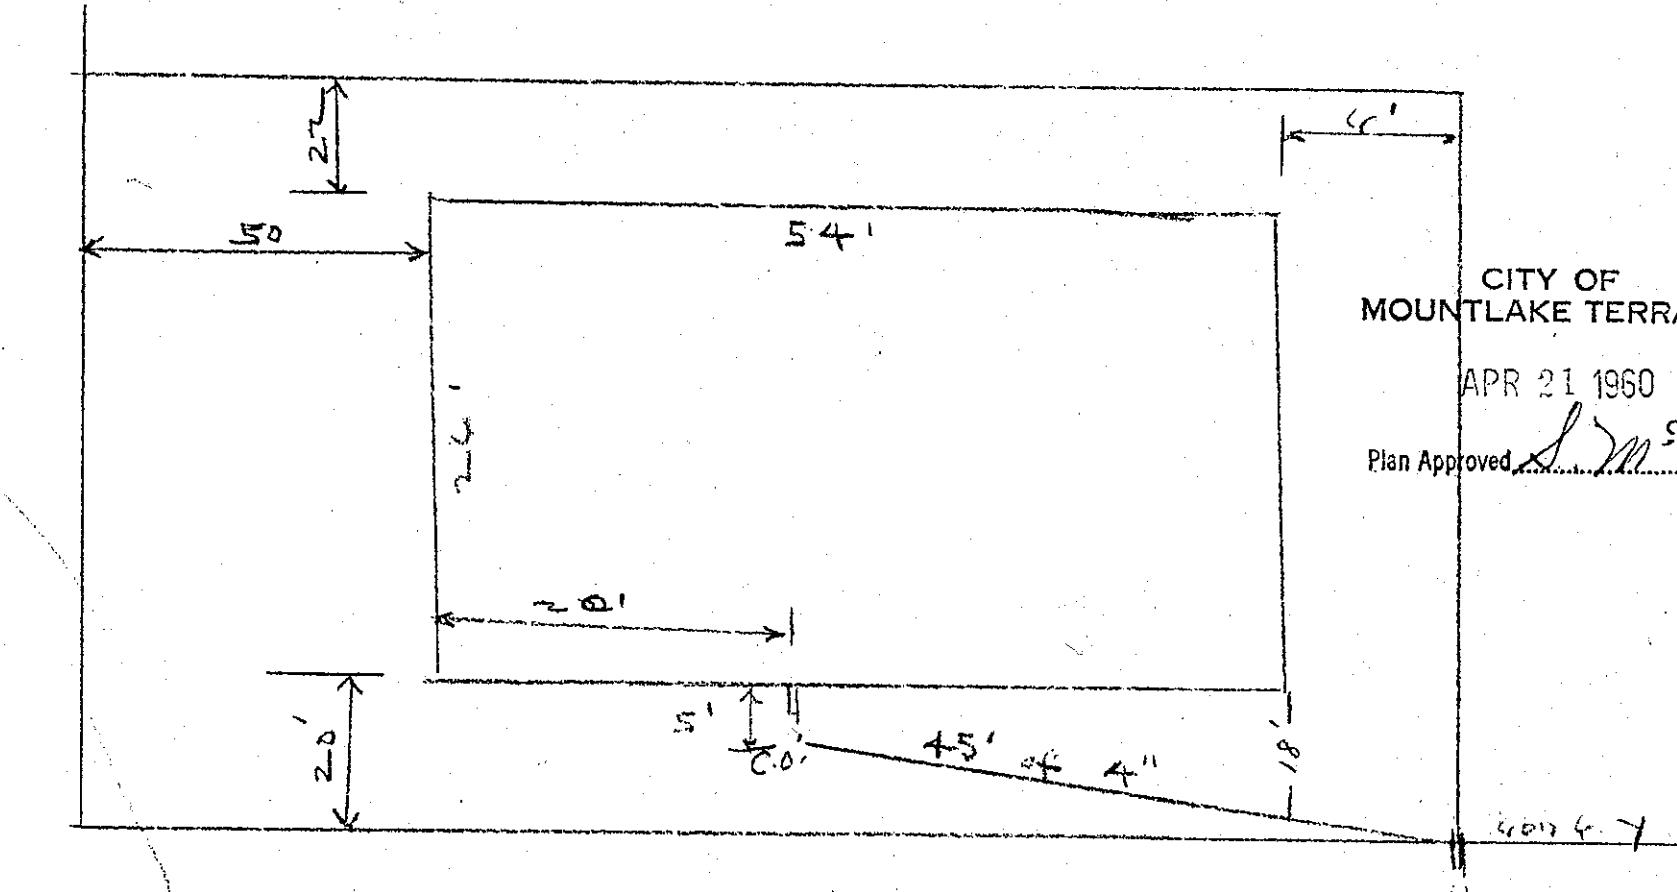

Date

Approved:

BACKFILL WORK ORDER ISSUED

DEPOSIT, \$10.00 4/20/60

SEWER WORK ORDER ISSUED

1294

DATE 4-21-60

BY Sam Holton WSTCov

APPLICATION

SIDE SEWER PERMIT

The City of Mountlake Terrace

CARD No. 5362

OUTSIDE INSIDE REPAIRS

EASEMENT No.

OWNER Kris Knudsen
HOUSE No. 23603 - 53rd


CONTRACTOR

PERMIT No.

STREET
AVENUE LOT No.

BLOCK No.

NAME ADD.

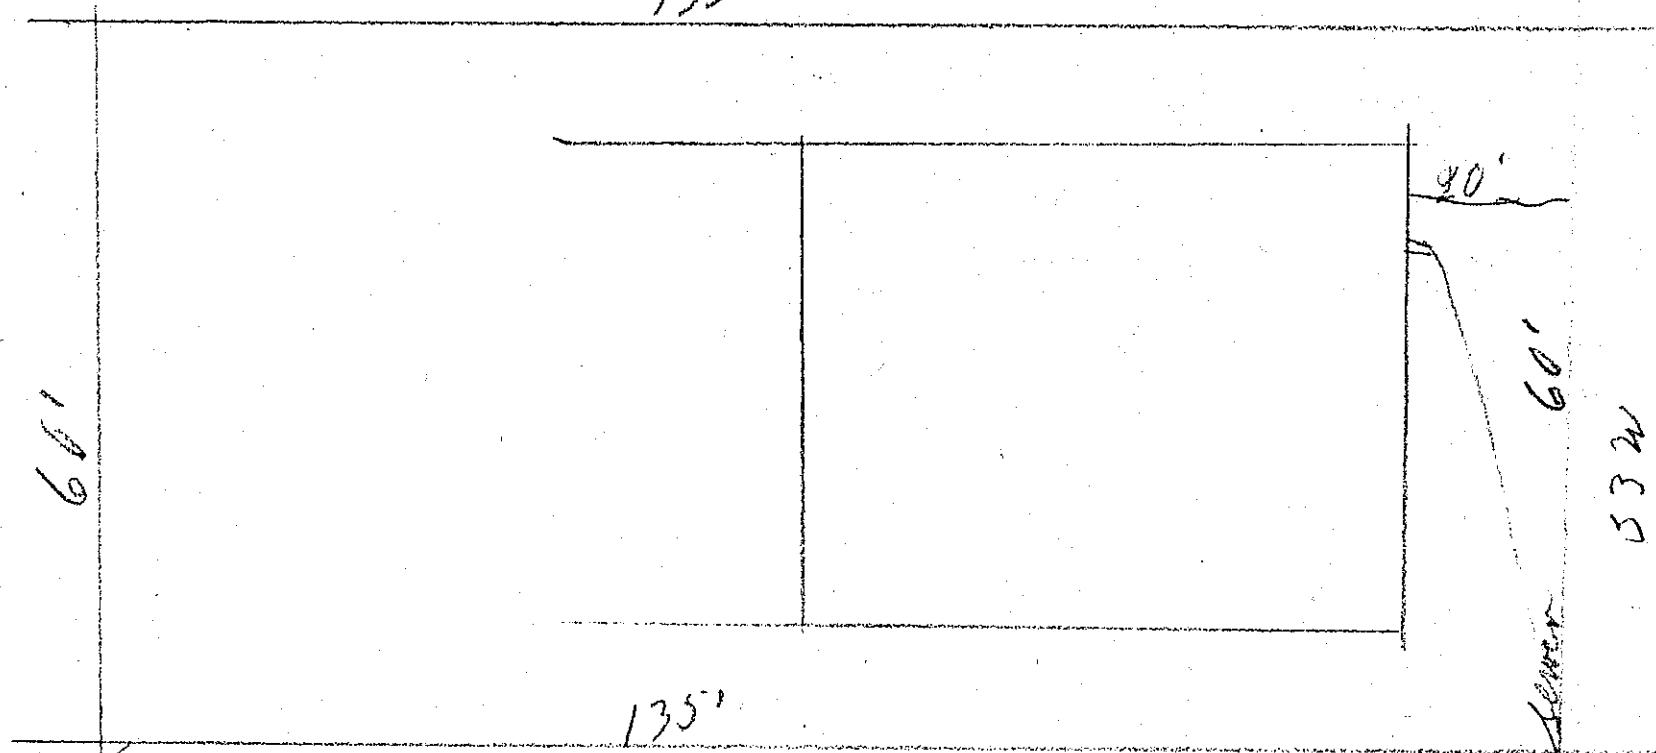

Date

Approved:

BACKFILL WORK ORDER ISSUED

DEPOSIT, \$

SEWER WORK ORDER ISSUED

DATE 5-5-64

BY

F. J. Baker

The City of Mountlake Terrace

APPLICATION
FOR

SIDE SEWER PERMIT

OUTSIDE INSIDE REPAIRS

W.M. Davis
CARD No.

EASEMENT No. None

OWNER Wm. H. Davis

HOUSE NO. 23604 - 53rd W

CONTRACTOR Wingfield - Brown


PERMIT No. 1135

STREET
AVENUE LOT No.

#10

Div. #8
BLOCK No.

NAME ADD.

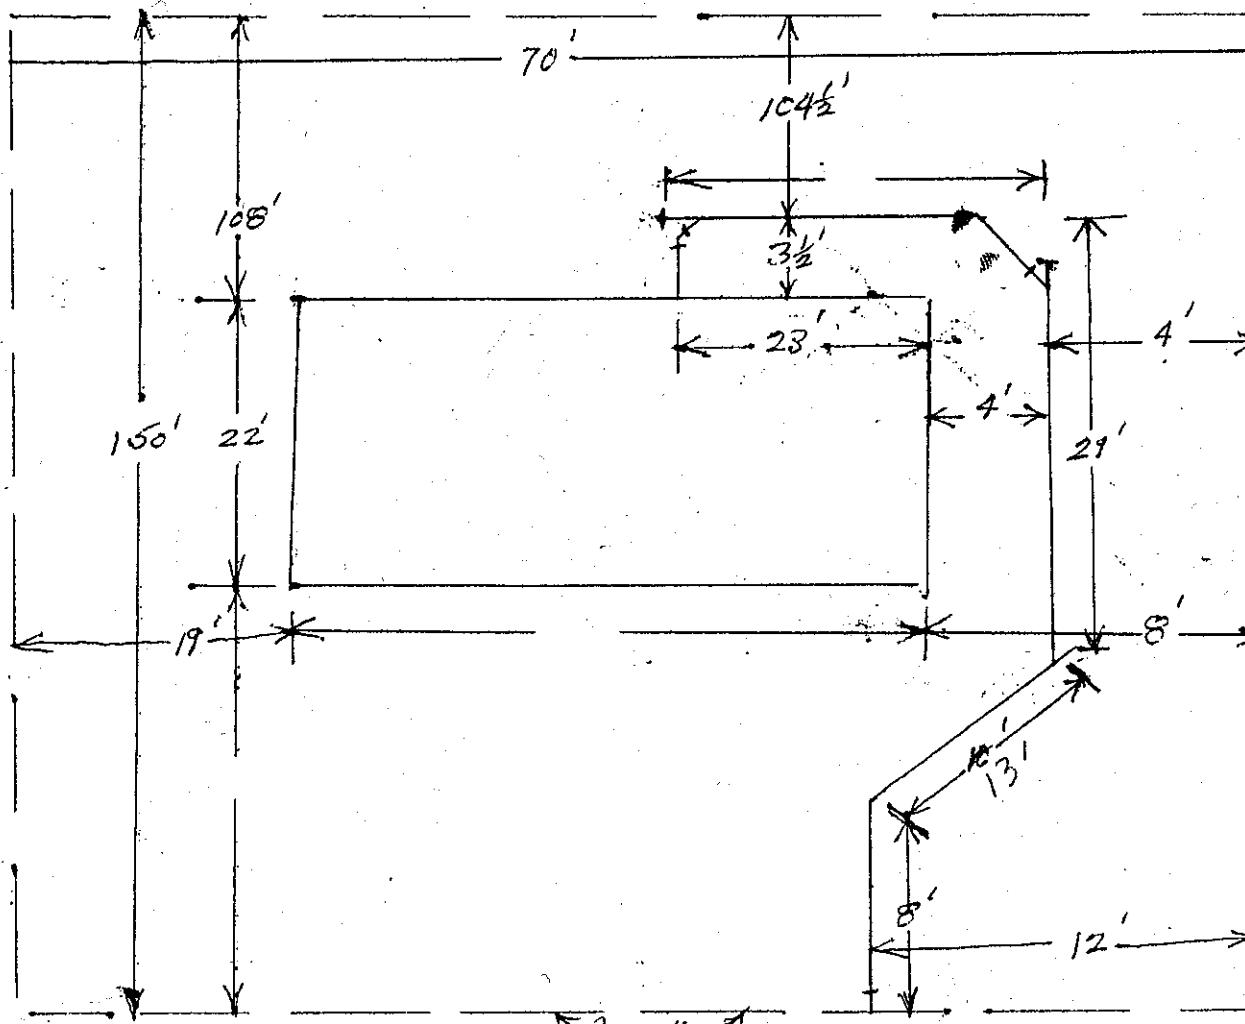

CITY OF
MOUNTLAKE TERRACE

NOV 17 1959

Plan Approved

J. Fairley
M.H.

Date

Approved:

BACKFILL WORK ORDER ISSUED

DEPOSIT, \$10.00

11-12-59


SEWER WORK ORDER ISSUED

5358

DATE 11-13-59 BY

Scott M Holton
1-8-60 INS+CON J.M.H.

53RD AVE W

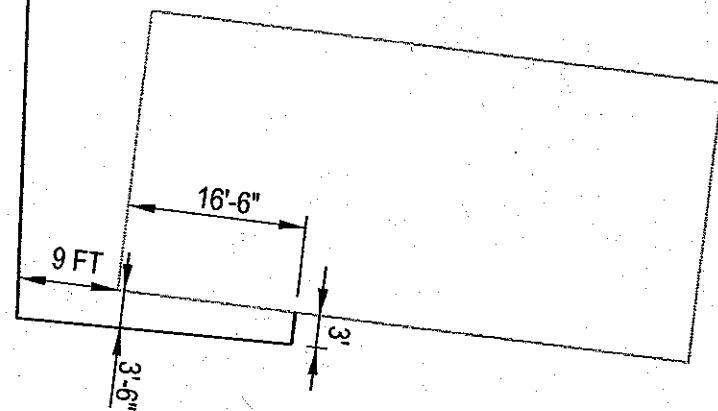

CITY OF MOUNTLAKE TERRACE
DEPARTMENT OF COMMUNITY DEVELOPMENT

Side Sewer As-Built
23801 53rd Ave W
U -

revision date
Dec 2002

APPLICATION

H. L. Br J 985

CARD No.


The City of Mountlake Terrace

SIDE SEWER PERMIT

OUTSIDE INSIDE REPAIRS

EASEMENT No.....

OWNER..... Harry L. Bridges .. CONTRACTOR..... Self .. PERMIT No..... 2094
 HOUSE No..... 23802 - 5-3 W. STREET..... 20 ..
 AVENUE LOT No..... NAME ADD..... Replat of Land Tracts

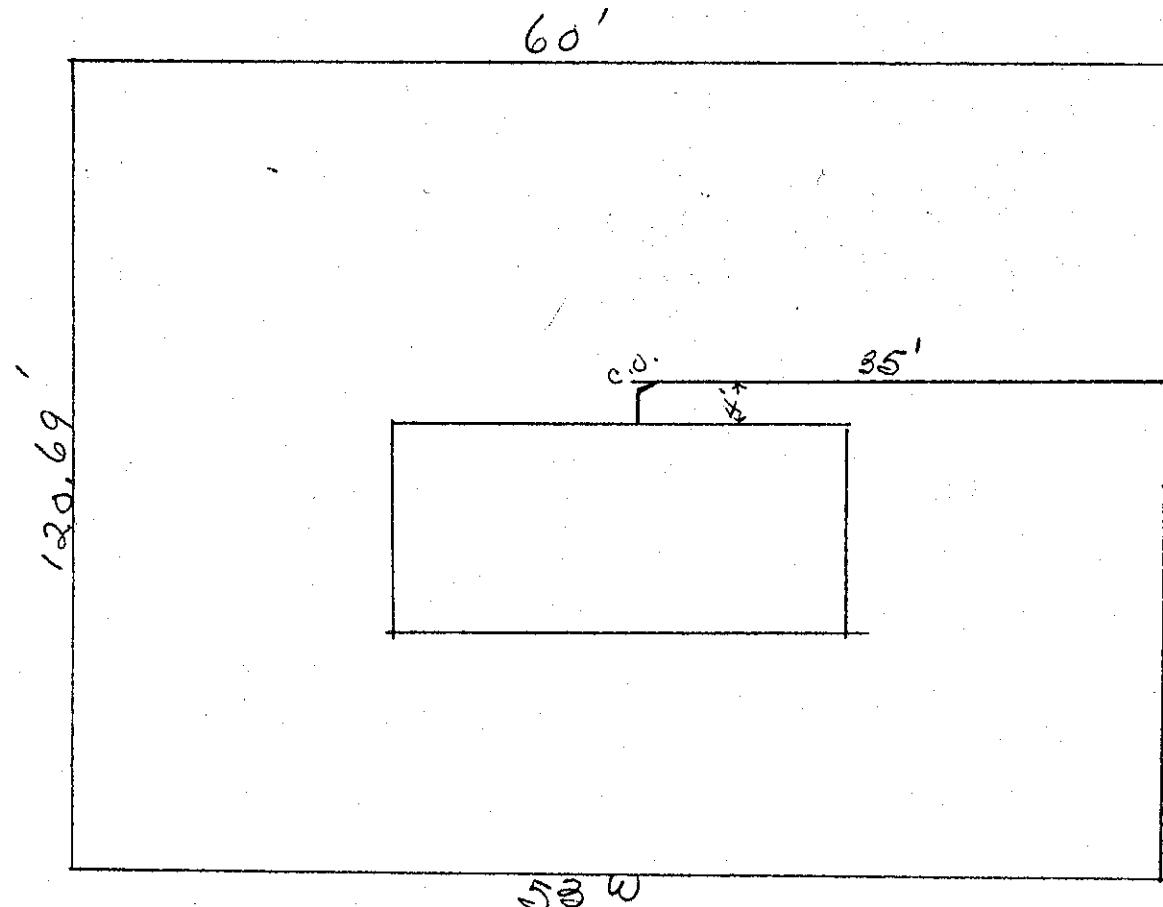21
22
23
24CITY OF
MOUNTLAKE TERRACE

MAR 29 1960

Plan Approved.....

BACKFILL WORK ORDER ISSUED.....
 SEWER WORK ORDER ISSUED.....

Date

DEPOSIT, \$10.00 3/21/60 Approved:
 928 3-30-60

DATE

BY

Scott M Holton/MS

APPLICATION

The City of Mountlake Terrace

CARD No.

SIDE SEWER PERMIT

OUTSIDE INSIDE REPAIRS

EASEMENT No.

OWNER: JULIUS WECHTER

CONTRACTOR: A.D. Johnson Const Co.

PERMIT No. 2016

HOUSE No. 23804

53 W

STREET
AVENUE LOT No.



19

BLOCK No.

NAME ADD.

Repeat of Job 9

60'

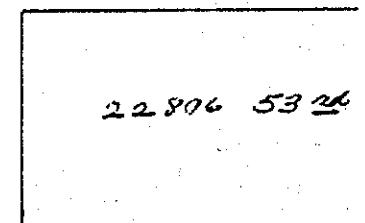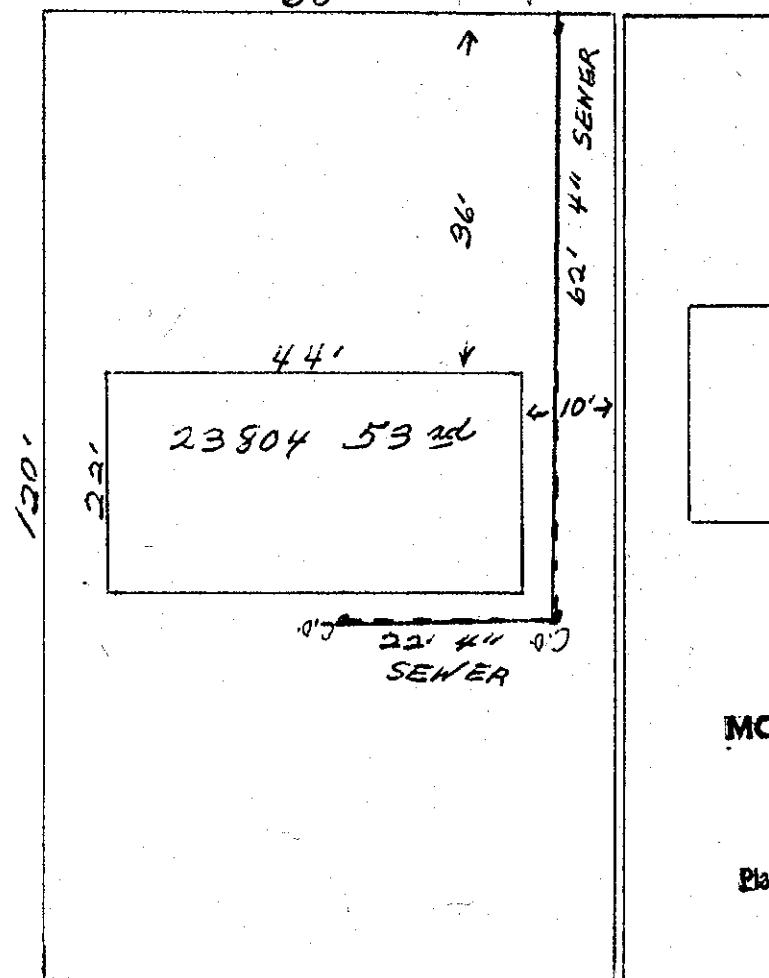CITY OF
MOUNTLAKE TERRACE

MAR 15 1960

Plan Approved

J. J. Jallner

Date

Approved:

BACKFILL WORK ORDER ISSUED

DEPOSIT, \$10 *100*

3-15-60

SEWER WORK ORDER ISSUED

864

DATE

3-15-60

BY

Scott M. Hilton INSTCO

The City of Mountlake Terrace

APPLICATION


Arthur Larson
CARD No.

SIDE SEWER PERMIT

OUTSIDE INSIDE REPAIRS

EASEMENT No. none

OWNER Arthur & Carol Y Larson CONTRACTOR owns PERMIT NO. 6
HOUSE NO. 23805 - 53rd Ave W. STREET 32
NAME ADD. Replat of Lind Tracts AVENUE LOT NO. 32 BLOCK NO. 2

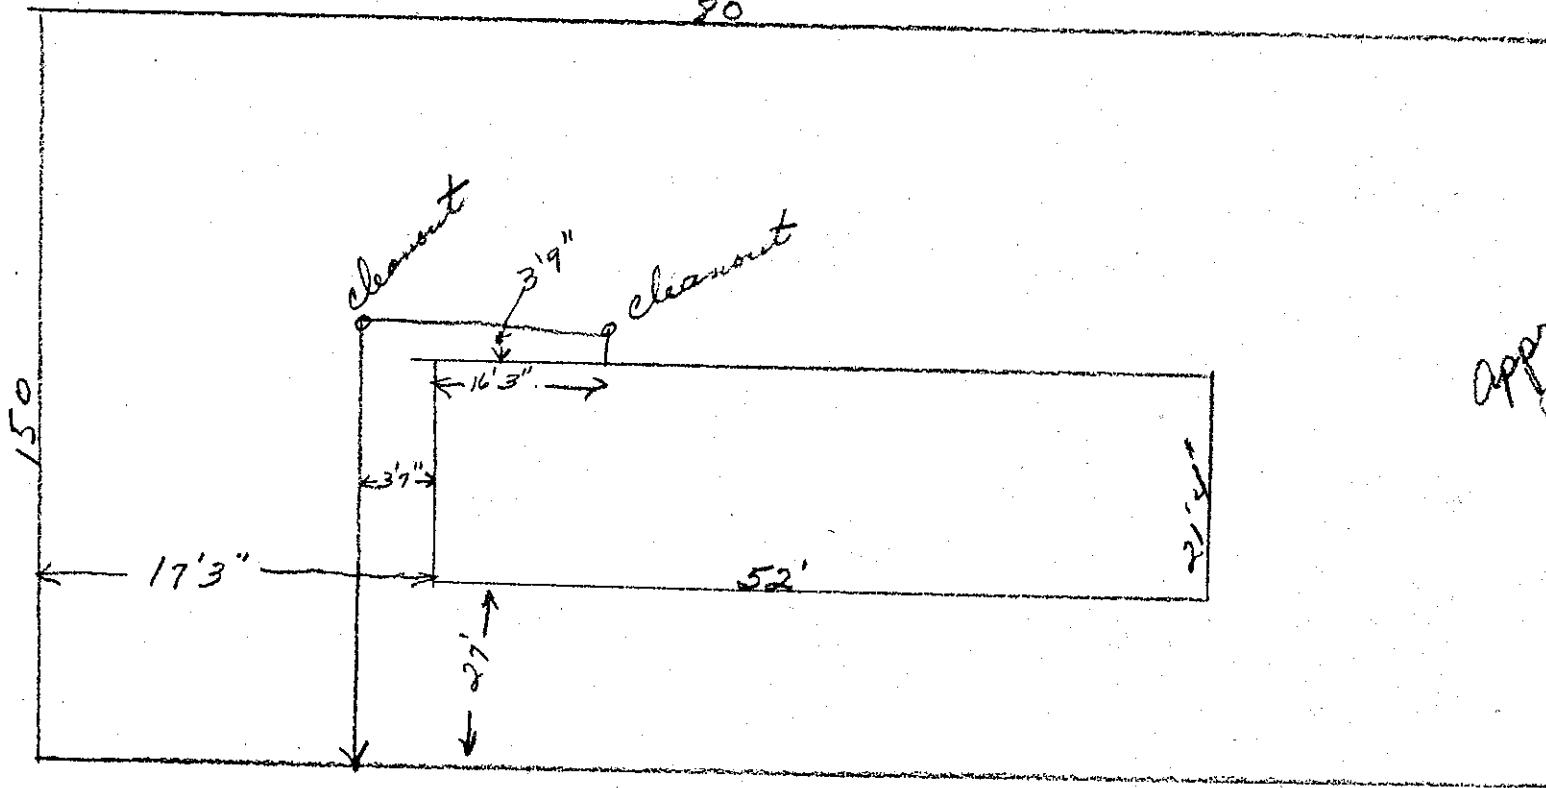

Date

BACKFILL WORK ORDER ISSUED

DEPOSIT, \$10⁰⁰

Approved:

SEWER WORK ORDER ISSUED

7-7-59
3750

DATE 2/1/60 BY J. Larson

APPLICATION

CARD No. (4)

The City of Mountlake Terrace

SIDE SEWER PERMIT

OUTSIDE INSIDE REPAIRS

EASEMENT No.

OWNER Clifton E. McHaffey
HOUSE No. 23506 53rd West

CONTRACTOR

STREET

AVENUE LOT No.

NAME ADD.

Clifton E. McHaffey


PERMIT No. 2187

18

BLOCK No.

REPLAT OF LIND TRACTS

STREET 53 W.

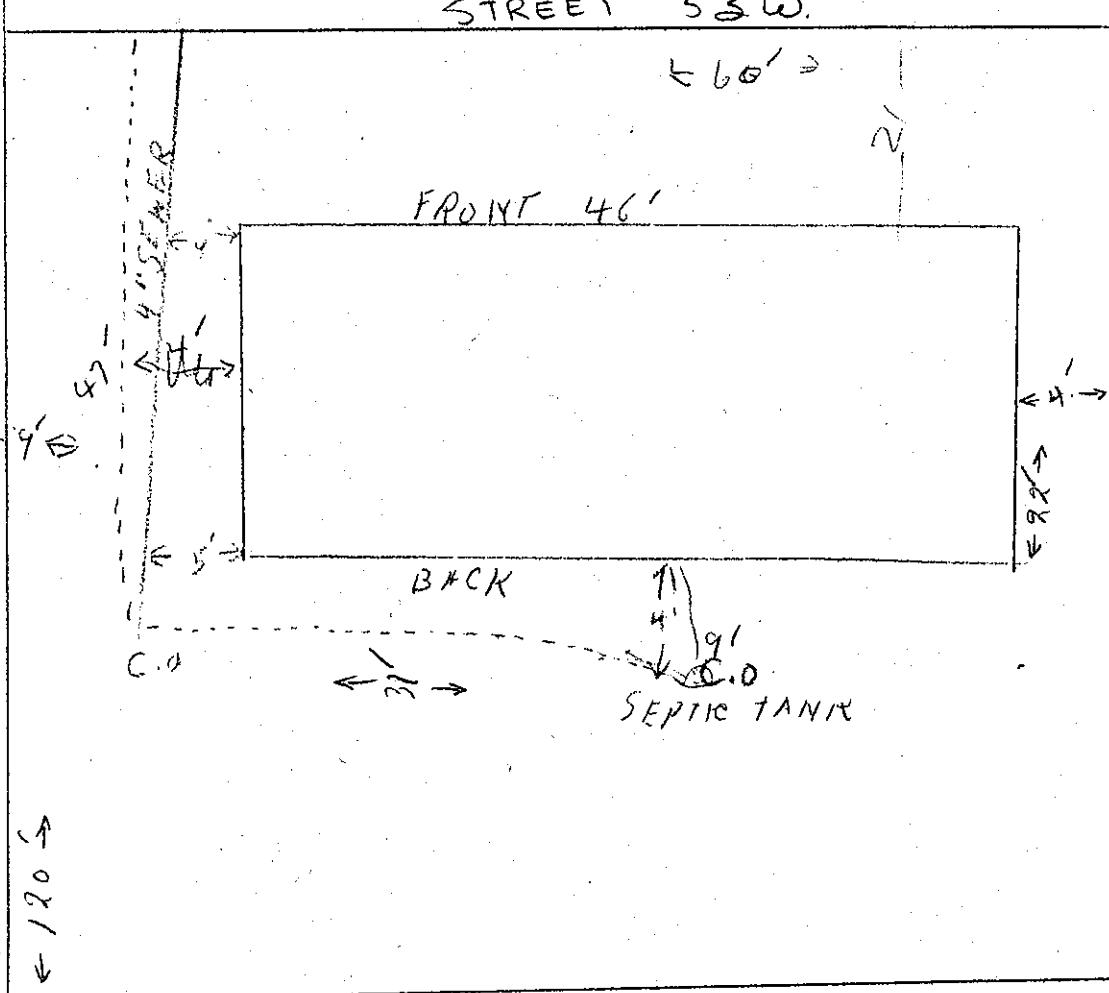

Date

Approved:

BACKFILL WORK ORDER ISSUED

DEPOSIT, \$10.00 3/25/60

SEWER WORK ORDER ISSUED

1001

DATE

9-21-66

BY

J. M. Holton INS+CON

APPLICATION

SIDE SEWER PERMIT


The City of Mountlake Terrace

OUTSIDE INSIDE REPAIRS

CARD No.

EASEMENT NO. None

OWNER Metropolitan Mortgage & Securities CONTRACTOR Wingfield - Brown PERMIT NO. 2659
 HOUSE NO 3803 - 53rd W.

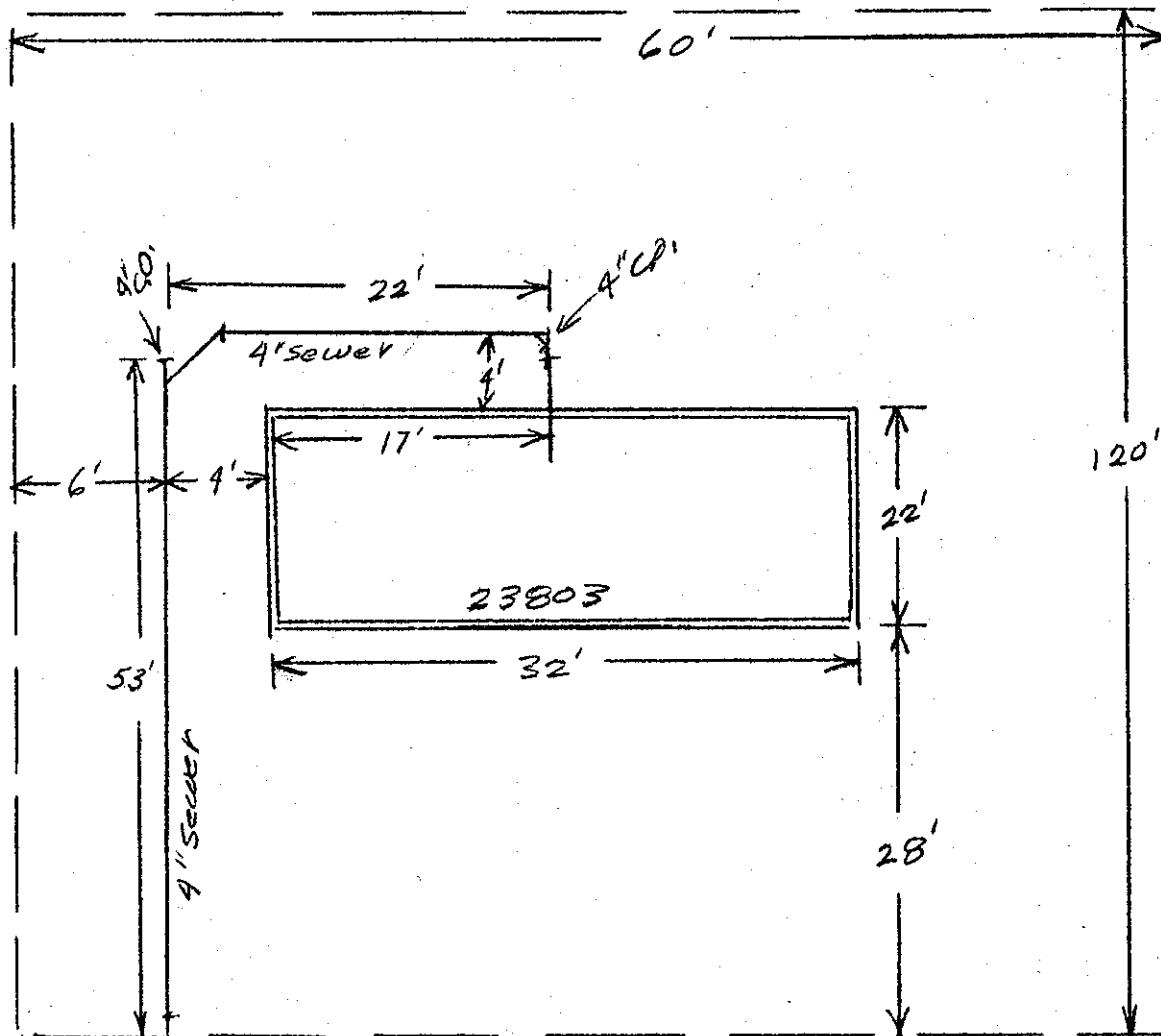STREET
AVENUE LOT No. 17BLOCK No. 2NAME ADD. Replat of Lin TractsCITY OF
MOUNTLAKE TERRACE

MAY 13 1960

Plan Approved,

S. M. Holton

BACKFILL WORK ORDER ISSUED

DEPOSIT, \$10.00

Approved:

SEWER WORK ORDER ISSUED

5/13/60

1442

DATE 5-13-60

BY

S. M. Holton INST CON

The City of Mountlake Terrace

APPLICATION

SIDE SEWER PERMIT

OUTSIDE INSIDE REPAIRS

MARGARET Fuhrmann
CARD No.

EASEMENT No. None

OWNER Margaret Fuhrmann
HOUSE No. 23810 53rd W.

CONTRACTOR Wingfield - Brown


STREET
AVENUE LOT No. 16

PERMIT No. 2377

BLOCK No. 2

NAME ADD.

Replat of Lin Tracts

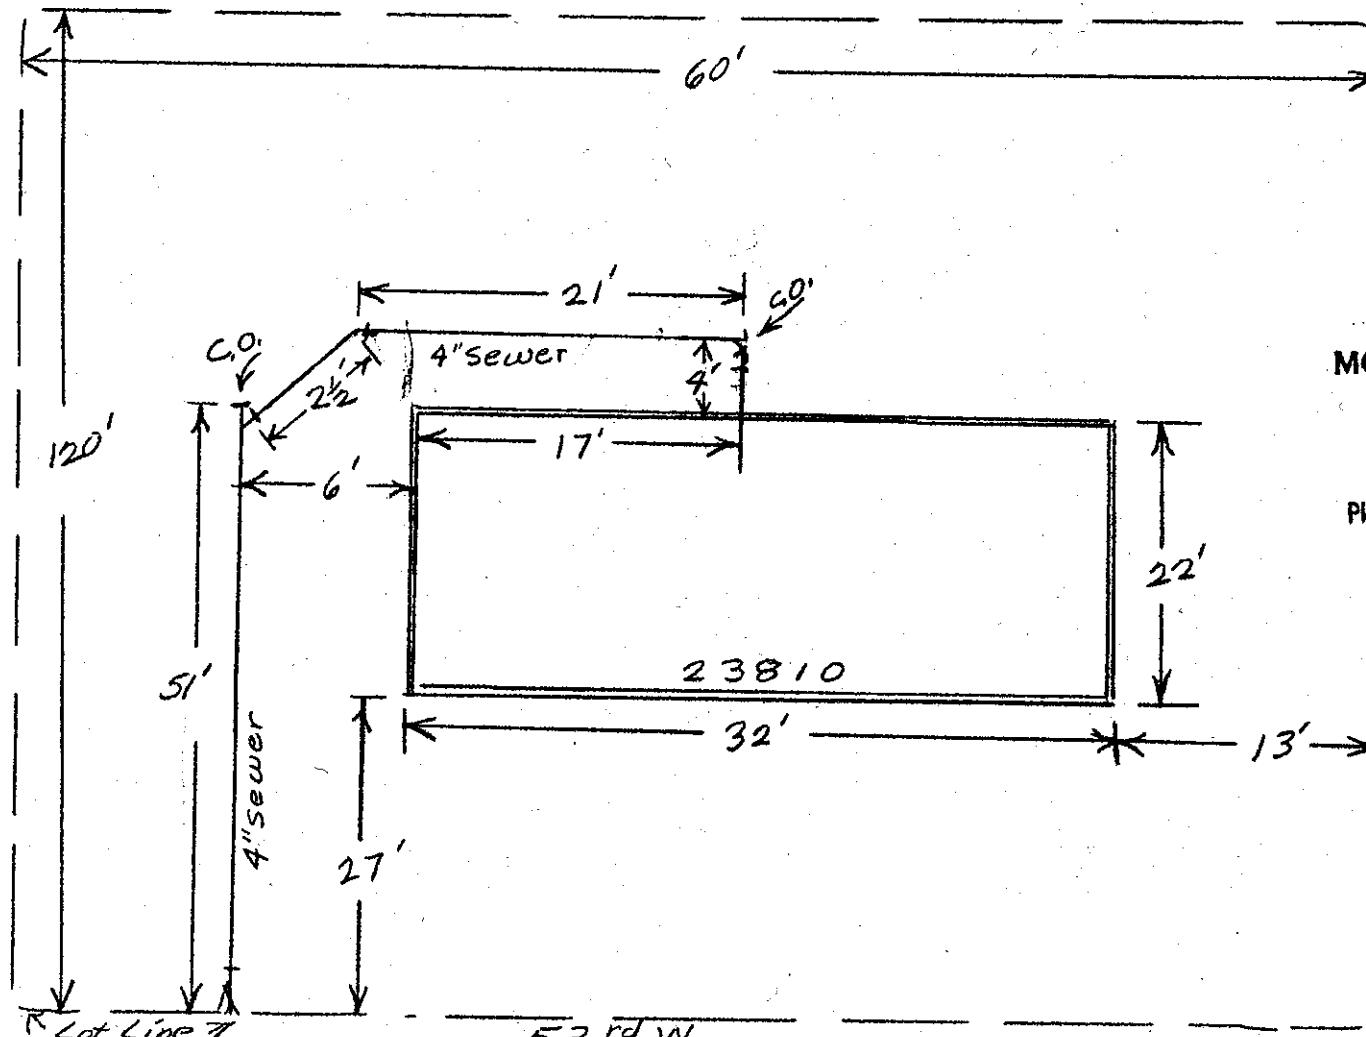

CITY OF
MOUNTLAKE TERRACE

APR 2 1960

Plan Approved

Date

53rd W.

Approved:

BACKFILL WORK ORDER ISSUED

DEPOSIT, \$10.00

4/4/60

SEWER WORK ORDER ISSUED

\$1160

DATE

4/4/60

BY

J. Fairless

APPLICATION

SIDE SEWER PERMIT

OUTSIDE INSIDE REPAIRS

JAMES A LITTLE

CARD No.

The City of Mountlake Terrace

EASEMENT No. 13 58239

OWNER JAMES A. LITTLE

HOUSE No. 23901 - 53 WEST


CONTRACTOR Self

STREET
AVENUE LOT No. 31

PERMIT No. 1429

BLOCK No. 2 LINE TRACKS

NAME ADD.

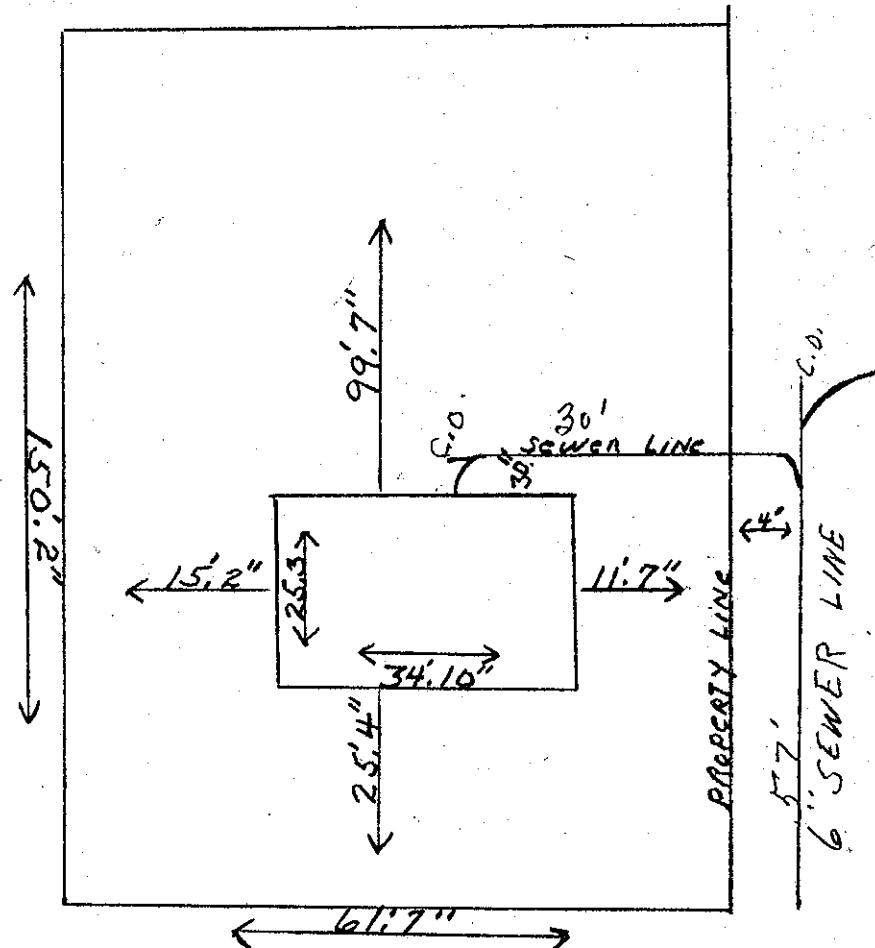

CITY OF
MOUNTLAKE TERRACE

FEB 17 1960

Plan Approved

Date

Approved:

BACKFILL WORK ORDER ISSUED

DEPOSIT, \$ 10.00

SEWER WORK ORDER ISSUED

5677

DATE 2-18-60

BY Scott M Holton INSTCov

1/4/60 Dyer

APPLICATION

The City of Mountlake Terrace

SIDE SEWER PERMIT

OUTSIDE INSIDE REPAIRS

CARD No.

B.H.U.Kay

EASEMENT No. None

OWNER Bobby H. McKay
HOUSE No. 23902-53 rd W.

CONTRACTOR Wingfield - Brown


STREET AVENUE LOT No. 15

PERMIT No. 2603

NAME ADD.

BLOCK No. 2

Plot of Lind Tracts

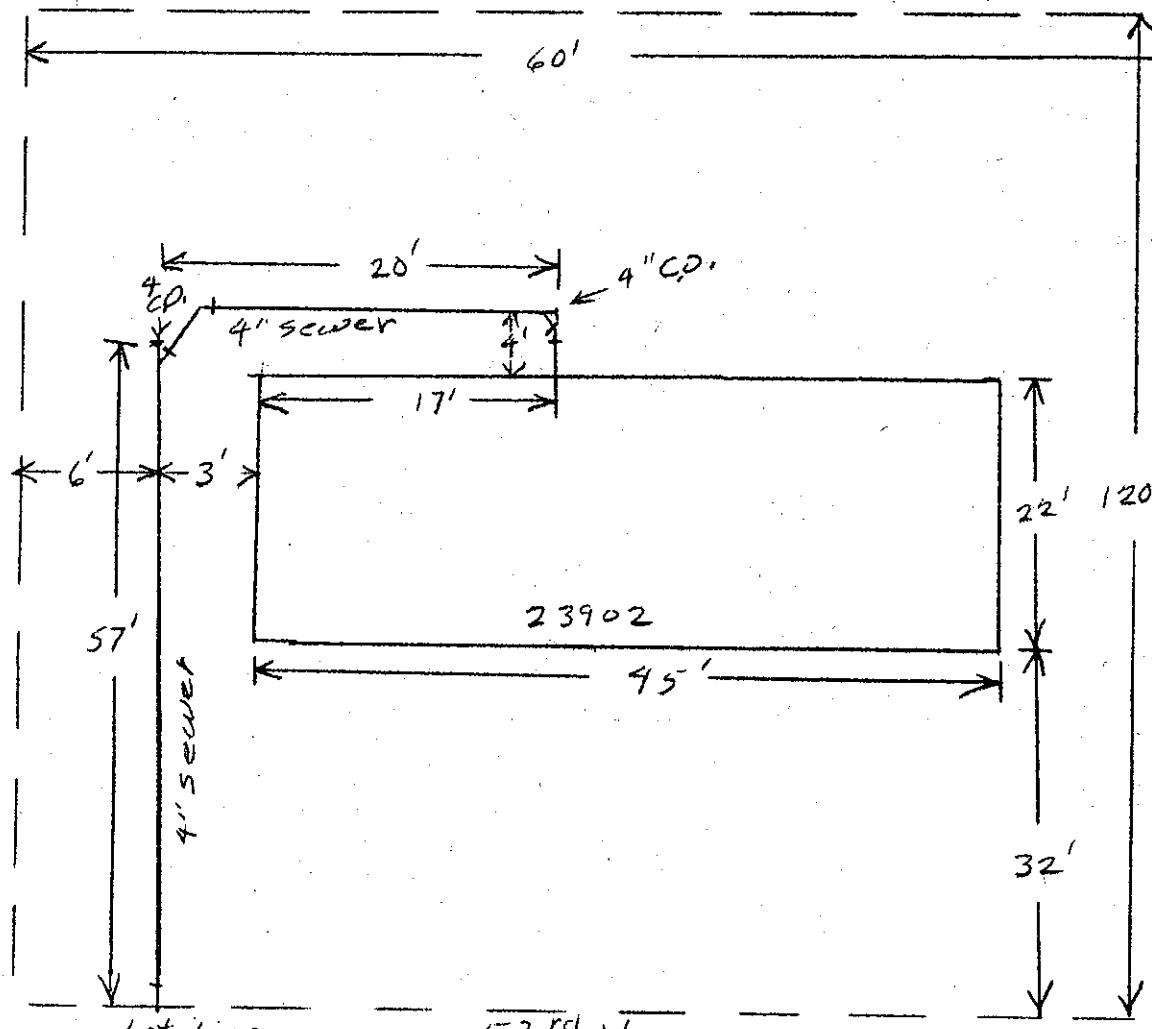

CITY OF MOUNTLAKE TERRACE

MAY 5 1960

Plan Approved

S. McAllee

BACKFILL WORK ORDER ISSUED

SEWER WORK ORDER ISSUED

DEPOSIT, \$10.00

5/4/60

Approved:

1378

DATE 5-5-60

BY S. M. Holtz 105-608

APPLI CATION

The City of Mountlake Terrace

CARD No.

SIDE SEWER PERMIT

OUTSIDE INSIDE REPAIRS

EASEMENT No. 1358239

OWNER DONALD A. WHEELER

CONTRACTOR *Leif*


HOUSE No. 23903 - 53 WEST

STREET
AVENUE LOT No. 30

PERMIT No. 1422

BLOCK No. 2 LIND TRACTS

NAME ADD

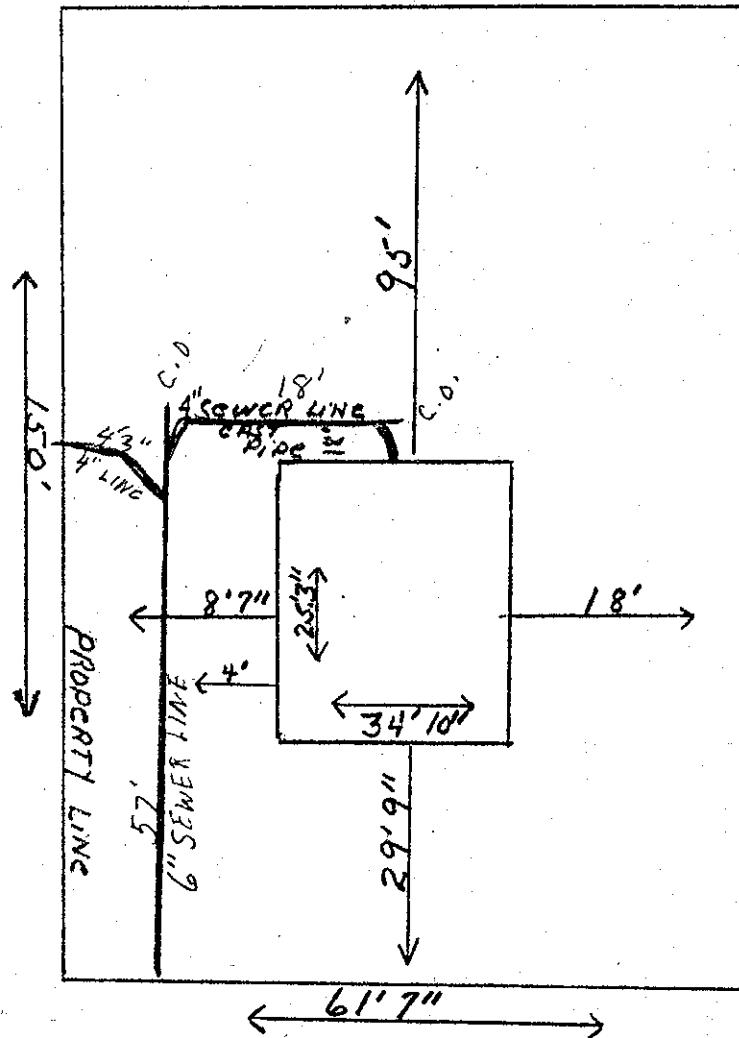

Date

Approved:

BACKFILL WORK ORDER ISSUED

DEPOSIT, \$ 10.00

SEWER WORK ORDER ISSUED

DATE 2-18-60

BY

Scott M Holton INSTCO# 5676
J 4/60 - Dyoat

None 85791

The City of Mountlake Terrace

APPLICATION

for

SIDE SEWER PERMIT

OUTSIDE INSIDE REPAIRS

George D. Grover

CARD No.

EASEMENT No. None

OWNER George D. Grover

CONTRACTOR

PERMIT NO. 43

HOUSE No. 23904 53rd W.


STREET
AVENUE LOT No. Lat 14

BLOCK No. 2

60'

NAME ADD

Replat of Linal Tracts

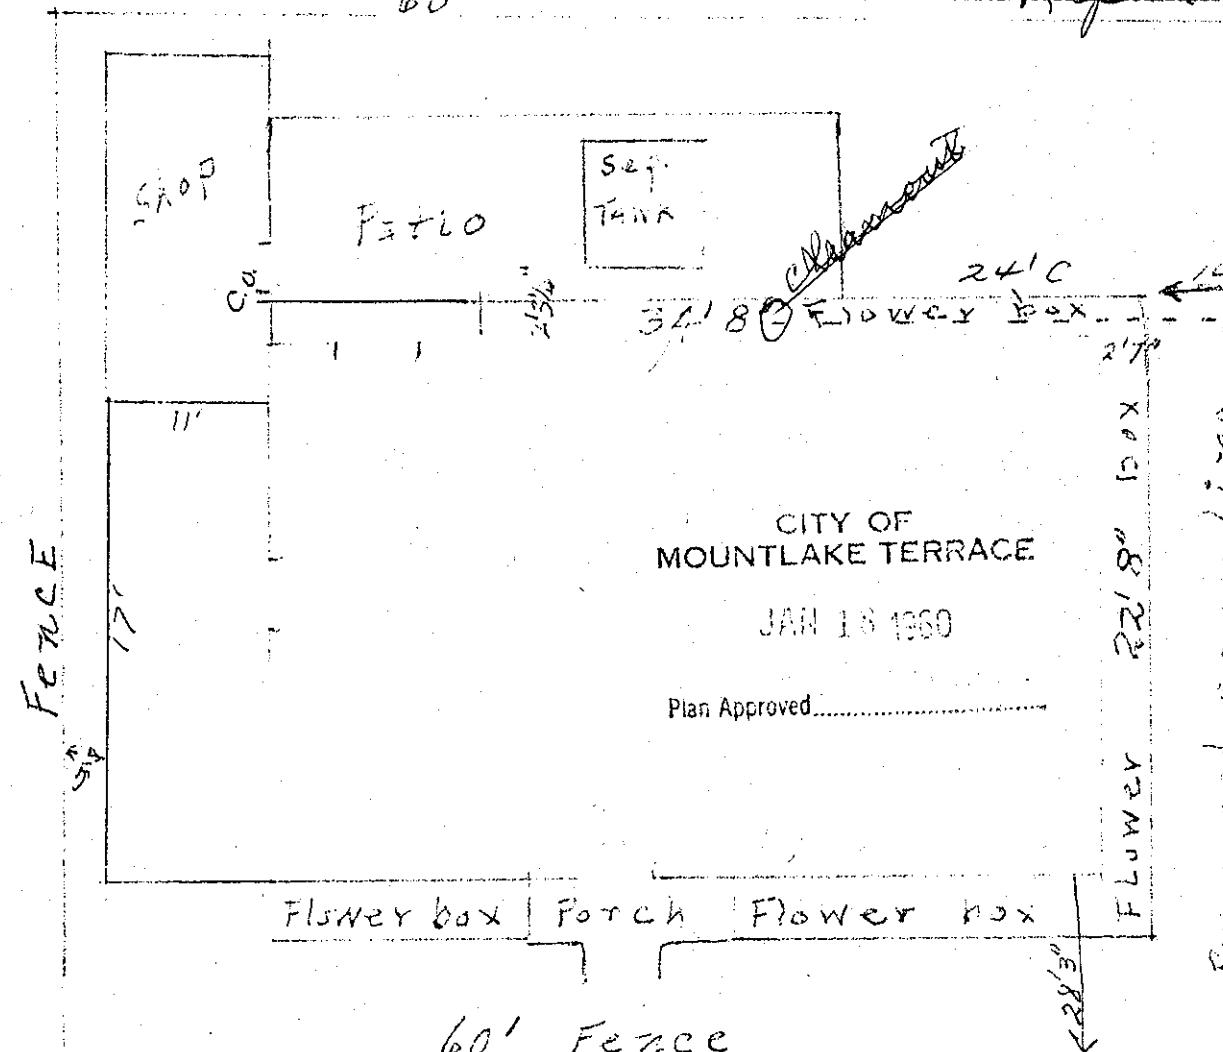

Date

Approved:

DEPOSIT, \$100 7-8-59

BACKFILL WORK ORDER ISSUED

SEWER WORK ORDER ISSUED

3732 DATE


BY

1-19-60 INSTCON SMK.

60.0

30

30

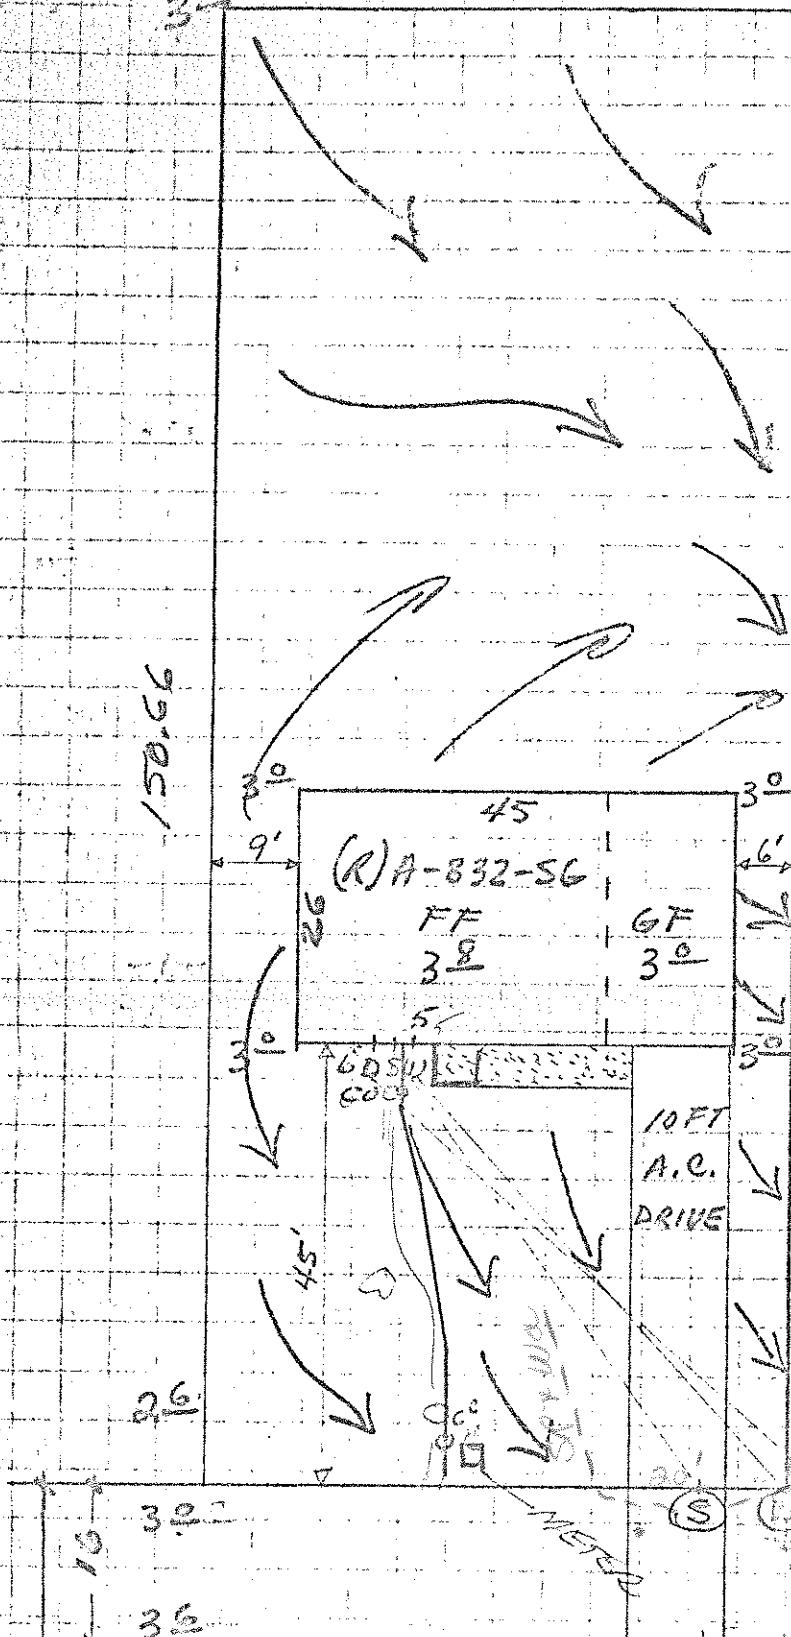

SCALE:
1:20

LOT 29, BLOCK 2, REPLAT OF
LIND TRACTS, VOL 13, PG. 21.

23905 - 53 AVE. W.
MOUNTLAKE TERRACE.

NORD HOMES, INC.

JOB # MT-15

1. POWER TO BE UNDERGROUND SERVICE.
2. DRIVEWAY ACCESS TO INCLUDE 25 FT OF CULVERT.
3. SEWER: 168 FT NORTH OF STUB TO BE INSTALLED.
4. WATER METER TO BE INSTALLED.
5. APPROX. 100 YDS OF FILL DIRT TO BE ADDED TO LOT TO PROVIDE POSITIVE DITCHLINE IN FRONT AND POSITIVE ON SITE DRAINAGE

P.L.

BT STREET WITH
2 FT. WIDE THICKENED
EDGE
C.B.

(W) Water - just west of property line

(S) Sewer

MT
SEWER

The City of Mountlake Terrace

APPLICATION

CARD No. _____

SIDE SEWER PERMIT

OUTSIDE INSIDE REPAIRS

EASEMENT No. _____


OWNER _____ CONTRACTOR Bruce Hummel

PERMIT No. 41-33-78

HOUSE No. 23907 53RD AVE W STREET _____ AVENUE LOT No. _____ BLOCK No. _____

NAME ADD

Nozzle

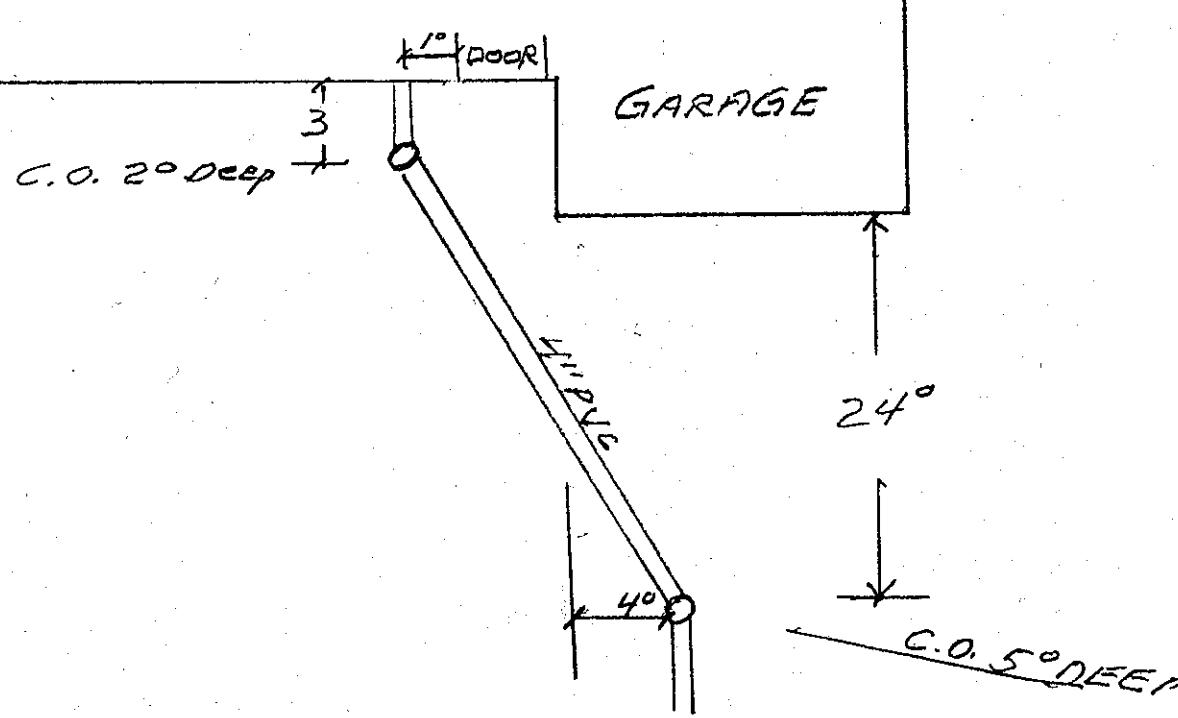

53RD

BACKFILL WORK ORDER ISSUED

Date

9/12/78

DEPOSIT, \$

20

Approved:

SEWER WORK ORDER ISSUED

7-14-78

DATE

9/12/78 BY F.H. Smith

The City of Mountlake Terrace

APPLICATION

CARD NO.

SIDE SEWER PERMIT

OUTSIDE INSIDE REPAIRS

EASEMENT NO.

OWNER

ALEXANDER

CONTRACTOR

SELF

PERMIT NO. 4-34-78

HOUSE No.


24007 53 AVE S.W.

STREET
AVENUE LOT NO.

BLOCK NO.

NAME ADD

← N

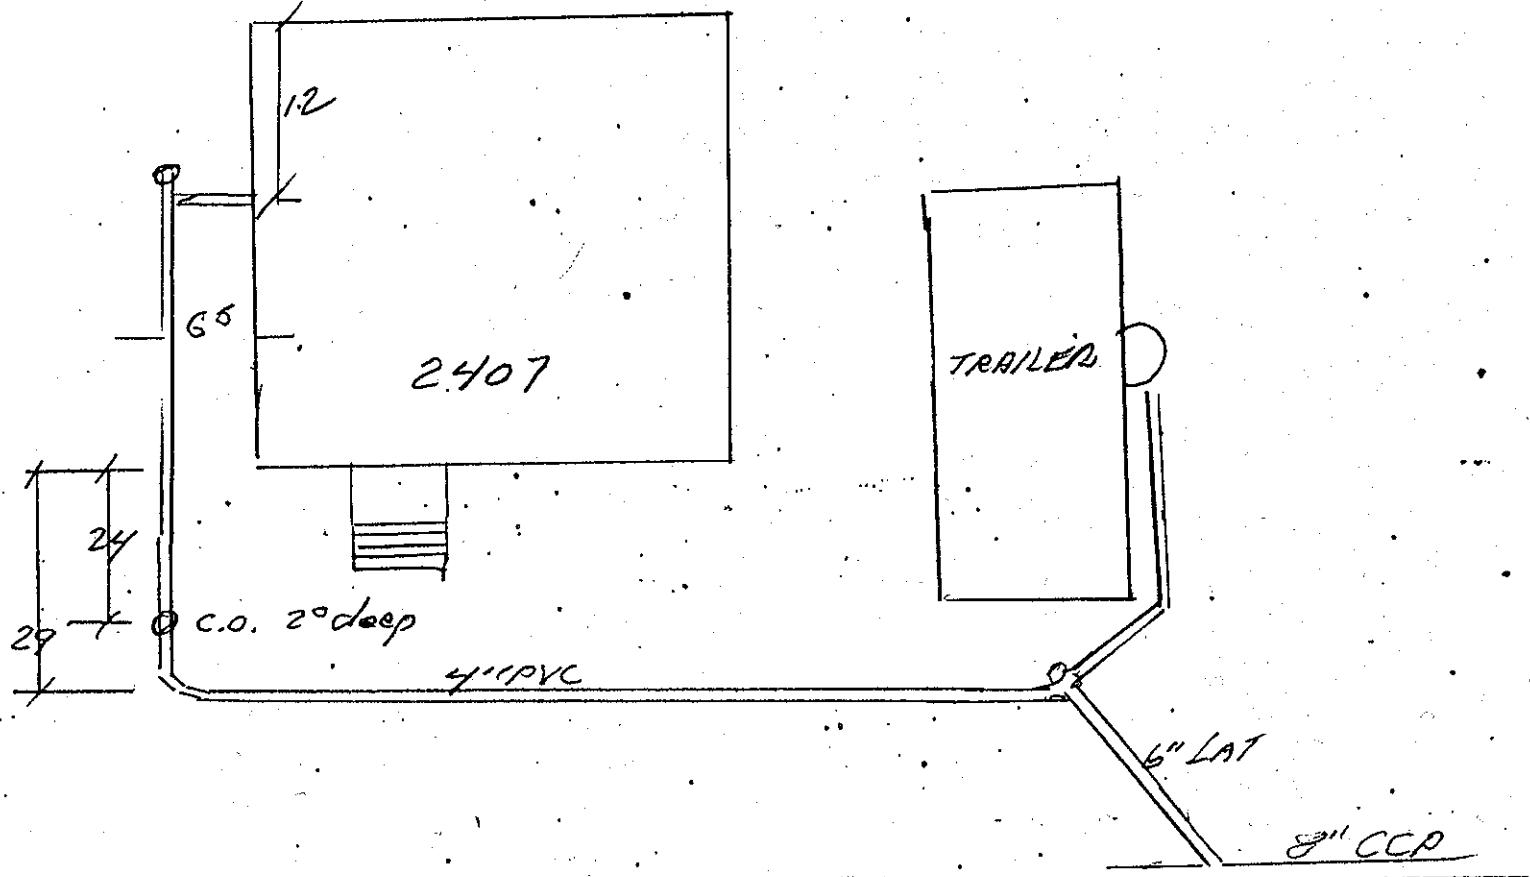

BACKFILL WORK ORDER ISSUED

SEWER WORK ORDER ISSUED

Date

8/28/78

DEPOSIT \$

20

ON LID


Approved:

DATE

8/28/78

BY

J.H. Smith

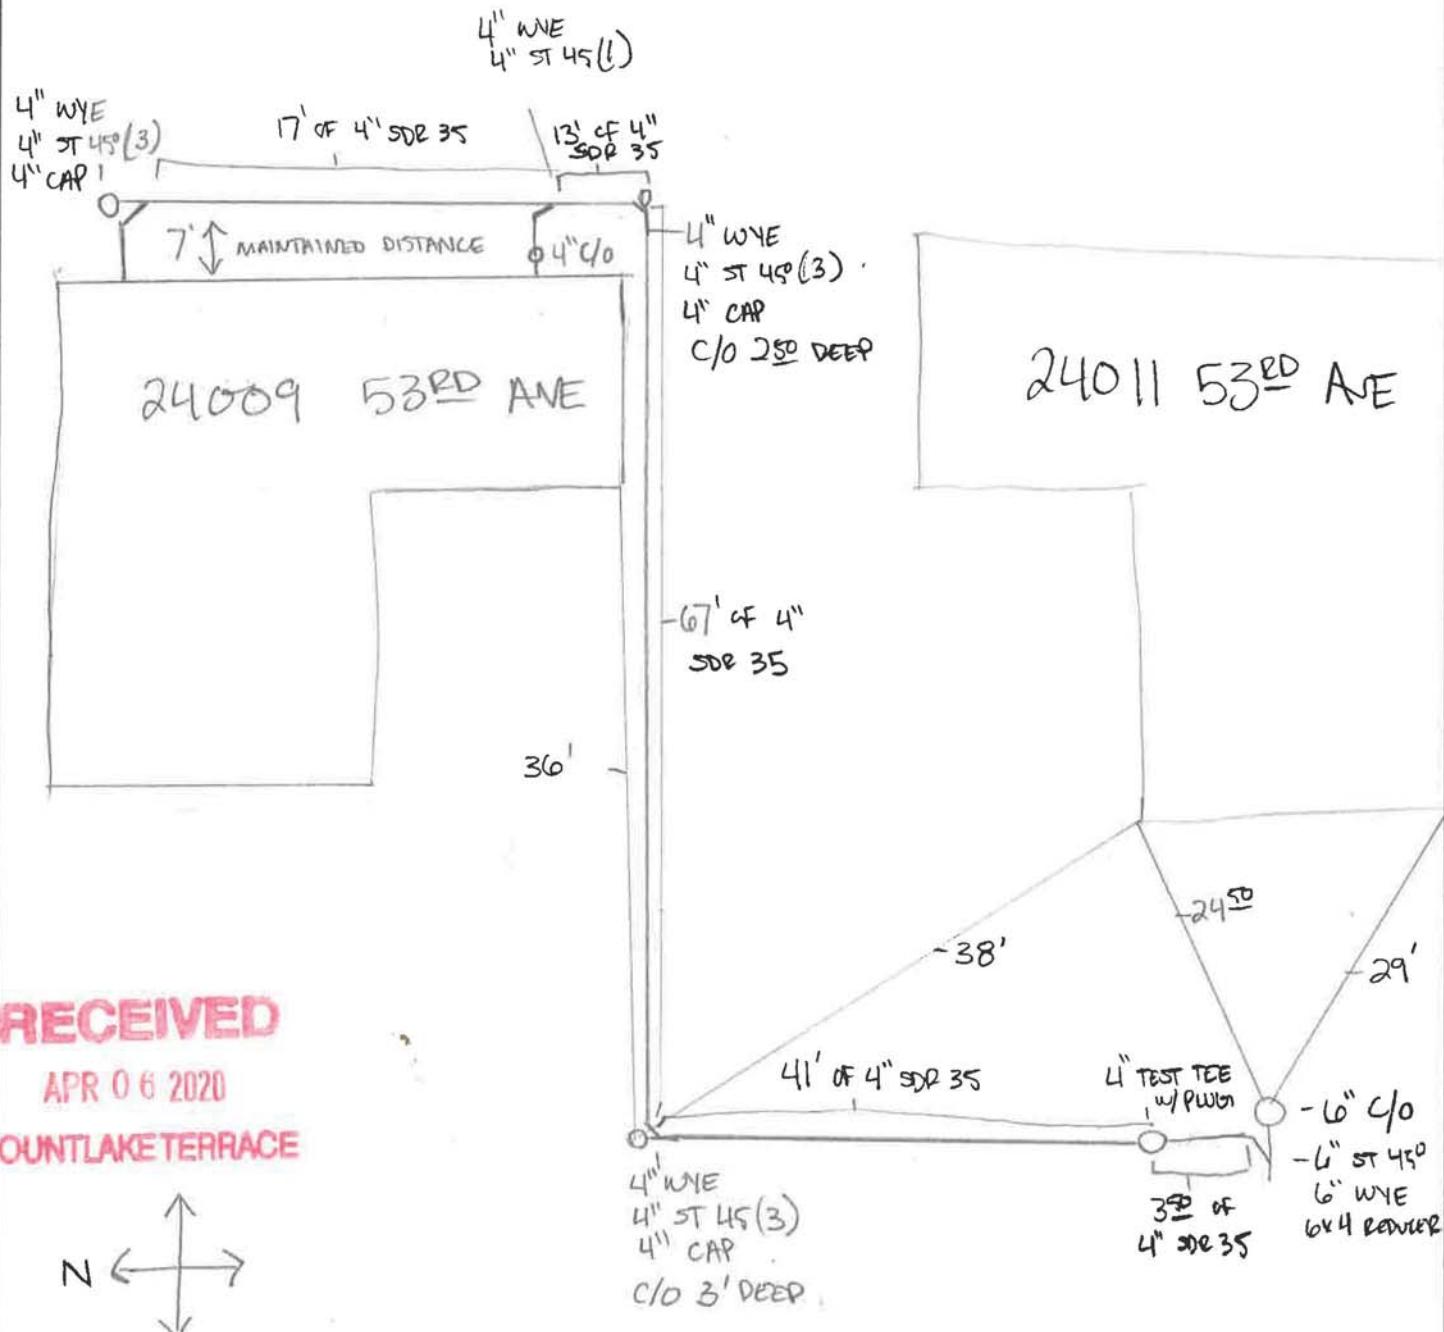

OWNER: ROBERT A & DETA J SINCLAIR

ADDRESS: 24009 53RD AVE W

DATE: 4-3-20

PERMIT #: U-200011

Inspector's Signature: *Tom A. Mahuli*

SIDE SEWER DRAWING

1. Drawing must be clearly labeled (streets, north arrow).
2. Indicate location of all piping, cleanouts, manholes or other fixed features.
3. Dimension pipe length and distance from other features.
4. Label diameter, bends, material type of pipe and depth at cleanouts.



CALL BEFORE YOU
DIG:
1-800-424-5555 (or 811)

The City of Mountlake Terrace

APPLICATION

CARD No. _____

SIDE SEWER PERMIT

OUTSIDE INSIDE REPAIRS

EASEMENT NO. _____

0 108 76

OWNER Thornton Sergeant

CONTRACTOR Himself

PERMIT NO. _____



HOUSE No. 24010 53rd Ave W

STREET

AVENUE LOT No. _____

BLOCK No. _____

NAME ADD

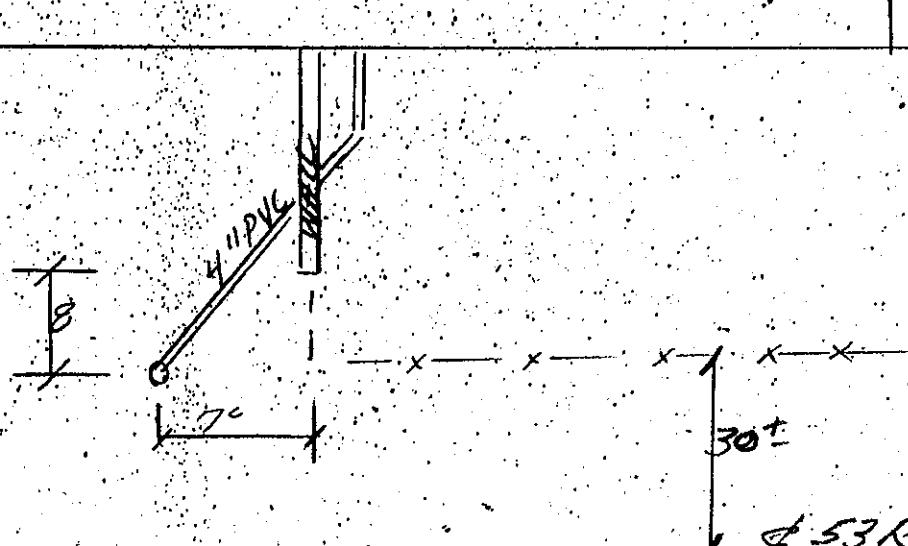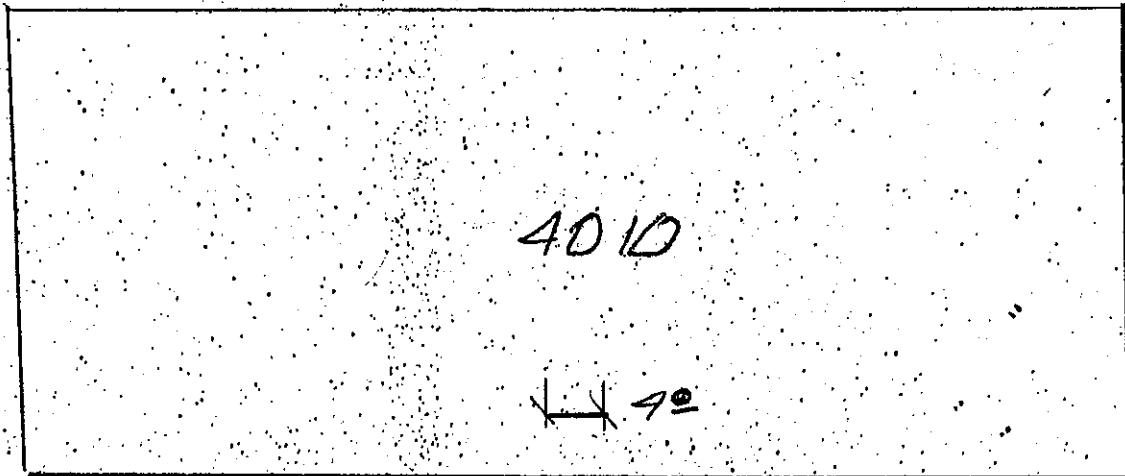

11/29 Date

Approved:

11 29 76

BACKFILL WORK ORDER ISSUED

22 29 76

DEPOSIT, \$ 10


SEWER WORK ORDER ISSUED

11 29 76

DATE

BY

TH/Smith

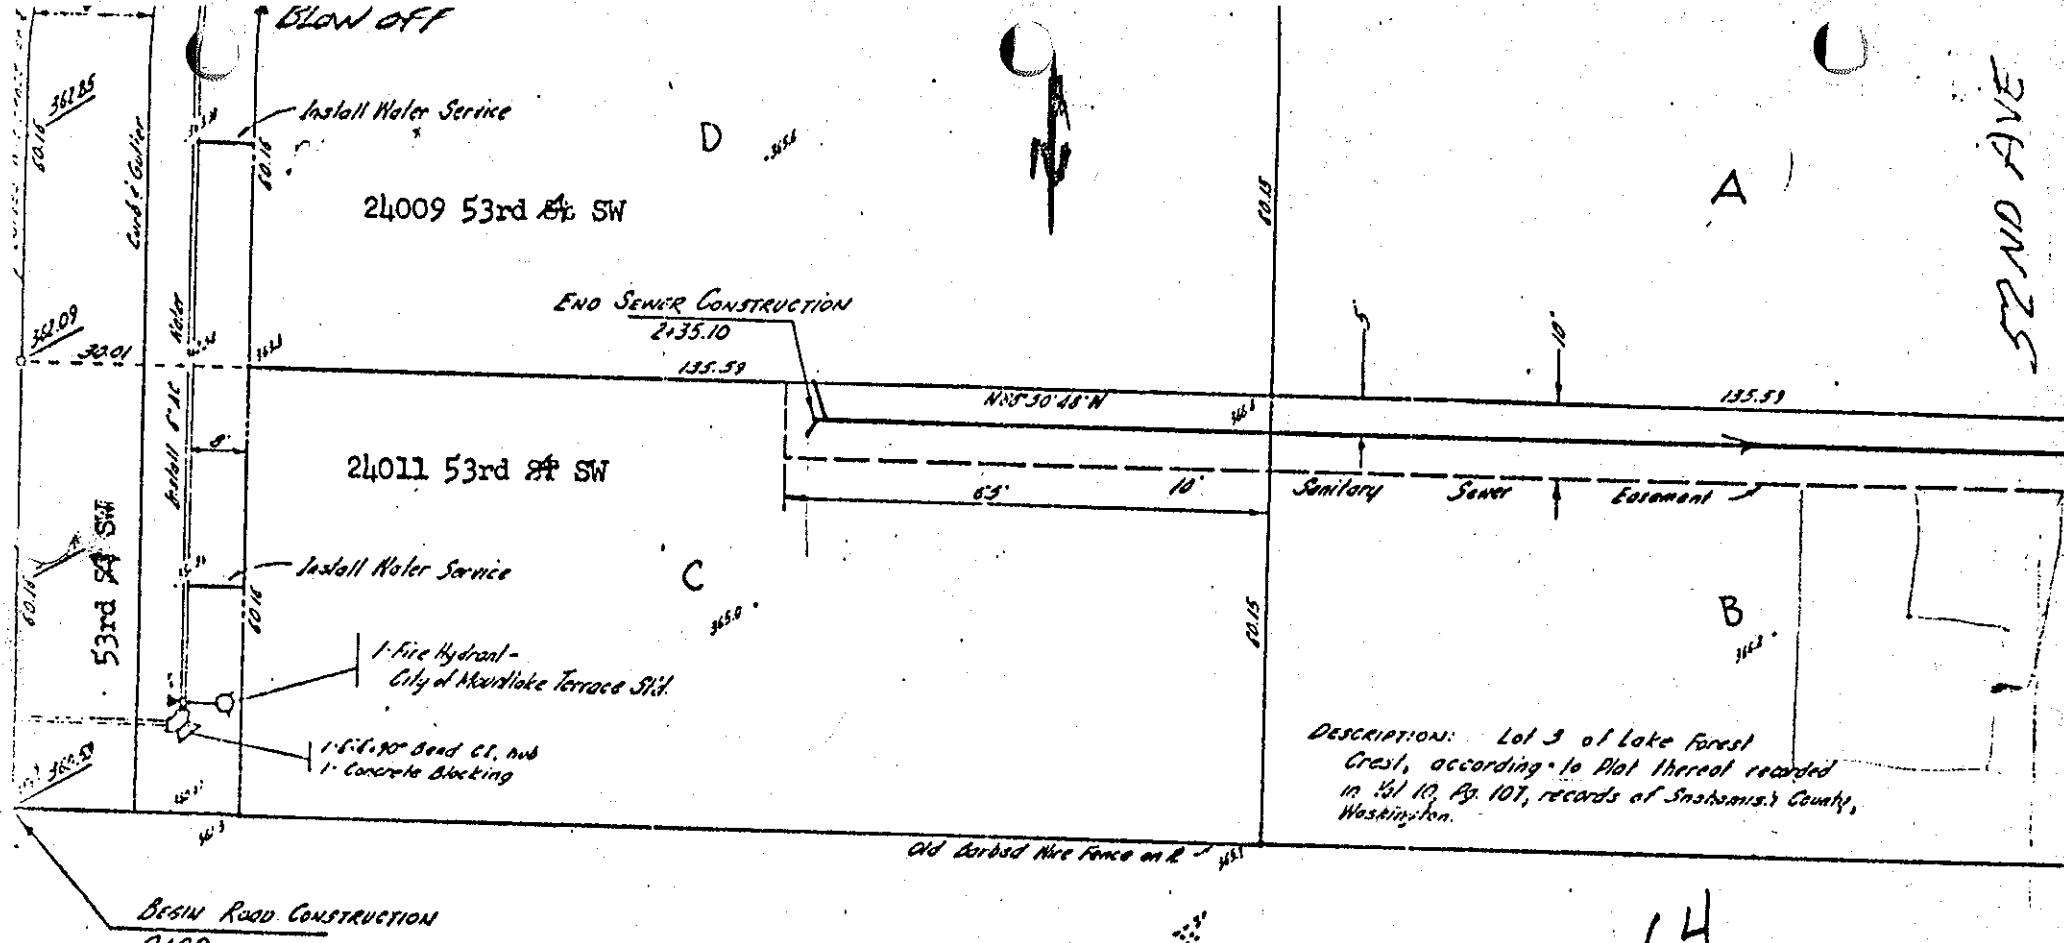

The City of Mountlake Terrace

775-9230

APPLICATION

CARD NO.

SIDE SEWER PERMIT

OUTSIDE INSIDE REPAIRS

EASEMENT NO.

OWNER M. MALLEY
HOUSE No. 24012 53RD AVE W



CONTRACTOR

STREET
AVENUE LOT NO.

PERMIT NO. 11-32-78

BLOCK NO.

NAME ADD

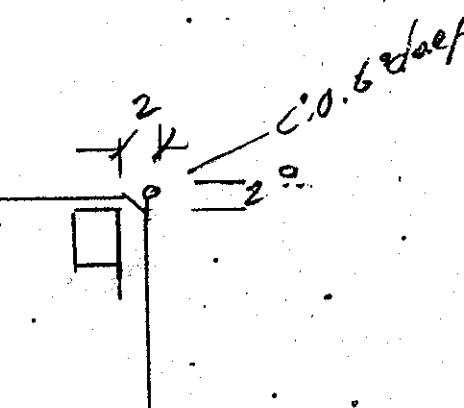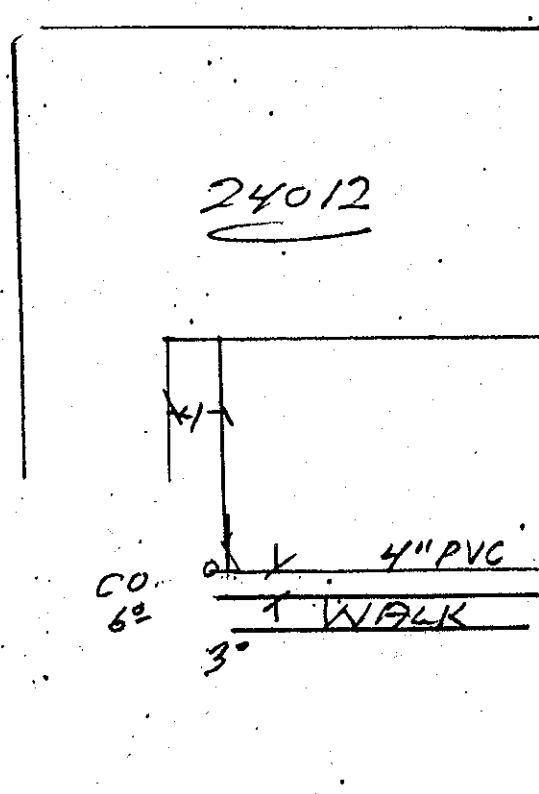

of 53RD AVE.

BACKFILL WORK ORDER ISSUED
SEWER WORK ORDER ISSUED

Date
9/5/78

DEPOSIT \$

20⁰⁰

Approved:

DATE 9/5/78 BY J.H. Smith

The City of Lake Terrace

APPLICATION

CARD No.

SIDE SEWER PERMIT

OUTSIDE INSIDE REPAIRS

EASEMENT No.

OWNER Doug Gilbert

CONTRACTOR Himself

U 107 76


HOUSE No. 24015 53rd Ave W

STREET
AVENUE LOT No.

PERMIT No.

BLOCK No.

NAME ADD

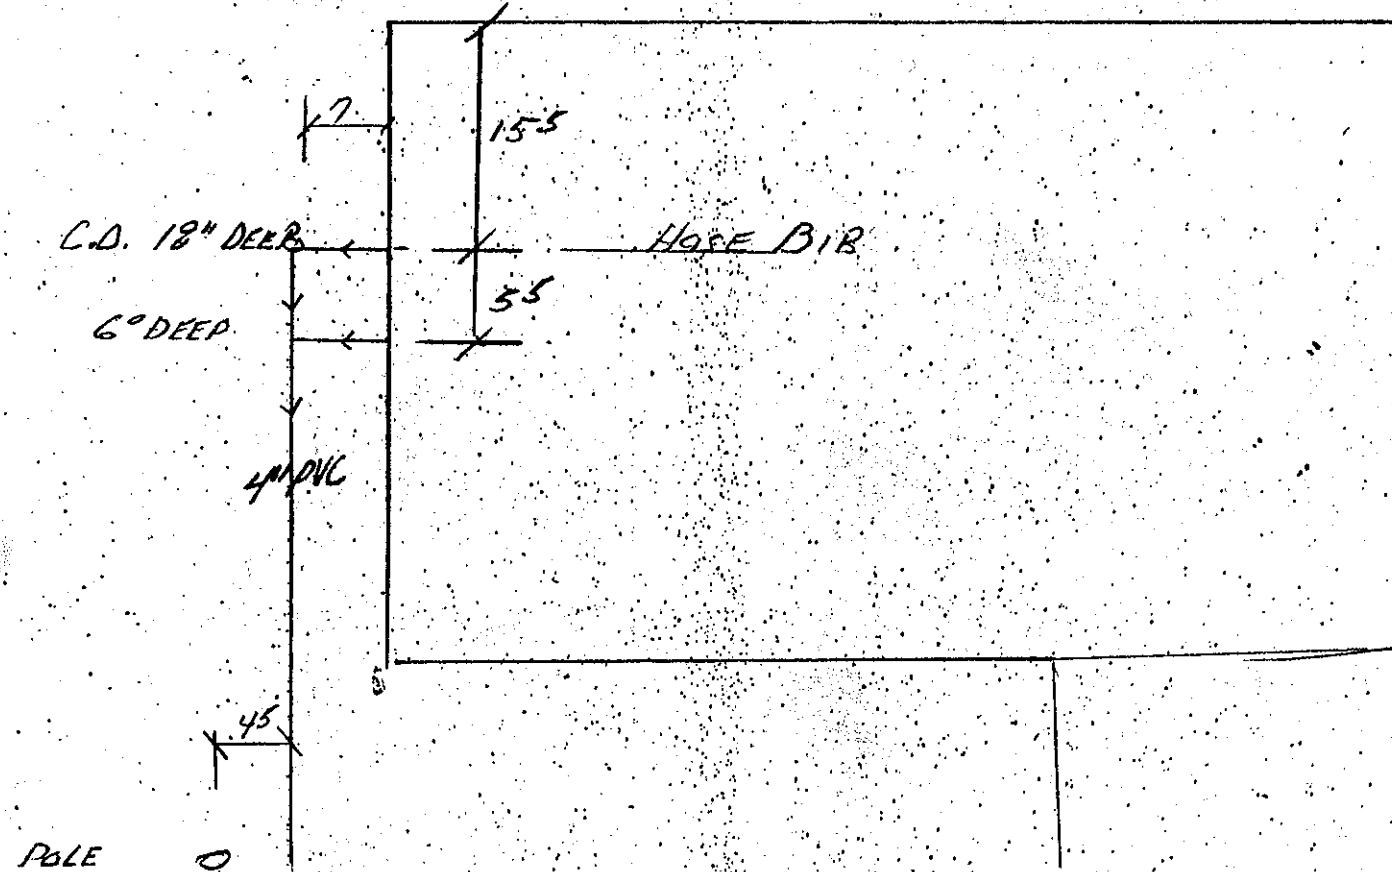

53RD AVE W

BACKFILL WORK ORDER ISSUED	Date	DEPOSIT, \$	Approved:
11 22 76	10		
SEWER WORK ORDER ISSUED	11 19 76	DATE 11 22 76	BY

The City ofountlake Ter

APPLICATION

SIDE SEWER PERMIT

OUTSIDE INSIDE REPAIRS

CARD NO.

EASEMENT NO.

OWNER *Bob Home Drive*
HOUSE NO. *21702 1/ place*

CONTRACTOR *Tynwood Septic tank Co.*

PERMIT No. *3717*

STREET
AVENUE LOT No. *Lot 3*

BLOCK No. *28 70*

NAME ADD *Sharlet*

77


56

32

22'

6'

141

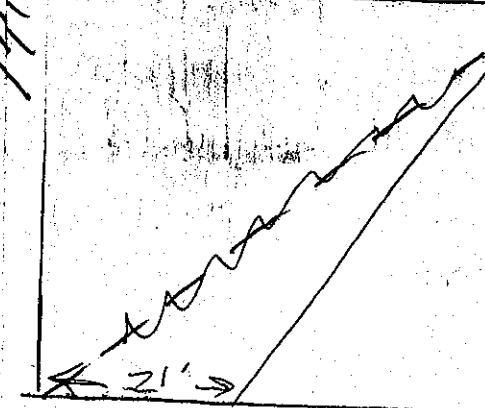

Date

Approved:


BACKFILL WORK ORDER ISSUED
SEWER WORK ORDER ISSUED

DEPOSIT, \$

DATE *3-5-64*

BY

R. Behn

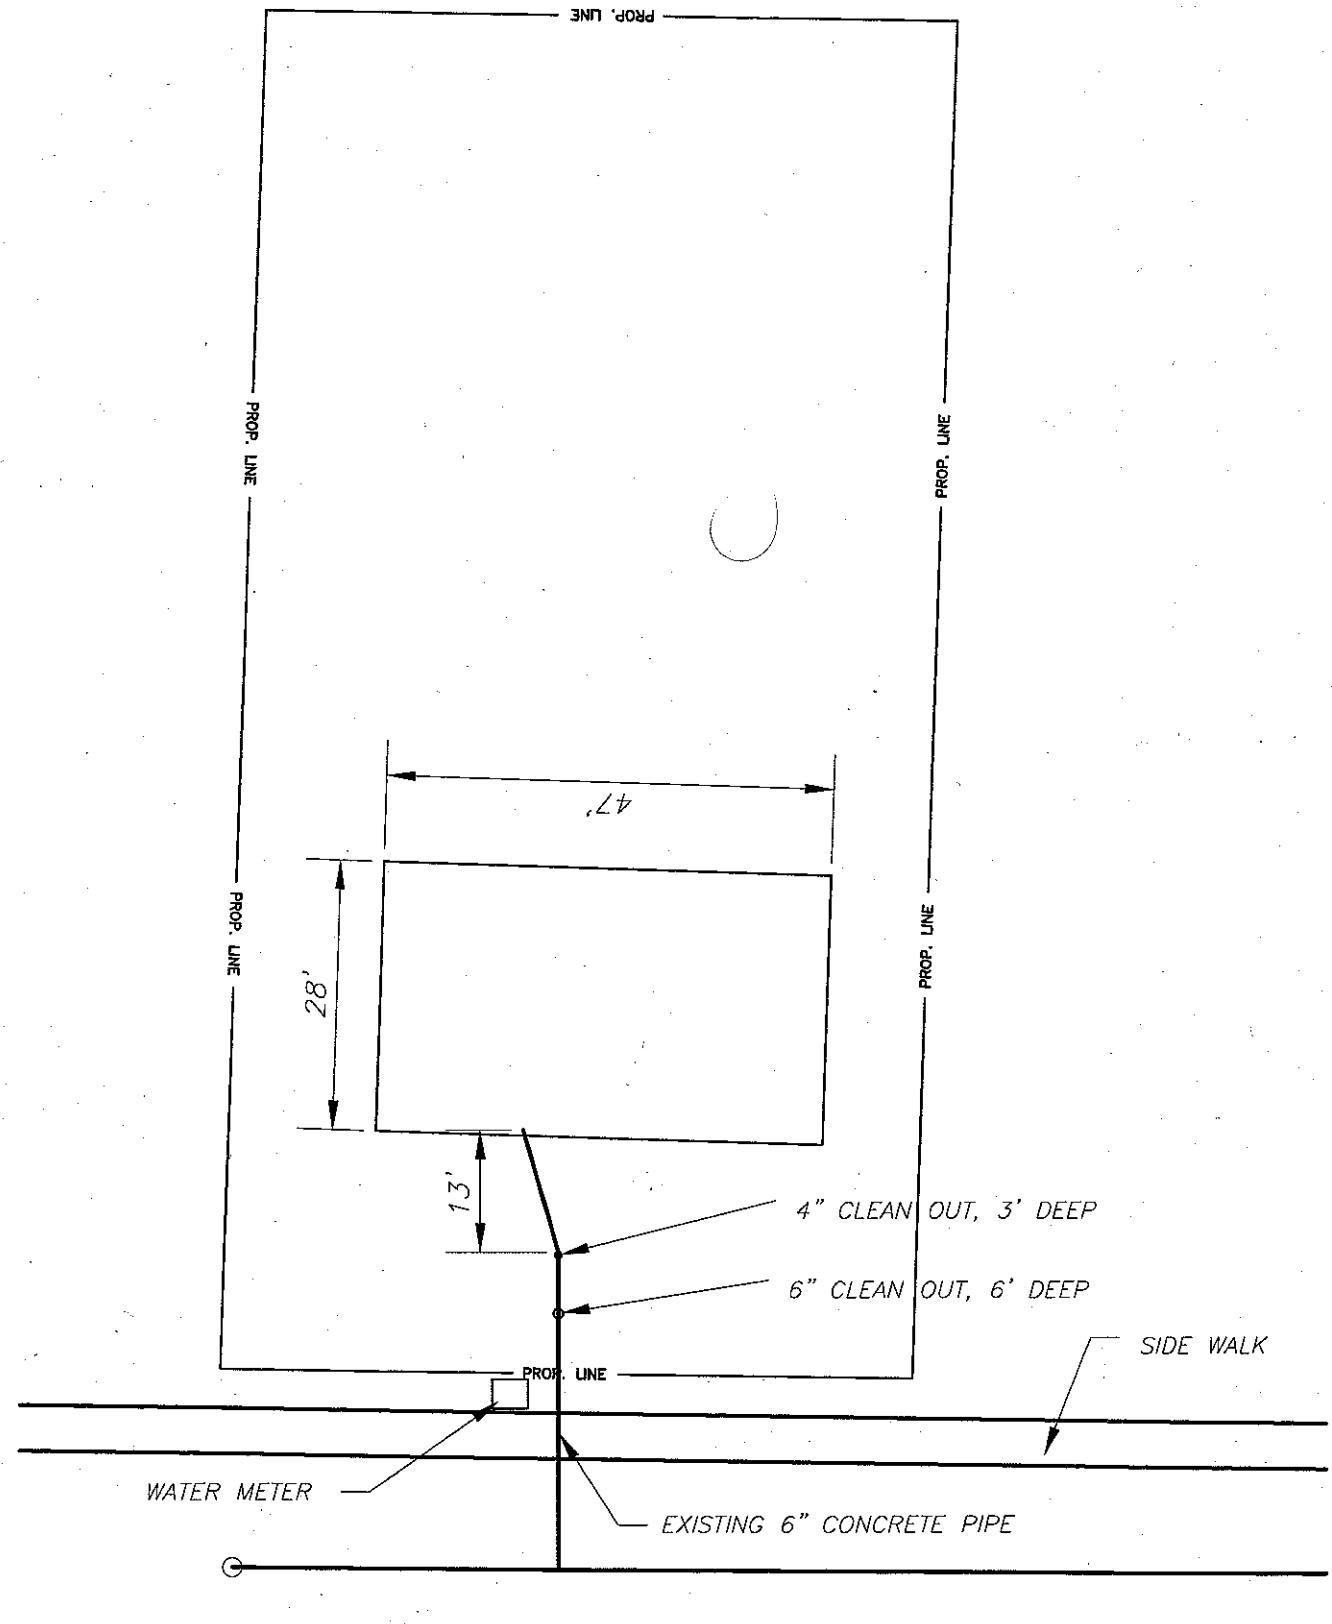

CITY OF MOUNTLAKE TERRACE
DEPARTMENT OF COMMUNITY DEVELOPMENT

DWG TITLE:

SEWER PLAN
21403 54TH PL SW

Scale: 1" : 20'

PLAN No.

X

REV. DATE:
JULY, 2005

The City of Mountlake 1

APPLICATION

for

SIDE SEWER PERMIT

OUTSIDE INSIDE REPAIRS

EASEMENT NO.

OWNER

Wick Co Inc

HOUSE NO.

2140 54th pl NW

CONTRACTOR

Lynnwood Septic Tank Co

PERMIT NO. 3718

STREET

AVENUE LOT NO.


54th 2

BLOCK NO.

NAME ADD.

Sholet

77

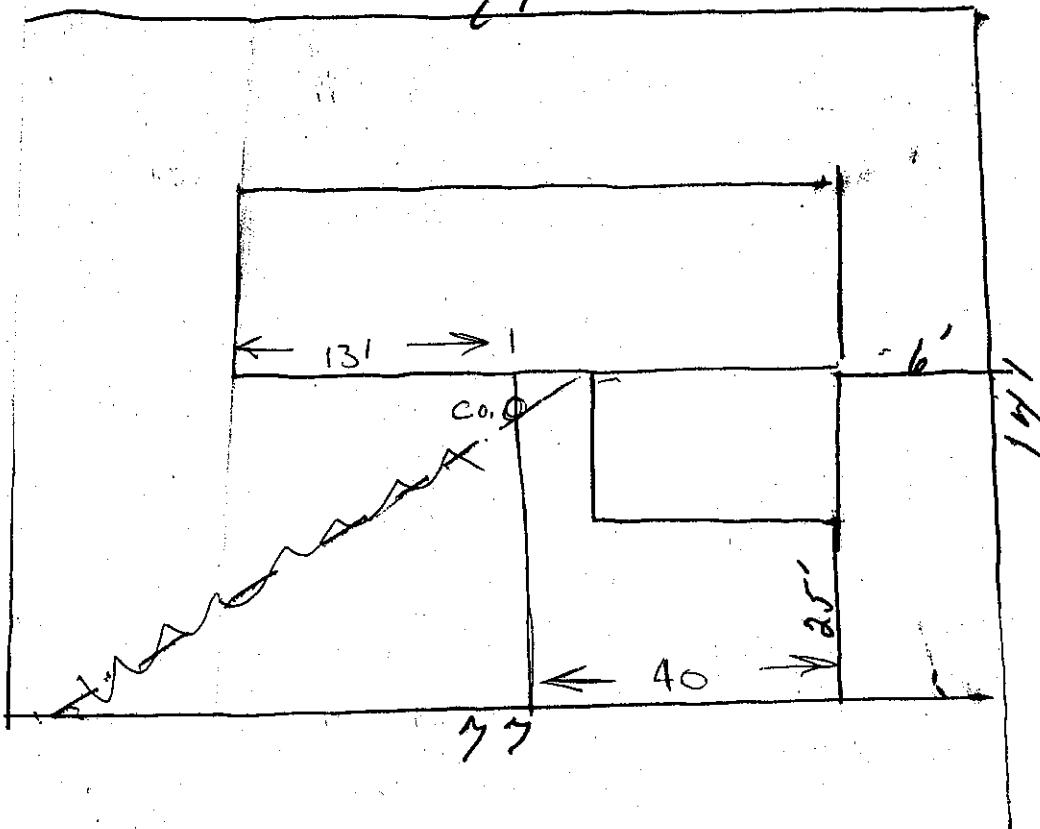

BACKFILL WORK ORDER ISSUED
SEWER WORK ORDER ISSUED

Date

DEPOSIT, \$

Approved:

DATE 3-5-69

BY

R. Baker

The City of Mountlake Terrace

APPLICATION

for

SIDE SEWER PERMIT

OUTSIDE INSIDE REPAIRS

CARD NO.

EASEMENT NO.

OWNER nick horns Inc

HOUSE NO. 21406


CONTRACTOR Lynnwood Septic PERMIT NO. 3706

STREET 54 plw AVENUE LOT NO. 1

NAME ADD.

Sharlet

BLOCK No.

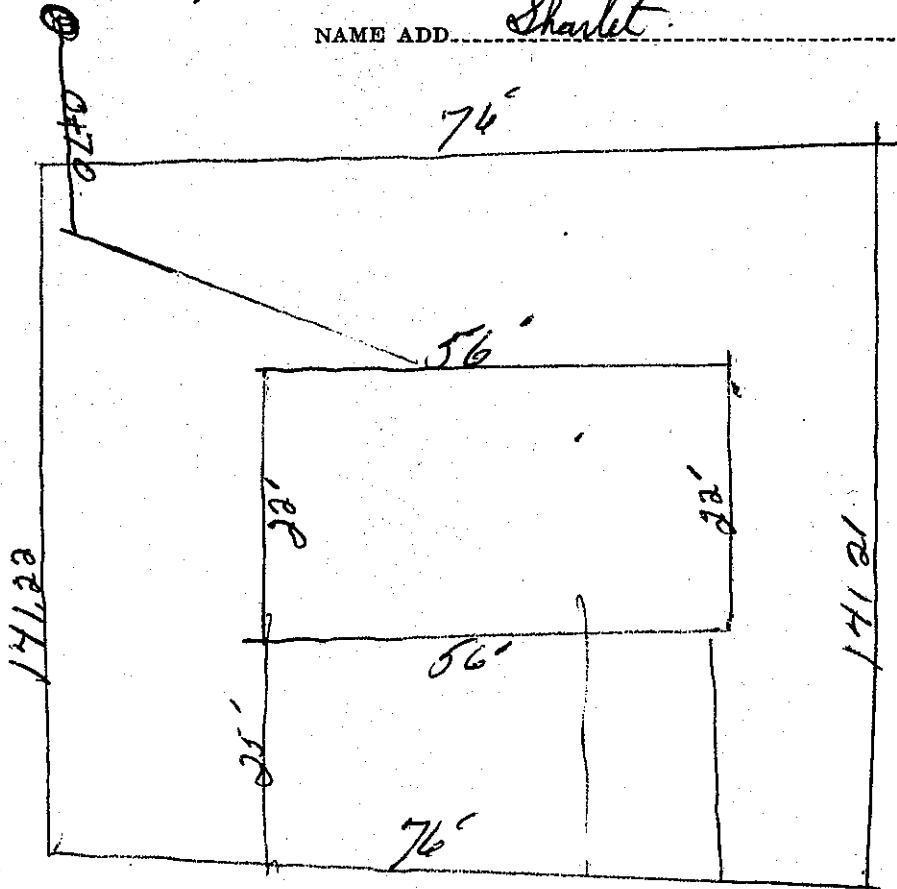

Date

Approved:

BACKFILL WORK ORDER ISSUED

DEPOSIT, \$

SEWER WORK ORDER ISSUED

DATE BY

The City of Mountlake Terrace

APPLICATION

for

SIDE SEWER PERMIT

OUTSIDE INSIDE REPAIRS

CARD No.

EASEMENT No.

OWNER *wick Horne, Inc.*

HOUSE No. *21501* STREET *5th pl S W*

CONTRACTOR

STREET


AVENUE LOT No.

NAME ADD.

PERMIT No.

BLOCK No.

Job - 71

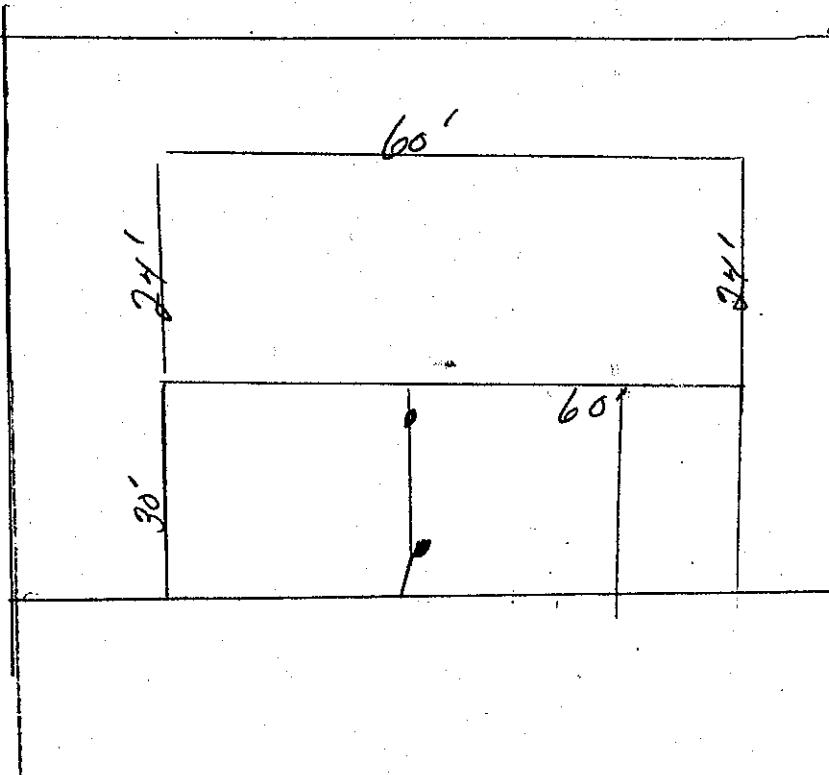

Date

Approved:

BACKFILL WORK ORDER ISSUED

DEPOSIT, \$

DATE *6-26-64* BY *George D. Baker*

SEWER WORK ORDER ISSUED

APPLICATION

for

SIDE SEWER PERMIT

OUTSIDE INSIDE REPAIRS

CARD No.....

The City of Mountlake Terrace

EASEMENT No.....

OWNER JACK MILLER

CONTRACTOR JACK MILLER

PERMIT No. 3786


HOUSE NO. 21502 54 PL West

STREET
AVENUE LOT NO.

BLOCK No.

NAME ADD.

54 PL WEST

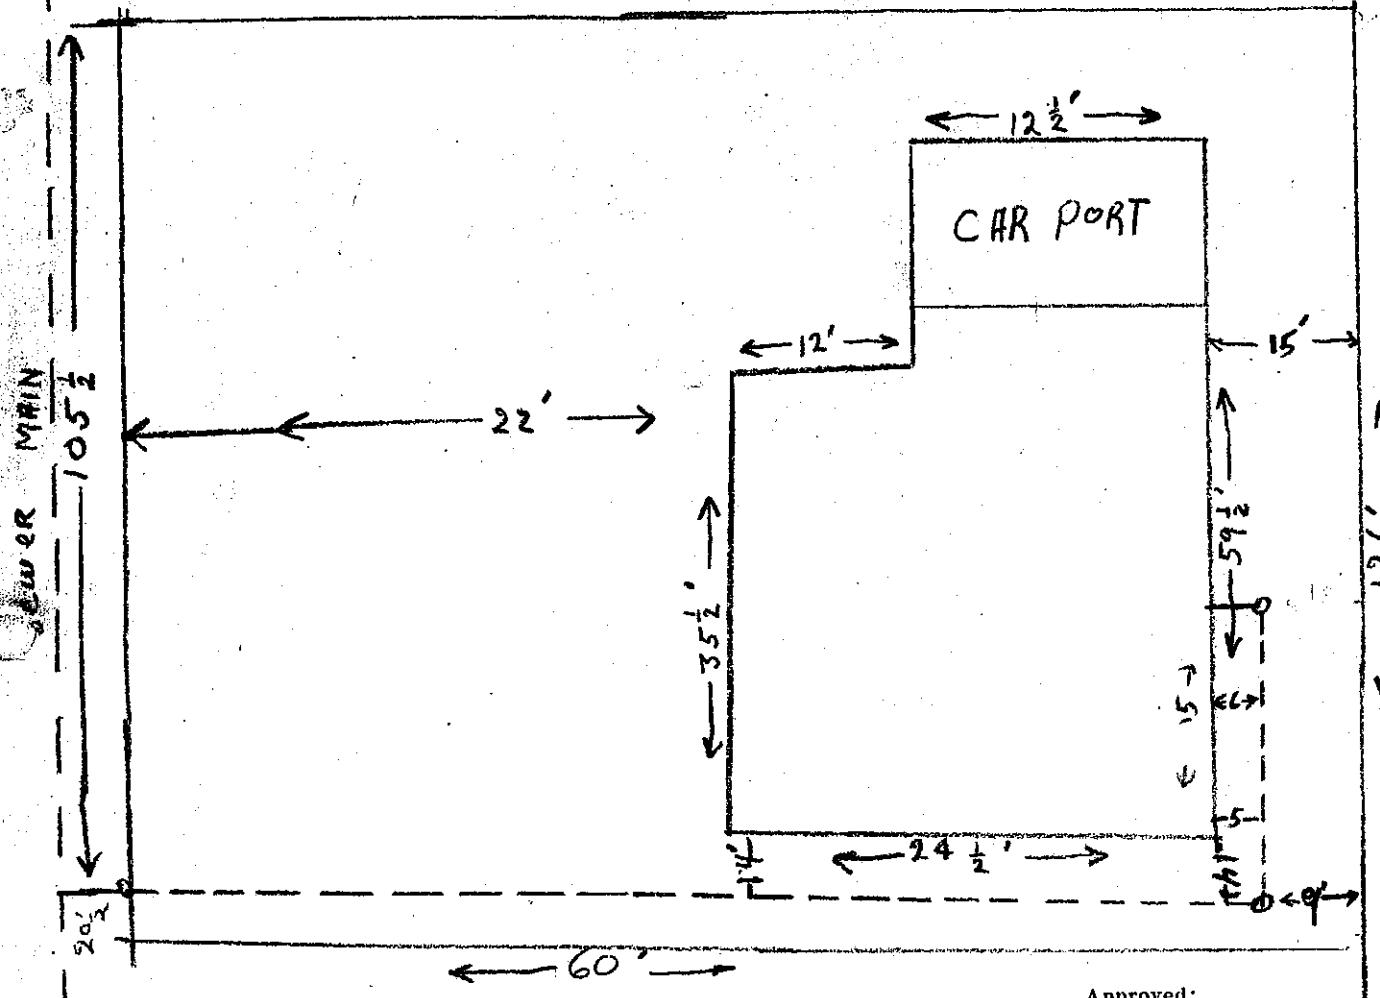

Date

Approved:

DATE 6-1-64

BY

BACKFILL WORK ORDER ISSUED

DEPOSIT, \$

SEWER WORK ORDER ISSUED

R. Bell

f Mountlake Terrace

APPLICATION

for

SIDE SEWER PERMIT

OUTSIDE INSIDE REPAIRS

CARD No.....

EASEMENT No.....

OWNER

American Corporation

HOUSE No. 21503 54th Ave W

CONTRACTOR Tuckix Const


PERMIT NO. 3930

STREET

AVENUE LOT NO.

BLOCK No.....

NAME ADD.....

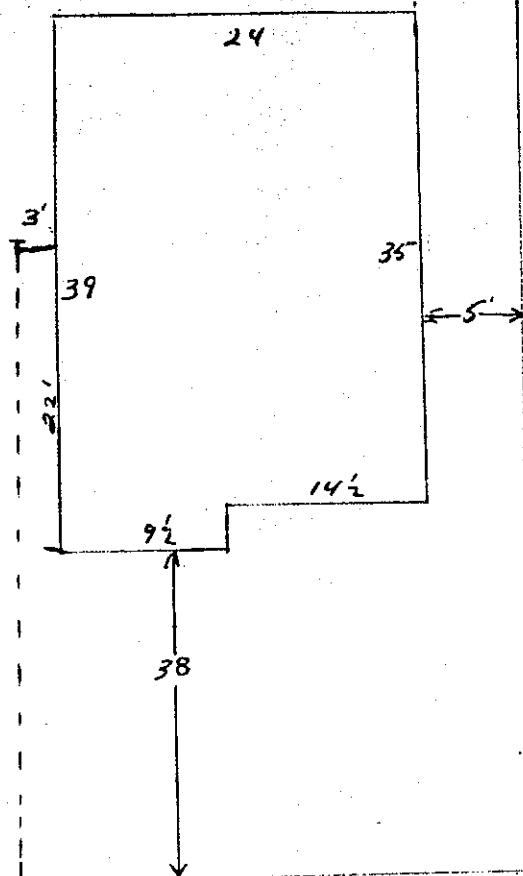

Date

Approved:

BACKFILL WORK ORDER ISSUED.....

DEPOSIT \$.....

SEWER WORK ORDER ISSUED.....

DATE 4/28/65

BY George F. Baker

APPLICATION

for

SIDE SEWER PERMIT

The City of Mountlake Terrace

CARD No.

OUTSIDE INSIDE REPAIRS

EASEMENT No.

OWNER JAMES D. SWAN
HOUSE NO. 21504

CONTRACTOR SAME

STREET
AVENUE LOT No.

PERMIT No. 3837


54 PL. W.

8

BLOCK No.

NAME ADD. MLT DIV # 32

54 PL. W.

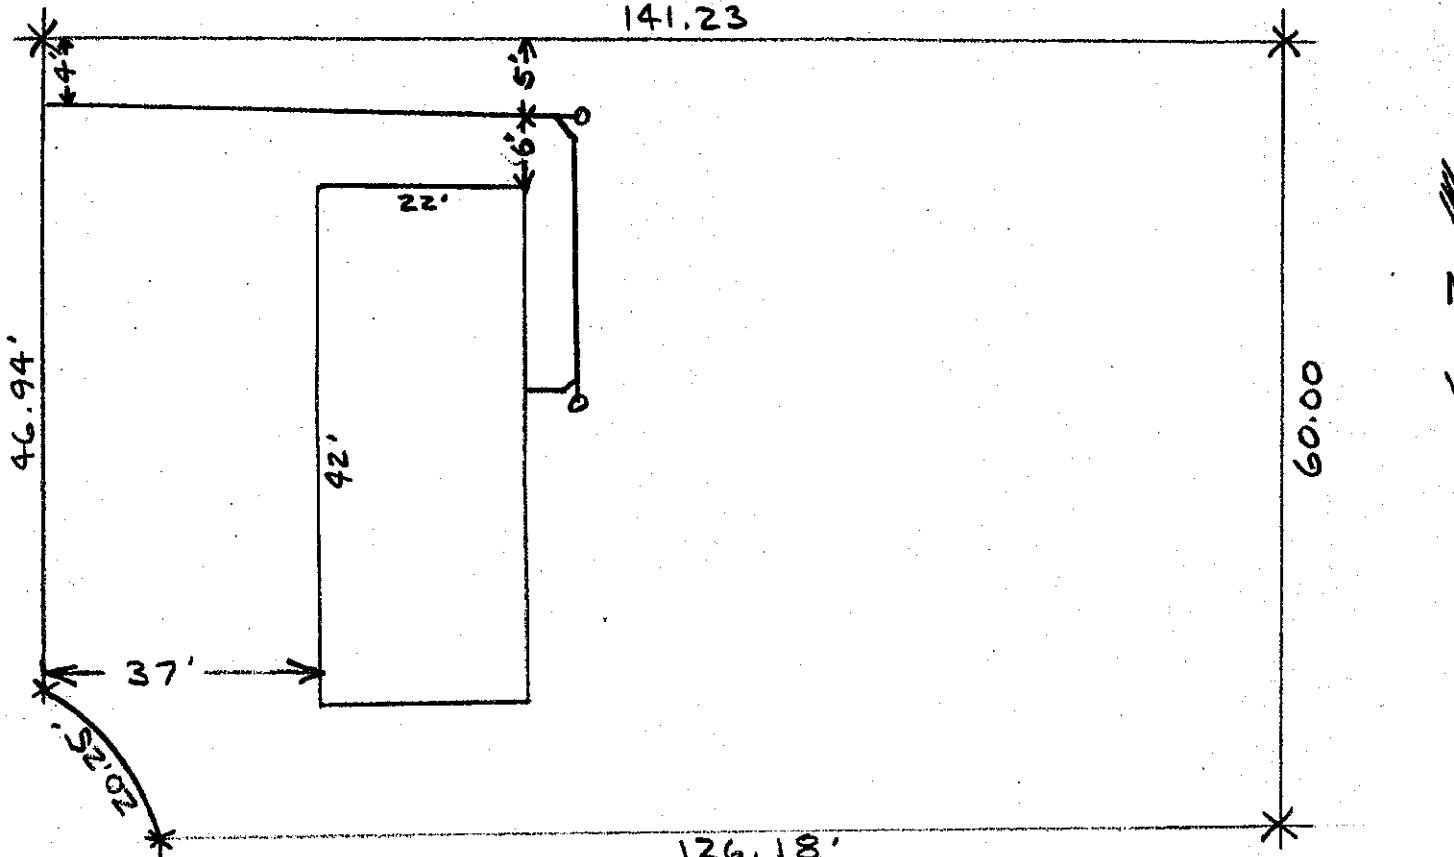

Date

Approved:

BACKFILL WORK ORDER ISSUED

DEPOSIT, \$

SEWER WORK ORDER ISSUED

DATE 7-30-69 BY R Baker

The City of Mountlake Terrace

APPLICATION

for

SIDE SEWER PERMIT

OUTSIDE INSIDE REPAIRS

CARD No.

EASEMENT No.

OWNER ALAN E. Edwards

CONTRACTOR JACK Miller

PERMIT NO. 3785


HOUSE No. 21505 54 PL WEST

STREET
AVENUE LOT No.

BLOCK No.

NAME ADD.

54 PL West

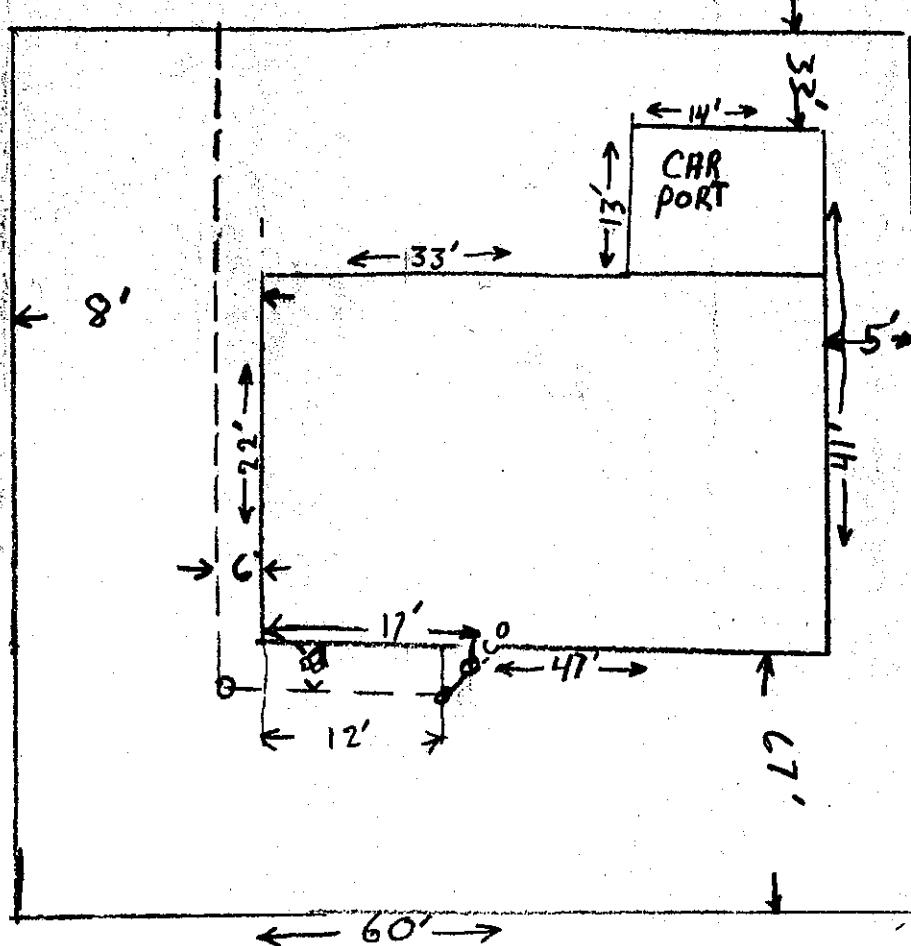

Date

Approved:

BACKFILL WORK ORDER ISSUED

DEPOSIT, \$

SEWER WORK ORDER ISSUED

DATE 6-1-64 BY B. Bah

The City of Mountlake Terrace

APPLICATION

for

SIDE SEWER PERMIT

OUTSIDE INSIDE REPAIRS

CARD No.....

EASEMENT No.....

OWNER RICHARD A. WALKER
HOUSE No. 21506 STREET S4 PL.


CONTRACTOR Same

STREET 9
AVENUE LOT No.

PERMIT No. 3839

BLOCK No.

NAME ADD MLT DIV # 32

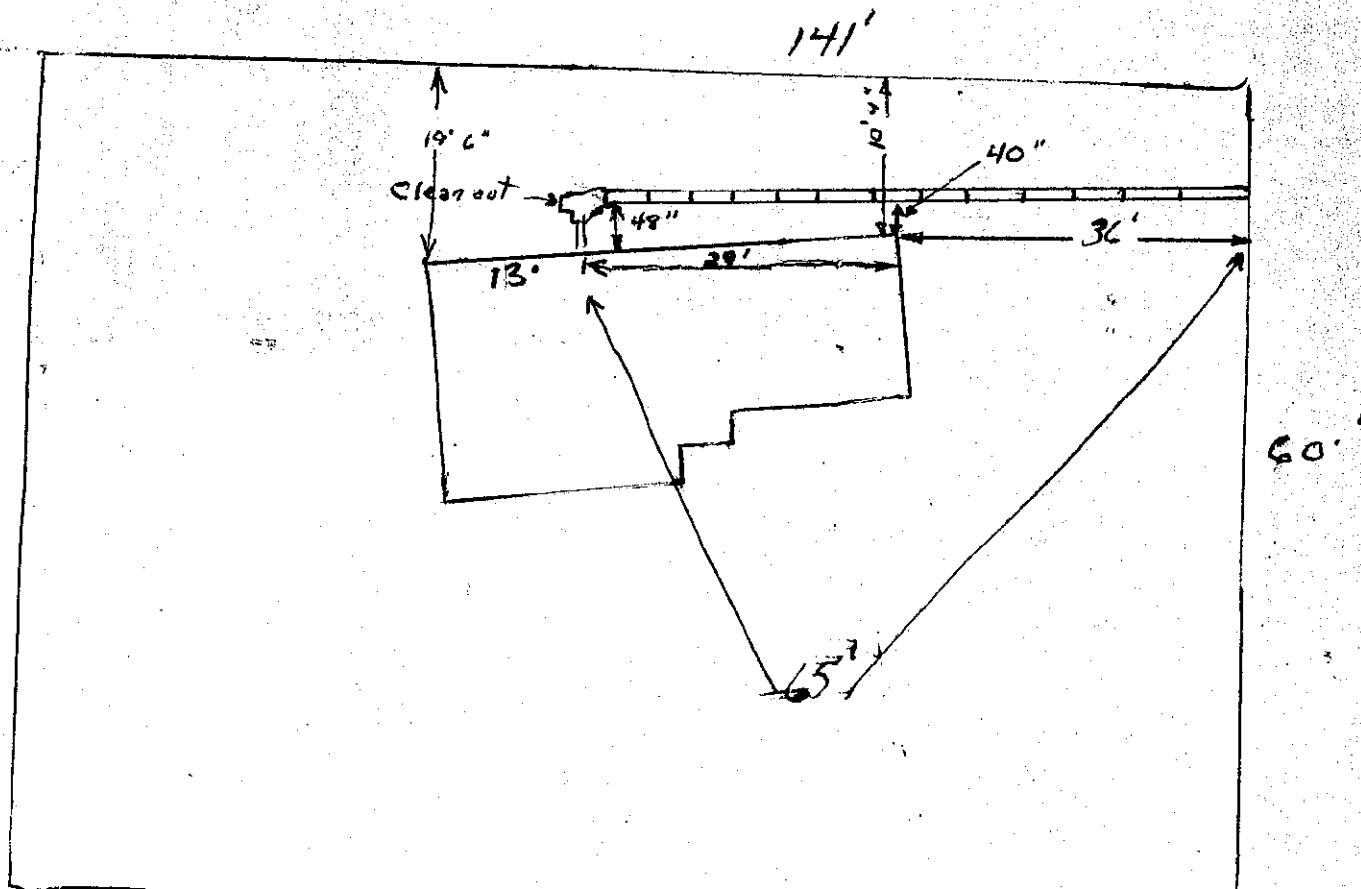

Date

Approved:

BACKFILL WORK ORDER ISSUED.....

DEPOSIT, \$.....

SEWER WORK ORDER ISSUED.....

DATE 7-23-68 BY R.B. Bahr

The City of Mountlake Terrace

APPLICATION

FOR

SIDE SEWER PERMIT

OUTSIDE INSIDE REPAIRS

CARD NO.

EASEMENT NO.

OWNER Stanley R. Negrych

CONTRACTOR Tucker


PERMIT NO. 3959

HOUSE No. 21507 54th PL W

STREET
AVENUE LOT NO. 4

BLOCK NO.

NAME ADD. Mountlake Terrace Div 32

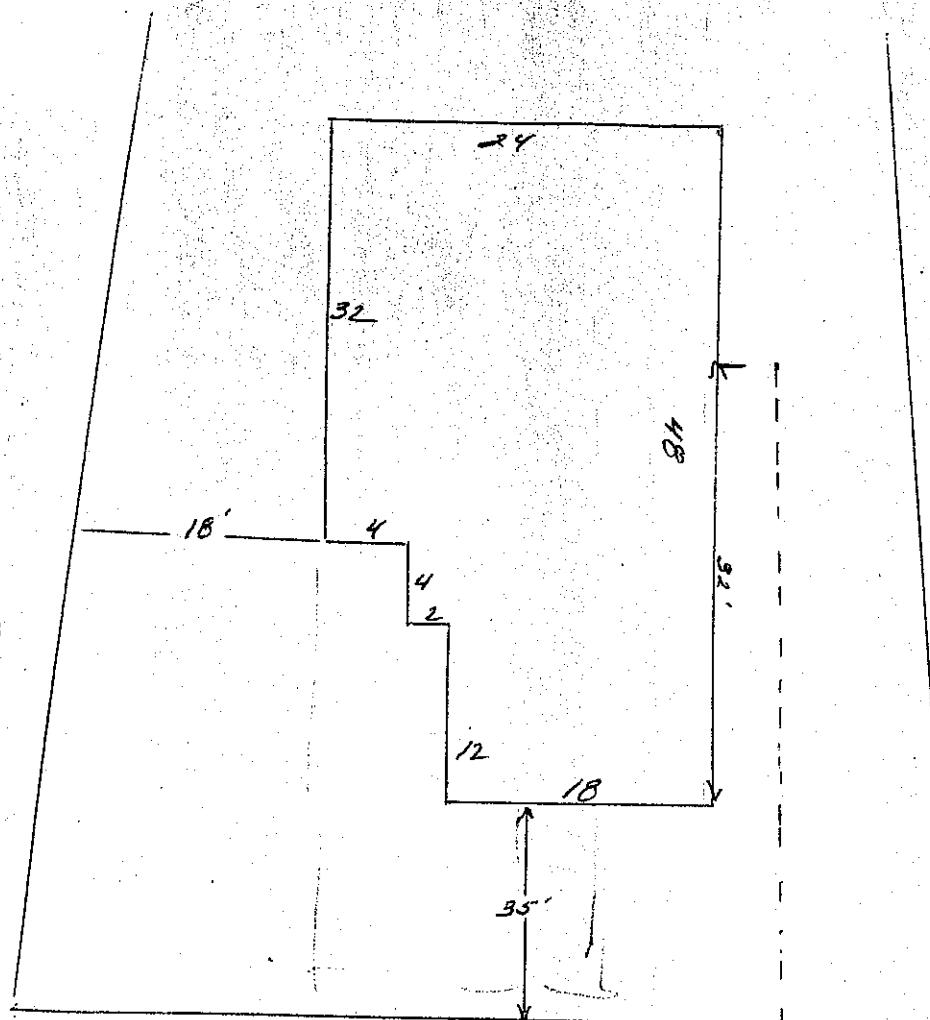

BACKFILL WORK ORDER ISSUED

Date

DEPOSIT, \$

SEWER WORK ORDER ISSUED

Approved:

DATE 6/24/65 BY

Plan Approved

JUN 34

CITY OF
MOUNTLAKE TERRACE

J. Baker

APPLICATION

for

SIDE SEWER PERMIT

CARD No.

The City of Mountlake Terrace

OUTSIDE INSIDE REPAIRS

EASEMENT No.

OWNER L.A. Kent


HOUSE No. 21508 54 PL W

CONTRACTOR R. & M

PERMIT No. 3838

APPROVAL NO. ~~58142~~ 10 BLOCK No.

NAME ADD. MLT DIV # 32

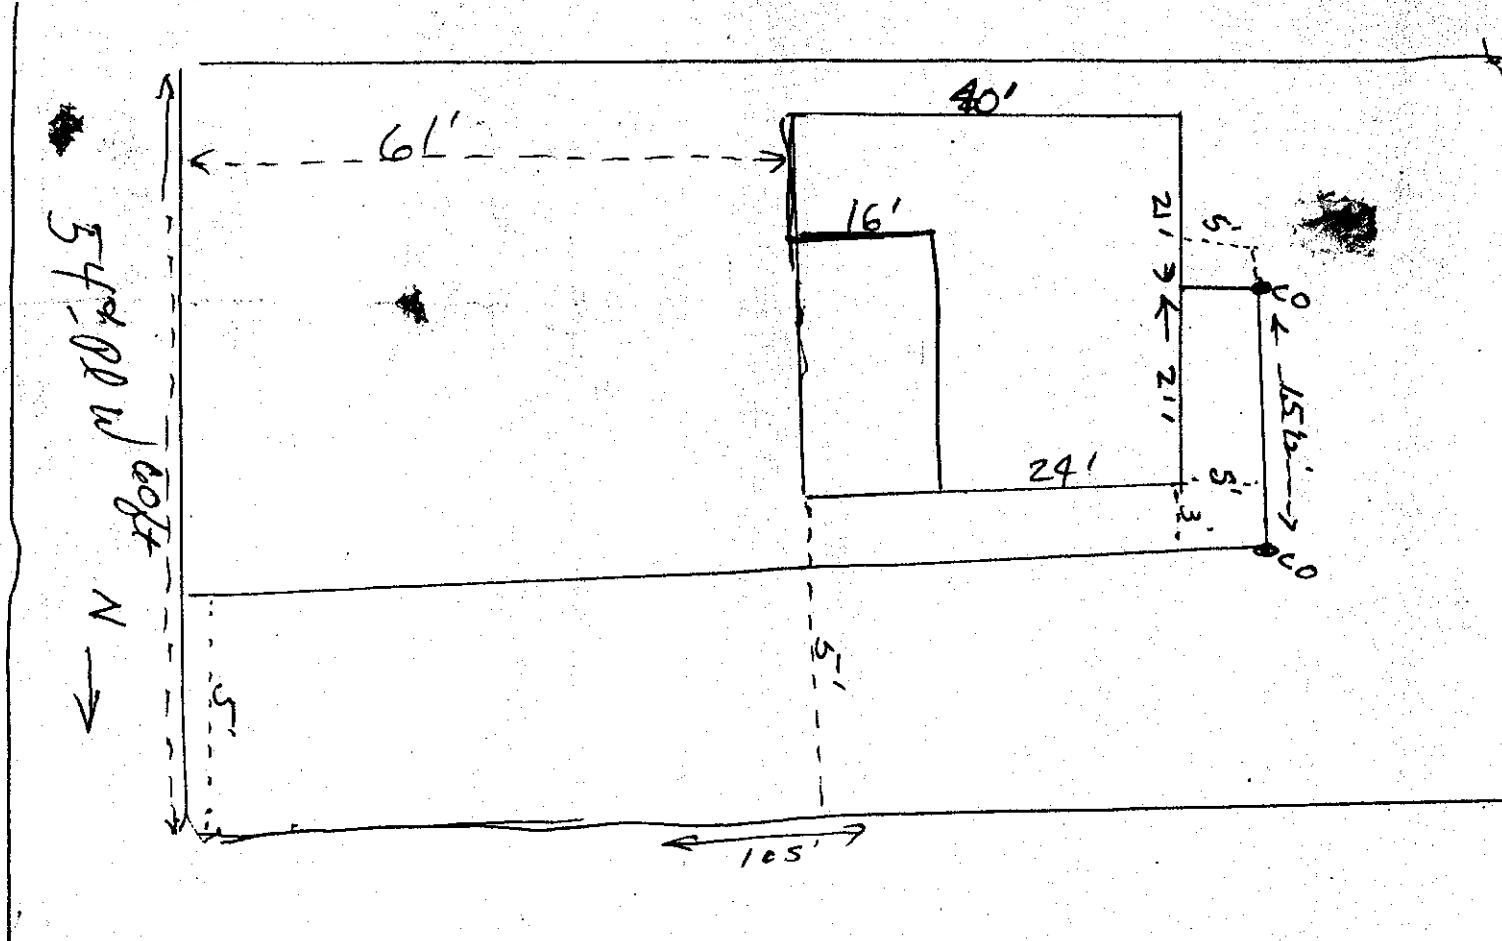

Date

Approved:

BACKFILL WORK ORDER ISSUED

DEPOSIT \$


SEWER WORK ORDER ISSUED

DATE 7-27-64

BY

R. Bahn

21509 54th PL W

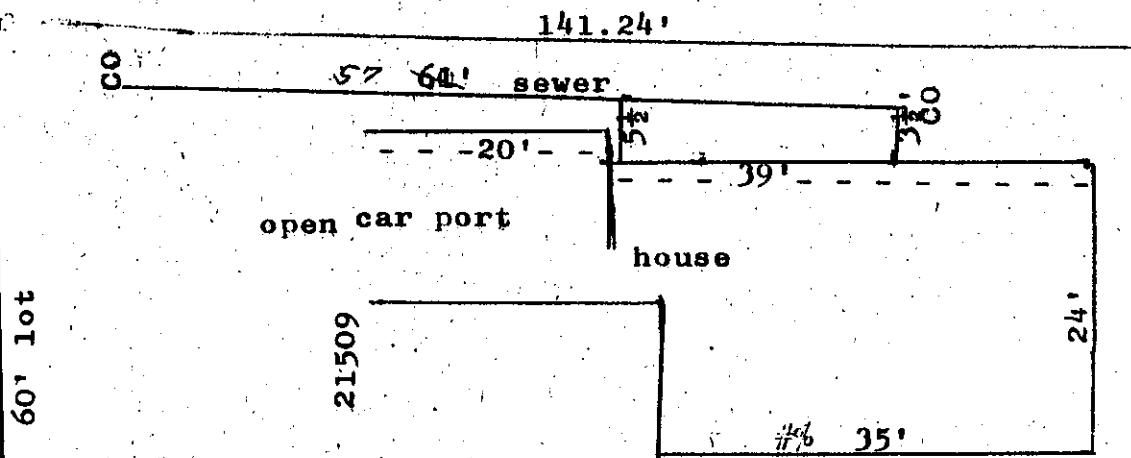

54th Pl West

The City of Mountlake Terrace

APPLICATION

for

SIDE SEWER PERMIT

OUTSIDE INSIDE REPAIRS

CARD No.

EASEMENT No.

OWNER D. L. Galliherth

HOUSE NO. 21510-54 PL. W.


CONTRACTOR

STREET
AVENUE LOT NO. 11

PERMIT No. 3759

BLOCK NO.

NAME ADD. MLT DIN # 32

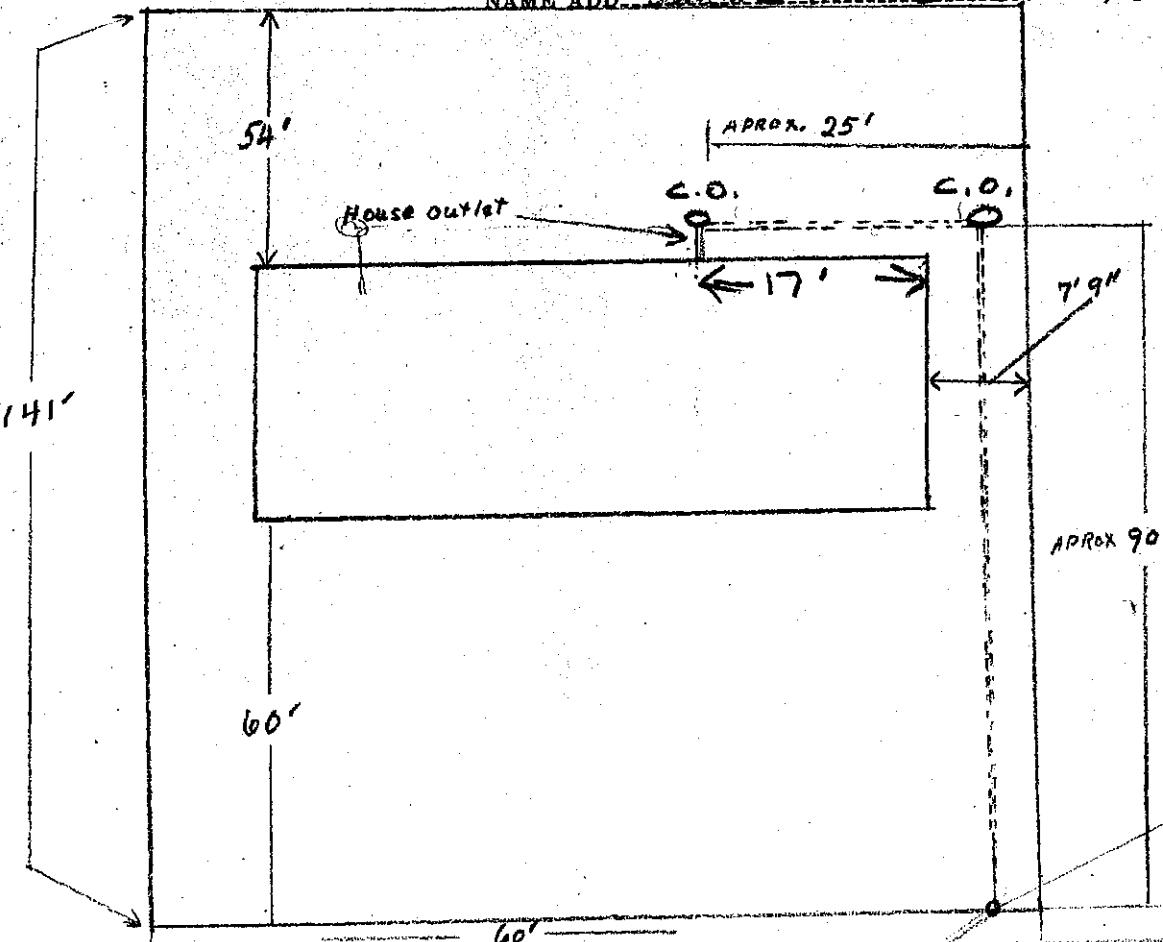

54th PL. W. STREET

Date

SEWER MAIN

NORTH →

Approved:

DATE

4-29-64 BY [Signature]

BACKFILL WORK ORDER ISSUED

DEPOSIT, \$

SEWER WORK ORDER ISSUED

The City of Montlake Terrace

APPLICATION

for

SIDE SEWER PERMIT

OUTSIDE INSIDE REPAIRS

CARD NO.

EASEMENT No.

None

OWNER W. T. CLARKE

HOUSE No. 2141 54TH PL. W.

CONTRACTOR HILL'S CONSTRUCTION PERMIT NO. 1165

STREET

AVENUE LOT NO.

BLOCK No.

NAME ADD. LOT #2 MONTLAKE TERRACE DIV. 32


CITY OF
MONTLAKE TERRACE

NOV 17 1959

Plan Approved.

J. Fairless

S.M.

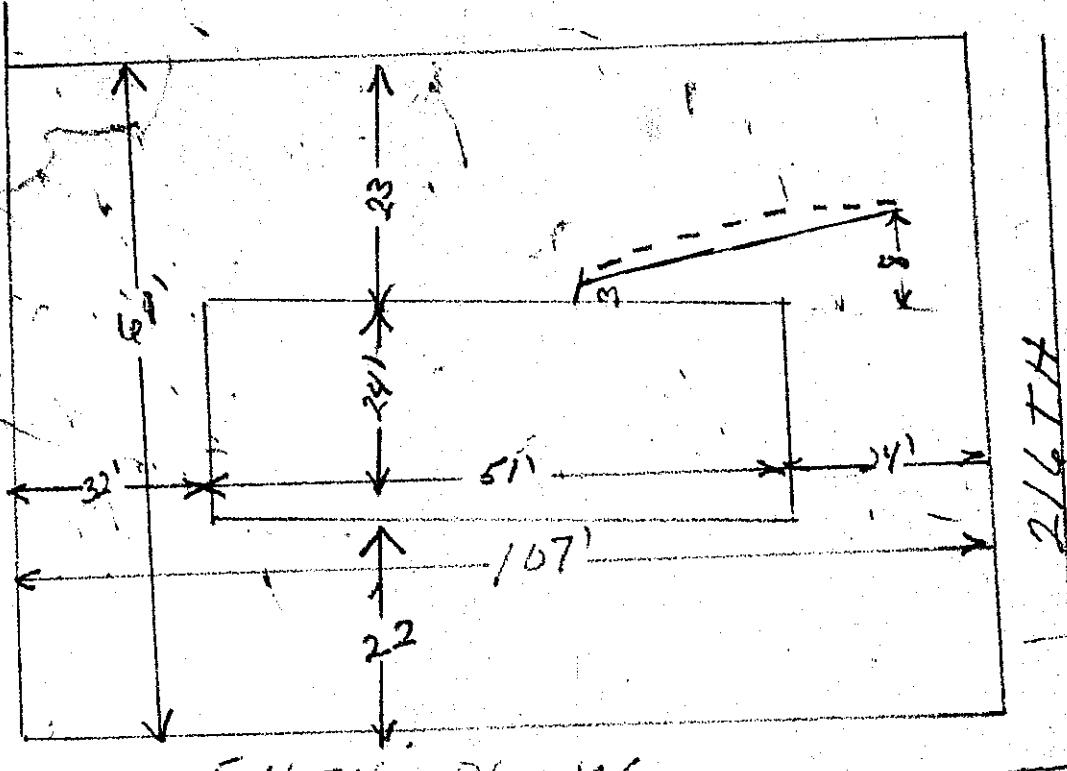

54TH PL. W

T 1165 - N.C

Date

Approved:

BACKFILL WORK ORDER ISSUED

SEWER WORK ORDER ISSUED

DEPOSIT, \$ 10.00

11-16-59

11-17-59

5392 DATE

BY

4-13-62 S.M.H. O.K.

APPLICATION

for

SIDE SEWER PERMIT

The City of Mountlake Terrace

CARD NO.

OUTSIDE INSIDE REPAIRS

EASEMENT No. 1389355

The City of Mountlake Terrace

OWNER

G. W. Billquist

HOUSE No. 21512 54th Pl. West

CONTRACTOR

STREET
AVENUE LOT No.

NAME ADD.


M.L.T. #32

Top Notch Plumbing

PERMIT No.

2434

BLOCK NO.

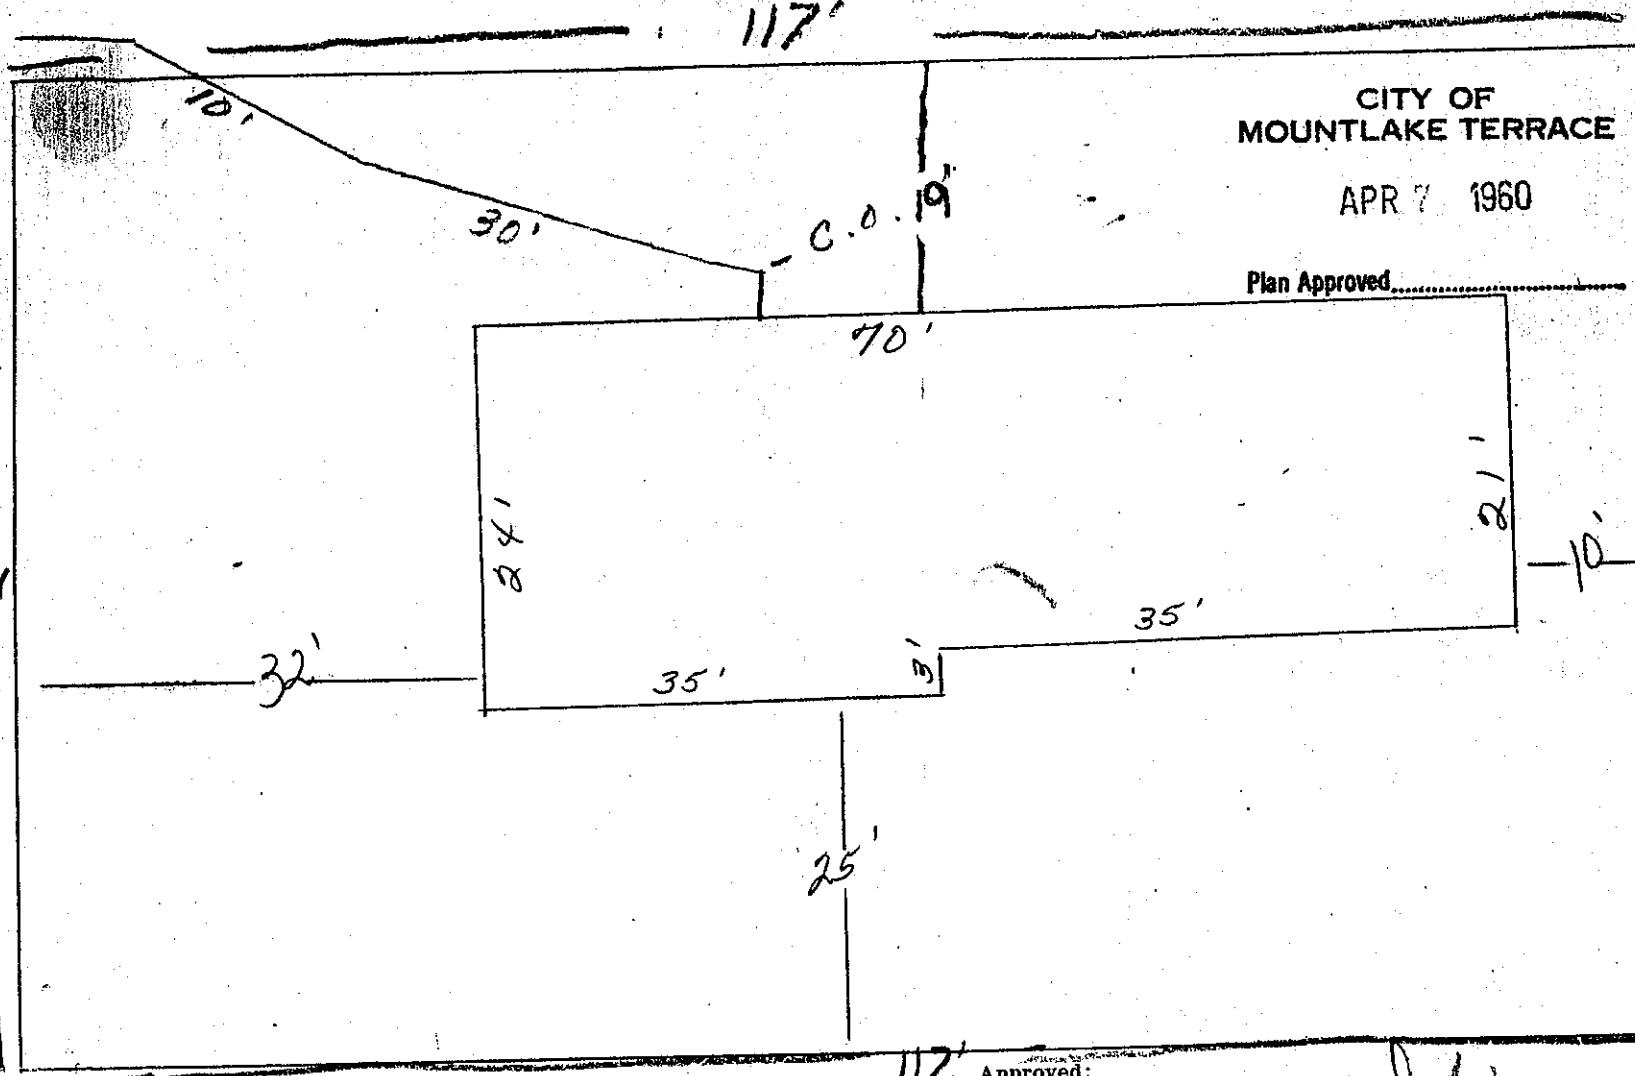

Date

Approved:

4/7/60

DEPOSIT \$10.00

BACKFILL WORK ORDER ISSUED

DATE 4/7/60 BY J. Morris

SEWER WORK ORDER ISSUED

1221

APPLICATION

FOR

SIDE SEWER PERMIT

OUTSIDE INSIDE REPAIRS

CARD NO.

The City of Mountlake Terrace

BASEMENT NO. 1357563

OWNER FRANK N. KARIS PERMIT NO. 2568

HOUSE NO. 21602-54


CONTRACTOR

STREET
AVENUE LOT NO.

SE 1/4 LOT 21

BLOCK NO.

NAME ADD Track 21, Seattle Heights Gardens

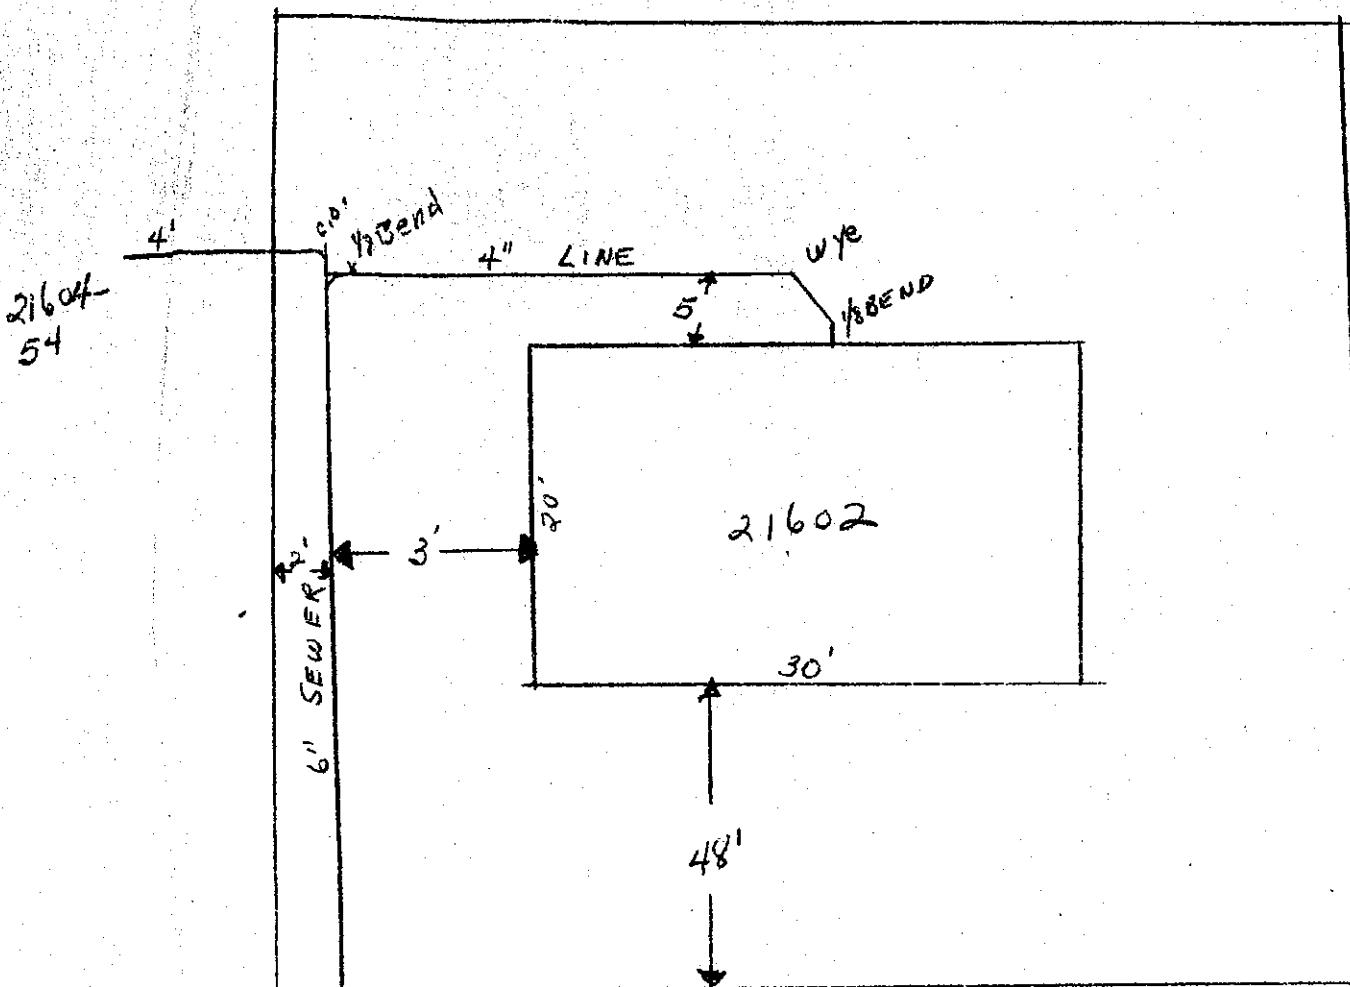CITY OF
MOUNTLAKE TERRACE

MAY 3 1960

Plan Approved, S. M. Holton

BACKFILL WORK ORDER ISSUED
SEWER WORK ORDER ISSUED

Date

DEPOSIT, \$10.00

Approved:

4/27/60

1339

DATE 5-3-60

BY

S. M. Holton, INST CON

The City of Mountlake Terrace

APPLICATION

for

SIDE SEWER PERMIT

OUTSIDE INSIDE REPAIRS

J. C. BARRETT
CARD No.

EASEMENT No. 135-7563

OWNER J. C. BARNETT

HOUSE No. 3160 1/2 W. 54

CONTRACTOR

STREET


AVENUE LOT NO.

NAME ADD

PERMIT No. 2567

BLOCK NO.

E 1/2 OF N 1/2 OF TRACT 22 - Seattle Lights Gas Co.

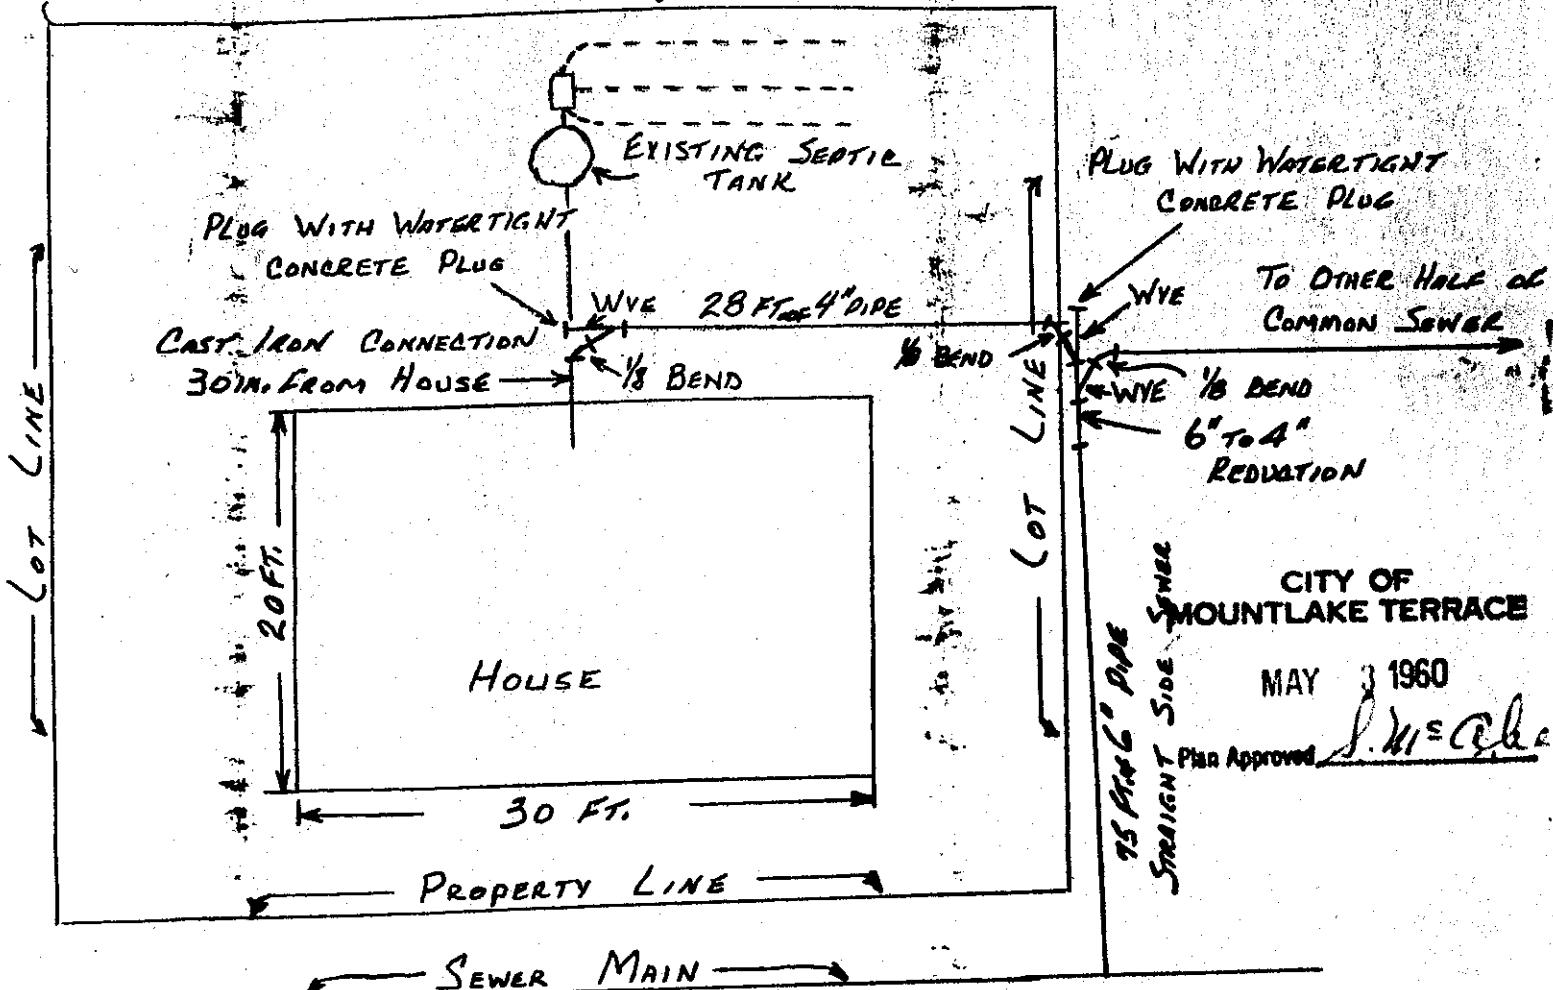

BACKFILL WORK ORDER ISSUED
SEWER WORK ORDER ISSUED

Date

DEPOSIT \$10.00

Approved:

DATE 5-3-60

BY J. M. Holton INST CON

1334

The City of Mountlake Terrace

APPLICATION

for

SIDE SEWER PERMIT

OUTSIDE INSIDE REPAIRS

CARD NO.

EASEMENT No. None

OWNER

Jess Randall Casey

CONTRACTOR

Wingfield

PERMIT No.

HOUSE NO.

21605 - 54th W.


STREET

AVENUE LOT NO. West 1/2 of 19

BLOCK NO.

NAME ADD.

Seattle Heights Gardens

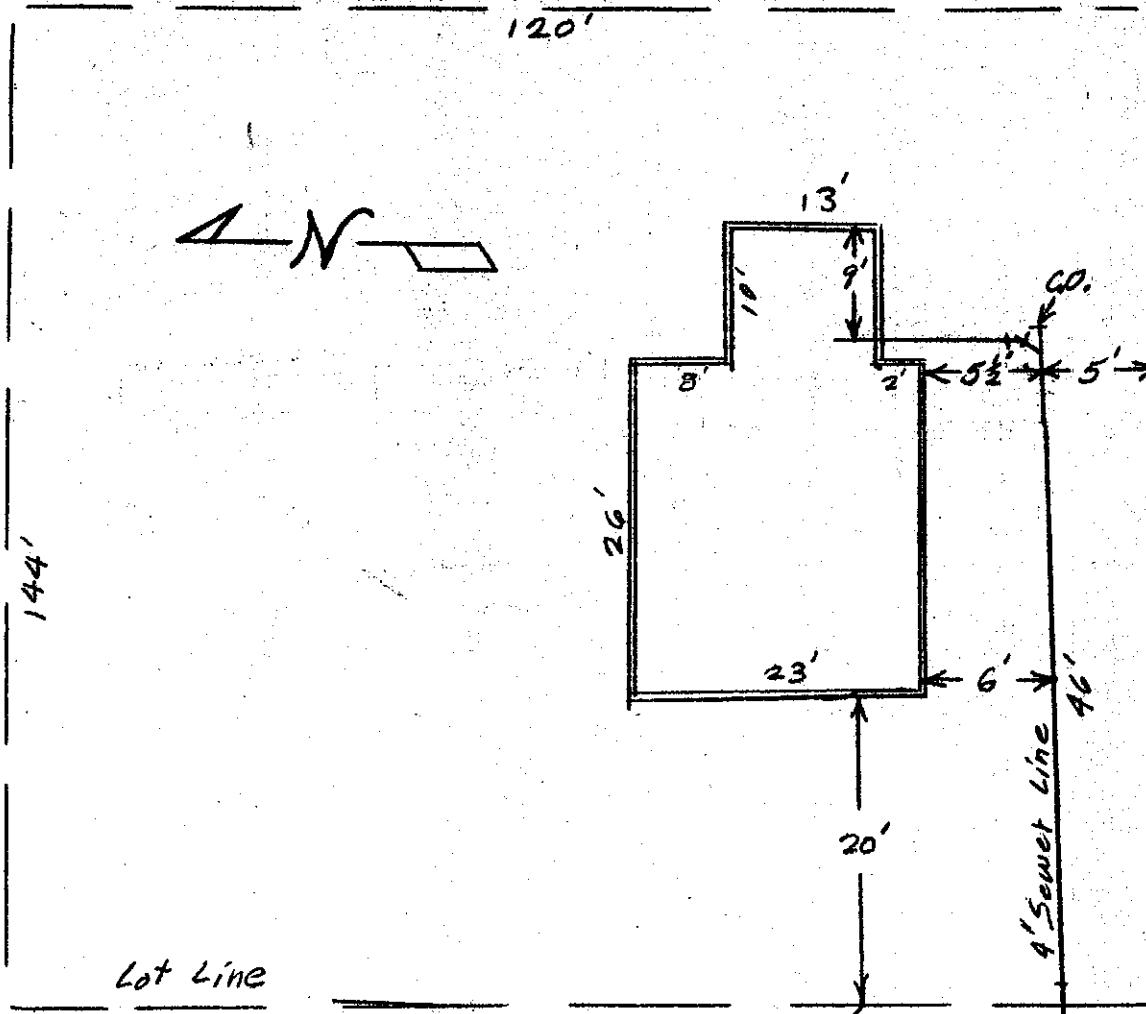

Date

54th W.

Approved:

DATE 12-2-60 BY

BACKFILL WORK ORDER ISSUED

DEPOSIT \$ 10,00

SEWER WORK ORDER ISSUED

12/2/60
#2057

S. M. Holton

N.W.VER

CARD No.

The City of Mountlake Terrace

APPLICATION

for

SIDE SEWER PERMIT

OUTSIDE INSIDE REPAIRS

BASEMENT No.

1359970

OWNER

H. Werner

CONTRACTOR

PERMIT NO.

HOUSE NO.

29608 54 W

STREET


AVENUE LOT No.

1/2 of E 1/2 of lot #23

BLOCK NO.

NAME ADD

Seattle Heights Gardens

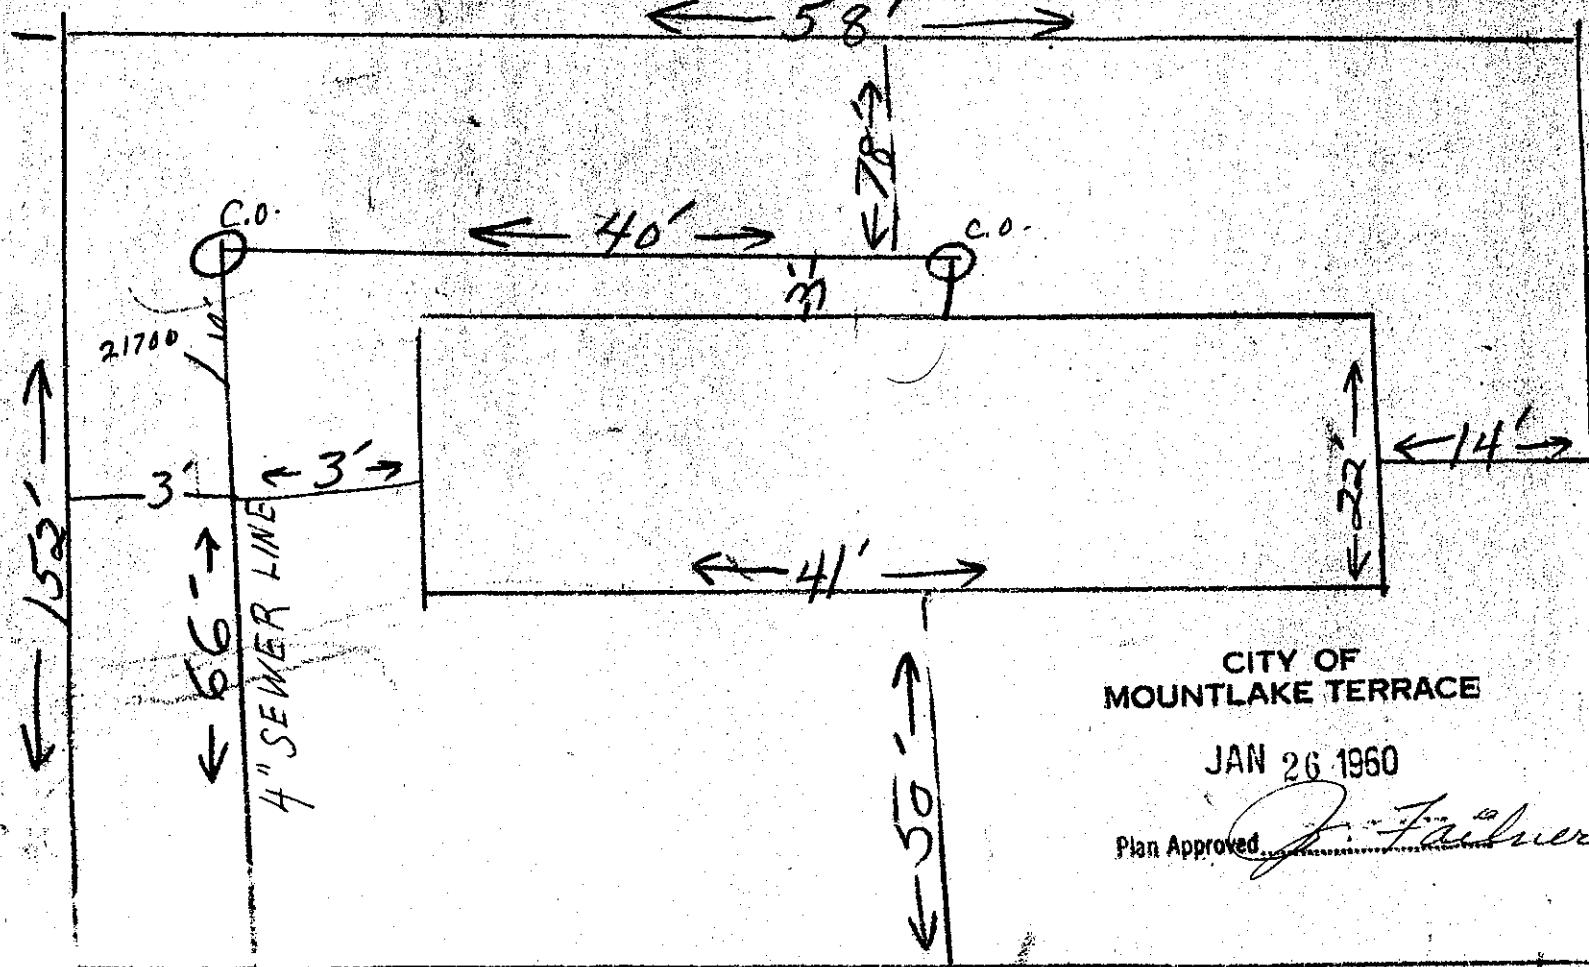CITY OF
MOUNTLAKE TERRACE

JAN 26 1960

Plan Approved.

J. Failler

Date

Approved:

BACKFILL WORK ORDER ISSUED

DEPOSIT, \$ 10.00

SEWER WORK ORDER ISSUED

1/25/60

DATE

1-26-60 BY Scott m Holton INS ALL.

The City of Mountlake Terrace

APPLICATION

for

SIDE SEWER PERMIT

OUTSIDE INSIDE REPAIRS

CARD No.

EASEMENT NO. ~~None~~

OWNER E. PETERSON

HOUSE No. 21609 W. 54TH.

CONTRACTOR HILL'S CONSTRUCTION


PERMIT No. 1161

STREET

AVENUE LOT No.

BLOCK No.

NAME ADD THE N. 1/2 of the W. 1/2 of lot (18) Seattle
Alights Gardens recorded in Vol. 9 of plots page 14,

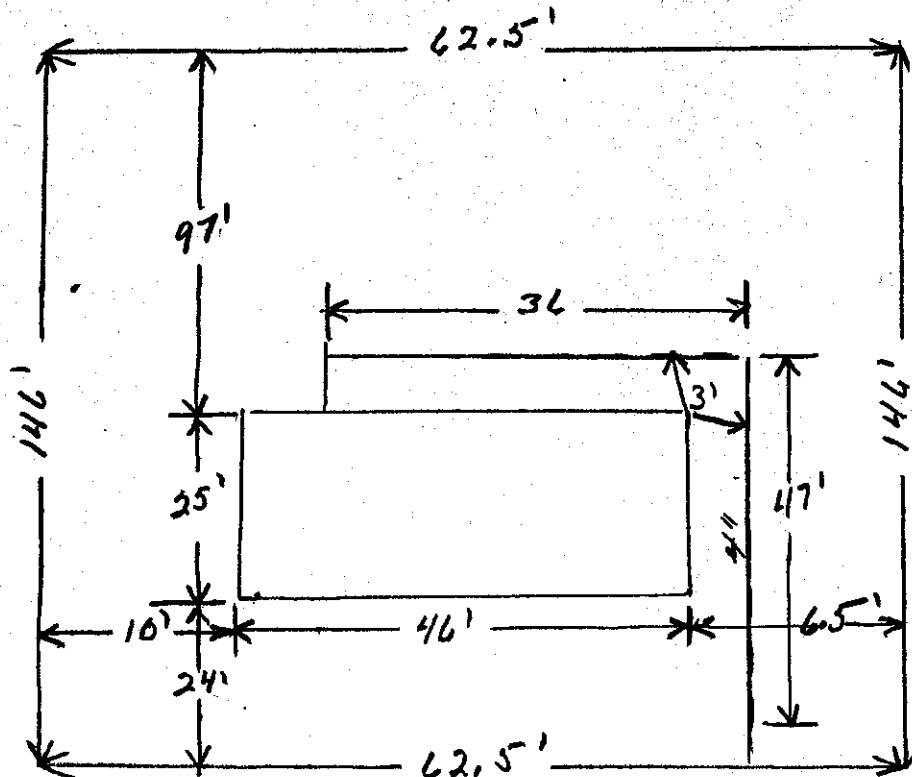

CITY OF
MOUNTLAKE TERRACE

NOV 17 1959

Plan Approved

J. Fairnes
SM

TNSP - N.C.

BACKFILL WORK ORDER ISSUED

SEWER WORK ORDER ISSUED

Date

DEPOSIT, \$10⁰⁰ 11-16-59

Approved:

5386 DATE

11-17-59 BY J. Fairnes

APPLICATION

for

SIDE SEWER PERMIT

The City of Mountlake Terrace

CARD NO.


1359970

OUTSIDE INSIDE REPAIRS

EASEMENT NO.

OWNER Carl M. Ross
HOUSE NO. 21700 54WCONTRACTOR Evergreen Const
STREET 1/2 of E. 1/2 of lot # 23
AVENUE LOT NO. BLOCK NO.

NAME ADD Seattle Heights Gardens

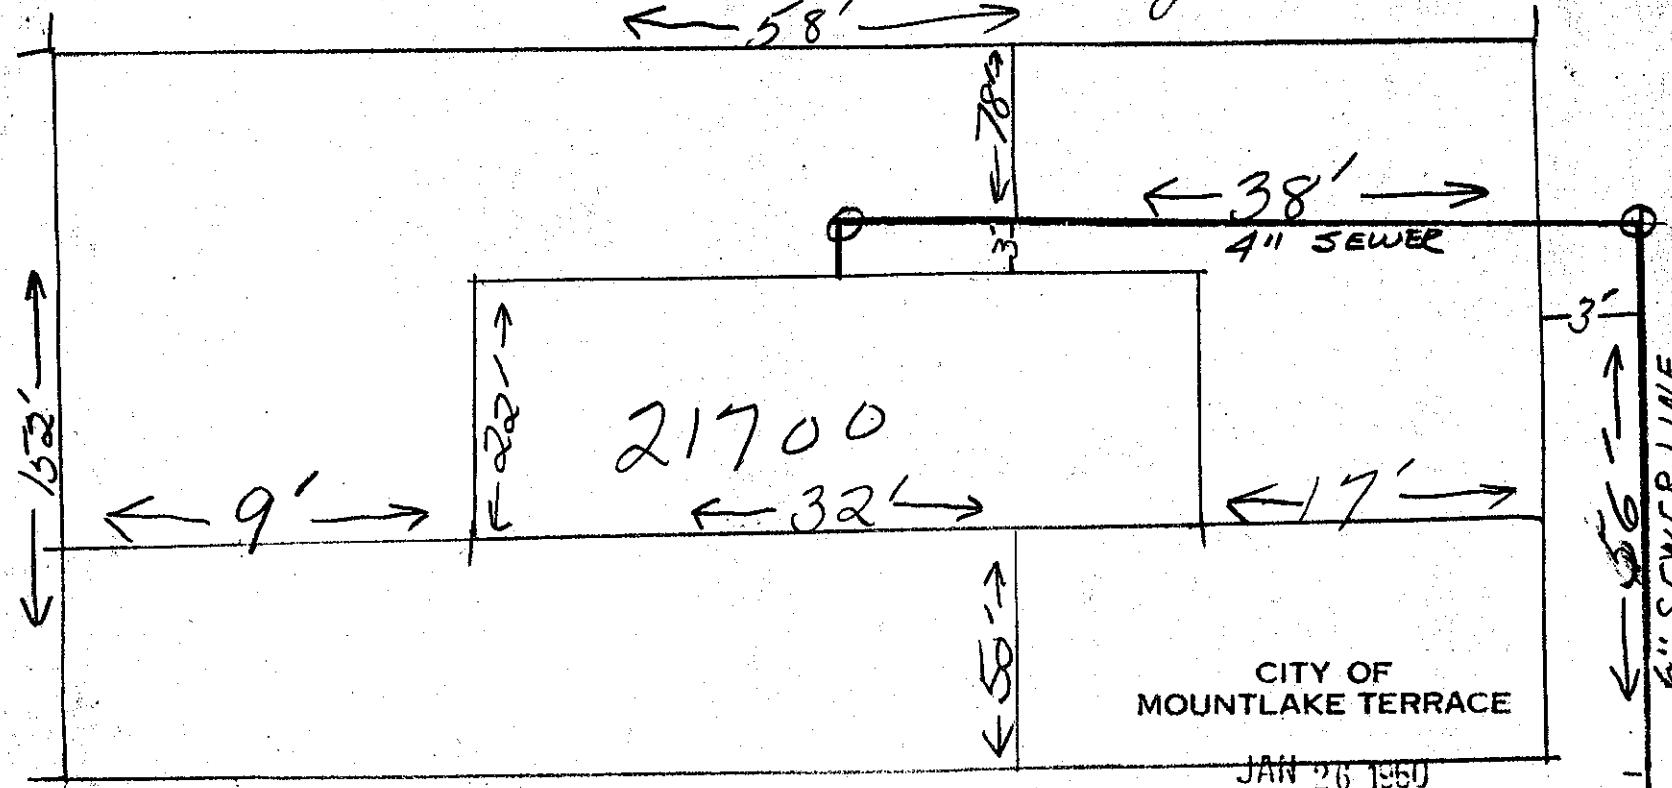CITY OF
MOUNTLAKE TERRACE

JAN 26 1960

Plan Approved,

J. M. Ghee

54W

Approved:

DATE

1-26-60 BY Scott M Holton INS N.C.

BACKFILL WORK ORDER ISSUED

SEWER WORK ORDER ISSUED

Date

DEPOSIT \$ 10,00

71563

1/25/60

The City of Mountlake Terrace

APPLICATION

for

SIDE SEWER PERMIT

OUTSIDE INSIDE REPAIRS

Dewey Shay

CARD No.

EASEMENT No.

OWNER Dewey Shay
HOUSE No. 21704 - 54th w.

CONTRACTOR

B. & C.

STREET So. 1/2 of Ctr. 1/2 of LOT 24


AVENUE LOT No.

PERMIT No. 1834

BLOCK No.

NAME ADD

Seattle Heights Gardens

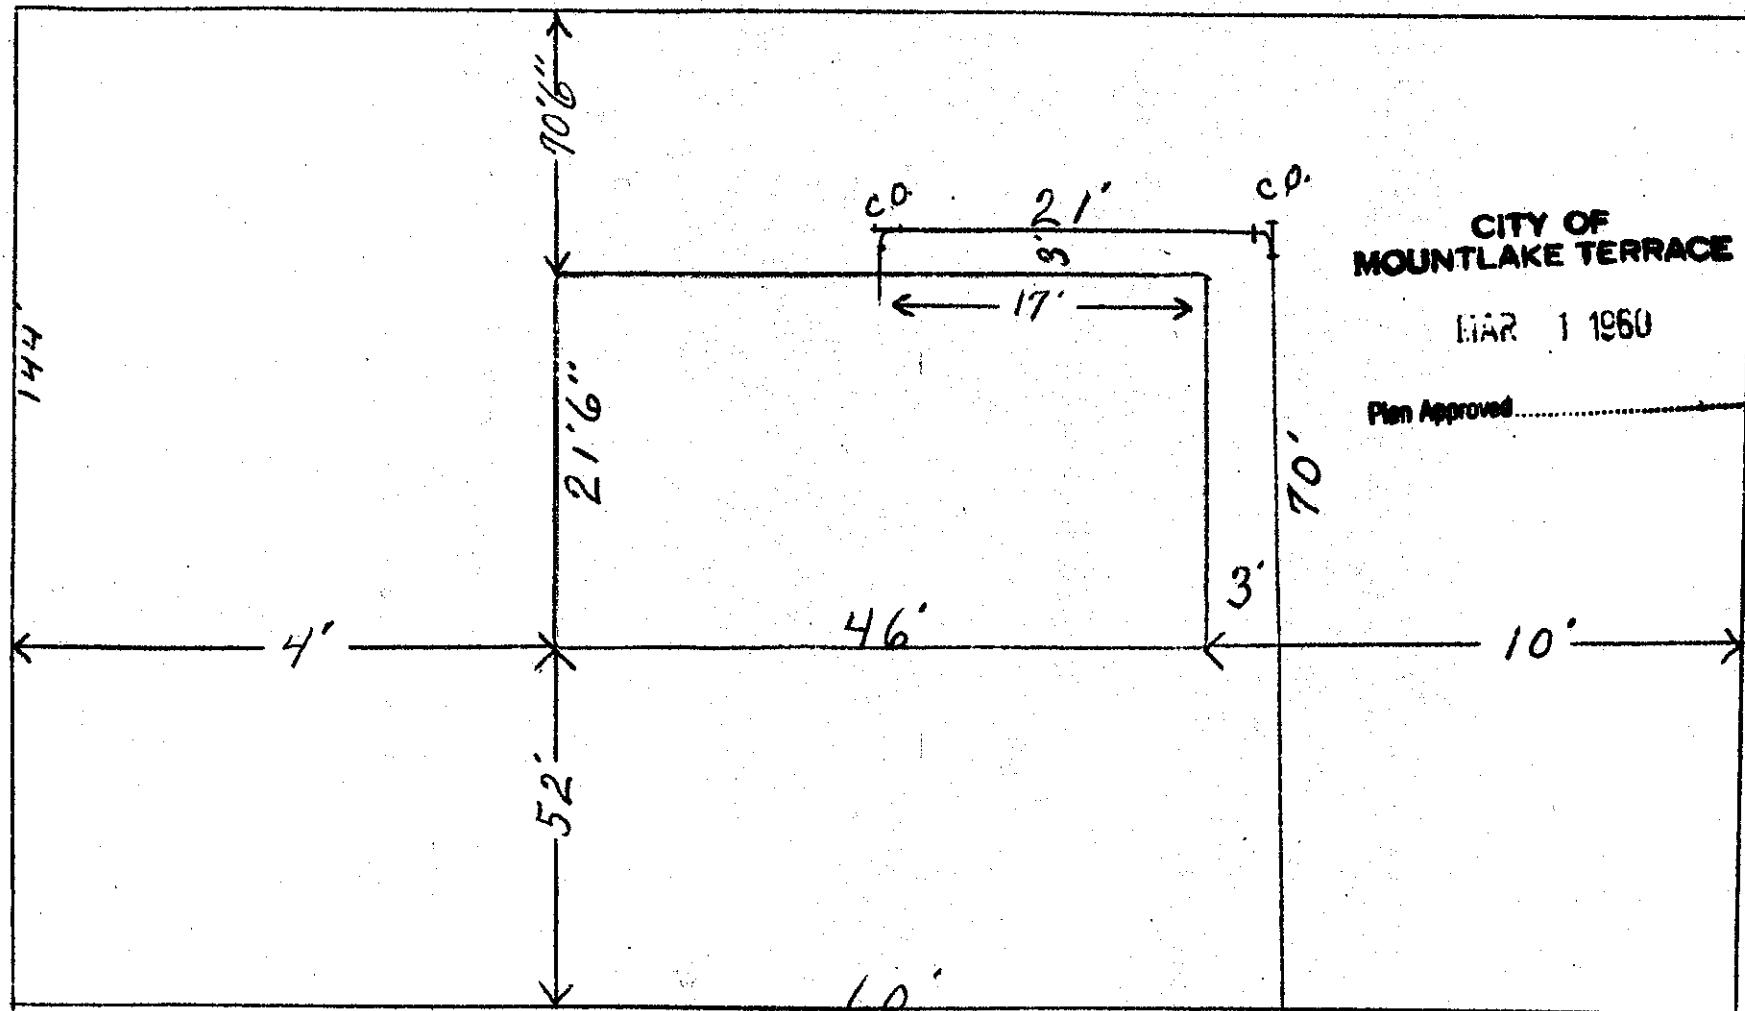

Date

BACKFILL WORK ORDER ISSUED

DEPOSIT, \$ 10.00

SEWER WORK ORDER ISSUED

2-29-60
Rec. 701

Approved:

DATE 3/1/60

BY

J. Hansen, wife + Con

David Coolidge

The City of Mountlake Terrace

PR8-7662

APPLICATION

for

SIDE SEWER PERMIT

OUTSIDE INSIDE REPAIRS

CARD No.

EASEMENT No.

COOLIDGE ✓

OWNER David Coolidge

CONTRACTOR Currier

PERMIT No.

HOUSE No. 21707 - (C) 59

STREET Avenue LOT No. #16


BLOCK No. 117

24

NAME ADD.

MA SAME

Seattle Heights Gardens
No. 1/2 of west 1/2 of lot 16

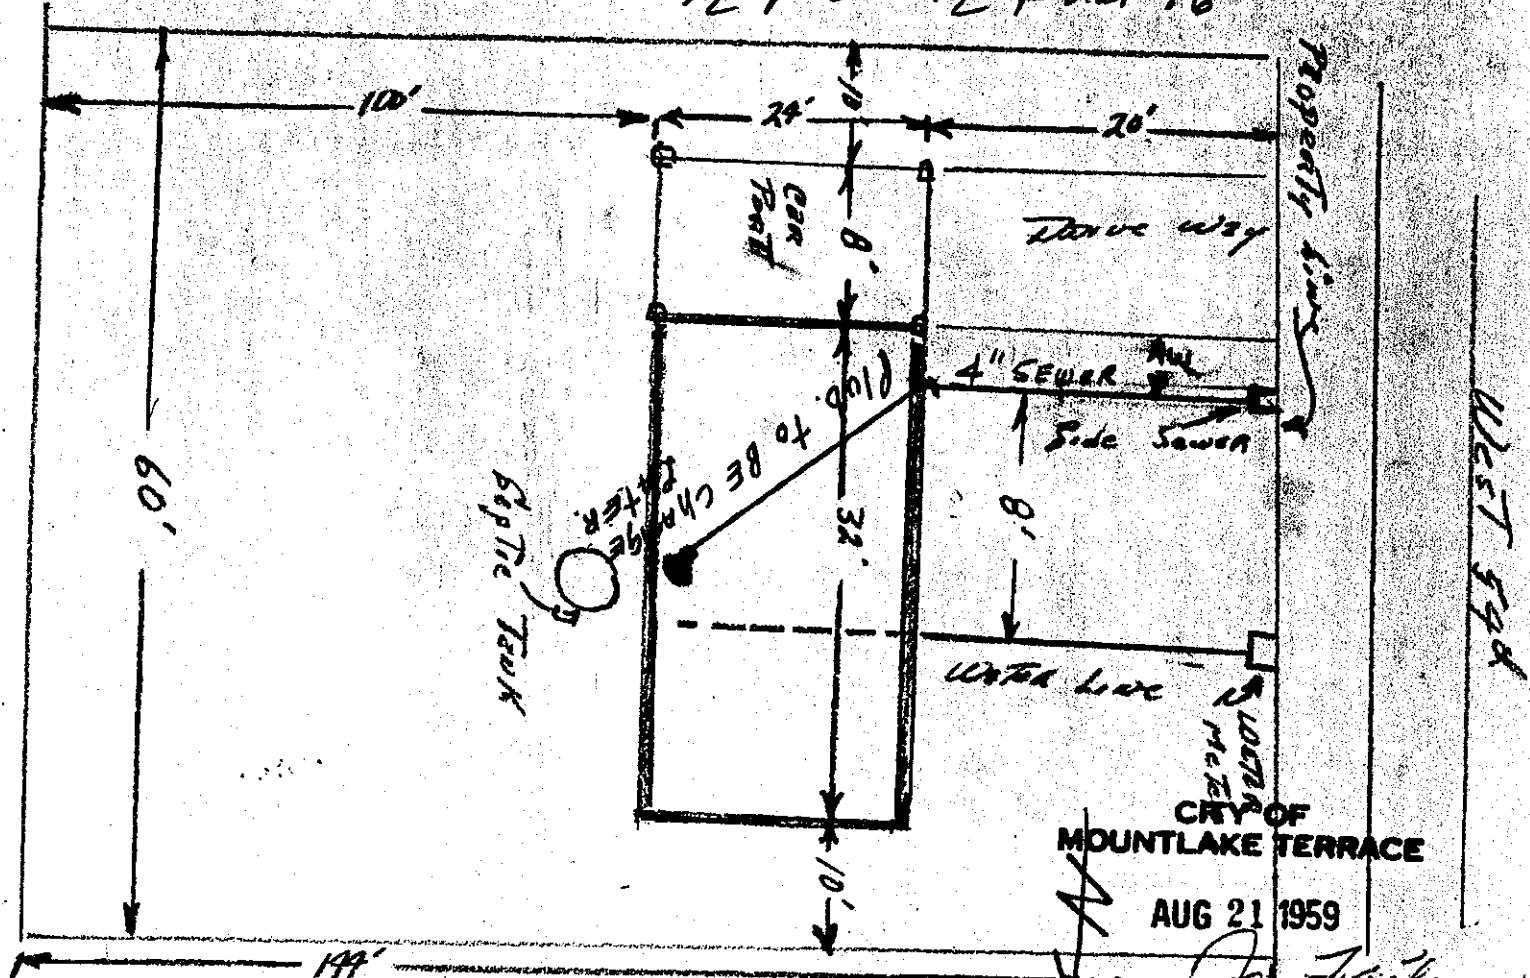

Date

Approved:

BACKFILL WORK ORDER ISSUED

DEPOSIT, \$10.00 8-18-59

SEWER WORK ORDER ISSUED

3905

DATE

8/21/59

BY

Hansen

The City of Mountlake Terrace

APPLICATION

for

SIDE SEWER PERMIT

OUTSIDE INSIDE REPAIRS

CARD NO.

BASEMENT NO. ~~2167~~

OWNER CHARLES W HINDMAN

HOUSE No. 21709 - 54 ac w.

CONTRACTOR *Hibbard*


STREET

AVENUE LOT No. 2167

PERMIT NO. 28

NAME ADD.

BLOCK No. 217

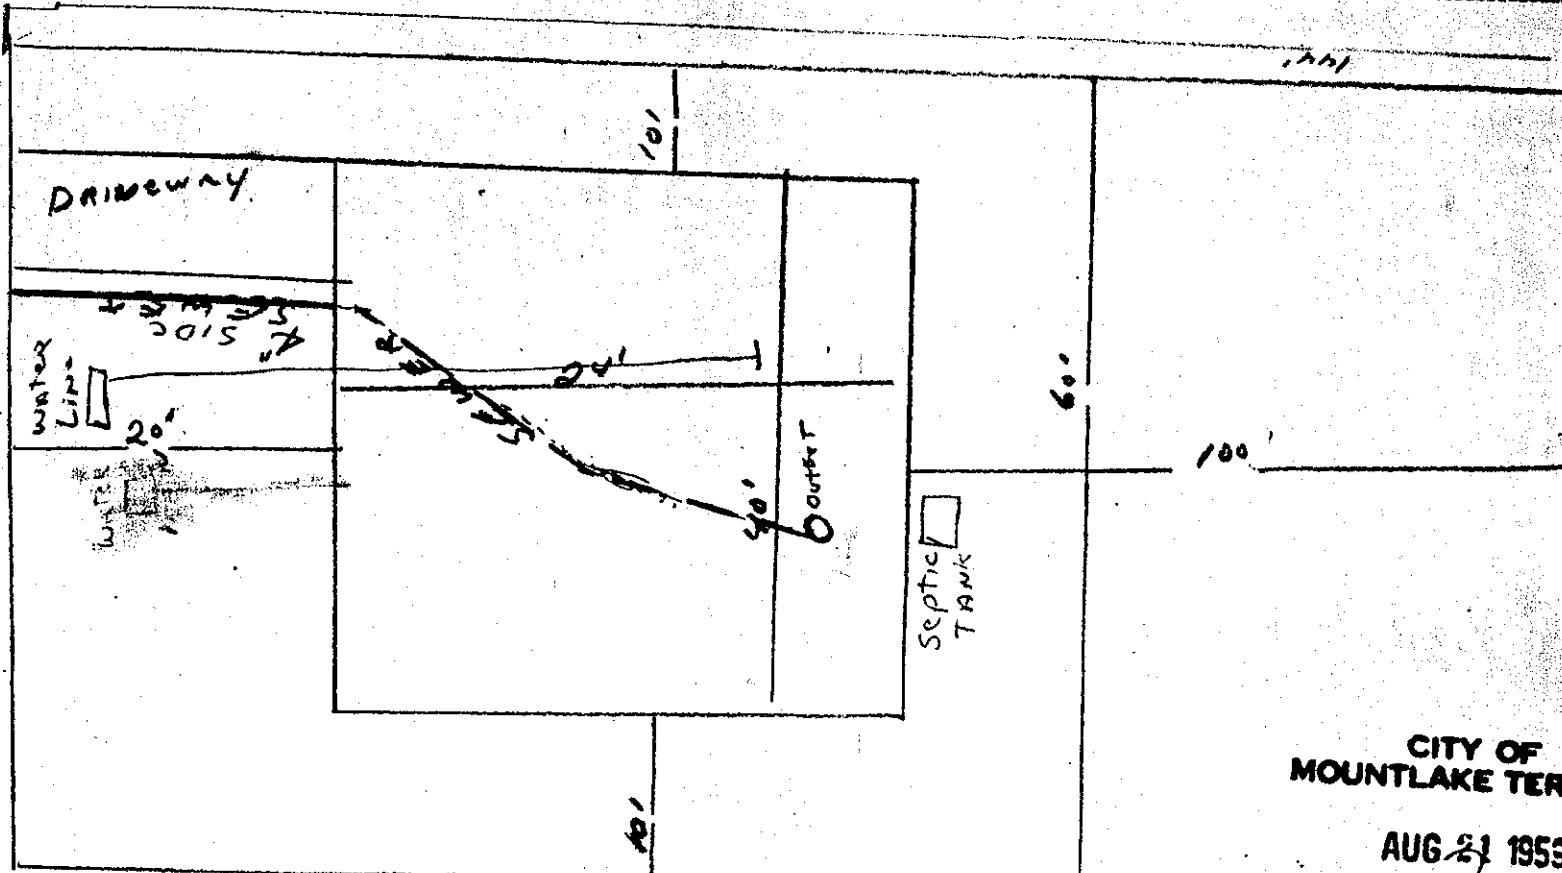

CITY OF
MOUNTLAKE TERRACE

AUG 21 1959

Plan Approved for failure

Date

Approved:

BACKFILL WORK ORDER ISSUED

DEPOSIT, \$10⁰⁰ 8-18-59

SEWER WORK ORDER ISSUED

DATE 8/21/59 BY

J. L. Hansen

NEP 10/20/01

The City of Mountlake Terrace

APPLICATION

for

SIDE SEWER PERMIT

OUTSIDE INSIDE REPAIRS

CARD NO.

EASEMENT No. 142-0142

OWNER Boyce Bradley
HOUSE No. 21801 - 54th & W


CONTRACTOR Manor Const. Co.

STREET 70 $\frac{1}{2}$ & 70 $\frac{1}{2}$ 15
AVENUE LOT NO.

PERMIT NO. 160

BLOCK No.

NAME ADD. Seattle Heights

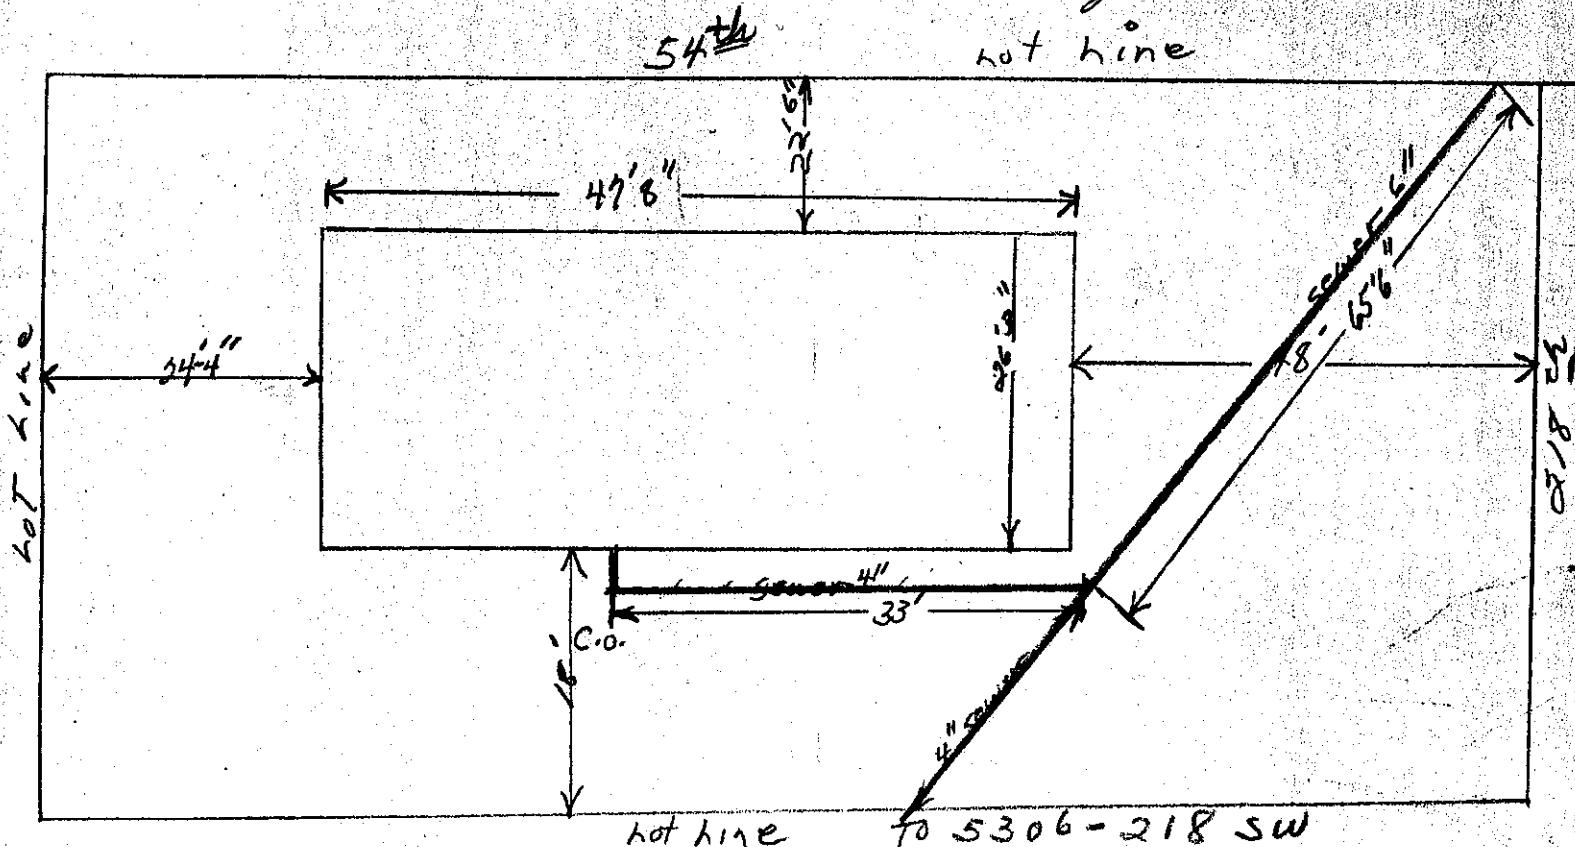

Date

Approved:

BACKFILL WORK ORDER ISSUED

DEPOSIT, \$ 10.00

SEWER WORK ORDER ISSUED

1898

DATE 9-22-60 BY S. Mr. Holton INS-COR

The City of Mountlake Terrace

APPLICATION

for

SIDE SEWER PERMIT

OUTSIDE INSIDE REPAIRS

CARD No.

EASEMENT No. 1349102

OWNER LAWRENCE E. + VIRGINIA G. SIMPSON

HOUSE NO. 21802 W 54

CONTRACTOR

STREET SOUTH HALF OF THE

AVENUE LOT NO. EAST HALF OF LOT 26 BLOCK NO. V


PERMIT NO. 11

JOINT SEWER

NAME ADD.

54th West

PROPERTY LINE

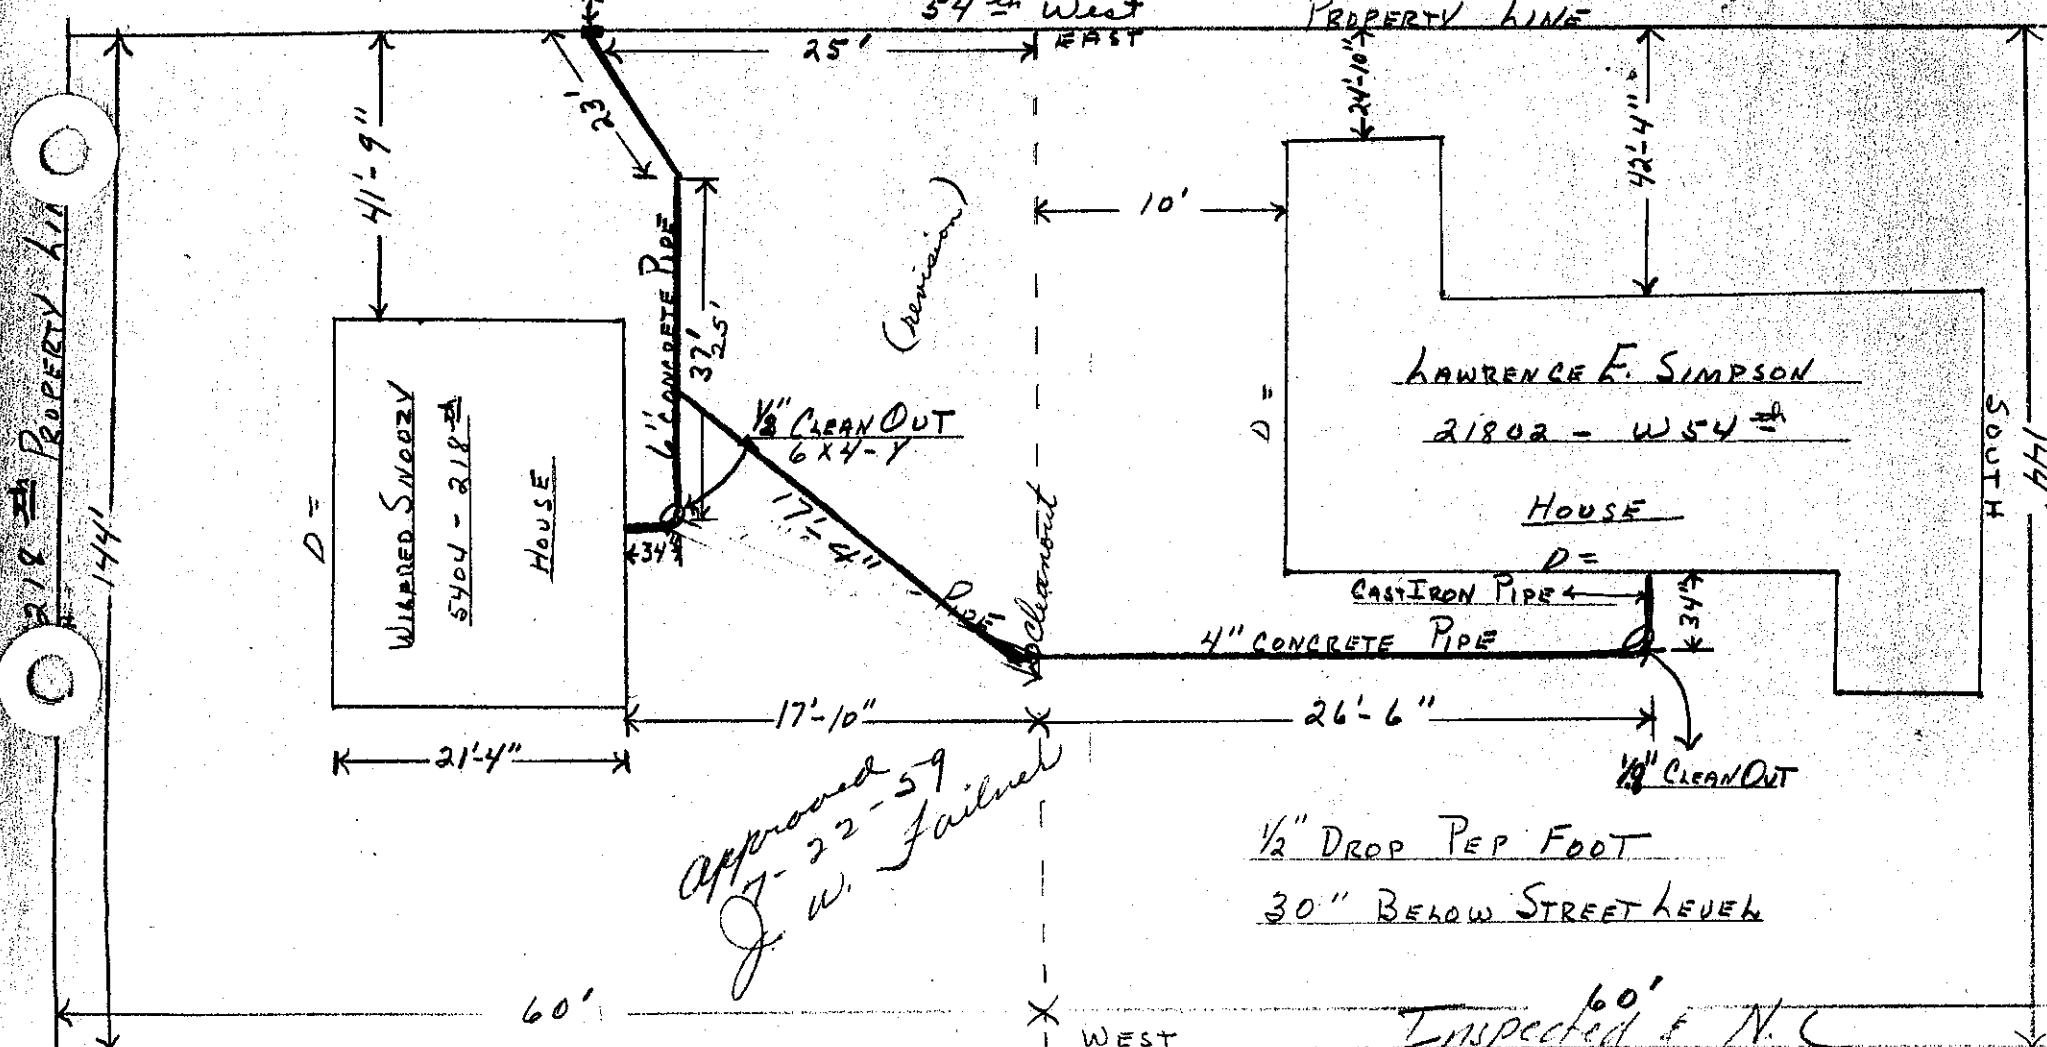

Date

Approved:

BACKFILL WORK ORDER ISSUED

DEPOSIT, \$10⁰⁰ 7-22-59

SEWER WORK ORDER ISSUED

3777

DATE

9/15/59

BY

60' Inspected & N.C.

B. Smith

The City of Mountlake Terrace

APPLICATION

for


SIDE SEWER PERMIT

OUTSIDE INSIDE REPAIRS

CARD No.

BASEMENT No. 1358-134

OWNER W. J. Daig - ^{wife} CONTRACTOR Owner
HOUSE No. 21808 W 54 STREET PERMIT NO. 838
AVENUE LOT NO. N¹ E² Lot 28 BLOCK NO.
NAME ADD. Seattle Heights Gardens

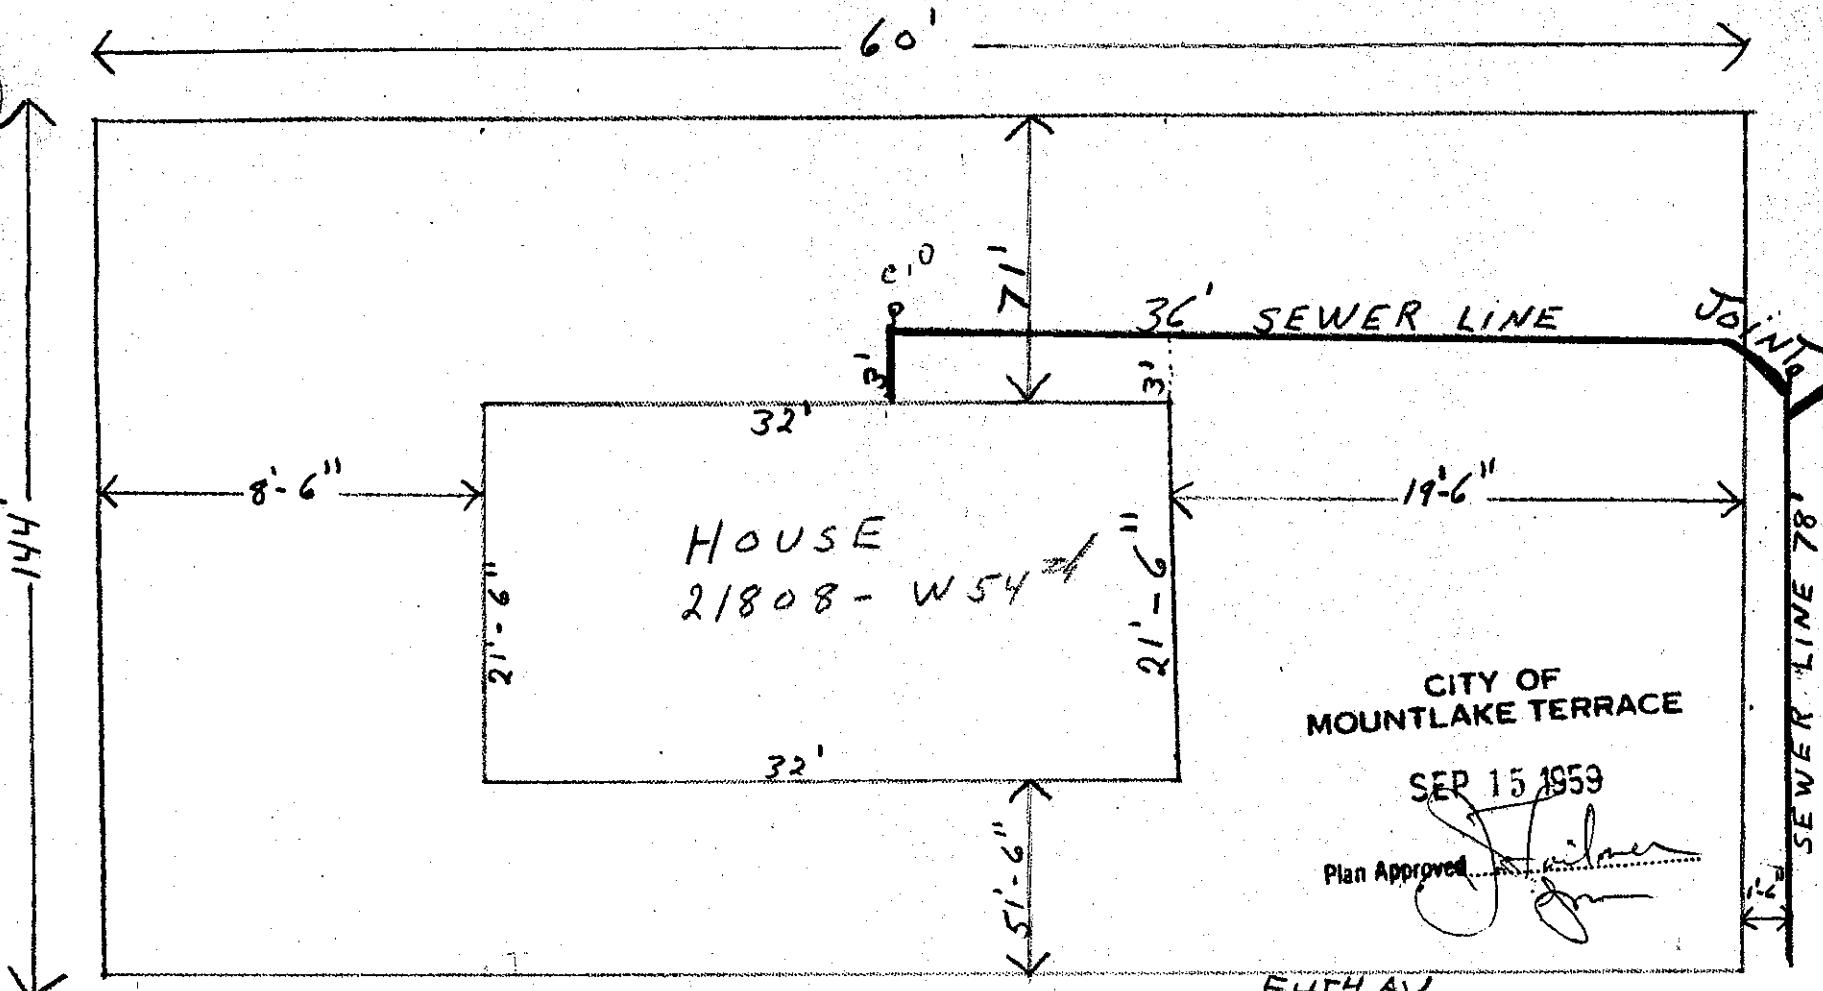

Date

Approved:

BACKFILL WORK ORDER ISSUED

DEPOSIT \$ 10⁰⁰ 9/4/59

64TH AV

SEWER WORK ORDER ISSUED

4839

DATE 2-4-60

BY Scott m Hollon FINAL COUNT MVS

The City of Mountlake Terrace

APPLICATION

for

SIDE SEWER PERMIT

OUTSIDE INSIDE REPAIRS

DeShon + Shaffer, INC.

CARD NO.

EASEMENT No. None

OWNER De Shon & Shaffer Inc.
HOUSE NO. 21809 - 54th N.


CONTRACTOR Wingfield - Brown

STREET
AVENUE LOT NO. 13 South West

PERMIT NO. 2566

NAME ADD. Seattle Heights Gardens

BLOCK NO.

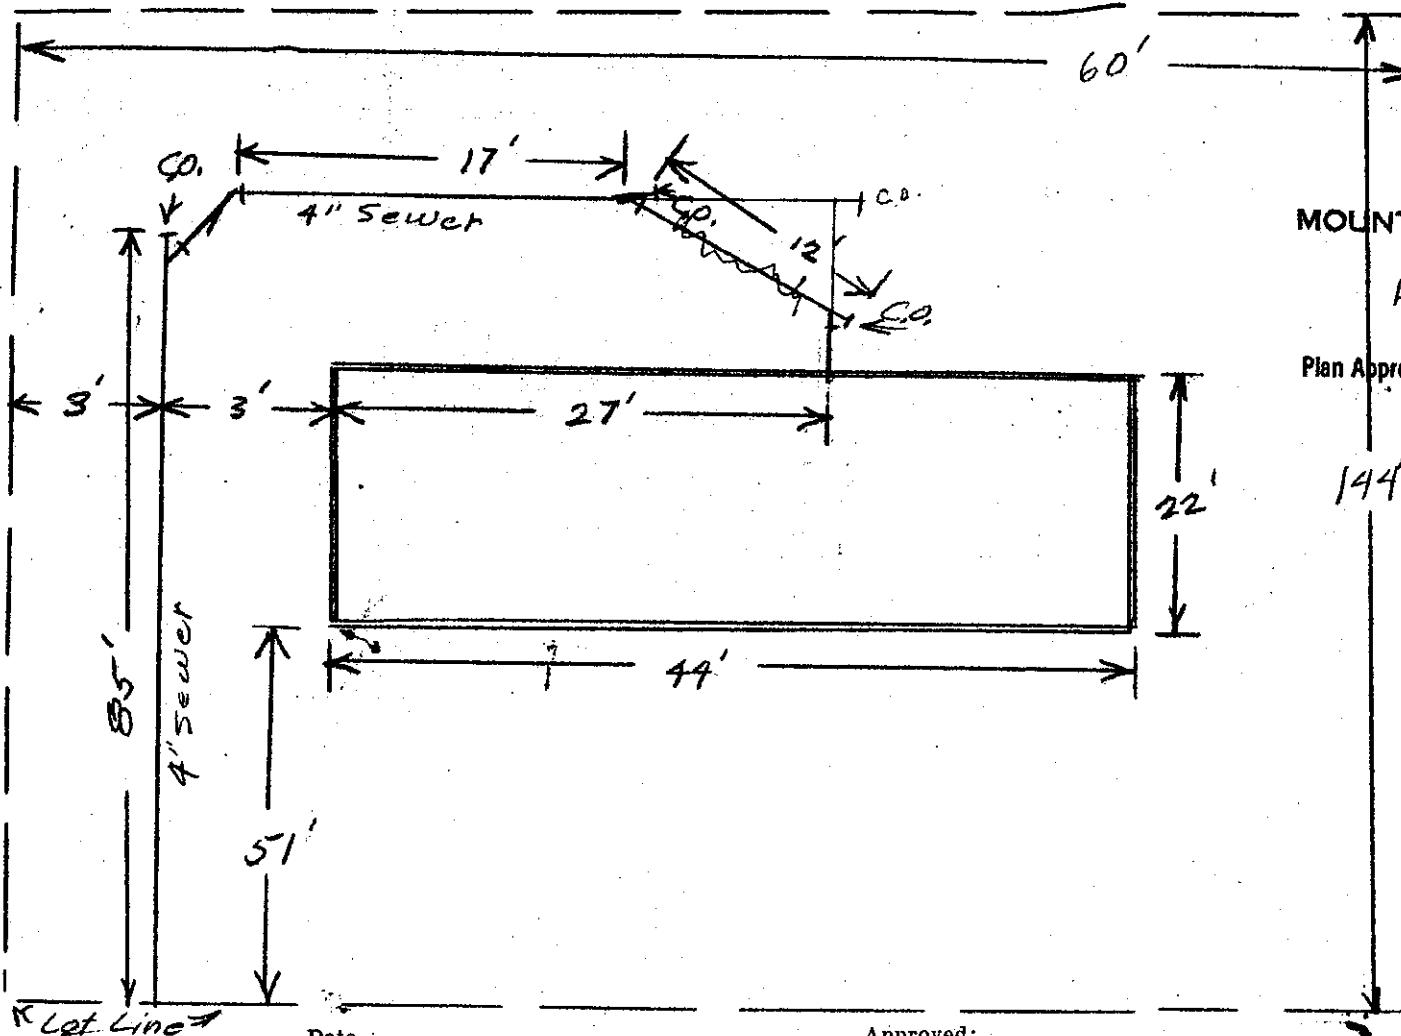

CITY OF
MOUNTLAKE TERRACE

APR 27 1960

Plan Approved,

J.M. Ahern

BACKFILL WORK ORDER ISSUED
SEWER WORK ORDER ISSUED

DEPOSIT, \$10.00

4/27/60

Approved:

1338

DATE 4-28-60

BY J. M. Holton INS + CON

John Jacobson

CARD No.

The City of Mountlake Terrace

APPLICATION

for

SIDE SEWER PERMIT

OUTSIDE INSIDE REPAIRS

EASEMENT NO.


852

OWNER John Jacobson

HOUSE NO. 21900 - 54th W. M.L.T.CONTRACTOR Band E Const 6304-222 ^{sec} MLT. PERMIT NO.

STREET AVENUE LOT NO. So 1/2 of C. 1/2 LOT 28 BLOCK NO.

NAME ADD Seattle Heights gardens

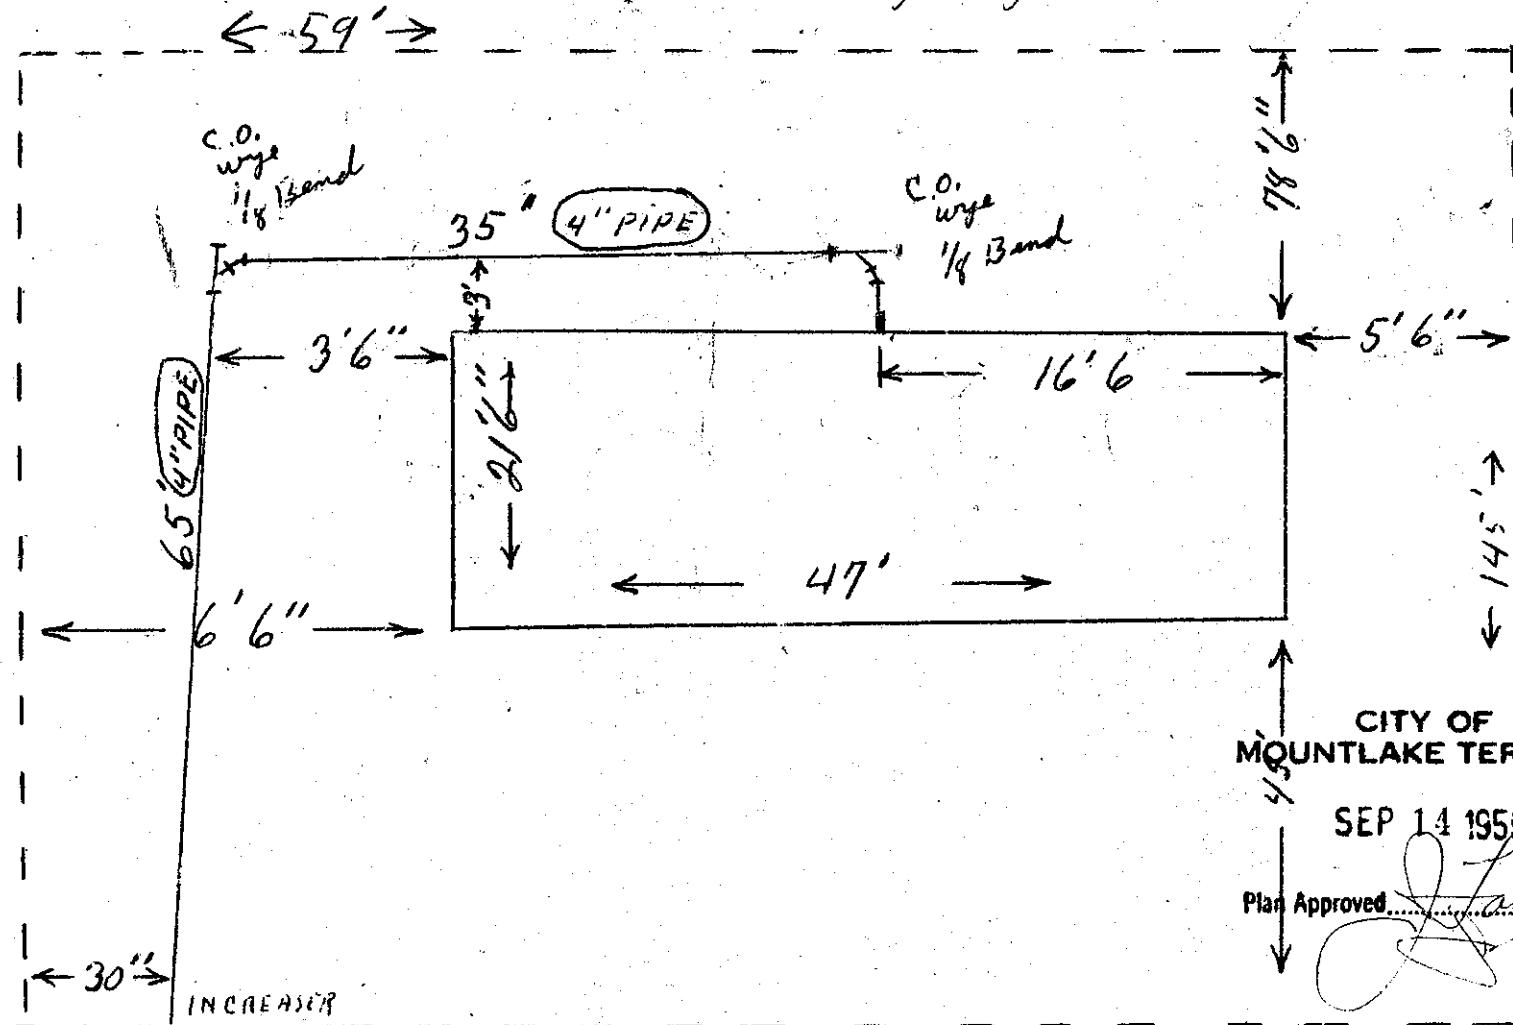CITY OF
MOUNTLAKE TERRACE

SEP 14 1959

Plan Approved.....

Date

Approved:

BACKFILL WORK ORDER ISSUED

DEPOSIT, \$

10.00 9/11/59

SEWER WORK ORDER ISSUED

DATE

7/15/59 BY 10/1/59

\$4728

3-8-1-8 INSTRUMENT & MATER

The City of Mountlake Terrace

APPLICATION

for

SIDE SEWER PERMIT

OUTSIDE INSIDE REPAIRS

CARD No.

EASEMENT No.

OWNER JACK E. HACKETT
HOUSE NO. 21921 - 54th West

CONTRACTOR

STREET

AVENUE LOT No. So. 1/2 of W 1/2 Lot 13

BLOCK No.

PERMIT No. 2657

SEATTLE HEIGHTS
GARDENS

NAME ADD.

LOT LINE

D-40'

A-60'

X 192'

18'

EXISTING
SEPTIC TANK

C-48'

CITY OF
MOUNTLAKE TERRACE

MAY 23 1960

Plan Approved S. M. Abee

LOT LINE

SIDE SEWER

Date

Approved:

BACKFILL WORK ORDER ISSUED

DEPOSIT, \$10.00 5/13/60

SEWER WORK ORDER ISSUED

1440

DATE 5/23/60

BY

J. E. Hackett

APPLICATION

for

SIDE SEWER PERMIT

OUTSIDE INSIDE REPAIRS

The City of Mountlake Terrace

John Meek

CARD No.

EASEMENT No. 1390879

OWNER John Meek

HOUSE No. 21902 54 W

CONTRACTOR Racine Const.


PERMIT NO. 2467

STREET
AVENUE LOT NO.

29 N E 1/4

BLOCK NO.

NAME ADD. Seattle Heights Gardens

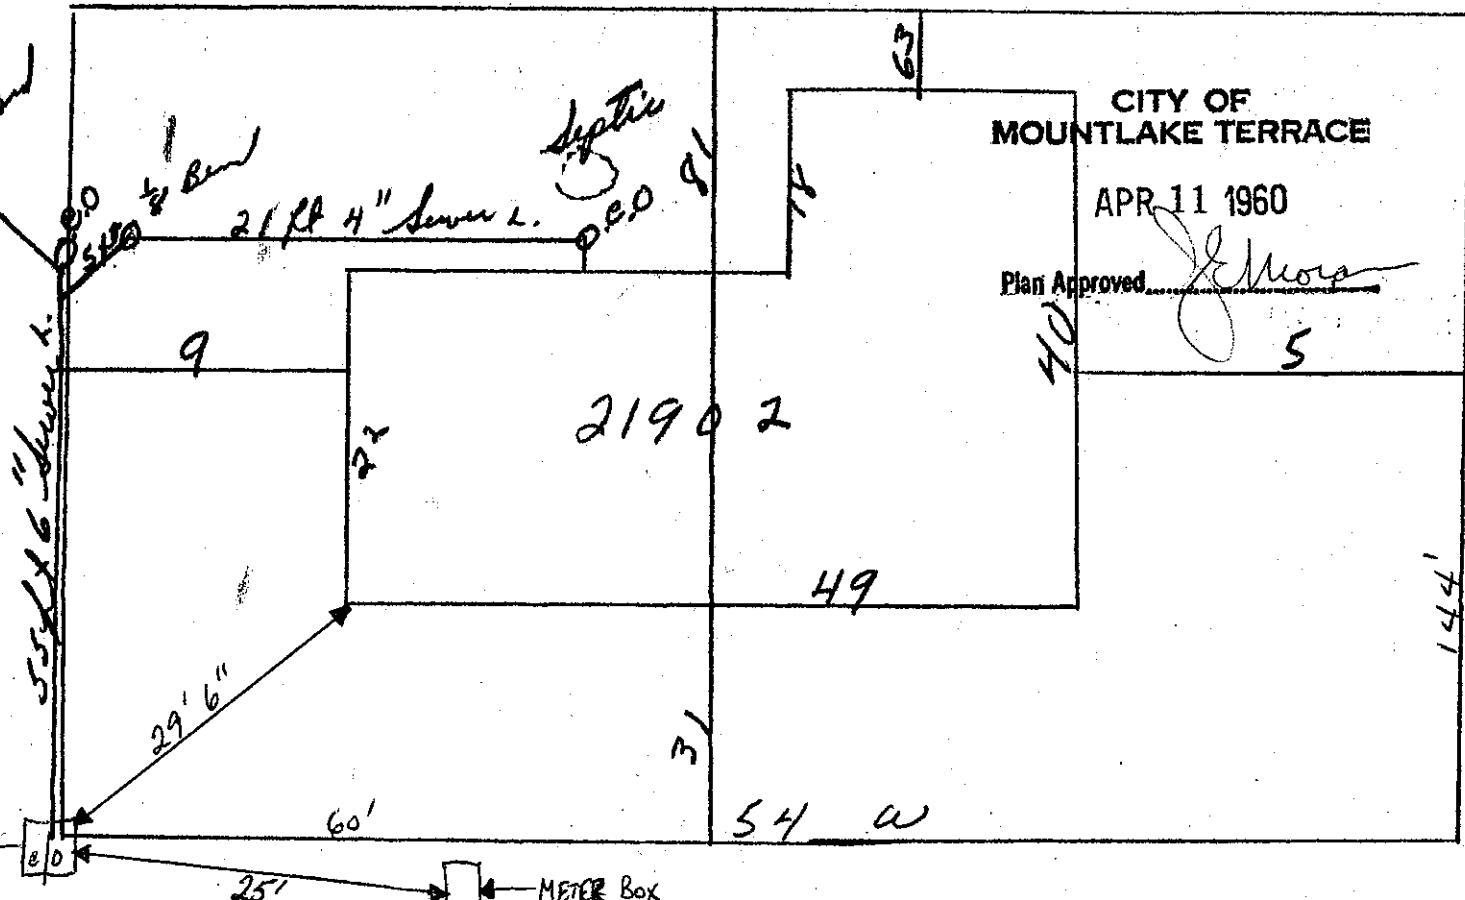

Date

Approved:

BACKFILL WORK ORDER ISSUED

DEPOSIT, \$10.00

4/12/60

SEWER WORK ORDER ISSUED

1254

DATE 4/12/60

BY

John Meek

The City of Mountlake Terrace

APPLICATION

for

SIDE SEWER PERMIT

OUTSIDE INSIDE REPAIRS

CARD No.

EASEMENT No. 1399603

OWNER Jon V. Rees

HOUSE NO. 21903 - 54 W,


CONTRACTOR

STREET
AVENUE LOT No.

NAME ADD. NW 1/4 Lot 12 Seattle Heights Gardens

BLOCK No.

PERMIT No. 2629

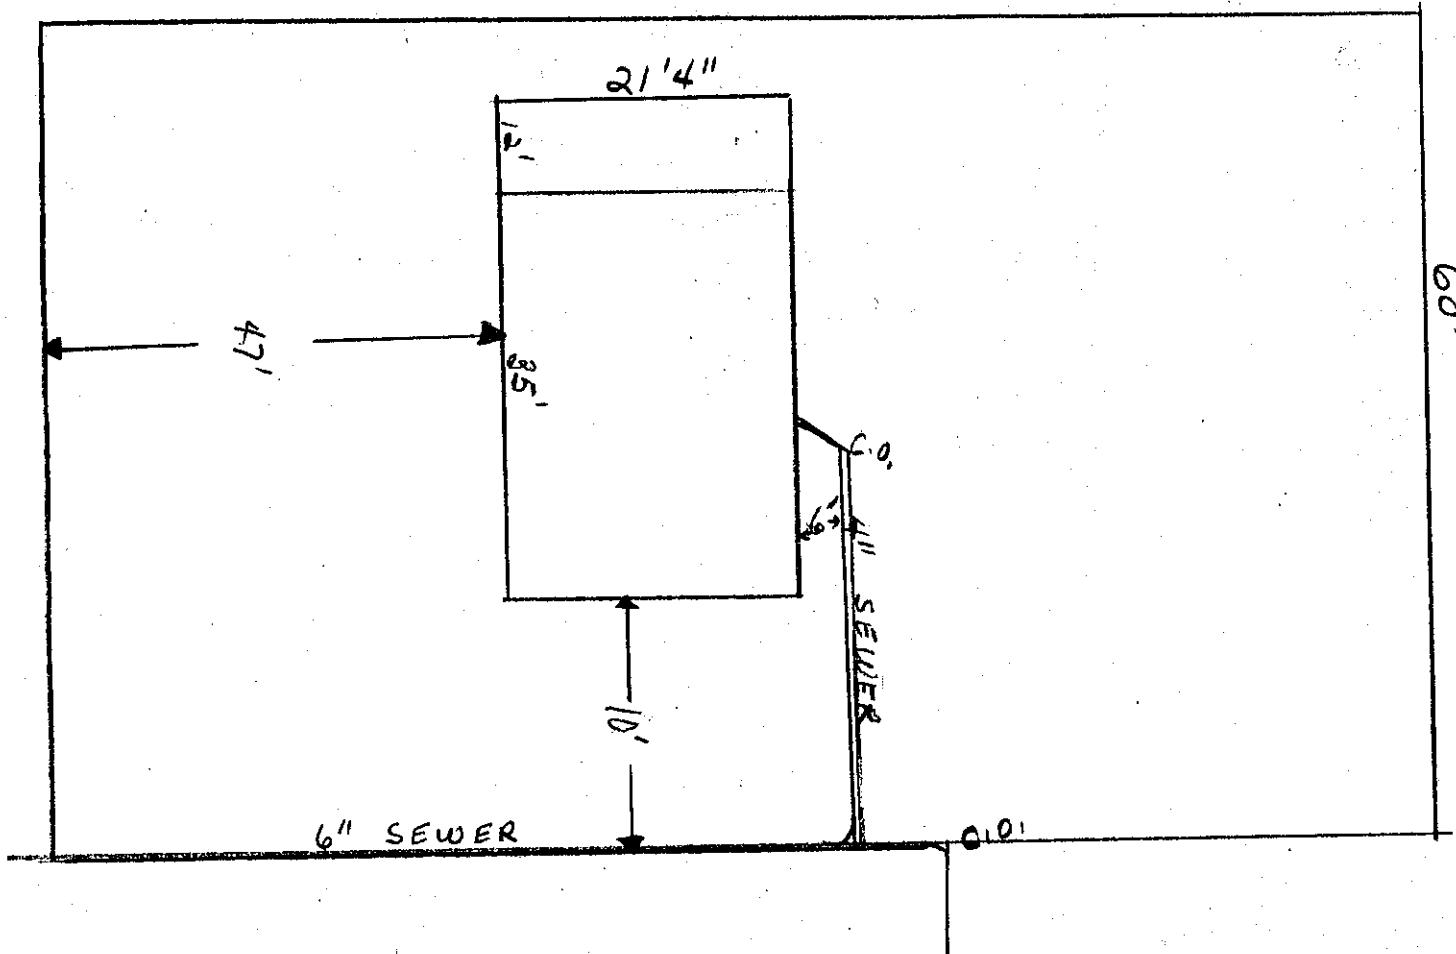

Date

Approved:

BACKFILL WORK ORDER ISSUED

DEPOSIT, \$10.00

5/7/60

SEWER WORK ORDER ISSUED

1411

DATE

5-19-60

BY

S. M. Holton INST & CON

APPLICATION

for


SIDE SEWER PERMIT

OUTSIDE INSIDE REPAIRS CARD No. ✓

The City of Mountlake Terrace

EASEMENT No. 1399603

OWNER Walter L. Phelps CONTRACTOR Self PERMIT No. 2630
 HOUSE No. 21905 - 54 W. STREET
 AVENUE LOT No.
 NAME ADD. SW 1/4 Lot 12 Seattle Heights Gardens

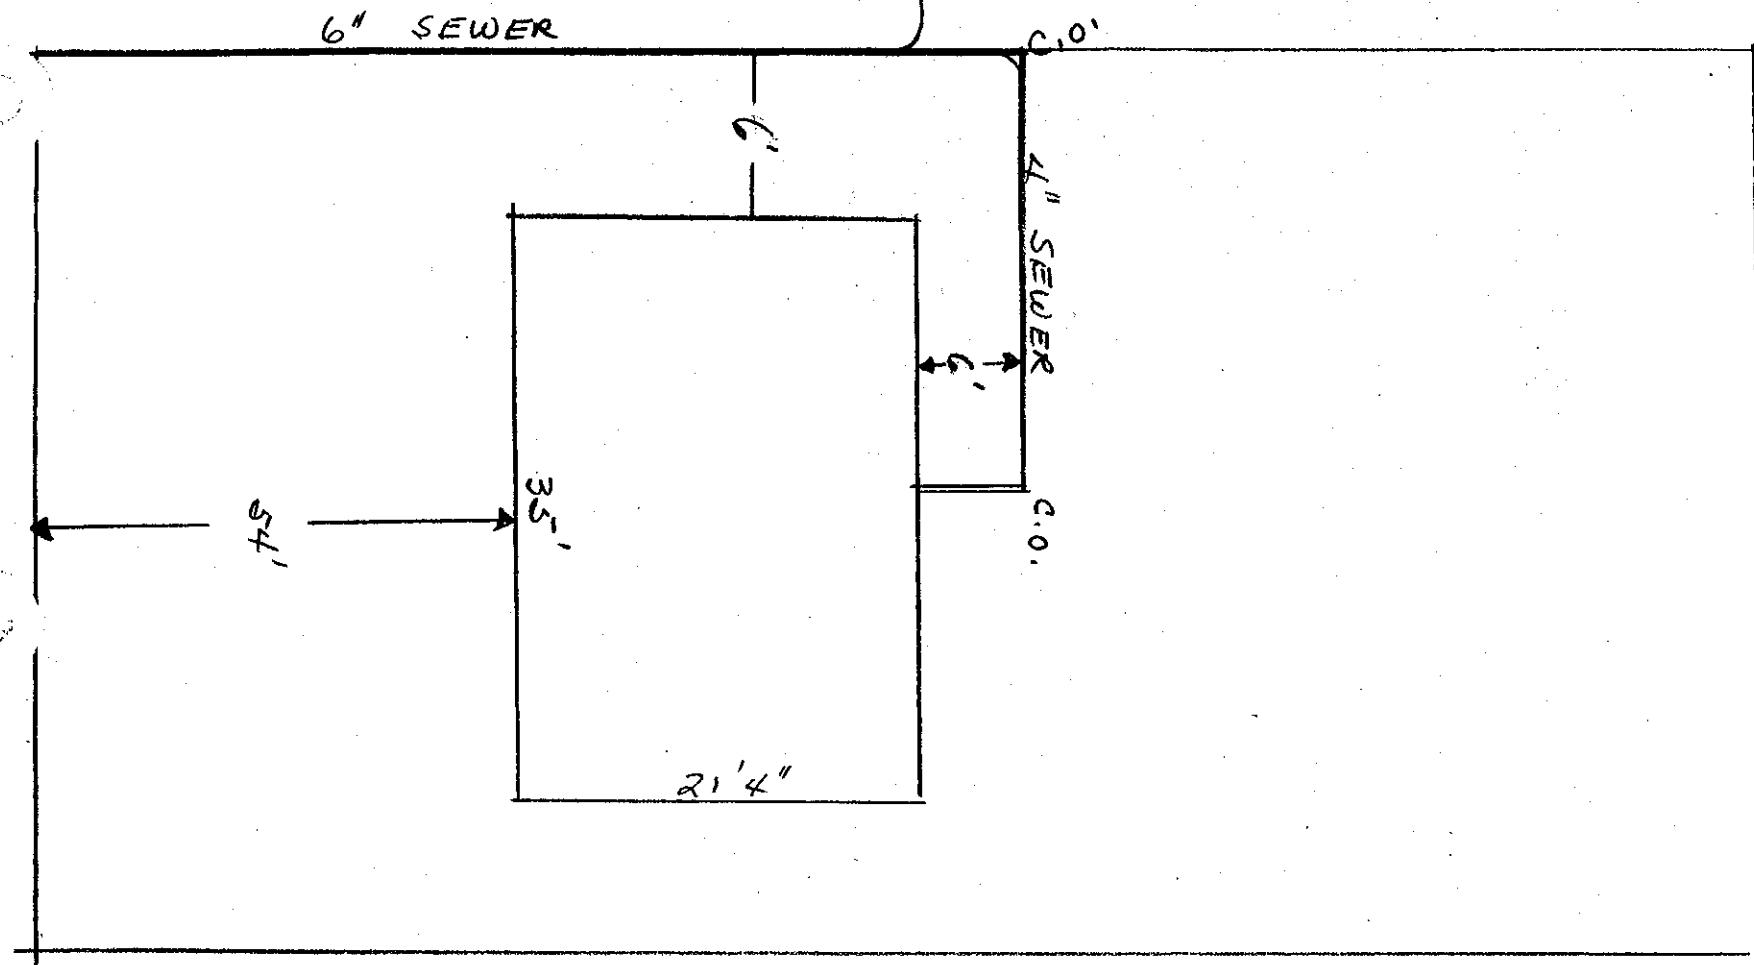

Date

BACKFILL WORK ORDER ISSUED

DEPOSIT, \$10.00

Approved:
5/7/60

SEWER WORK ORDER ISSUED

1412

DATE

5-19-60

BY S. M. Holton 1A5t.CAD

The City of Mountlake Terrace

APPLICATION

for

SIDE SEWER PERMIT

OUTSIDE INSIDE REPAIRS


CARD No. _____

EASEMENT No. _____

OWNER Liffray & Stasser
HOUSE No. 2190 1/2 54⁰ W.
4PLEX

CONTRACTOR Arrow Const Co. PERMIT NO. 48-74
STREET BOTHELL Bus L 74-3
AVENUE LOT No. _____ BLOCK No. _____

NAME ADD

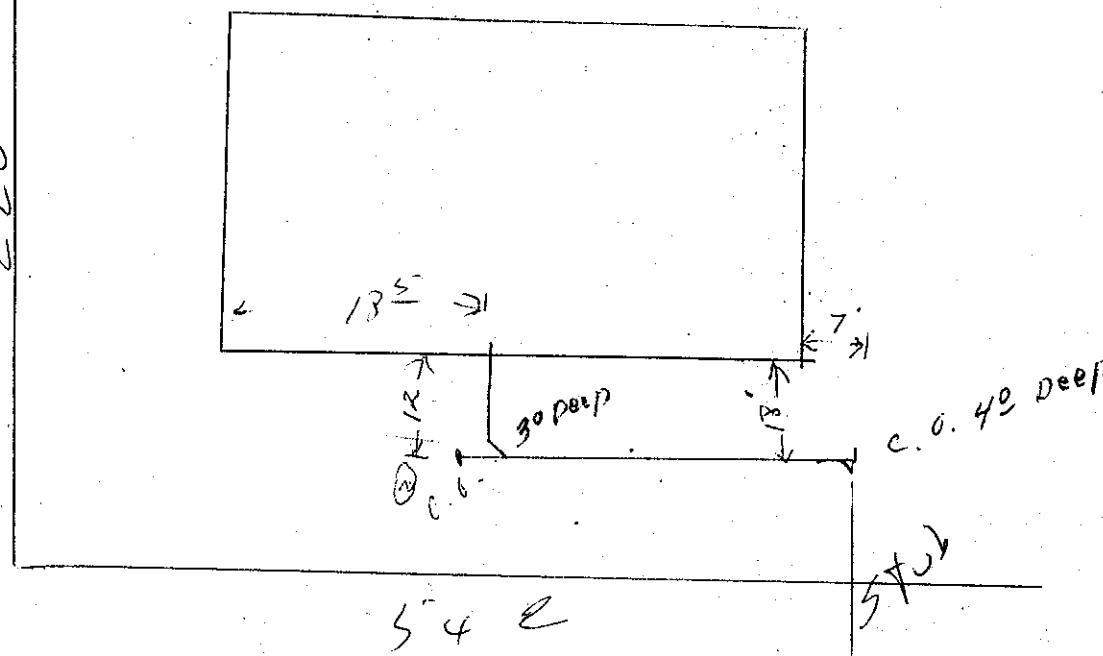

BACKFILL WORK ORDER ISSUED _____
SEWER WORK ORDER ISSUED _____

Date
10/2/74

DEPOSIT, \$

10/1/74

Approved:

DATE 10/2/74

BY

J. W. Smith

The City of Mountlake Terrace

APPLICATION

for

SIDE SEWER PERMIT

OUTSIDE INSIDE REPAIRS

HAL K MARTIN

CARD No.

EASEMENT No.

OWNER

Hal K Martin

CONTRACTOR

Dunek

PERMIT No. 1232


HOUSE No. 21909 West 54th

STREET
AVENUE LOT NO.

BLOCK No.

NAME ADD.

W. 64 ft Lot 11, Seattleights Gardens

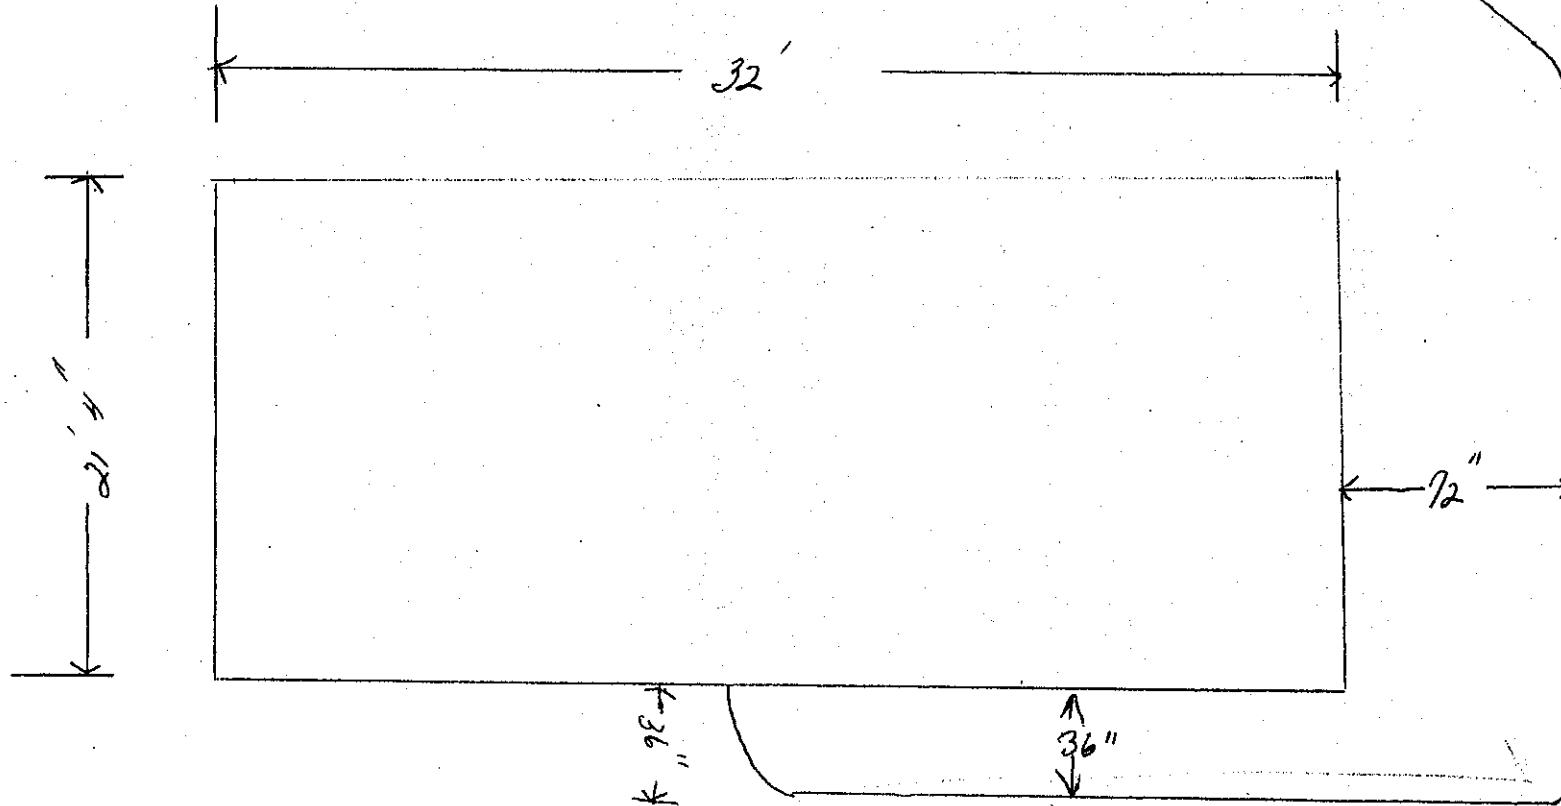

Date

Approved:

BACKFILL WORK ORDER ISSUED

DEPOSIT, \$10.00

SEWER WORK ORDER ISSUED

Receipt #

DATE

1/1/60 BY

Jellino

The City of Mountlake Terrace

APPLICATION

for

SIDE SEWER PERMIT

OUTSIDE INSIDE REPAIRS

CARD No.

EASEMENT No. None

OWNER Dorothy Cathleen Hartley
HOUSE NO. 220 1/2 - 54W

PR6-2437

CONTRACTOR

STREET
AVENUE LOT NO.

NAME ADD.


PERMIT NO.

BLOCK NO.

79

SH west W½ N½ tract,
Morrison Acre Tracts

220 - S.W. 150'

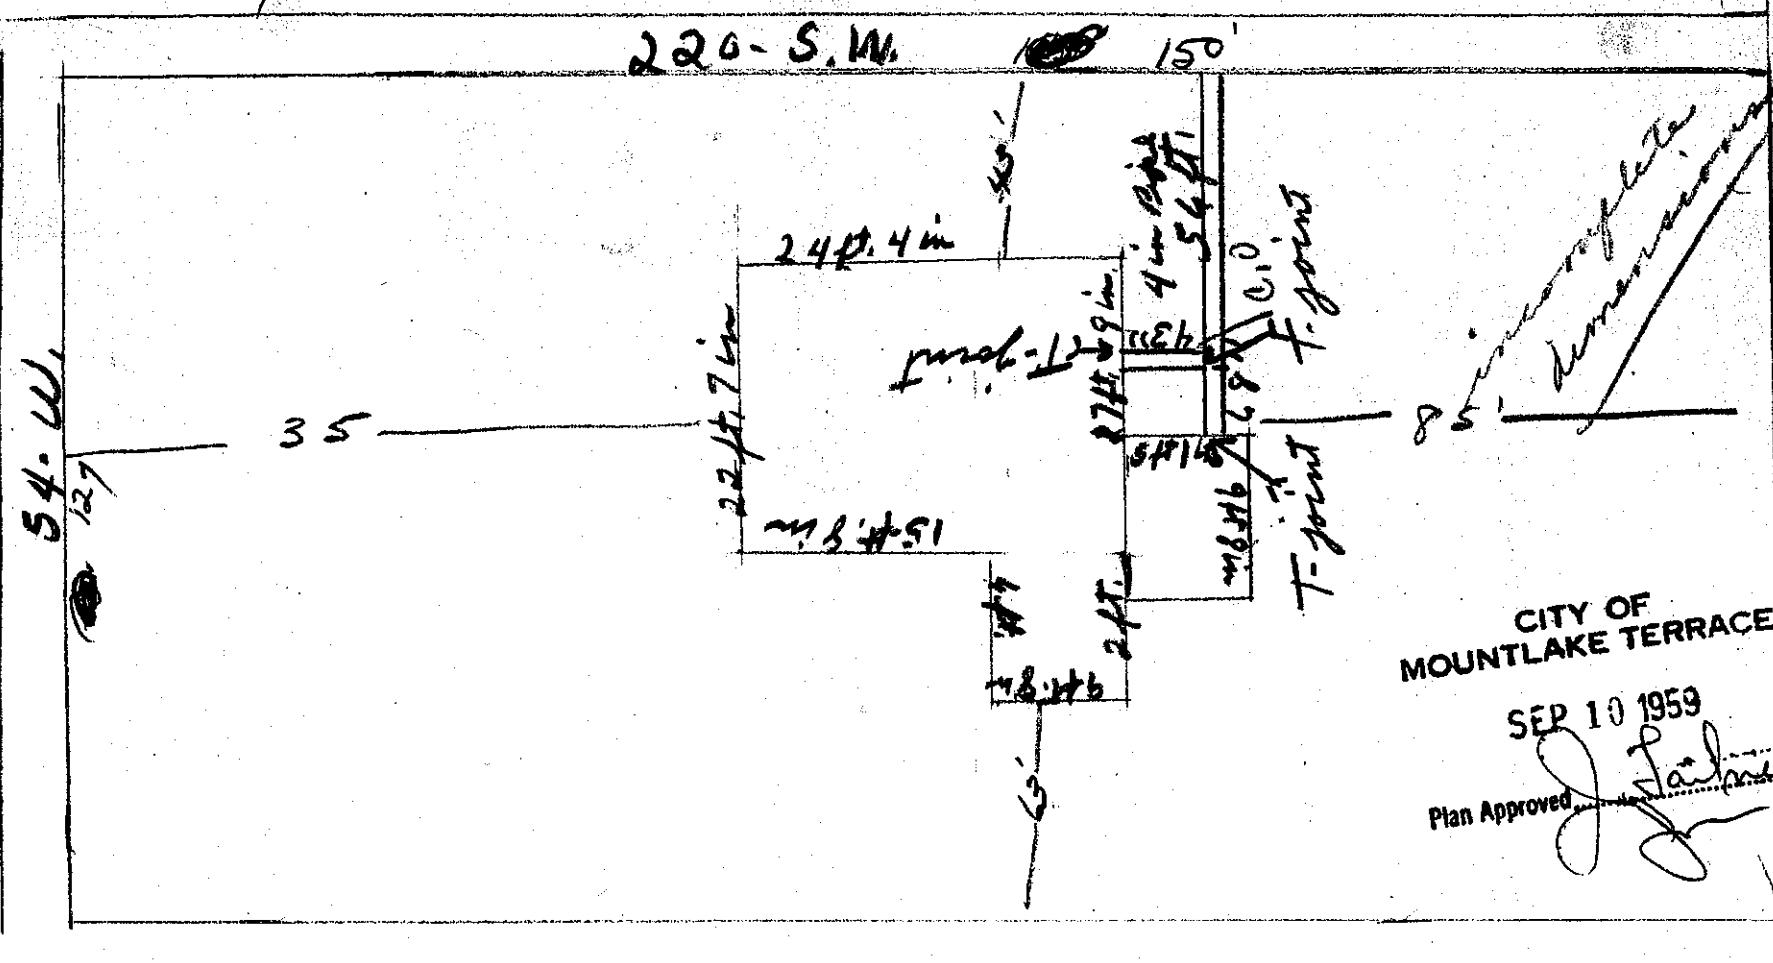

CITY OF
MOUNTLAKE TERRACE

SEP 10 1959

Plan Approved

Date

Approved:

BACKFILL WORK ORDER ISSUED

DEPOSIT, \$10⁰⁰

6-24-59

SEWER WORK ORDER ISSUED

3698

DATE

5-17-60 BY S. M. Holton INST+N.C.

5-24-60 INST+CON S.M.H.

The City of Mountlake Terrace

APPLICATION

for

SIDE SEWER PERMIT

OUTSIDE INSIDE REPAIRS

J. M. Sowers
CARD No.

EASEMENT No. None

OWNER J. M. Sowers

CONTRACTOR


Wingfield

HOUSE No. 22012 - 54th W.

PERMIT No. 215

STREET AVENUE LOT No. E 150 of N 95 of lot 10 BLOCK No. 1

NAME ADD. Morrison Lien Tracts

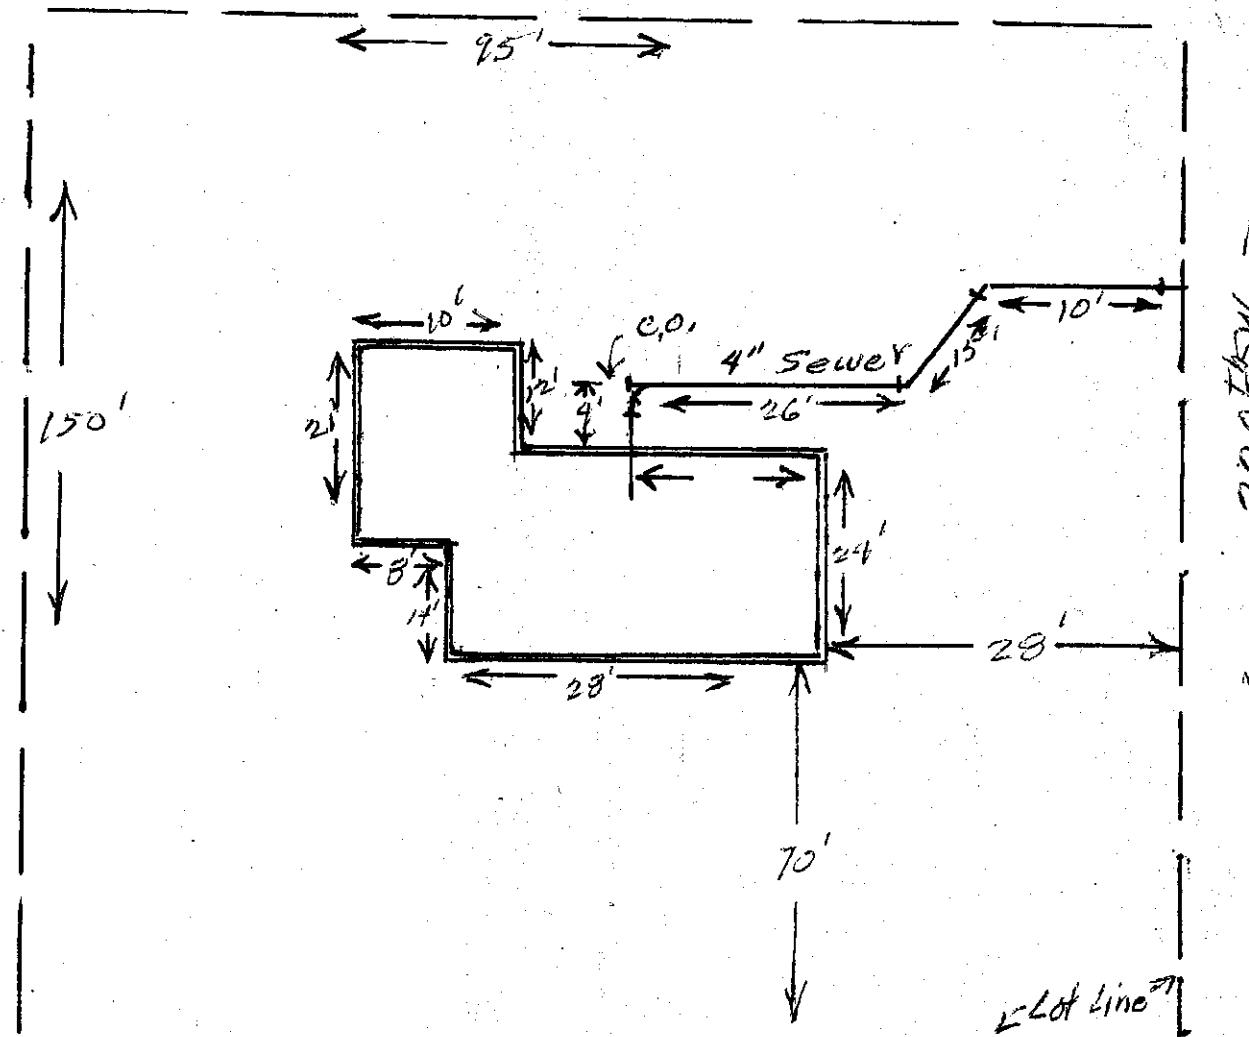

Date

54th W.

Approved:

BACKFILL WORK ORDER ISSUED

DEPOSIT, \$ 10.00

SEWER WORK ORDER ISSUED

7-1-60

DATE

7-1-60 BY J. M. Holton INSTCON

The City of Mountlake Terrace

APPLICATION

for

SIDE SEWER PERMIT

OUTSIDE INSIDE REPAIRS

DONALD T. HARDY

CARD NO.

OWNER Donald Hardy

HOUSE No. 22014 - 54th W.

CONTRACTOR Wingfield-Brown


PERMIT No. 1351

STREET
AVENUE LOT No. 10

BLOCK No. 1

NAME ADD.

Morrison Acer Tracts

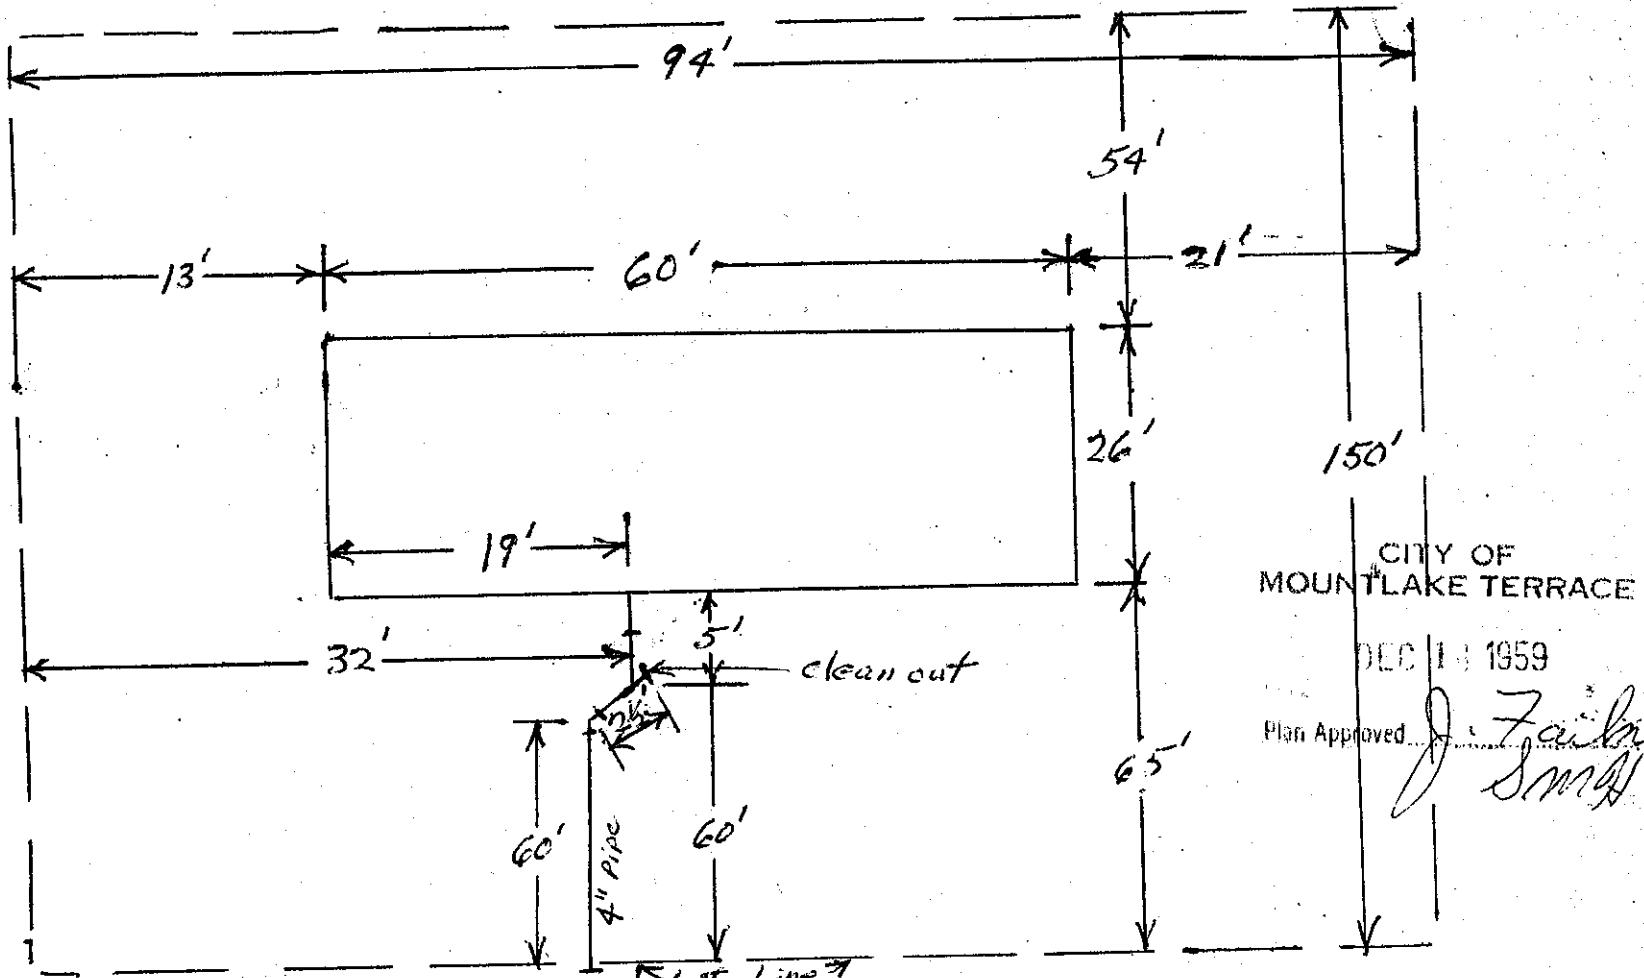

Date

Approved:

BACKFILL WORK ORDER ISSUED

DEPOSIT, \$10.00

SEWER WORK ORDER ISSUED

#TS 573

DATE 12-16-59 BY Scott McHilton 10/15

The City of Mountlake Terrace

APPLICATION

for

SIDE SEWER PERMIT

OUTSIDE INSIDE REPAIRS


CARD No.

EASEMENT No. 1347639

OWNER Wm. K. Ford
HOUSE No. 22015 - 59th W.
CONTRACTOR Wm. K. Ford
STREET N.E. OF S.E. OF W.
AVENUE LOT No. 1/2 OF W.
NAME ADD. Harrison Street LESS WID FOR ROAD

PERMIT NO. 3034

LOT 1
BLOCK No. 2

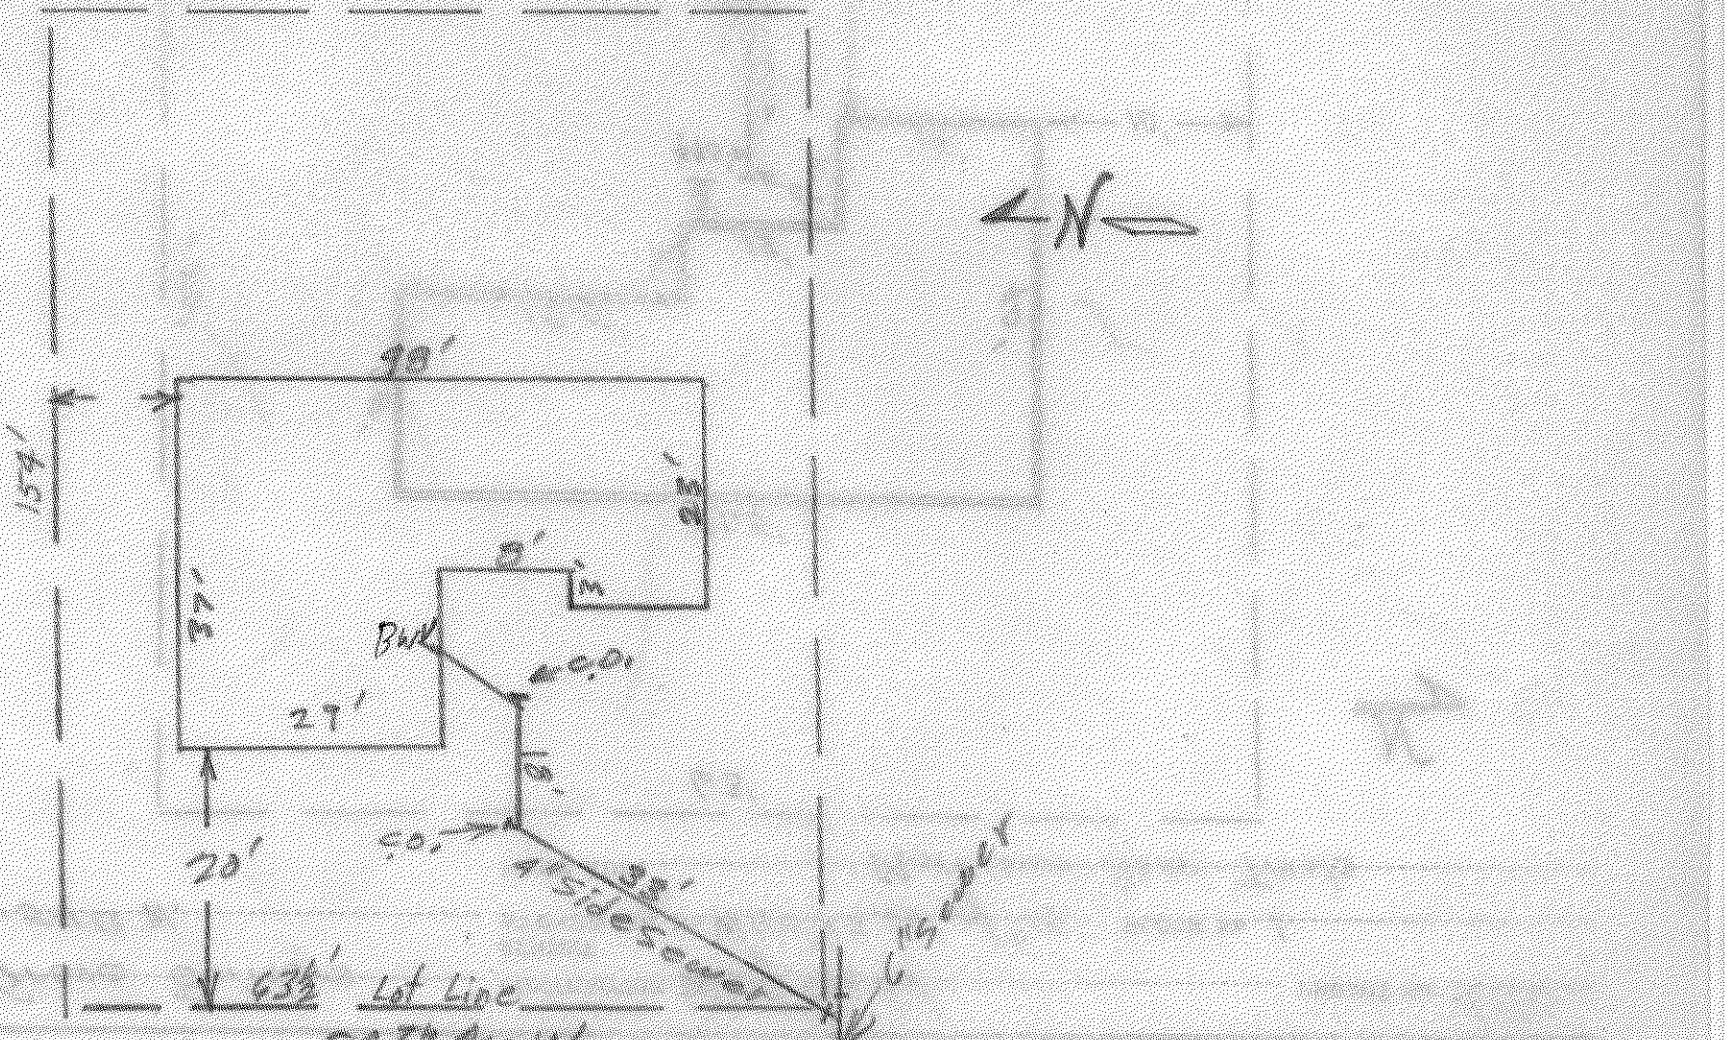

Date

Approved:

BACKFILL WORK ORDER ISSUED

SEWER WORK ORDER ISSUED

DEPOSIT, \$

DATE

2-21-62

BY

J. M. Miller

APPLICATION

For


SIDE SEWER PERMIT

The City of Mountlake Terrace

CARD No.

OUTSIDE INSIDE REPAIRS EASEMENT No. NoneOWNER Landing & Grove Builders
HOUSE NO. 22020 - 54th W.CONTRACTOR Wingfield

STREET

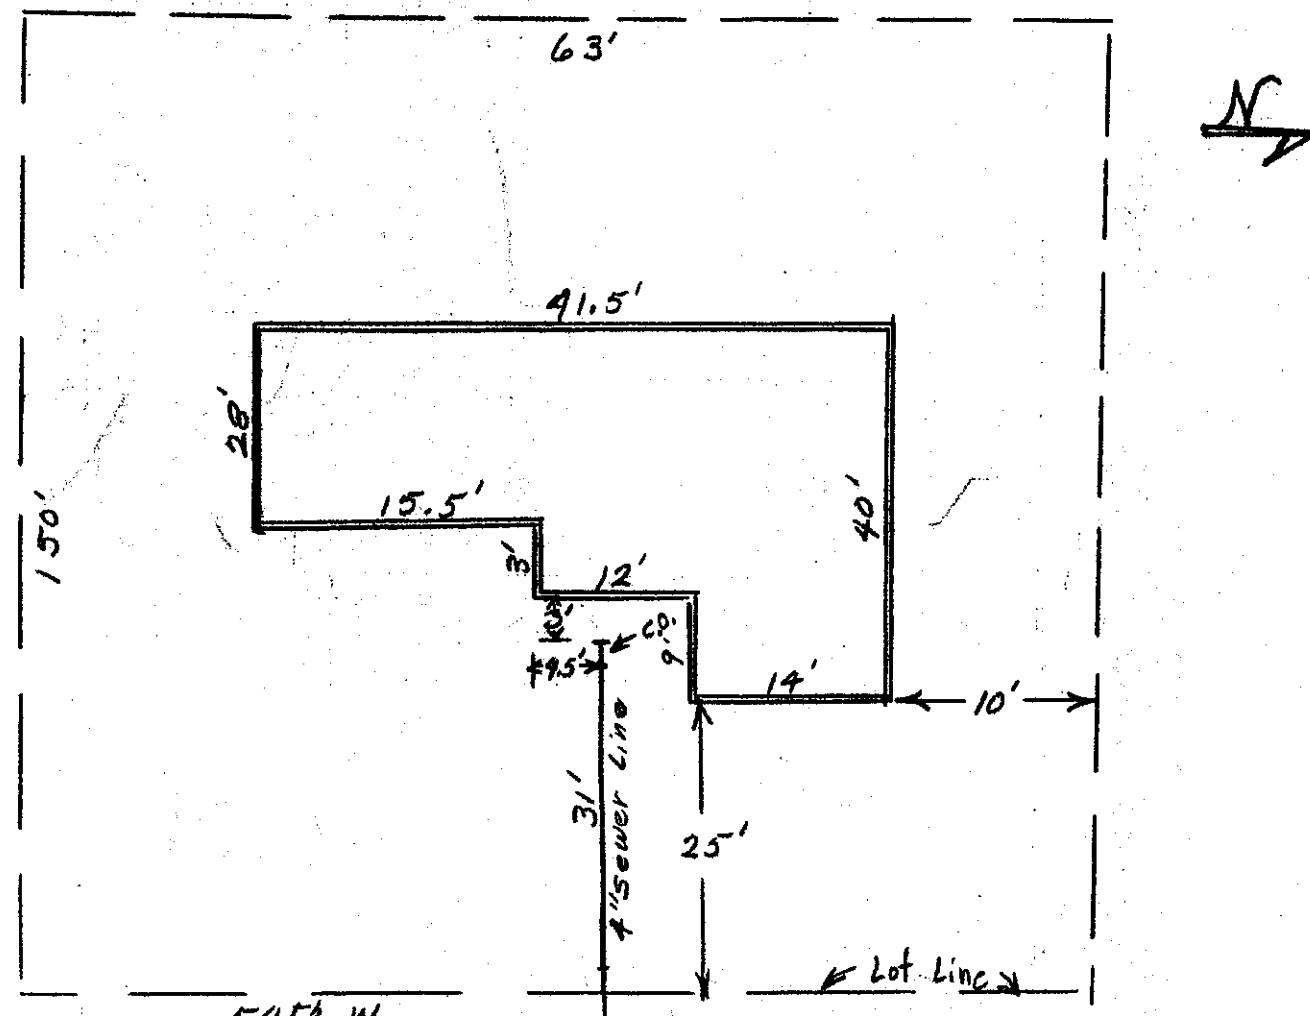AVENUE LOT NO. W 150' E 5.65' of 10PERMIT NO. 490BLOCK NO. 1NAME ADD Morrison Acre Tracts

Date

Approved:

DEPOSIT, \$10.00

9/28/60

BACKFILL WORK ORDER ISSUED

SEWER WORK ORDER ISSUED

1919

DATE 9-27-60

BY

S.M. Holton INS. N.C.

APPLICATION

for

SIDE SEWER PERMIT

OUTSIDE INSIDE REPAIRS

The City of Mountlake Terrace

CARD NO.

EASEMENT No. 1347699


OWNER R. E. Rich

CONTRACTOR B. & C.

PERMIT NO. 2554

HOUSE No. 22025 - 54th W.STREET
AVENUE LOT NO.

BLOCK NO.

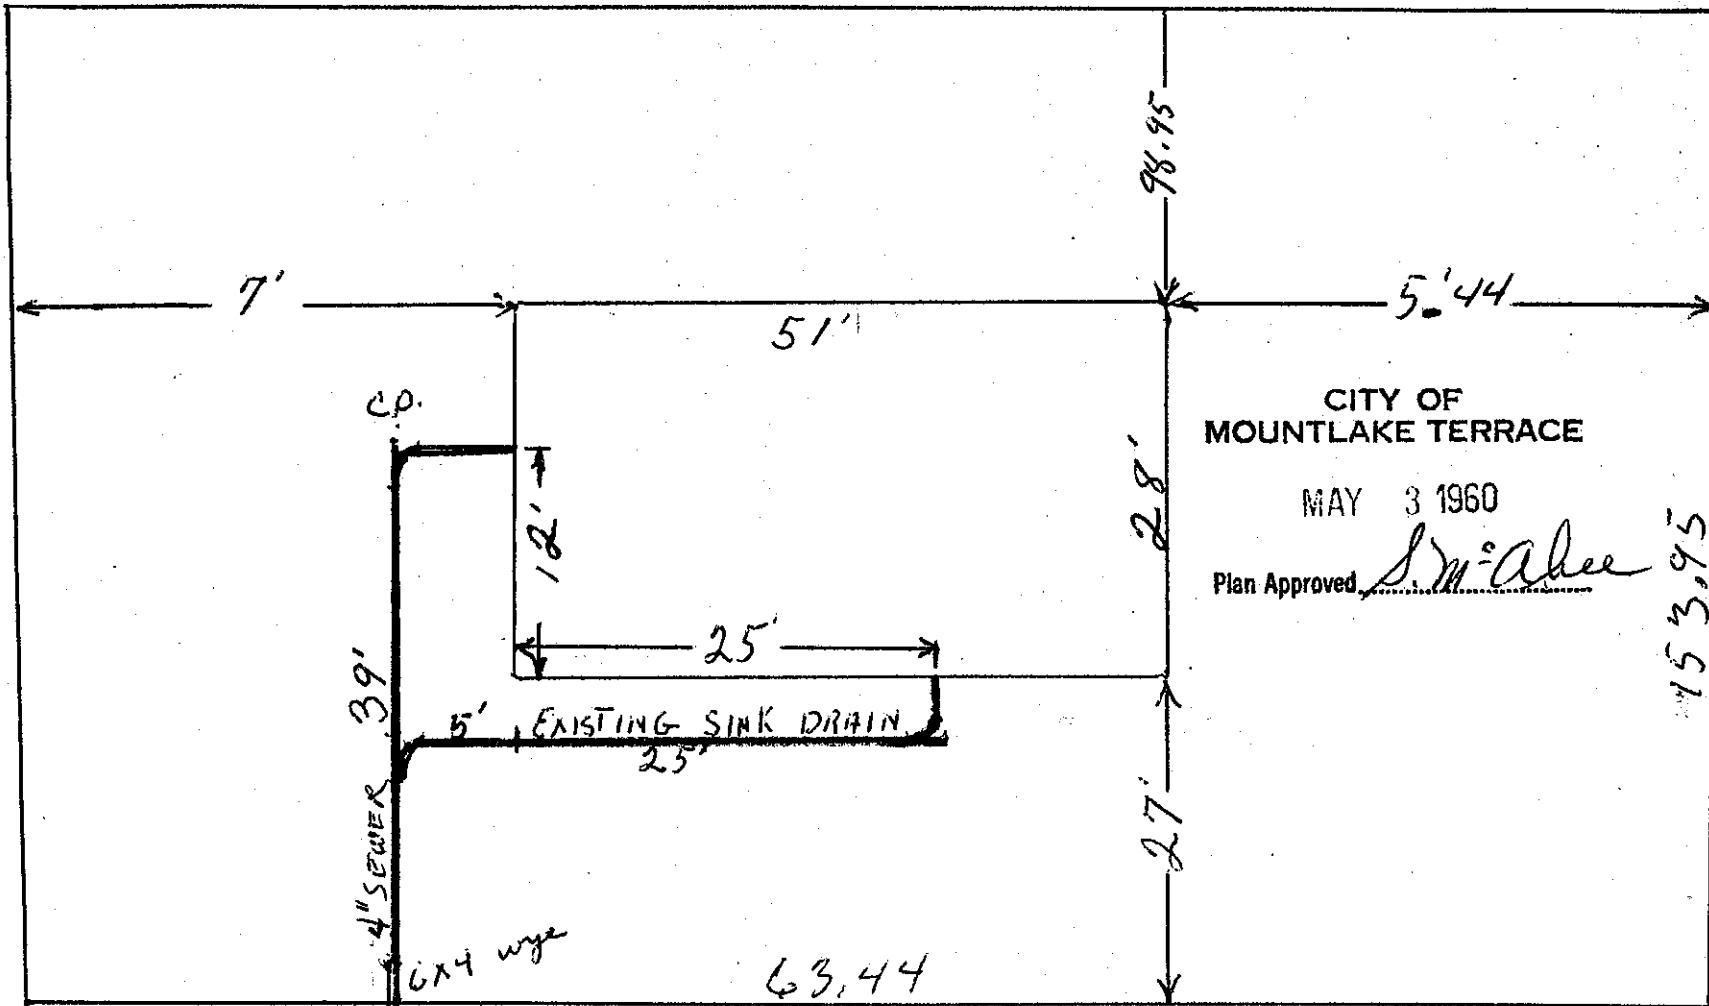NAME ADD S. 1/2 of S. 1/2 of W 1/2 of Lot 1 BL. 2 ^{Morrison} acre or.

Date

Approved:

BACKFILL WORK ORDER ISSUED

DEPOSIT, \$10.00 4/26/60

SEWER WORK ORDER ISSUED

1328

Approved:

DATE 5-3-60

BY S. M. Holton INST CON

The City of Mountlake Terrace

APPLICATION

for

SIDE SEWER PERMIT

OUTSIDE INSIDE REPAIRS

CARD No.

EASEMENT No.

OWNER HENRY TRAUTLOFF

HOUSE NO. 22029 54th


CONTRACTOR

PERMIT No. 929

STREET

AVENUE LOT No. 2 W. 153' of the N. 100' of LT 2 BLOCK No. 2

NAME ADD. Morrison's Acre

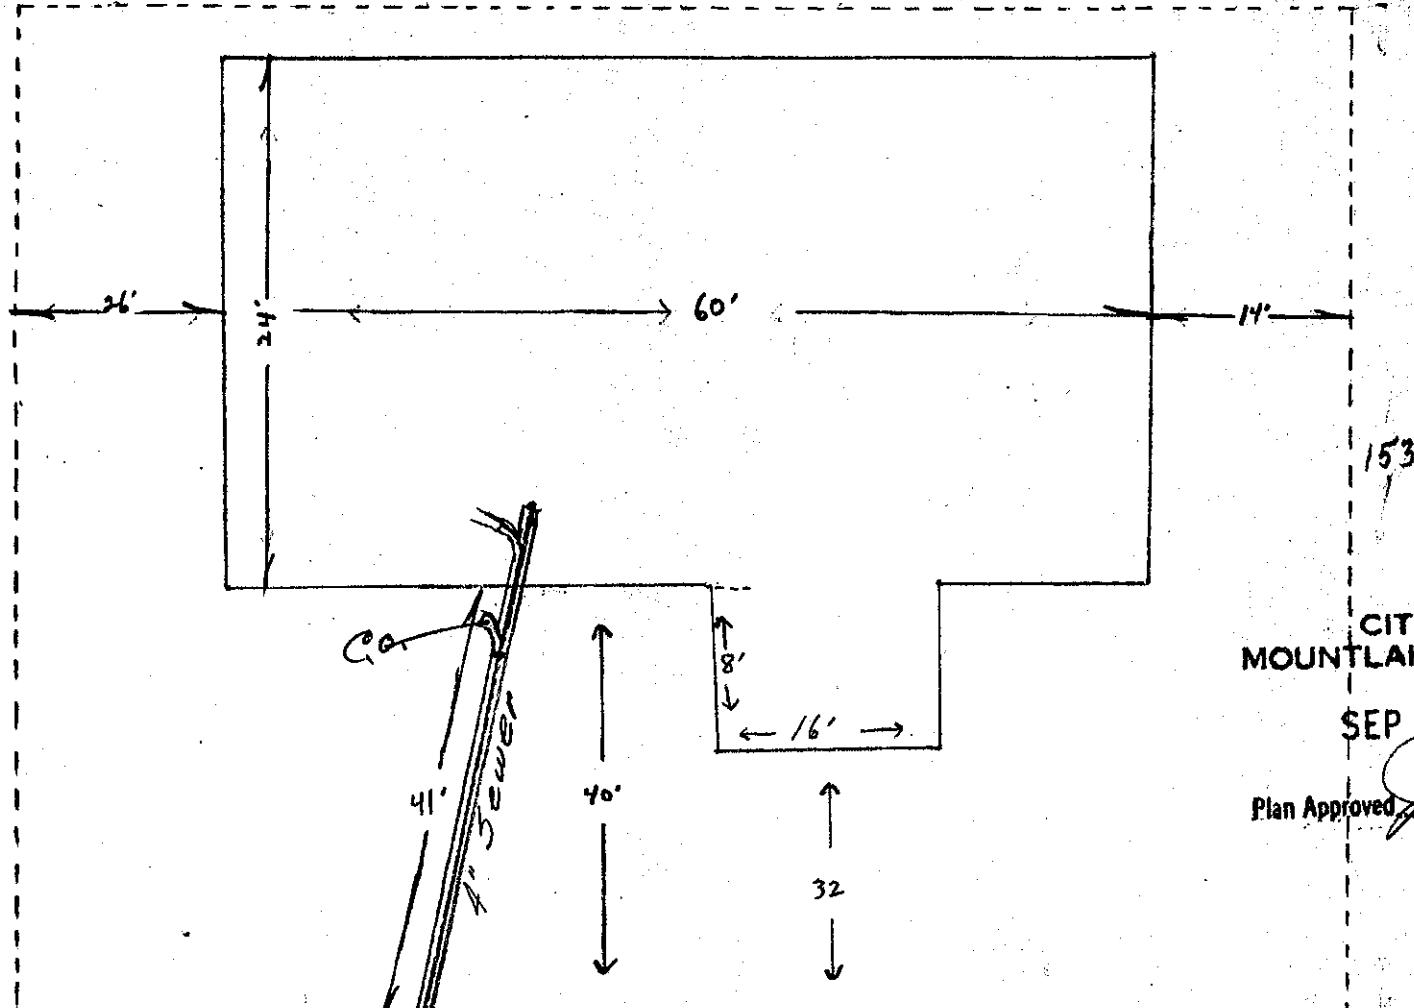

CITY OF
MOUNTLAKE TERRACE

SEP 30 1959

Plan Approved

J. Fairman

Date

100

Approved:

BACKFILL WORK ORDER ISSUED

DEPOSIT, \$ 10.00

SEWER WORK ORDER ISSUED

9-29-59

DATE

12-11-59 BY

Scott M Holton M/S

The City of Mountlake Terrace

APPLICATION

for

SIDE SEWER PERMIT

OUTSIDE INSIDE REPAIRS

M. E. RODERICK

CARD No.

BASEMENT No. None

OWNER Mickey E Roderick

CONTRACTOR

self

PERMIT No. 1061

HOUSE No. 22102, 54 WEST

STREET

AVENUE LOT NO.

8

BLOCK NO.

NAME ADD

Dw 33


CITY OF
MOUNTLAKE TERRACE

MAR 21 1960

Plan Approved

J. Fairnes

Main Sewer

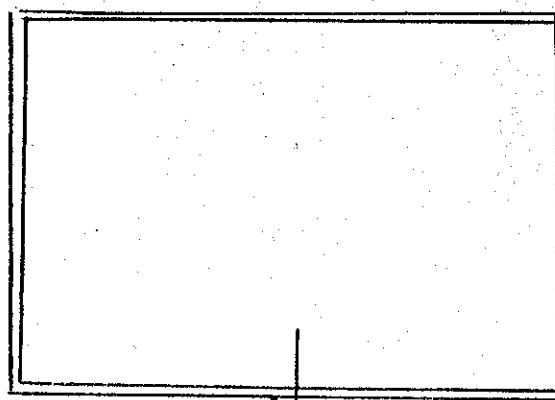

54" From House
To 1/8 Bend
1/8 Bend cleanout
Plug
septic TANK

Date

Approved:

BACKFILL WORK ORDER ISSUED

DEPOSIT,

10⁰⁰

10-30-59

2/1/1960

2/1/1960

SEWER WORK ORDER ISSUED

The City of Mountlake Terrace

APPLICATION

for

SIDE SEWER PERMIT

OUTSIDE INSIDE REPAIRS

Ronald dome
CARD No.

EASEMENT No. 1364628

OWNER Ronald dome

CONTRACTOR Self


PERMIT NO. 1622

HOUSE NO. 22105 54 th

STREET AVENUE LOT NO. 14

BLOCK NO.

NAME ADD. Pennell Park

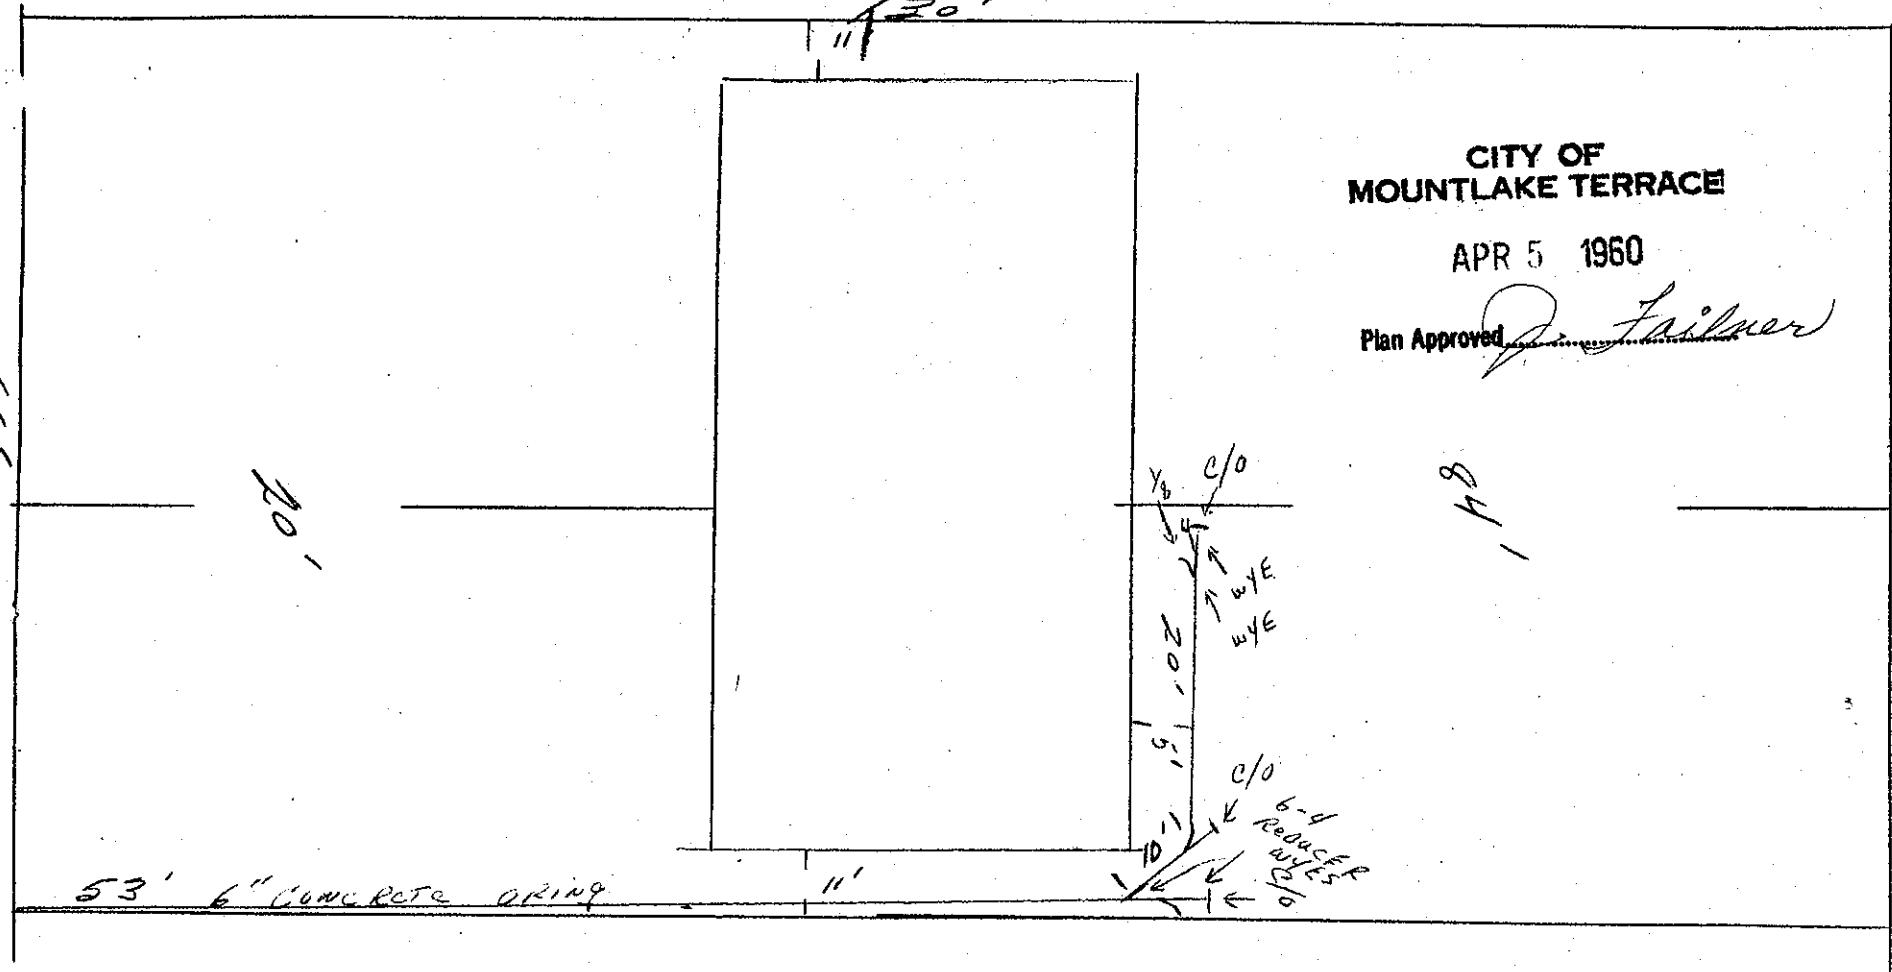

Date

Approved:

BACKFILL WORK ORDER ISSUED

DEPOSIT, \$10.00 2-2-60

SEWER WORK ORDER ISSUED

5900

DATE

4/5/60 BY J. Fairman

The City of Mountlake Terrace

APPLICATION

for

SIDE SEWER PERMIT

OUTSIDE INSIDE REPAIRS

CARD No.

EASEMENT No. 136 4628

OWNER C H Combs

CONTRACTOR Seft

PERMIT No. 1623


HOUSE No. 22209 54th

STREET
AVENUE LOT No. 13

BLOCK No.

NAME ADD. Dennell Park

6" Casing Diking 130'

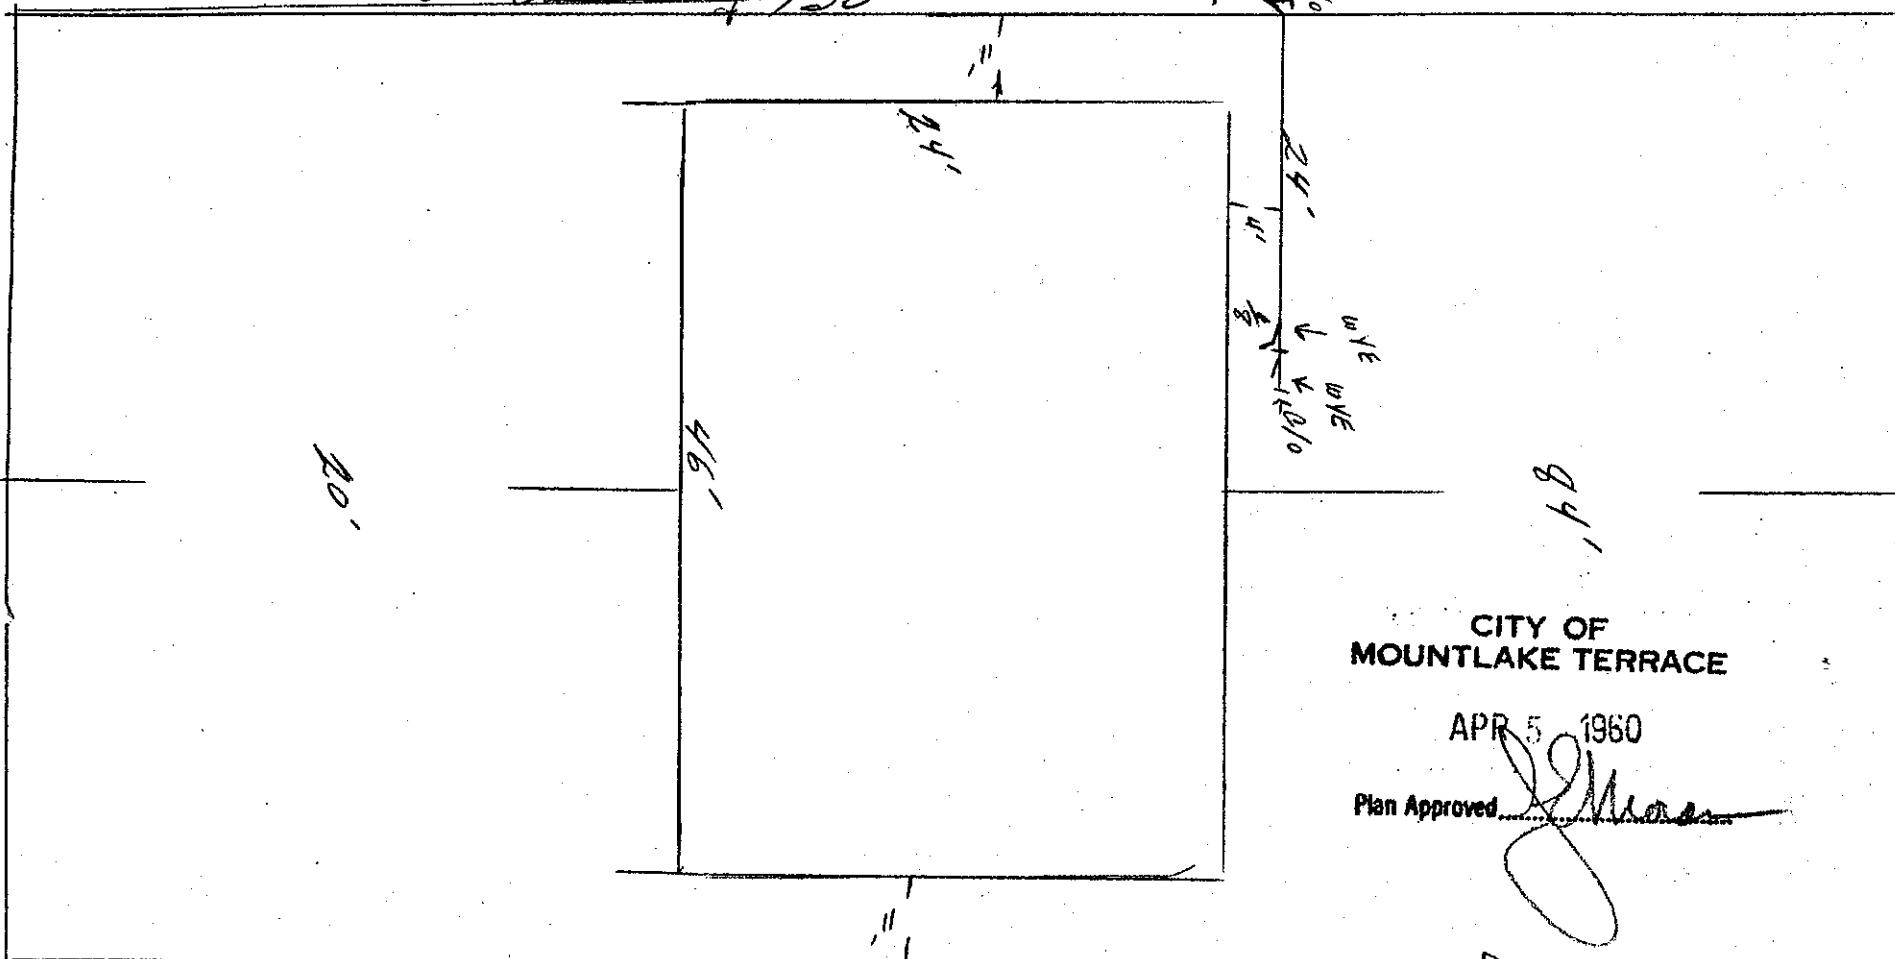

CITY OF
MOUNTLAKE TERRACE

APR 5 1960

Plan Approved.

BACKFILL WORK ORDER ISSUED

Date

Approved:

SEWER WORK ORDER ISSUED

DEPOSIT, \$10.00

2-2-60

\$900

DATE 4/4/60

BY

J. H. Moore

The City of Mountlake Terrace

APPLICATION

for

SIDE SEWER PERMIT

OUTSIDE INSIDE REPAIRS

James Cumming

CARD No.

EASEMENT No. 1364627

OWNER

James Cumming

CONTRACTOR

Owner

PERMIT No.

HOUSE No.

2220 1 54²⁰

STREET

AVENUE LOT NO. 12

BLOCK NO. 2220 PARK

1576

NAME ADD.

LOT LINE

1-15'-0"

8'

0' 0"


3' 0"

7' 0"

2' 0"

82'

22'

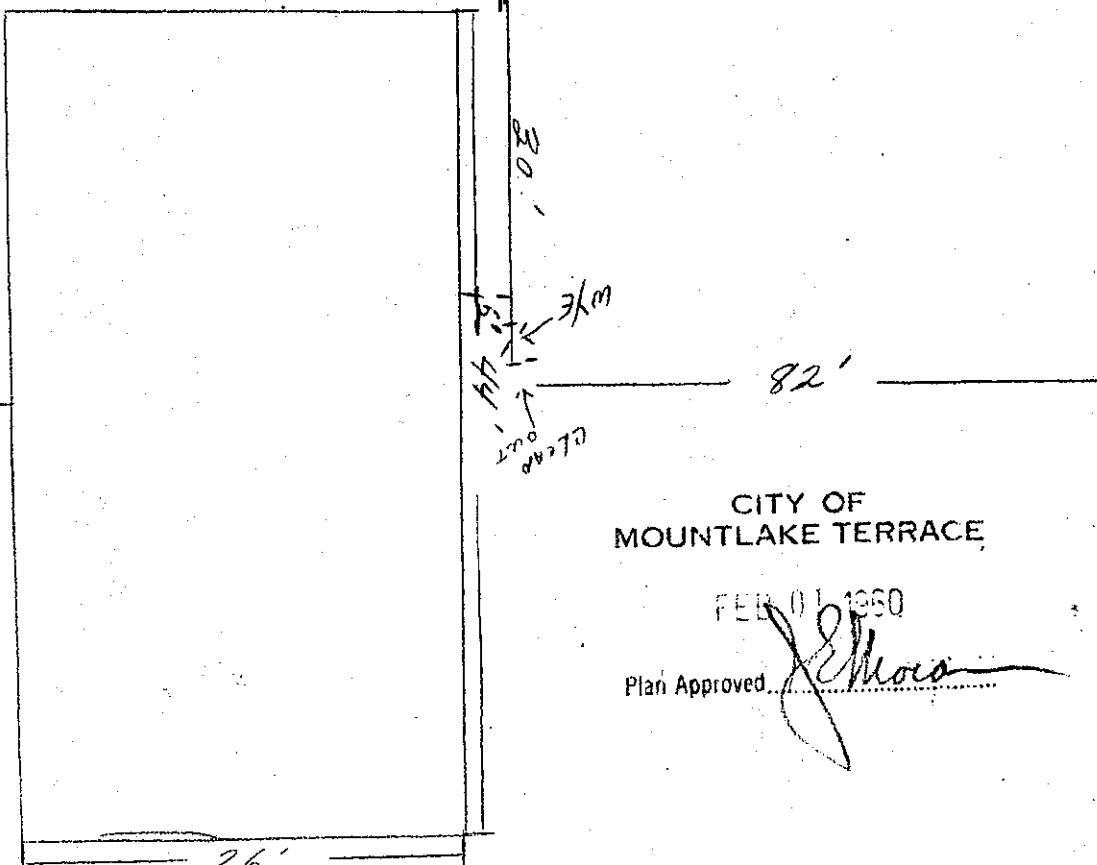

CITY OF
MOUNTLAKE TERRACE

FEB 01 1960

Plan Approved

Date

Approved:

BACKFILL WORK ORDER ISSUED

DEPOSIT, \$ 10.00

SEWER WORK ORDER ISSUED

DATE 4/4/60

BY

J. Ellman

The City of Mountlake Terrace

APPLICATION

for


SIDE SEWER PERMIT

OUTSIDE INSIDE REPAIRS

CARD NO.

EASEMENT No.

OWNER *H. Donnell* CONTRACTOR *CARBON & MARTINI* PERMIT No. *2523*
HOUSE No. *22207 54 4* STREET *10* BLOCK No.
NAME ADD *Mountlake Park*

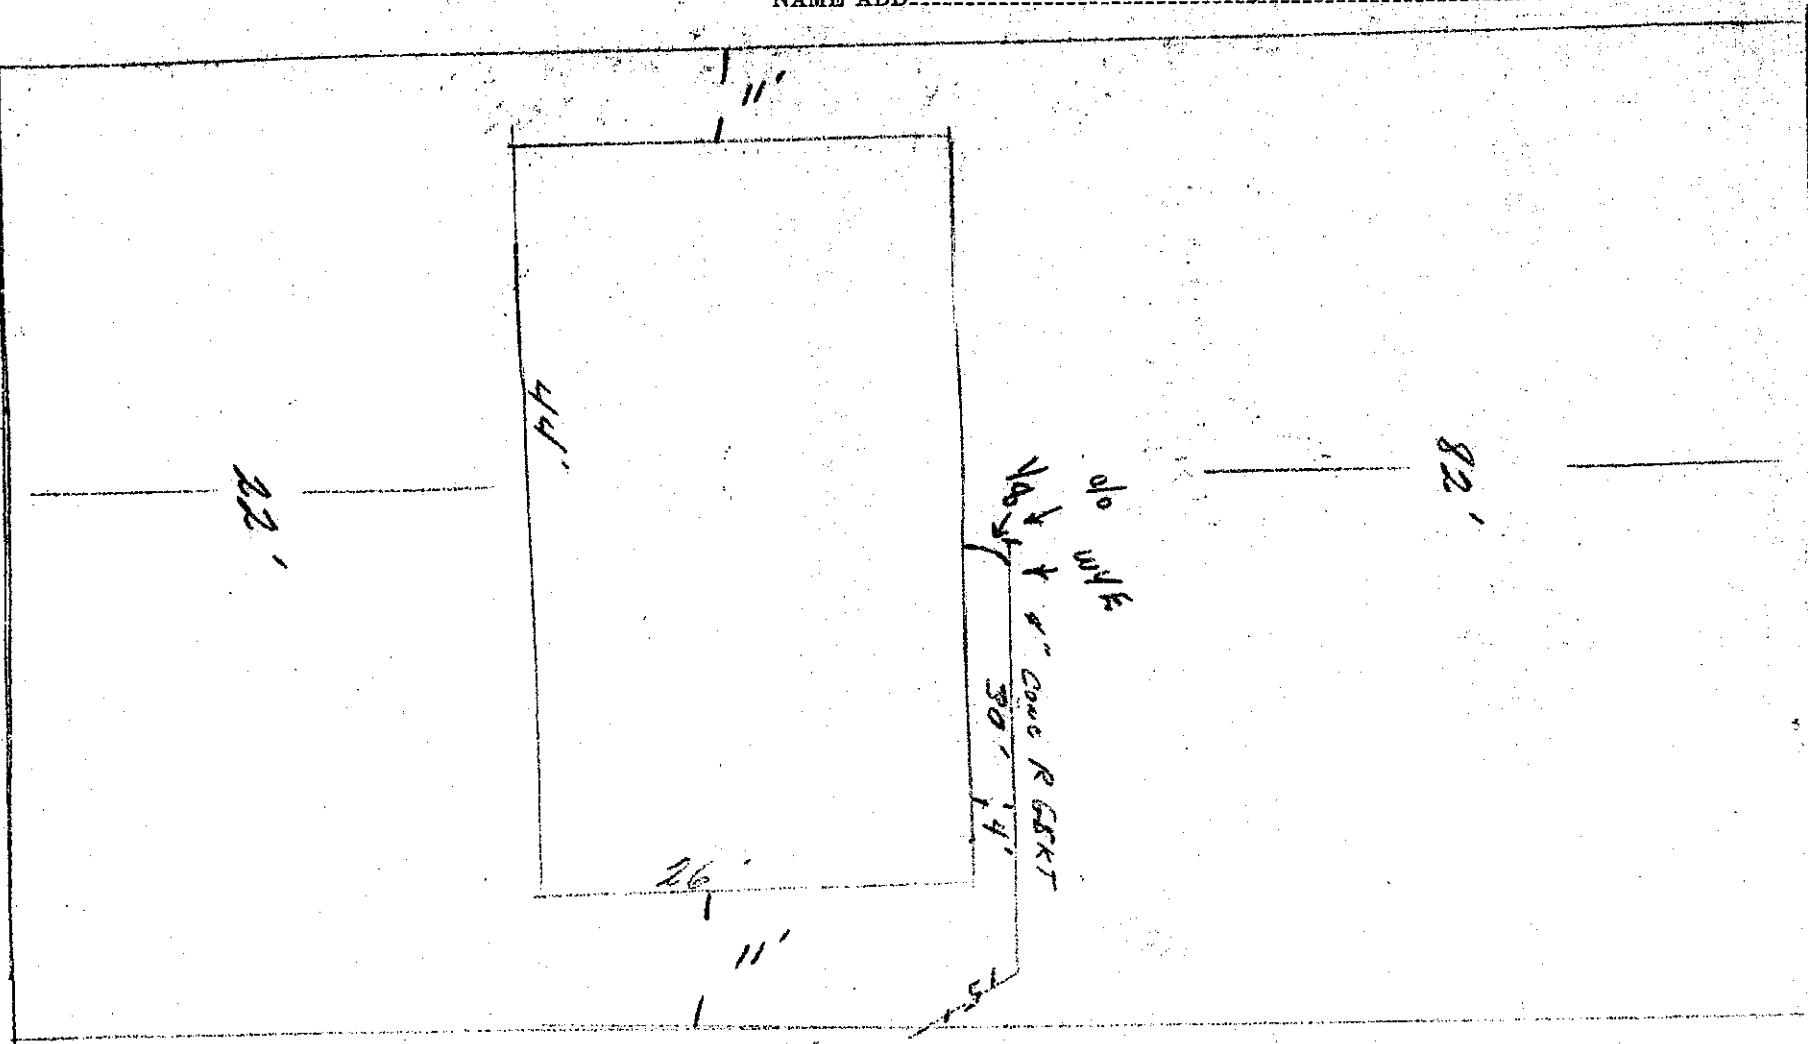

Date

Approved:

BACKFILL WORK ORDER ISSUED

DEPOSIT, \$10.00

4/24/60

DATE 4-25-60

SEWAGE WORK ORDER ISSUED

BY S. m. Holton INST CON

The City of Mountlake Terrace

APPLICATION

for

SIDE SEWER PERMIT

OUTSIDE INSIDE REPAIRS

H. Donnell

CARD No.

EASEMENT No.

OWNER Hellen Donnell
HOUSE NO. 22207 54th W.

CONTRACTOR CARRISON & MARTINI

PERMIT NO. 2524


STREET

AVENUE LOT No. 9

BLOCK No.

NAME ADD. Donnell Park

6" CONC RUBBER GSKT
60'

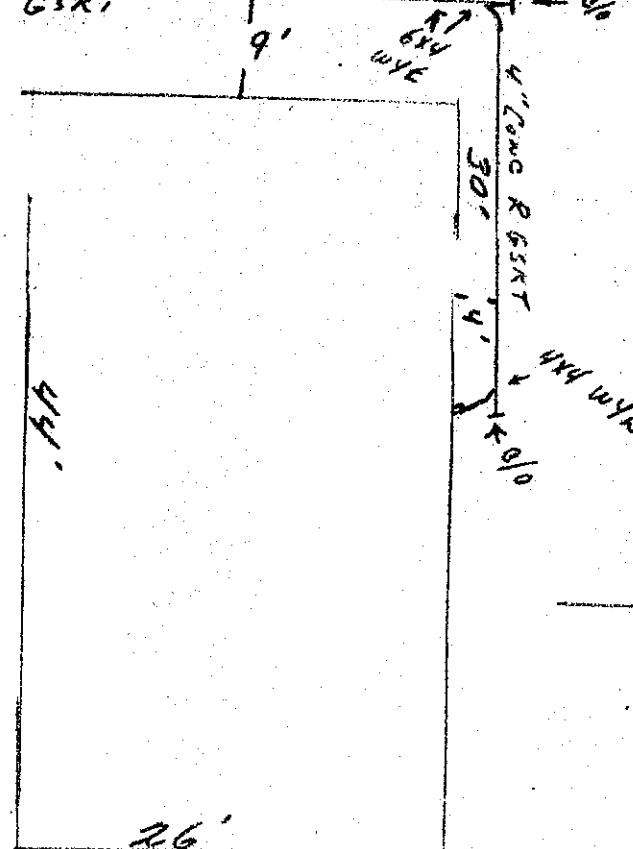

134

Date

Approved:

BACKFILL WORK ORDER ISSUED

DEPOSIT, \$10.00

4/21/60

SEWER WORK ORDER ISSUED

The City of Mountlake Terrace

APPLICATION

for

SIDE SEWER PERMIT

OUTSIDE INSIDE REPAIRS

C. F. RUMPEL

CARD No.

EASEMENT No.

OWNER Carl F. Rumpel

HOUSE No. 22209 - 54th St. W.

CONTRACTOR

STREET
AVENUE LOT No.


B

BLOCK No.

PERMIT NO. 1750

Dowell Park

NAME ADD

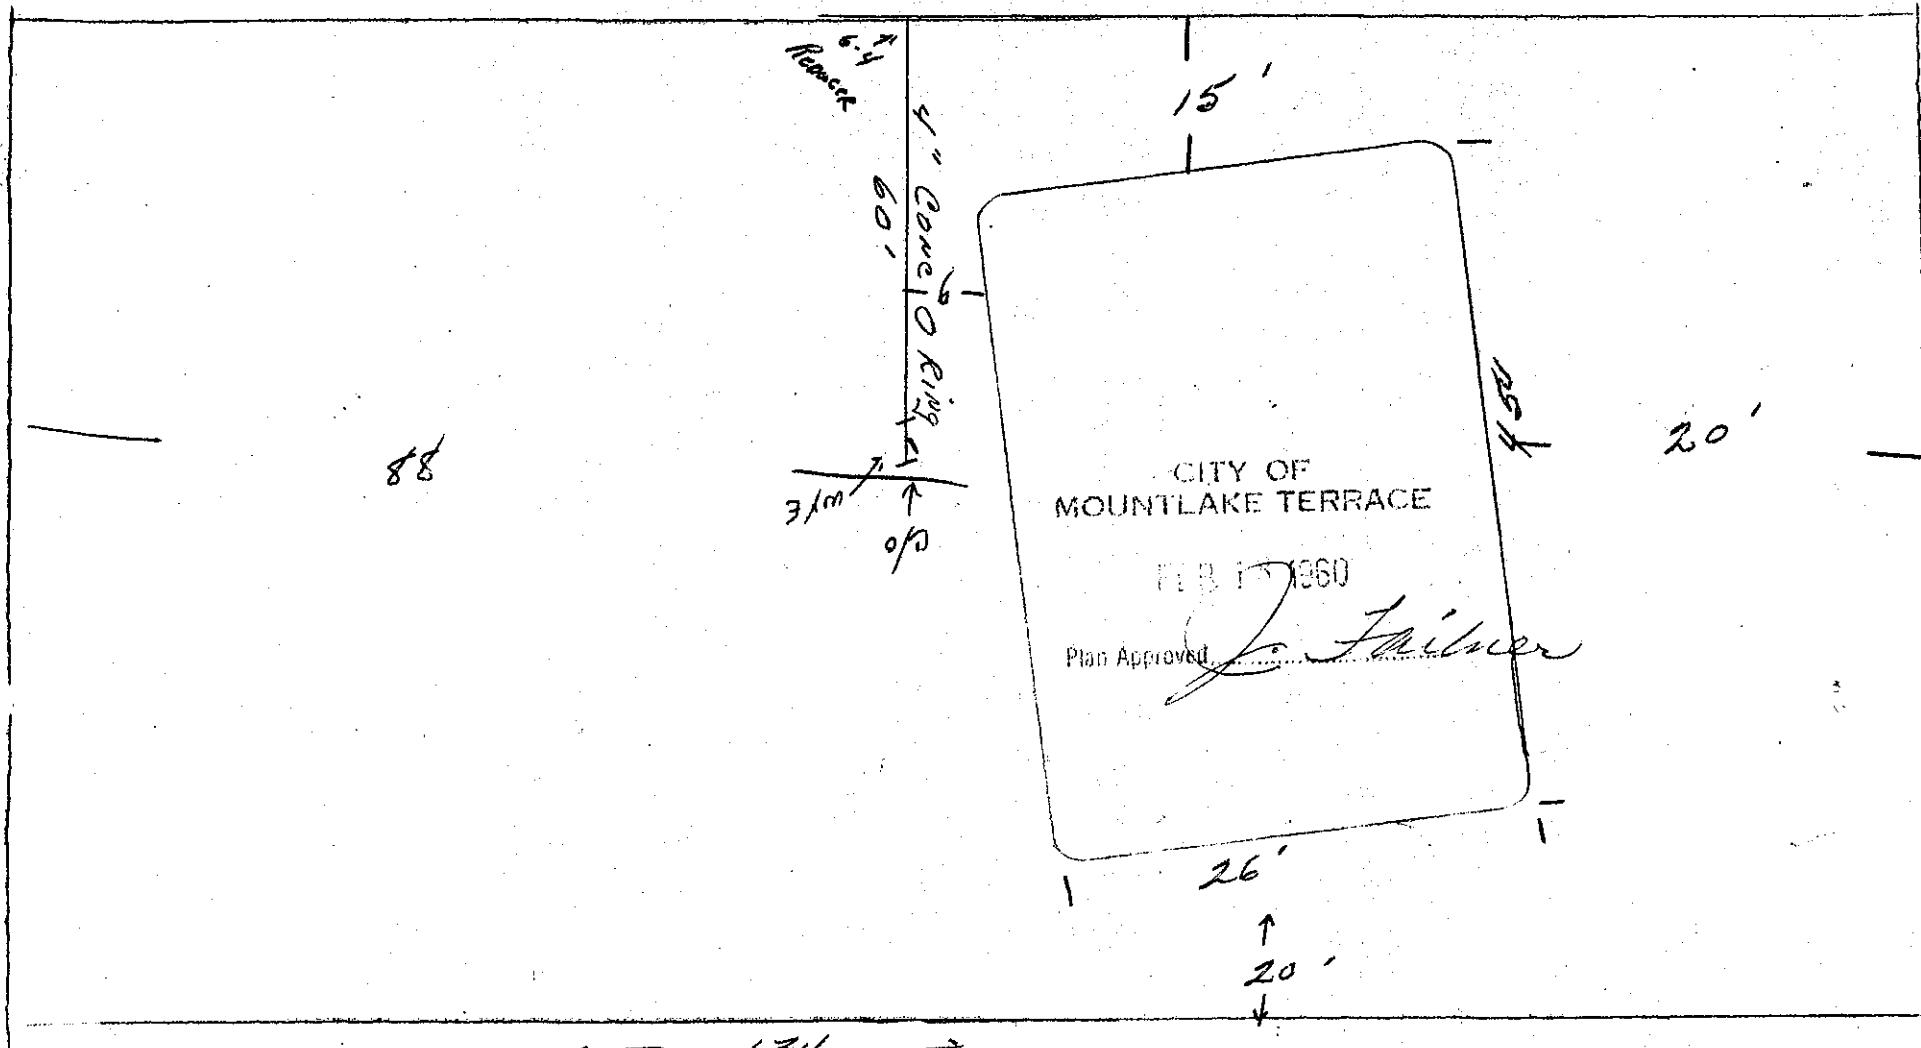

Date

1/24

Approved:

BACKFILL WORK ORDER ISSUED

DEPOSIT, \$ 10.00

0 10 1. 0 4 m 11. 0t

The City of Mountlake Terrace

APPLICATION

for

SIDE SEWER PERMIT

OUTSIDE INSIDE REPAIRS

CARD No.

EASEMENT No.

1392410

OWNER *John P. Martin*
HOUSE No. 22301 54th

CONTRACTOR *Clarkson & Martinini*


STREET
AVENUE LOT No.

52

BLOCK No.

NAME ADD *Div 7 22*

PERMIT No. 2457

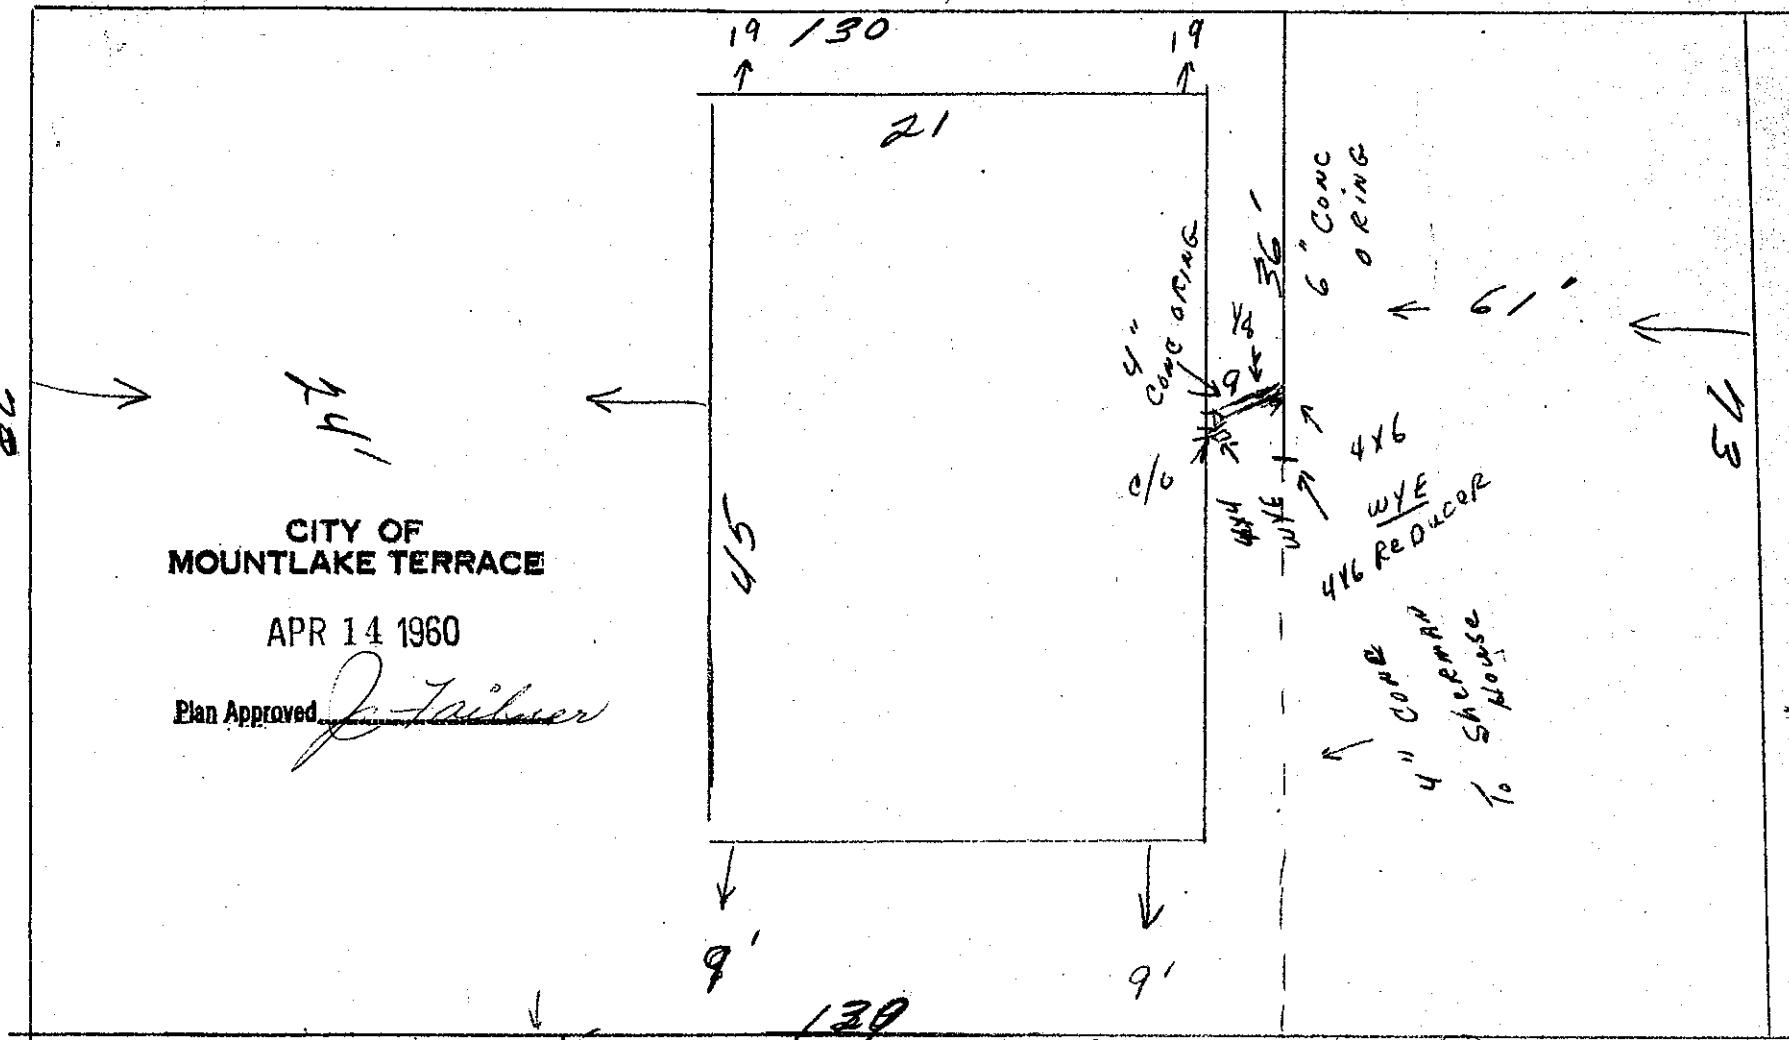

BACKFILL WORK ORDER ISSUED

DEPOSIT, \$10.00

SEWER WORK ORDER ISSUED

DATE 4/14/60

BY

The City of Mountlake Terrace

APPLICATION

for

SIDE SEWER PERMIT

OUTSIDE INSIDE REPAIRS

CARD NO.

EASEMENT NO.

1392410

HARRY Sherman

OWNER Harry Sherman

HOUSE No. 2230 1/2 54th W.

+ 130' -


CONTRACTOR CARBON & MARTIN PERMIT NO. 2458

STREET

AVENUE LOT No. 53

BLOCK No.

NAME ADD. Div # 22

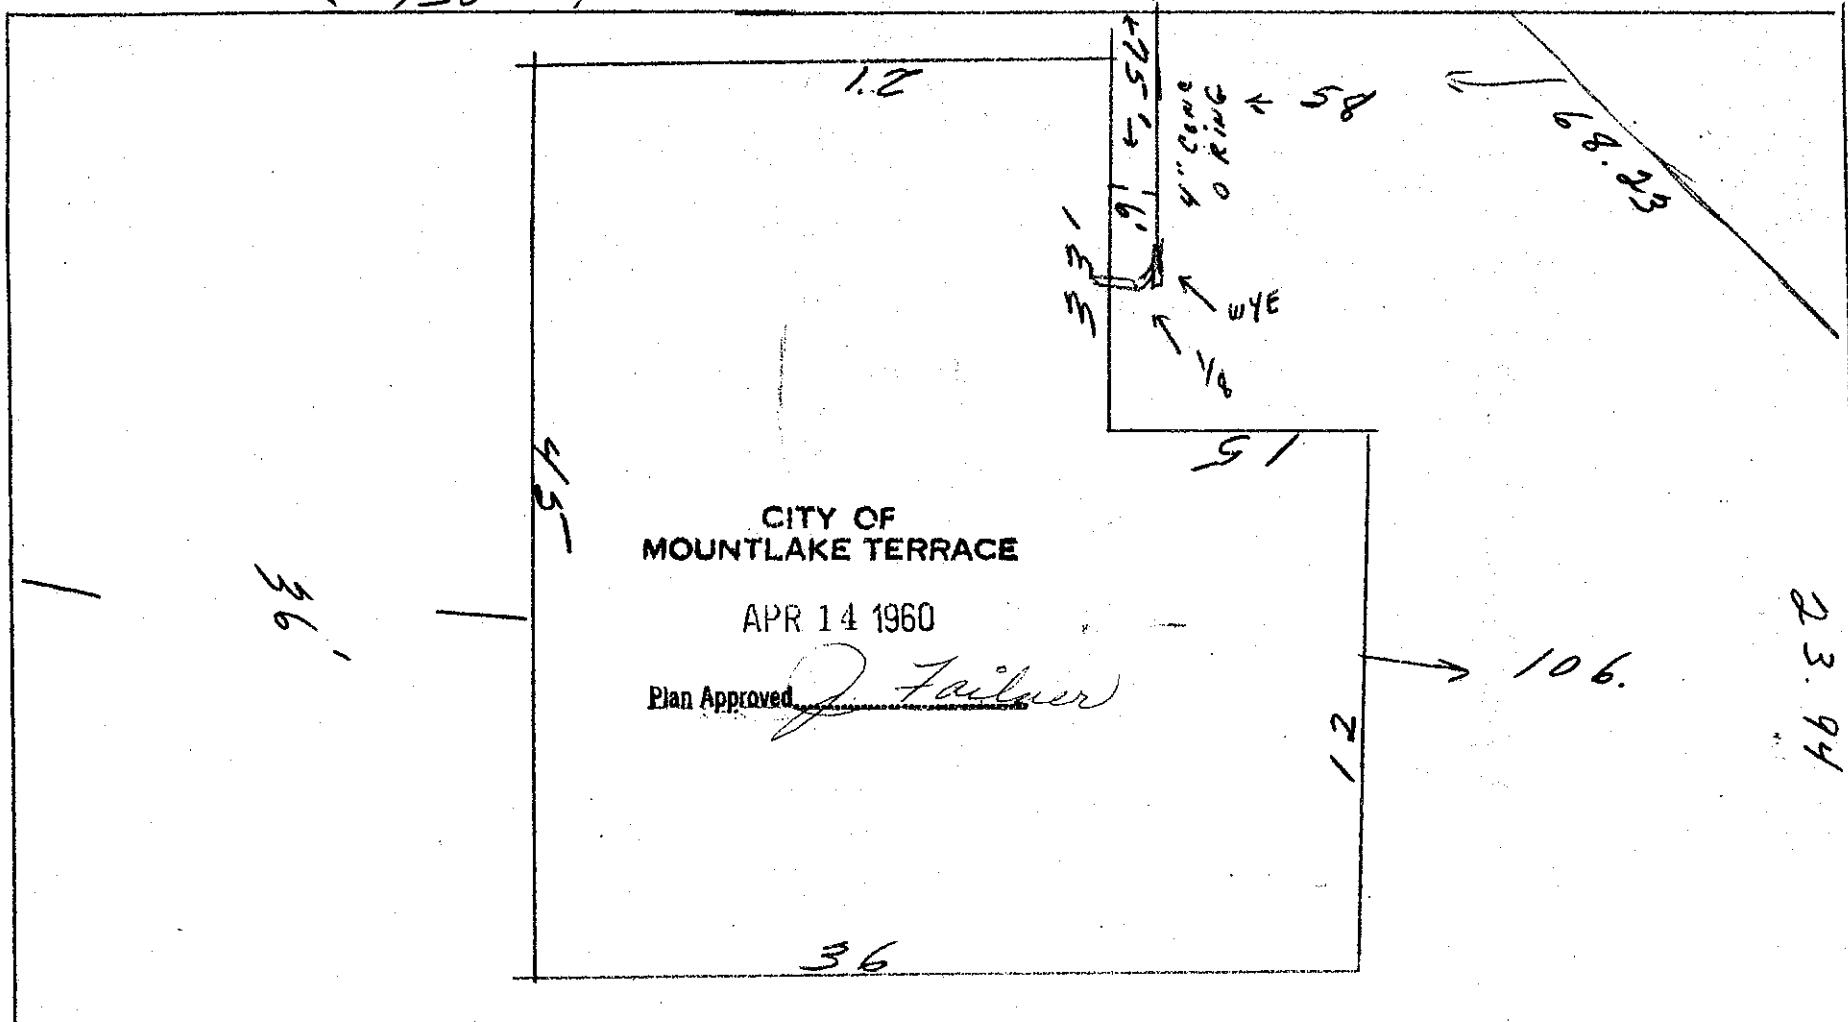

CITY OF
MOUNTLAKE TERRACE

APR 14 1960

Plan Approved

J. Faehner

BACKFILL WORK ORDER ISSUED

Date

DEPOSIT, \$10.00

SEWER WORK ORDER ISSUED

Approved:

reg. #1247

DATE

4/14/60 BY J. Faehner

The City of Mountlake Terrace

APPLICATION

for

SIDE SEWER PERMIT

OUTSIDE INSIDE REPAIRS

CARD No.

1362086

OWNER E. Absher

HOUSE No. 22307 54W

CONTRACTOR Evergreen Const.

PERMIT NO. 1541

STREET
AVENUE LOT No.

54 Mt. Lk. Terrace Dr. #22

BLOCK No.

NAME ADD


68'

11'

C.O.

41'
4" LINE

C.O.

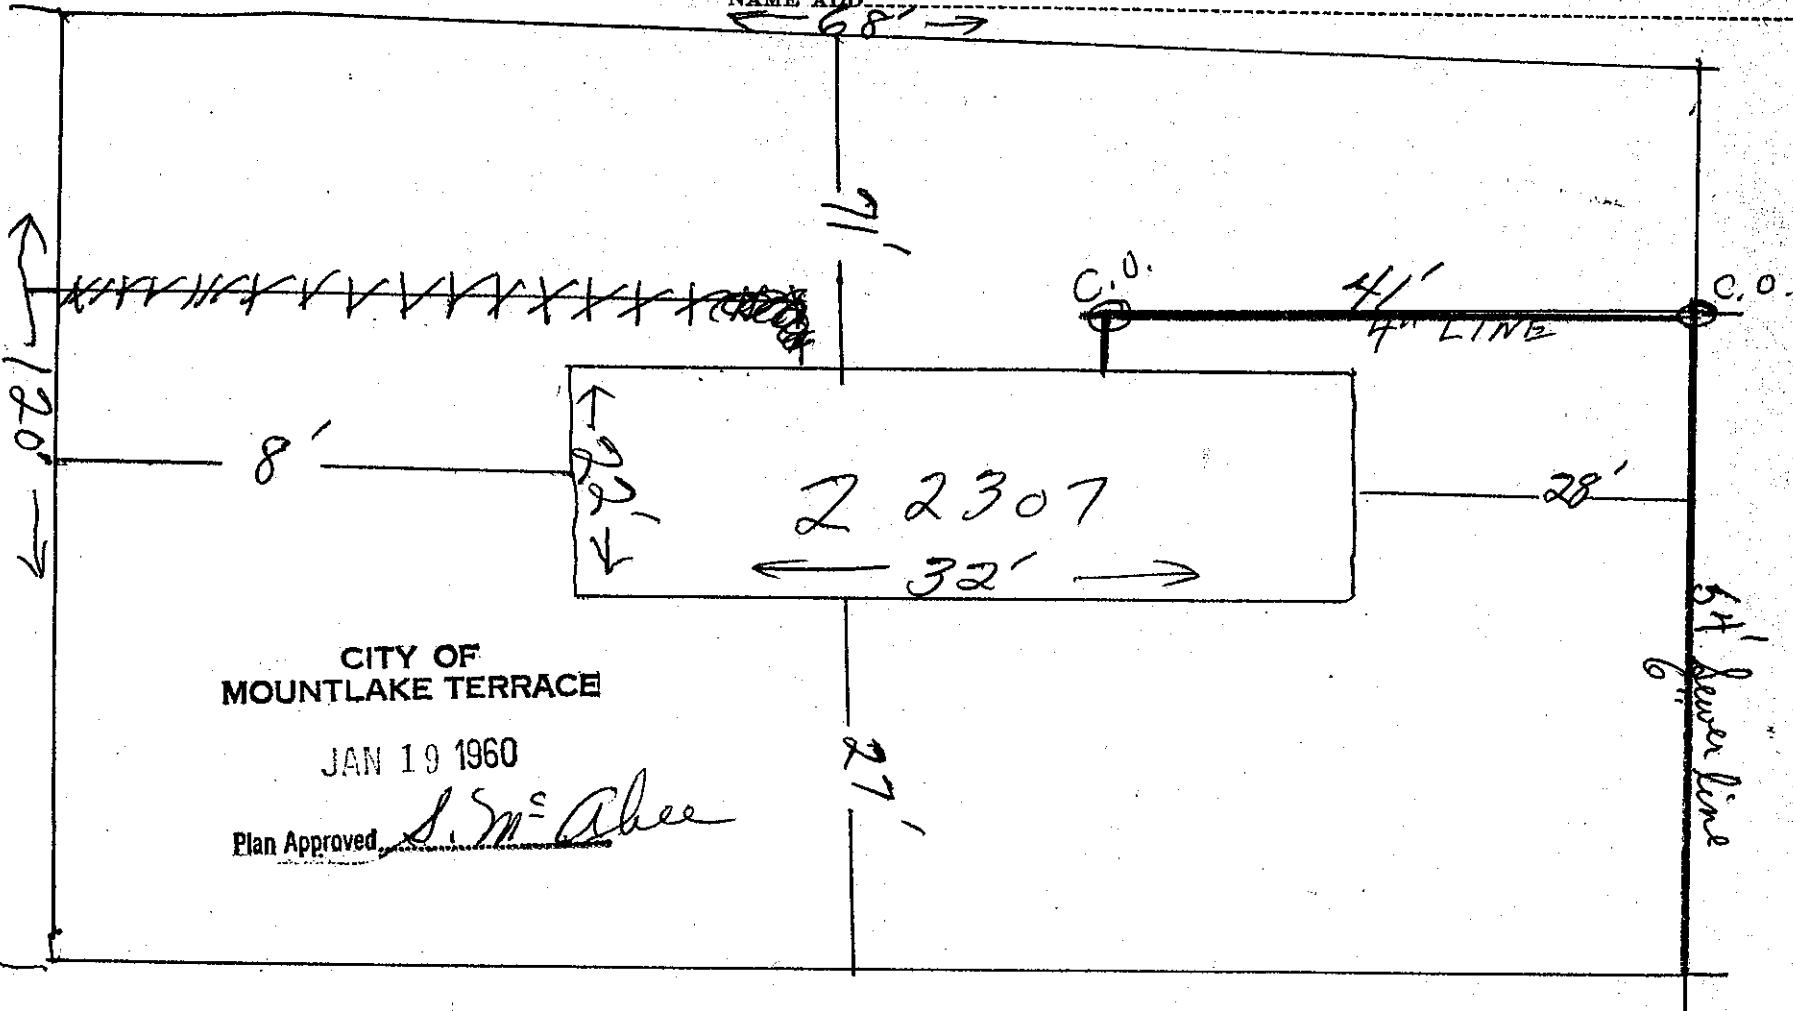

CITY OF
MOUNTLAKE TERRACE

JAN 19 1960

Plan Approved,

S. M. Absher

Date

DEPOSIT, \$ 10.00

BACKFILL WORK ORDER ISSUED

SEWER WORK ORDER ISSUED

Approved:

1/21/60

DATE 1-21-60

BY Scott M. Holton NSXAI-

NUMBER

Mountlake Terrace

APPLICATION

for

SIDE SEWER PERMIT

OUTSIDE INSIDE REPAIRS

CARD NO.

BASEMENT No. 1363086

OWNER E. A. Mauzer

HOUSE No. 22309 - 54th W.


CONTRACTOR Evergreen Coast

PERMIT NO. 1542

STREET

AVENUE LOT NO.

NAME ADD.

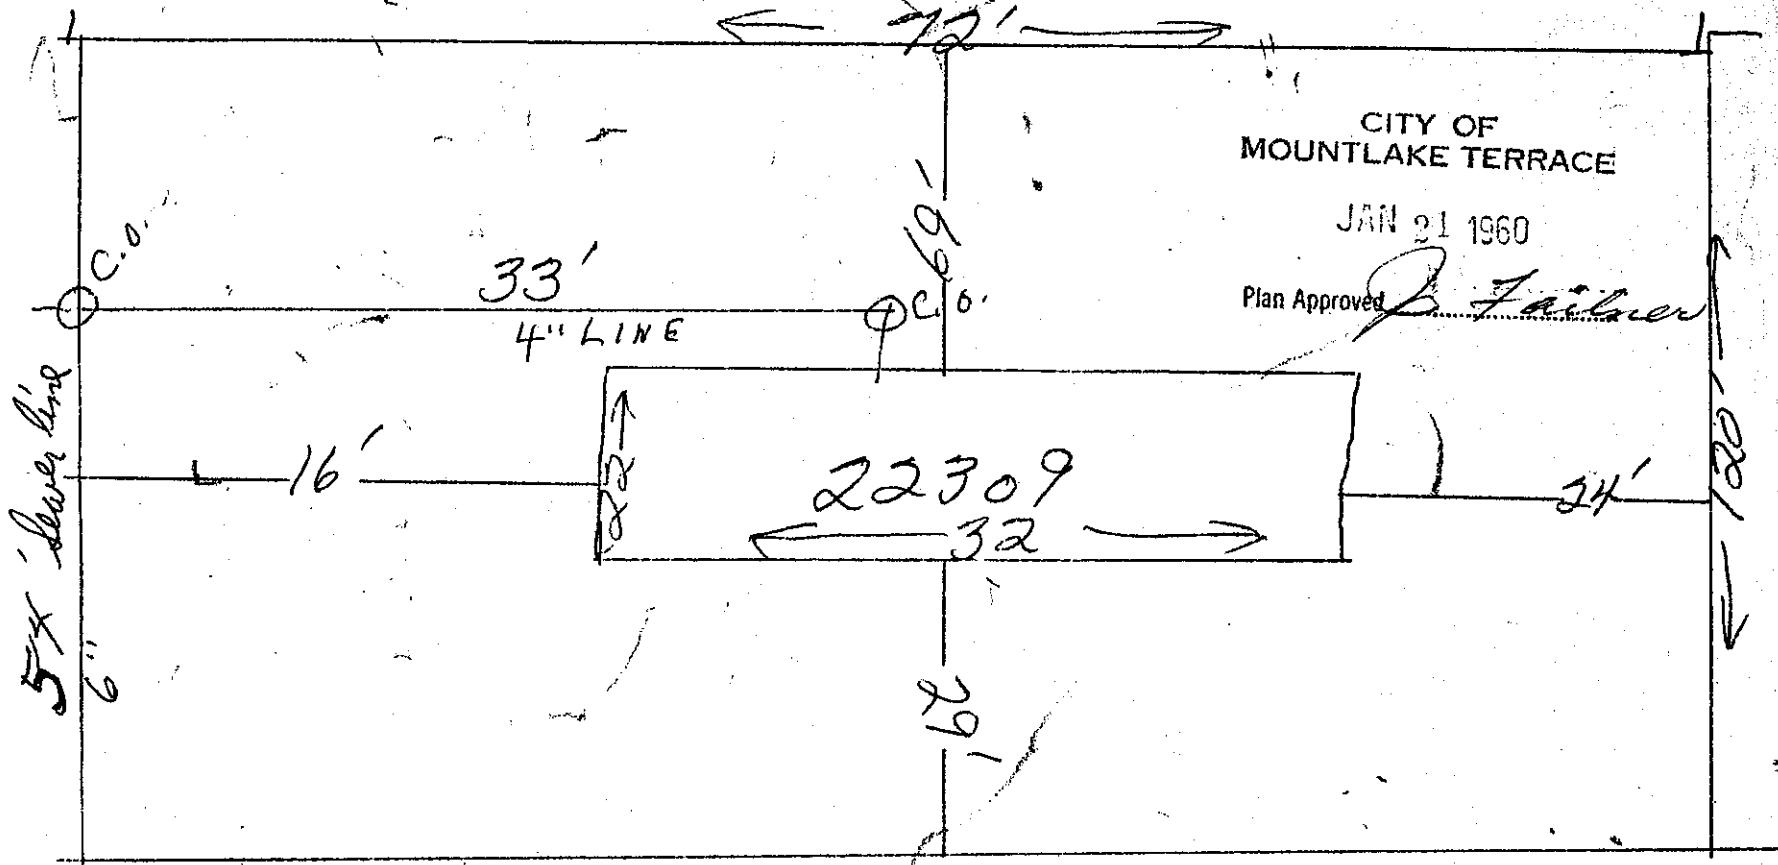DUE 2/22
BLOCK NO. 55

BACKFILL WORK ORDER ISSUED

SEWER WORK ORDER ISSUED

Date

DEPOSIT, \$ 10.00

1/21/60

#556

Approved:

DATE

1-21-60 BY Scott M. Holloman INSTAC

Z. J. 3/14/60

The City of Mountlake Terrace

APPLICATION

for

SIDE SEWER PERMIT

OUTSIDE INSIDE REPAIRS

S.K. Nelson

CARD No.

EASEMENT No. 1381129

OWNER S.K. Nelson

CONTRACTOR

PERMIT No. 1785-


HOUSE No. 22803 - 54th - West

STREET
AVENUE LOT NO. 2

BLOCK No. 1

NAME ADD

Dist 12

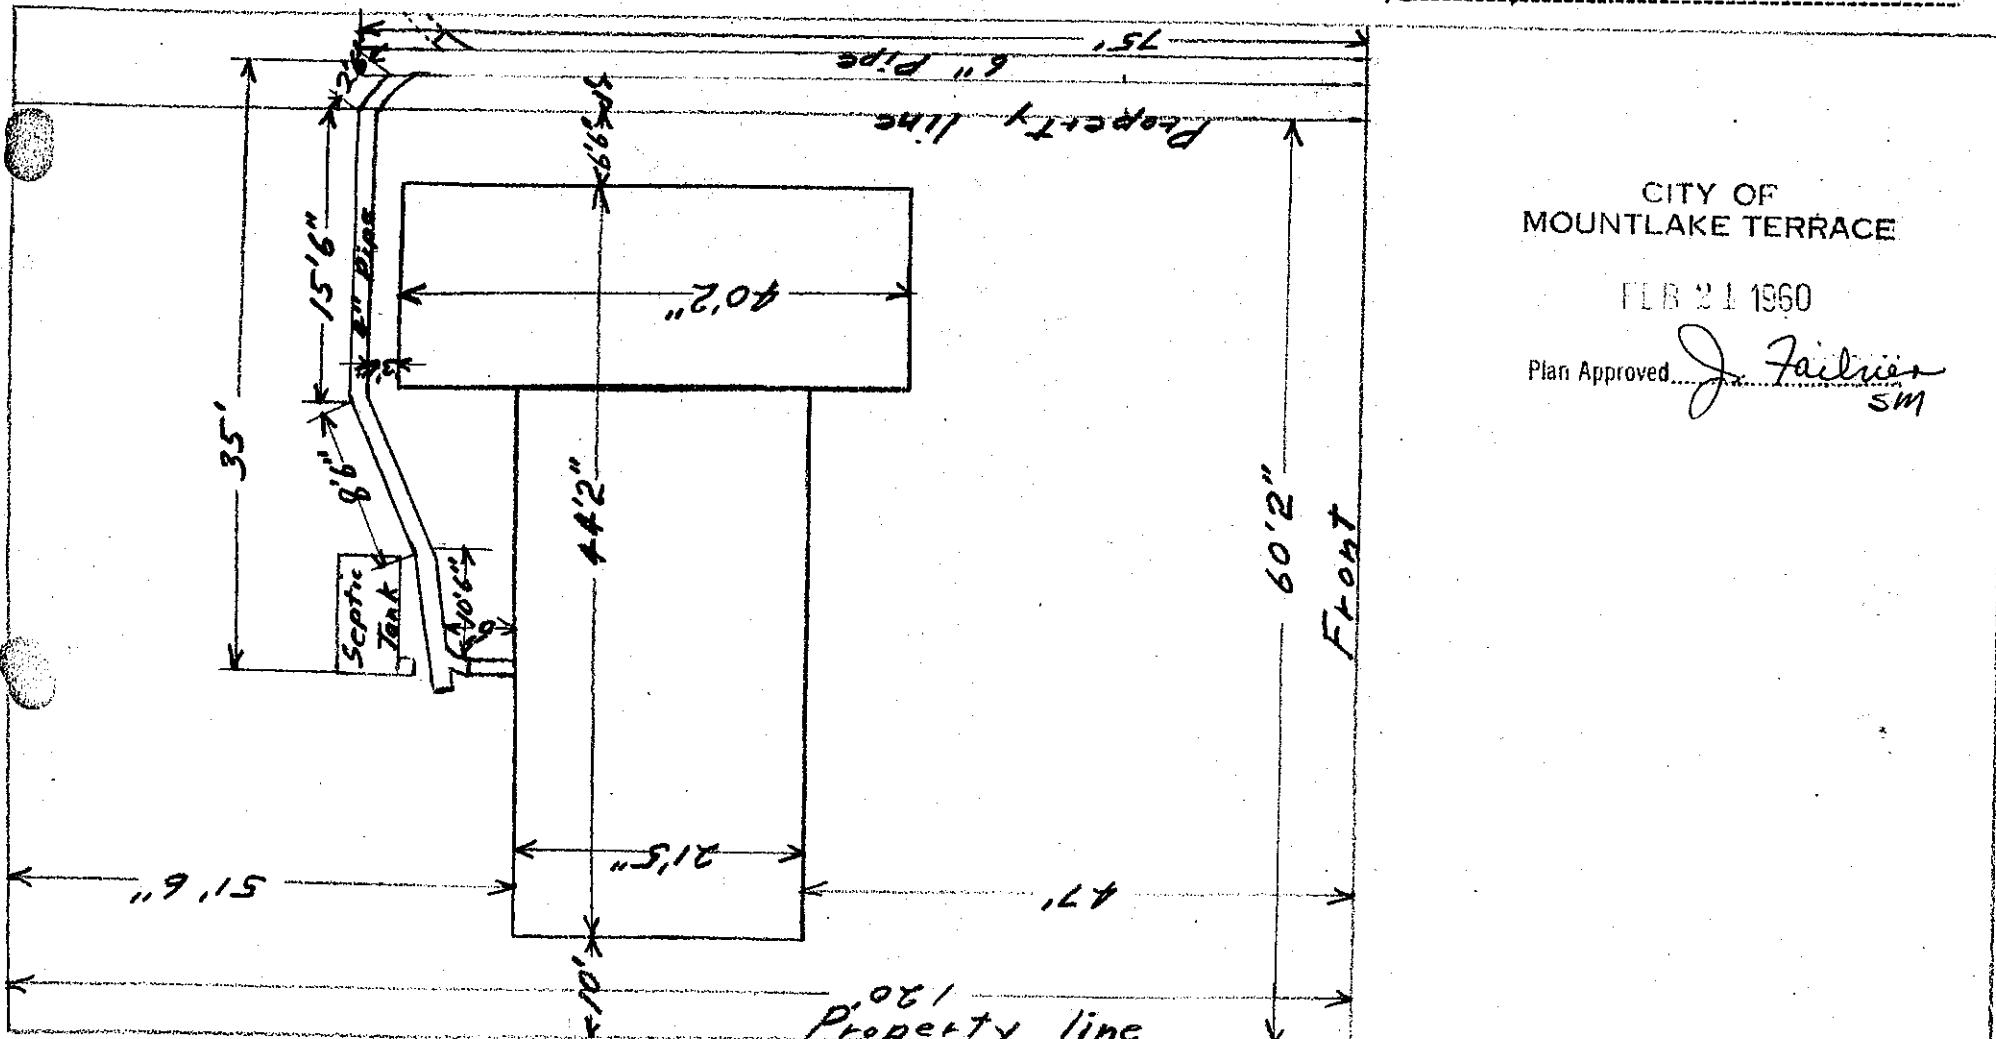

CITY OF
MOUNTLAKE TERRACE

FEB 21 1960

Plan Approved

J. Fairies
sm

BACKFILL WORK ORDER ISSUED

Date

DEPOSIT, \$10.00

Approved:

SEWER WORK ORDER ISSUED

2-24-60

DATE

3-3-60 BY S. Cotton Hutton INS CO

The City of Mountlake Terrace

APPLICATION

for

SIDE SEWER PERMIT

OUTSIDE INSIDE REPAIRS

E. L. McADDEN

CARD NO.

EASEMENT NO.

OWNER E L M^c ADDEN
HOUSE No. 22804-W54*

CONTRACTOR


HILLS CONST CO

PERMIT NO. 1274

STREET
AVENUE LOT NO. 19

BLOCK NO. 2

NAME ADD. Blk 14

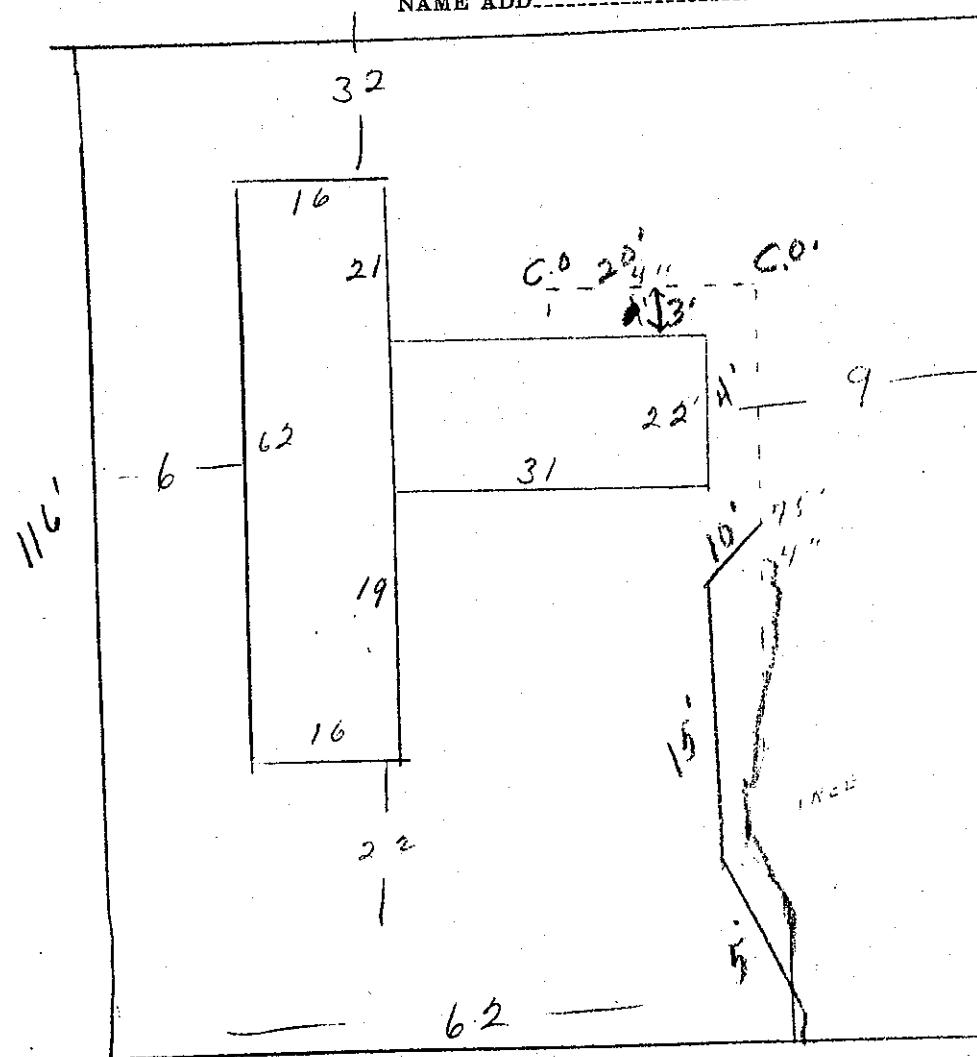

CITY OF
MOUNTLAKE TERRACE

DEC 4 1959

Plan Approved

J. Fairnes
SMH

Date

Approved:

DEPOSIT, \$

BACKFILL WORK ORDER ISSUED

SEWER WORK ORDER ISSUED

DATE 12-4-59

BY

Scott McHoltz

The City of Mountlake Terrace

APPLICATION

for

SIDE SEWER PERMIT

OUTSIDE INSIDE REPAIRS

R.E. OTTO
CARD No.

EASEMENT No.

1381129

OWNER

R.E. Otto

HOUSE No.

22805 W. 54

CONTRACTOR

Self

STREET
AVENUE LOT NO.

3

PERMIT No.


1742

BLOCK No.

1

NAME ADD.

DIV. 12

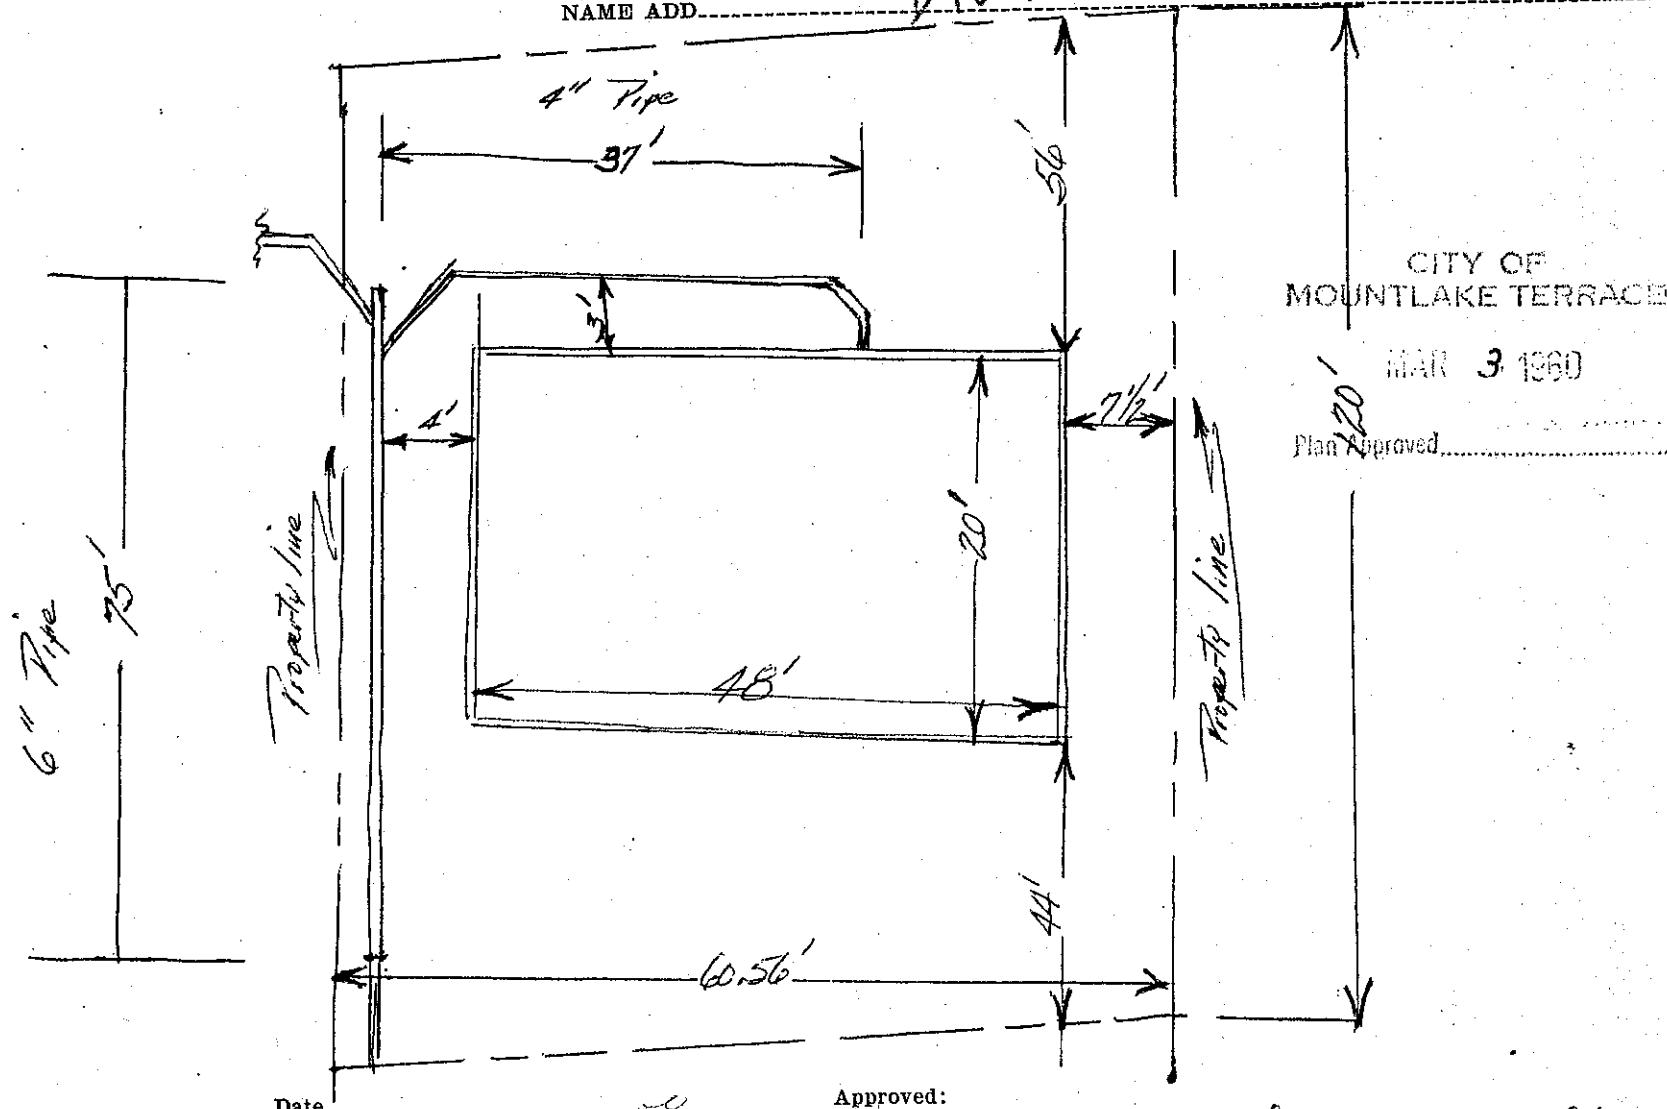

BACKFILL WORK ORDER ISSUED

SEWER WORK ORDER ISSUED

APPLICATION

for

SIDE SEWER PERMIT

OUTSIDE INSIDE REPAIRS

② EDITH LAMB

CARD No.

The City of Mountlake Terrace

EASEMENT NO.

OWNER Edith M. Lamb

CONTRACTOR Gordon E. Bartlett, Inc.

PERMIT No.

HOUSE No. 22806


54th WestSTREET
AVENUE LOT NO. 18

BLOCK NO. 2

NAME ADD. Mountlake Terrace Div. No. 14

865

60 ft.

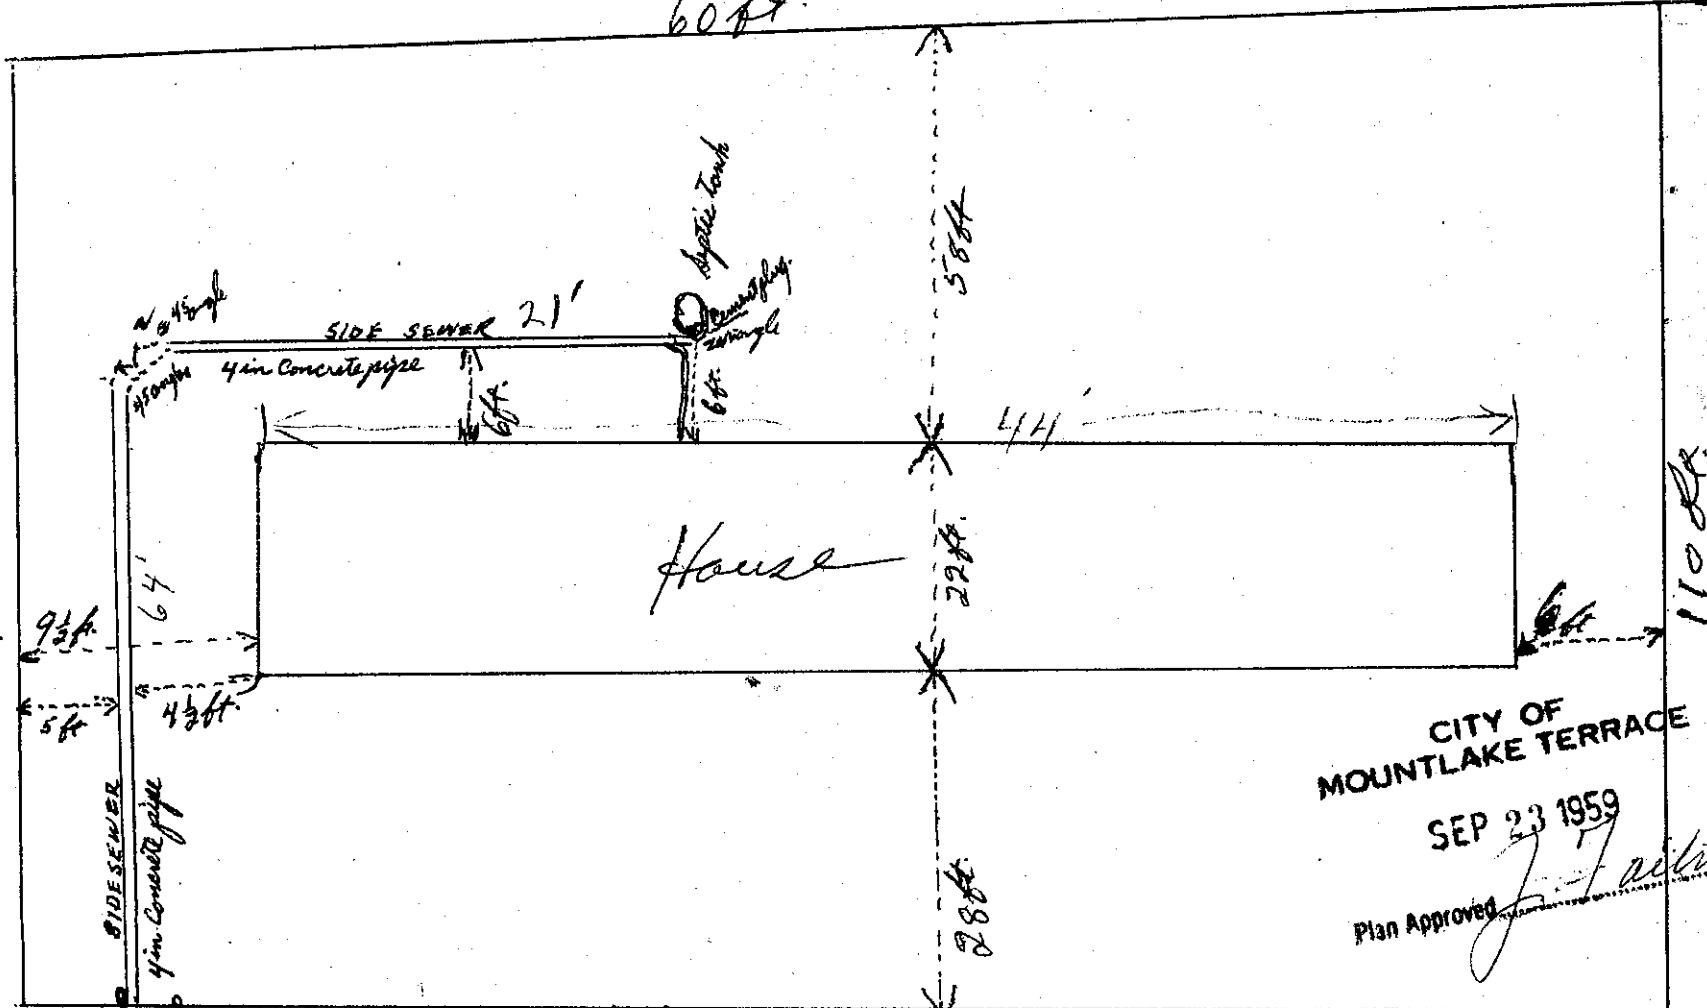CITY OF
MOUNTLAKE TERRACE

SEP 23 1959

Plan Approved

Date

60ft

Approved:

DEPOSIT, \$10⁰⁰

9/19/59

DATE

9-24-59 BY Scott M Holton

BACKFILL WORK ORDER ISSUED

SEWER WORK ORDER ISSUED

APPLICATION

for

SIDE SEWER PERMIT

The City of Mountlake Terrace

R. K. JOHNSON
CARD NO.OUTSIDE INSIDE REPAIRS

EASEMENT NO.

OWNER ROBERT K. JOHNSON

CONTRACTOR SELF


PERMIT NO. 1923

HOUSE NO. 22806 54 WEST

STREET AVENUE LOT NO. 17

2

NAME ADD. MOUNTLAKE TERRACE DIV. # 14

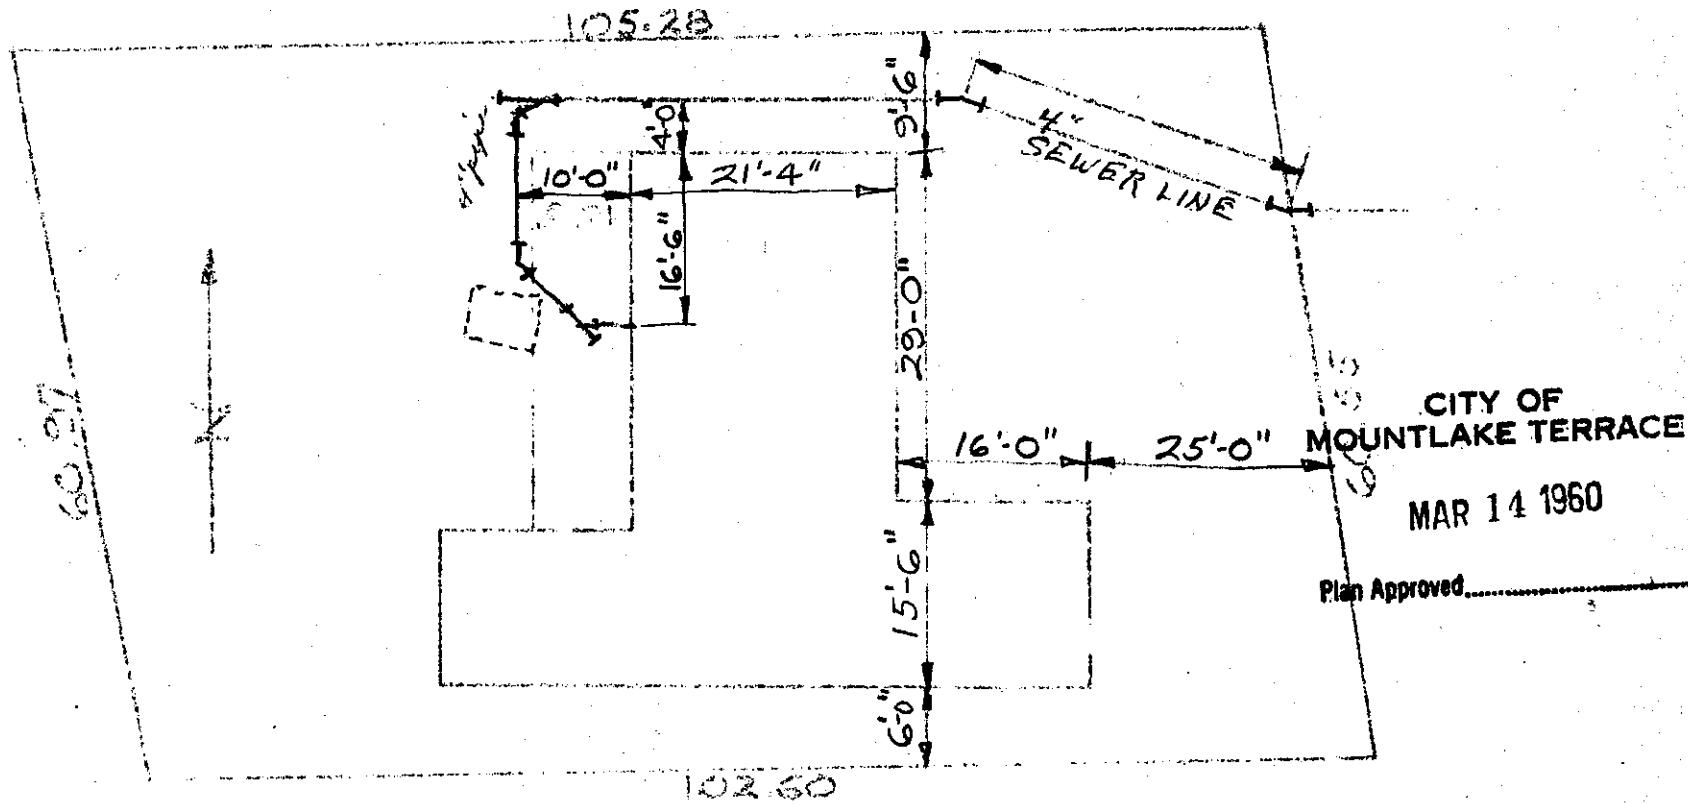

Date

Approval:

BACKFILL WORK ORDER 101130
OWNER WORK ORDER 182002

DEPOSIT: \$10.00

3/16/60

DATE: 3-14-60

BY Scott McHale INST. NO.

The City of Mountlake Terrace

APPLICATION

for

SIDE SEWER PERMIT

OUTSIDE INSIDE REPAIRS

CARD NO.

EASEMENT No. 1353916

(2) Roy H. Renier

OWNER Roy H Renier
HOUSE No 22809 W 54th


CONTRACTOR GORDON E BARTLETT

PERMIT No. 905

STREET
AVENUE LOT NO. 5

BLOCK No. 1 DIV 12

NAME ADD.

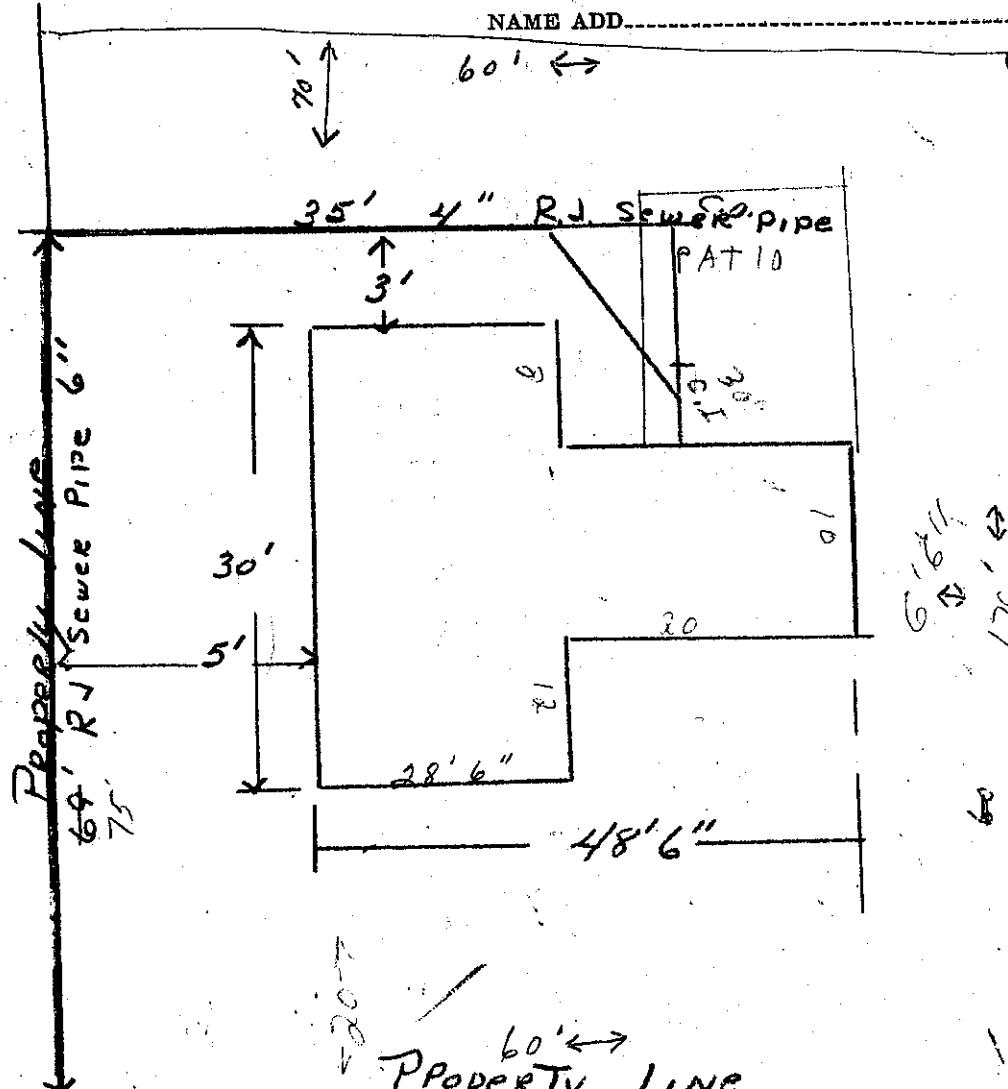

BACKFILL WORK ORDER ISSUED
SEWER WORK ORDER ISSUED

Date

DEPOSIT, \$ 10.00

Ref. # 4984

Approved:

9-26-59

DATE

Scott M Holton IWS.

Plan Approved

SEP 25 1959

CITY OF
MOUNTLAKE TERRACE

J. Faithur

The City of Mountlake Terrace

APPLICATION

for

SIDE SEWER PERMIT

OUTSIDE INSIDE REPAIRS

EDNA. HOLM
CARD No.

EASEMENT No.

OWNER: Edna Holm

CONTRACTOR: B & C.

PERMIT No. 178


HOUSE No. 22810 - 54th SW.

STREET AVENUE LOT No. 16 DIV 14

BLOCK No. 2

NAME ADD:

60.97

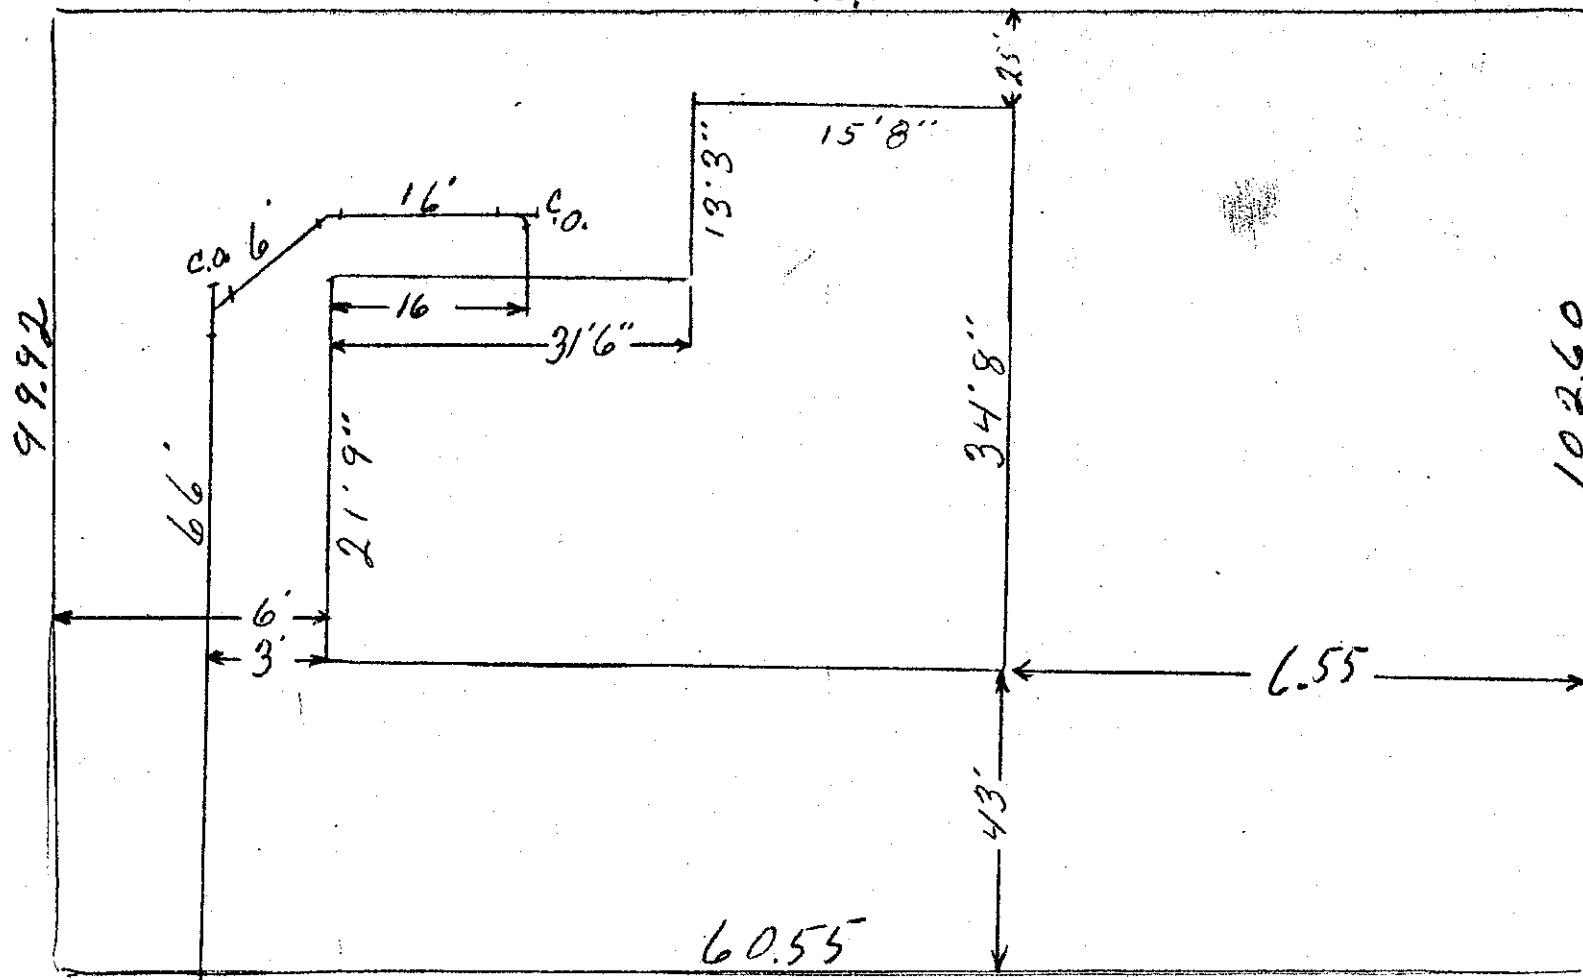

Date

Approved:

BACKFILL WORK ORDER ISSUED

DEPOSIT, \$ 10.00

SEWER WORK ORDER ISSUED

DATE

6/13/66

J. D. M.

8-15-60
The City of Mountlake Terrace

APPLICATION

for

SIDE SEWER PERMIT

OUTSIDE INSIDE REPAIRS

CHARLES H. PHIPPS

CARD No. 2

EASEMENT No. None

OWNER CHARLES H. PHIPPS


HOUSE NO. 22901 - 54 W

CONTRACTOR GORDON E. BARTLETT INC. PERMIT NO. 907

STREET 6
AVENUE LOT NO.

BLOCK NO. 1

NAME ADD. DIV # 12

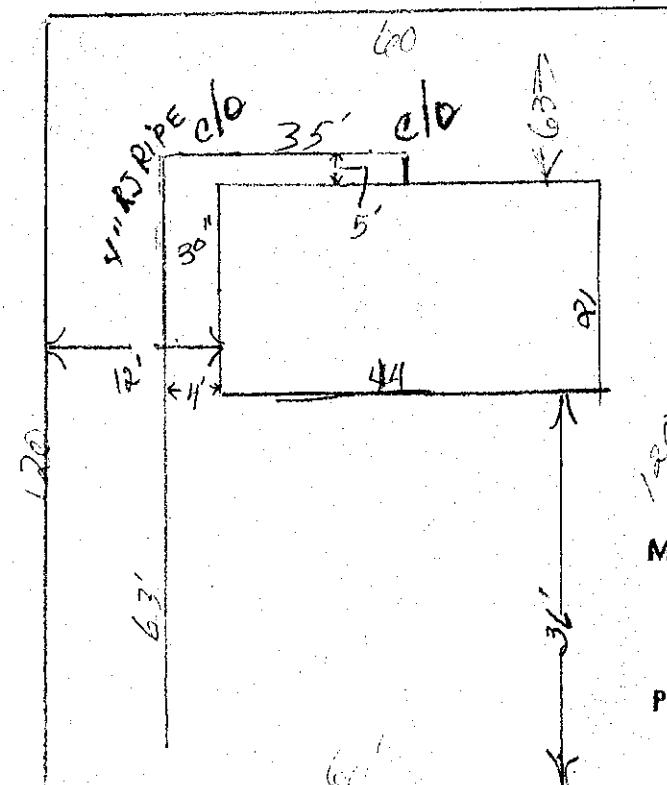

CITY OF
MOUNTLAKE TERRACE

SEP 25 1959

Plan Approved,

J. Faistner

Date

Approved:

BACKFILL WORK ORDER ISSUED

DEPOSIT, \$10.00

DATE

9-26-59

SEWER WORK ORDER ISSUED

R. # 1981

BY *Scott M Holton INS.*

The City of Mountlake Terrace

CARD NO.

SIDE SEWER PERMIT

OUTSIDE INSIDE REPAIRS

BASEMENT No. None

OWNER J. H. SCEELES

CONTRACTOR WINGFIELD - BROWN


PERMIT No. 934

HOUSE NO. 22902 54TH AVE.

STREET
AVENUE LOT NO. ~~22~~ 15

BLOCK NO. 2 DIV. 14

NAME ADD.

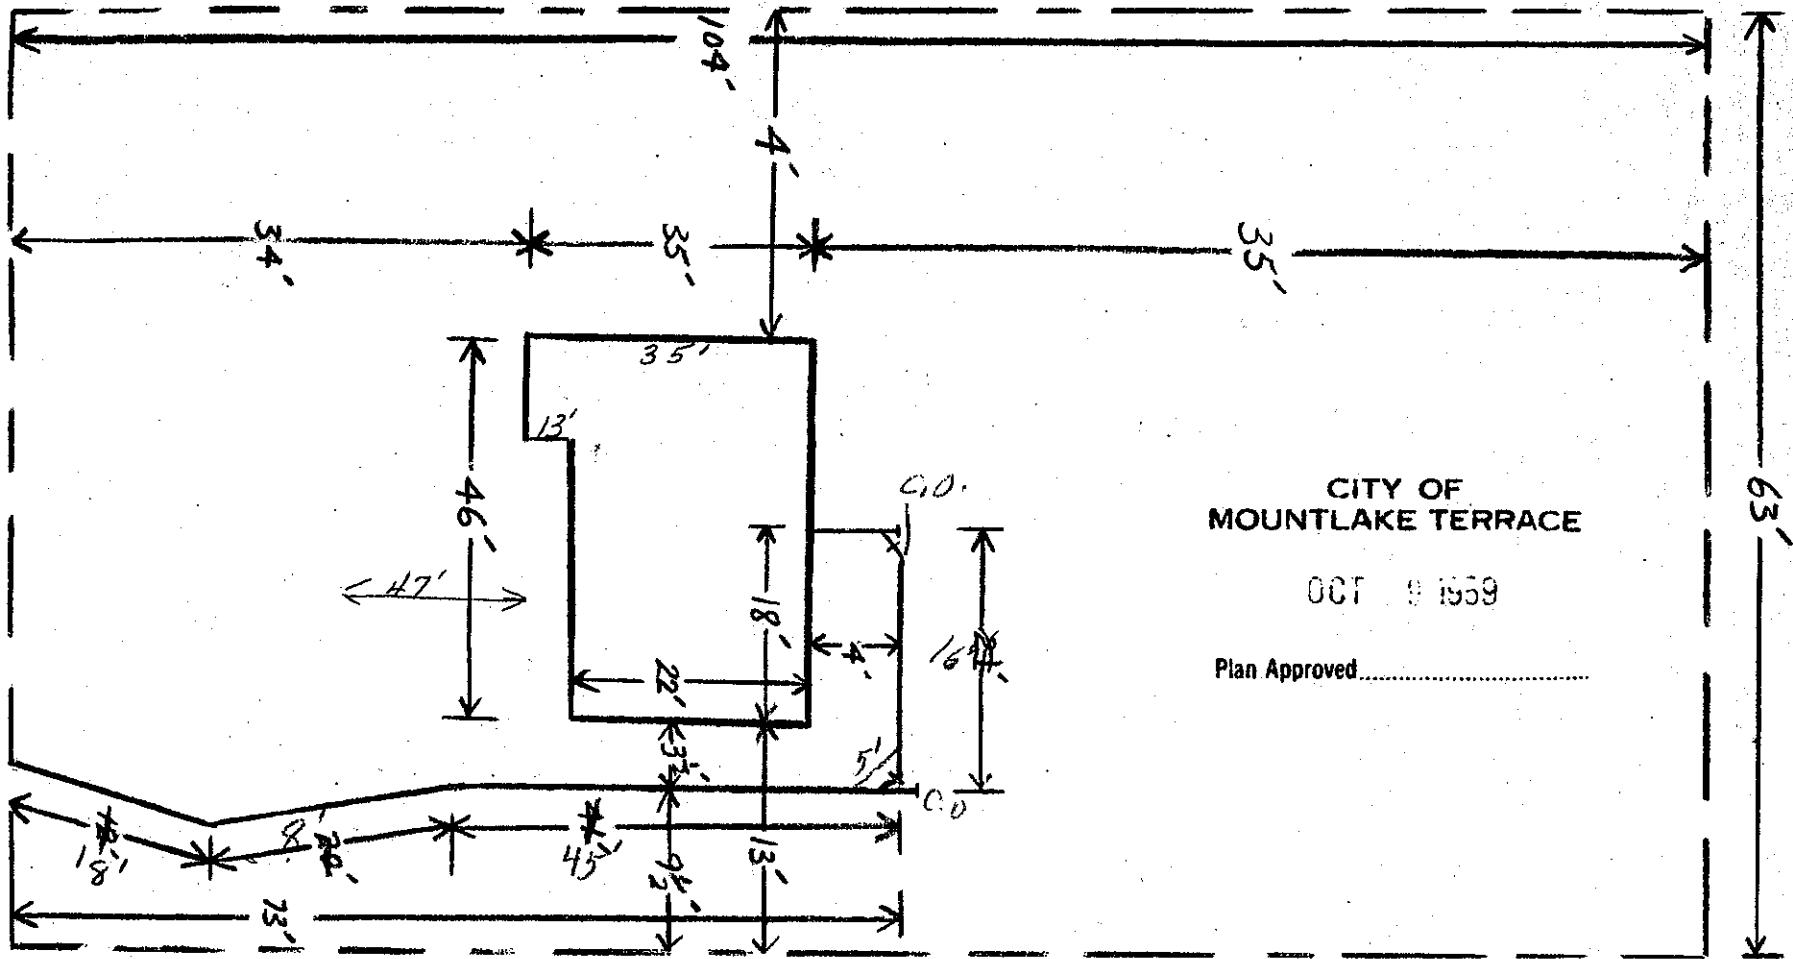

Date

Approved:

BACKFILL WORK ORDER ISSUED

DEPOSIT, \$ 10.00

SEWER WORK ORDER ISSUED

Rec. 5034

DATE 10-9-59

BY

Scott M Holton INS
9/30/59 Dyest 1-11-60 INST CON 8 MTH N.C.

APPLICATION

for

SIDE SEWER PERMIT

The City of Mountlake Terrace

CARD No.

OUTSIDE INSIDE REPAIRS

EASEMENT No. 1343277

OWNER Michael Southey
HOUSE No. 22903 - 54 1/2 W.


CONTRACTOR Wingfield-Brown

STREET
AVENUE LOT NO. 7

PERMIT No. 1772

NAME ADD.

Dir. #12

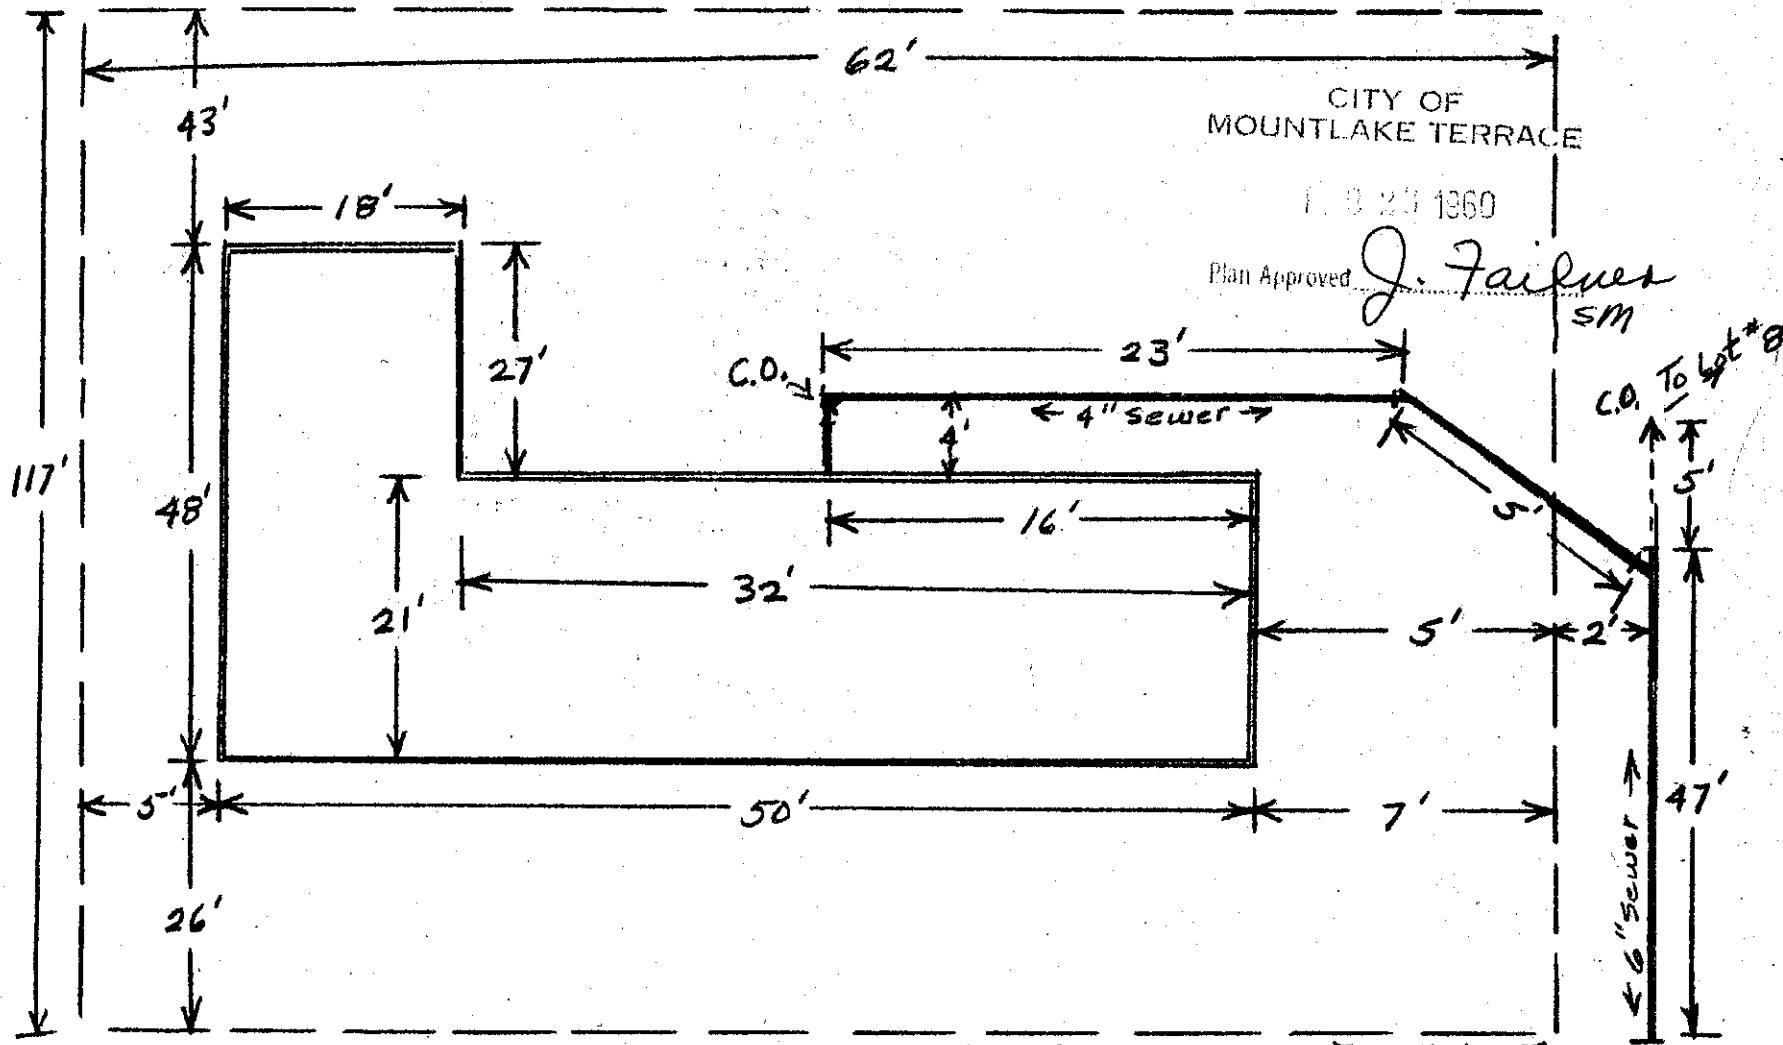

BACKFILL WORK ORDER ISSUED

DEPOSIT, \$10 *Gu*

SEWER WORK ORDER ISSUED

2-23-60

DATE 3-3-60

642
cc

BY Scott on Holton INSTCON

The City of Mountlake Terrace

APPLICATION

for

SIDE SEWER PERMIT

OUTSIDE INSIDE REPAIRS

CARD NO.

EASEMENT NO.

OWNER GEORGE R. REILLY

HOUSE No. 22904 - 54th Ave. WEST

CONTRACTOR

Gordon Bartlett Inc.

PERMIT NO.

867

STREET

AVENUE LOT No.


14

BLOCK NO.

TWO (2)

NAME ADD.

Dir 14

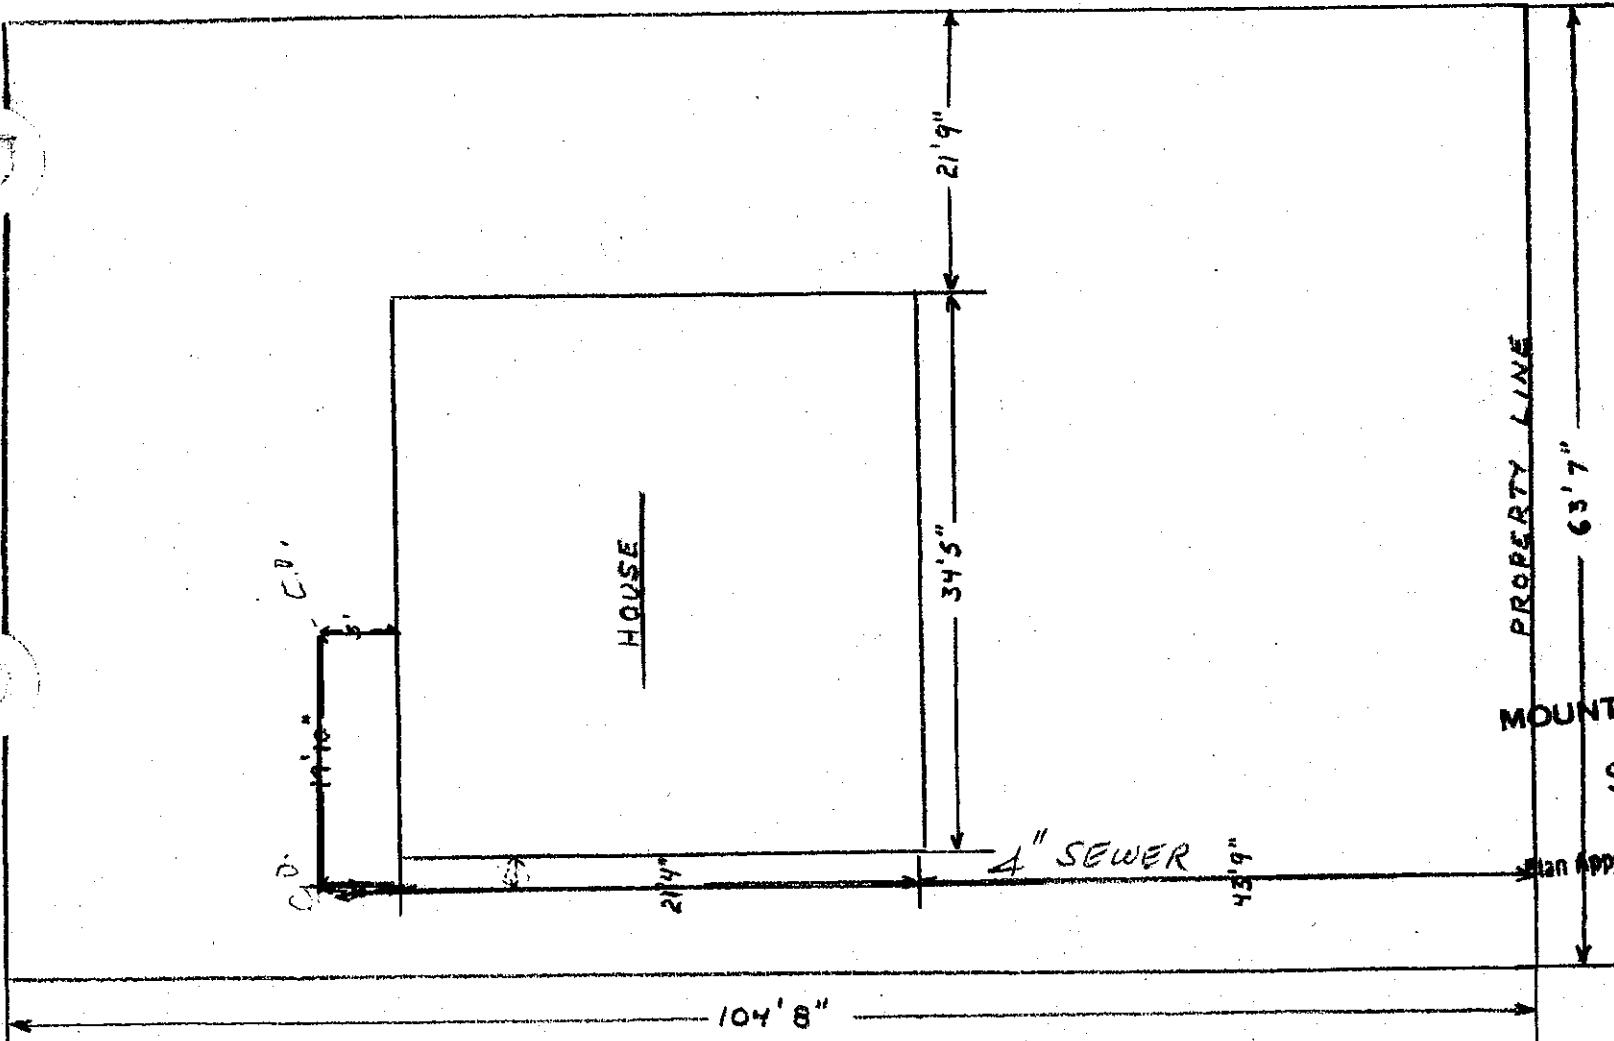

CITY OF
MOUNTLAKE TERRACE

SEP 23 1959

Plan Approved

J. Faillue

Date

Approved:

BACKFILL WORK ORDER ISSUED

DEPOSIT, \$10.00 9/19/59

SEWER WORK ORDER ISSUED

DATE

9-25-59

BY

Scott M Holton INS.

N.C.

4936

The City of Mountlake Terrace

APPLICATION

FOR

SIDE SEWER PERMIT

OUTSIDE INSIDE REPAIRS

V.C. Macln

CARD NO.

1343277

EASEMENT NO.

OWNER Vernon C. Mueller
HOUSE No. 22905 - 54th W.

CONTRACTOR

Wingfield - Brown

STREET

AVENUE LOT No. 8


PERMIT NO.

1773

BLOCK NO.

Div. #12

NAME ADD.

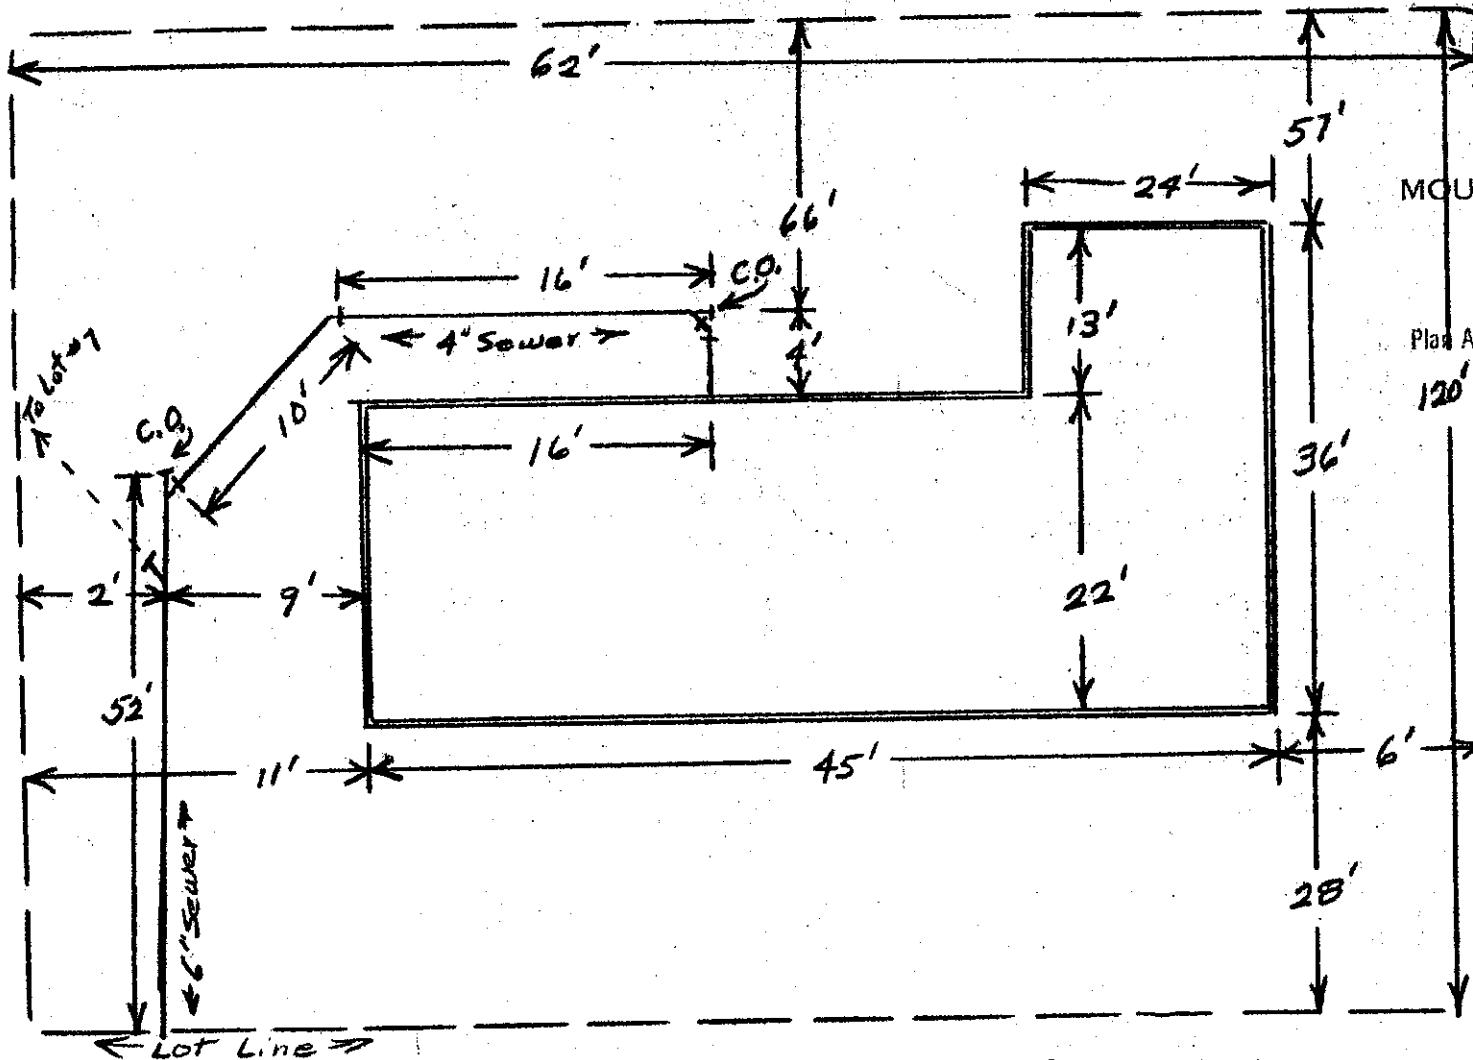

Date

Approved:

2-23-60

DATE

BACKFILL WORK ORDER ISSUED

DEPOSIT, \$10.00

SEWER WORK ORDER ISSUED

642
et

3-3-60 BY Scott M Holton NBScon

The City of Mountlake Terrace

APPLICATION

for

SIDE SEWER PERMIT

OUTSIDE INSIDE REPAIRS

CARD No.

EASEMENT No.

OWNER Paul A. Jarras
HOUSE No. 22906 - 54th Street

CONTRACTOR


STREET
AVENUE LOT No. 13

PERMIT No. 866

BLOCK No. 2

NAME ADD. 14

Lot line 108.73

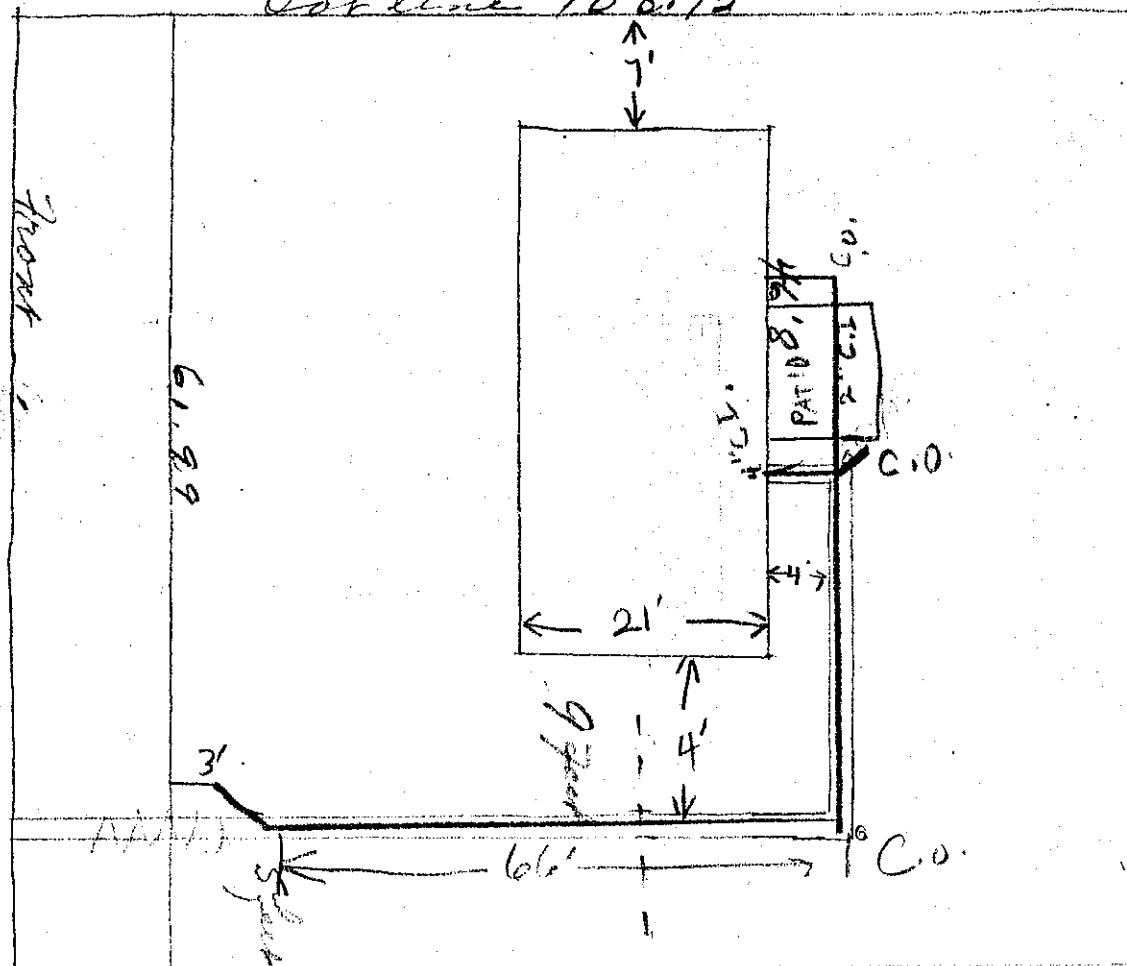

CITY OF
MOUNTLAKE TERRACE

SEP 23 1959

Plan Approved

Date

Approved:

BACKFILL WORK ORDER ISSUED

DEPOSIT, \$

10⁰⁰ 9/9/59

SEWER WORK ORDER ISSUED

DATE 9-25-59 BY Scott M Holton INS.

#4936

271

N

APPLICATION

for

SIDE SEWER PERMIT


The City of Mountlake Terrace

CARD No. *✓*OUTSIDE INSIDE REPAIRS

EASEMENT No.

OWNER JOHN F. TYBURSKI CONTRACTOR Hill Construction PERMIT No. 957
 HOUSE No. 22907-54th W STREET AVENUE LOT No. 9 BLOCK No. 1 DIV-12

NAME ADD.

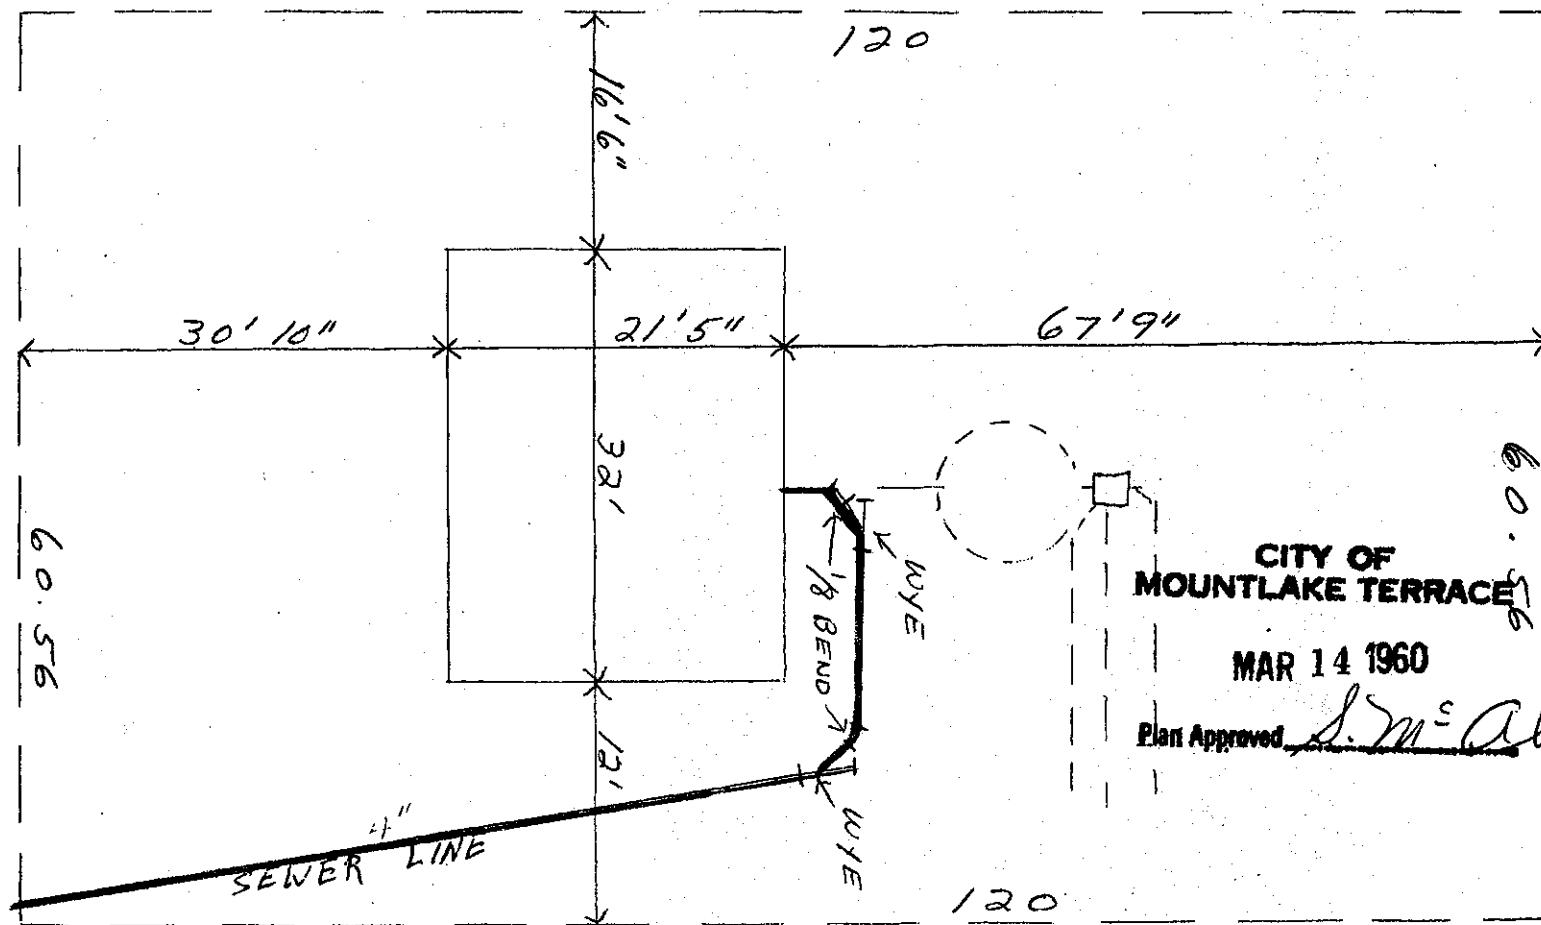

Date

Approved:

BACKFILL WORK ORDER ISSUED

DEPOSIT, \$ 10.00

SEWER WORK ORDER ISSUED

3/12/60

11 8 18

DATE 3-14-60

BY

Scott M Holton/MSYCON

APPLICATION
FORBETTY E. SPANGLER
CARD No.....

The City of Mountlake Terrace

SIDE SEWER PERMIT

OUTSIDE INSIDE REPAIRS

EASEMENT No.....

OWNER BETTY E. SPANGLER + DRIVE M. GUESS
HOUSE No. 2290 8 - W. 54TH

CONTRACTOR


HILL CONSTRUCTION PERMIT NO. 1733

STREET

AVENUE LOT No. 12

BLOCK No. 2 DIV. 14

NAME ADD.....

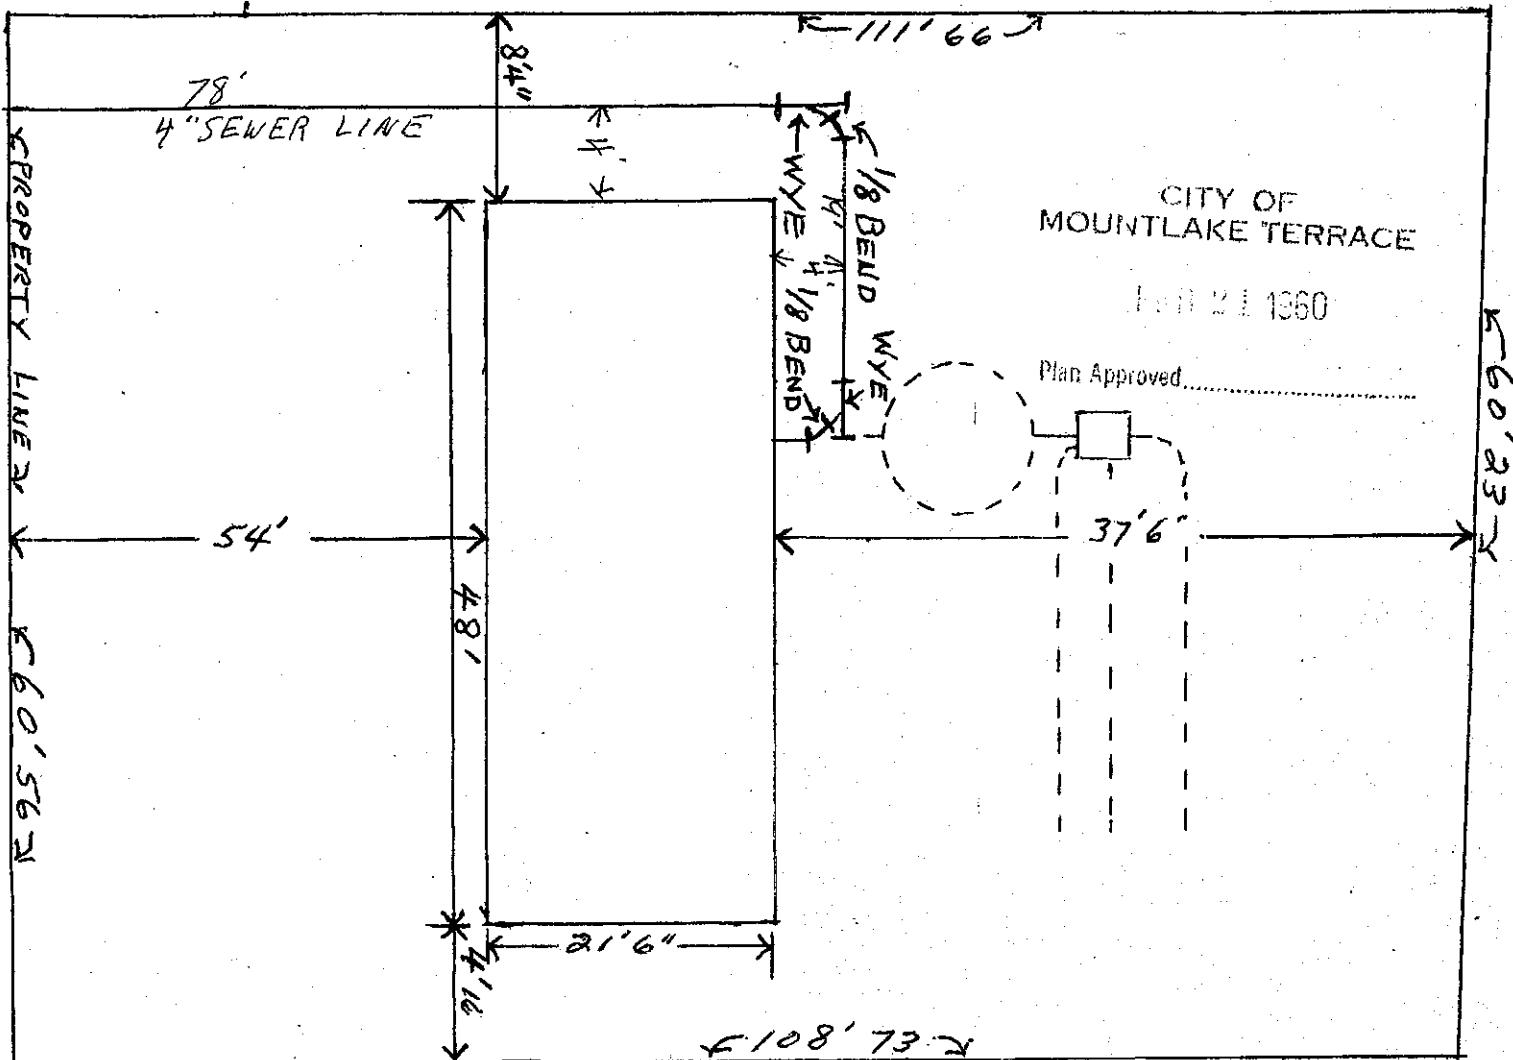

Date

Approved:

BACKFILL WORK ORDER ISSUED

DEPOSIT, \$10.00 2-17-60

SEWER WORK ORDER ISSUED

5966 DATE 2-25-60 BY

Scott M Holton MSYCON

The City of Mountlake Terrace

APPLICATION

for

SIDE SEWER PERMIT

OUTSIDE INSIDE REPAIRS

CARD No.

EASEMENT No. 1377431

OWNER Phillip S. Spoerry
HOUSE NO. 23003 - 5473

CONTRACTOR Self

STREET AVENUE LOT NO. 2


PERMIT No. 2492

BLOCK NO. 4

NAME ADD. Mountlake Terrace Div. No 12

LOT LINE

60.10

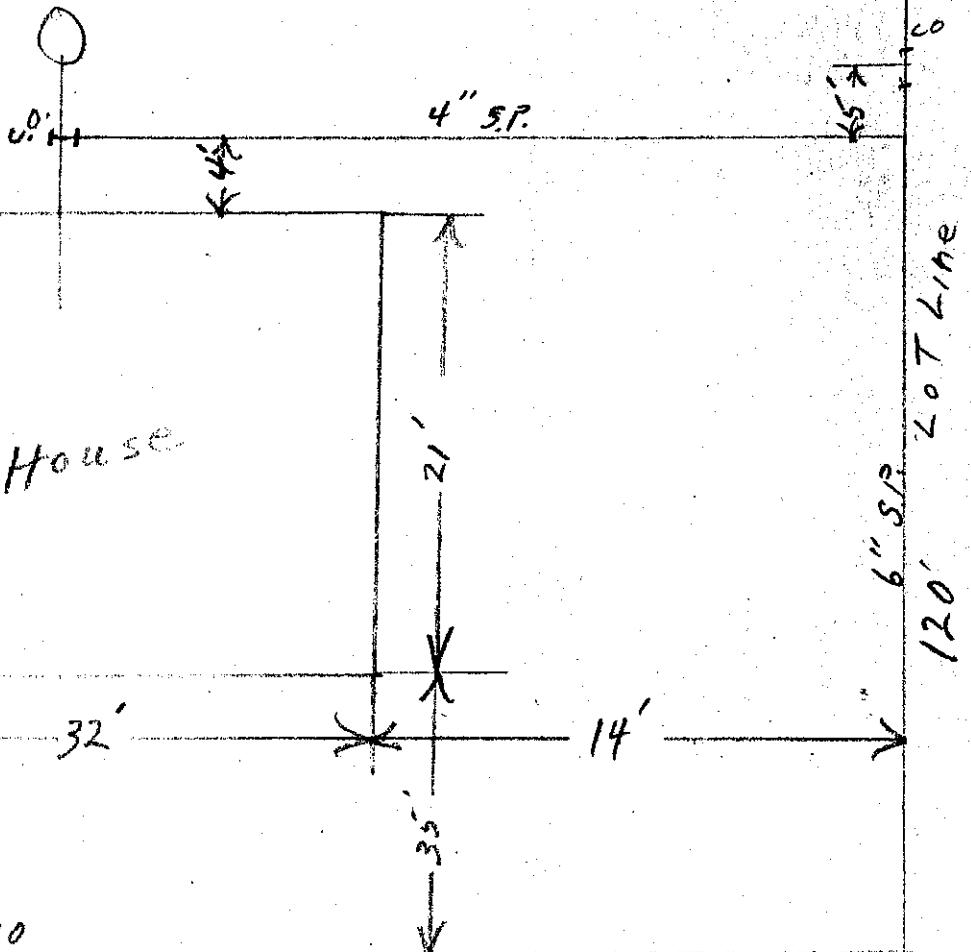

Date

Approved:

BACKFILL WORK ORDER ISSUED

DEPOSIT, \$ 10.00 4/15/60

5473

SEWER WORK ORDER ISSUED

1281

DATE

4/15/60 BY J. Taitner

R. L. Gockley

CARD NO.

The City of Mountlake Terrace

APPLICATION

for

SIDE SEWER PERMIT

OUTSIDE INSIDE REPAIRS

EASEMENT No. None

OWNER R. L. Gockley

HOUSE No. 23004 - 54th W.

CONTRACTOR Wingfield - Brown


PERMIT No. 1599

STREET
AVENUE LOT No. 19

BLOCK No. 3

NAME ADD.

Dir. # 14

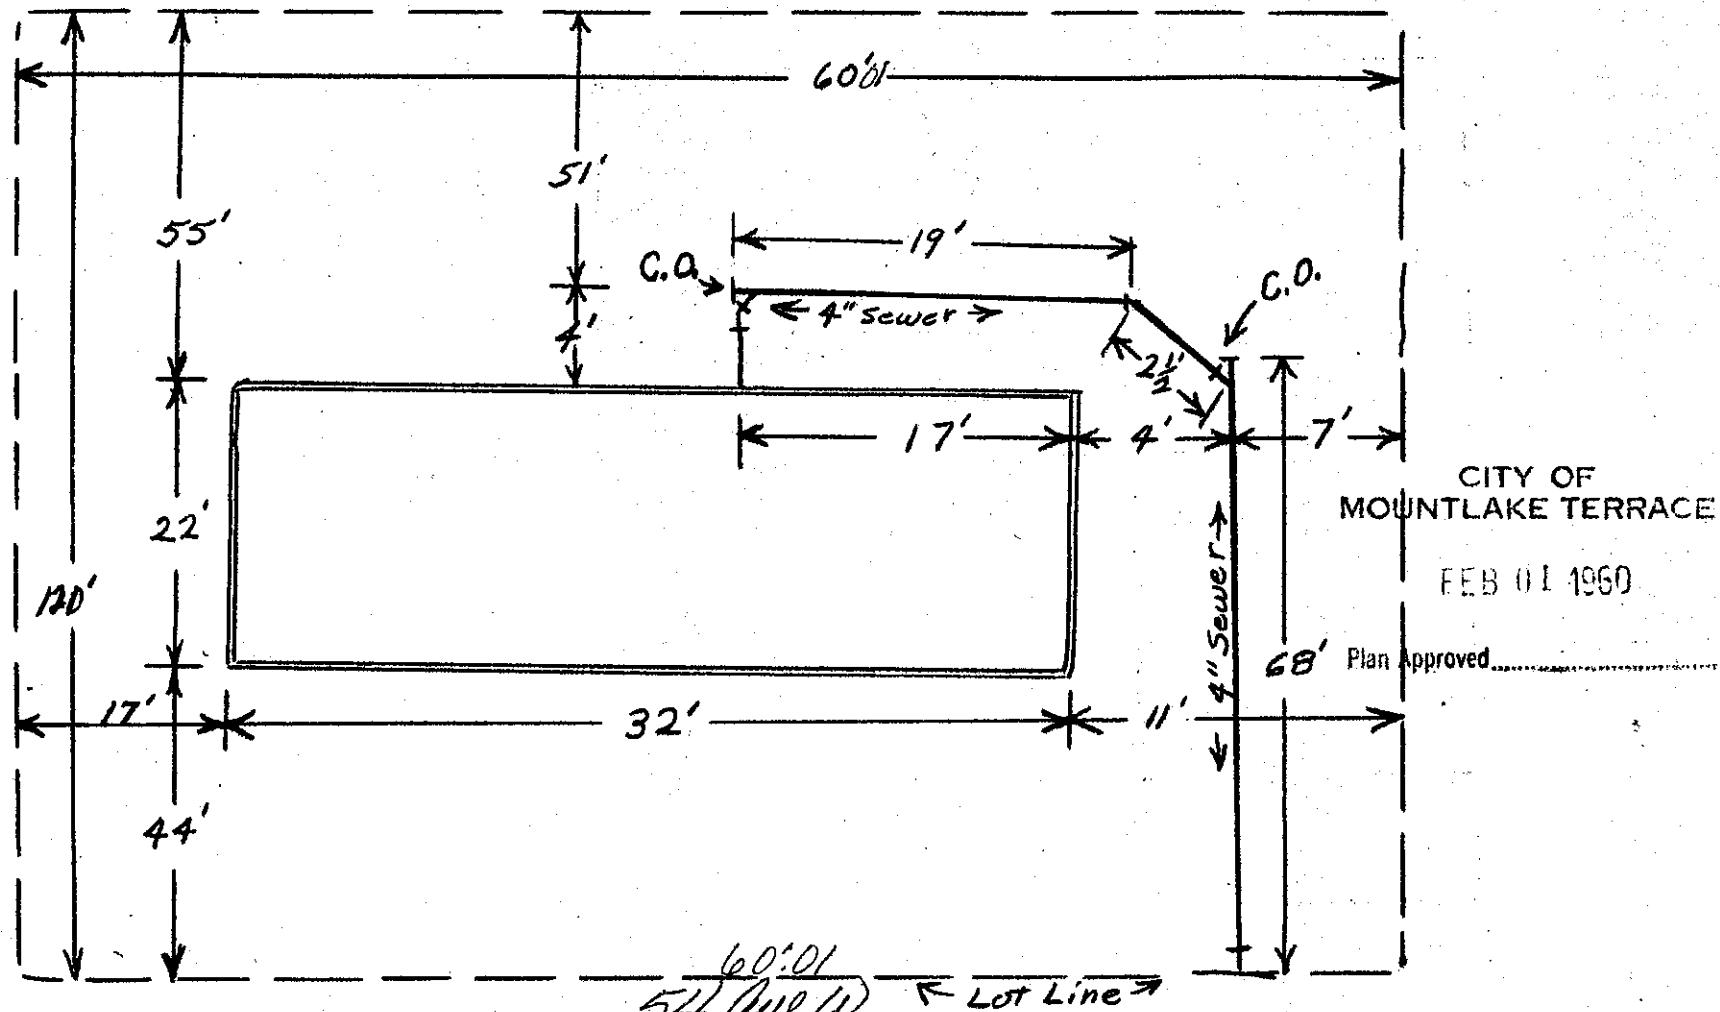

BACKFILL WORK ORDER ISSUED

SEWER WORK ORDER ISSUED

The City of Mountlake Terrace

APPLICATION

for

CARD NO

OUTSIDE INSIDE REPAIRS

EASEMENT NO.

1377431

OWNER Stewart, Seth

OWNER Stewart
HOUSE No. 23005-54th W

CONTRACTOR.

STREET
AVENUE LOT No

PERMIT No.


1106

~~P. 1 owned 1 d
D. 3~~

BLOCK No.

NAME ADD.

M. Tenn. Nov. 12

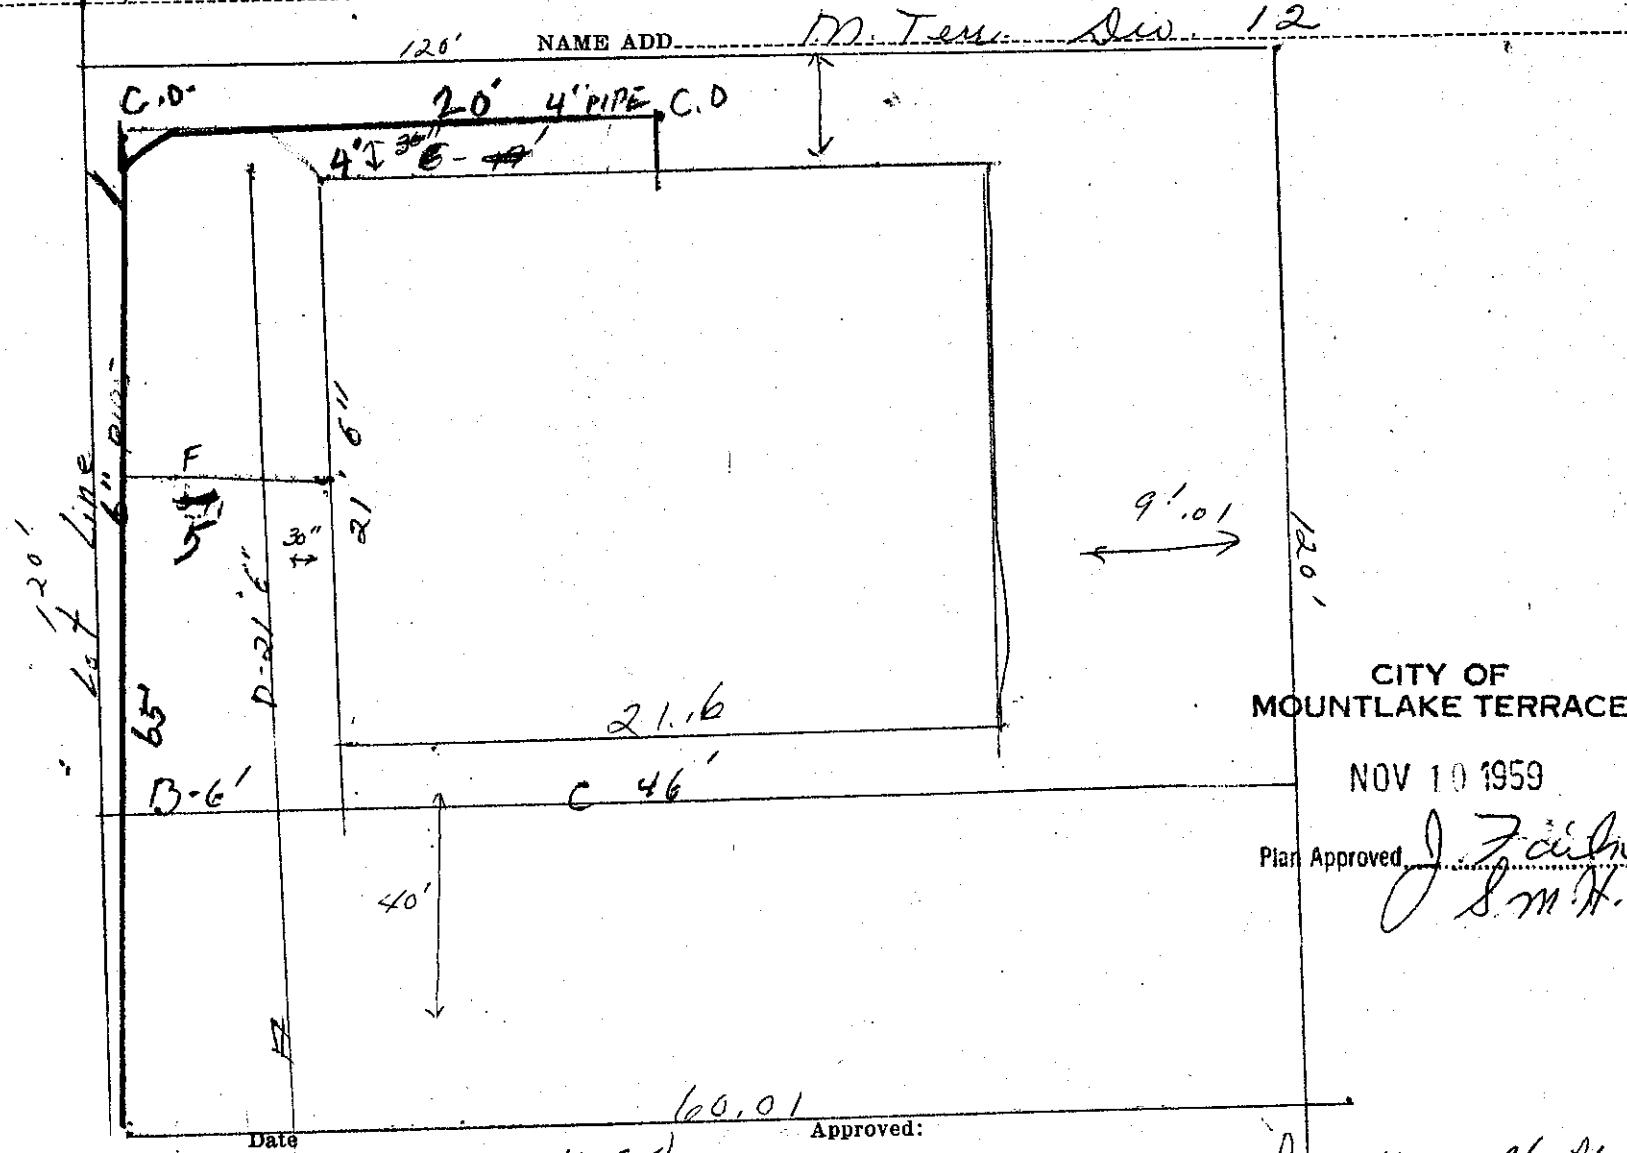

Plan Approved

NOV 10 1959

oved. J. J. d'Albion
J. S. M. H.

BACKFILL WORK ORDER ISSUED

SEWER WORK ORDER ISSUED-

DEPOSIT, \$10.00

Approved

DATE 11-10-39 BY

BACKFILL WORK ORDER ISSUED DEPOSIT \$10.00 DATE 11-10-59 BY Scott in Holton IN
SEWER WORK ORDER ISSUED REC 5338 11-10-59 BY N
Searle 11-17-59

The City of Mountlake Terrace

APPLICATION

for

SIDE SEWER PERMIT

OUTSIDE INSIDE REPAIRS

CARD No.

EASEMENT No. 13 54403

OWNER

C. A. WIGEN

HOUSE No.

23006 54th West

CONTRACTOR

HALE CONSTRUCTION

PERMIT NO.

895

STREET

AVENUE LOT NO.

18


BLOCK No.

3

NAME ADD.

DIVISION 14

b.D.BI

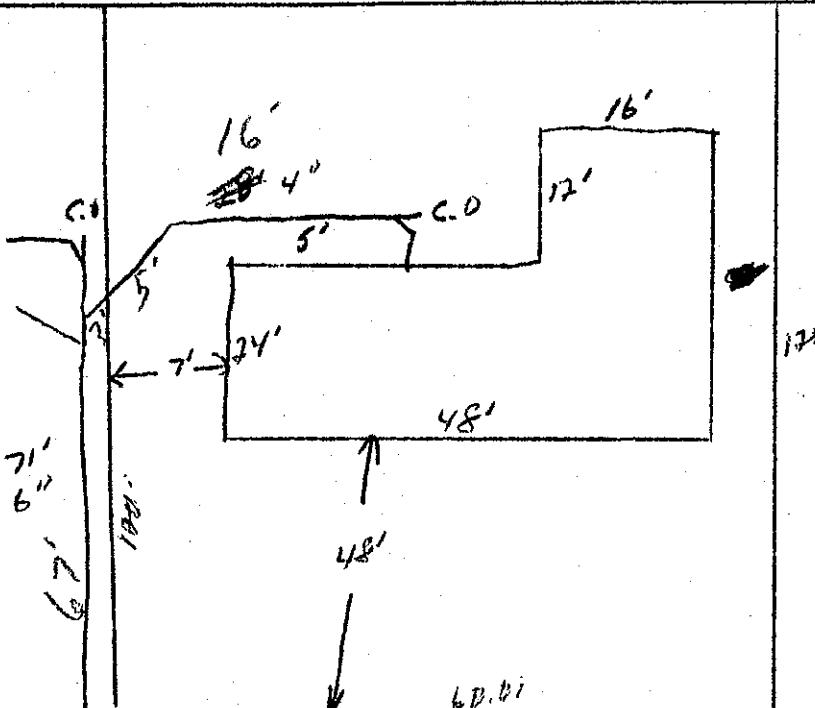

CITY OF
MOUNTLAKE TERRACE

OCT 5 1959

Plan Approved

54TH WEST

Date

Approved:

BACKFILL WORK ORDER ISSUED

DEPOSIT: \$ 10⁰⁰ 9/24/59

SEWER WORK ORDER ISSUED

#4977

DATE

10-5-59

BY

Scott M Holton INS.

1-11-60 INS+CON 8m 96 N.C.

APPLICATION

CARD No.

The City of Mountlake Terrace

SIDE SEWER PERMIT

OUTSIDE INSIDE REPAIRS

EASEMENT No.

1353922

OWNER JAMES W. ANDERSON

HOUSE No. 23007 - 54th WEST,

CONTRACTOR Hasey

STREET

AVENUE LOT No. 4

PERMIT No. 2395


NAME ADD. 12

BLOCK No. 4

CITY OF
MOUNTLAKE TERRACE

MAY 19 1960

Plan Approved

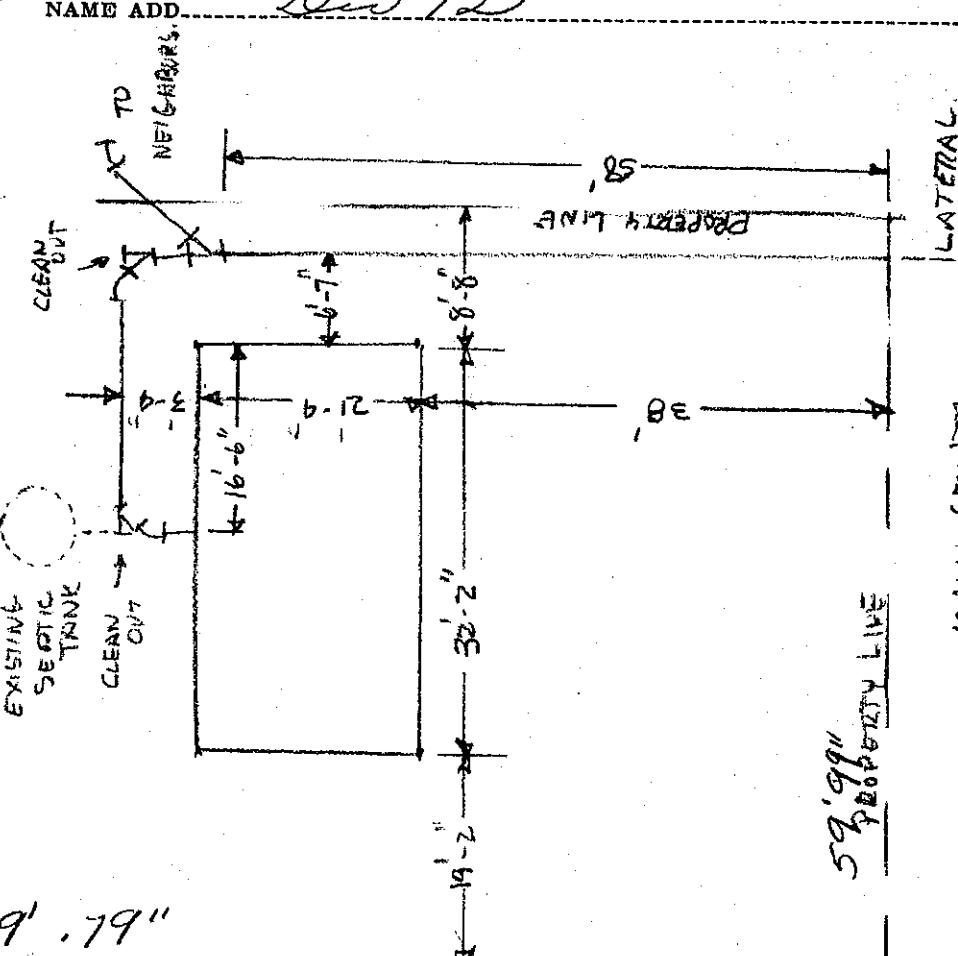S. McAllee

Date

BACKFILL WORK ORDER ISSUED

SEWER WORK ORDER ISSUED

DEPOSIT, \$

10.00

Approved:

DATE 5-19-60

BY

L. M. Holton IVST&CO

rec. 1180

Reene Freeman

The City of Mountlake Terrace

APPLICATION

for

SIDE SEWER PERMIT

OUTSIDE INSIDE REPAIRS

CARD No.

EASEMENT No. 1354403

OWNER DAN STEBOD

HOUSE No. 23008-54th WEST

CONTRACTOR HALIE CONSTRUCTION

PERMIT No. 896


STREET

AVENUE LOT No. 17

BLOCK No.

3

NAME ADD. DIVISION 14

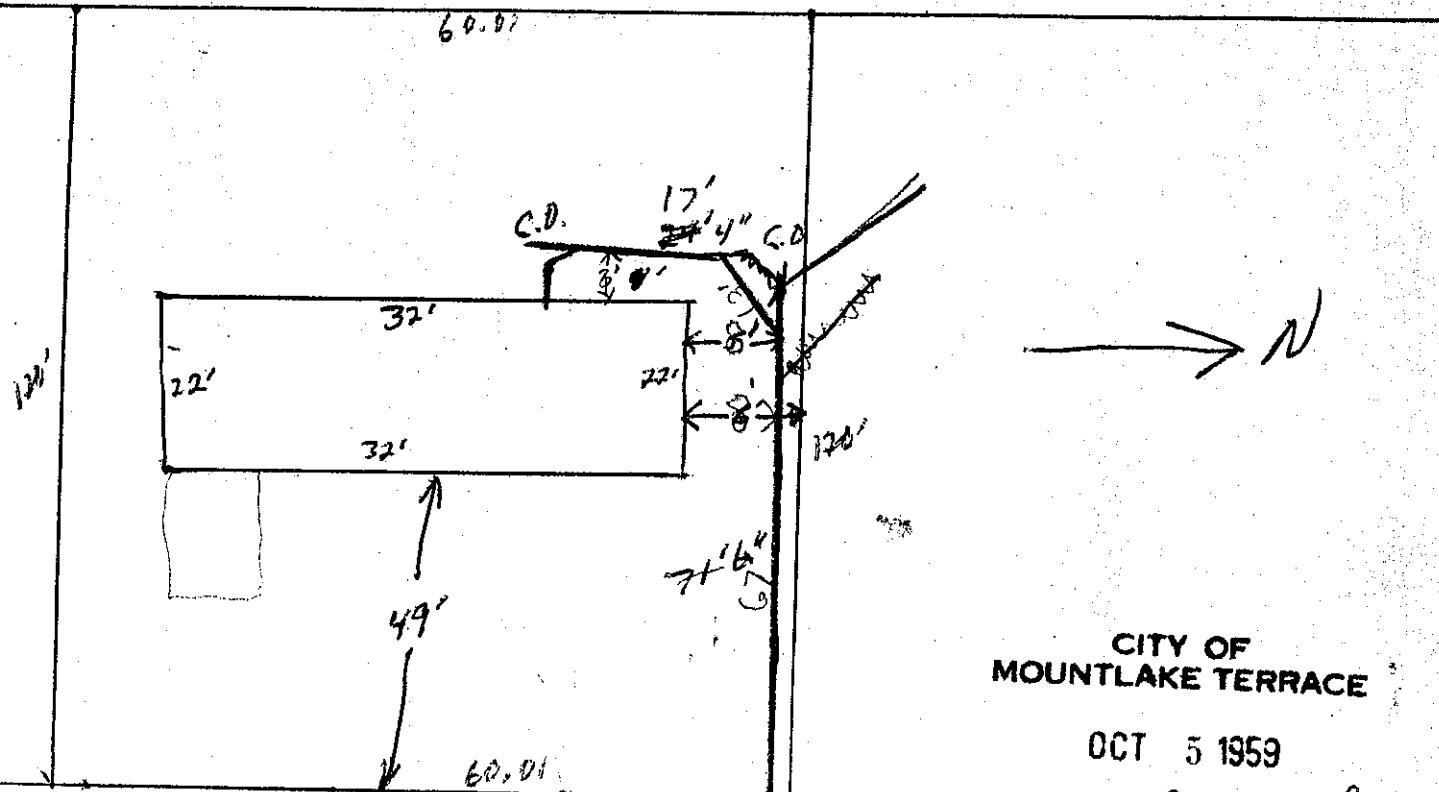

CITY OF
MOUNTLAKE TERRACE

OCT 5 1959

Plan Approved, *J. J. Farren*
Oct 5 1959.

BACKFILL WORK ORDER ISSUED

SEWER WORK ORDER ISSUED

Date

DEPOSIT, \$ 10⁰⁰ 9/24/59

Approved:

4977

DATE 10-5-59

BY Scott M Holton INS

NR

APPLICATION

The City of Mountlake Terrace

SIDE SEWER PERMIT

OUTSIDE **INSIDE** **REPAIRS**

CARD No.

1353922

OWNER - IRVIN L. ROSS

CONTRACTOR None

PERMIT No. 2391

STREET

AVENUE LOT No.

5


... BLOCK No

NAME ADD.

Div. 12

HOUSE No. 23009 - 54th WEST

HOUSE No. 23009 - 54th WEST

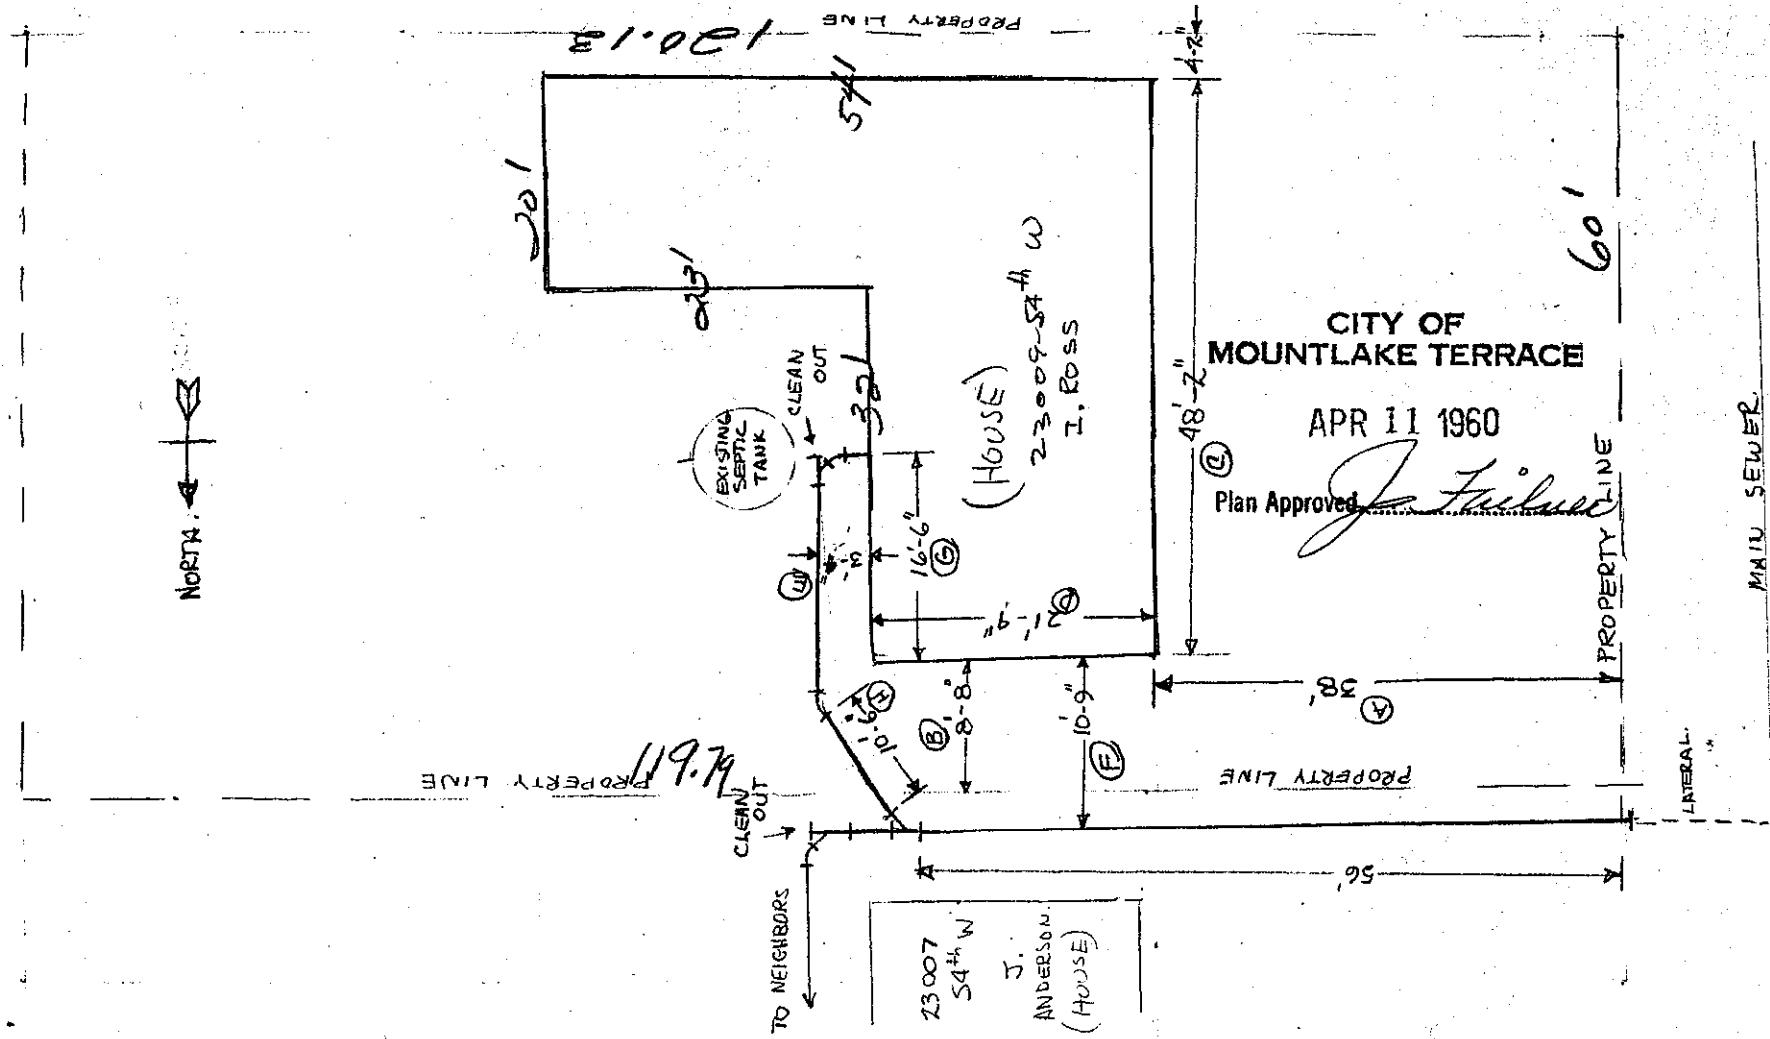

Date _____

Page

Approved:

BACKFILL WORK ORDER ISSUED.

DEPOSIT, \$.

SEWER WORK ORDER ISSUED

rec. #1180

DATE - 4/11/06

... BY

1180 DATE
Reeni Freeman

APPLICATION


FOR

SIDE SEWER PERMIT

The City of Mountlake Terrace

CITY OF MOUNTLAKE TERRACE
CARD No.OUTSIDE INSIDE REPAIRS EASEMENT NO. NoneOWNER Glyde CrawfordHOUSE No. 23010 - 54 1/2 W.CONTRACTOR Wing Field - BrownPERMIT No. 2647STREET
AVENUE LOT No. 16BLOCK No. 3

NAME ADD.

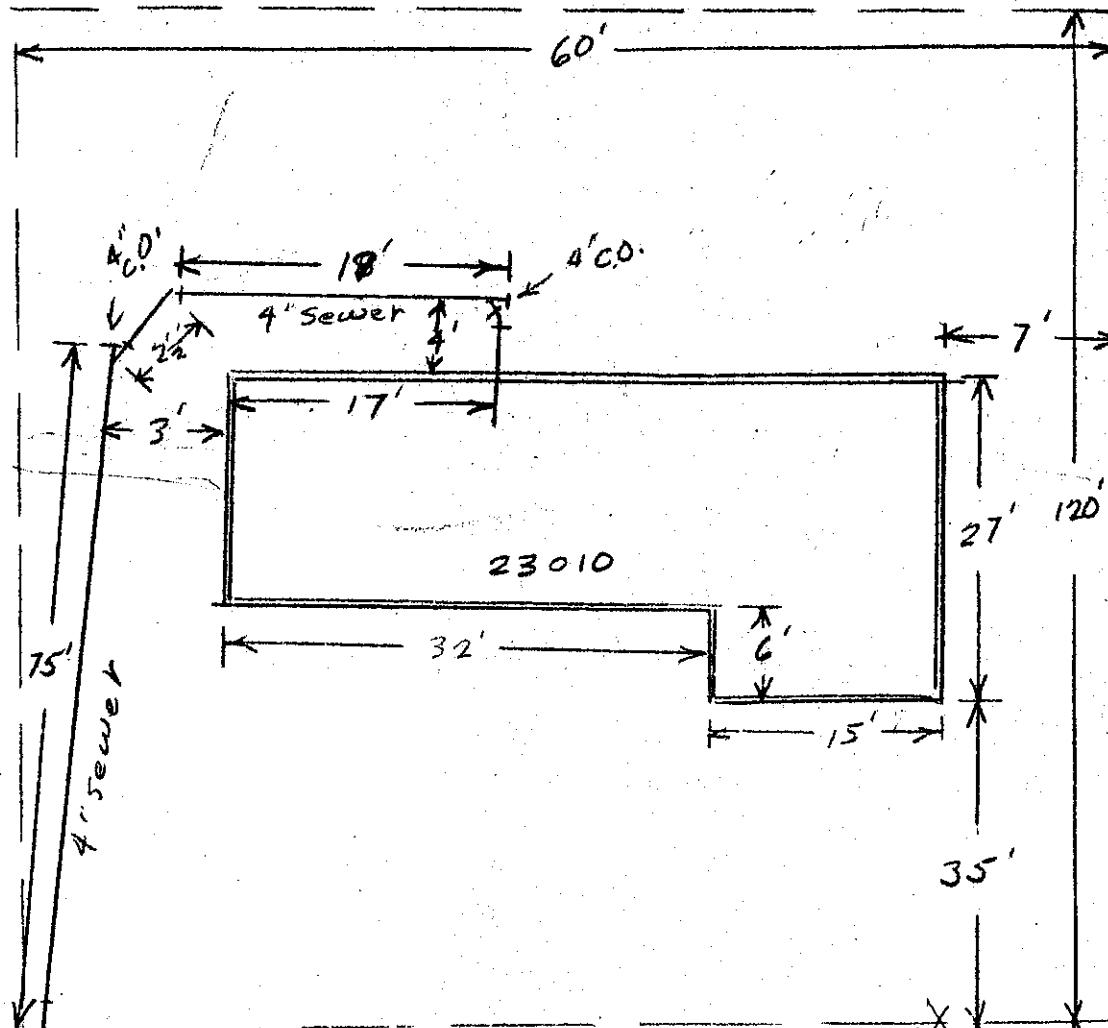DIV#14

60
47
13
CITY OF
MOUNTLAKE TERRACE

MAY 12 1960

Plan Approved

S. M. AlbeeDate 5/11/60

Approved:

54 1/2 W.BACKFILL WORK ORDER ISSUED
SEWER WORK ORDER ISSUEDDEPOSIT, \$10.00 5/11/60

1428

DATE 5-12-60

BY

J. M. Holton/WS/CON

The City of Mountlake Terrace

APPLICATION

CARD No.

SIDE SEWER PERMIT

OUTSIDE INSIDE REPAIRS

EASEMENT No.

OWNER Robert Baker

CONTRACTOR

PERMIT No.

HOUSE No. 23101 59th AVE W.


STREET
AVENUE LOT NO.

6

BLOCK No.

4

NAME ADD. MLT DIY #12

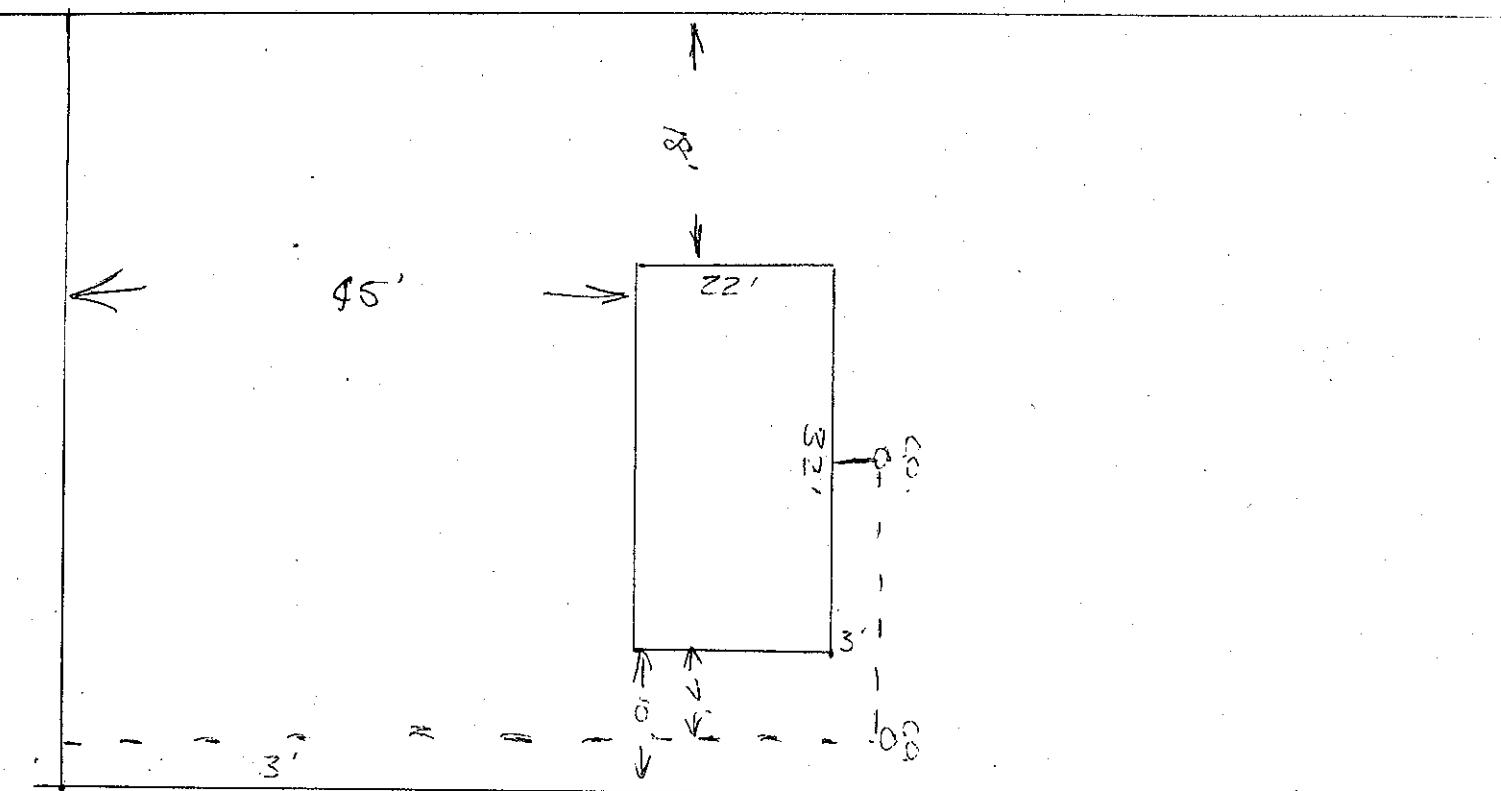

Date

Approved:

BACKFILL WORK ORDER ISSUED

DEPOSIT, \$

SEWER WORK ORDER ISSUED

DATE BY

The City of Mountlake Terrace

APPLICATION

for

SIDE SEWER PERMIT

OUTSIDE INSIDE REPAIRS

CARD No.

EASEMENT No. 135-1486

OWNER Nicholson

HOUSE No. 23102 - W - 54 ave

CONTRACTOR

PERMIT No. 2096

STREET
AVENUE LOT No.


15

BLOCK No.

3

NAME ADD

Milk Barrow Dr. #14

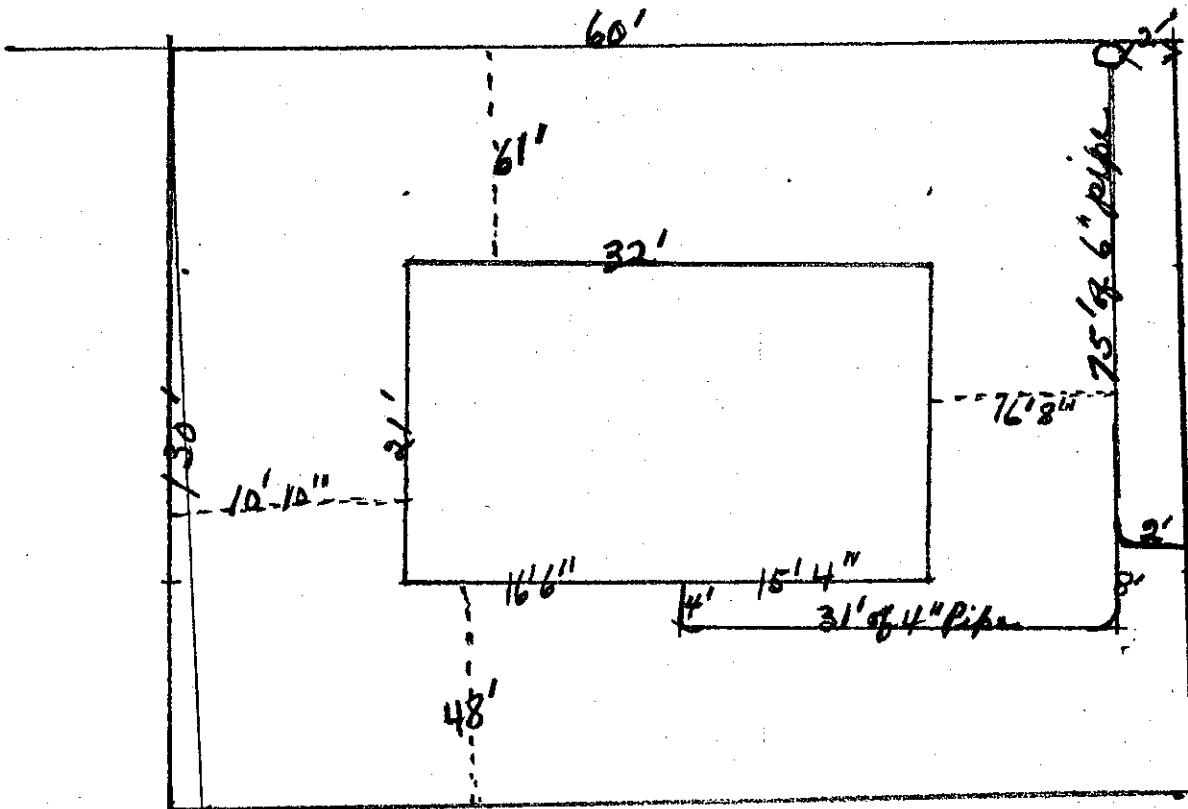

CITY OF
MOUNTLAKE TERRACE

APR 5 1960

Plan Approved

Date

Approved:

BACKFILL WORK ORDER ISSUED

DEPOSIT, \$10.00

3/28/60

SEWER WORK ORDER ISSUED

1035

DATE

7/5/60

BY

J. E. Mora

The City of Mountlake Terrace

APPLICATION

for

SIDE SEWER PERMIT

OUTSIDE INSIDE REPAIRS

J. A. O'Brien
CARD NO.

EASEMENT NO.

OWNER

James A. O'Brien

HOUSE NO.

2310 3 - 54

CONTRACTOR

STREET

AVENUE LOT No.

NAME ADD


PERMIT No.

2280

4

BLOCK No.

DIV. 12

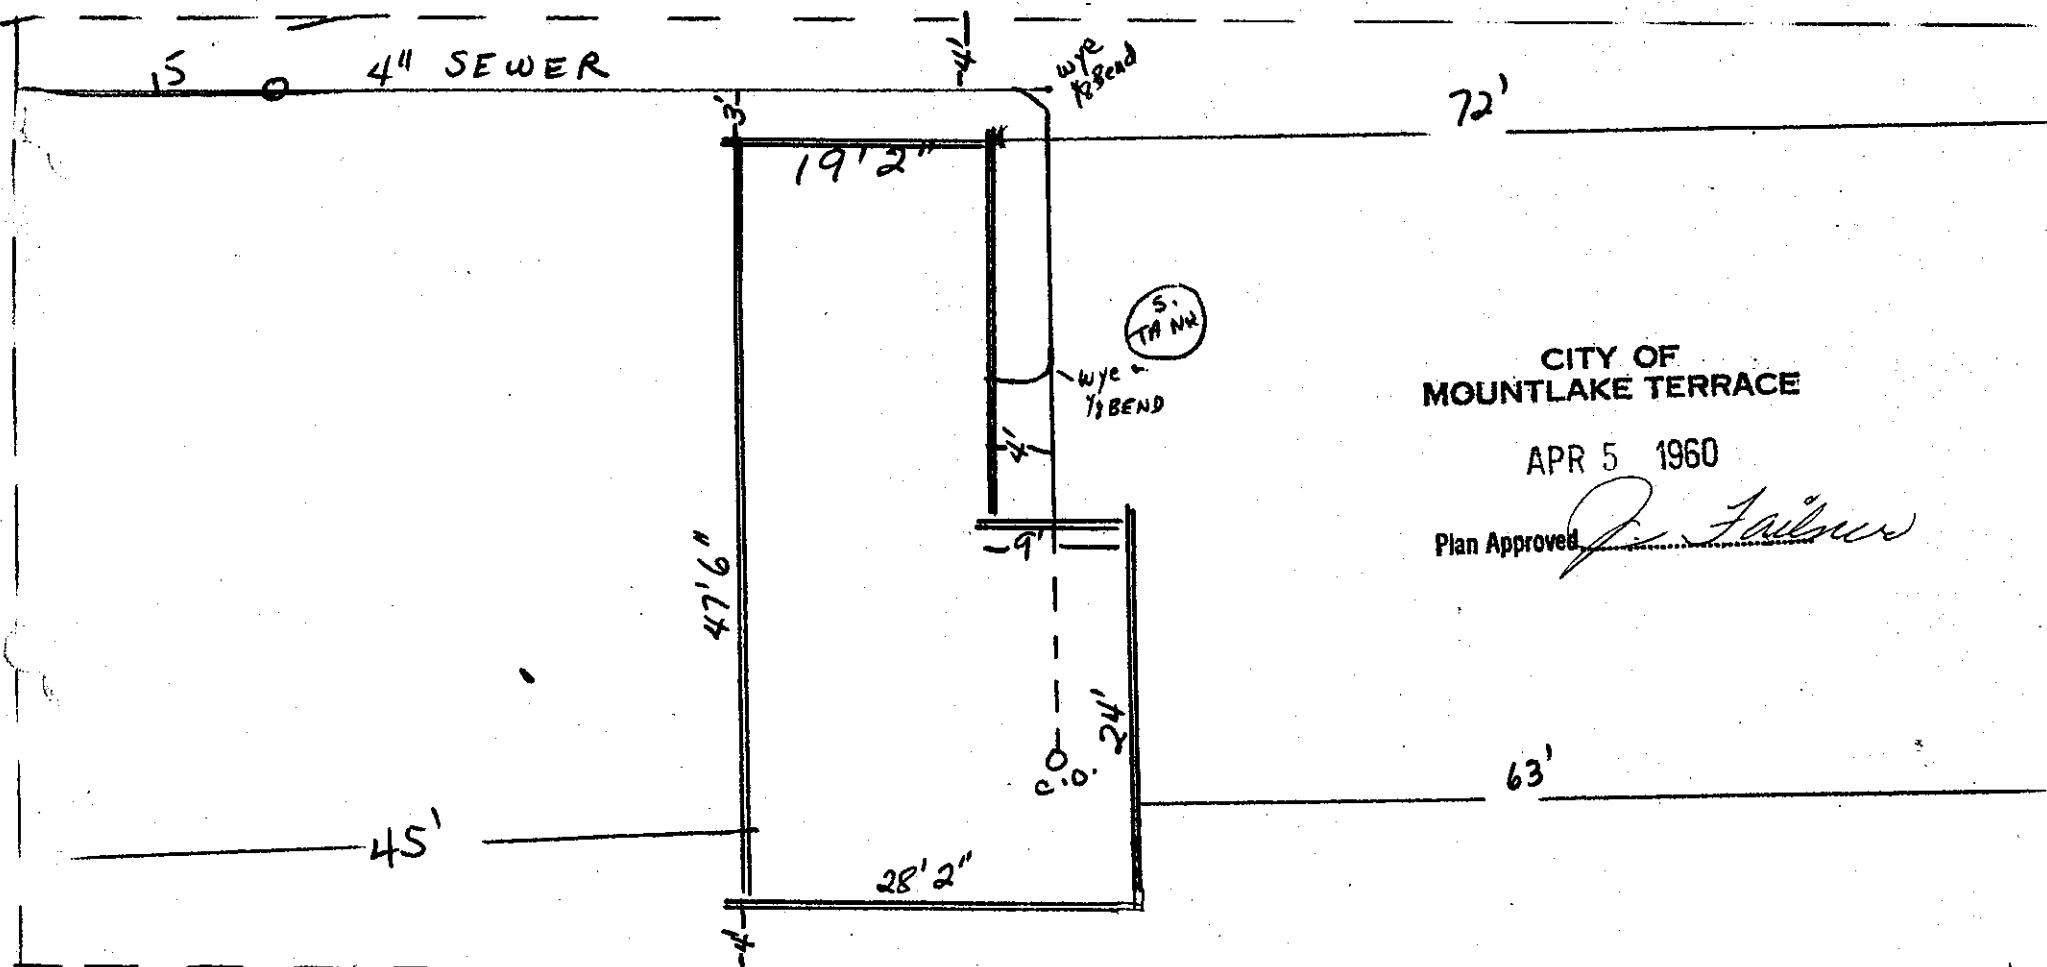

CITY OF
MOUNTLAKE TERRACE

APR 5 1960

Plan Approved

J. Fairman

Date

Approved:

BACKFILL WORK ORDER ISSUED

DEPOSIT, \$10.00

3/29/60

SEWER WORK ORDER ISSUED

1072

DATE

4-22-60

BY

J. M. Holton NSC-018

The City of Mountlake Terrace

APPLICATION

for

SIDE SEWER PERMIT

OUTSIDE INSIDE REPAIRS

CARD No.

1357486

EASEMENT No.

2097

OWNER

Hobestry

CONTRACTOR

STREET


AVENUE LOT No.

14

BLOCK No. 3

HOUSE NO. 23104- W-54 Ave

NAME ADD. Mountlake Terrace Ave. #14

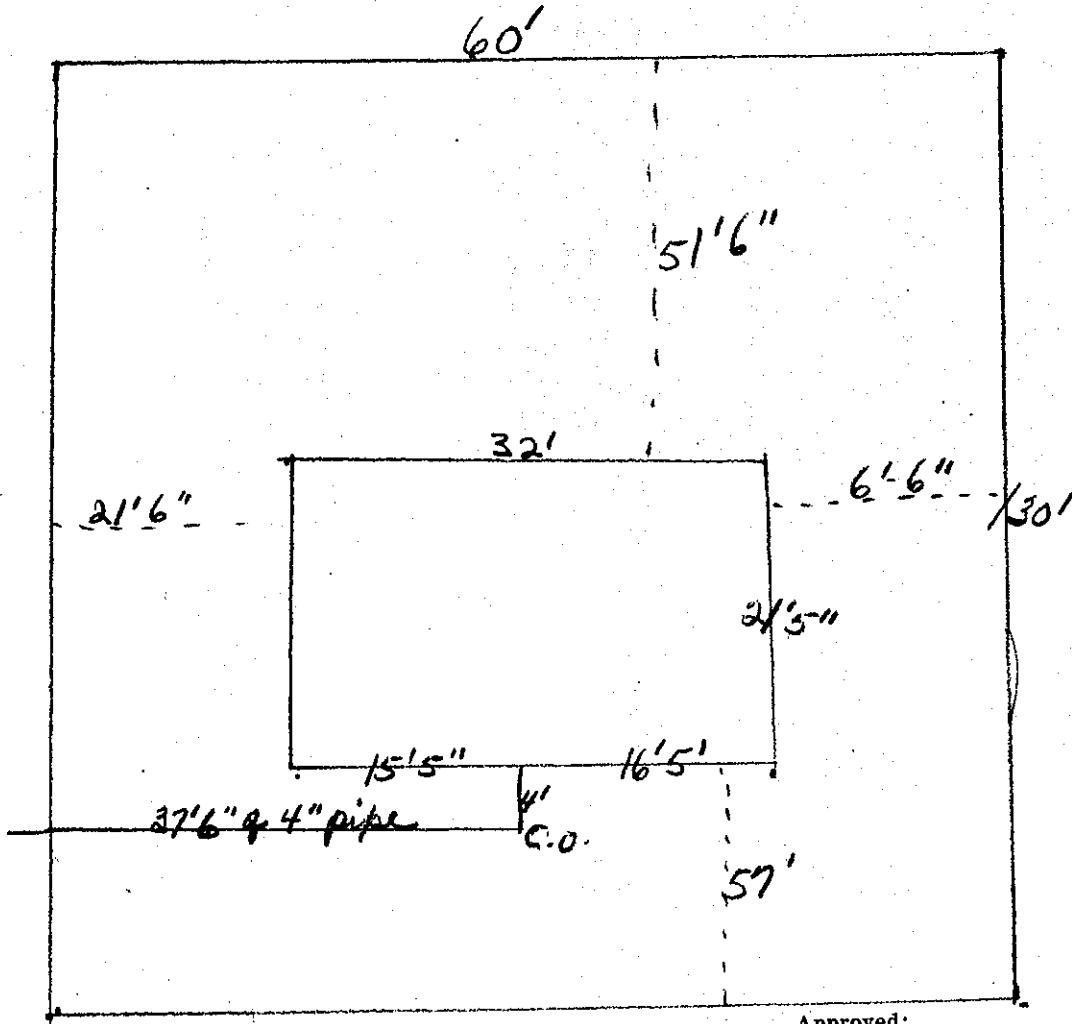

CITY OF
MOUNTLAKE TERRACE

MAR 30 1960

Plan Approved.....

BACKFILL WORK ORDER ISSUED

SEWER WORK ORDER ISSUED

Date

DEPOSIT, \$10.00

Approved:

3/28/60

1035

DATE

3-31-60

BY

Scott M Holton NS 8381

C. F. BANKS

The City of Mountlake Terrace

APPLICATION

FOR

SIDE SEWER PERMIT

OUTSIDE INSIDE REPAIRS

CARD No.

EASEMENT No.

1368123

OWNER C. F. BANKS

HOUSE No. 23105 54TH

CONTRACTOR HALE CONSTRUCTION


PERMIT No.

STREET AVENUE LOT NO. LOT 8

BLOCK No. 4

NAME ADD 23105 12

1588

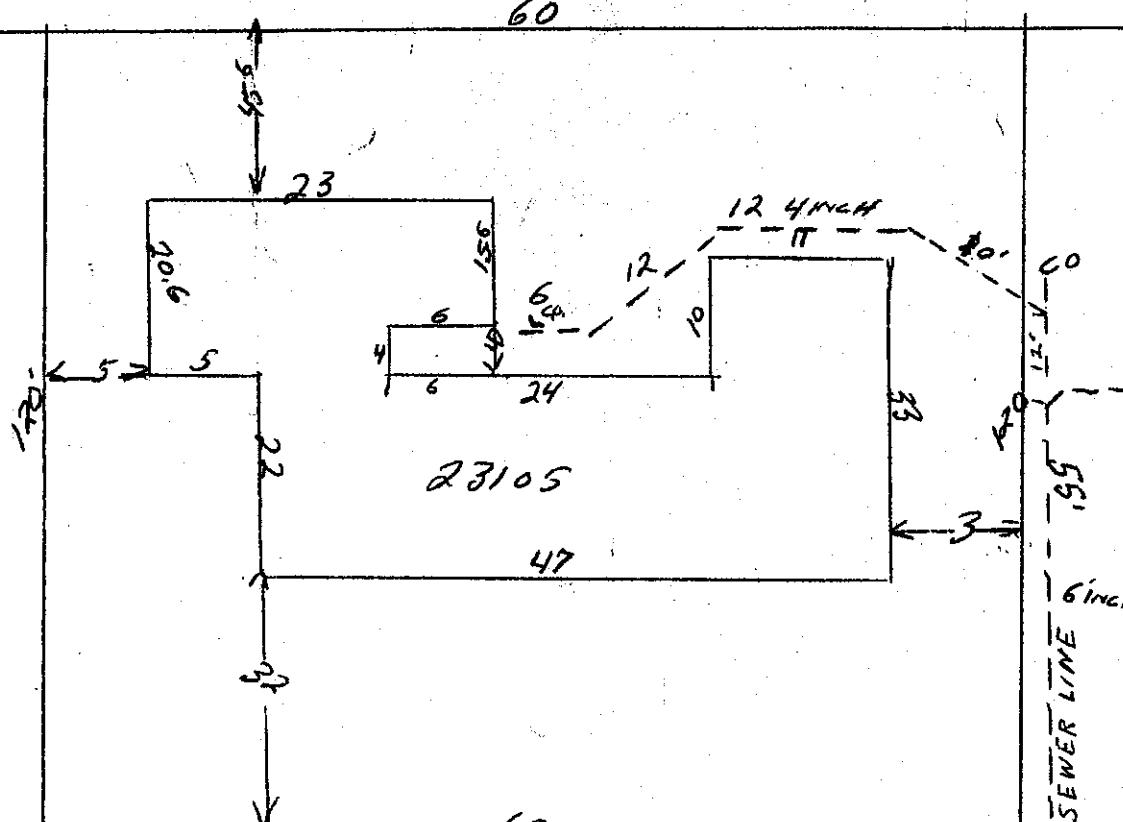

CITY OF MOUNTLAKE TERRACE

JAN 29 1960

Plan Approved.

Date

Approved:

BACKFILL WORK ORDER ISSUED
SEWER WORK ORDER ISSUED

DEPOSIT, \$ 10.00

1/28/60 BY
\$ 5870

DATE 1-29-60

BY, Scott M Holton INS+CON

The City of Mountlake Terrace

APPLICATION

for

SIDE SEWER PERMIT

OUTSIDE INSIDE REPAIRS

CARD No.....

EASEMENT No.....

OWNER EDNA L. Speed

HOUSE No. 2310 1/2 54th W.

CONTRACTOR Owner


STREET AVENUE LOT No. 13

NAME ADD.

PERMIT No. 2018

BLOCK No. 3

Mar 21, 1960

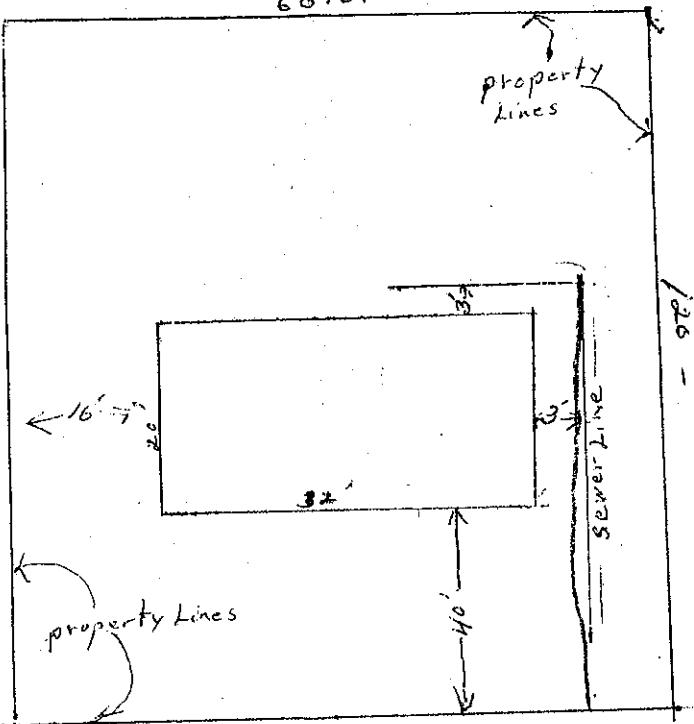

CITY OF MOUNTLAKE TERRACE

MAR 24 1960

Plan Approved

J. Faillner

N

Approved:

DATE 3/24/60 BY J. Faillner

Date

DEPOSIT, \$ 10.00

BACKFILL WORK ORDER ISSUED

3/15/60

SEWER WORK ORDER ISSUED

-41867

The City of Mountlake Terrace

APPLICATION

for

SIDE SEWER PERMIT

OUTSIDE INSIDE REPAIRS

HAROLD HOLM

CARD No.

EASEMENT No.

1368123

OWNER HAROLD HOLM
HOUSE No. 23107 - 54 th

CONTRACTOR


STREET
AVENUE LOT No. LOT 9

NAME ADD. 114 1/2

PERMIT No.

1587

BLOCK No. 8

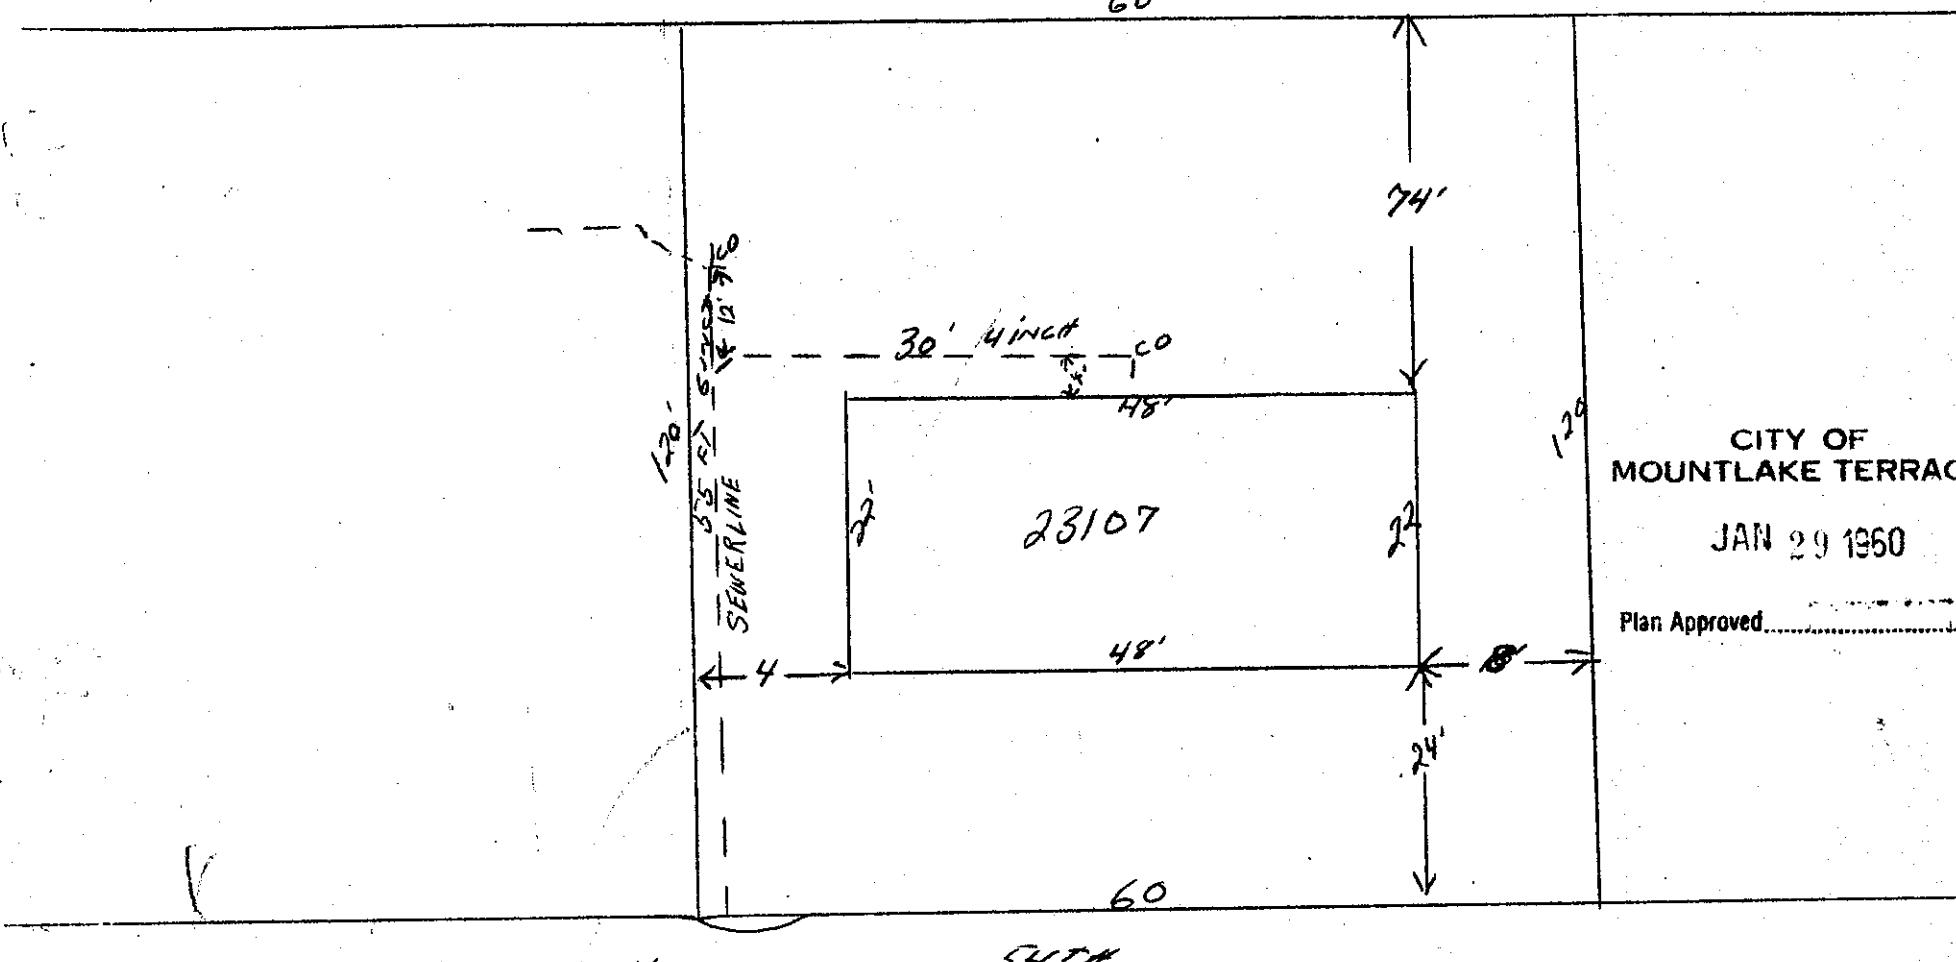

CITY OF
MOUNTLAKE TERRACE

JAN 29 1960

Plan Approved

Date

Approved:

BACKFILL WORK ORDER ISSUED

DEPOSIT, \$ 10.00

SEWER WORK ORDER ISSUED

5870

DATE 1-29-60 BY

Scott McHutton INS + CON

The City of Mountlake Terrace

APPLICATION
for

SIDE SEWER PERMIT

OUTSIDE INSIDE REPAIRS

DEAN ANDERSON

CARD No.

EASEMENT No.

None

OWNER: Doran Amundson
HOUSE No. 23108 - 54th


CONTRACTOR: B & E

STREET: AVENUE LOT No. 12 DIV 14 BLOCK No. 3

PERMIT No.

1680

NAME ADD:

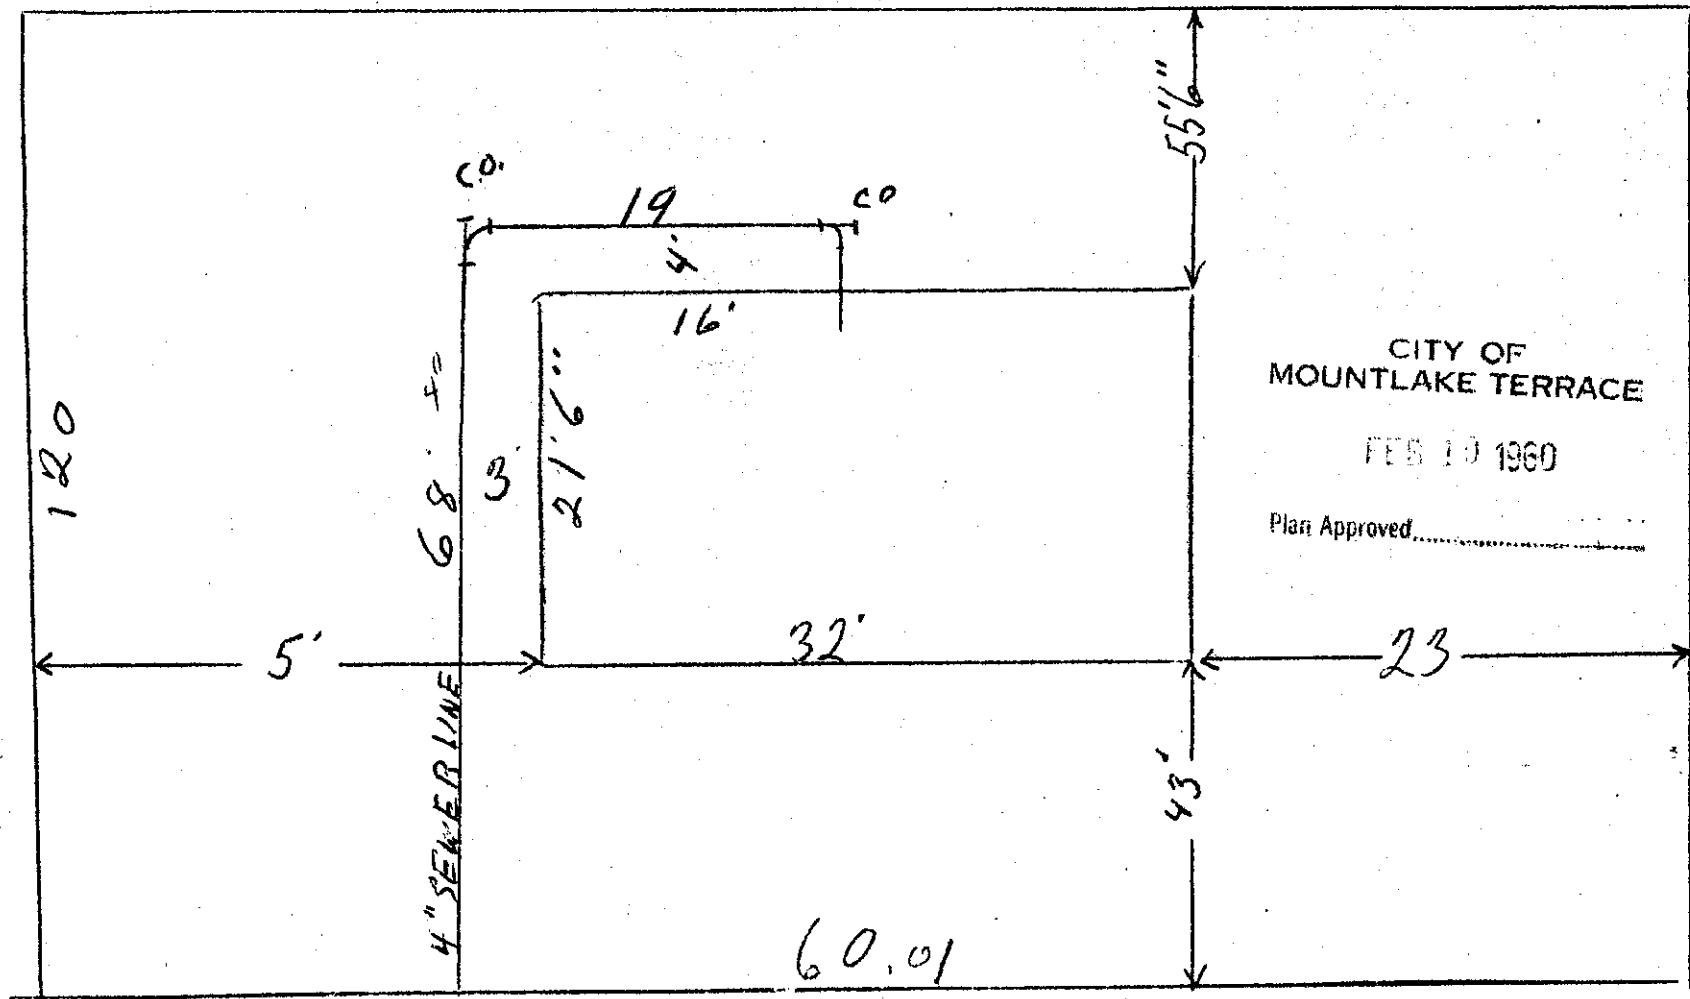

Date

Approved:

BACKFILL WORK ORDER ISSUED.
SEWER WORK ORDER ISSUED.

DEPOSIT, \$10⁰⁰ 2-9-60
5969

DATE 2-10-60

BY

Scott McHolton Inc. Co.

APPLICATION

The City of Mountlake Terrace

for

SIDE SEWER PERMIT

OUTSIDE INSIDE REPAIRS

PUGET SOUND MEADIST UNION
 CARD No. _____
 (PARSONAGE)
 EASEMENT No. _____

OWNER: Puget Sound-Meth-Union
 HOUSE No. 23206 - 58w

CONTRACTOR _____


STREET _____

AVENUE LOT No. 18

PERMIT No. 2331

BLOCK No. 2

NAME ADD 6

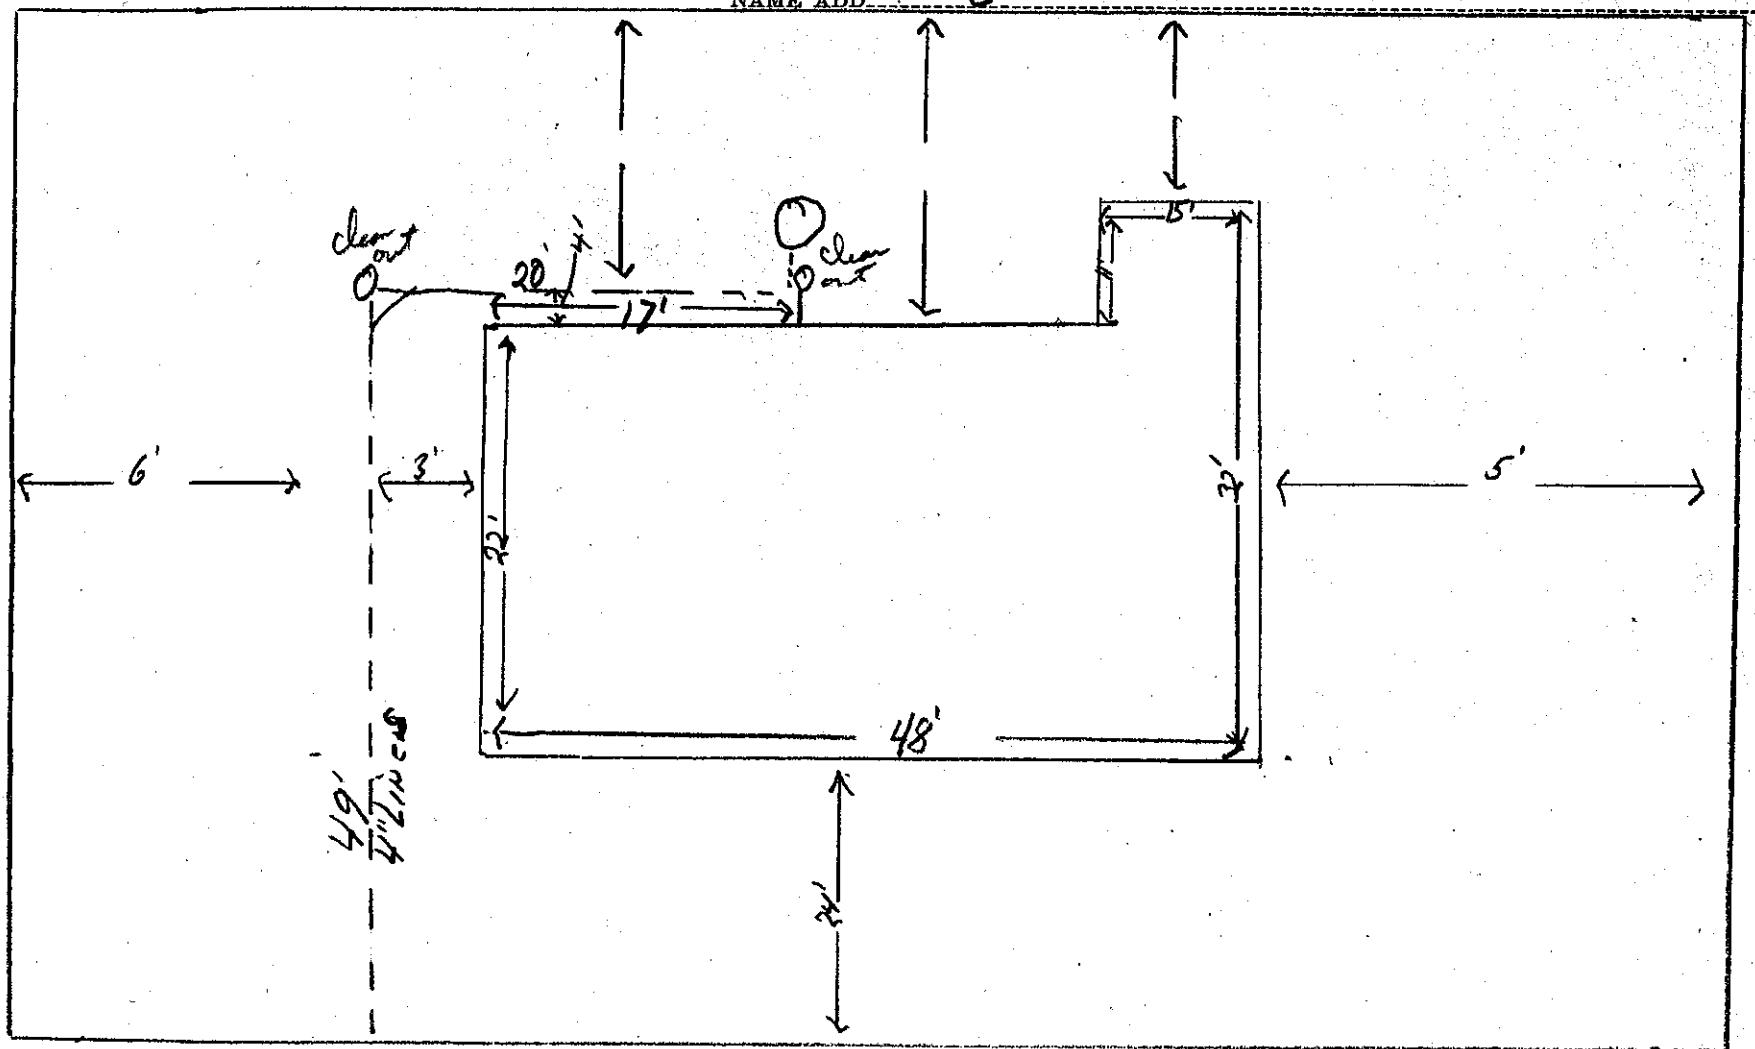

Date

Approved:

BACKFILL WORK ORDER ISSUED
 SEWER WORK ORDER ISSUED

DEPOSIT, \$10.00 3/31/60
 1104

DATE

BY S.M. Holton INS+Cov

E.G. Lee

The City of Mountlake Terrace

APPLICATION

107

SIDE SEWER PERMIT

OUTSIDE INSIDE REPAIRS

CARD No.

EASEMENT No.

None

OWNER ENOCH G. LEE

HOUSE No. 23208 ST & W.


CONTRACTOR

STREET 232ND S.W.
AVENUE LOT NO. 547 W. - LOT 17

PERMIT No. 15882

NAME ADD.

BLOCK No. 2

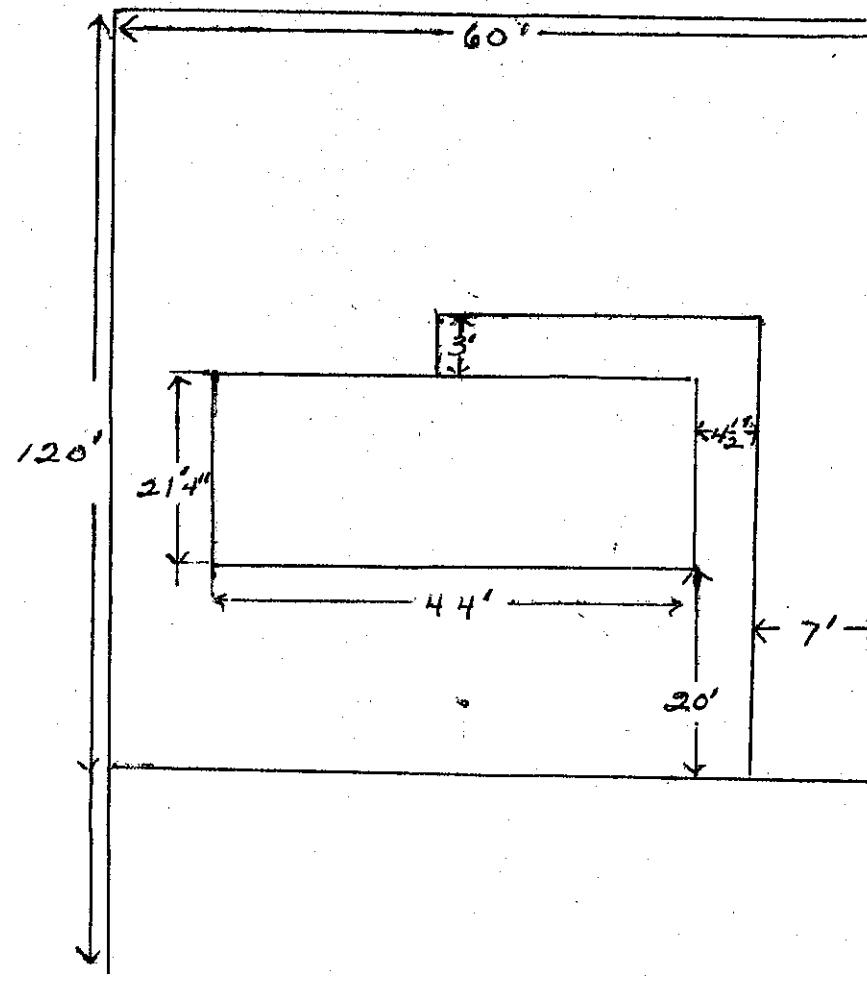

CITY OF
MOUNTLAKE TERRACE

APR 15 1960

Plan Approved

Date

Approved:

BACKFILL WORK ORDER ISSUED

DEPOSIT, \$ 10.00

SEWER WORK ORDER ISSUED

3-7-60

Rec. 740

DATE 4/15/60 BY

J. Failsar

The City of Mountlake Terrace

APPLICATION

for

SIDE SEWER PERMIT

OUTSIDE INSIDE REPAIRS

CARD NO.

1355449

OWNER

DUANE LACEY

HOUSE NO.

23210 54th W.

CONTRACTOR

STREET

AVENUE LOT No.

16

PERMIT NO.


1306

EASEMENT NO.

BLOCK No. 2 10116

NAME ADD

100

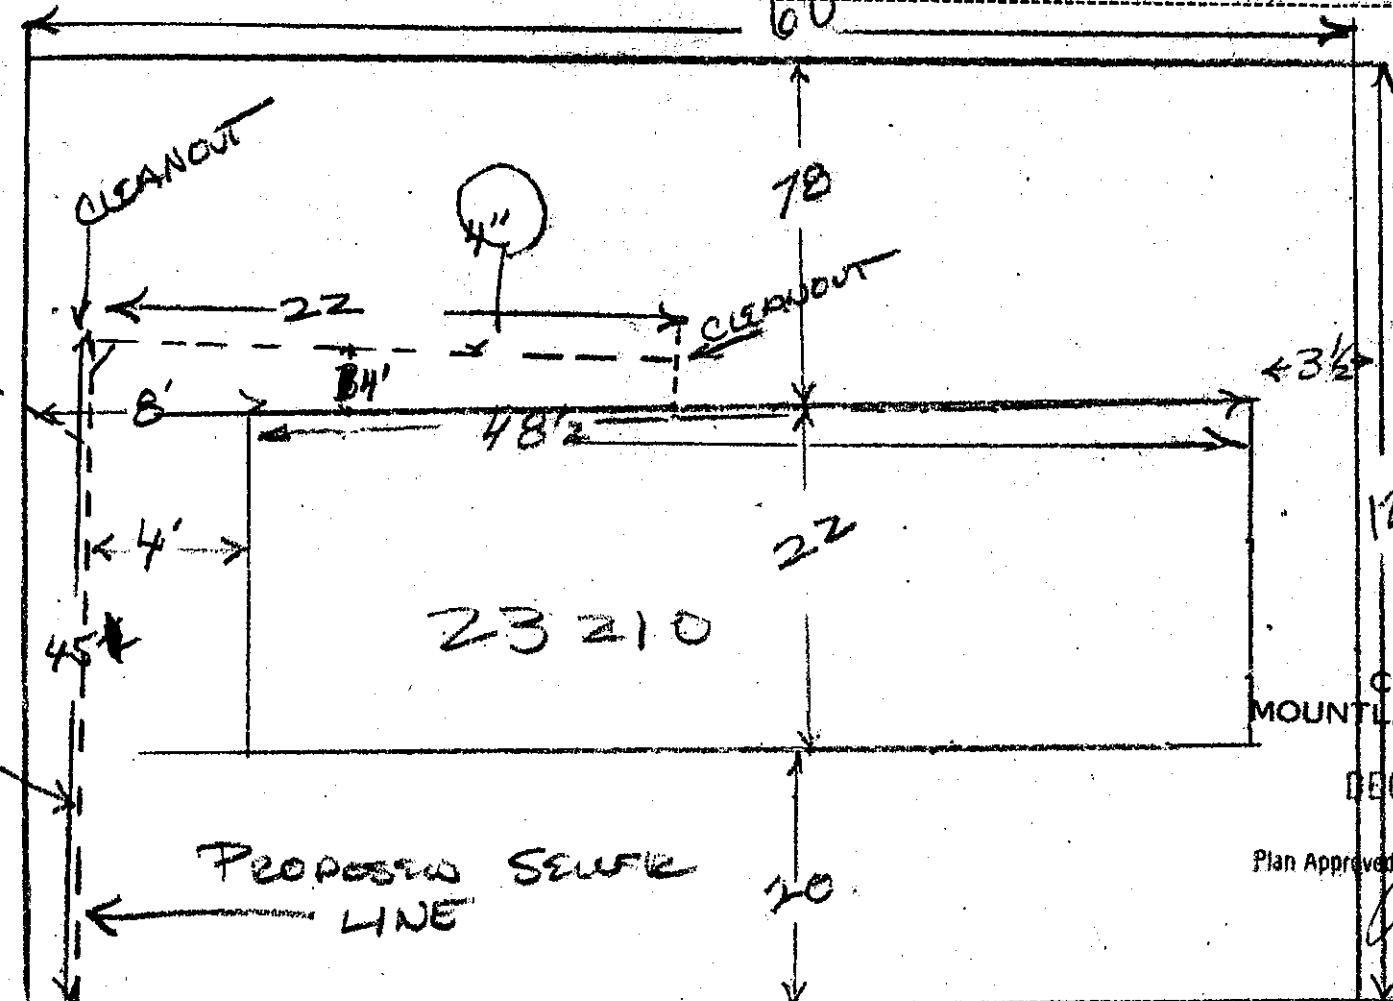

CITY OF
MOUNTLAKE TERRACE

DEC 14 1959

Plan Approved

J. J. Jackson
S. M. H.

Date

Approved:

BACKFILL WORK ORDER ISSUED

DEPOSIT, \$10

12-8-59

SEWER WORK ORDER ISSUED

5529

DATE 12-14-59

et

Scott on Holton WS

1-16-60 INSTANT 8mH

N.C.

APPLICATION

for

SIDE SEWER PERMIT

The City of Mountlake Terrace


Louis E. Bell

CARD No.

OUTSIDE INSIDE REPAIRS

EASEMENT No.

OWNER Louis E. Bell CONTRACTOR De Nomis Const. Co. PERMIT No. 1553
 HOUSE NO. 23301 W. 54 STREET AVENUE LOT No. 1 BLOCK No. 3

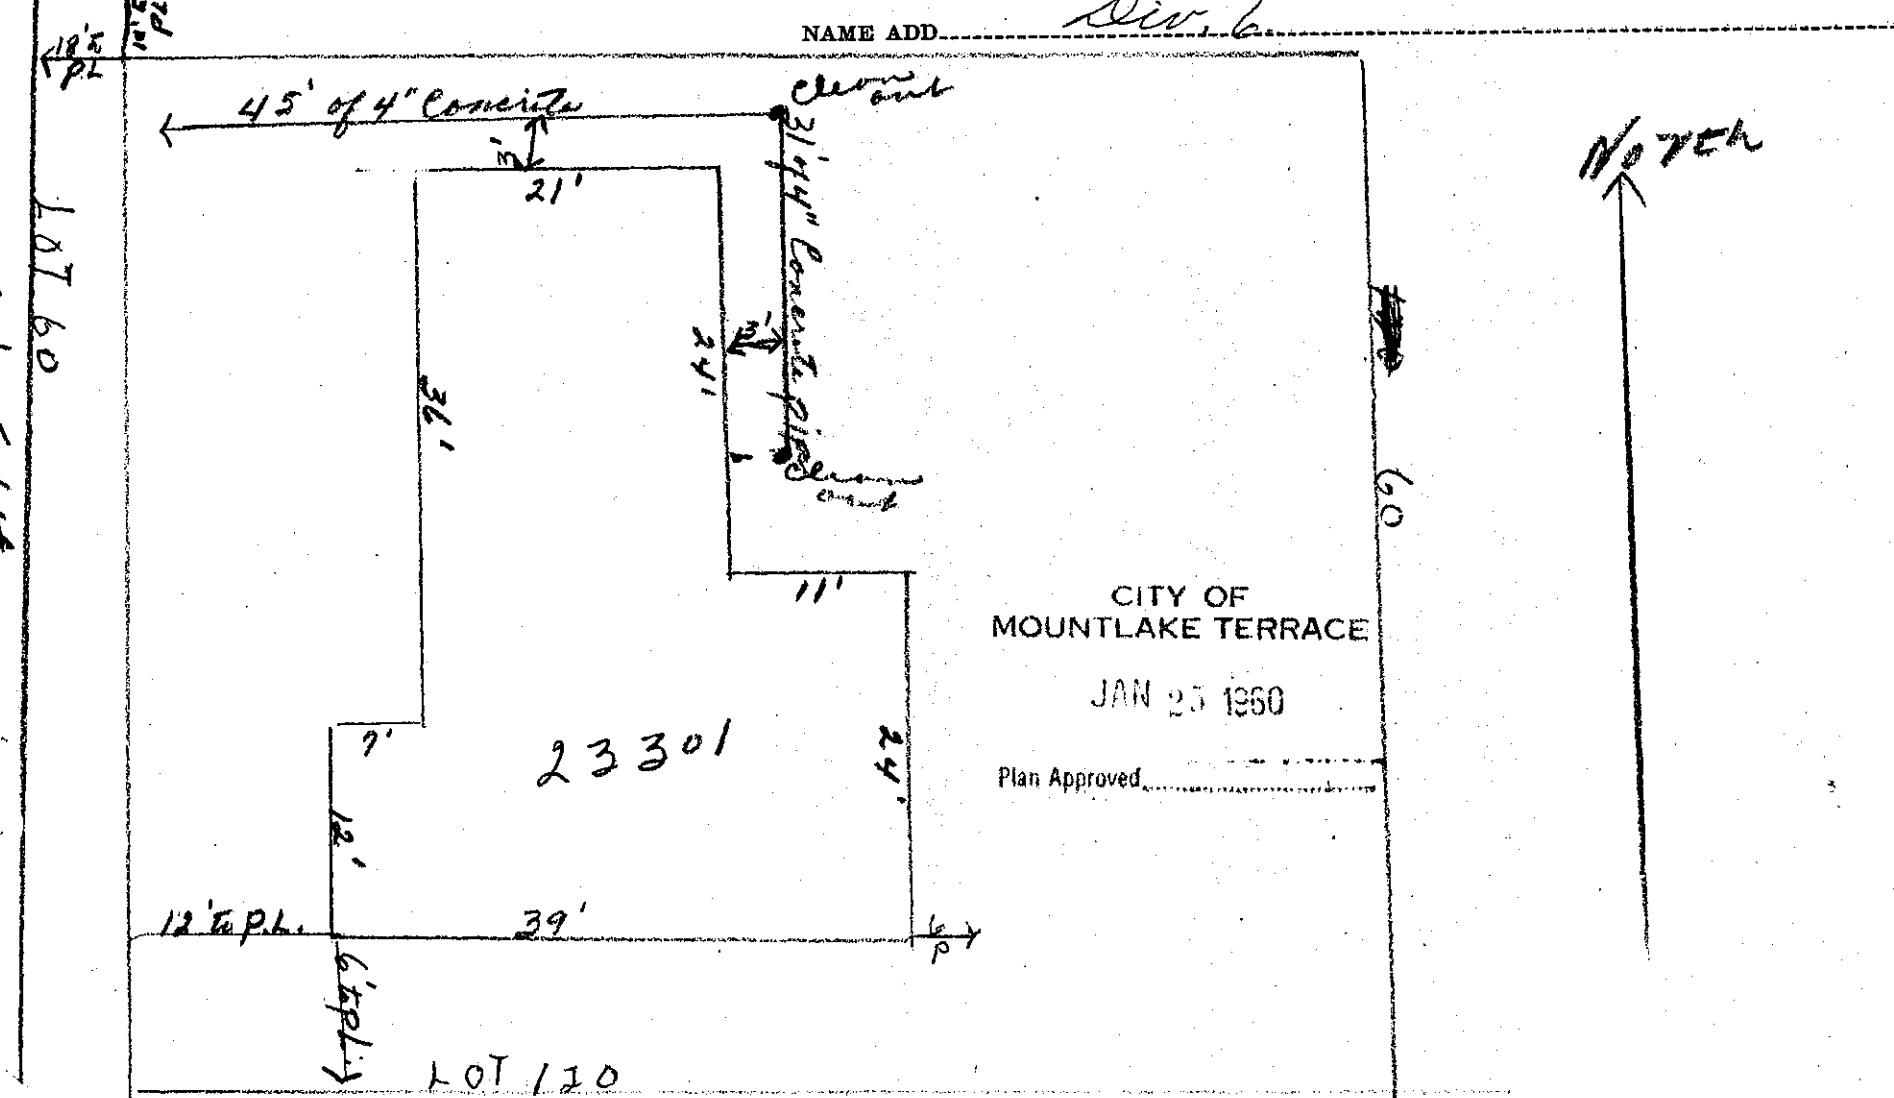NAME ADD Div. 6CITY OF
MOUNTLAKE TERRACE

JAN 25 1960

Plan Approved

Date

Approved:

WORK ORDER ISSUED

DEPOSIT, \$10.00

1-22-60

58-32 DATE 1-25-60

BY Scott M Holton NSCON

X ORDER ISSUED

The City of Mountlake Terrace

APPLICATION

for

SIDE SEWER PERMIT

OUTSIDE INSIDE REPAIRS

CARD NO.

1355-449

EASEMENT NO.

OWNER CARL FORD:

HOUSE No. 23302 54 W

CONTRACTOR

STREET
AVENUE LOT No.

15

PERMIT NO.


1365

BLOCK No. 2

DIV 6

NAME ADD.

60

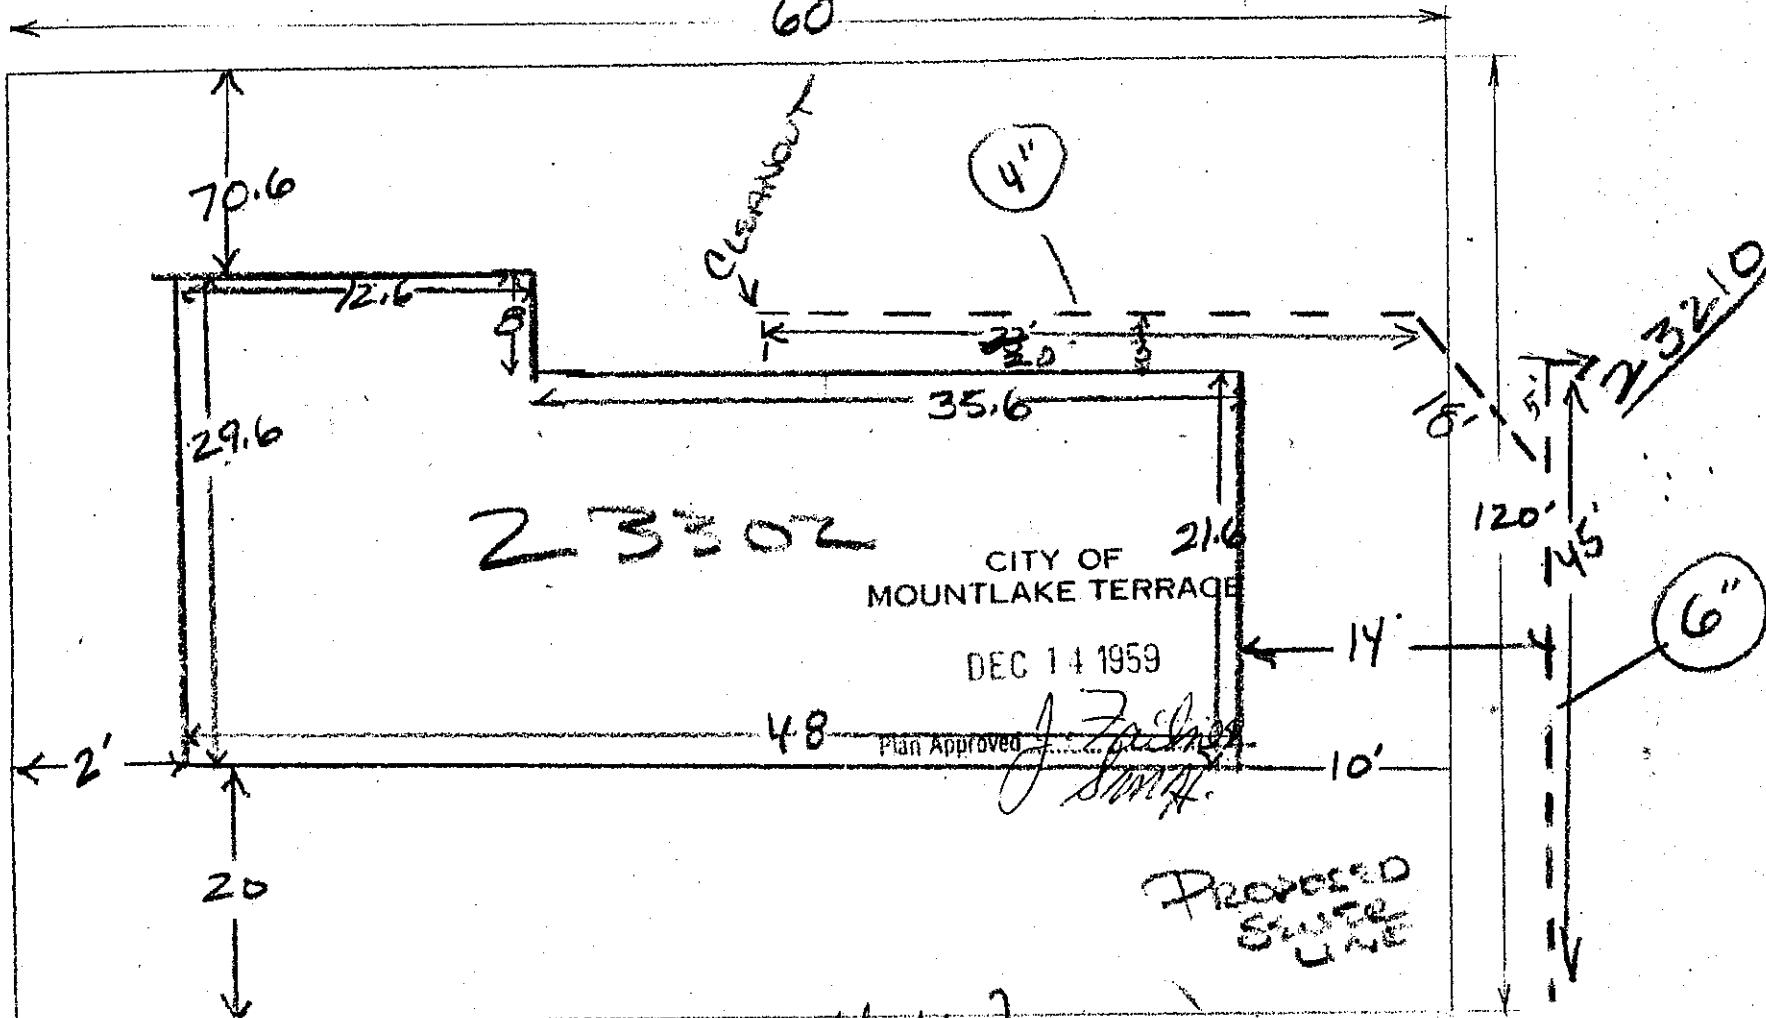

Date

Approved:
54 ft W

BACKFILL WORK ORDER ISSUED

DEPOSIT, \$10⁰⁰

OWNER WORK ORDER ISSUED

DATE 12-14-59

BY Scott McHolton WS
1-15-60 INST CONLMTH NO

The City of Mountlake Terrace

APPLICATION

for

SIDE SEWER PERMIT

OUTSIDE INSIDE REPAIRS

W.B. B. LARD
CARD NO.

EASEMENT NO.

OWNER

Wilmore B. Bickford

CONTRACTOR

see)

HOUSE No. 23303 - 54th WEST

STREET

AVENUE LOT No. TWO

PERMIT NO.

1823

BLOCK No. THREE

NAME ADD

DIV. 6

SEWER MAIN

PROPERTY LINE

A = 36'

D = 21 $\frac{1}{2}$ '

C = 32'

CITY OF
MOUNTLAKE TERRACE

MAR 14 1960

Plan Approved

SERVICE
LATERAL

4" SEWR LINE


B = 11'

HOUSE

LOT LINE

F-5'
5 $\frac{1}{2}$ '

G = 17 $\frac{1}{2}$ '

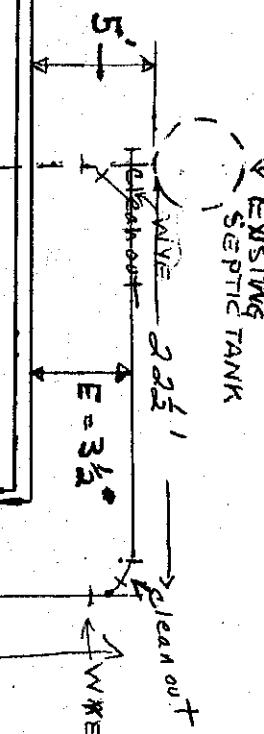

Date

Approved:

BACKFILL WORK ORDER ISSUED

DEPOSIT, \$ 10.00

SEWER WORK ORDER ISSUED

rec 689

DATE 2/27/60

BY Remi Freeman
2-14-12 L. H. Miller Inc.

City of Mountlake Terrace

APPLICATION
for

SIDE SEWER PERMIT

OUTSIDE INSIDE REPAIRS

J. W. ERICKSON
CARD No.

EASEMENT No. 1354258

OWNER James W. and Celia L. Erickson

CONTRACTOR

PERMIT No. 2451

HOUSE NO. 23304 - 54th Ave. W.

STREET
AVENUE LOT No. 14


BLOCK No. 2

NAME ADD Division No. 6

CITY OF
MOUNTLAKE TERRACE

APR 9 1960

Plan Approved

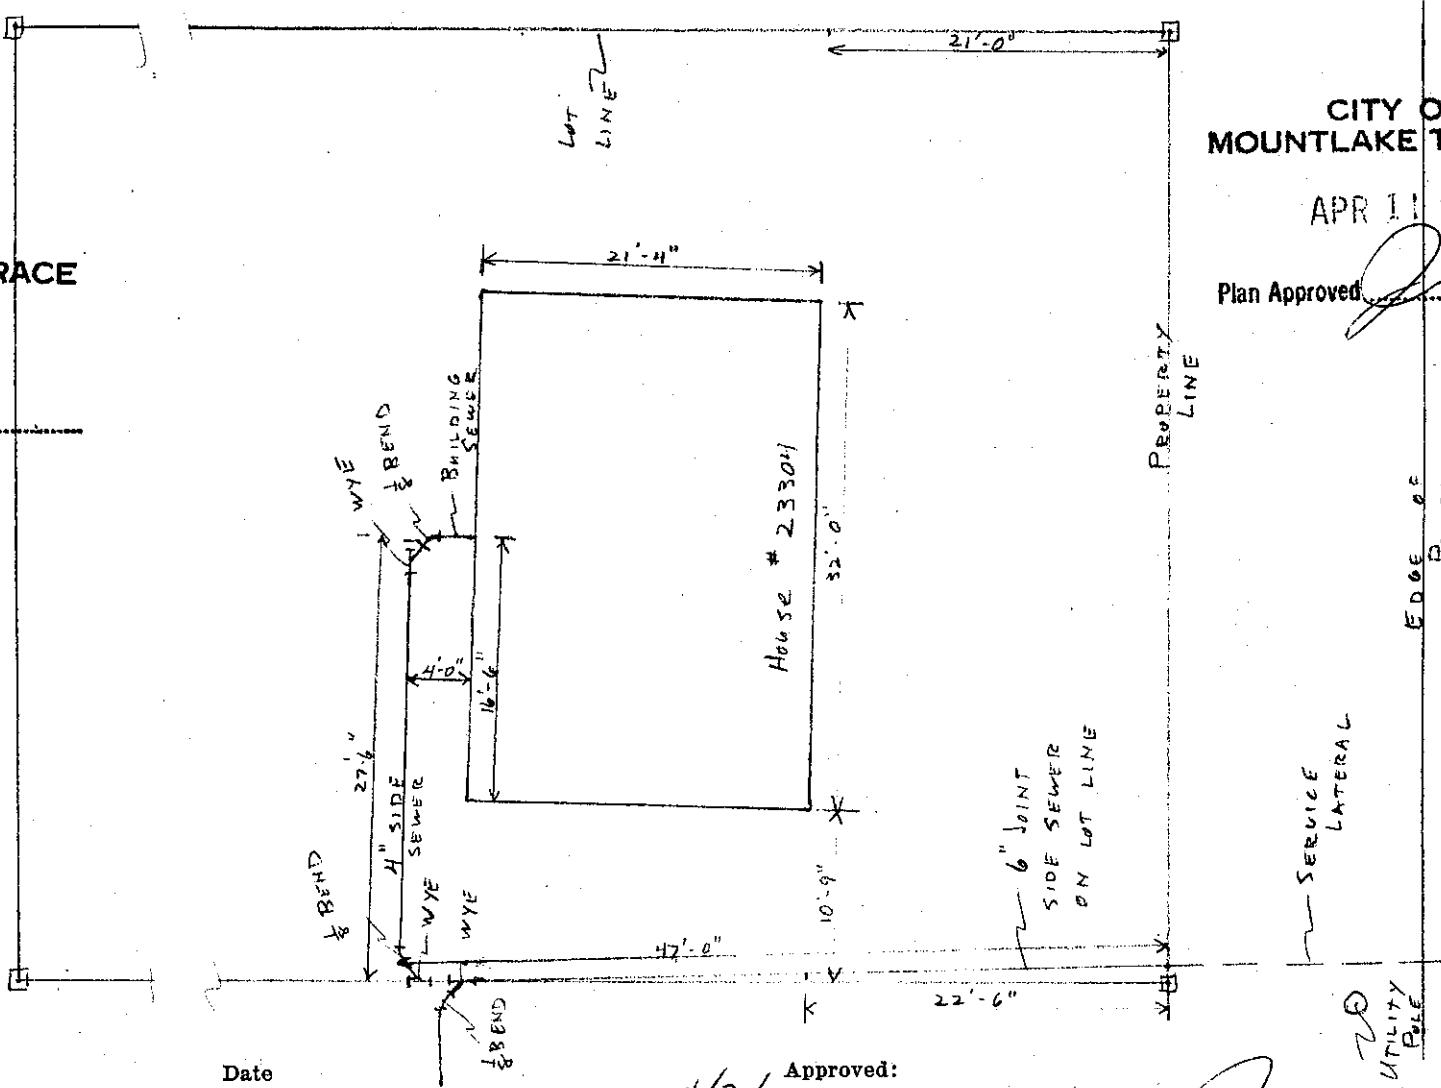

Date

Approved:

BACKFILL WORK ORDER ISSUED
SEWER WORK ORDER ISSUED

DEPOSIT \$10.00 4/9/60
1240

DATE 4/11/60

BY

J. Faillen

City of Mountlake Terrace

APPLICATION
for

SIDE SEWER PERMIT

OUTSIDE INSIDE REPAIRS

CARD No.

EASEMENT No.

OWNER Al SAHLEE

HOUSE No. 23305 - W 54

MA SAME

CONTRACTOR INDUSTRIAL Projects

PERMIT NO. 2235


STREET

AVENUE LOT No. 3

BLOCK No. 3

NAME ADD.

Div. b

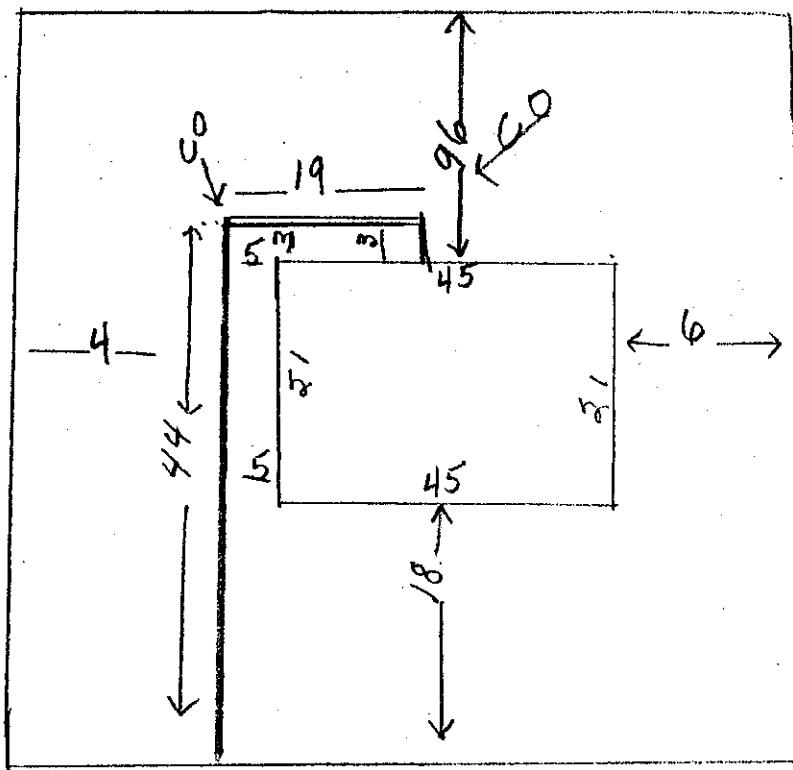

Date

Approved:

BACKFILL WORK ORDER ISSUED

DEPOSIT, \$ 10.00

3/28-60

SEWER WORK ORDER ISSUED

1043

DATE 3-29-60

BY

J.W. Holton INS+CON

The City of Mountlake Terrace

APPLICATION
for

SIDE SEWER PERMIT

OUTSIDE INSIDE REPAIRS

R.W. Boe

CARD No.

EASEMENT No. 1354255

OWNER ROGER W. and PATRICIA K. BOE

CONTRACTOR

PERMIT No. 2452

HOUSE NO. 23306 - 54th AVE. W.

STREET
AVENUE LOT NO. 13

BLOCK NO. 2


NAME ADD. DIVISION No. 6

47'-2"

CITY OF
MOUNTLAKE TERRACE

APR 9 1960

Plan Approved

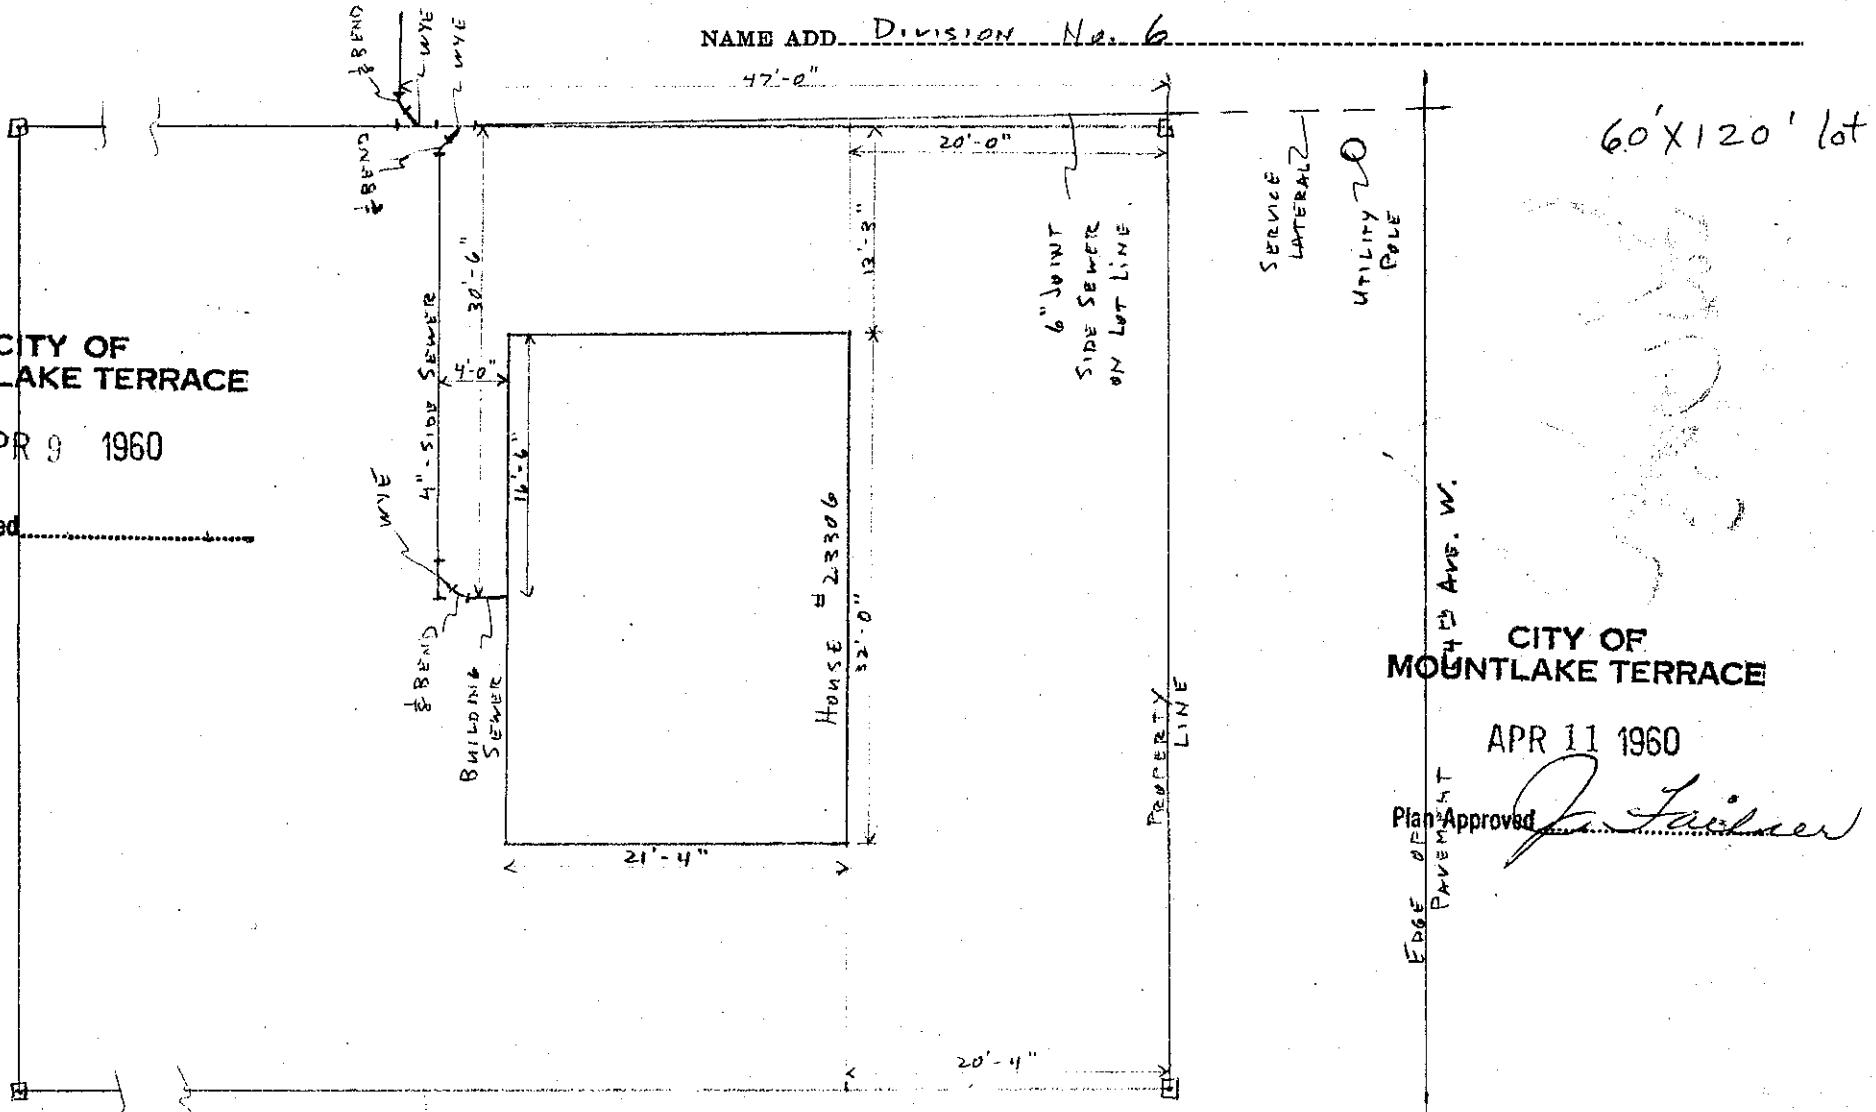

BACKFILL WORK ORDER ISSUED

DEPOSIT, \$10.00

Approved:

1240

SEWER WORK ORDER ISSUED

DATE

4/9/60

4/14/60

BY

J. Fairman

The City of Mountlake Terrace

APPLICATION

for

SIDE SEWER PERMIT

OUTSIDE INSIDE REPAIRS

CARD No.....

EASEMENT No.....

OWNER

George Barret

HOUSE No. 23307-54w.

60' wide.

CONTRACTOR

De Vosse Coast Co.

PERMIT No. 795


STREET

AVENUE LOT No. 4

BLOCK No. 3

NAME ADD

Mountlake Terrace Dist #6
Vol. 13 page 33.

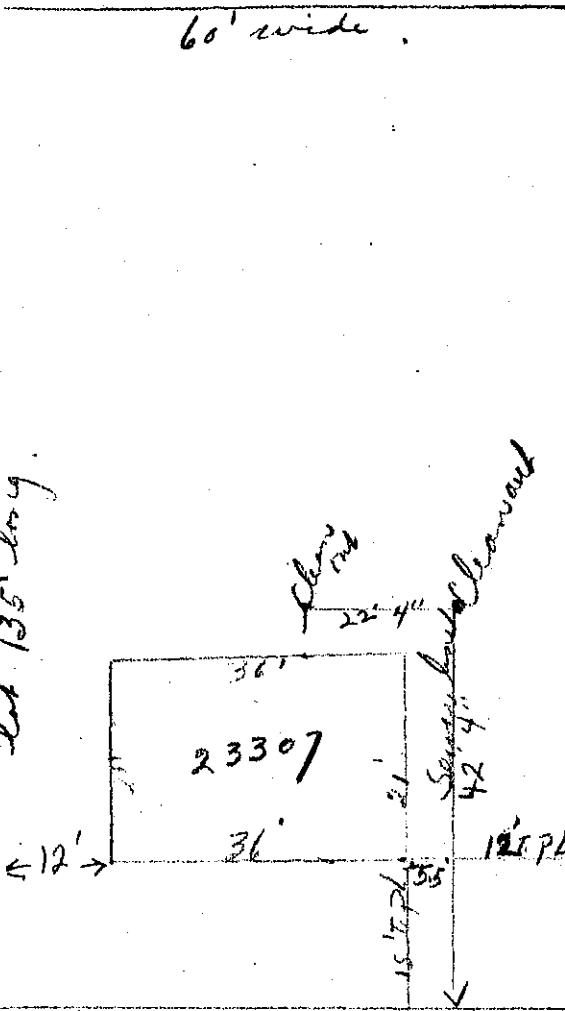

23307-54w.

Date

BACKFILL WORK ORDER ISSUED

SEWER WORK ORDER ISSUED

DEPOSIT, \$

10⁰⁰ 78/57

Approved:

4313

DATE 9-8-59

BY

Scott M Holton INS
NC.

10-31-59 INCL on 2nd

The City of Mountlake Terrace

APPLICATION

CARD NO.

SIDE SEWER PERMIT

OUTSIDE INSIDE REPAIRS

EASEMENT NO.

OWNER

W.H. VIMONT

CONTRACTOR

T & M CONSTRUCTION PERMIT NO. 1355

HOUSE No.


23308 54 West

STREET
AVENUE LOT No. 12

BLOCK No. 2 DIY

NAME ADD

60

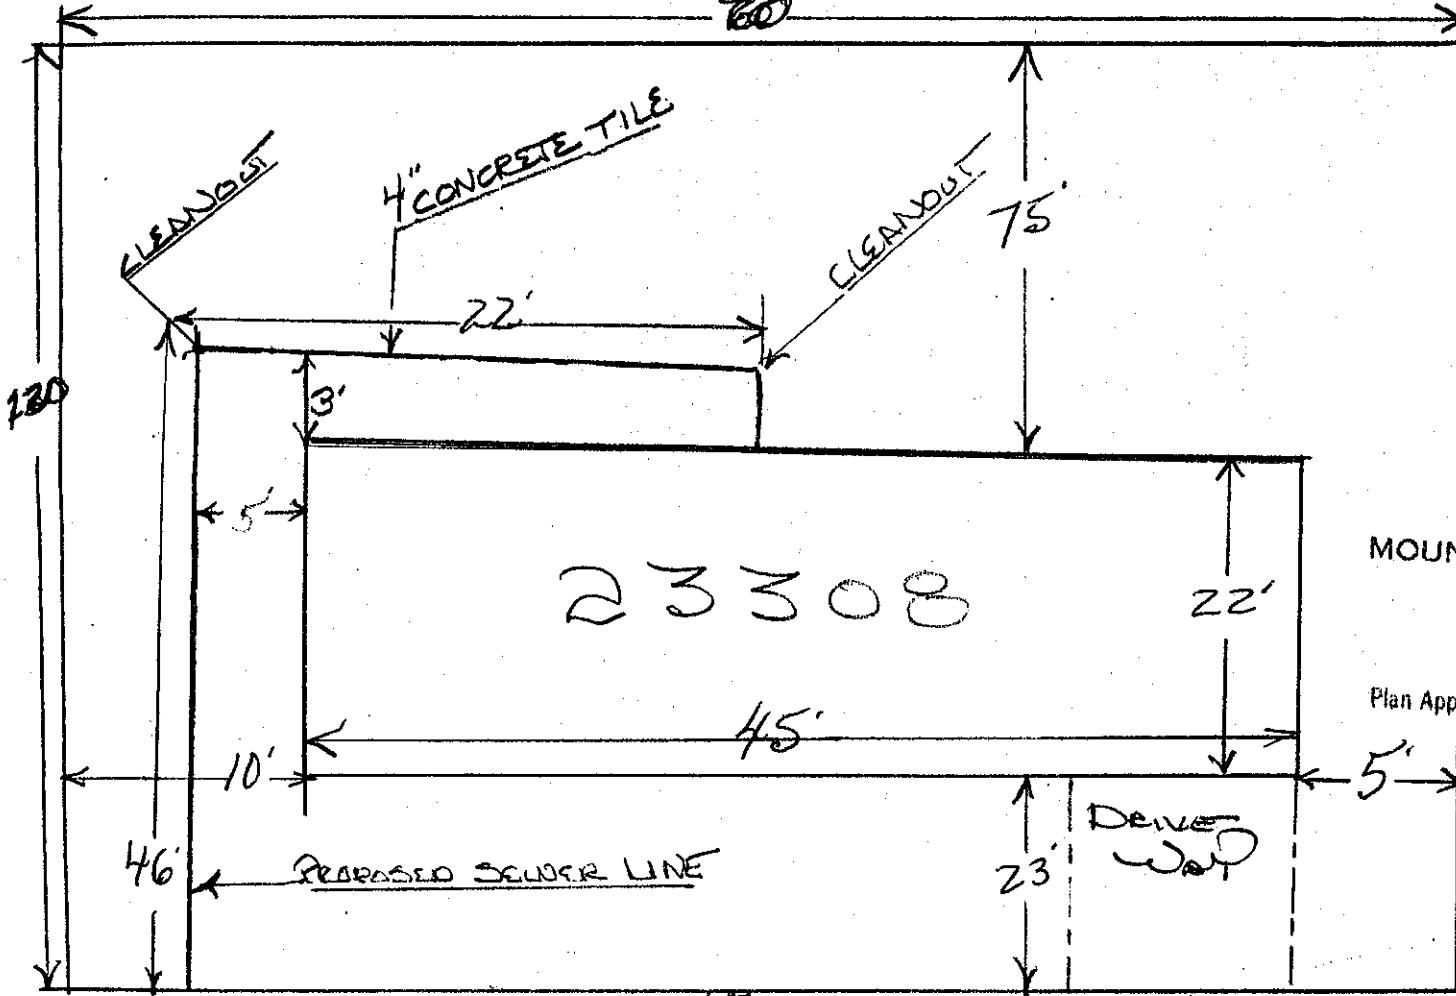

CITY OF
MOUNTLAKE TERRACE

DEC 22 1959

Plan Approved

J. Faiger
S.M.A.

Approved:

12-18-59

558 0

DATE 12-22-59 BY Scotton Holloman N.C.

BACKFILL WORK ORDER ISSUED

DEPOSIT \$10.00

12-18-59

SEWER WORK ORDER ISSUED

558 0

The City of Mountlake Terrace

R.A. DORSETT

CARD NO.

APPLICATION

for


SIDE SEWER PERMIT

OUTSIDE INSIDE REPAIRS

EASEMENT NO.

1385283

OWNER Ronald A. Dorsett & Donald J. CONTRACTOR Self PERMIT NO. 1922
HOUSE No. 2340 3/4 West STREET 2
AVENUE LOT NO. 2 BLOCK NO. 2
NAME ADD. MLT #7

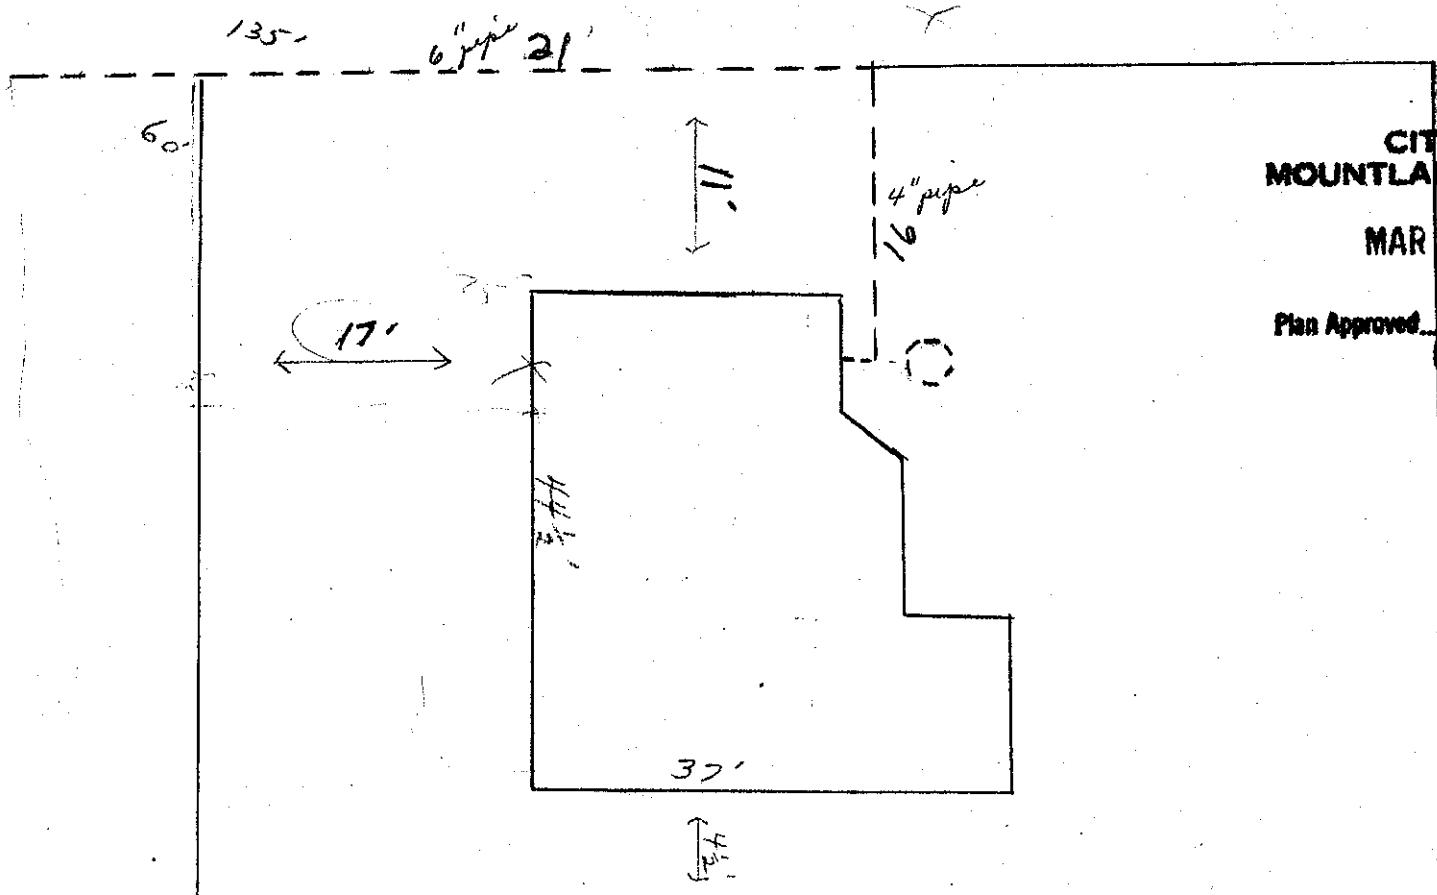

Date

Approved:

BACKFILL WORK ORDER ISSUED

DEPOSIT, \$

10.00

SEWER WORK ORDER ISSUED

3/10/60

DATE

3-21-60 BY

9/4/60
J. Faileux SM
Scott M. Holtor INS

The City of Mountlake Terrace

APPLICATION

for

SIDE SEWER PERMIT

OUTSIDE INSIDE REPAIRS

CARD No.

1357800

EASEMENT No.

OWNER GRACE V. PALMER
HOUSE NO. 23404 - W 54th

CONTRACTOR

PAY A. STEWART, CO. PERMIT NO. 1411

STREET
AVENUE LOT No.


19

BLOCK No.

NAME ADD.

MLT #7

PROPERTY OF
DENNIS SCHINDLER

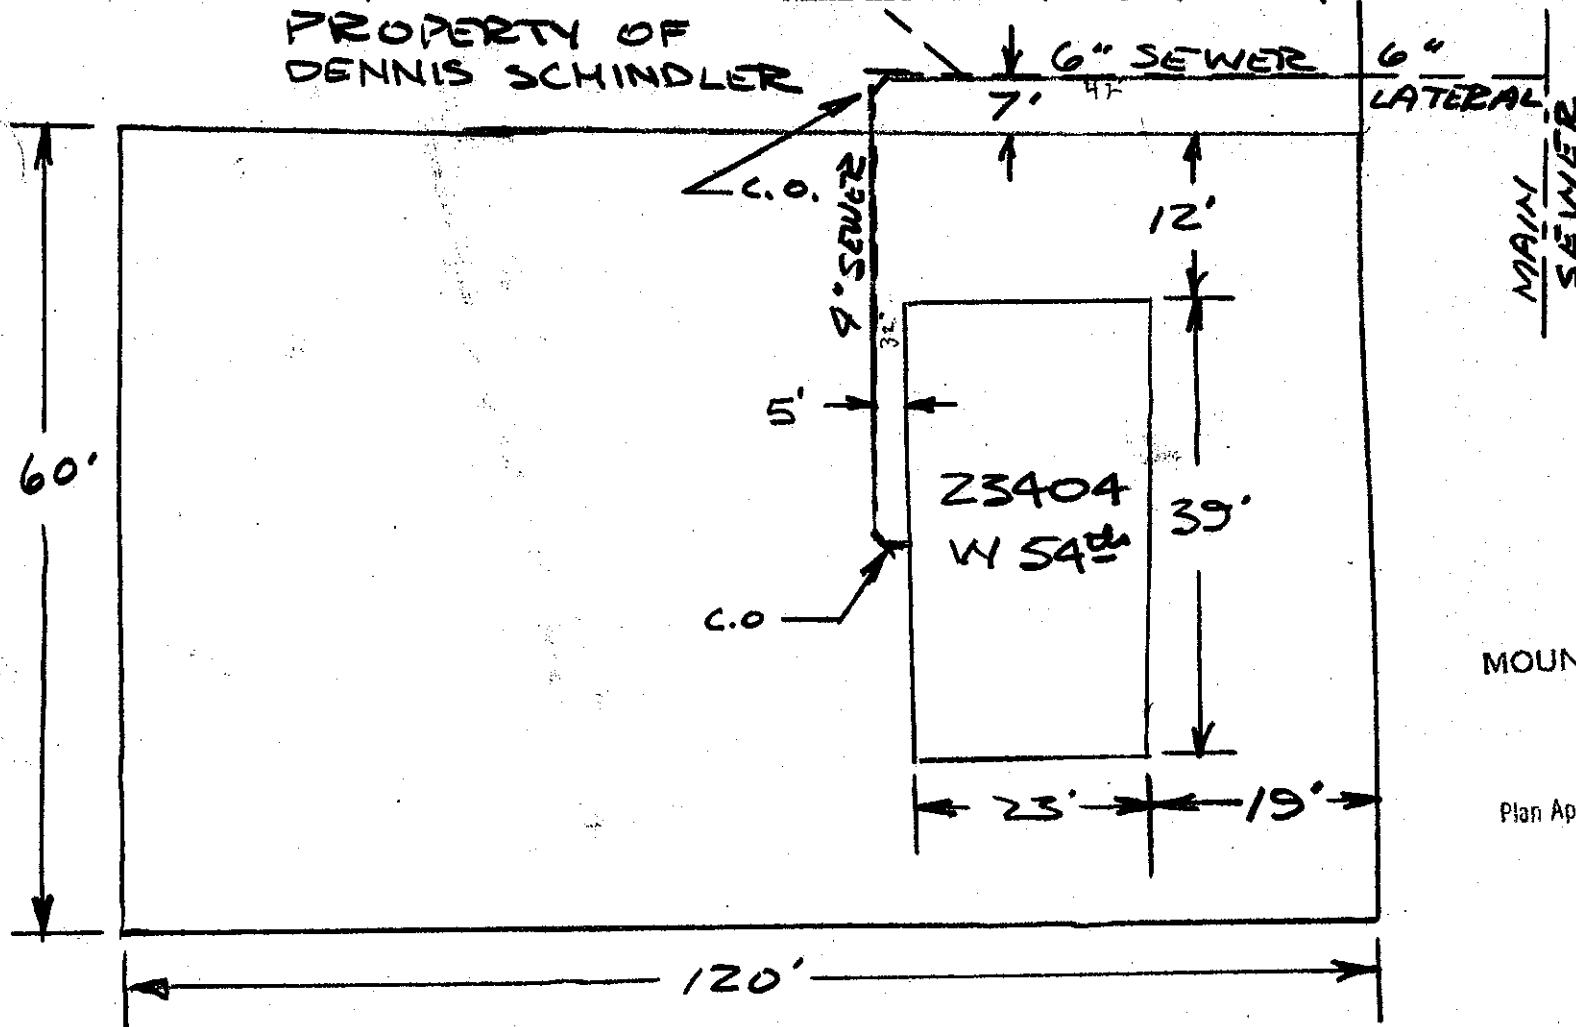

CITY OF
MOUNTLAKE TERRACE

DEC 31 1959

Plan Approved,

Scott M Holton 115601
5659 DATE 12/31/59 BY

Date

Approved:

BACKFILL WORK ORDER ISSUED

DEPOSIT, \$10⁰⁰ 12-31-59

SEWER WORK ORDER ISSUED

5659 DATE 12/31/59

The City of Mountlake Terrace

APPLICATION
for

SIDE SEWER PERMIT

OUTSIDE INSIDE REPAIRS

CARD No.

EASEMENT No. 136-0106

OWNER Newell Barker

HOUSE No. 23405 W. 54th.


CONTRACTOR

STREET
AVENUE LOT No. ~~3~~

PERMIT No. 1774

BLOCK No. 2

NAME ADD. ~~West 7~~

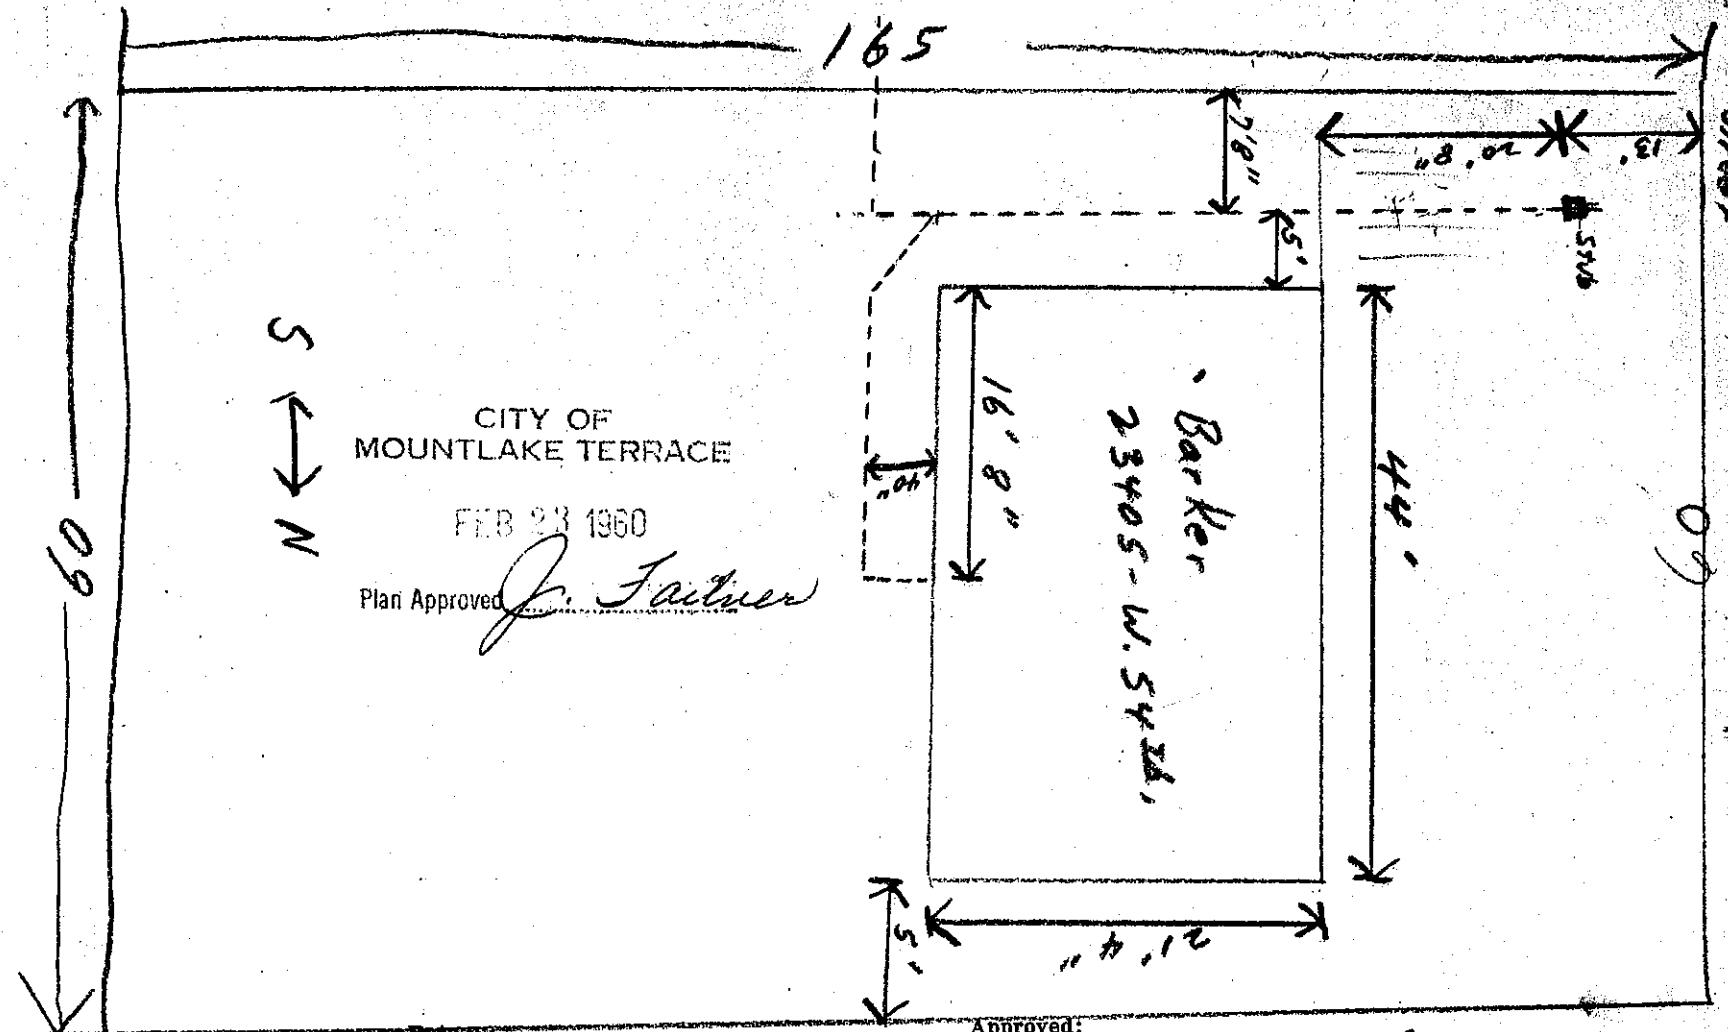

BACKFILL WORK ORDER ISSUED
SEWER WORK ORDER ISSUED

Date

DEPOSIT \$ 10.00

2-23-60

Ric 645

Approved:

DATE 3-8-60

BY

Scott M Holton NSCO

The City of Mountlake Terrace

APPLICATION

CARD NO.

SIDE SEWER PERMIT

OUTSIDE INSIDE REPAIRS

EASEMENT No. 1357678

OWNER Wm G. Ranck
HOUSE No. 23406 - W 54TH

CONTRACTOR

STREET
AVENUE LOT No.

NAME ADD.

Owner

18


M. Terrace Div #7

60'

PERMIT No. 964

BLOCK No.

BLK 1

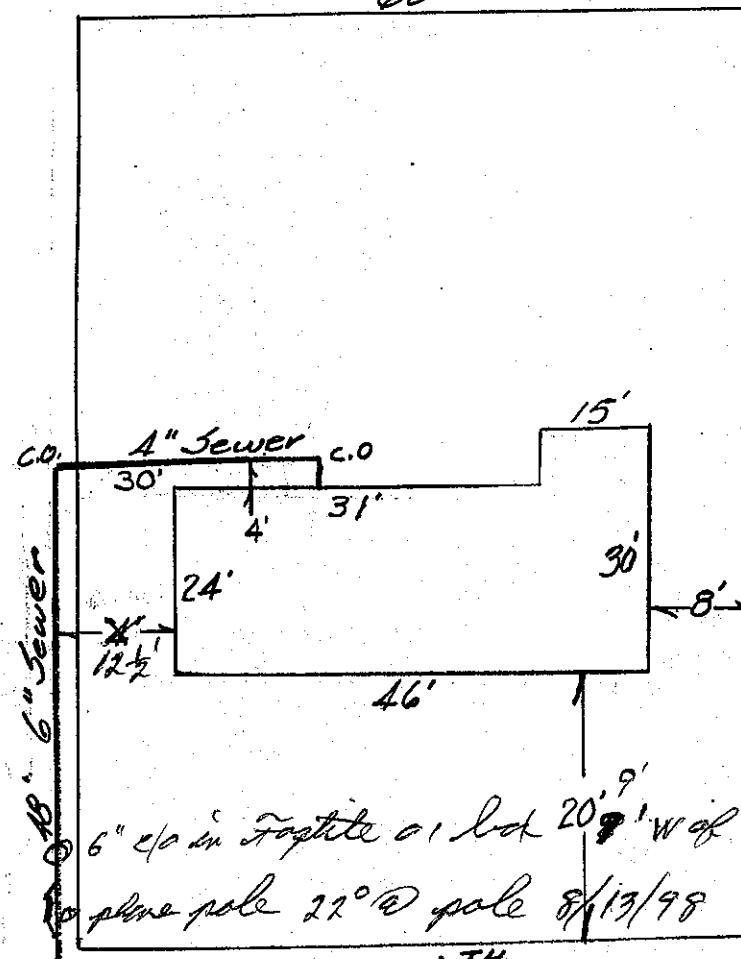

CITY OF
MOUNTLAKE TERRACE

DEC 2 1959

Plan Approved

J.M. Allee

BACKFILL WORK ORDER ISSUED
SEWER WORK ORDER ISSUED

Date

DEPOSIT, \$ 10.00

Receipt # 5123
Deposit 10/9/59

Approved:

DATE 12-2-59

BY

Scott M Holton I.M.S.N.

The City of Mountlake Terrace

APPLICATION

for

SIDE SEWER PERMIT

OUTSIDE INSIDE REPAIRS

JANET HELLER

CARD No.

EASEMENT No. 1360106

OWNER Janet Heller
HOUSE No. 23407 W. 54th

CONTRACTOR


STREET
AVENUE LOT NO.

NAME ADD.

PERMIT No. 1775

BLOCK No. 2

Div. 7

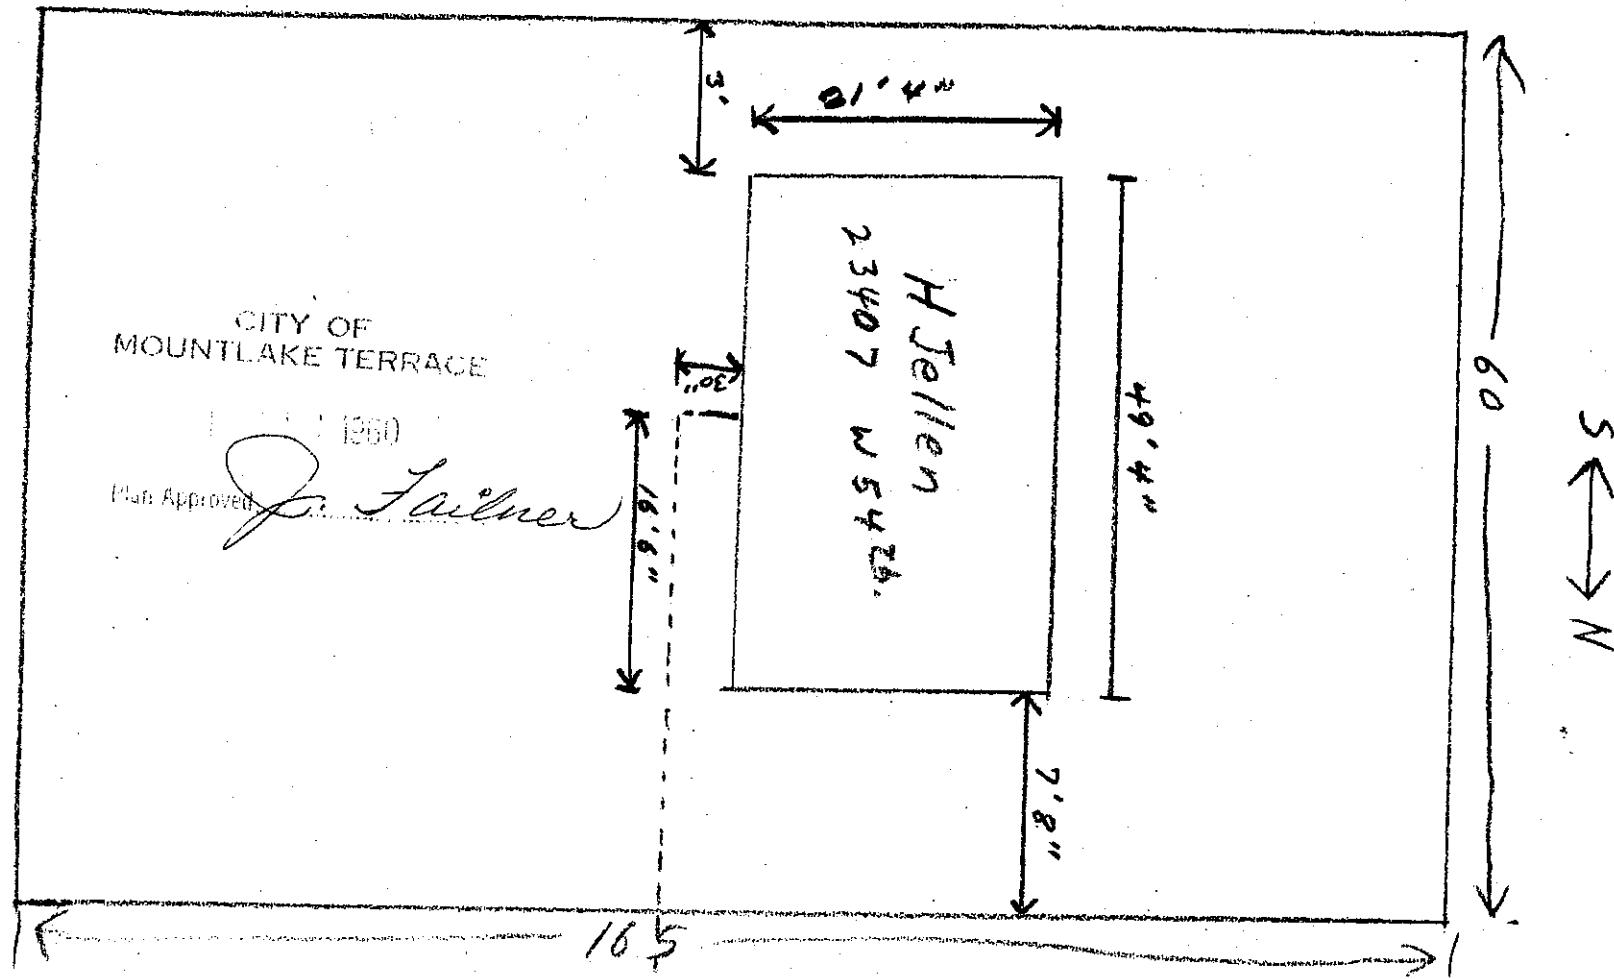

Date

Approved:

BACKFILL WORK ORDER ISSUED

SEWER WORK ORDER ISSUED

DEPOSIT, \$

DATE 3-8-60

BY Scott M Holton Mscov

The City of Mountlake Terrace

APPLICATION
FOR

SIDE SEWER PERMIT
OUTSIDE INSIDE REPAIRS

Robert Lutz
CARD No.

EASEMENT No.

1357678

OWNER ROBT LUTZ

HOUSE NO. 23408 - WEST 54TH


CONTRACTOR DAWN HOLBROOK

PERMIT NO. 1264

STREET AVENUE LOT NO. LOT 10 17

BLOCK NO. 1

NAME ADD. DIVISION 7

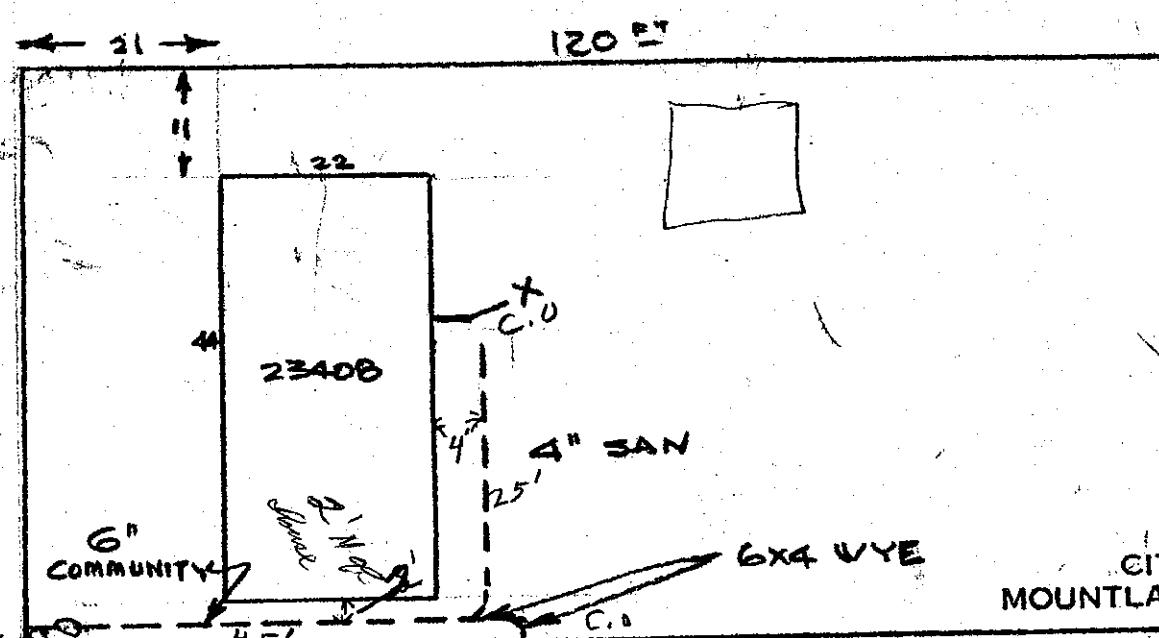

DEC 2 1959

Plan Approved

J. Fairnes
S.M.A.

Date

Approved:

DEPOSIT, \$ 10 ⁰⁰ 12-1-59

5484 DATE

BACKFILL WORK ORDER ISSUED
SEWER WORK ORDER ISSUED

12-2-59 BY Scott McHolton IWS
1-18-60 INST CON SMT NC

The City of Mountlake Terrace

APPLICATION

for

SIDE SEWER PERMIT

OUTSIDE INSIDE REPAIRS

D. F. Murphy

CARD NO.

EASEMENT No. 1359252

OWNER Donald F Murphy
HOUSE No. 23409 - 54th Av


CONTRACTOR self

STREET
AVENUE LOT No. LOT 5

BLOCK No. Block 2
NAME ADD. Mountlake terrace DIVISION 197

PERMIT No. 19445

WATER TIGHT PLANS

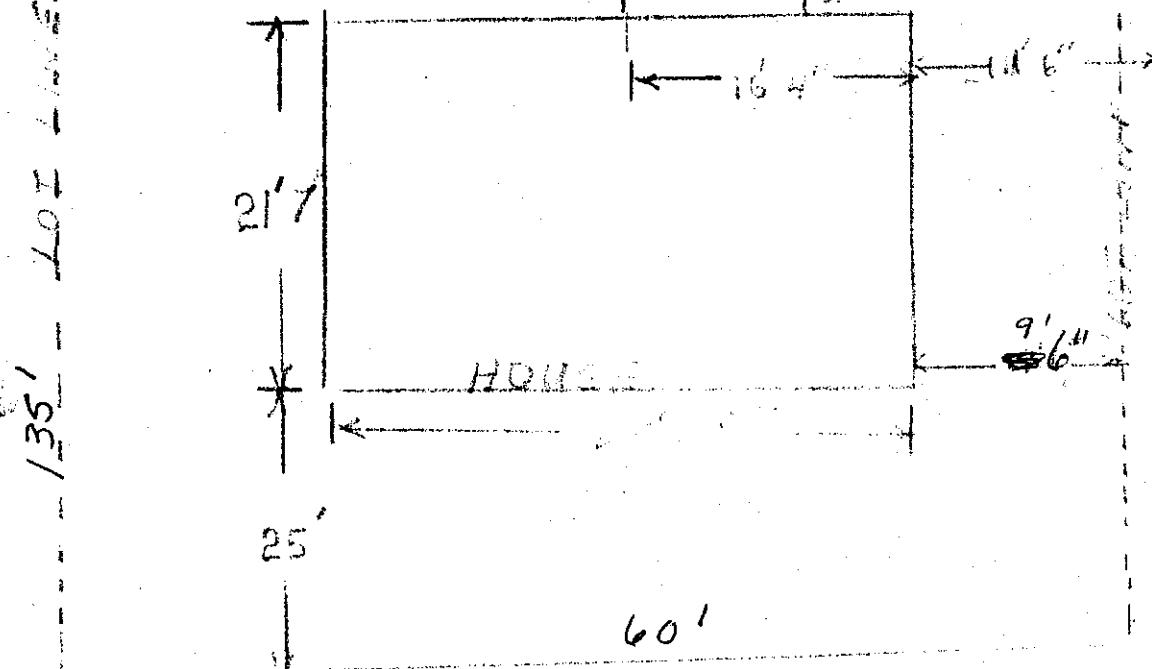

WATER TIGHT CONSTRUCTION

CITY OF
MOUNTLAKE TERRACE

MAR 14 1960

Plan Approved

J. Fairman

SERVICE LATERAL

BACKFILL WORK ORDER ISSUED
SEWER WORK ORDER ISSUED

Date

DEPOSIT, \$ 10.00

Approved:

rec. 799
Renee Greenan

DATE 3/15/60 BY J. Fairman

The City of Mountlake Terrace

APPLICATION

SIDE SEWER PERMIT

OUTSIDE INSIDE REPAIRS

CARD NO.

EASEMENT No. 13640116

OWNER

Roy Mc Daniels

PERMIT No. 1544

HOUSE No. 23410 - 54th St. M.L.T.

CONTRACTOR B.Y.C.


STREET

AVENUE LOT No. 16

DIV 7

BLOCK No. 1

NAME ADD.

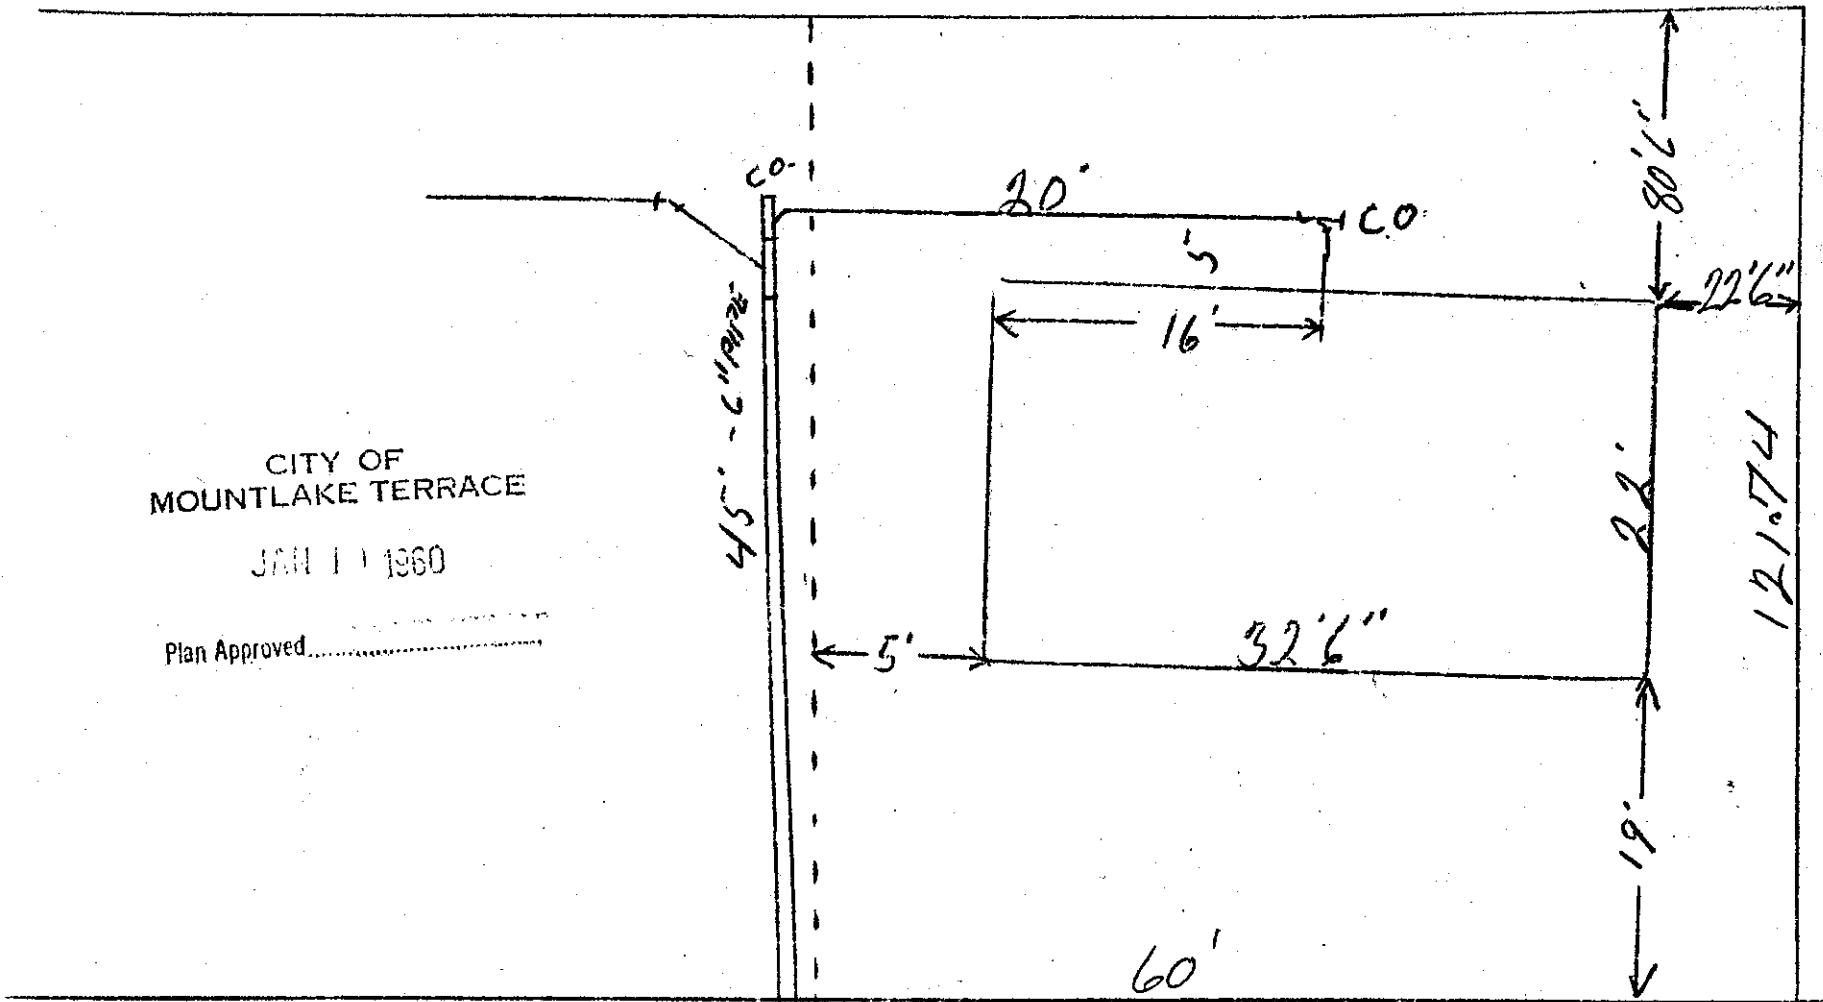

Date

Approved:

BACKFILL WORK ORDER ISSUED.....

DEPOSIT, \$ 10.00

SEWER WORK ORDER ISSUED.....

1/21/60

DATE 1-21-60

BY

#5825 Deposit

Scott M Holton NSC on

The City of Mountlake Terrace

APPI

R.W. 7

CARD NO.

1359252

SIDE SEWER PERMIT

OUTSIDE INSIDE REPAIRS

EASEMENT NO.

OWNER: Randall W. & Bernice File

HOUSE No. 23501 54th Ave N

CONTRACTOR

self

PERMIT NO.

1944

STREET
AVENUE LOT No.


6

BLOCK NO.

2

NAME ADD.

Mountlake Terrace Division No 7

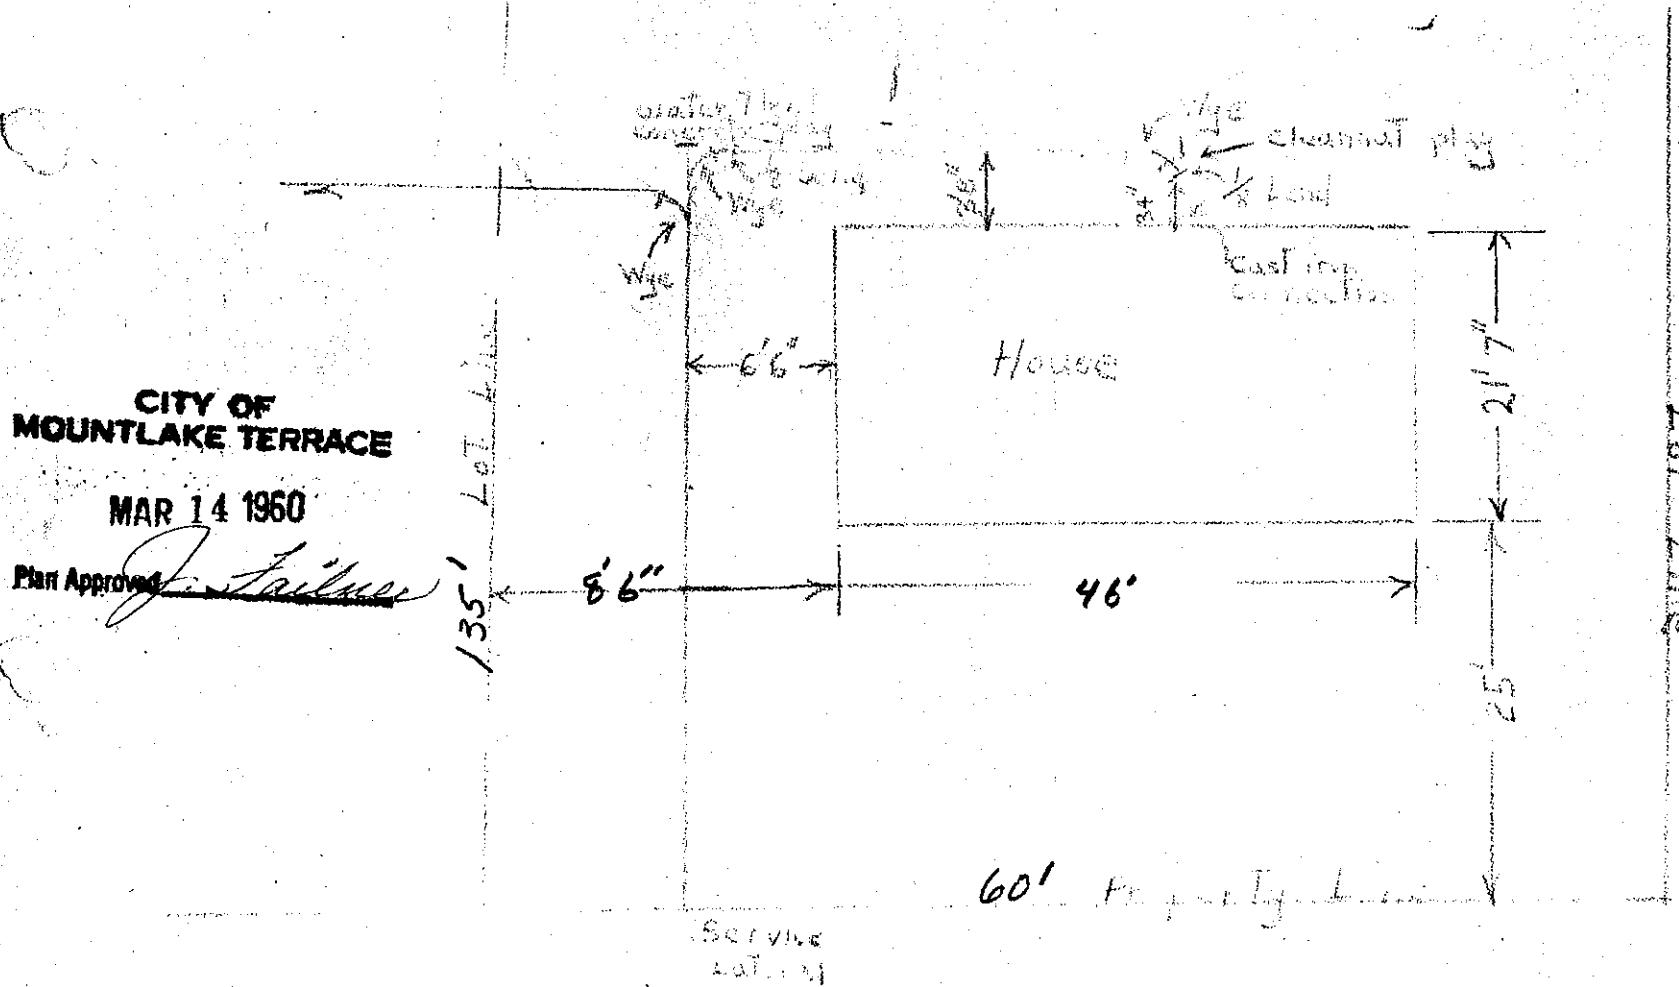

Plan Approved

J. Fairman

MAR 14 1960

Date

Approved:

BACKFILL WORK ORDER ISSUED

SEWER WORK ORDER ISSUED

DEPOSIT, \$

1000

rec. 798

DATE 3/15/60 BY

Reini Freeman

The City of Mountlake Terrace

APPLICATION
FOR

SIDE SEWER PERMIT

OUTSIDE INSIDE REPAIRS

DONNIE PIERCE
CARD No.

136-4416

EASEMENT No.

OWNER

Donnie Pierce

CONTRACTOR

B&E

PERMIT No.

1545

HOUSE NO.

23502-54th SW M.L.T.


STREET

AVENUE

LOT No. 15 DIV 7

BLOCK No. 1

NAME ADD.

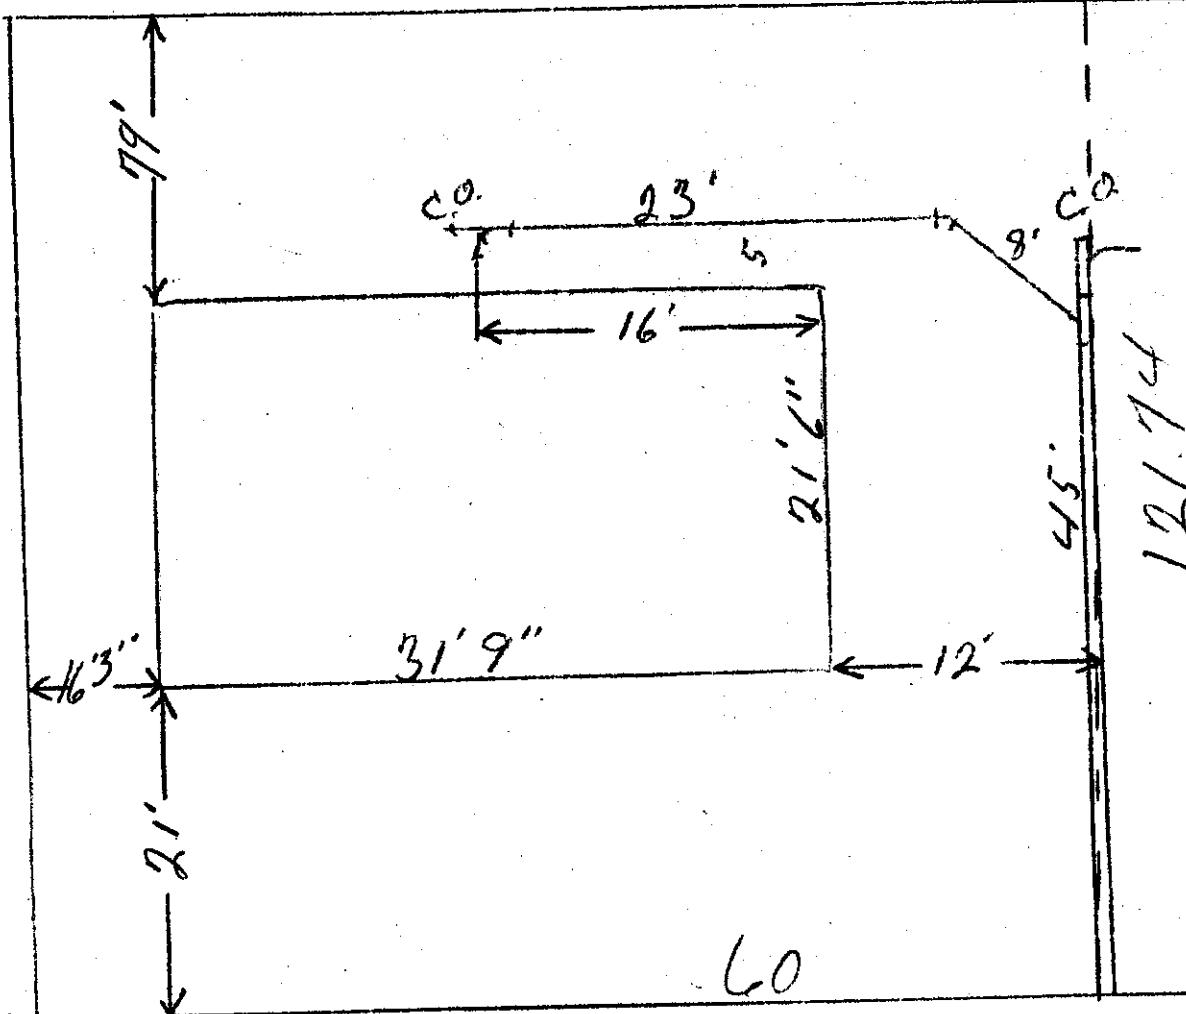

CITY OF
MOUNTLAKE TERRACE

JAN 21 1960

Plan Approved

Date

Approved:

BACKFILL WORK ORDER ISSUED

DEPOSIT, \$ 10.00

SEWER WORK ORDER ISSUED

1/21/60
#5825 Dept

DATE

1-21-60

BY

Scott M Holton/NSTcom

The City of Mountlake Terrace

APPLICATION

for

SIDE SEWER PERMIT

OUTSIDE INSIDE REPAIRS

Louis Castro

CARD NO.

EASEMENT No.

OWNER Louis Castro
HOUSE No. 2350 3-54th W.

CONTRACTOR

C & E Contracting

PERMIT No.

2488

STREET
AVENUE LOT NO.

7

BLOCK No.

2


NAME ADD.

MLT DIV. #7

CITY OF
MOUNTLAKE TERRACE

APR 18 1960

Plan Approved

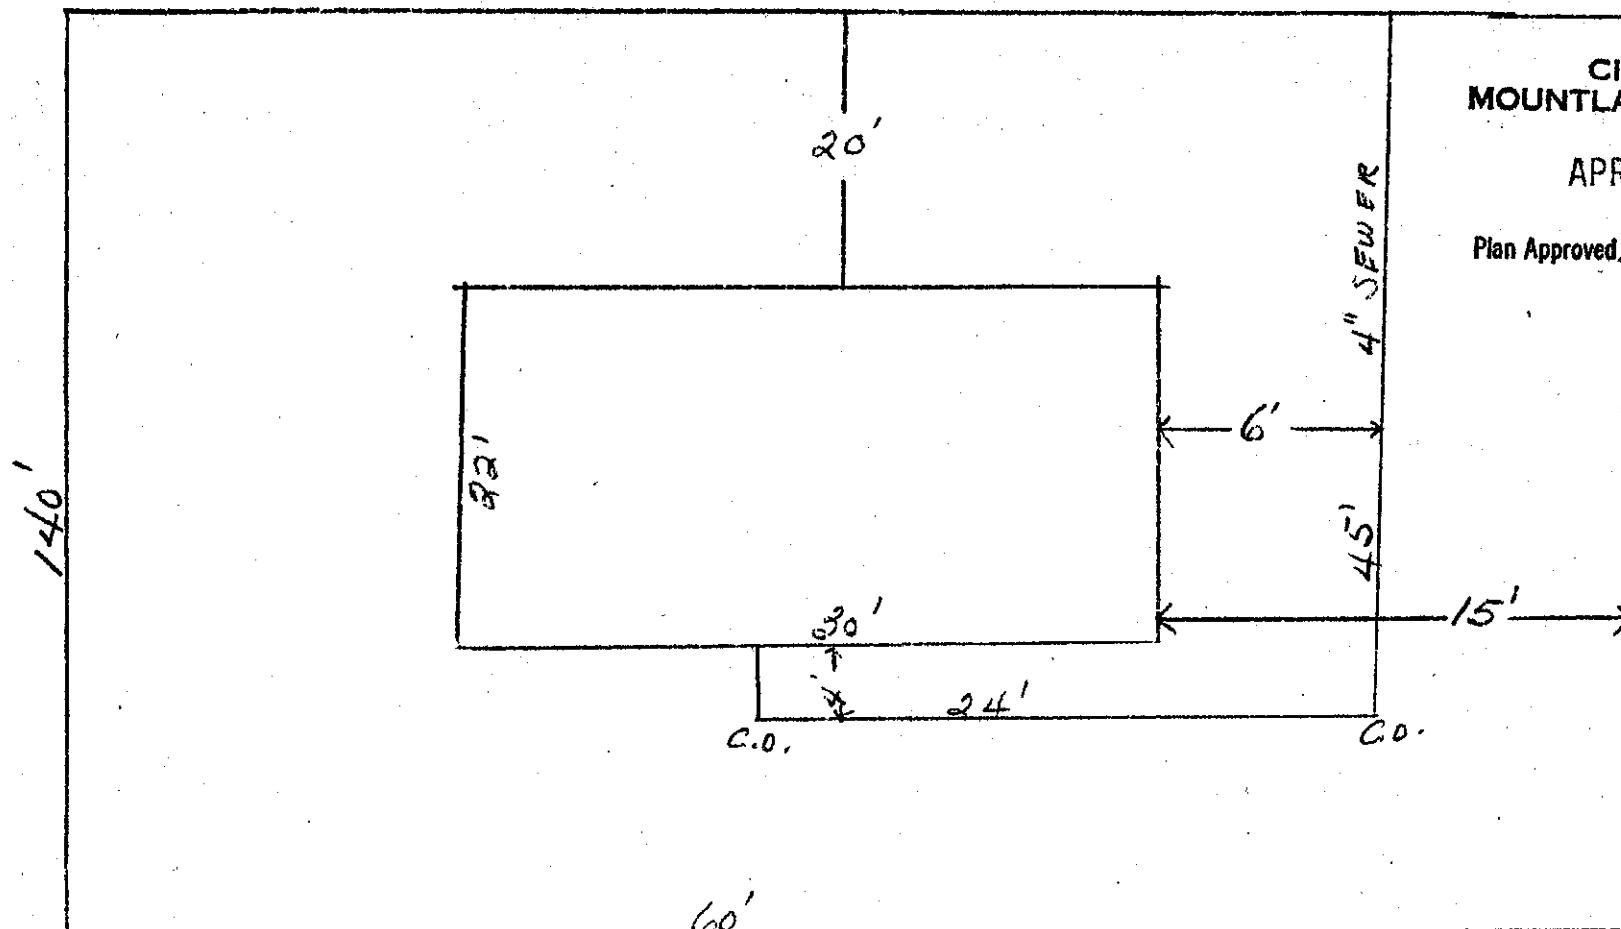

Date

BACKFILL WORK ORDER ISSUED

DEPOSIT, \$10.00

Approved:

4/15/60

SEWER WORK ORDER ISSUED

1277

DATE 4-18-60

BY S. M. Holton INST CO

The City of Mountlake Terrace

APPLICATION

for


SIDE SEWER PERMIT

OUTSIDE INSIDE REPAIRS

CARD No. ~~2003~~ 050

EASEMENT No. 1348630

OWNER Loren A. Hansen & Barbara A. Hansen, his wife CONTRACTOR None Self PERMIT No. 2003
HOUSE No. 23505 - 54th Ave. West STREET AVENUE LOT NO. 8 BLOCK NO. 2
NAME ADD M.L.T. #7

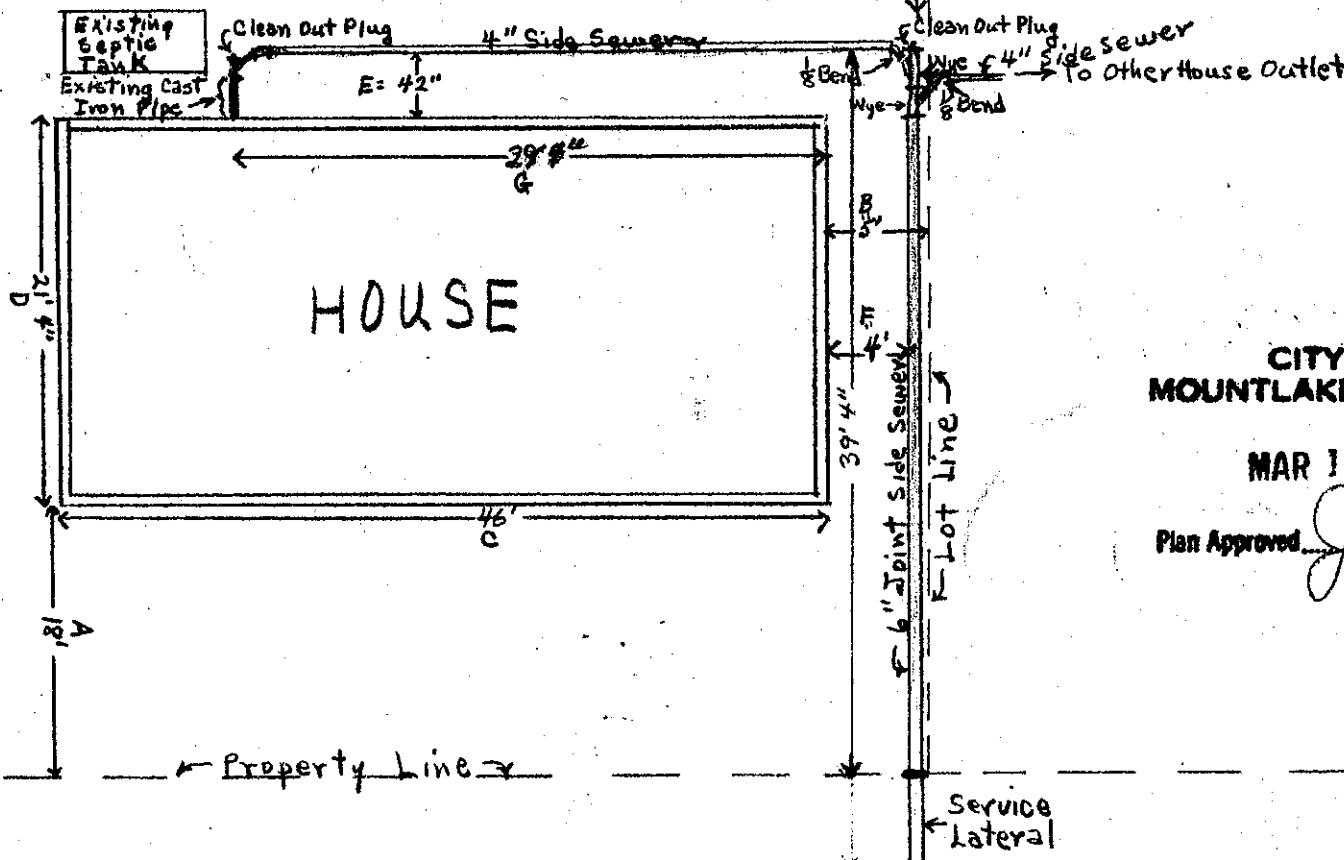

CITY OF
MOUNTLAKE TERRACE

MAR 15 1960

Plan Approved

J. Failner
SM

BACKFILL WORK ORDER ISSUED

Date

Approved:

DEPOSIT, \$ 10.00

SEWER WORK ORDER ISSUED

3/15/60
T18 F9

DATE 4/11/60

BY

J. Failner

The City of Mountlake Terrace

APPLICATION

for

SIDE SEWER PERMIT

CARD No.

OUTSIDE INSIDE REPAIRS

EASEMENT No.

JOB FINISHED FOR CITY BY WINGFIELD

OWNER

Chesley

CONTRACTOR

C & E CONTRACTING

PERMIT No. 2489

HOUSE No.

28506 - 54th W.

STREET

13

AVENUE LOT No.

BLOCK No.

E.R. McDONALD
STEVENS NURTON INC.


NAME ADD.

DIV. # 7

CITY OF
MOUNTLAKE TERRACE

APR 18 1960

Plan Approved

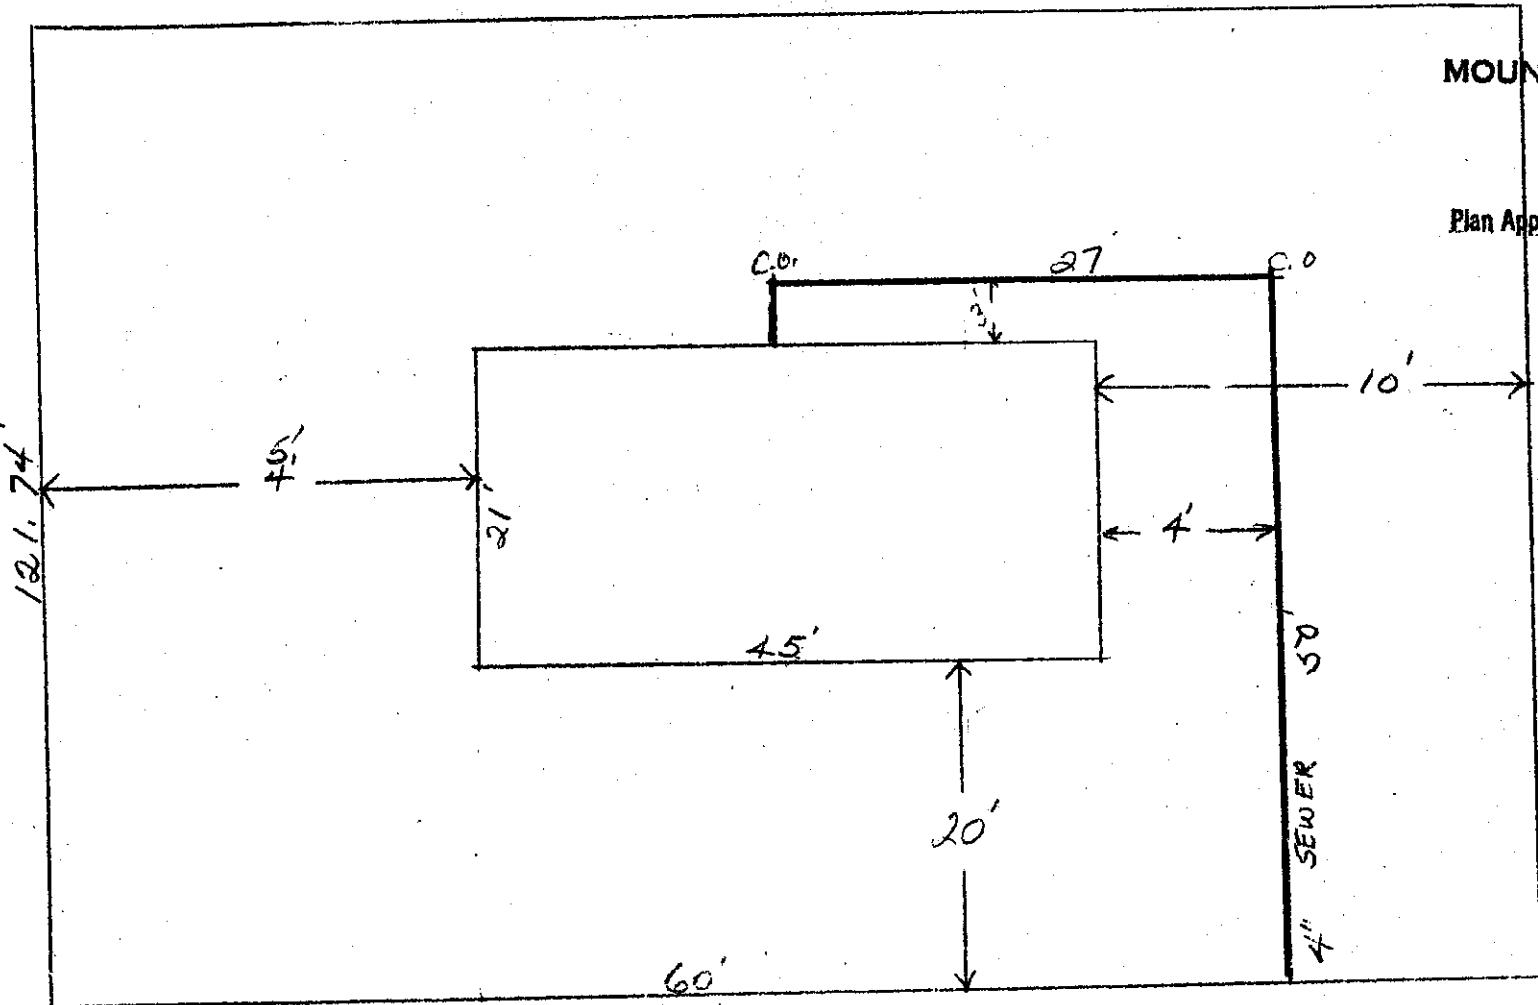

Date

Approved:

BACKFILL WORK ORDER ISSUED

DEPOSIT, \$10.00

4/15/60

SEWER WORK ORDER ISSUED

DATE 4-18-60

BY S.M. Tolton INC.

The City of Mountlake Terrace

APPLICATION

for

SIDE SEWER PERMIT

OUTSIDE INSIDE REPAIRS

EARL W. WERNES

CARD NO.

EASEMENT No. None

OWNER Earl Werness

HOUSE No. 23508 - 54th W.

CONTRACTOR Wingfield - Brown


PERMIT No. 1736

STREET
AVENUE LOT No. 12

BLOCK No. 1

NAME ADD.

Div. # 7

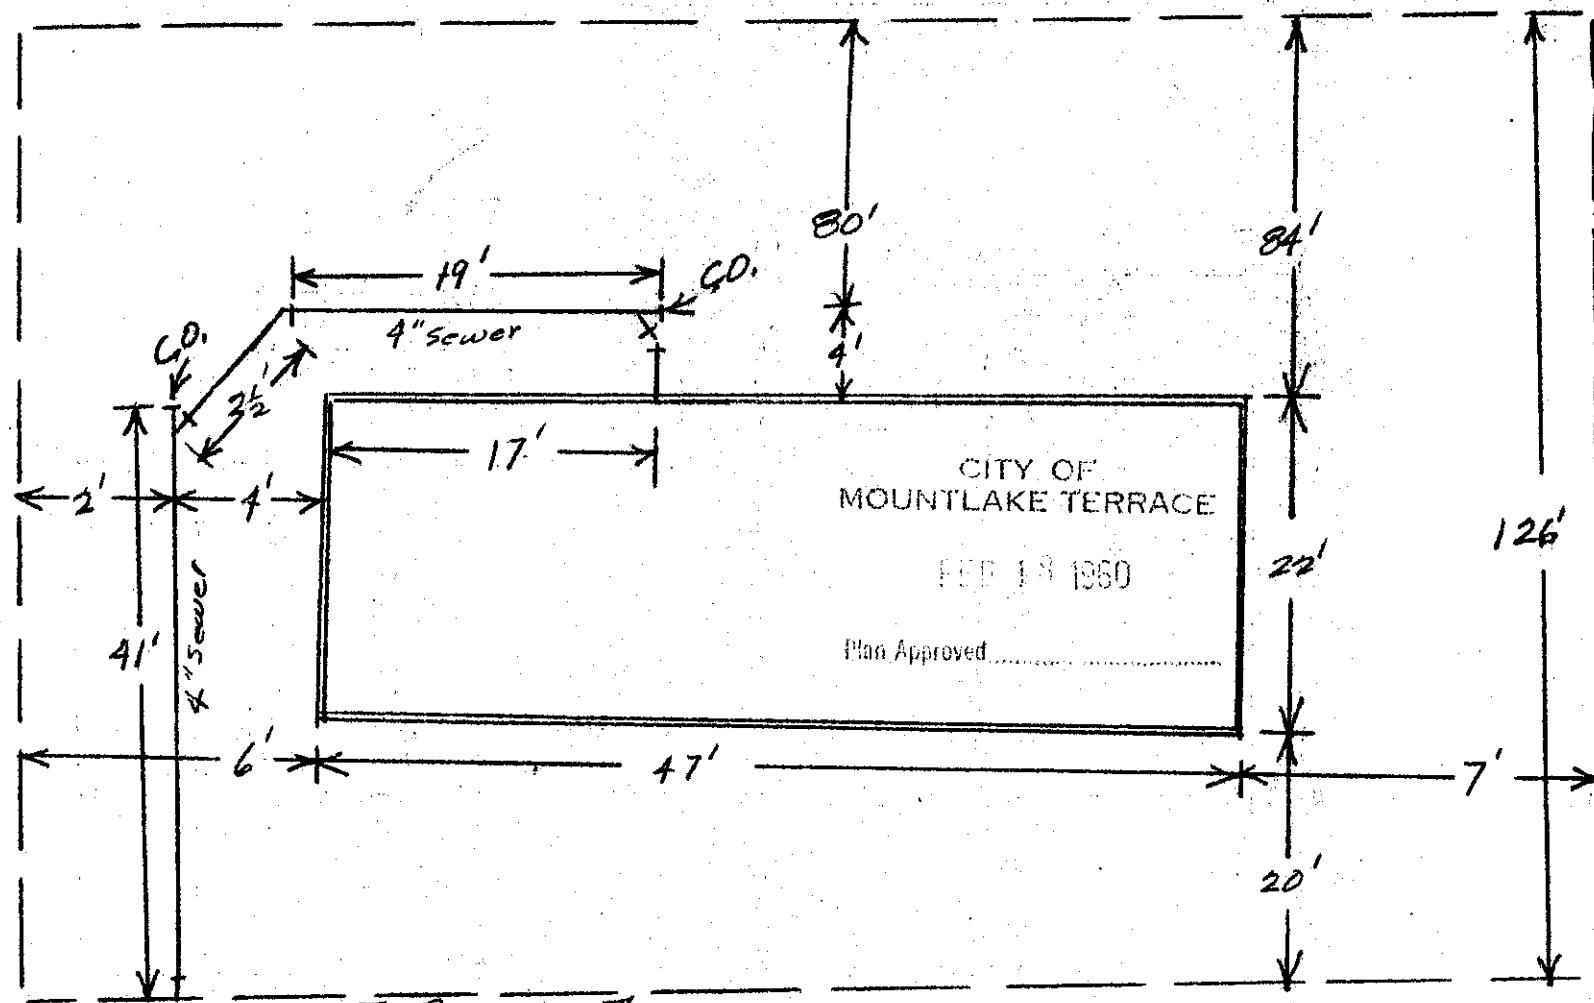

Date

Approved:

BACKFILL WORK ORDER ISSUED

DEPOSIT, \$ 10.00

SEWER WORK ORDER ISSUED

2-17-60

Ron H. Egan

DATE 2-18-60

BY

Scott M Holton, NSCON

APPLICATION
FOR

A. McLeod

CARD No.

The City of Mountlake Terrace

SIDE SEWER PERMIT

OUTSIDE INSIDE REPAIRS

EASEMENT No. None

OWNER A. McLeod

HOUSE NO. 23604 - 54th W.

CONTRACTOR

Wingfield - Brown

PERMIT NO. 192


STREET
AVENUE LOT NO.

28 #5

BLOCK NO.

NAME ADD.

D.I.Y. # 8

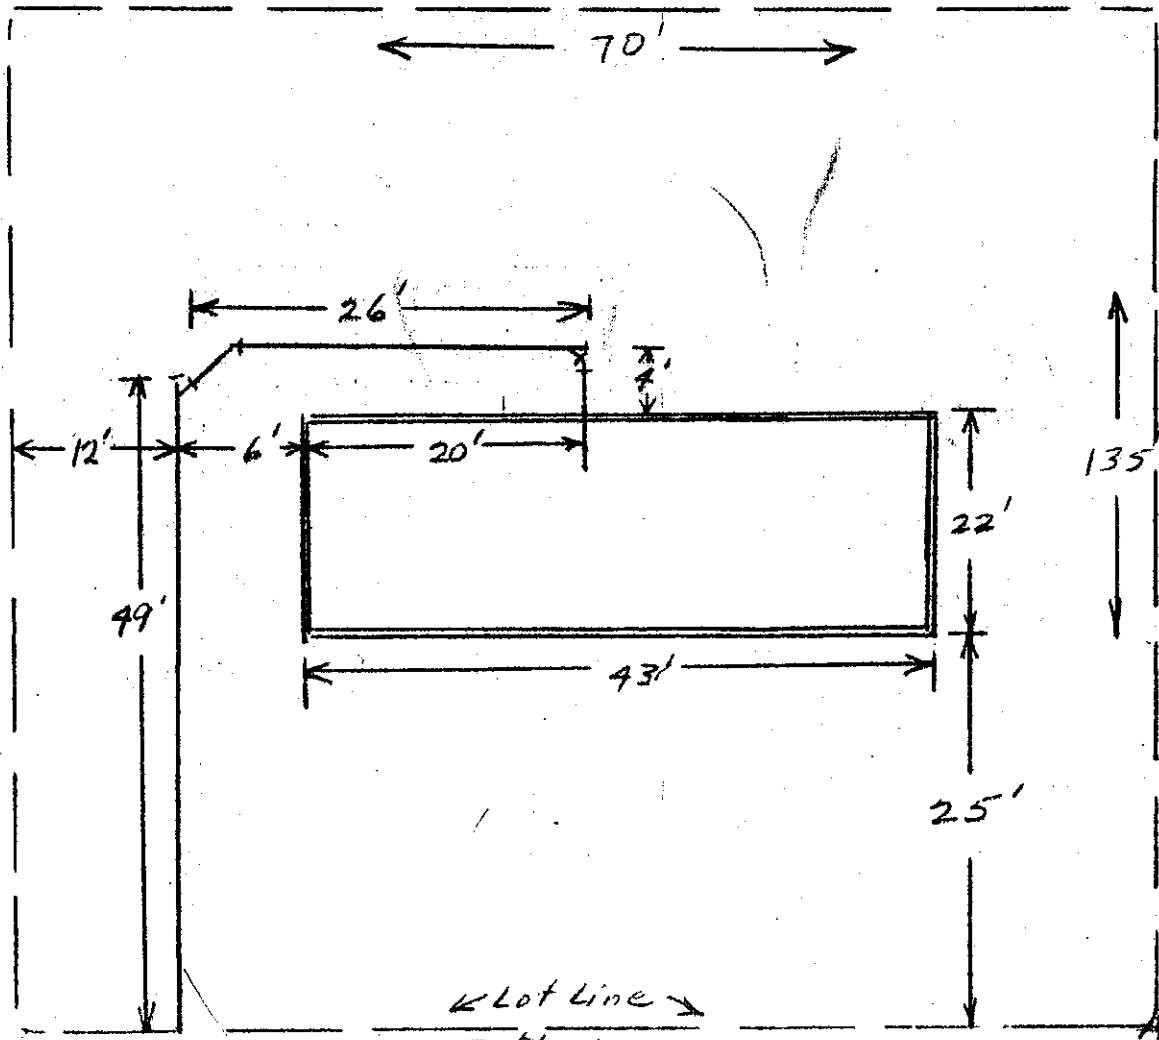

Date

<Lot Line>

54th W.

Approved:

BACKFILL WORK ORDER ISSUED

DEPOSIT, \$ 10,00

SEWER WORK ORDER ISSUED

675-60

H 1618

DATE 6/15/60

BY

J. McLeod

APPLICATION

for

SIDE SEWER PERMIT

OUTSIDE INSIDE REPAIRS

K. E. Early

CARD NO.

The City of Mountlake Terrace

EASEMENT NO.

OWNER Kenneth E. Early

CONTRACTOR Owner

STREET
AVENUE LOT No. 9

PERMIT NO. 2278

HOUSE No. 23605 54th W.

BLOCK No.


NAME ADD

DIV. 8

CITY OF
MOUNTLAKE TERRACE

MAY 5 1960

Plan Approved

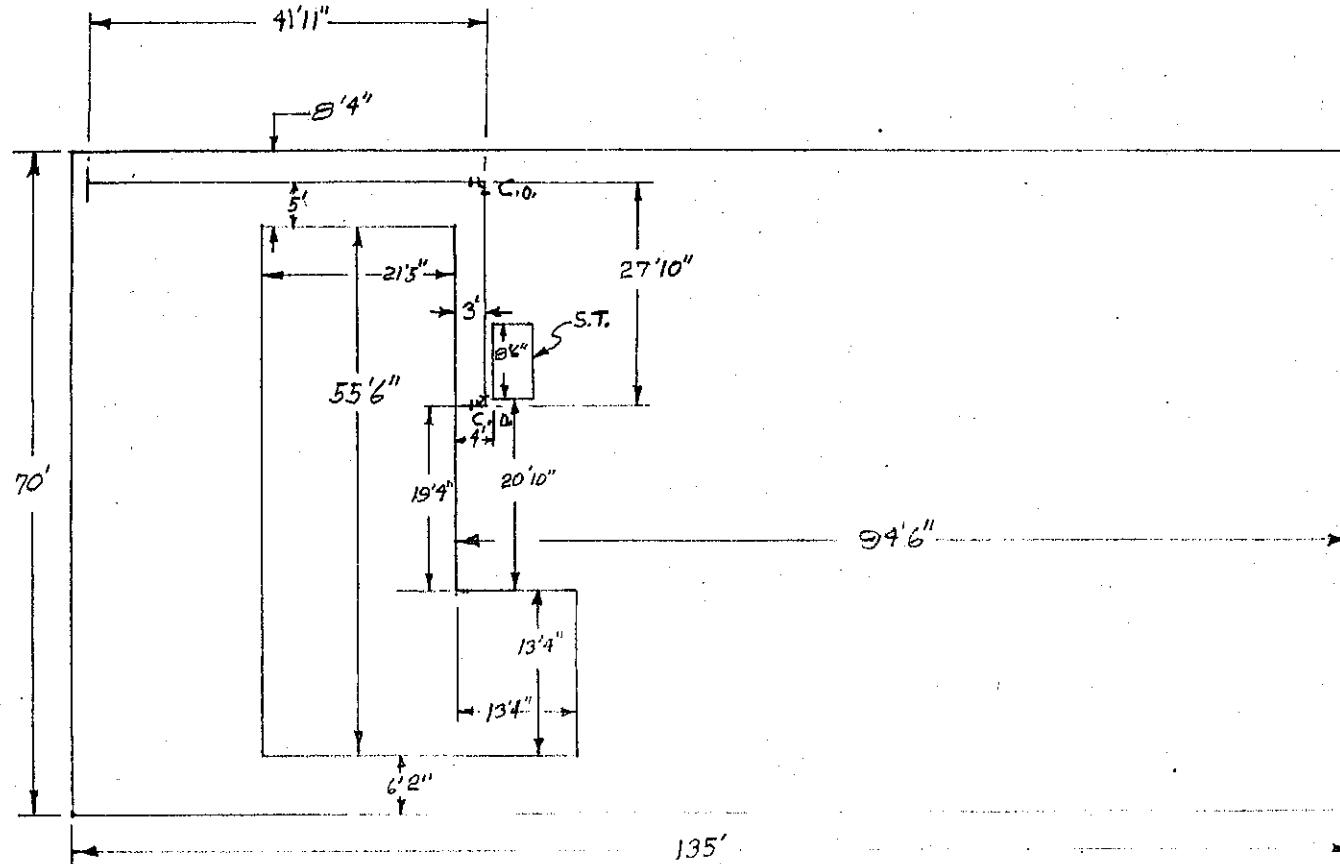

Date

Approved:

BACKFILL WORK ORDER ISSUED

DEPOSIT, \$10.00 3/29/60

SEWER WORK ORDER ISSUED

1070

DATE 5-5-60

BY

S. M. Holton INST+CON

The City of Mountlake Terrace

APPLICATION

for

SIDE SEWER PERMIT

OUTSIDE INSIDE REPAIRS

Ed. ATKINSON

CARD NO.

EASEMENT No. None

OWNER L Edgar Atkinson

HOUSE No. 23719 - 54th W.

CONTRACTOR Wingfield - Brown


PERMIT No. 54

STREET

AVENUE LOT No.

BLOCK No.

NAME ADD.

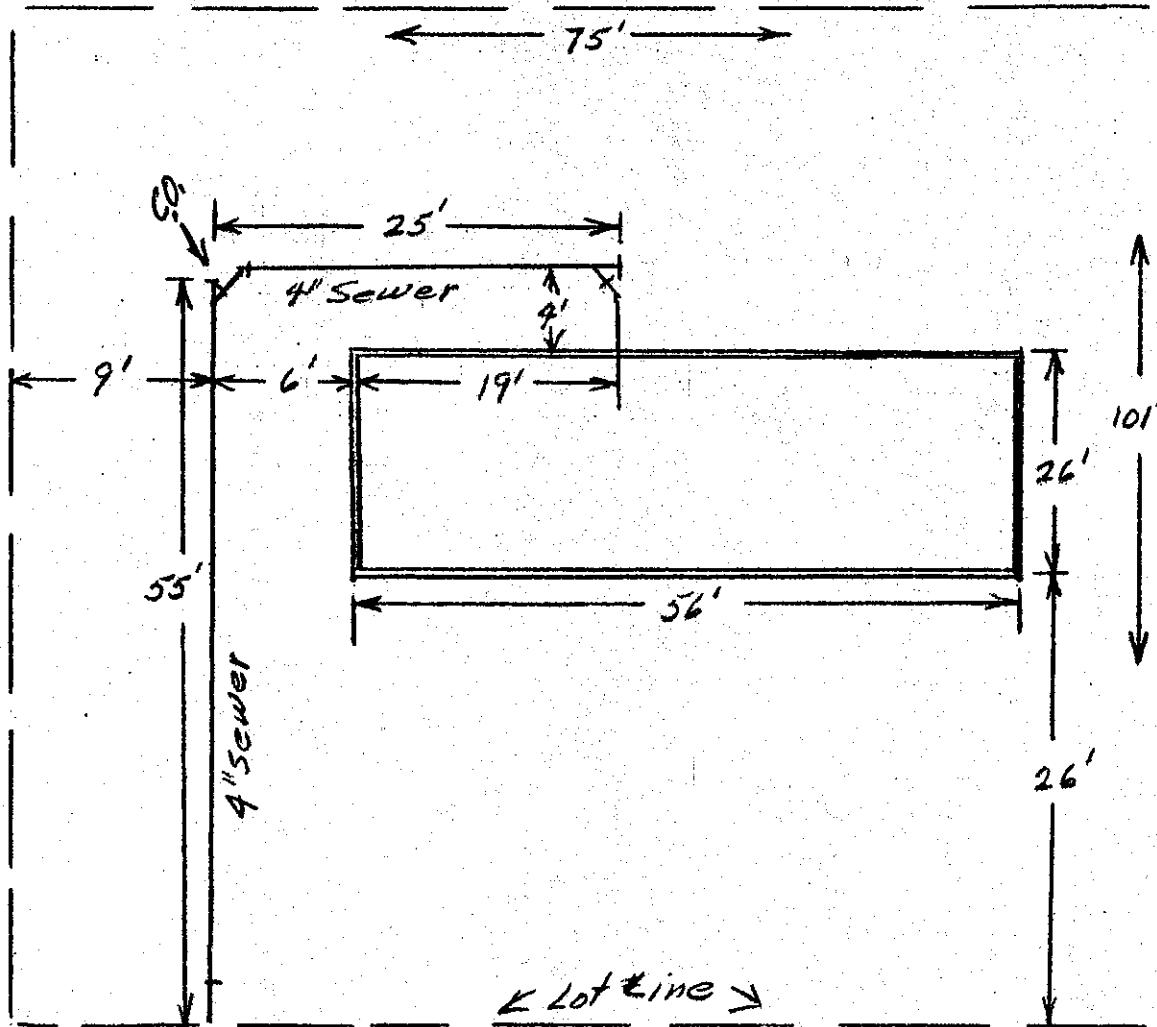

Date

BACKFILL WORK ORDER ISSUED

SEWER WORK ORDER ISSUED

DEPOSIT, \$

10.00

5-19-60

Approved:

DATE

6/17/60

BY

J. M. Maran

The City of Mountlake Terrace

APPLICATION

for

SIDE SEWER PERMIT

OUTSIDE INSIDE REPAIRS

CARD No.

EASEMENT No. None

OWNER G. J. P'ELAN

HOUSE No. 23801 - 54th W.

CONTRACTOR HALE CONSTRUCTION

STREET AVENUE LOT No. 1

NAME ADD. LIND TRACT

PERMIT No. 897

BLOCK No. 2


54TH WEST

CITY OF
MOUNTLAKE TERRACE

SEP 25 1959

Plan Approved:

J. S. Fairman

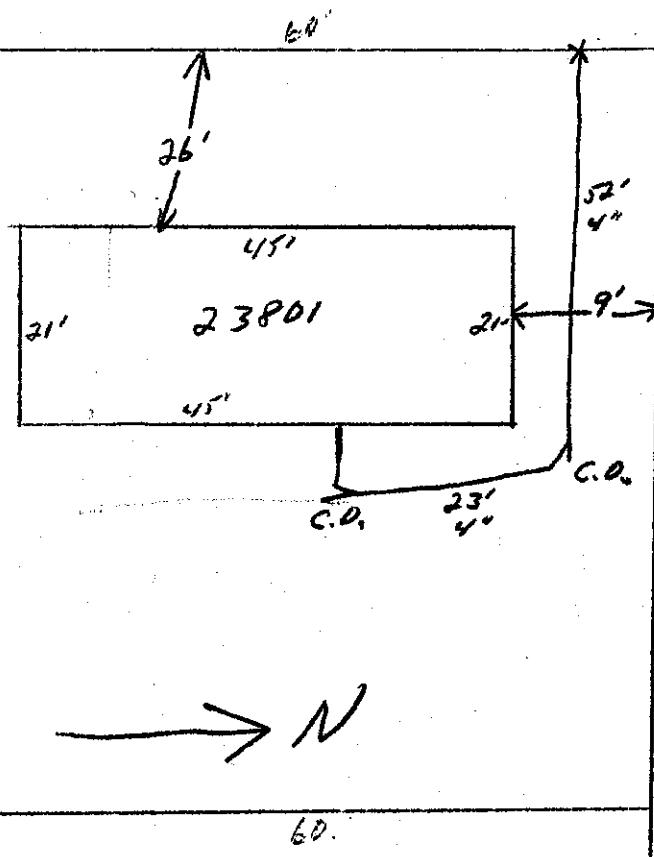

BACKFILL WORK ORDER ISSUED

SEWER WORK ORDER ISSUED

Date

DEPOSIT, \$ 10⁰⁰ 9/24/59 Approved:

Approved:
DATE

9-25-59

BY

Scott M Holton INS

#4977

2-11-1A INST CON 8MTH

N.C.

The City of Mountlake Terrace

APPLICATION
for

SIDE SEWER PERMIT

OUTSIDE INSIDE REPAIRS

MAX CUMMING'S

CARD NO.

None

EASEMENT NO.

PERMIT NO.

OWNER

Max Cummings
23802 W 57th

HOUSE NO.

CONTRACTOR

Self

STREET


AVENUE LOT NO.

40

54"

NAME ADD.

60 Repeat of Link Tracts

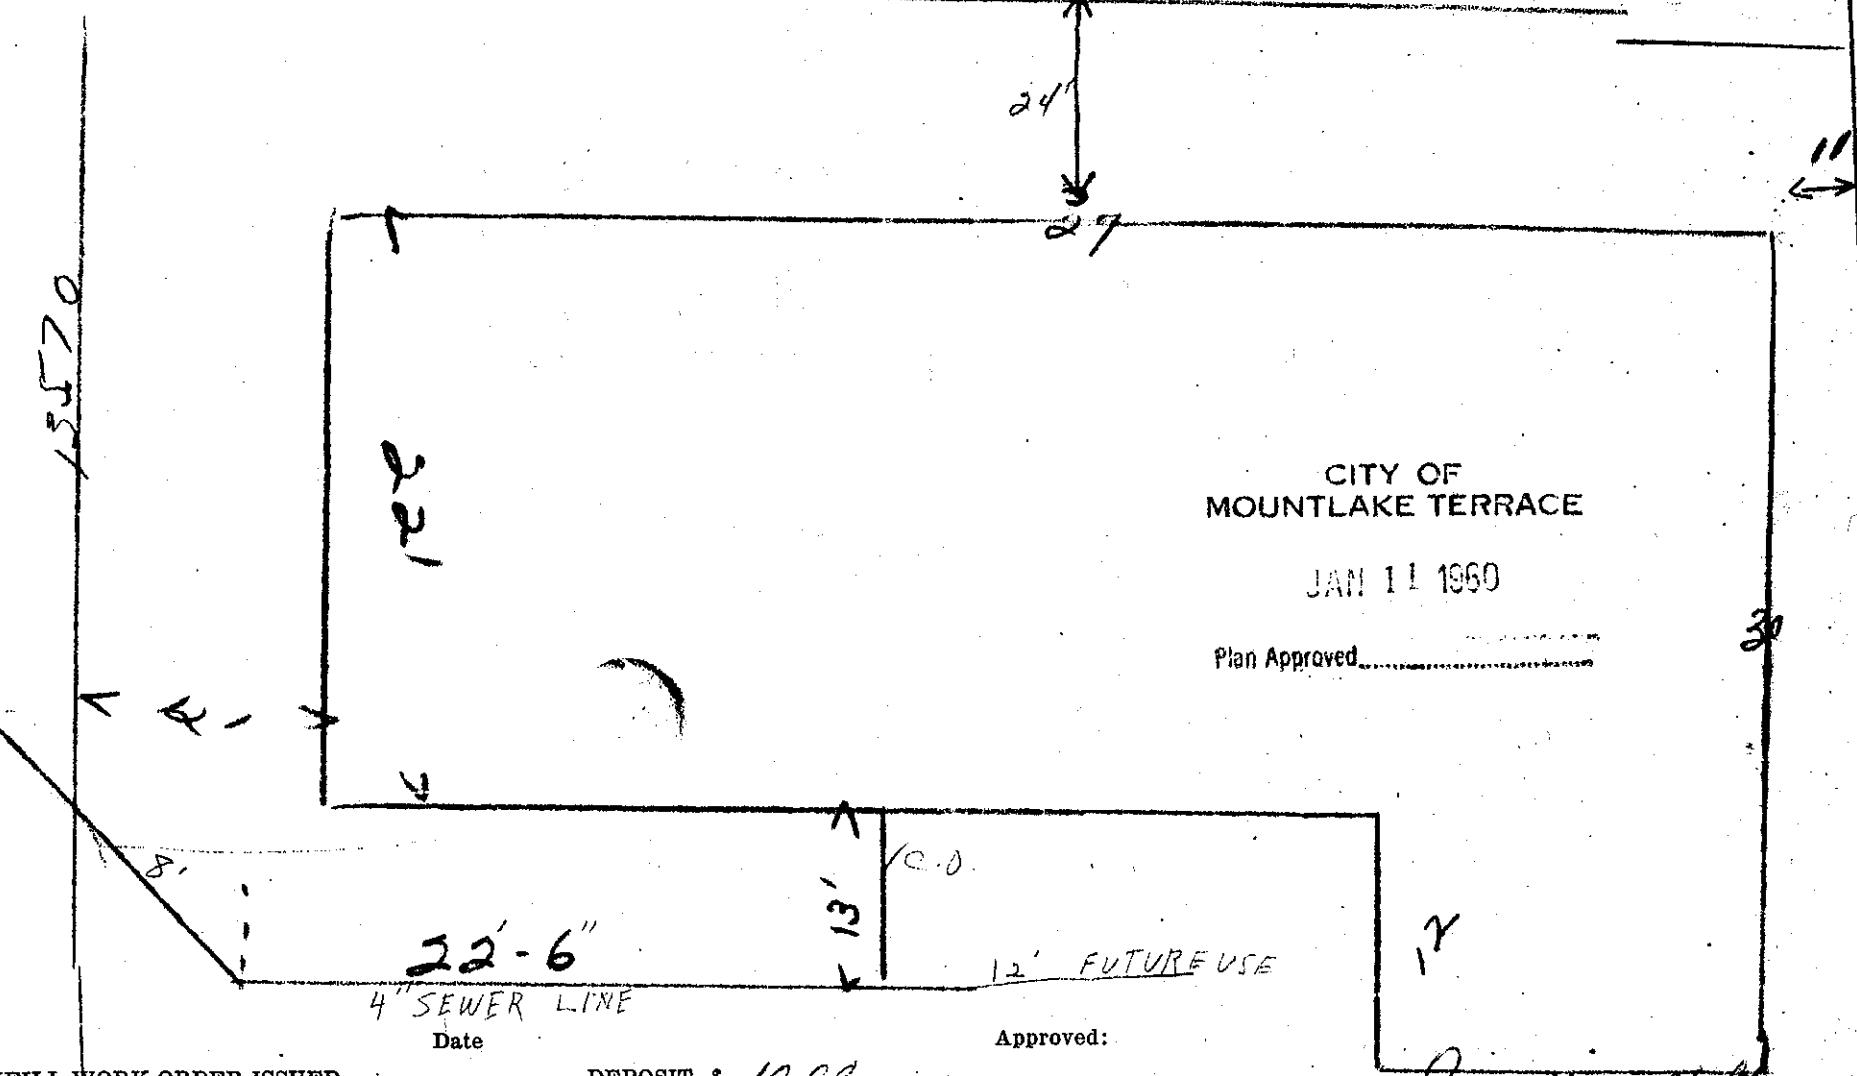

CITY OF
MOUNTLAKE TERRACE

JAN 11 1960

Plan Approved

BACKFILL WORK ORDER ISSUED

SEWER WORK ORDER ISSUED

DEPOSIT, \$ 10.00

100.00 5182 04

DATE 1-11-60

BY

Scott M Holton Mst
CON.

The City of Mountlake Terrace

APPLICATION

EARL DUBOIS

for
SIDE SEWER PERMIT

CARD No.

OUTSIDE INSIDE REPAIRS

EASEMENT No. none

OWNER Earl Dubois
HOUSE No. 23803 - 54th Ave.



CONTRACTOR A. Thomas Const. Co. PERMIT NO. 903

STREET
AVENUE LOT NO. 2

BLOCK No. 1

NAME ADD Lind Street

lat 60'

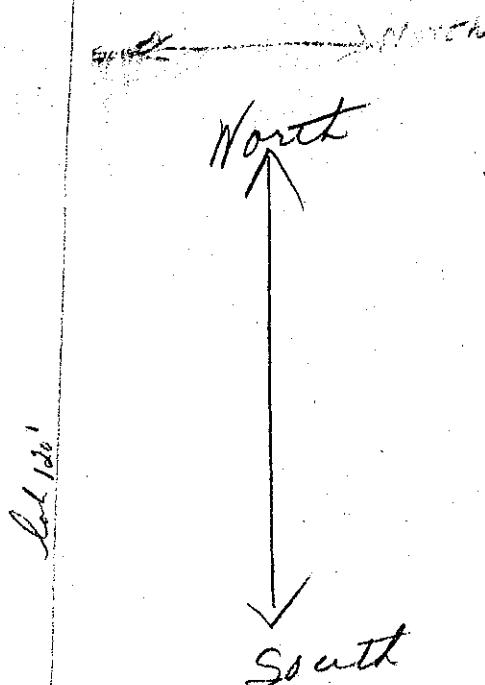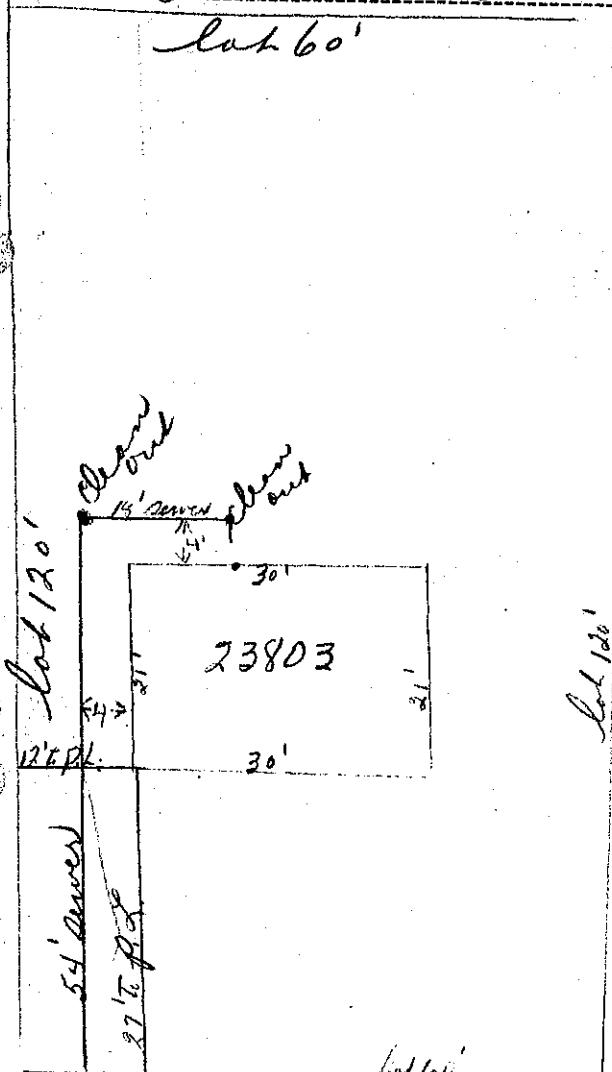

CITY OF
MOUNTLAKE TERRACE

SEP 25 1959

Plan Approved

J. Faucher

BACKFILL WORK ORDER ISSUED
SEWER WORK ORDER ISSUED

Date

DEPOSIT, \$

10⁰⁰ 9/25/59

Approved:

#4982

DATE 9-25-59 BY Scott m Holtor 115

17-31-59 INC-LAW David

Nr

The City of Mountlake Terrace

APPLICATION

for

SIDE SEWER PERMIT

OUTSIDE INSIDE REPAIRS

CARD No.

EASEMENT NO. 1346404


OWNER

Julius W. Martin
23804 W. 54.

HOUSE NO.

→ NORTH

lot 65'

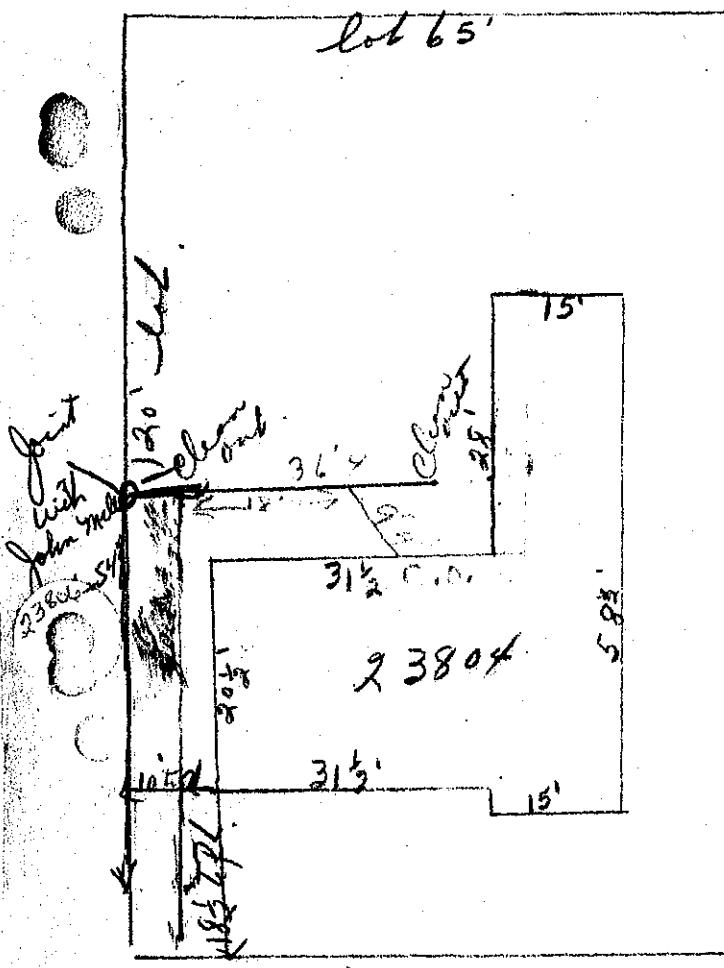

W 54

Date

BACKFILL WORK ORDER ISSUED

SEWER WORK ORDER ISSUED

Approved:
8/28/59

DEPOSIT, \$10⁰⁰ DATE 8/28/59 BY Scott M Holton N.C.
3943 INSP. +

12-31-59 INSTANT EXCEPT BASEMENT & M.R.

CONTRACTOR

DeMossia Conct Co
STREET
AVENUE LOT NO. 39

PERMIT NO. 35

BLOCK NO. 1

NAME ADD

Replot of Lind Tract, according
to plat thereof recorded in volume
13 of plats, page 21, recorded
said County.

CITY OF
MOUNTLAKE TERRACE
AUG 28 1959

Plan Approved

J. Fairless

The City of Mountlake Terrace

APPLICATION

for

SIDE SEWER PERMIT

OUTSIDE INSIDE REPAIRS

R. H. Olson
CARD NO.

EASEMENT No. 1351643

OWNER Russell H. Olson
HOUSE No. 23805 - W. 5th St


CONTRACTOR

STREET
AVENUE LOT No. 3

BLOCK No. 2

NAME ADD Lind Tracts

PERMIT No. 2150

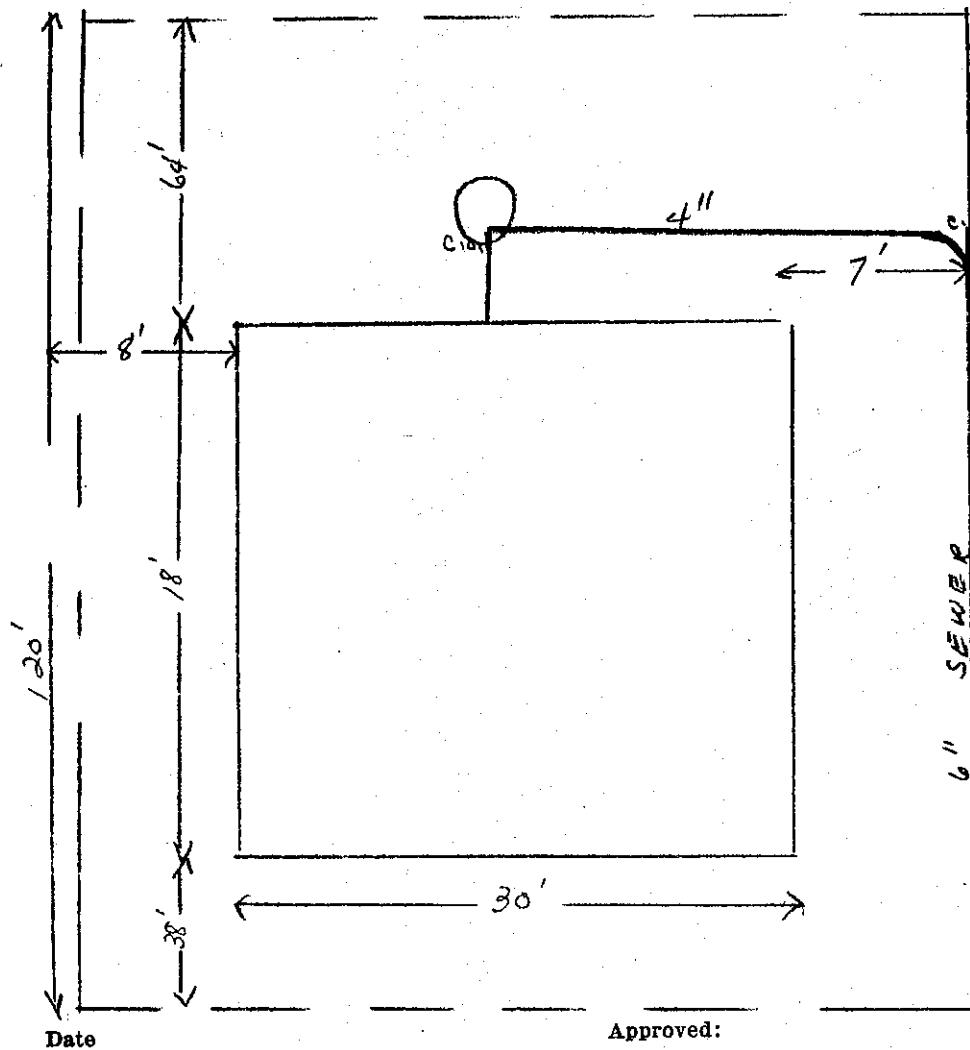

BACKFILL WORK ORDER ISSUED

DEPOSIT, \$

SEWER WORK ORDER ISSUED

DATE 4/9/60 BY

J. Fairner

CITY OF
MOUNTLAKE TERRACE

MAR 25 1960

Plan Approved

J. Fairner

The City of Mountlake Terrace

APPLICATION

for

SIDE SEWER PERMIT

OUTSIDE INSIDE REPAIRS

CARD NO.

EASEMENT No. 1346404

John L. Mills

OWNER John L. Mills
HOUSE NO. 23806 W. 54th

CONTRACTOR

STREET

AVENUE LOT NO. 38

BLOCK NO.


PERMIT NO. 36

NAME ADD.

De Novas Const. Co.
Replat on Lind Tracts
according to Plat thereof recorded
in volume 13 of plat, page
31, records of said County.

Lot 65'

→ North.

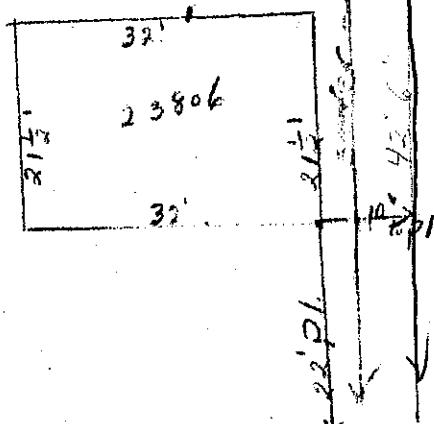

130
Laf

54 W

CITY OF
MOUNTLAKE TERRACE

AUG 28 1959

Plan Approved

J. Falmer

Date

Approved:

INSPT

BACKFILL WORK ORDER ISSUED

DEPOSIT, \$ 10 526.59

SEWER WORK ORDER ISSUED

*3944

DATE 8/28/59

BY Scott M. Holtby N.C.

The City of Mountlake Terrace

APPLICATION

for

SIDE SEWER PERMIT

OUTSIDE INSIDE REPAIRS

CARD No.

EASEMENT No.

125-1643

R.D. Biggs
PERMIT NO. 2151

OWNER Rodney J. Briggs
HOUSE No. 23807 - 52nd West

CONTRACTOR


STREET
AVENUE LOT No.

4

BLOCK No.

NAME ADD.

Lind Tract

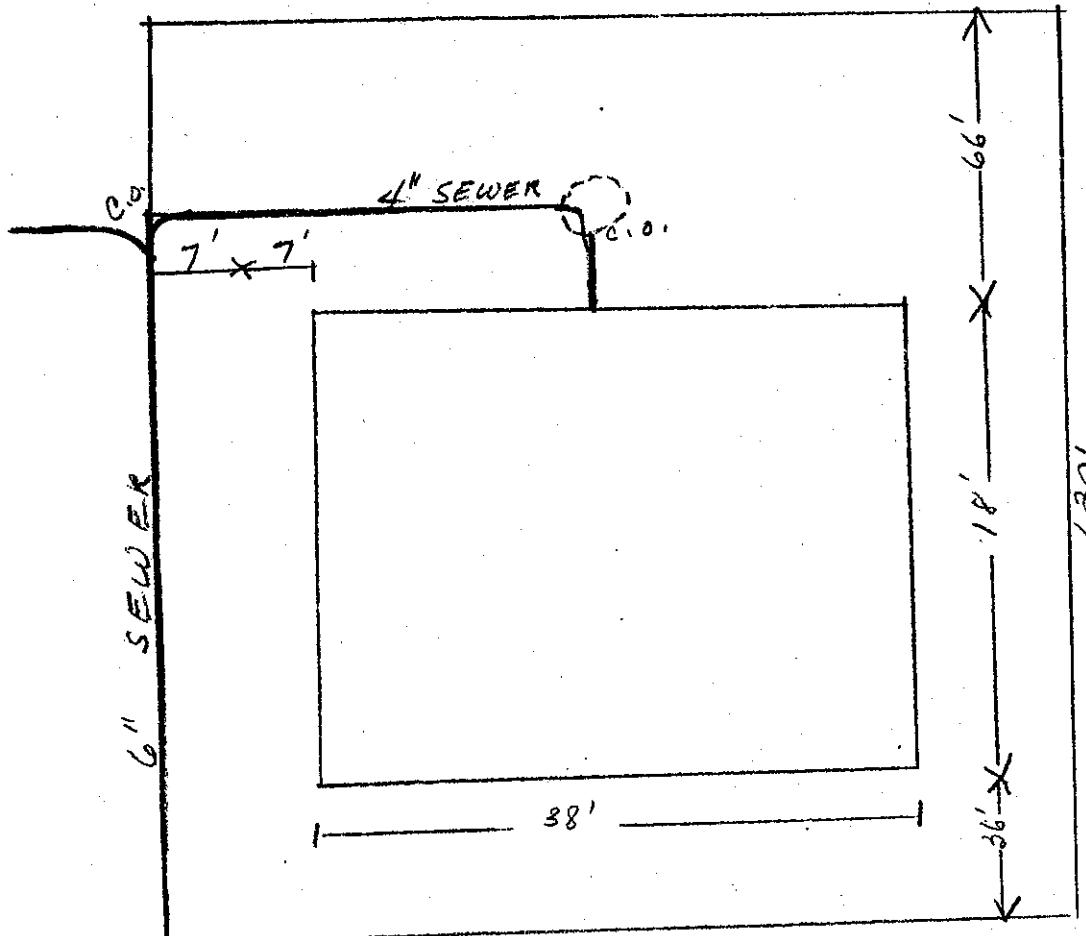

Date

Approved:

BACKFILL WORK ORDER ISSUED

DEPOSIT, \$

SEWER WORK ORDER ISSUED

DATE

1/4/60

BY

R. D. Biggs

The City of Mountlake Terrace

APPLICATION

for

SIDE SEWER PERMIT

OUTSIDE INSIDE REPAIRS

CARD No.

EASEMENT No. 1344646

OWNER William Reid
HOUSE No. 23808 - 54th W.

CONTRACTOR T & M Const. PERMIT No. 816


STREET 37
AVENUE LOT NO.

BLOCK No. 1

NAME ADD.

Replat of Land Tracts

→ N →

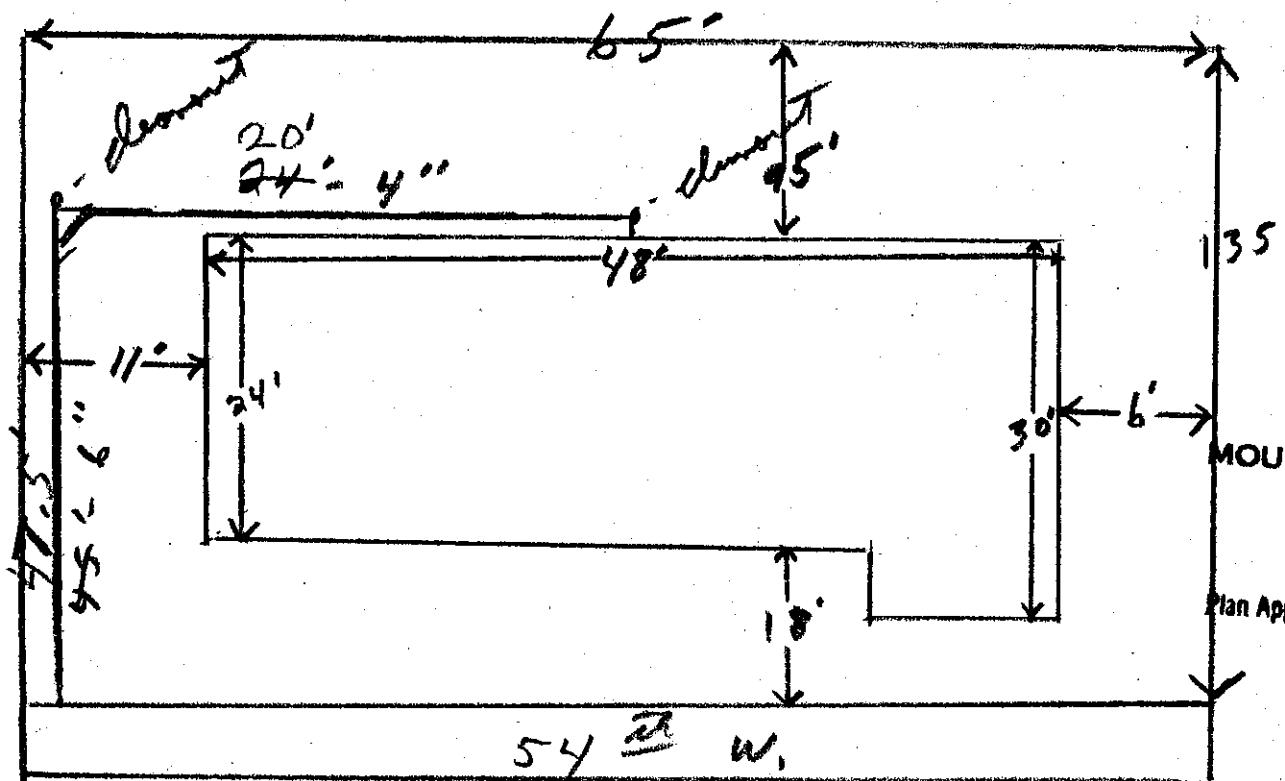

CITY OF
MOUNTLAKE TERRACE

SEP 11 1959

Plan Approved.

J. H. J.

Date

Approved:

CKFILL WORK ORDER ISSUED

DEPOSIT, \$10⁰⁰ 9-10-59

SP. WORK ORDER ISSUED

DATE

9-11-59 BY Scott M Holton INS.
N.C.

The City of Mountlake Terrace

APPLICATION

for

SIDE SEWER PERMIT

OUTSIDE INSIDE REPAIRS

CARD No.

EASEMENT No. 1362754

OWNER

R. K. Young
23809 54 W

HOUSE No.

CONTRACTOR

STREET
AVENUE LOT No.

NAME ADD.

PERMIT No. 1924

5.

BLOCK No. 2

61"

70'

C.O.R.

46'

4"

sewer line

10'

70'

4"

sewer line


6" sewer line
45'

CITY OF
MOUNTLAKE TERRACE

MAR 10 1960

Plan Approved

J. Fairman
SM
1/24

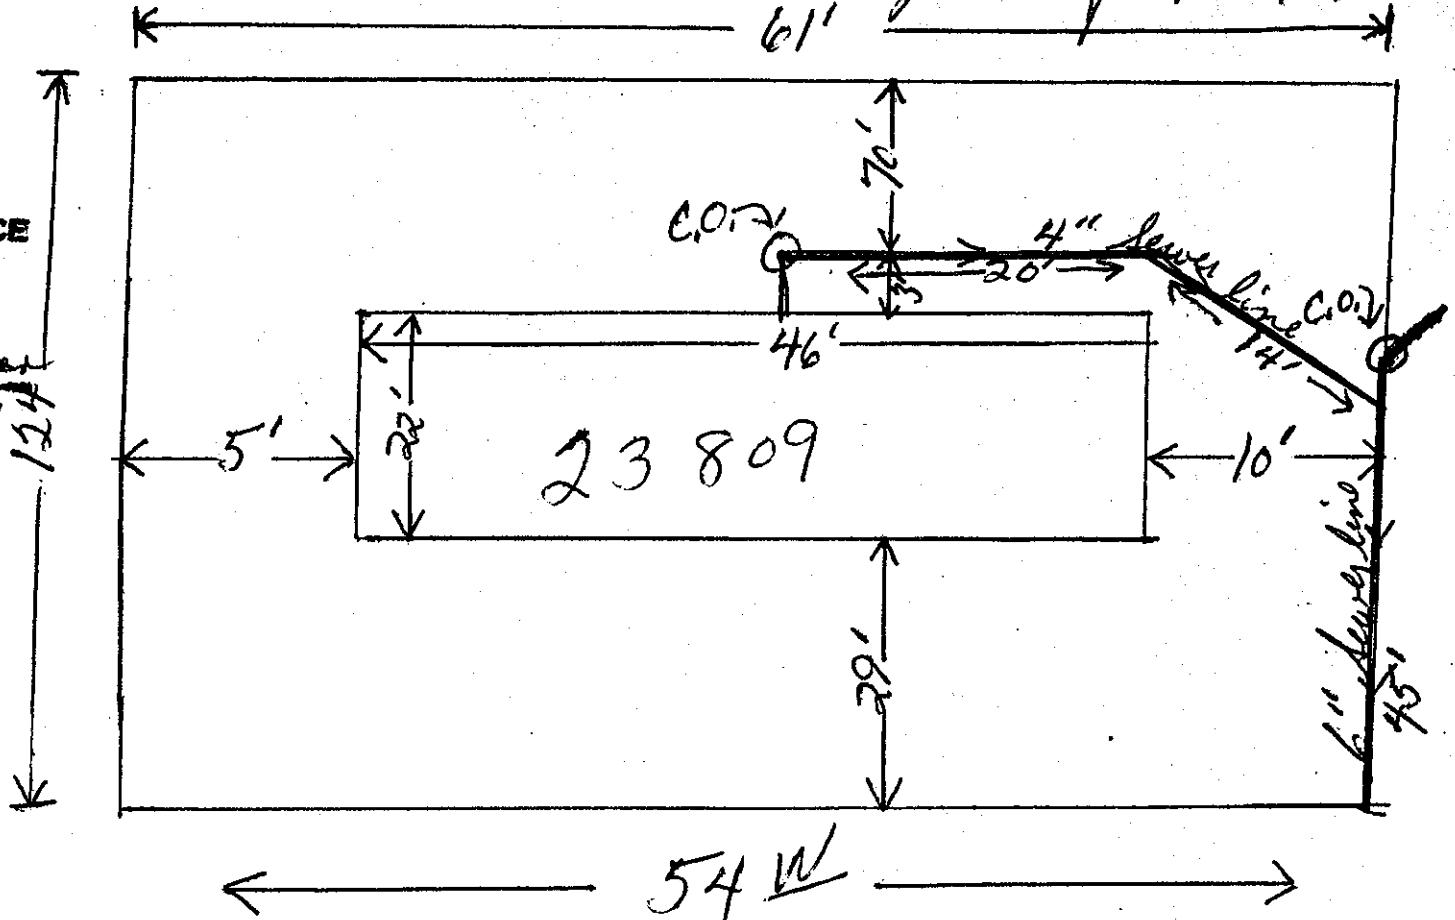

Date

BACKFILL WORK ORDER ISSUED,

SEWER WORK ORDER ISSUED.

DEPOSIT, \$ 10.00

5/10/60

774

Approved:

DATE 3-11-60

BY Scotton Holton Inscon

The City of Mountlake Terrace

APPLICATION

for

SIDE SEWER PERMIT

OUTSIDE INSIDE REPAIRS

CARD NO.

EASEMENT No. 1344646

OWNER Don D. Mason
HOUSE No. 23810 - 54 1/2 W.

CONTRACTOR

STREET
AVENUE LOT NO.

NAME ADD.


7 1/2 W. Front.

PERMIT NO.

817

BLOCK NO.

Replat of Land Tracts

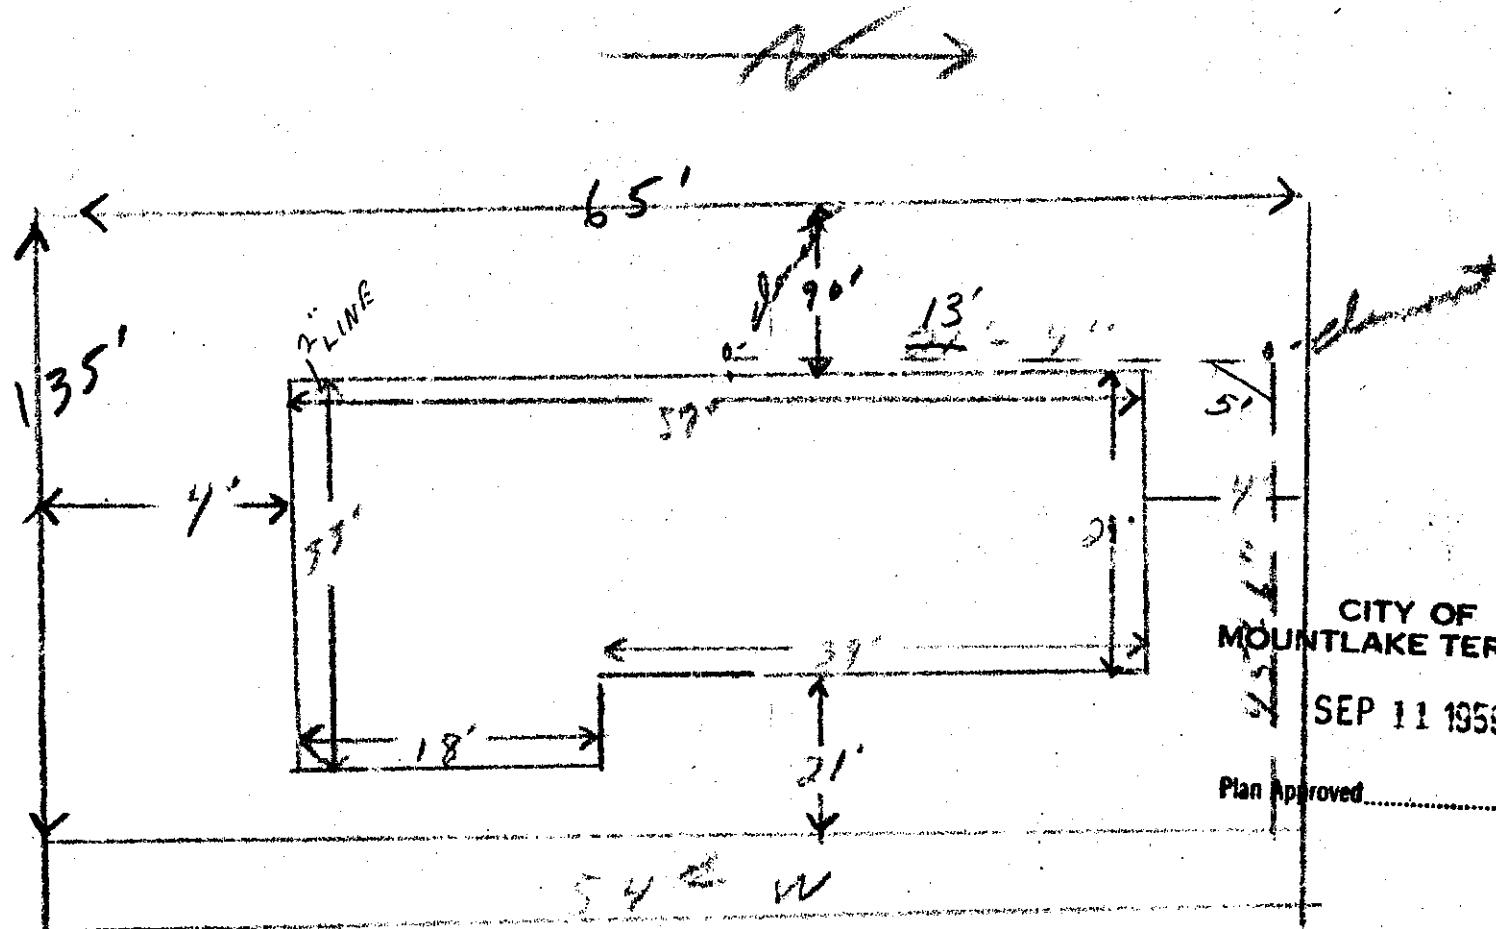

CITY OF
MOUNTLAKE TERRACE

SEP 11 1959

Plan Approved

Date

Approved:

BACKFILL WORK ORDER ISSUED

DEPOSIT, \$10⁰⁰ 9-10-59

SEWER WORK ORDER ISSUED

DATE

9-11-59 BY Scott M Holton INS.
2-19-68 INC. I. M. H. N.C.

The City of Mountlake Terrace

APPLICATION

for
SIDE SEWER PERMIT

OUTSIDE INSIDE REPAIRS

J. G. Dominick
CARD No.

EASEMENT No. 1362754

OWNER

J. G. Dominick
23901 54 W

CONTRACTOR

Rainer Const.

PERMIT No. 1925

HOUSE No.

STREET
AVENUE LOT NO.

BLOCK NO.

NAME ADD.


Laylat of Lind Trust

CITY OF
MOUNTLAKE TERRACE

MAR 10 1960

Plan Approved

J. Faulmer
SMY

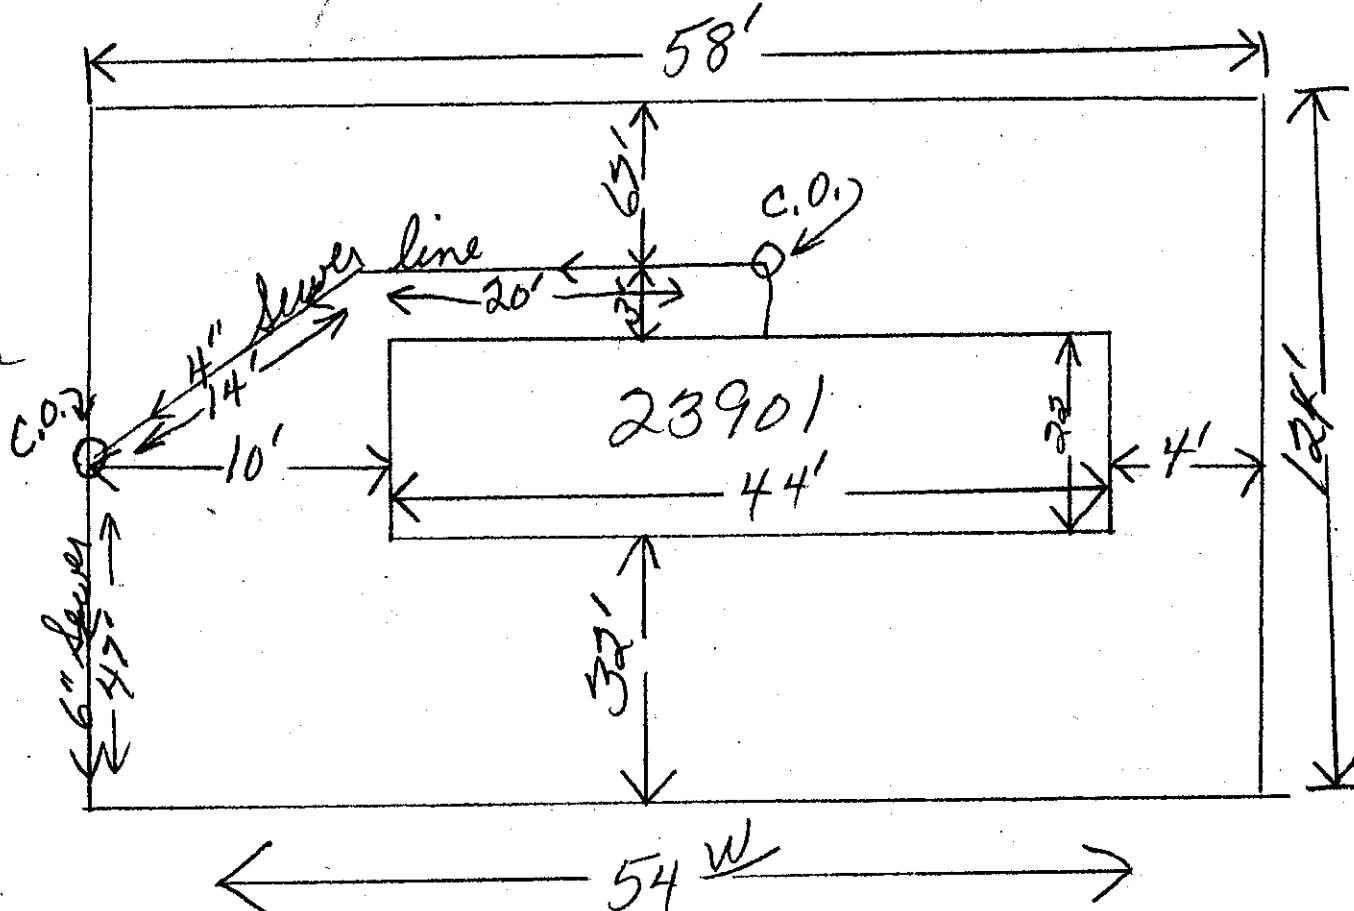

Date

Approved:

BACKFILL WORK ORDER ISSUED

DEPOSIT, \$

10.00

SEWER WORK ORDER ISSUED

3/10/60
774

DATE

3-11-60

BY

Scott M Holton/NSCO

The City of Mountlake Terrace

APPLICATION

10

SIDE SEWER PERMIT

OUTSIDE **INSIDE** **REPAIRS**

CARD No.

BASEMENT NO. 13-64160

OWNER: MURIEL WEST

CONTRACTOR S. A. M.

PERMIT No. 987


HOUSE No. 23903-54⁴ W

**STREET
AVENUE LOT NO.**

BLOCK N

NAME AP

No. 7 BLOCK N.
Reptiles of Linn County

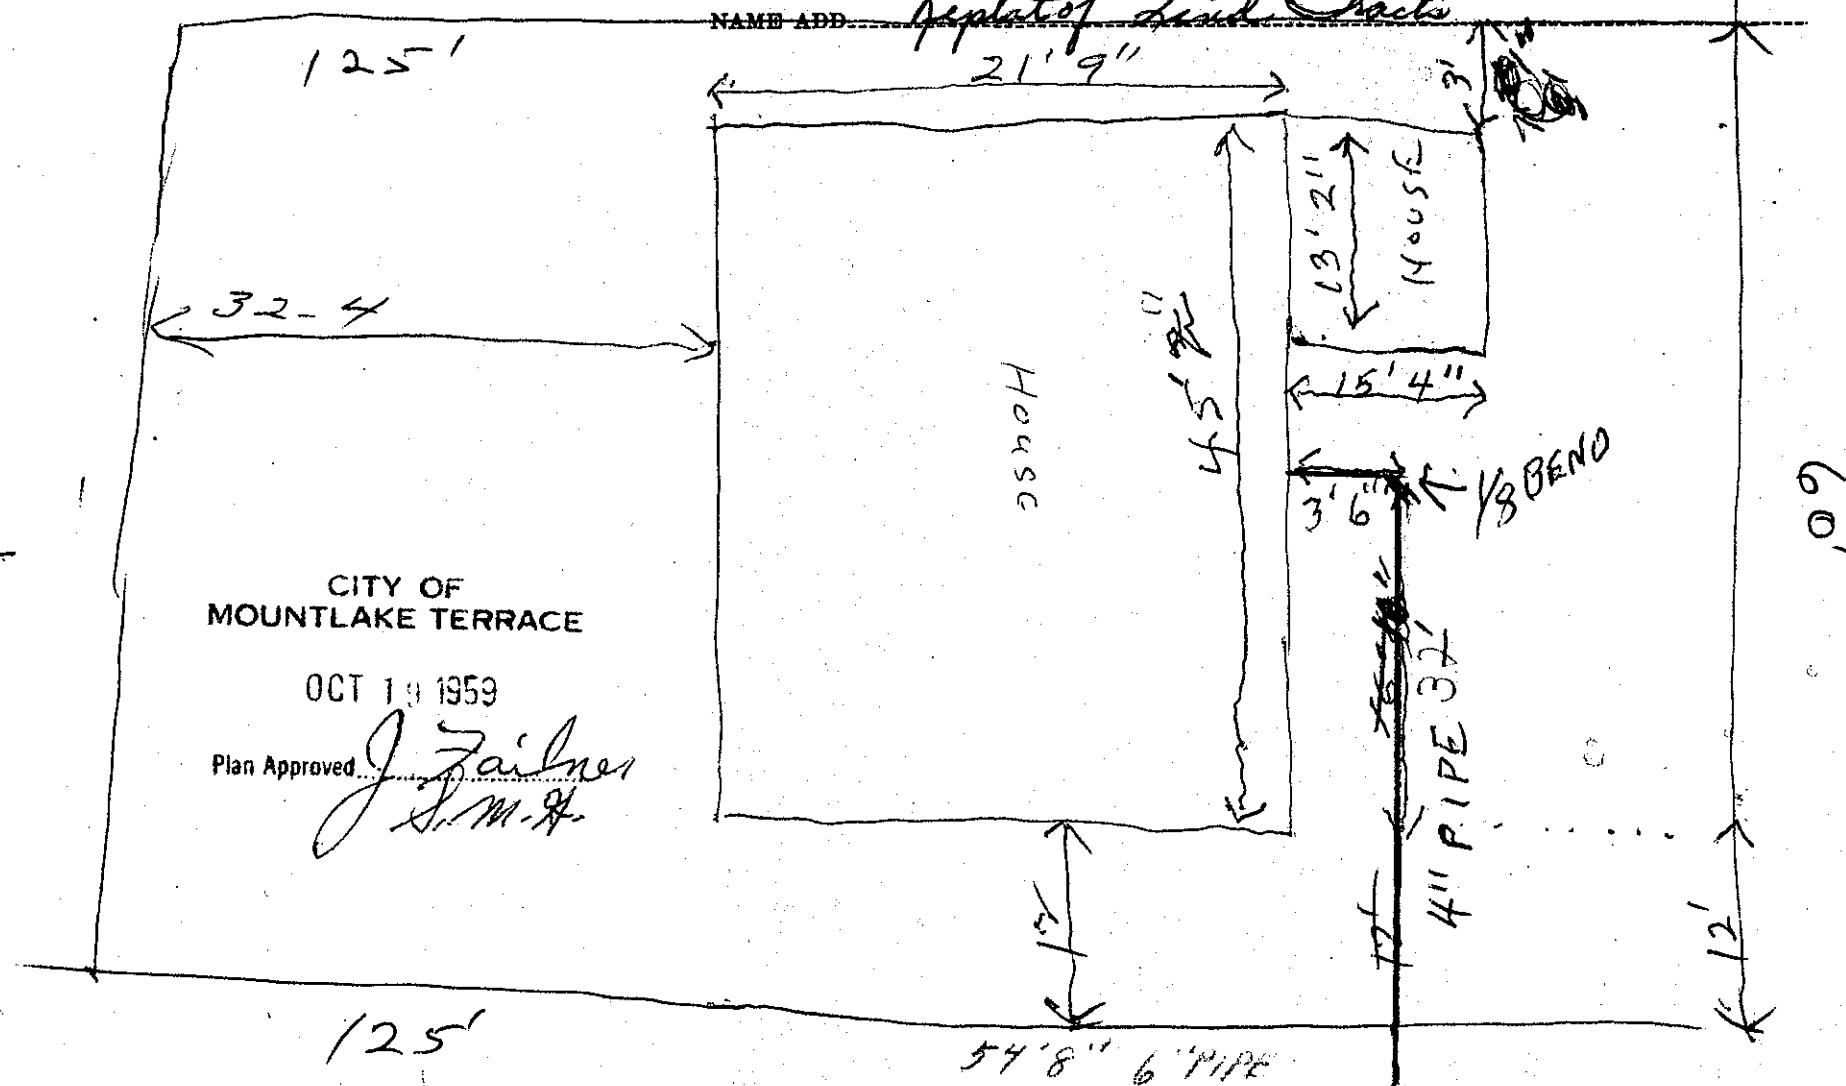

Date

Approved

BACKFILL WORK ORDER ISSUED

DEPOSIT \$10.00

10-1559

SEWER WORK ORDER ISSUED

PAGE 18-195

8

5

The City of Mountlake Terrace

APPENDIX

SIDE SEWER PERMIT

OUTSIDE **INSIDE** **REPAIRS**

H. A. W.

CARD NO.

CARD NO. _____
*(used only for convenience - not
EASEMENT NO. 1385957 Janus)*

OWNER Howard a Wood

CONTRACTOR *Selby*

PERMIT No. 1804

HOUSE No. 23804 54th WEST


STREET

AVENUE LOT No. 34

BLOCK N

REPRINT of LIND
TRACE

~~PROPERTY LINE~~ ^{REPLNT} NAME ADD. LIND TRACTS

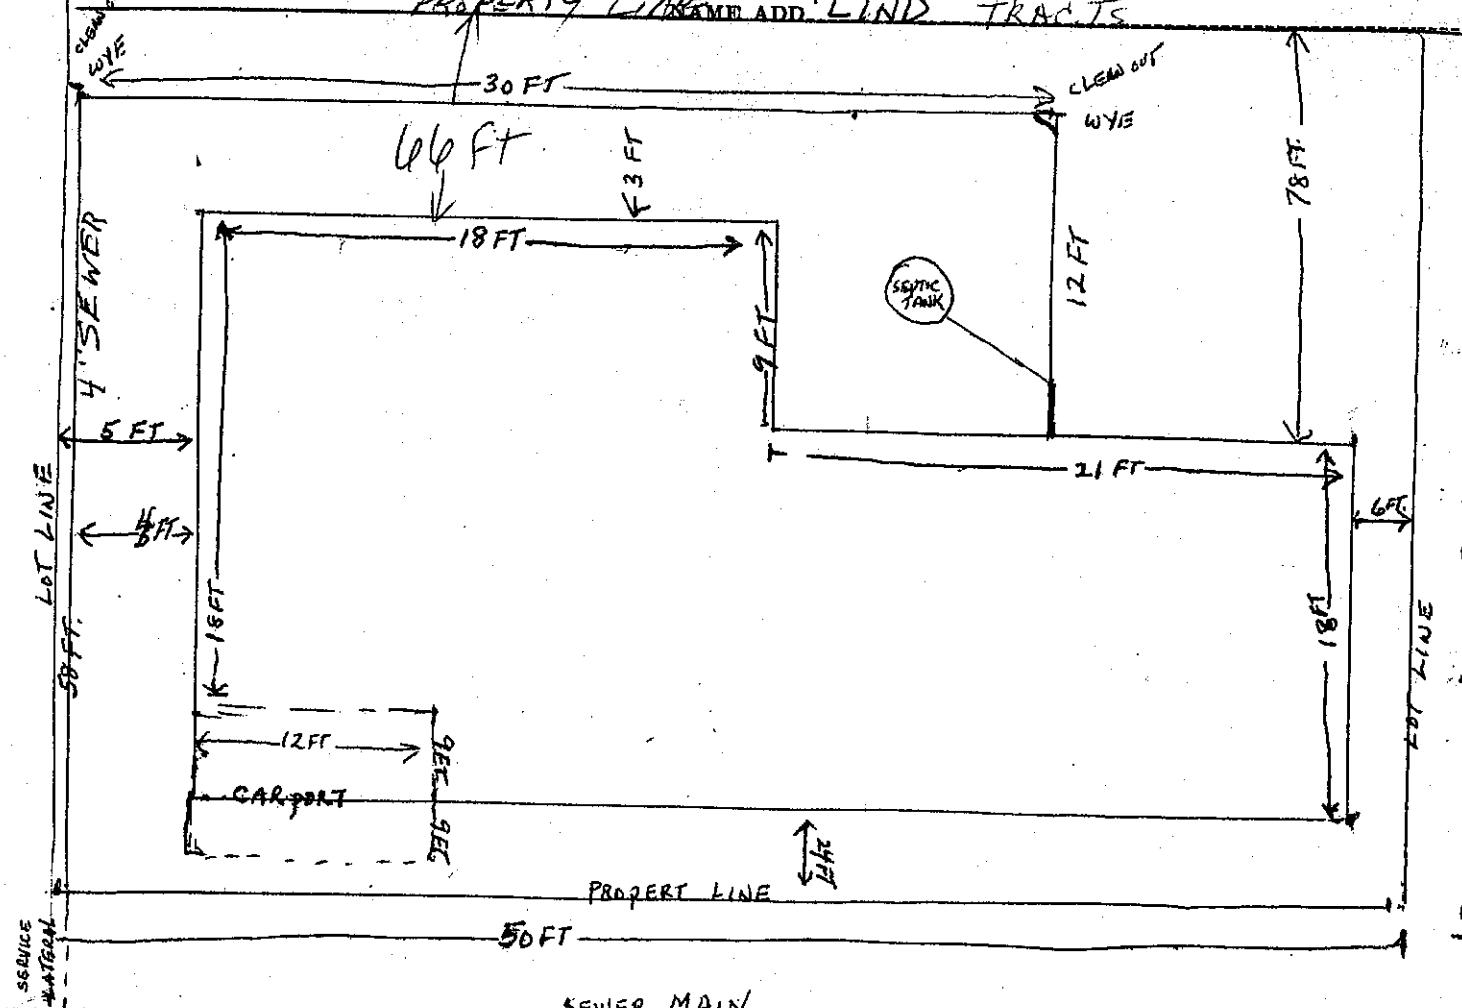

**CITY OF
OUNTLAKE VILLAGE**

MAR 1 1960

**BACKFILL WORK ORDER ISSUED
SEWER WORK ORDER ISSUED**

Date

DEPOSIT, \$10.00

Approved:

DATE 9/33/66

三四

The City of Mountlake Terrace

APPLICATION

FOR

SIDE SEWER PERMIT

OUTSIDE INSIDE REPAIRS

JOB FINISHED BY WINGFIELD

OWNER DARRELL E. WOOD
HOUSE No. 23905, 54, W.

6-7418

D.A.

CARD NO.

EASEMENT NO.

1364160 ✓

CONTRACTOR S.A.M.F.

PERMIT NO. 988

STREET
AVENUE LOT NO.

8

BLOCK NO.


NAME ADD.

1802847

20'

BACK LINE
BAG LINE

PROPERTY LINE

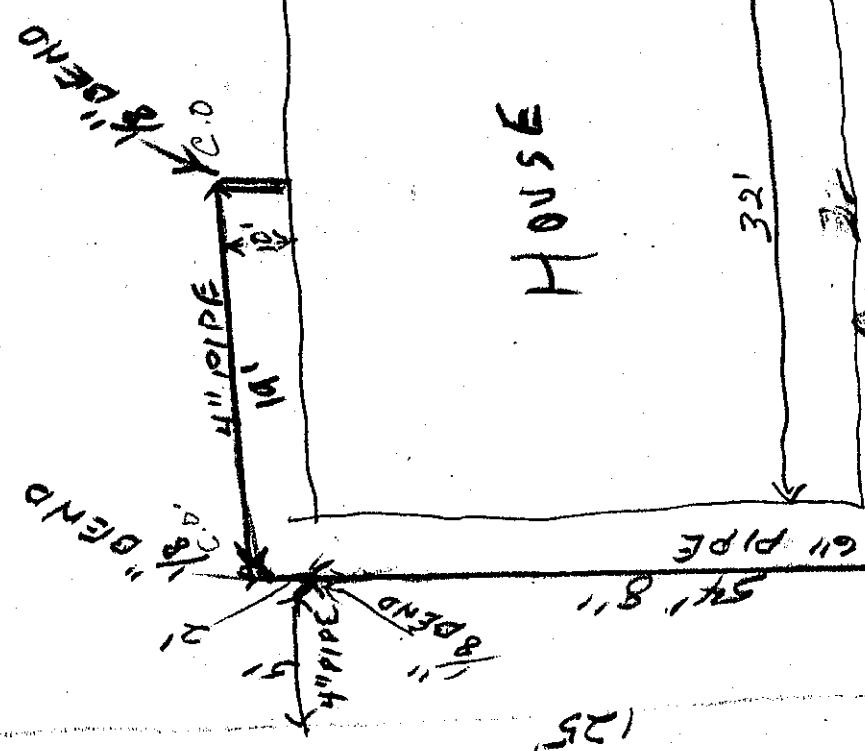

Plan Approved

Date

Approved:

BACKFILL WORK ORDER ISSUED
SEWER WORK ORDER ISSUED

DEPOSIT \$10⁰⁰ 10-15-59

5/79

DATE 16-19-59 BY Scott M Holton INS
8-29-60 INST CON S.M.H. N.C.

LIND TRAC
LOT 33

LIND ACT
LOT 32

23908 - 54TH AVE. W.

23906 - 54TH AVE. W.

LOT LINE 135.6'

LOT LINE 135.6'

LOT LINE 135.6'

LOT LINE 135.6'

PROPERTY LINE
60' (54" ACTUAL)

PROPERTY LINE
54"

27.6'

20'

26'

27.6'

20'

26'

27.6'

The City of Mountlake Terrace

APPLICATION

for

SIDE SEWER PERMIT

OUTSIDE INSIDE REPAIRS

CARD No.

EASEMENT No. 1356286

OWNER Merrill Anderson

HOUSE NO. 23907 - 54th W.

CONTRACTOR Wingfield - Brown

PERMIT No. 2204

STREET
AVENUE LOT NO. 9

BLOCK No. 2

NAME ADD.


Div. # 13

CITY OF
MOUNTLAKE TERRACE

MAR 29 1960

Plan Approved

J. Fairman

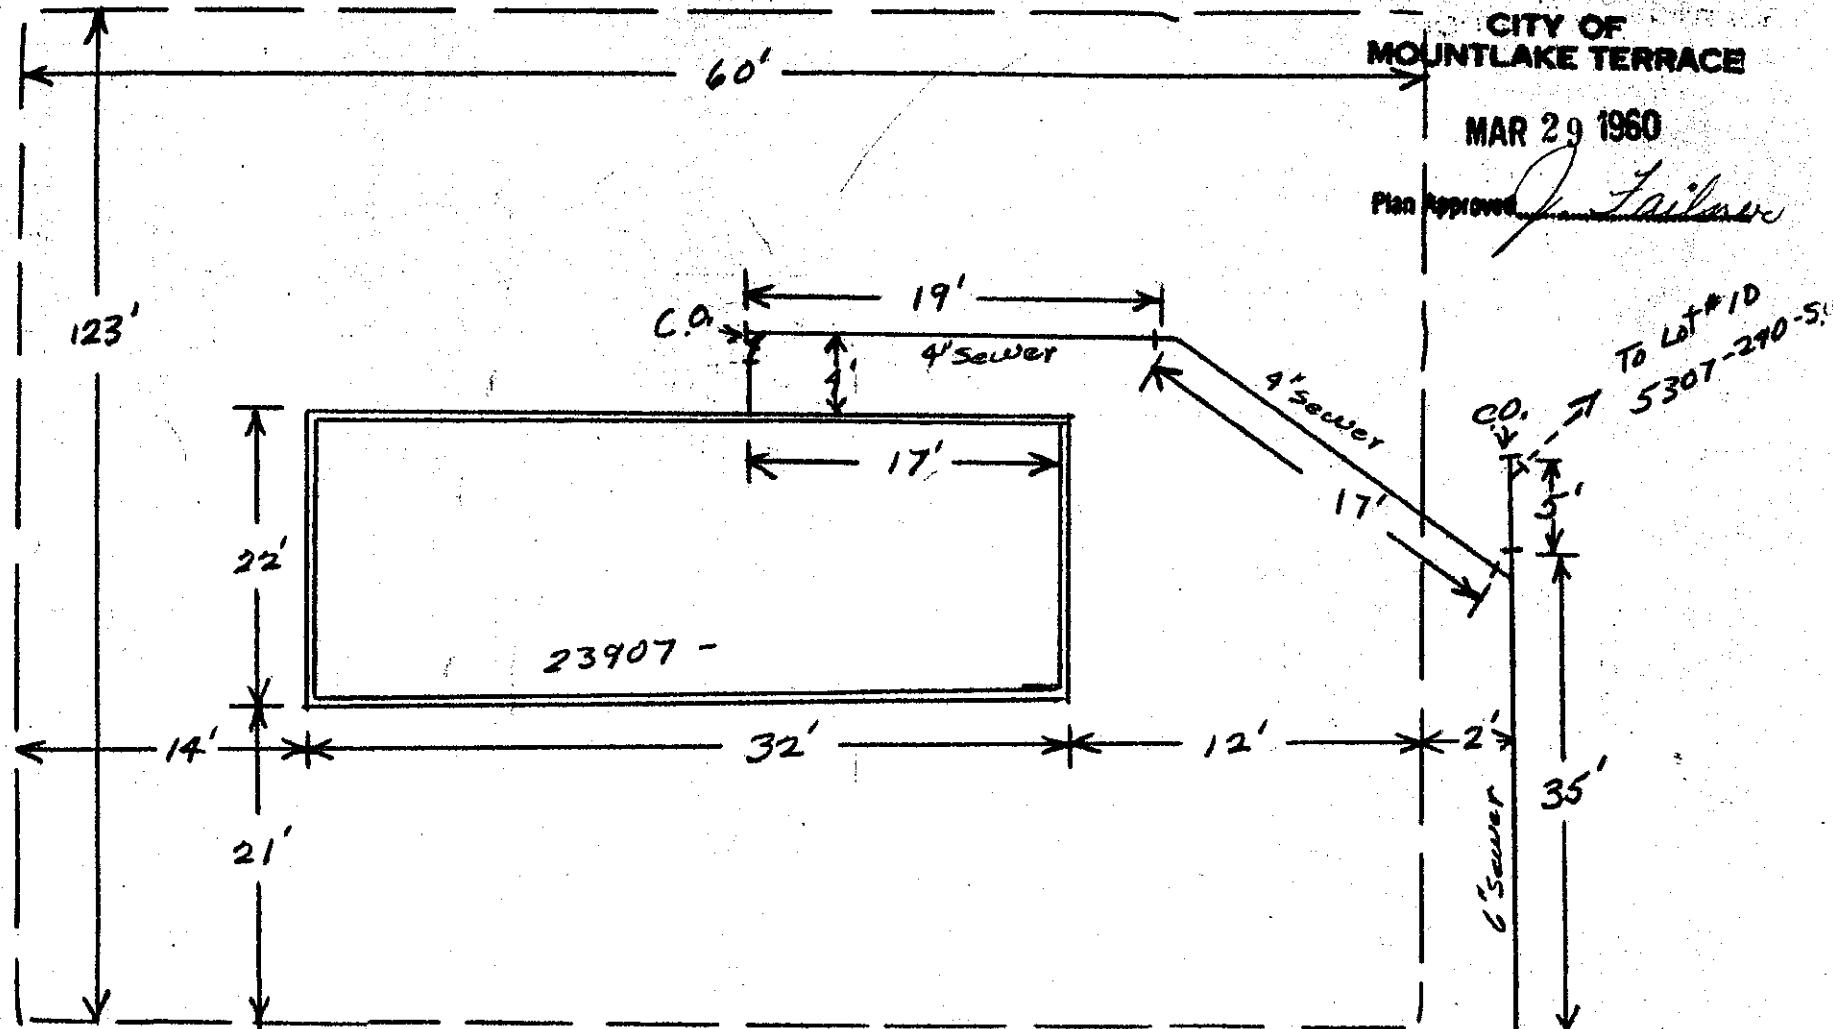

Date

Approved:

54th W E Lot Line

BACKFILL WORK ORDER ISSUED

DEPOSIT, \$10.00 3/26/60

SEWER WORK ORDER ISSUED

1015

DATE

3/29/60 BY J. Fairman

APPLICATION

for

SIDE SEWER PERMIT

The City of Mountlake Terrace

CARD No. _____

OUTSIDE INSIDE REPAIRS

EASEMENT No. _____

OWNER _____

CONTRACTOR _____

PERMIT No. _____

HOUSE No. _____

24005 - 54 AV. W.


STREET
AVENUE LOT No. _____

BLOCK No. _____

NAME ADD _____

240 ST. S.W.

54 AV. W.

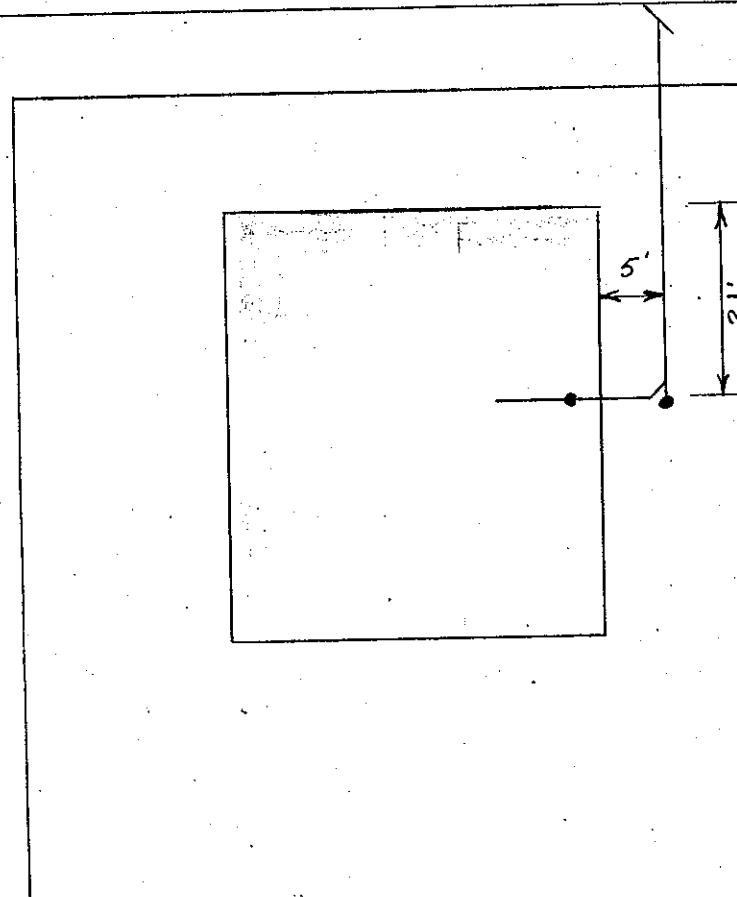

Date _____

Approved:

DATE

BACKFILL WORK ORDER ISSUED _____

DEPOSIT, \$ _____

SEWER WORK ORDER ISSUED _____

10/79

BY

M. Gonzales

The City of Mountlake Terrace

APPLICATION

for

SIDE SEWER PERMIT

OUTSIDE INSIDE REPAIRS

CARD No. _____

EASEMENT No. _____

OWNER WILLIAM TURY, JR.
HOUSE NO. 24009 54TH W/


CONTRACTOR _____

PERMIT No. 41-3-73

STREET
AVENUE LOT NO. _____

BLOCK No. _____

NAME ADD

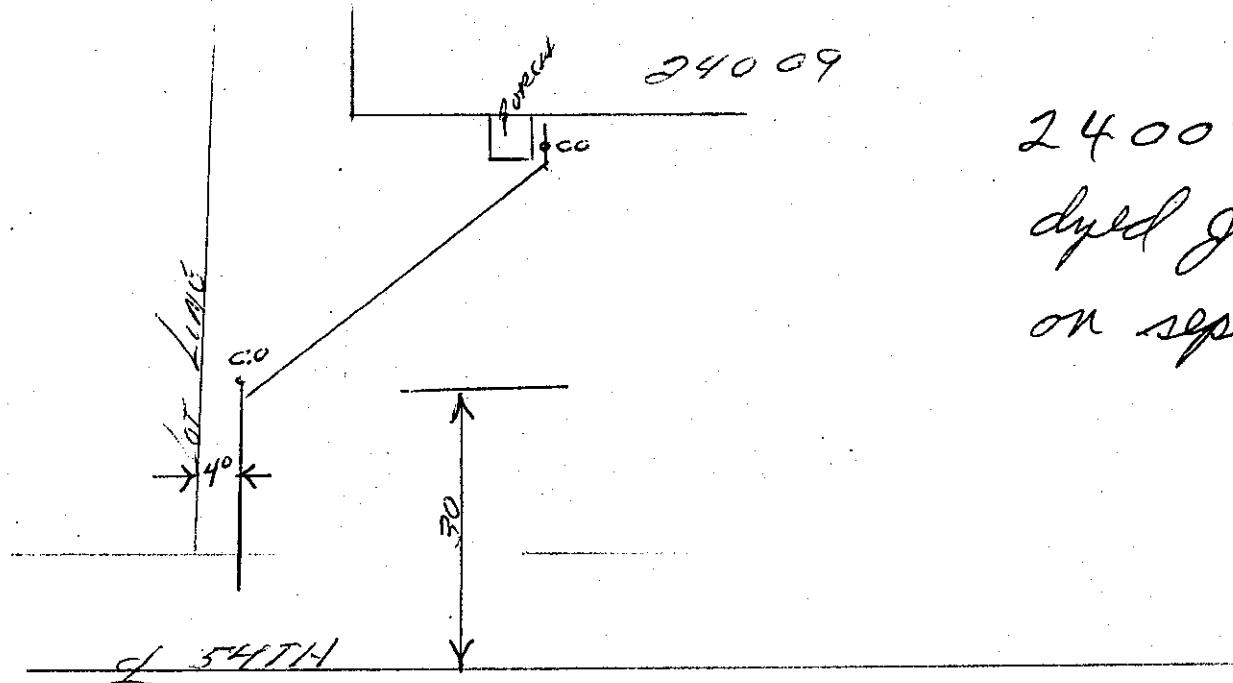

24007-54
dyed July 1991
on septic

Date

Approved:

BACKFILL WORK ORDER ISSUED _____

DEPOSIT, \$ _____

SEWER WORK ORDER ISSUED _____

DATE _____ BY _____

APPLICATION

for

SIDE SEWER PERMIT

OUTSIDE INSIDE REPAIRS


CARD No. _____

The City of Mountlake Terrace

EASEMENT No. NONEOWNER ROBERT J. JAKLEWICZCONTRACTOR RUSS JOHNSONPERMIT NO. U-26-82HOUSE No. 24016 54th W.STREET
AVENUE LOT No. _____

BLOCK No. _____

NAME ADD

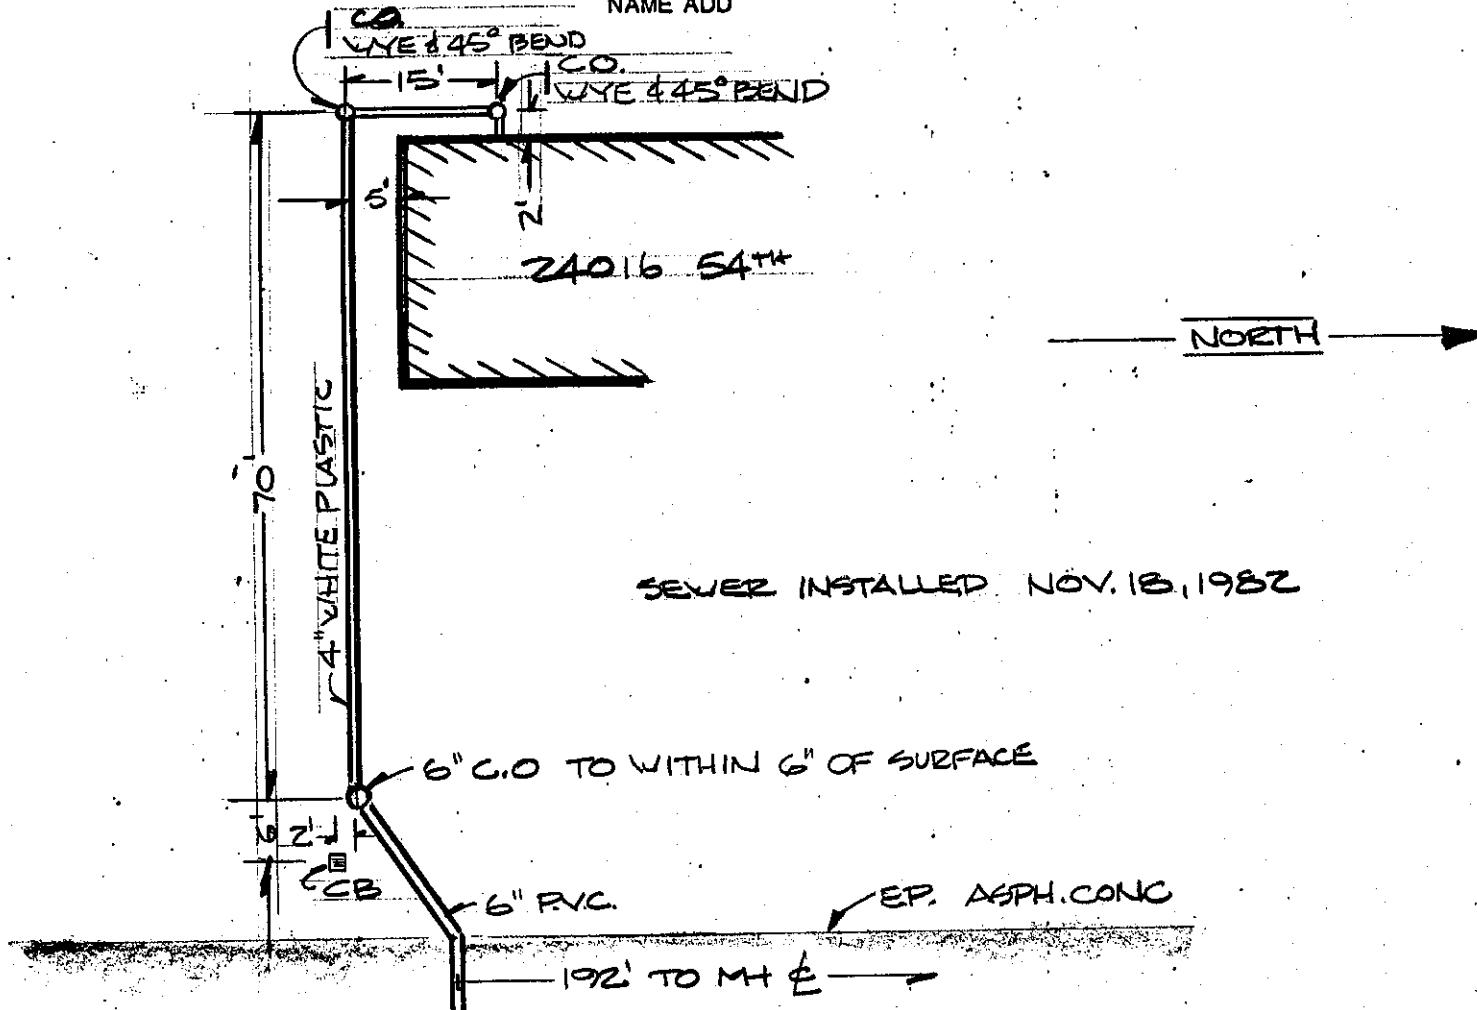

SEWER INSTALLED NOV. 18, 1982

Date

DEPOSIT, \$

AS BUILT INFO BY JOHN LYEN
FOR STAN QUAKE INSPECTOR
Approved: DRAWN BY WILL VANTRY
FOR STAN QUAKE

The City of Mountlake Terrace

SIDE SEWER / ILT

OUTSIDE INSIDE REPAIRS

OWNER Asher Strola

HOUSE No. 24030



CONTRACTOR Russ Johnson

PERMIT NO. U-87-7

STREET
AVENUE LOT NO. 54th Ave W

BLOCK No.

NAME ADD _____

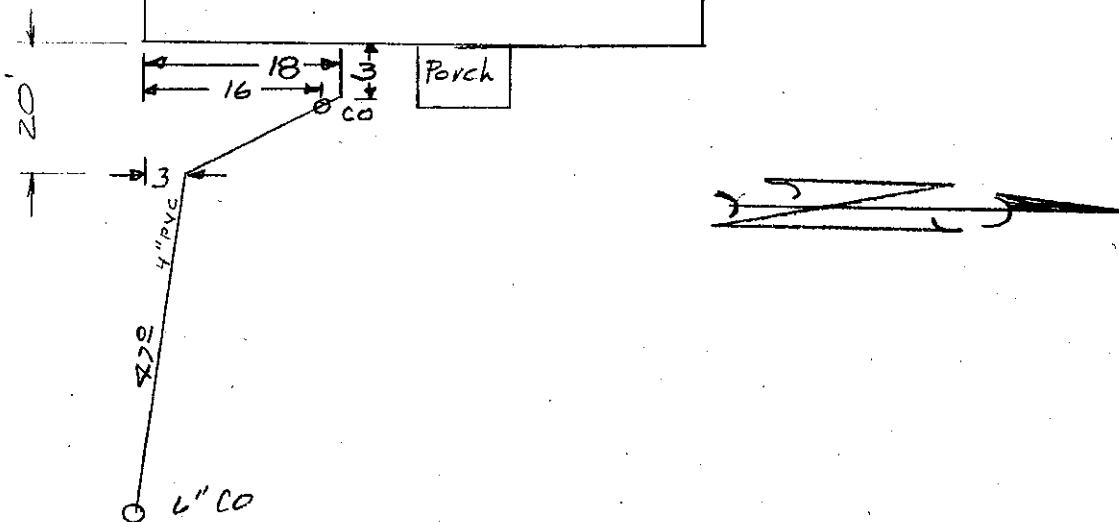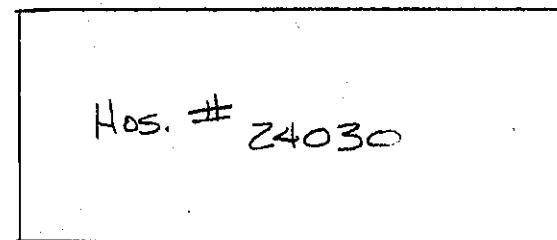

54th Ave West

SEWER WORK ORDER ISSUED Mar. 5, 87

BY Betty Williams FEE \$20⁰⁰ C.I.FEE _____

BACKFILL APPROVED

Mar. 10, 87

BY Ben Van Denee ASBILT Mar. 11, 87 BY BVD

The City of Mountlake Terrace

SIDE SEWER BILT

OUTSIDE INSIDE REPAIRS

OWNER FRANCES PICKERAL
HOUSE NO. 24110

CONTRACTOR DAVID ROSS / STRAIGHT LINE

STREET 54TH AV. W.
AVENUE LOT NO.

PERMIT NO. U-87-17

BLOCK NO.

NAME ADD.

24101-54
dyed July 1991
on sewer to 54th

NO SCALE

SEWER WORK ORDER ISSUED

8-20-87

BACKFILL APPROVED


8-21-87

BY B. WILLIAMS

BY B. VAN DERELD

FEE 20⁰⁰ C.I.FEE

ASBILT B. VAN DERELD BY V.F.

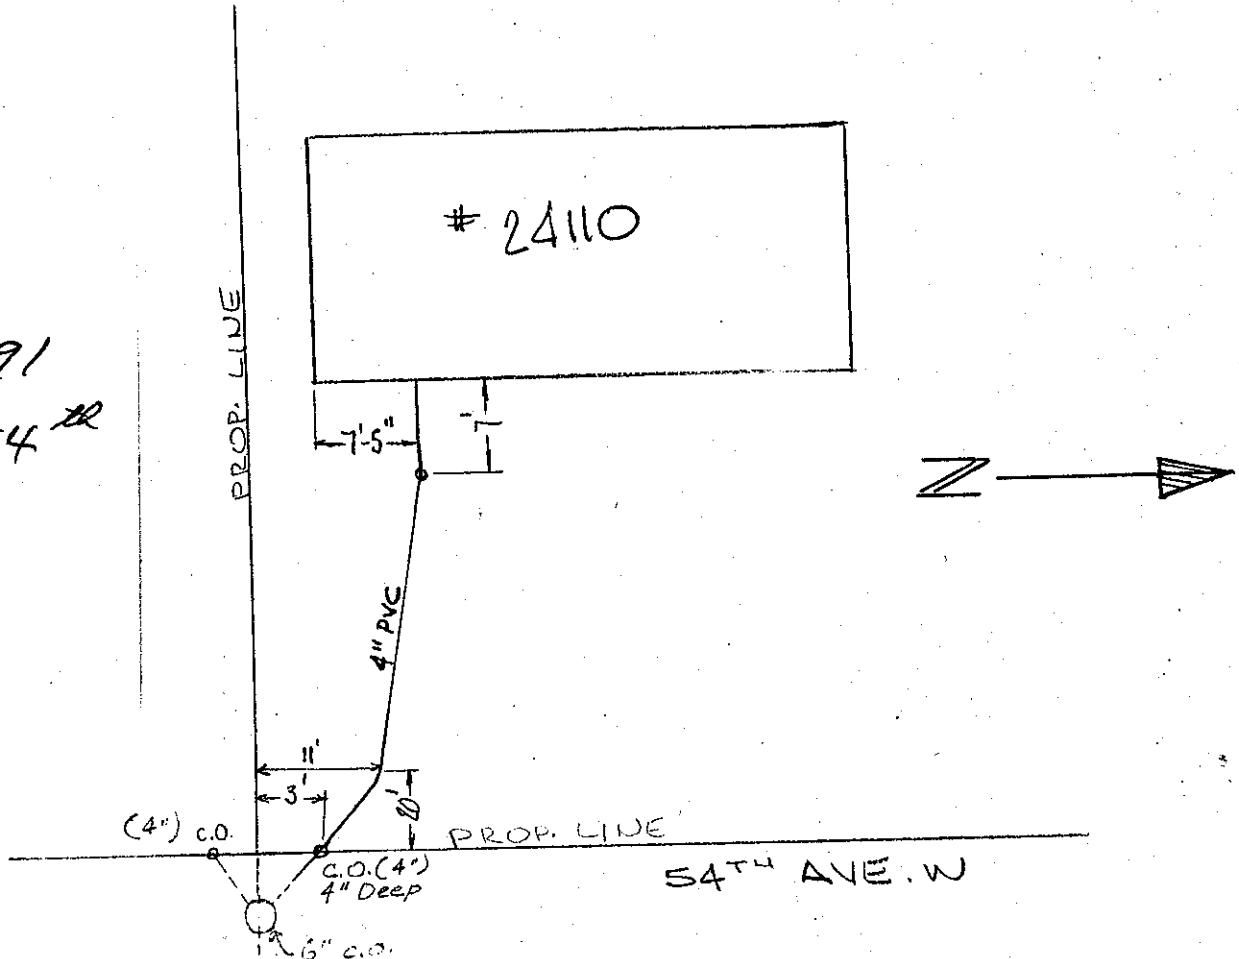

SIDE SEWER ASBILT

The City of Mountlake Terrace


OUTSIDE INSIDE REPAIRS OWNER ARTHUR DAY
HOUSE No. 24118

CONTRACTOR OWNER

STREET AVENUE LOT NO. 54TH AV. W. BLOCK No.

PERMIT No. U-87-2

NAME ADD.

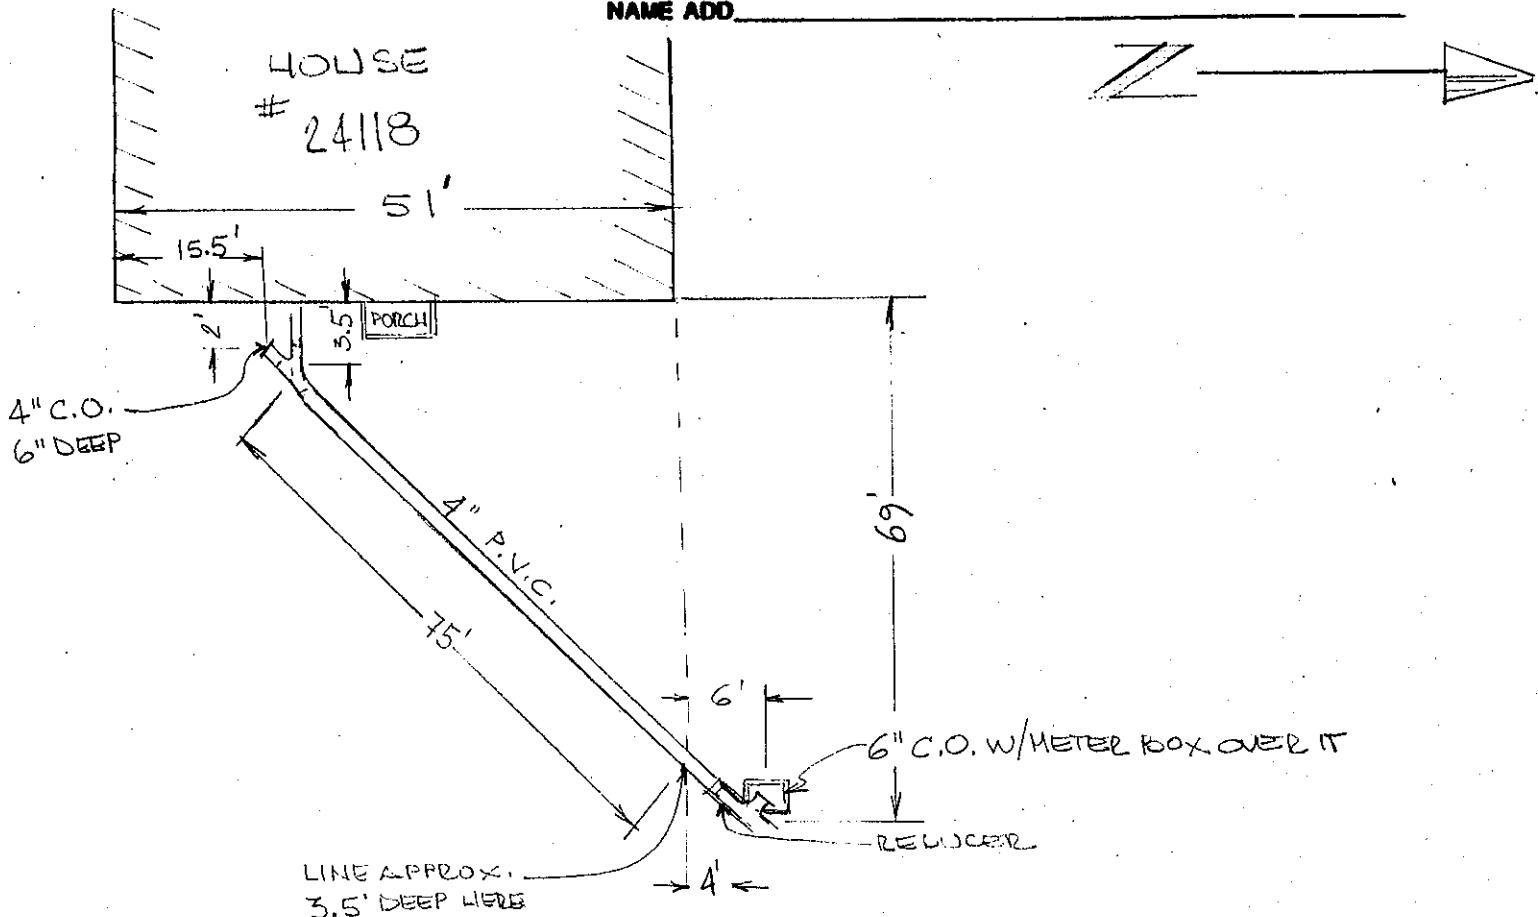

SEWER WORK ORDER ISSUED

8-25-87

BY B. WILLIAMS

FEE 20⁰⁰

C.I.FEE

BACKFILL APPROVED

9-3-87

BY W. VAN RY

ASBILT W. VAN RY BY V.F.

The City of Mountlake Terrace

PLICATION
for
SIDE SEWER PERMIT
OUTSIDE INSIDE REPAIRS

CARD NO.

1429252

EASEMENT NO. ~~All~~ Not L
Used

OWNER: Kaiser Gypsum Co.
HOUSE No. 2160 1/2 - 55 1/2 W.


CONTRACTOR: Wingfield

STREET
AVENUE LOT NO. SW. 1/4 of 21

PERMIT NO. 571

BLOCK NO. —

NAME ADD: _____

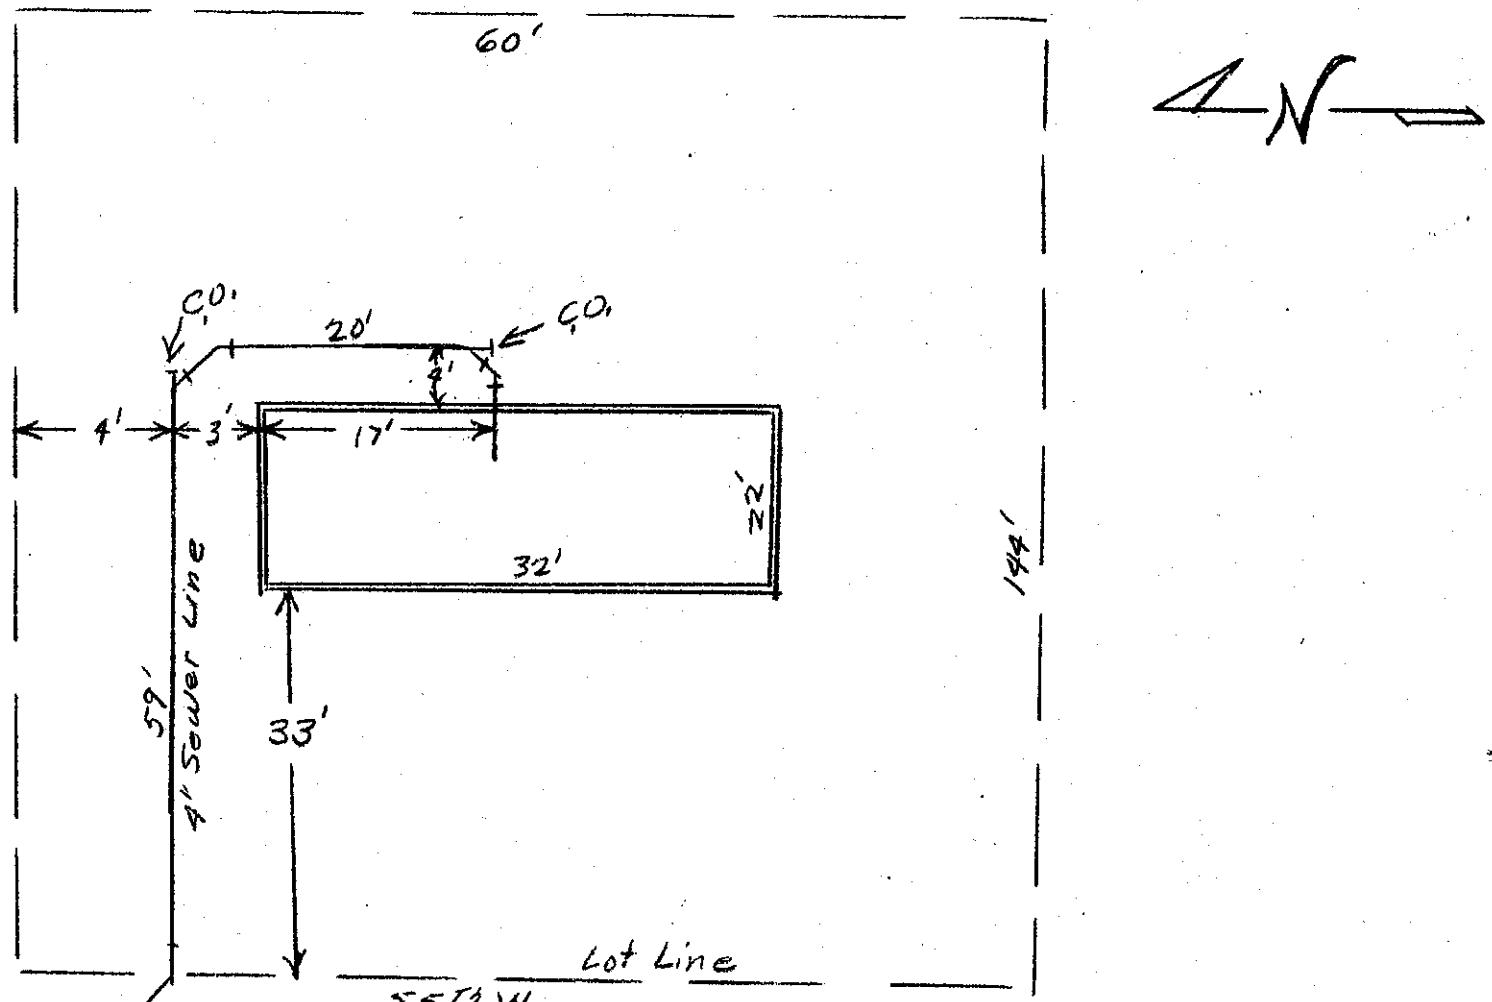

Date

Approved:

BACKFILL WORK ORDER ISSUED

DEPOSIT, \$10.00 11/16/60

WER WORK ORDER ISSUED

2023 DATE 11/17/60

BY Arthur E. Threlkeld

The City of Mountlake Terrace

APPLICATION

for

SIDE SEWER PERMIT

OUTSIDE INSIDE REPAIRS

J.R. Brock
CARD No.

EASEMENT No.

OWNER JOHN R BROCK

CONTRACTOR

PERMIT No.

HOUSE NO. 2160 1/2 on 55th


STREET

AVENUE LOT No. NE 1/4 In 39

BLOCK No.

NAME ADD.

Seattle Heights Gardens

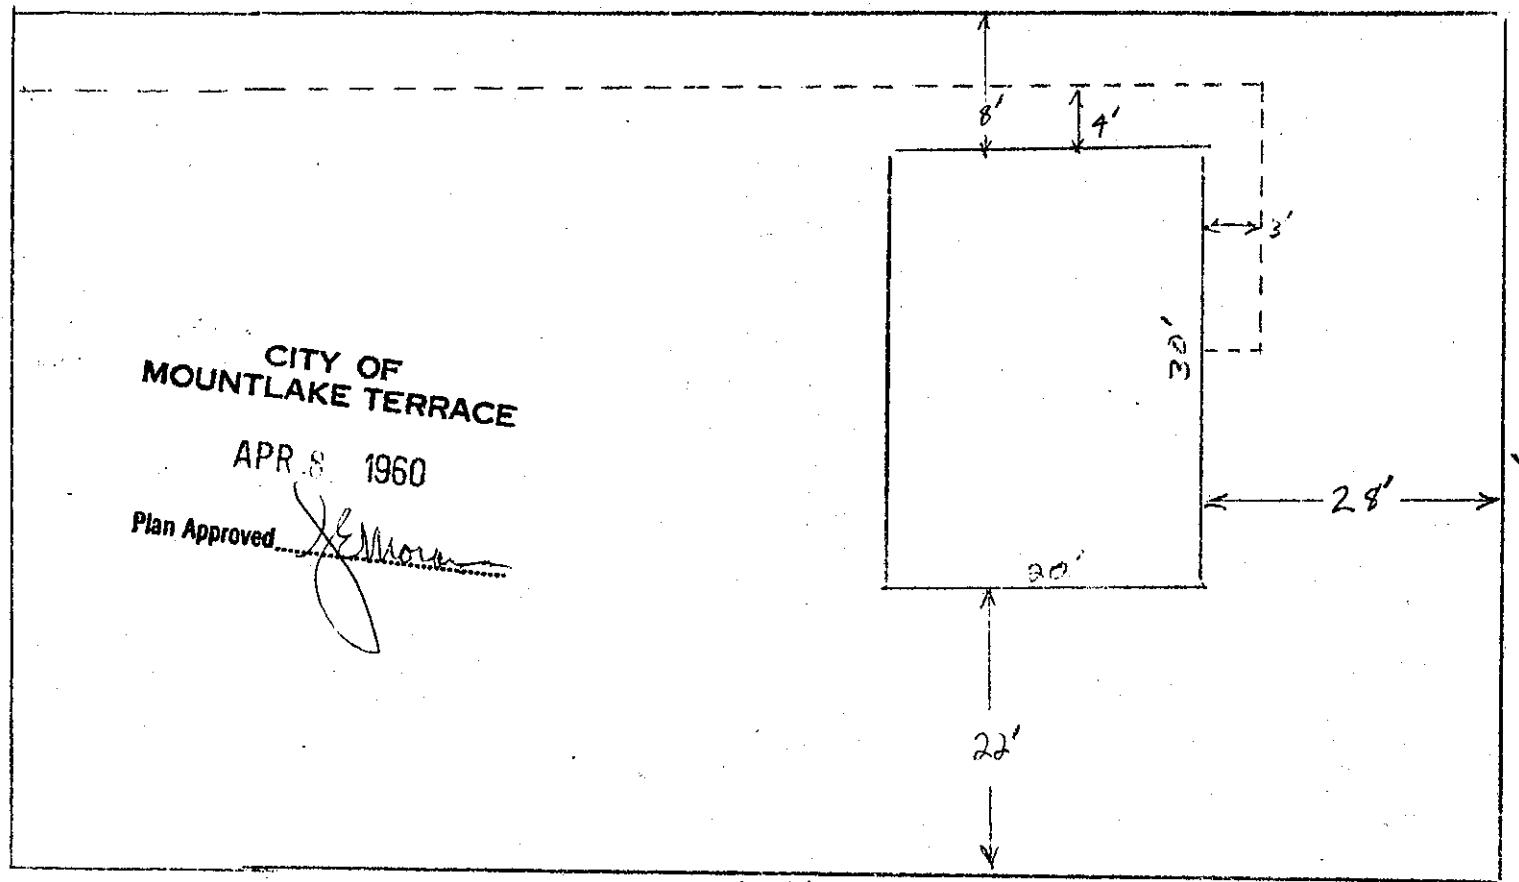

BACKFILL WORK ORDER ISSUED

Date

DEPOSIT, \$

SEWER WORK ORDER ISSUED

Approved: 3/30/60
10.00 4/8/60
1091 DATE 4/8/60

BY

J. More

The City of Mountlake Terrace

APPLICATION
for

SIDE SEWER PERMIT

OUTSIDE INSIDE REPAIRS

CARD No.

EASEMENT No.

OWNER

AUSTIN

HOUSE No. 21605 - 551w

CONTRACTOR

Redford Russell

PERMIT No.


1914

STREET

AVENUE LOT No. 22 Seattle Height Garden

BLOCK No.

NAME ADD.

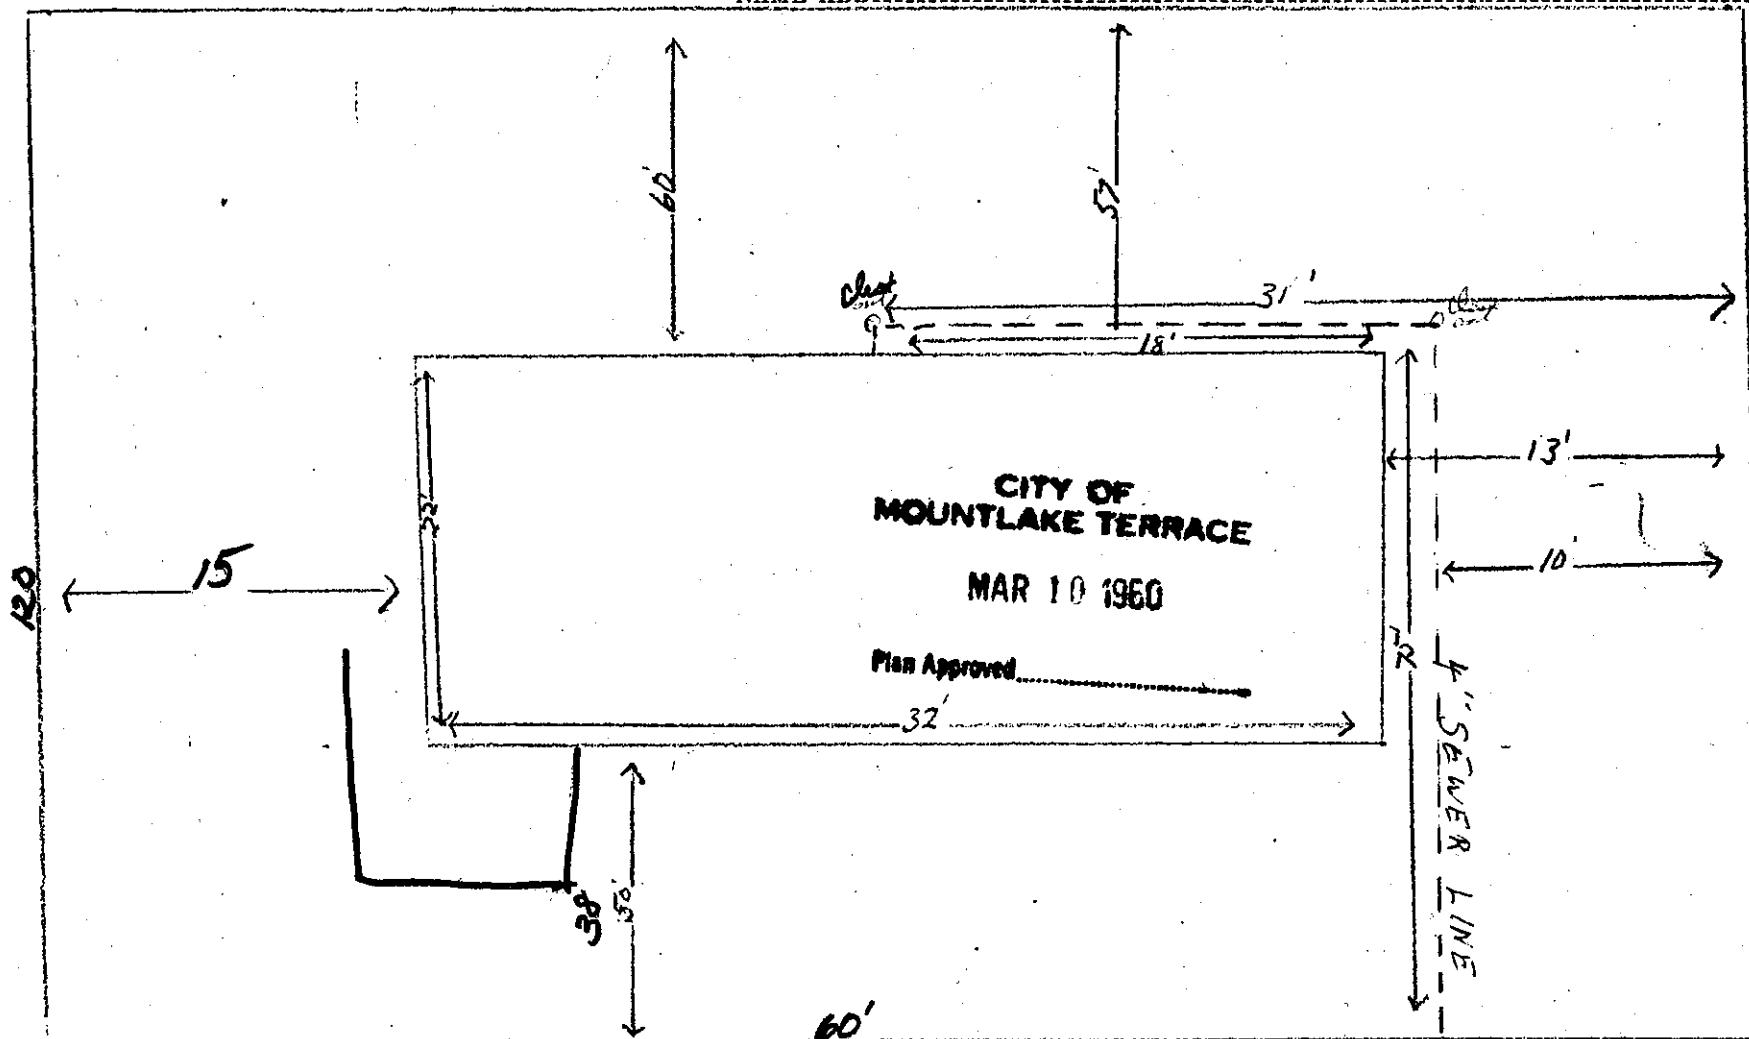

Date

BACKFILL WORK ORDER ISSUED

DEPOSIT, \$

10~~00~~ 3-9-60

Approved:

SEWER WORK ORDER ISSUED

765 DATE 3-11-60

BY

Scott M Holton HSTC/N

APPLICATION

The City of Mountlake Terrace

SIDE SEWER PERMIT

OUTSIDE INSIDE REPAIRS Cm
CARD NO.

EASEMENT NO.

OWNER: Mrs Schell
HOUSE No. 21207-55 & w.


CONTRACTOR: T.S. & C.

STREET:

AVENUE LOT No.:

PERMIT No. 353

BLOCK No.

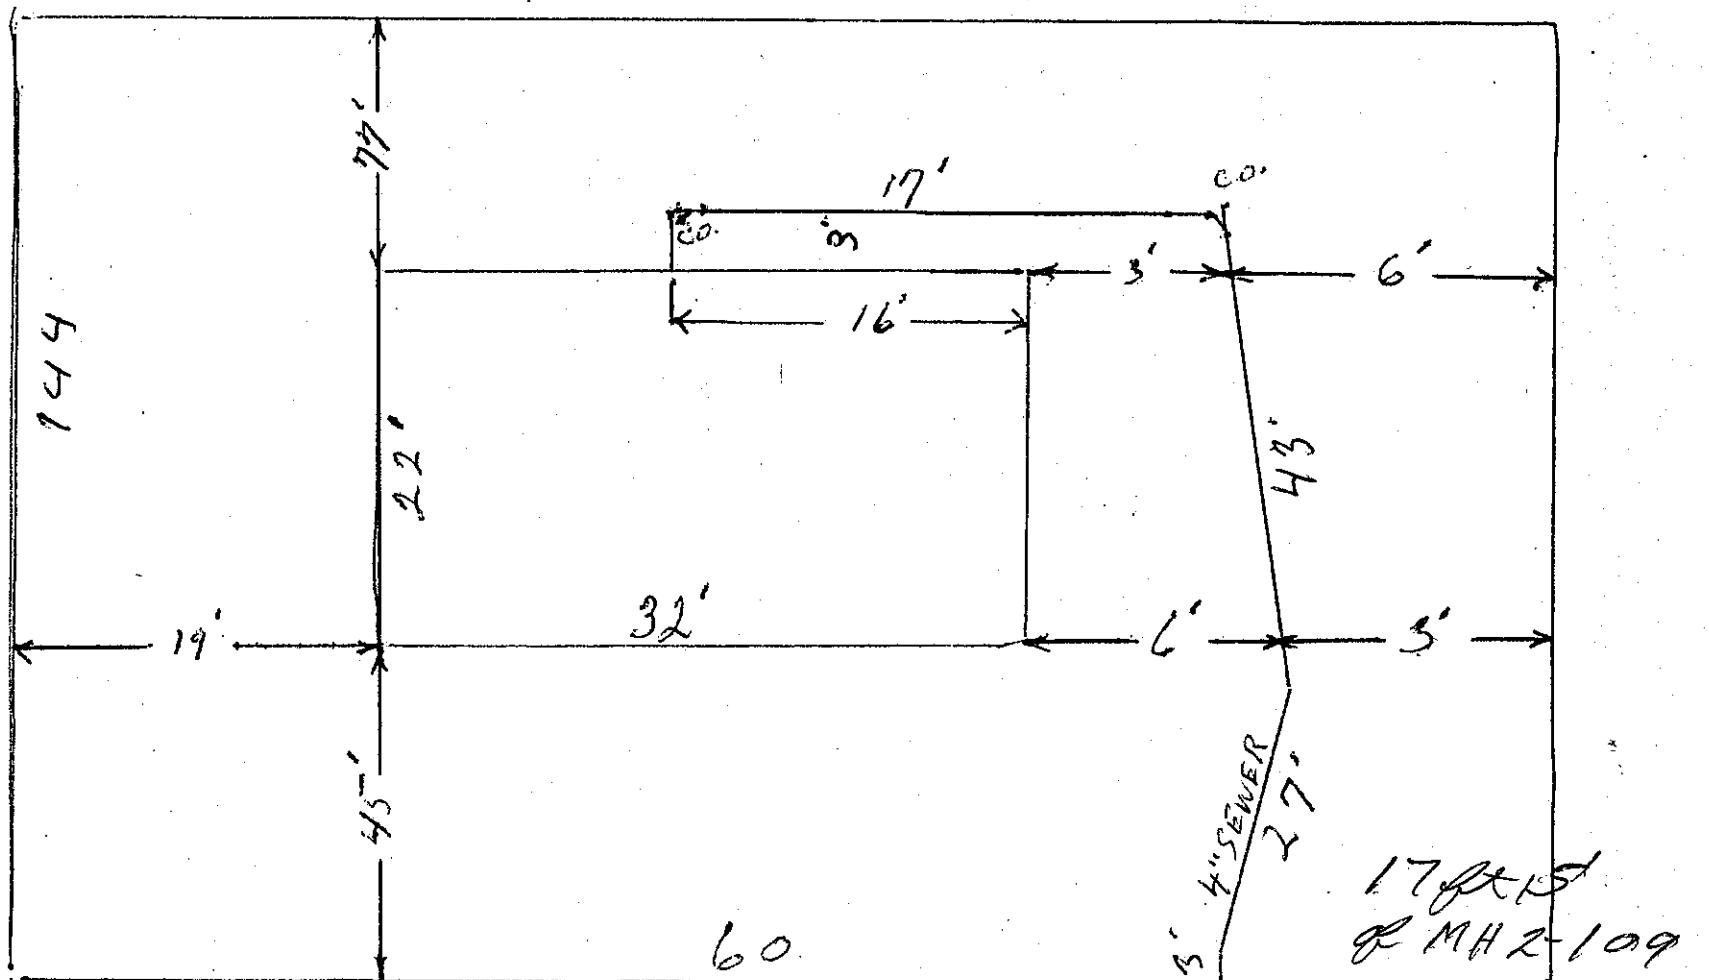NAME ADD: ~~114 1/2 of lot 22~~ Seattle Heights Gardens

Date

Approved:

BACKFILL WORK ORDER ISSUED

DEPOSIT, \$ 10.00

#1790
8/3/60 BY

SEWER WORK ORDER ISSUED

DATE 8-3-60

BY S. Holton INST CON

The City of Mountlake Terrace

APPLICATION
for

SIDE SEWER PERMIT
OUTSIDE INSIDE REPAIRS

CARD No.

EASEMENT No. 1393383

OWNER Eddin F. Hunt PERMIT NO. 2556

HOUSE No. 21608 - 55 W.


CONTRACTOR

Self

STREET
AVENUE LOT No.

BLOCK No.

NAME ADD. N 1/2 of E 1/2 of Lot 38, Seattle Heights Garden

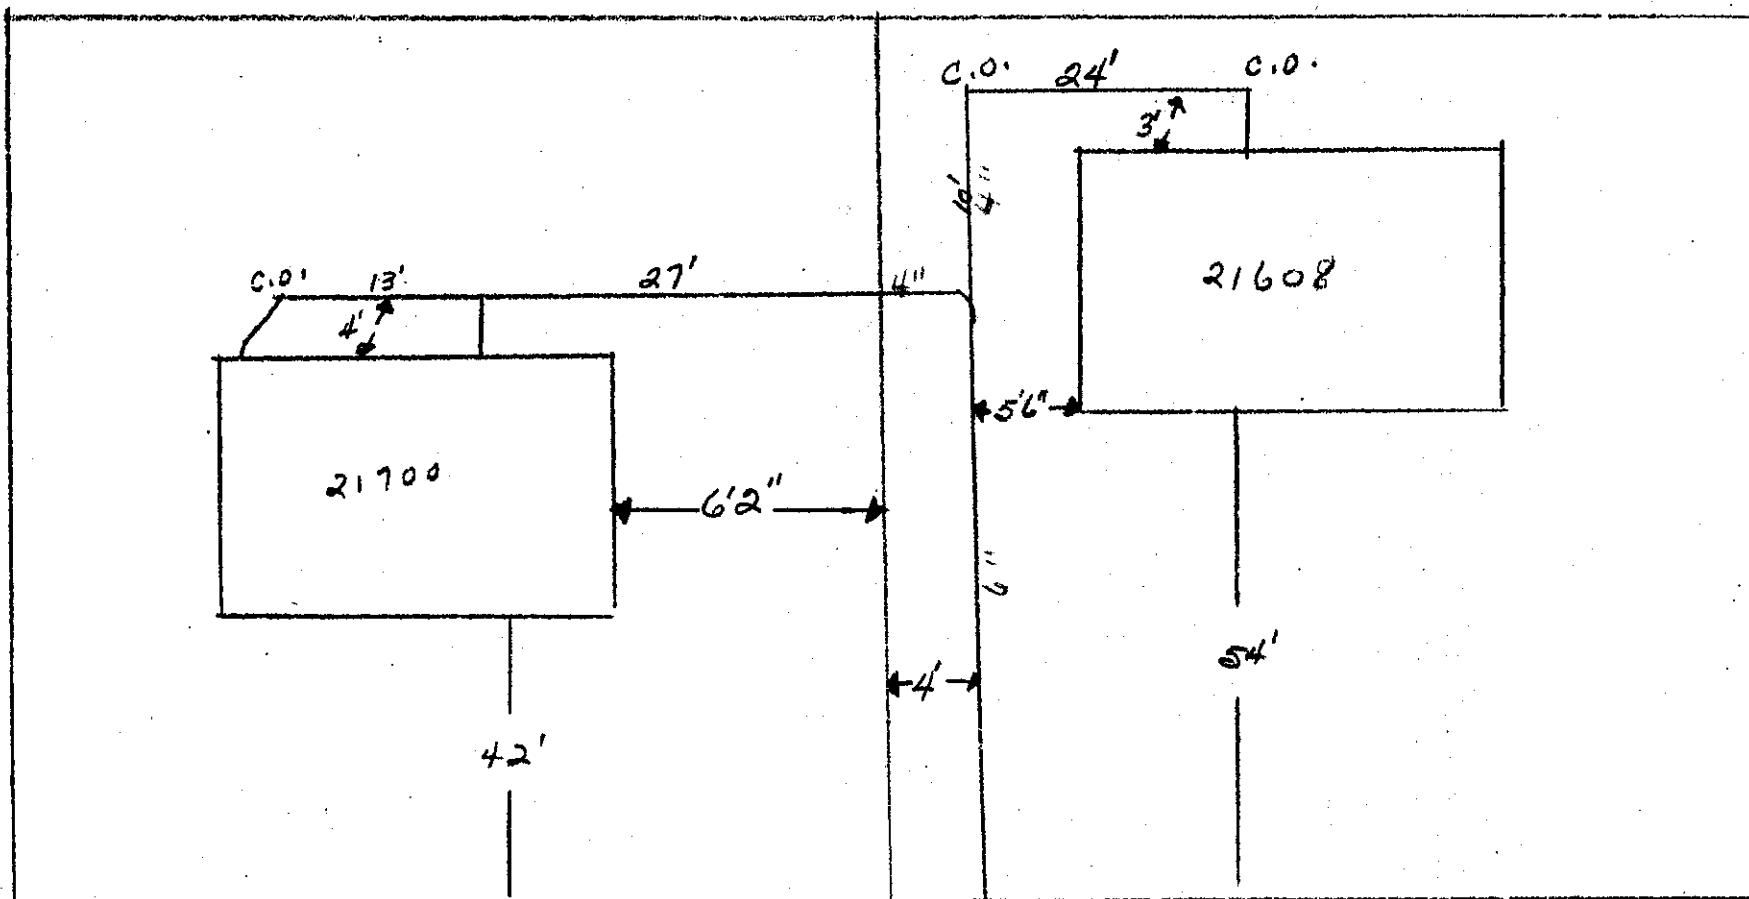

Date

Approved:

BACKFILL WORK ORDER ISSUED

DEPOSIT, \$10.00 4/26/60

SEWER WORK ORDER ISSUED

1330

DATE 5-10-60

BY

S. M. Holton, INST CON

The City of Mountlake Terrace

APPLICATION

CARD NO.

SIDE SEWER PERMIT

OUTSIDE INSIDE REPAIRS

EASEMENT No.

OWNER A.C. ROBINSON

CONTRACTOR

TNWADORE BIRO COAST

PERMIT No. 2383

HOUSE No. 21609 W 55

STREET


AVENUE LOT No.

23

BLOCK No.

NAME ADD.

Seattle Heights Gardens

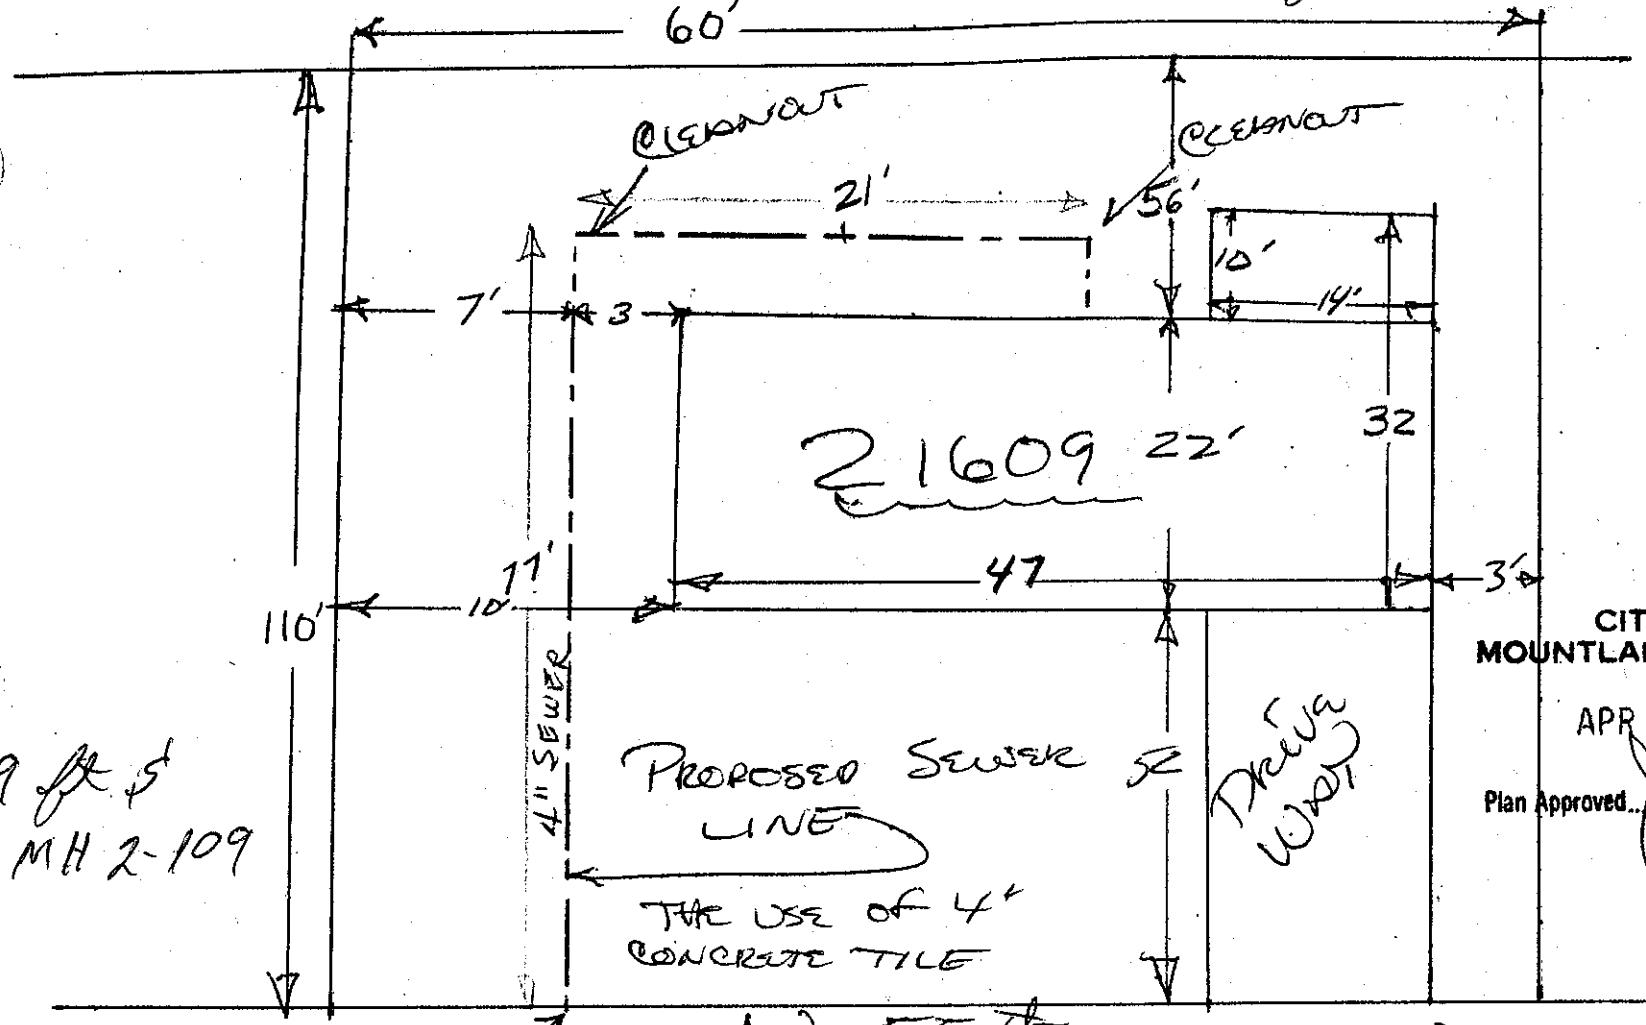

CITY OF
MOUNTLAKE TERRACE

APR 5 1960

Plan Approved:

BACKFILL WORK ORDER ISSUED

DEPOSIT, \$10.00 4/1/60

1165

DATE

4/8/60

BY

SEWER WORK ORDER ISSUED

J. Mora

The City of Mountlake Terrace

APPLICATION

for

SIDE SEWER PERMIT

OUTSIDE INSIDE REPAIRS

L.L.T. 7
CARD NO.

EASEMENT No. 1393283

OWNER Lester L. Lay
HOUSE NO. 21700 - 55 W.

CONTRACTOR

STREET
AVENUE LOT NO.


NAME ADD,

Seef

PERMIT NO. 2555

BLOCK NO.

1/2 of E 1/2 of Lot 38, Seattle Heights Gardens

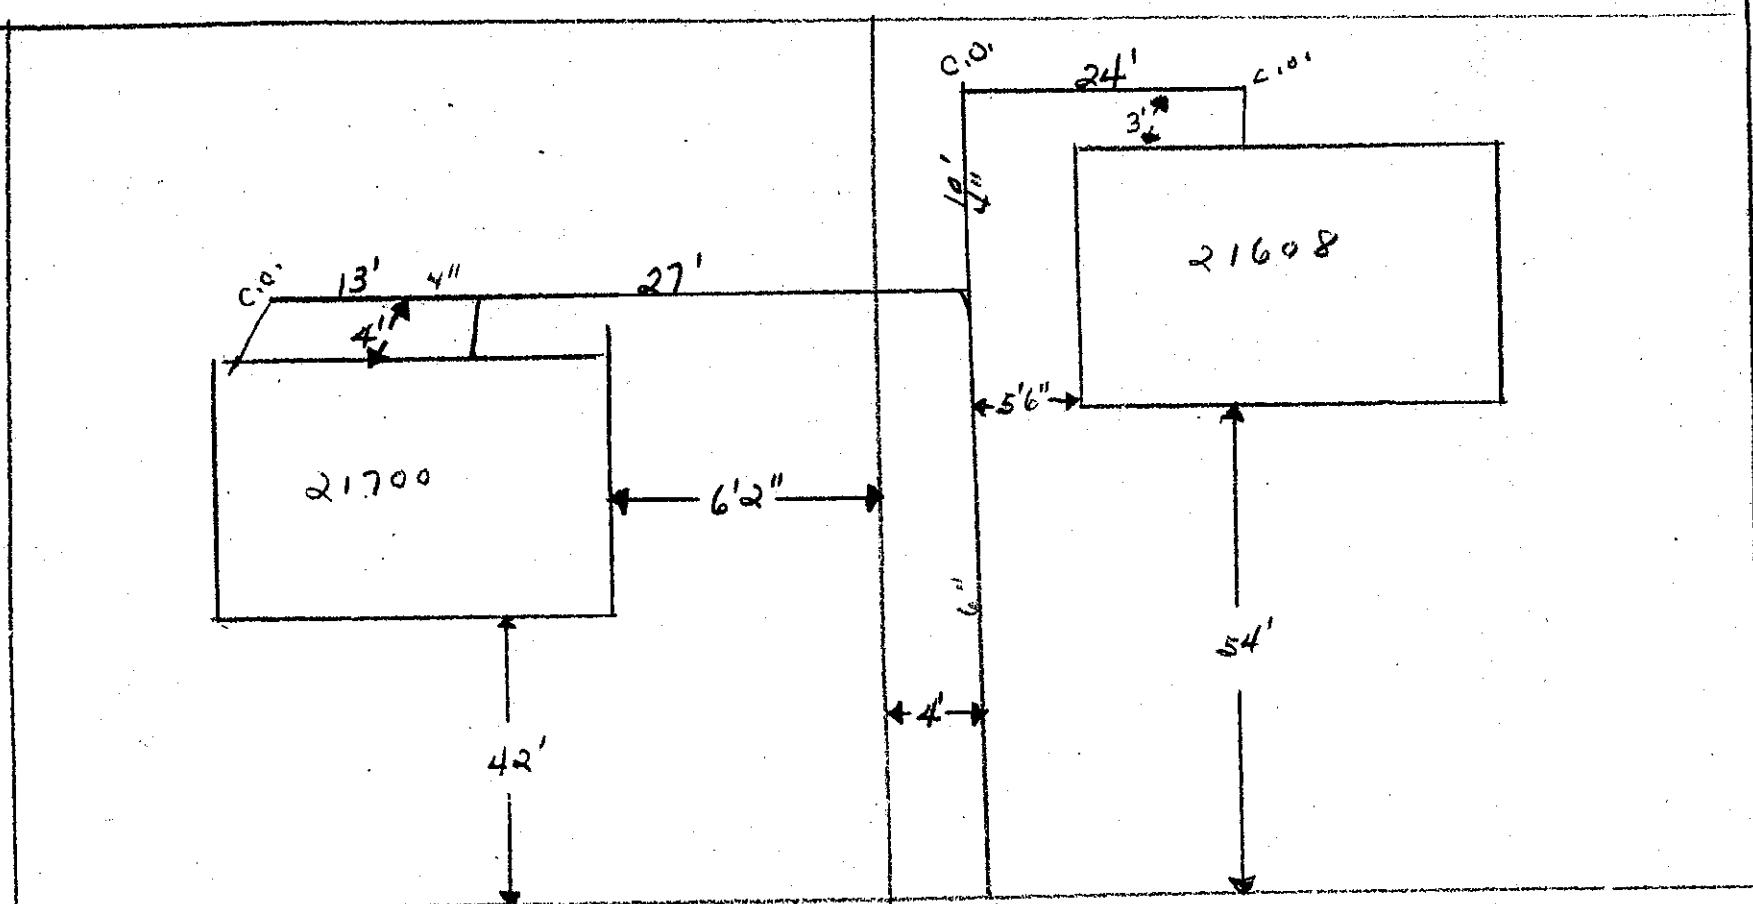

77 ft 15' of MH 2-109

Date

Approved:

BACKFILL WORK ORDER ISSUED

DEPOSIT \$10.00 4/26/60
1329

DATE

SEWER WORK ORDER ISSUED

5-10-60 BY J.M. Holton 1154 CON

The City of Mountlake Terrace

APPLICATION

for

SIDE SEWER PERMIT

OUTSIDE INSIDE REPAIRS

CARD NO.

EASEMENT No. 1398296

OWNER: LEWIS Weythman

CONTRACTOR:

HOUSE NO. 21701 - 55 W

STREET


AVENUE LOT NO. 5 1/2 S 8 W Lot 23

BLOCK NO.

NAME ADD.

Seattle Heights Gardens

PERMIT NO. 2681

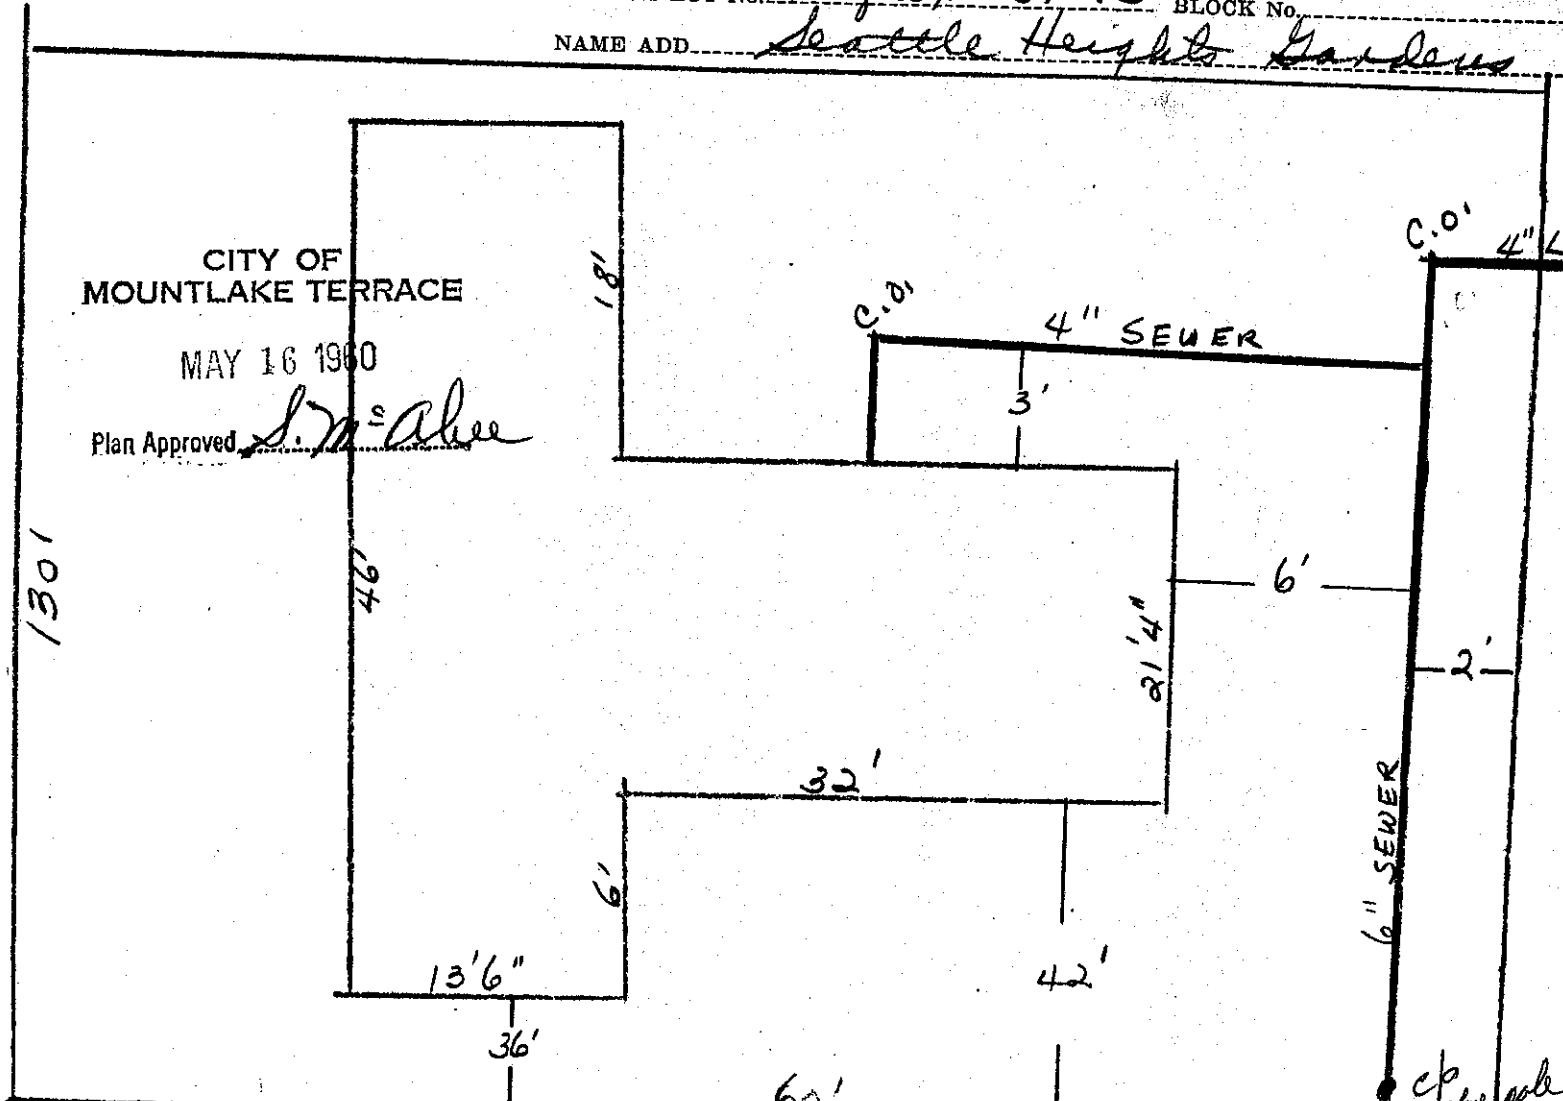

Date

Approved:

BACKFILL WORK ORDER ISSUED

SEWER WORK ORDER ISSUED

DEPOSIT, \$0.00 5/14/60

1463

DATE 5-16-60

BY

S. M. Holton INST CON

APPLICATION

for

SIDE SEWER PERMIT

The City of Mountlake Terrace

CARD No.

OUTSIDE INSIDE REPAIRS EASEMENT NO. 1398296

OWNER

CLIFFORD WILKE I

CONTRACTOR

Seef

PERMIT NO. 2500HOUSE NO. 21703-55 W MTLK TERRACE

STREET


N 1/2 of W 1/2 S 80

AVENUE LOT NO.

Lot 24

BLOCK NO.

NAME ADD

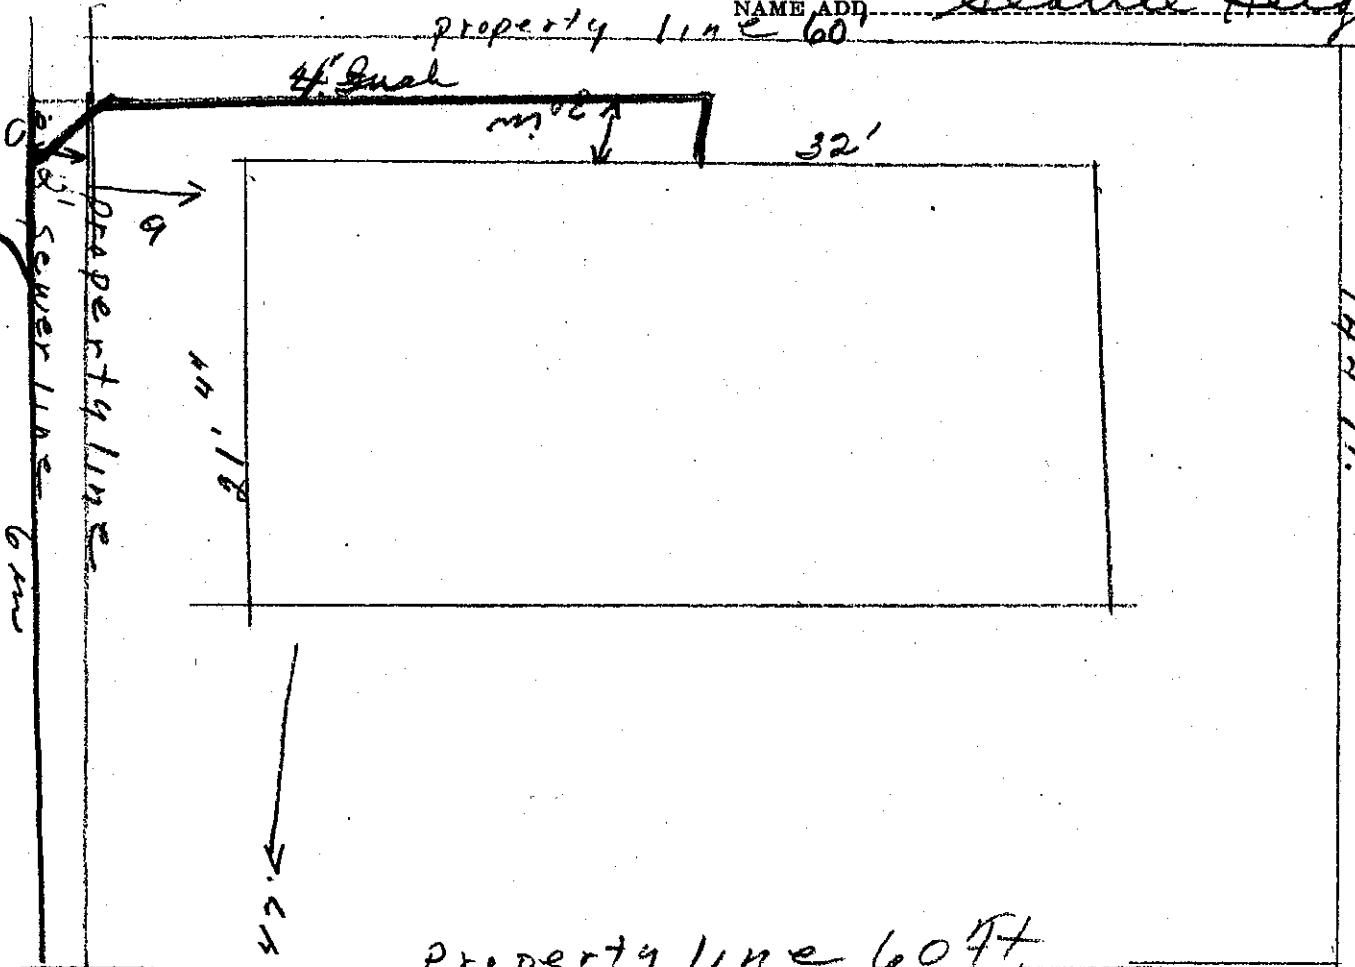Seattle Heights Gardensproperty line 60'CITY OF
MOUNTLAKE TERRACE

MAY 16 1960

Plan Approved S. M. AhernBACKFILL WORK ORDER ISSUED
SEWER WORK ORDER ISSUED

Date

DEPOSIT, \$10.00 4/18/60
1288

Approved:

DATE 5-16-60

BY

J. M. Holton IN ST CON

The City of Mountlake Terrace

APPLICATION

for

SIDE SEWER PERMIT

OUTSIDE INSIDE REPAIRS

CARD No.

EASEMENT No.

PERMIT NO.

2499

OWNER Ronald L. Helland

HOUSE No. 21205 - 55 AVE West

CONTRACTOR

STREET

AVENUE LOT No.

NAME ADD


self

BLOCK No.

5 1/2 Tract 24

15:4

Seattle Heights Garden

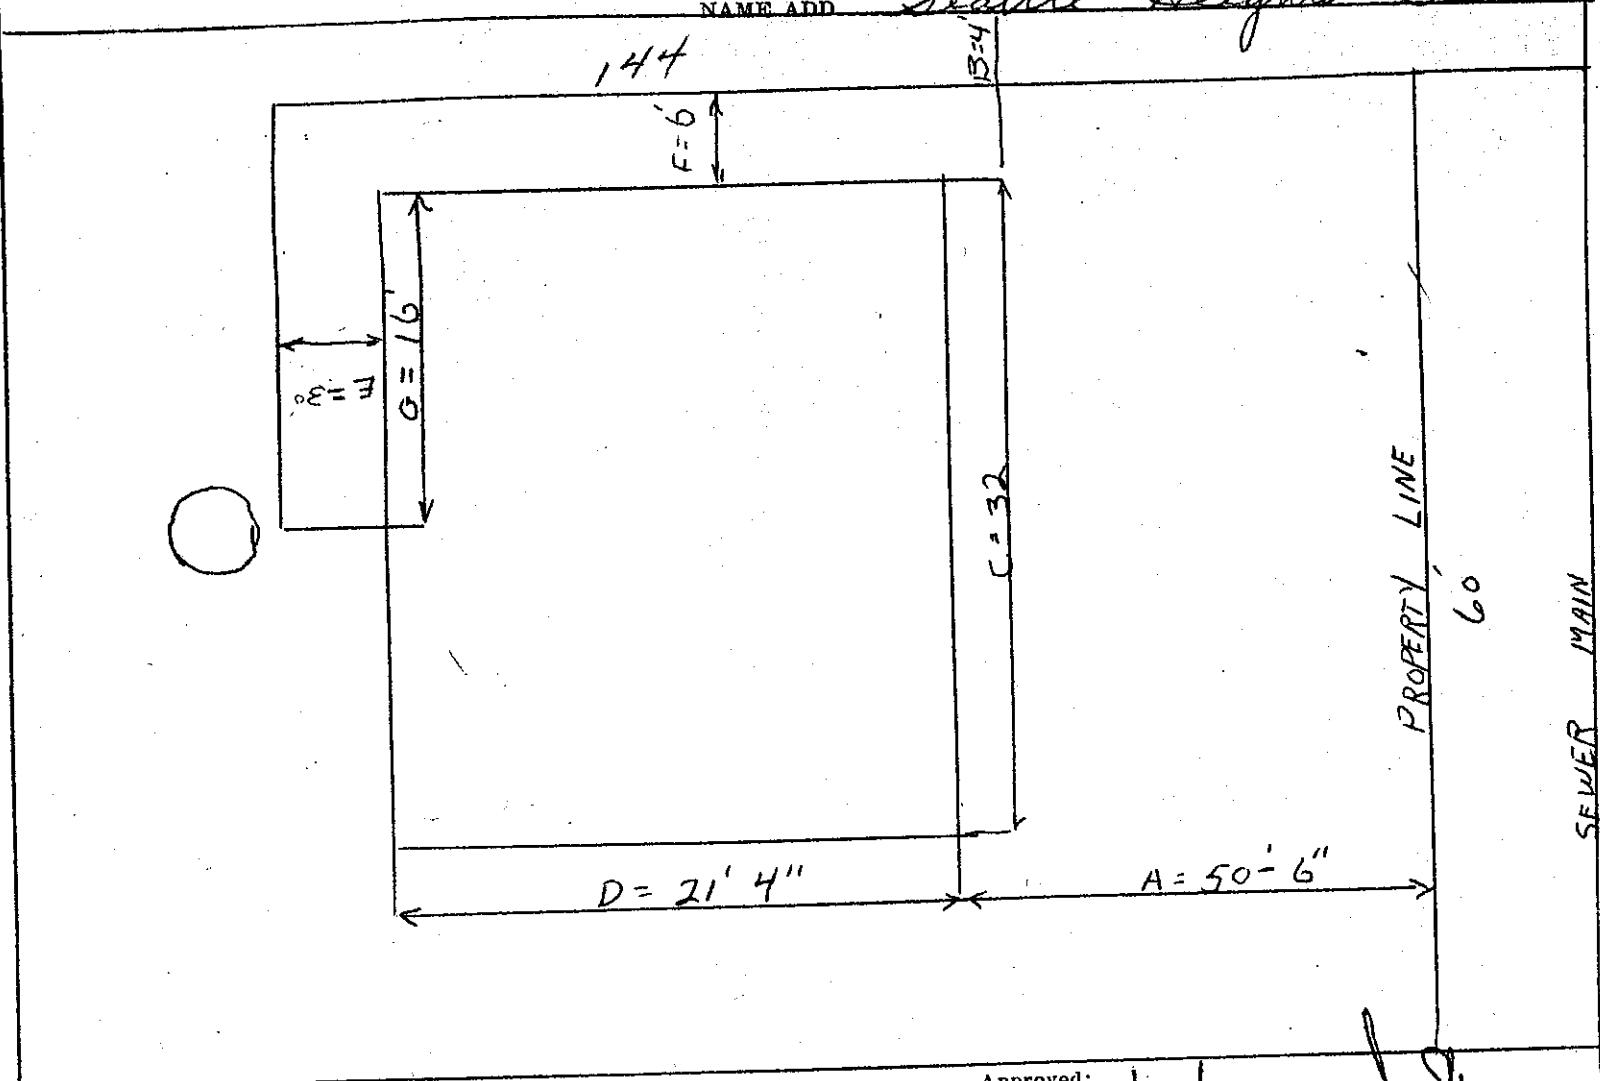

Date

Approved:

DEPOSIT, \$10⁰⁰ 4-16-60

BACKFILL WORK ORDER ISSUED

SEWER WORK ORDER ISSUED

1287 LT DATE 5/31/60 BY J. Mora

The City of Mountlake Terrace

APPLICATION

for

SIDE SEWER PERMIT

OUTSIDE INSIDE REPAIRS

CARD No.

EASEMENT No.

1397864

OWNER DONALD L. EDWARDS

CONTRACTOR PARSON & MARTININI


PERMIT No.

HOUSE NO. 21802 55 1/4 W

STREET AVENUE LOT No. 56 1/2 Lot 35

BLOCK No.

NAME ADD Seattle Heights Gardens

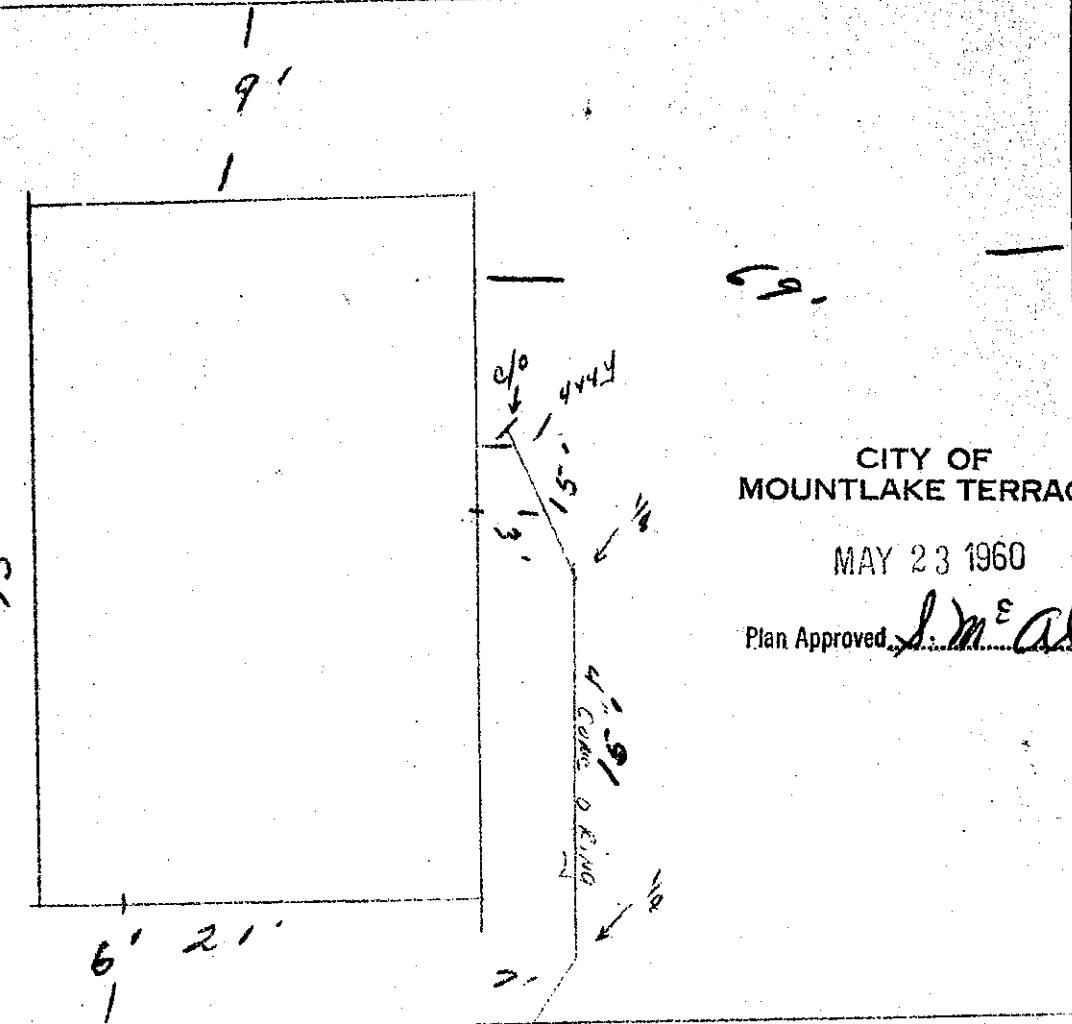

09
CITY OF
MOUNTLAKE TERRACE

MAY 23 1960

Plan Approved,

J. M. Alice

BACKFILL WORK ORDER ISSUED

Date

DEPOSIT, \$10.00

Approved:

SEWER WORK ORDER ISSUED

1492

5/19/60

DATE 5/23/60

BY

K. M. Morris

The City of Mountlake Terrace

APPLICATION

for

SIDE SEWER PERMIT

OUTSIDE INSIDE REPAIRS

M.J. KELLY
CARD No.

BASEMENT No. 1360906

OWNER

M.J. H. KELLY
HOUSE No. 21804 - 55 W

CONTRACTOR


Johshtn Tractor
STREET
AVENUE LOT NO.

PERMIT No. 1043

BLOCK NO.

NAME ADD.

Margaret M. Maygood Hs. Garden

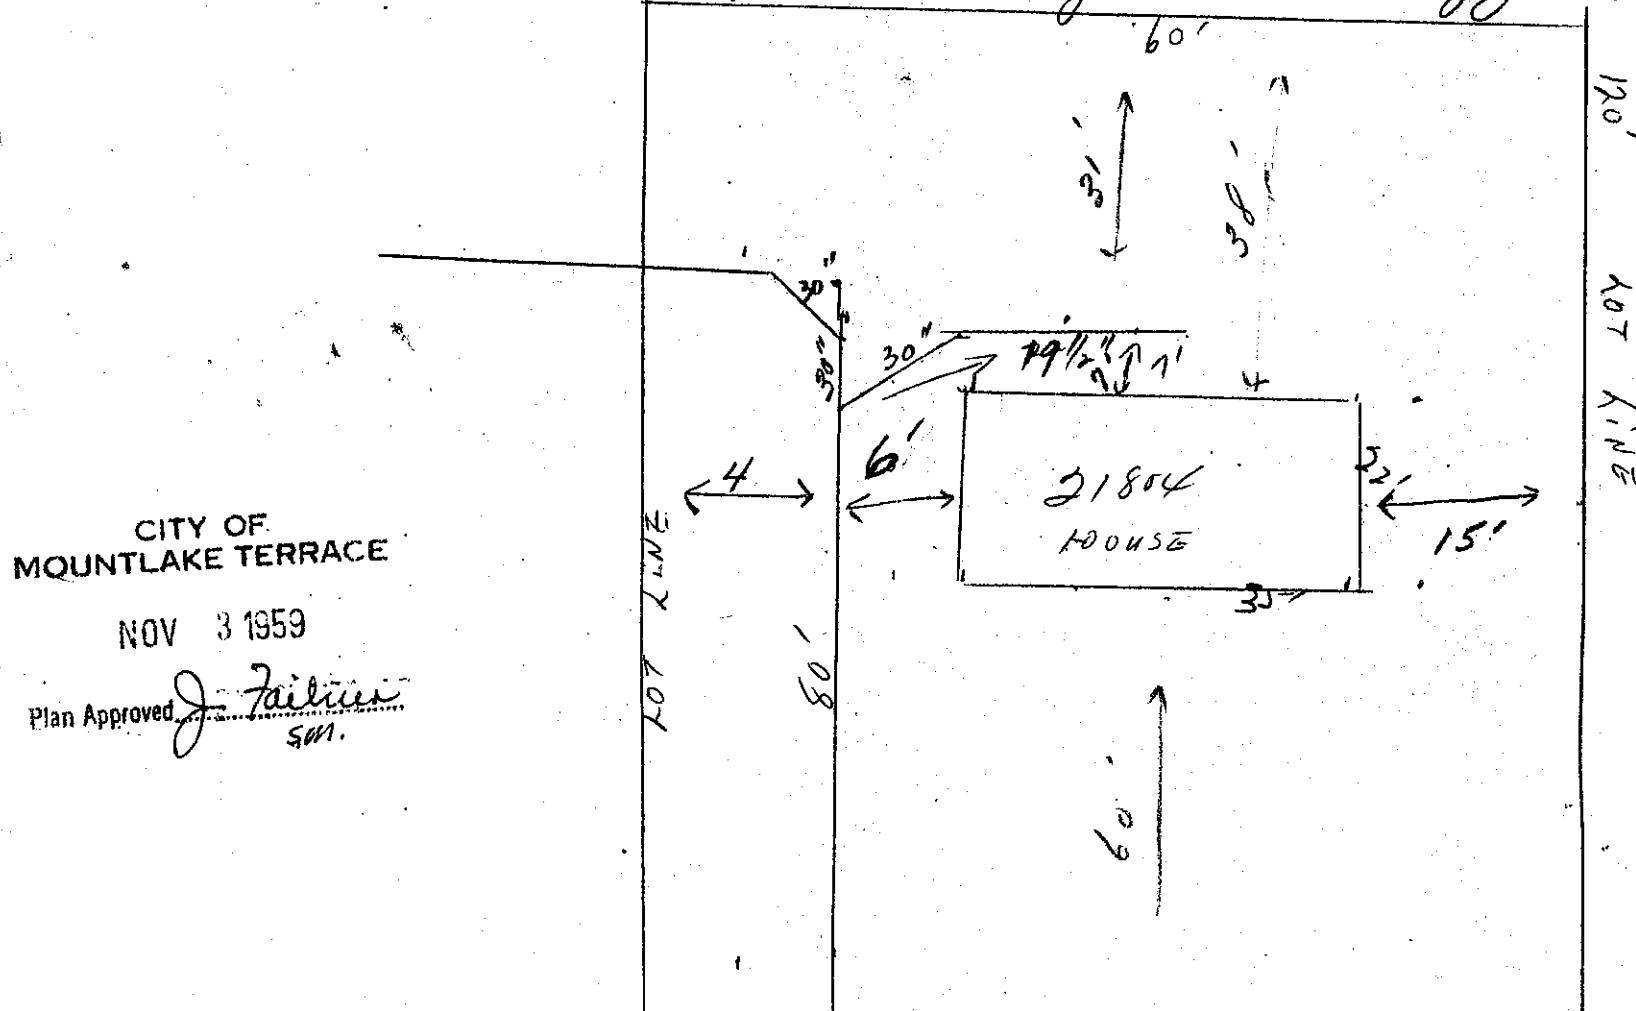

CITY OF
MOUNTLAKE TERRACE

NOV 3 1959

Plan Approved J. Faillie
son.

BACKFILL WORK ORDER ISSUED

SEWER WORK ORDER ISSUED

Date

DEPOSIT, \$ 10.00

Approved:

Inspected by

11/3/59

DATE

BY

Rec. 5261

10/29/59 - D. West

Com 4/25/60 M

APPLICATION

for

SIDE SEWER PERMIT

The City of Mountlake Terrace


CARD No.

OUTSIDE INSIDE REPAIRS EASEMENT No. 1358096
VOL. 691, PAGE 196OWNER Leslie C Knobla
HOUSE No. 21805 WEST 55TH AVENUE.

CONTRACTOR

STREET
AVENUE LOT NO. NORTH 1/2 OF WEST 1/2 TRACT 27 BLOCK NO.NAME ADD. SEATTLE HEIGHTS GARDEN.

PERMIT No. 2282

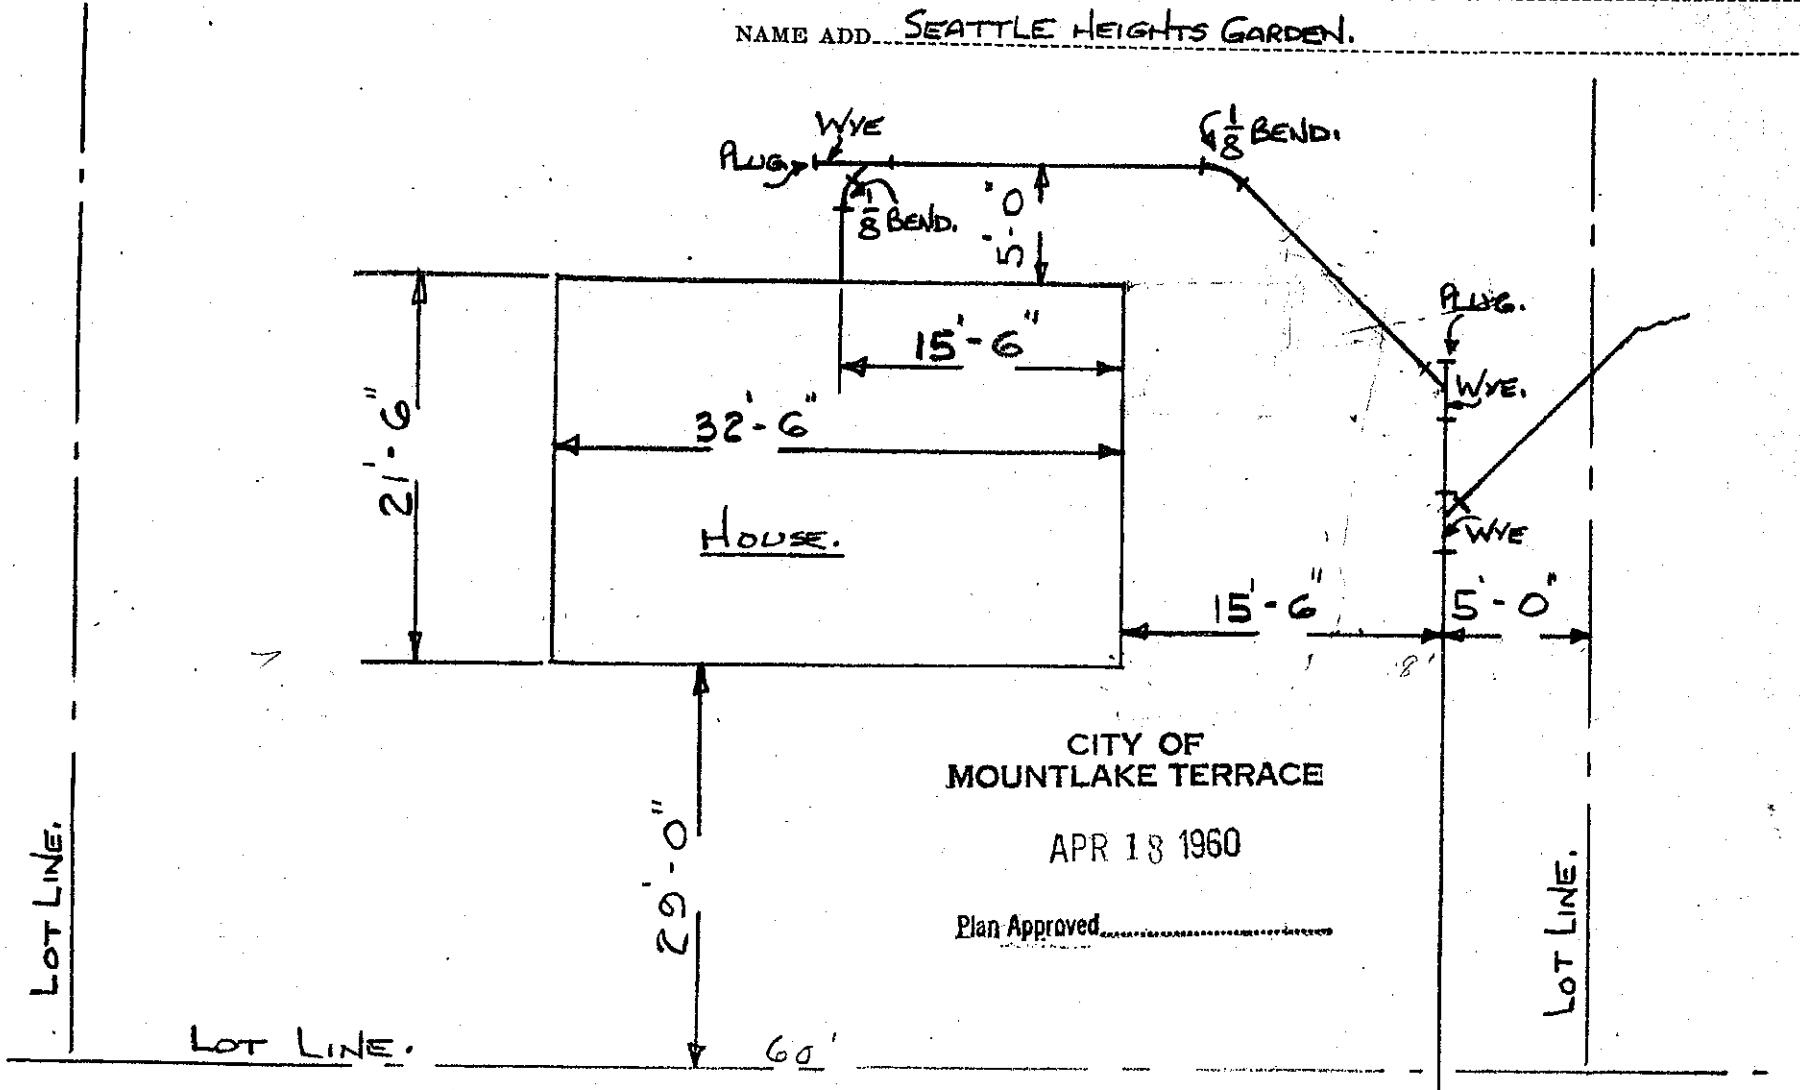

BACKFILL WORK ORDER ISSUED

Date

SEWER WORK ORDER ISSUED

DEPOSIT, \$10.00 3/30/60

107-B

DATE 4-18-60

BY

The City of Mountlake Terrace

APPLICATION
for

SIDE SEWER PERMIT

OUTSIDE INSIDE REPAIRS

OWNER MARGARET N. WAYGOOD
HOUSE NO. 21806 - West 55th

MARGARET N. WAYGOOD

CARD NO.

EASEMENT NO. 1360906

1042

CONTRACTOR

STREET

AVENUE LOT NO. 101-34


NAME ADD.

DUSTON TRACTOR

PERMIT NO.

BLOCK NO.

218 Seattle Rd.
Gardens

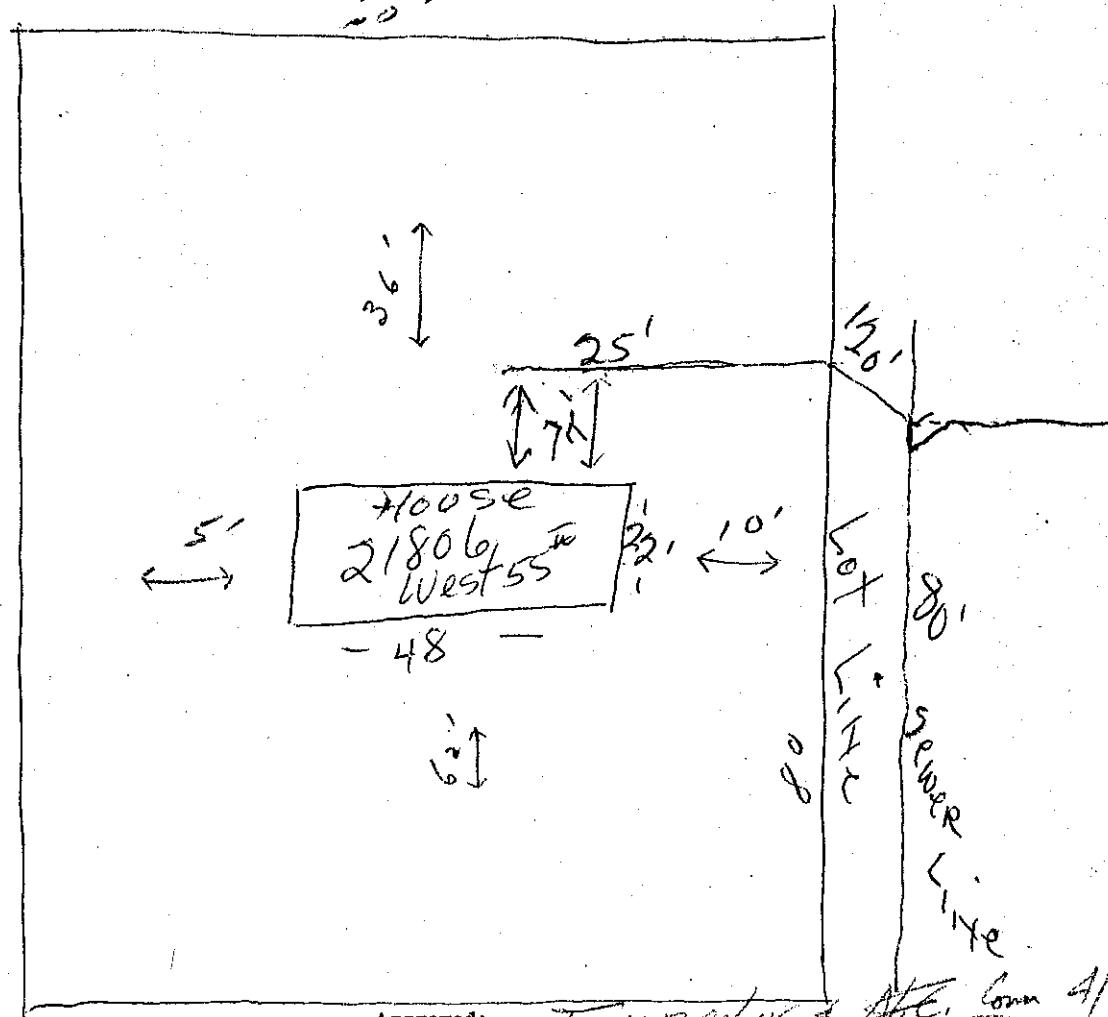

CITY OF
MOUNTLAKE TERRACE

OCT 11 1959

Plan Approved

J. Fairnes
SM

Date

BACKFILL WORK ORDER ISSUED

DEPOSIT, \$10.00

SEWER WORK ORDER ISSUED

Rec. 5262

Approved:

DATE

10/30/59 BY

10/30/59 10 a.m.

Inspector & Lic. Com 4/25/63 J.M.
C. W. H.

The City of Mountlake Terrace

APPLICATION

for

SIDE SEWER PERMIT

OUTSIDE INSIDE REPAIRS

CARD No.

EASEMENT No. 1358096

VOL. 691, PAGE 196

OWNER John T. Longdon

HOUSE NO. 21807 WEST 55TH. AVENUE

CONTRACTOR


STREET

AVENUE LOT NO.

SOUTH 1/2 OF WEST 1/2 TRACT 27 BLOCK NO.

NAME ADD. SEATTLE HEIGHTS GARDEN.

PERMIT NO. 2281

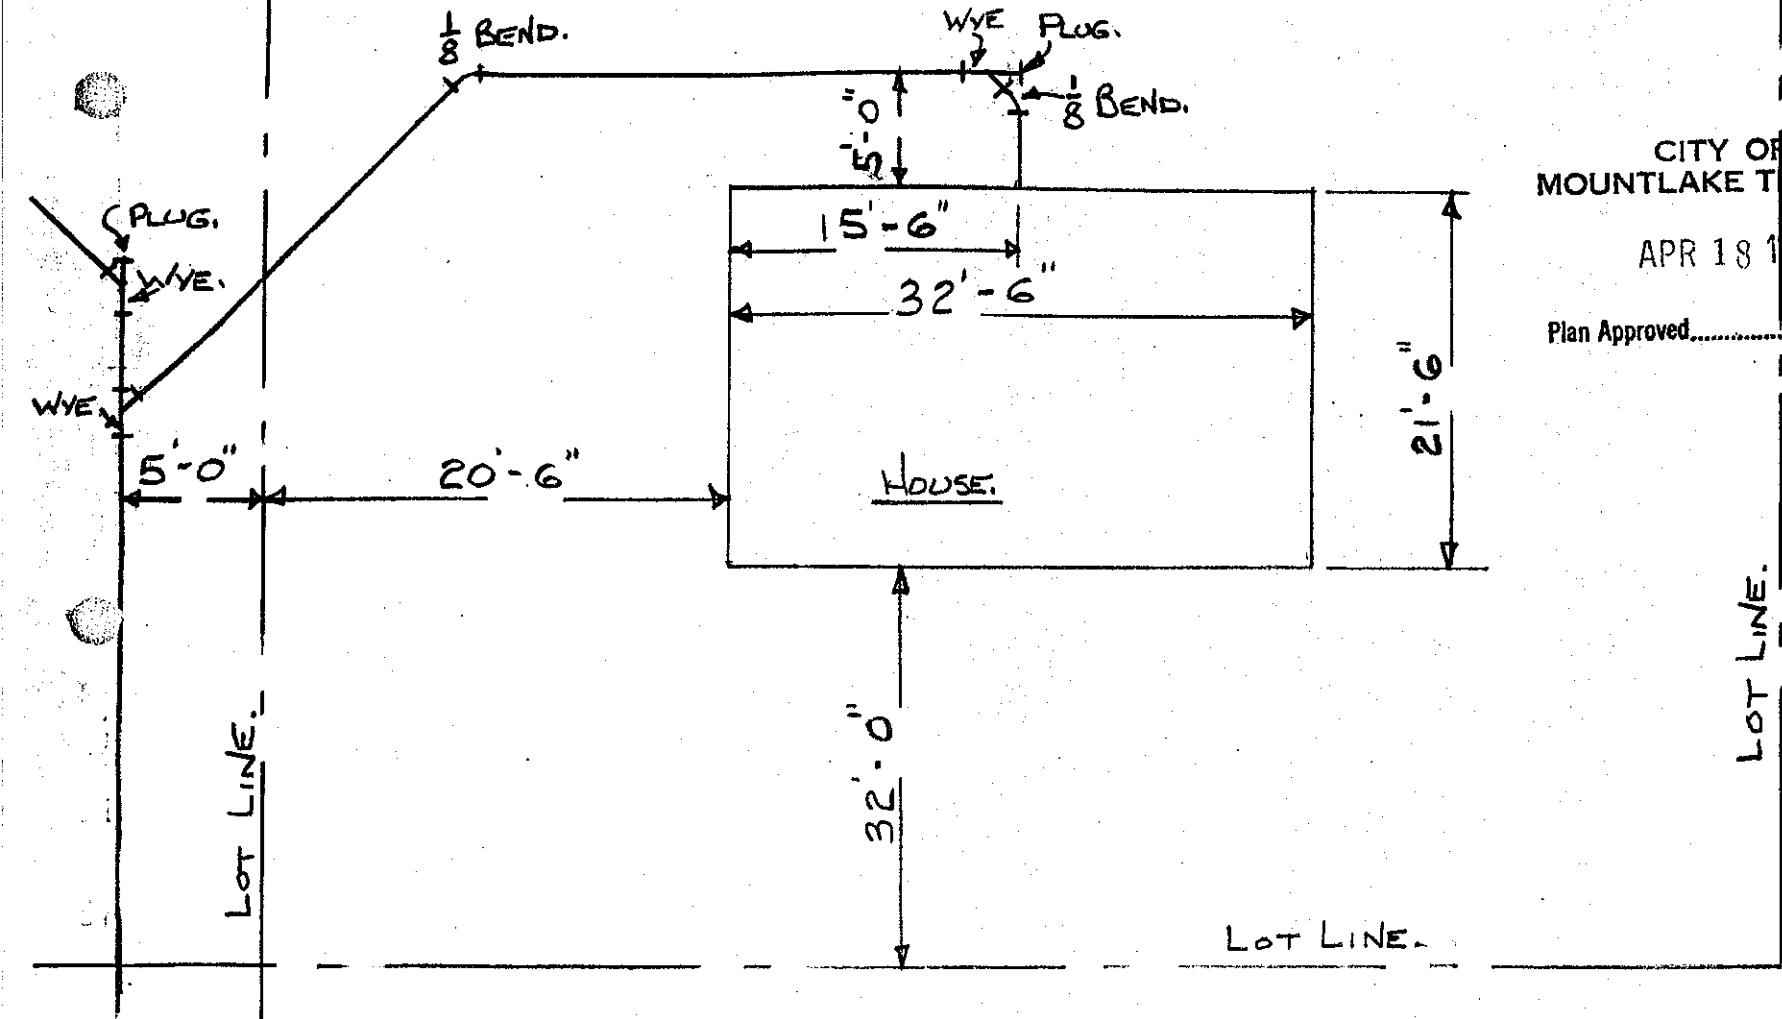

Date

Approved:

BACKFILL WORK ORDER ISSUED

DEPOSIT, \$10.00 3/30/60

SEWER WORK ORDER ISSUED

1074

DATE 4-18-60

BY J. M. Holt FINAL C. & N. INSP.

J. E. Humphreys

CARD No.

The City of Mountlake Terrace

APPLICATION

for

SIDE SEWER PERMIT

OUTSIDE INSIDE REPAIRS

EASEMENT No. None

OWNER

John E. Humphreys

CONTRACTOR

none

PERMIT No.

HOUSE NO.

21808


STREET
AVENUE LOT No.

West 55th NE 44
Lot 53

BLOCK No.

NAME ADD.

Seattle Height Gardens

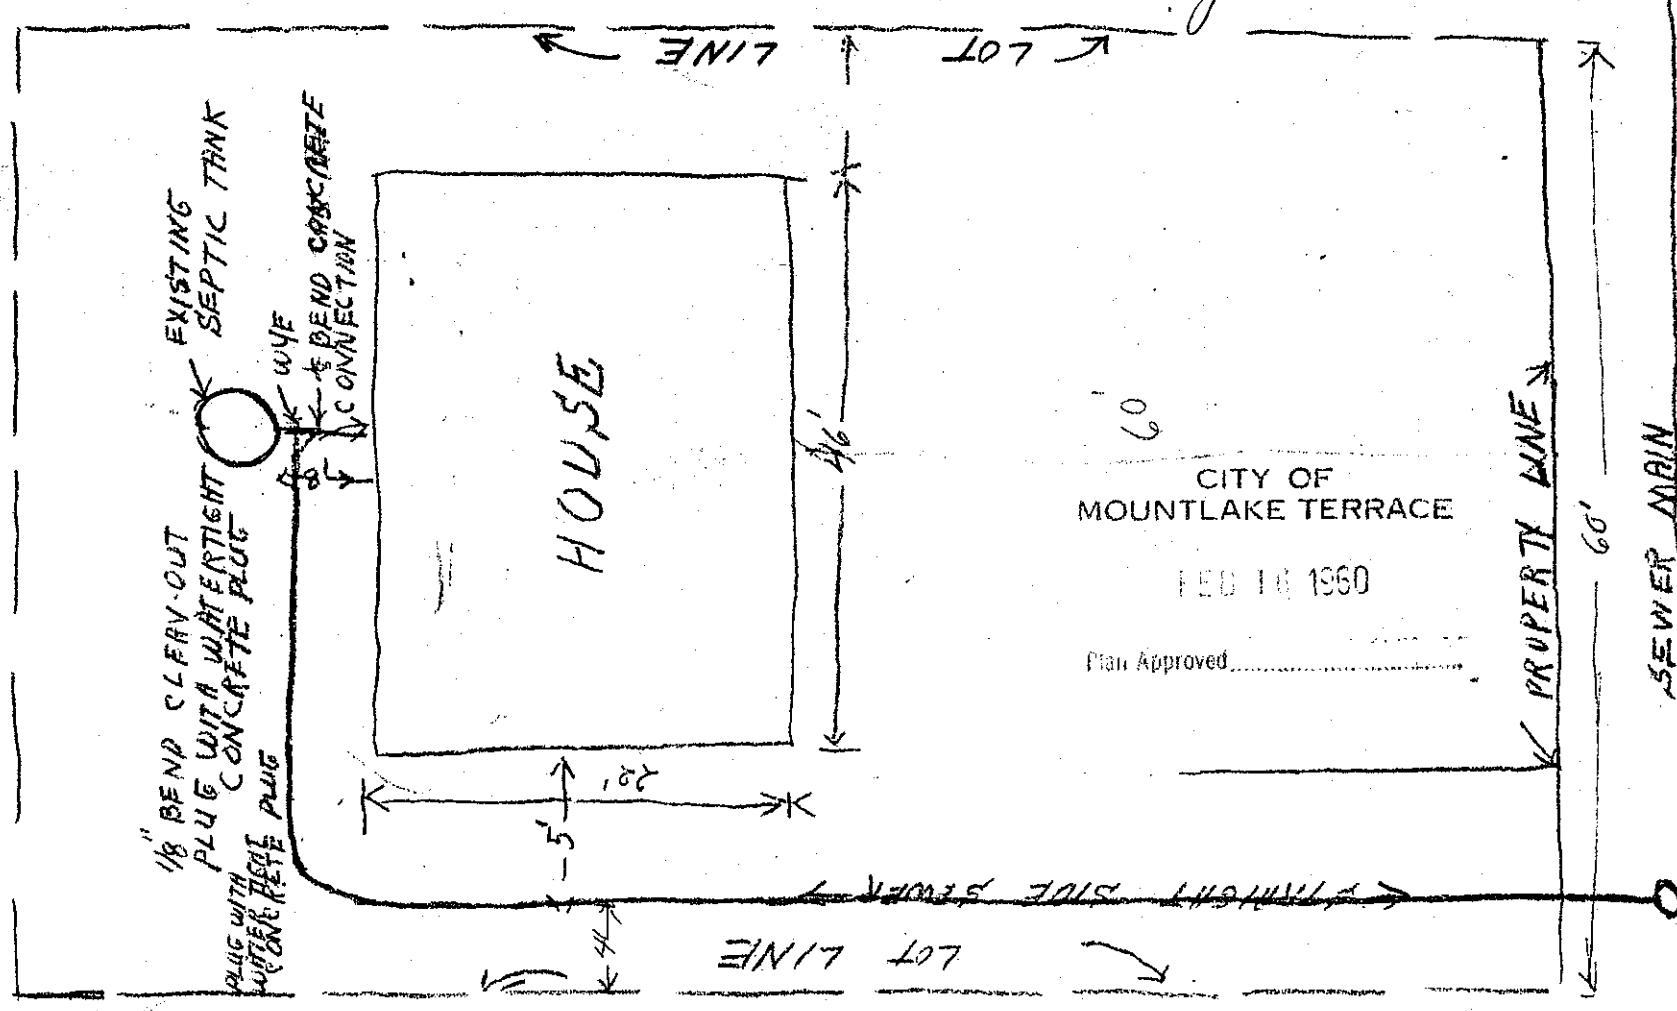

Date

Approved:

BACKFILL WORK ORDER ISSUED

DEPOSIT, \$10 ⁰⁰
2-11-60

SEWER WORK ORDER ISSUED

5997

DATE

2-16-60

BY

Scott M Holton INS.N.C.
5-9-11 8 m. a. 1960

APPLICATION

SIDE SEWER PERMIT

The City of Mountlake Terrace

CARD NO.

OUTSIDE INSIDE REPAIRS

EASEMENT NO.

OWNER Mrs J.D. Ziemianski


HOUSE No. 21900 WEST 55

CONTRACTOR SUBURBAN SEPTIC TANK & SEWER CO. PERMIT NO. 309

STREET 8½ E 5½ lot 33
AVENUE LOT NO.

BLOCK NO. Seattle Heights Garden

NAME ADD. Recorded in Vol 9. of Plats Page 16 Sec. 10

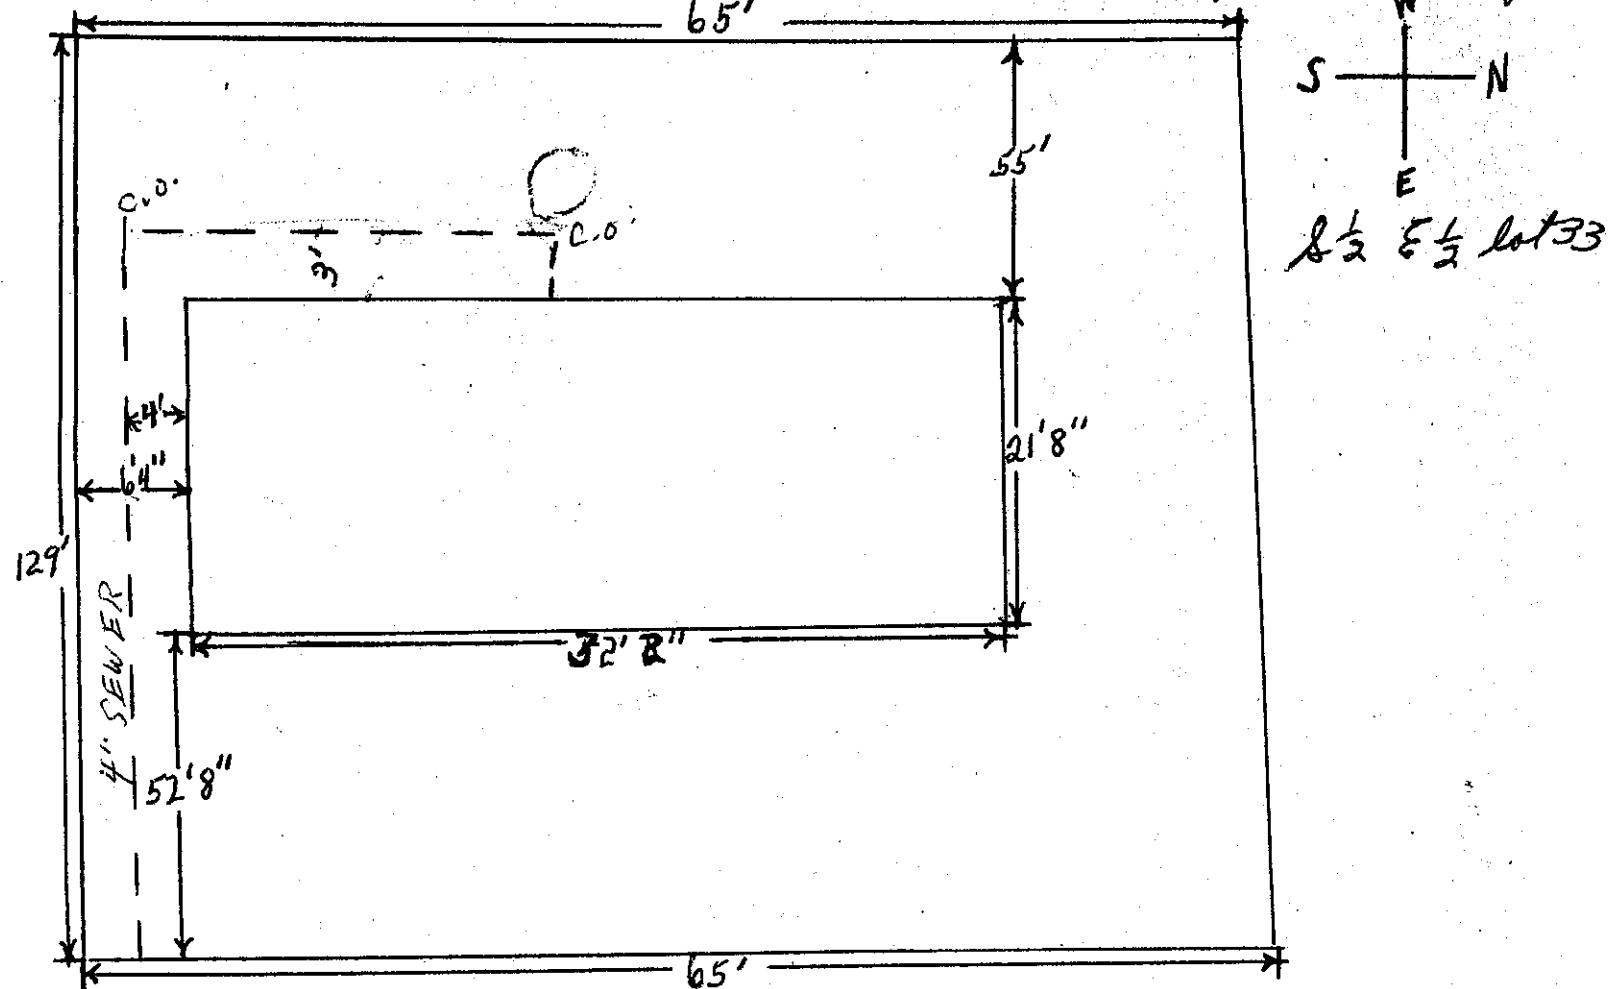

Date

Approved:

BACKFILL WORK ORDER ISSUED

DEPOSIT, \$ 10.00

SEWER WORK ORDER ISSUED

7-21-60
1757

DATE 7-22-60

BY S. M. Hilton INST CON

D.G.C410 R.O.S

APPLICATION

for

SIDE SEWER PERMIT

OUTSIDE INSIDE REPAIRS

CARD No.

BASEMENT No. 379350

The City of Mountlake Terrace

OWNER Demetrios G. Calogeros

HOUSE No. 21902 - SSW.

CONTRACTOR


STREET

AVENUE LOT NO.

PERMIT NO. 2668

BLOCK NO.

NAME ADD. N.E 14 Lot 32 Seattle Highlands Gardens

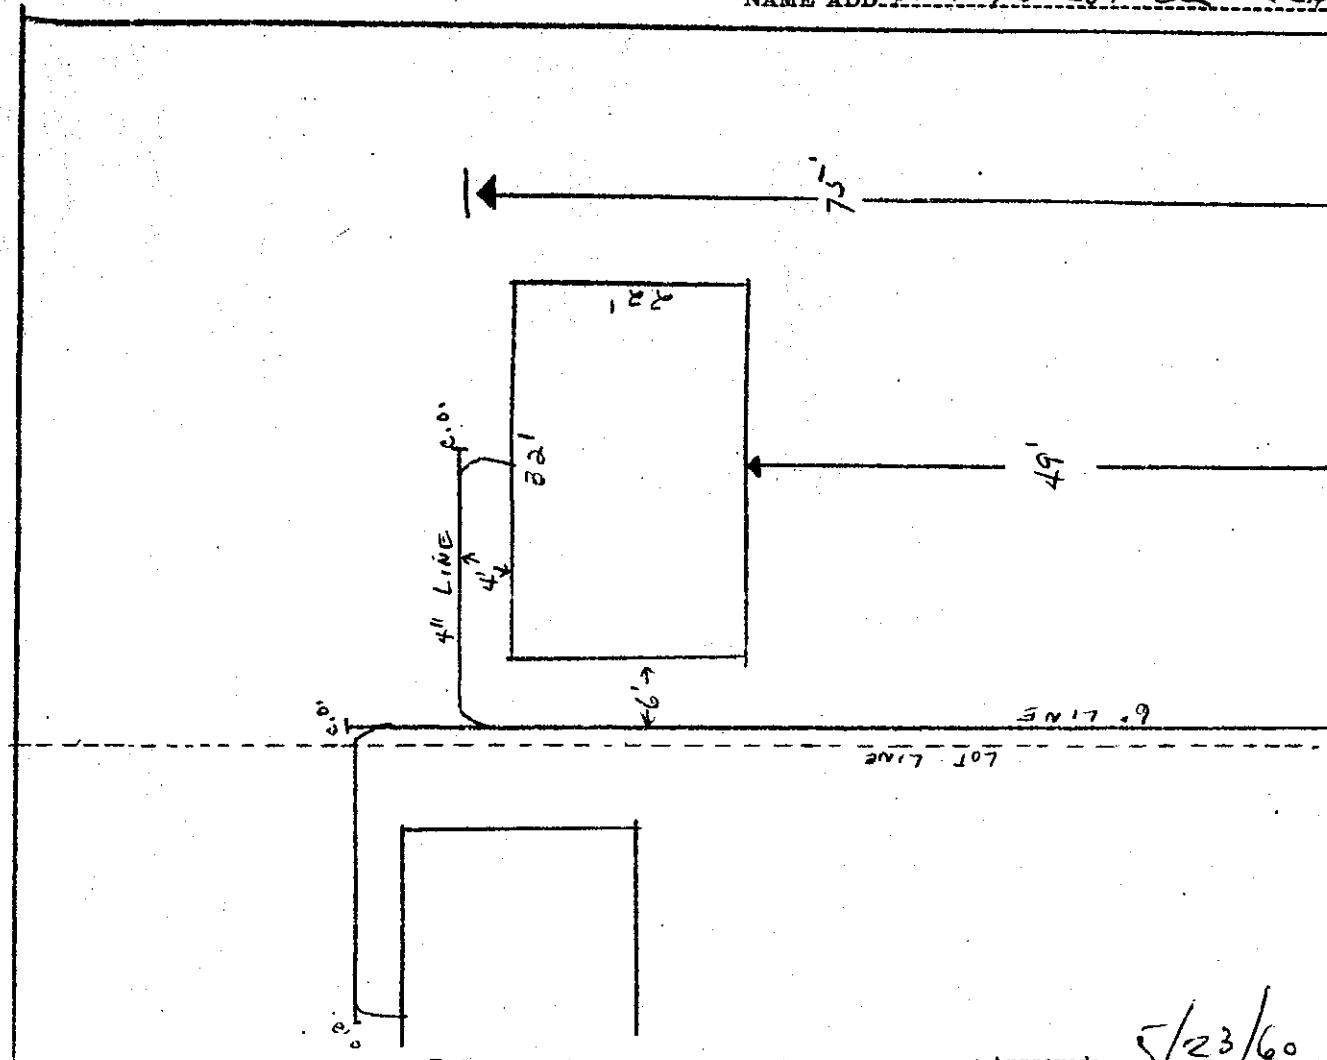

BACKFILL WORK ORDER ISSUED

SEWER WORK ORDER ISSUED

DEPOSIT, \$10.00

1450

Approved:

5/23/60

DATE 5-16-60

BY

J. M. Holton INS+N.C.

CITY OF
MOUNTLAKE TERRACE

MAY 16 1960

Plan Approved

J. M. Holton

J. M. Holton

ROY MOUNTS

APPLICATION

for

SIDE SEWER PERMIT

The City of Mountlake Terrace

CARD No.

OUTSIDE INSIDE REPAIRS

EASEMENT No. 1357954

OWNER Roy Mounts
HOUSE No. 2903 W 55

CONTRACTOR

STREET
AVENUE LOT NO.

Roy Mounts
1/2 Way
24

PERMIT No. 853


BLOCK No.

NAME ADD.

Seattle Heights Garage

50'

↙ N

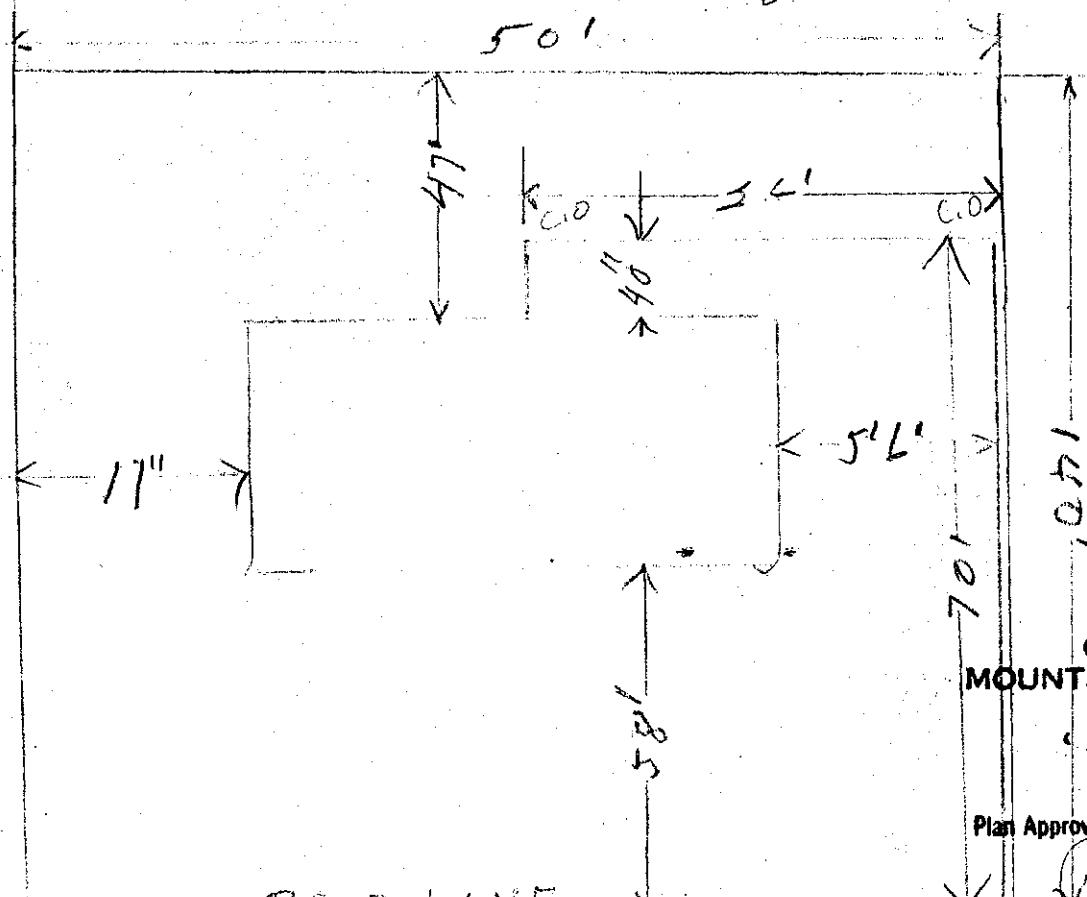

CITY OF
MOUNTLAKE TERRACE

SEP 14 1959

Plan Approved

[Signature]

Inspected by J. J. Conn

3/19/60

Approved:

DATE

BY

BACKFILL WORK ORDER ISSUED

DEPOSIT, \$ 10.00

Date

SEWER WORK ORDER ISSUED

9-11-59

Rec #4730

APPLICATION

for

SIDE SEWER PERMIT

OUTSIDE INSIDE REPAIRS T. F. T. R
CARD No.

EASEMENT No. 137935A

The City of Mountlake Terrace

OWNER THOMAS F. Tinner

HOUSE No. 21904 - 55 W.


CONTRACTOR

STREET

AVENUE LOT No.

PERMIT No. 2667

BLOCK No.

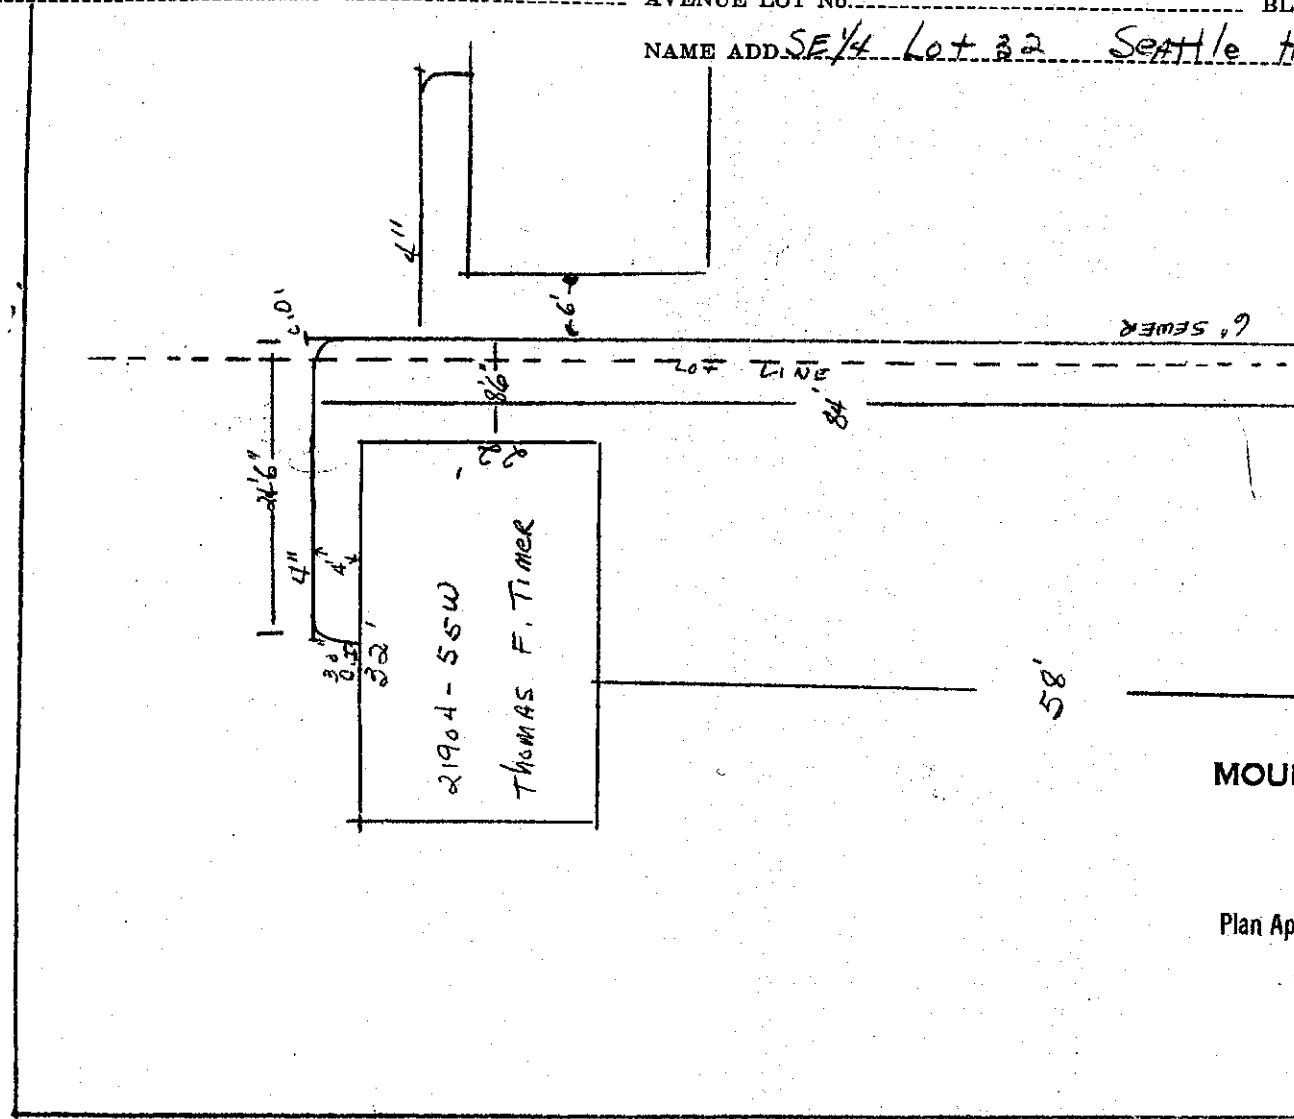NAME ADD. SE $\frac{1}{4}$ Lot 32 Seattle Heights GardensCITY OF
MOUNTLAKE TERRACE

MAY 16 1960

Plan Approved,

*S. M. Ahee*BACKFILL WORK ORDER ISSUED
SEWER WORK ORDER ISSUED

Date

DEPOSIT, \$10.00

Approved:
5/13/60
1449Approved:
5/13/60
1449

DATE

5-16-60

5/23/60 J. E. Moore

BY S. M. Holton IWS & N.C.

APPLICATION

The City of Mountlake Terrace

CARD No.

SIDE SEWER PERMIT

OUTSIDE INSIDE REPAIRS

EASEMENT No. 1357959

OWNER William Stubbs

CONTRACTOR By Owner

PERMIT NO. 854


HOUSE No. 21905 W 55

STREET

AVENUE LOT No. 29

BLOCK No.

NAME ADD. Seattle Heights Gardens

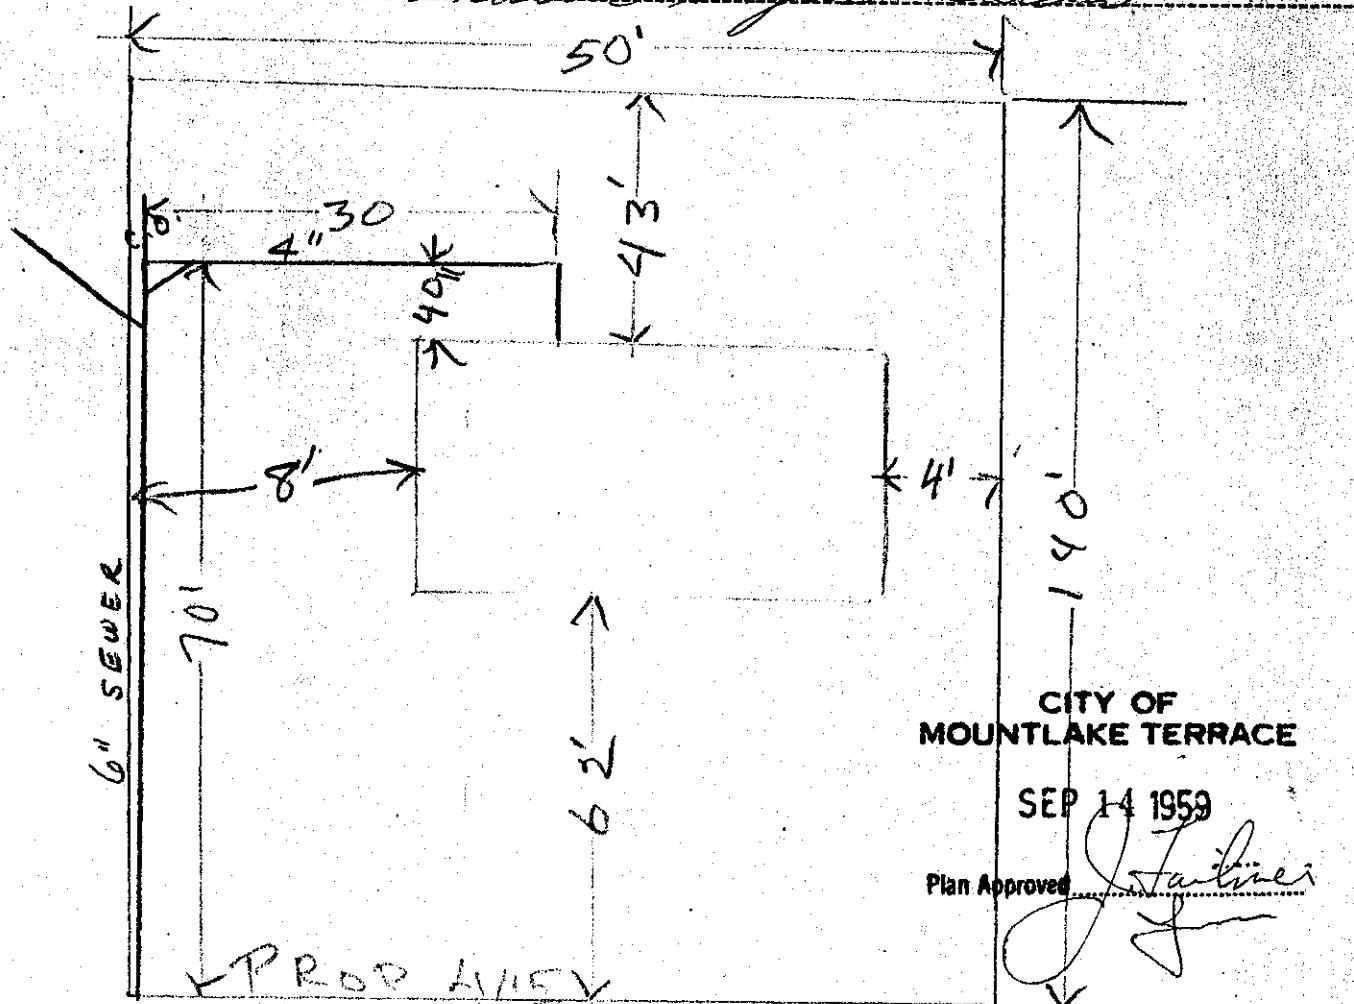

BACKFILL WORK ORDER ISSUED

Date

DEPOSIT, \$

10.00

SEWER WORK ORDER ISSUED

9-11-59

Rec 4731

Approved:

9/30/59

DATE

BY

B. J. Smith

The City of Mountlake Terrace

APPLICATION

for

SIDE SEWER PERMIT

OUTSIDE INSIDE REPAIRS

MELVIN E. BROWNLEE

CARD No.

EASEMENT No. None

OWNER: Melvin E. Brownlee
HOUSE NO. 22803 - 55th W.

CONTRACTOR: Wingfield - Brown

PERMIT NO.


1309

STREET
AVENUE LOT No. 2

BLOCK NO.

2
Div # 14

NAME ADD.

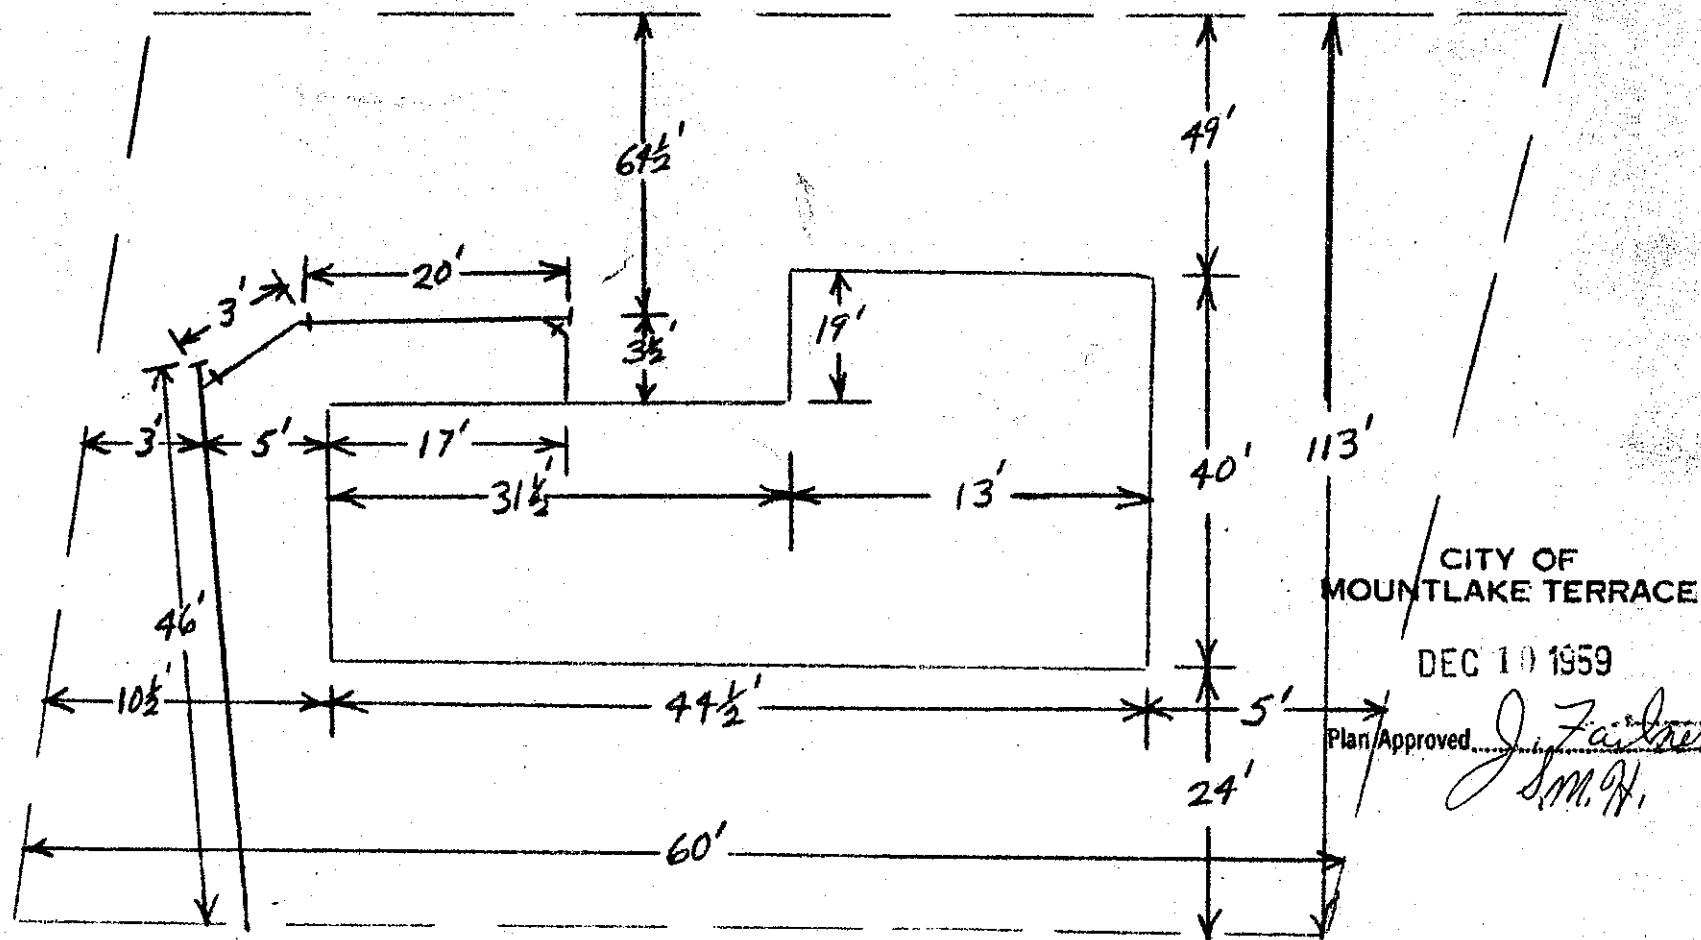

CITY OF
MOUNTLAKE TERRACE

DEC 10 1959

Plan Approved.

J. Fairner
S.M.H.

BACKFILL WORK ORDER ISSUED
SEWER WORK ORDER ISSUED

Date

DEPOSIT, \$10 ~~50~~

Approved:

12-9-59

S.S.B.2

DATE

12-10-59

BY

Scott M Holton, I.M.S.
D.C. N.C.

APPLICATION

for

SIDE SEWER PERMIT

The City of Mountlake Terrace

Margaret Whitehead

CARD No.

EASEMENT No. None

OWNER Margaret Whitehead
HOUSE NO. 22804-55th W.OUTSIDE INSIDE REPAIRS


PERMIT No. 2621

CONTRACTOR Walingfield - Brown
STREET 88th AVENUE LOT No. 9

BLOCK No. 1

Div. #14

NAME ADD.

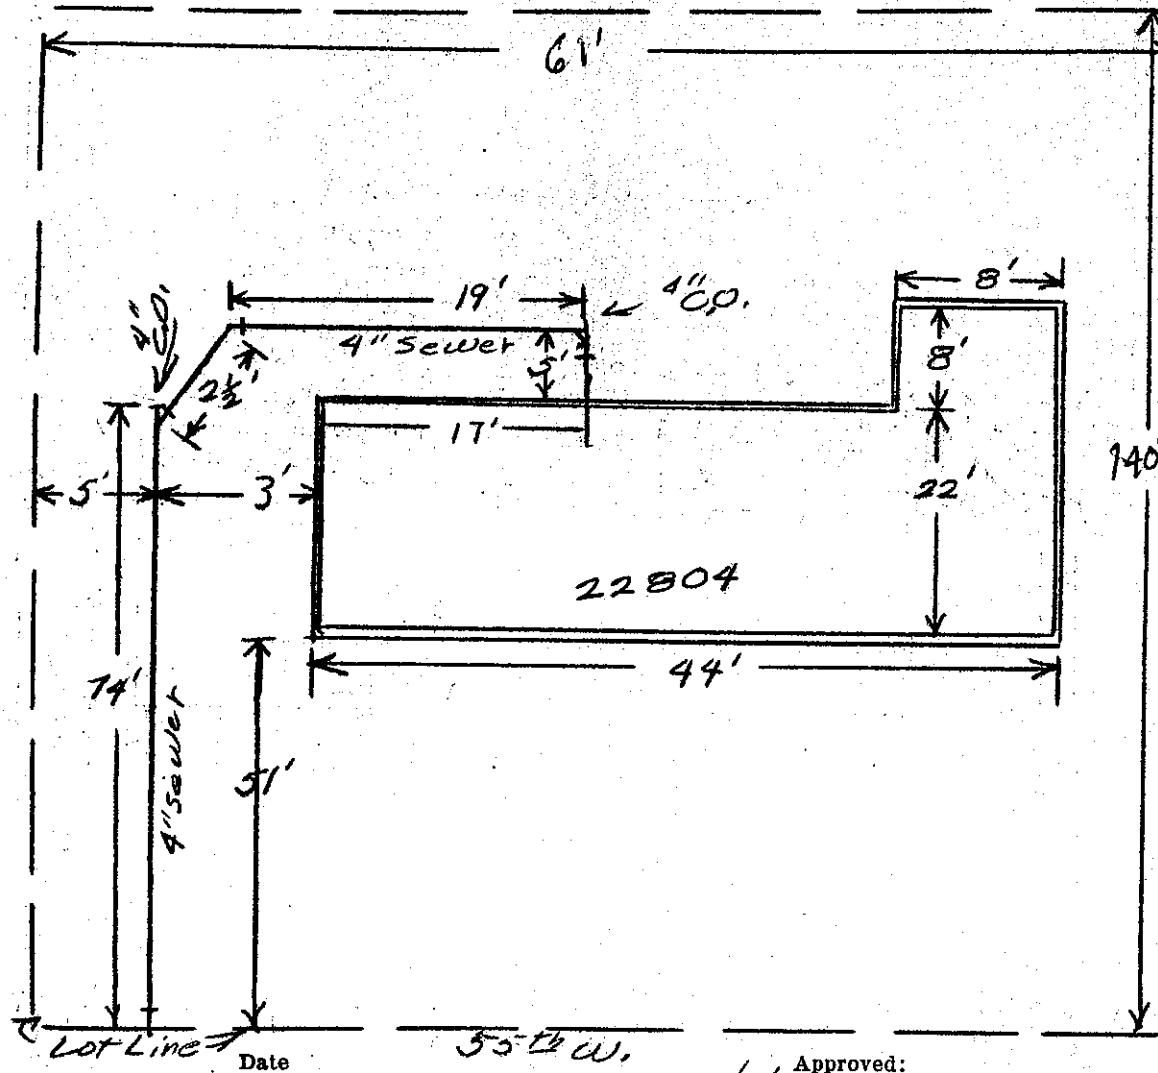

BACKFILL WORK ORDER ISSUED

DEPOSIT, \$10.00

Approved:
5/6/60

SEWER WORK ORDER ISSUED

1404

DATE 5-9-60

BY

S. M. Holton INST & CO

APPLICATION

for

SIDE SEWER PERMIT

The City of Mountlake Terrace

CARD No.

OUTSIDE INSIDE REPAIRS

EASEMENT No.

NONE

OWNER J.P. TRENT

HOUSE No. 22805 35th W.

CONTRACTOR WINGFIELD-BROWN


PERMIT No. 1265

STREET
AVENUE LOT NO. 3

BLOCK No. 9

NAME ADD.

Div. - #14

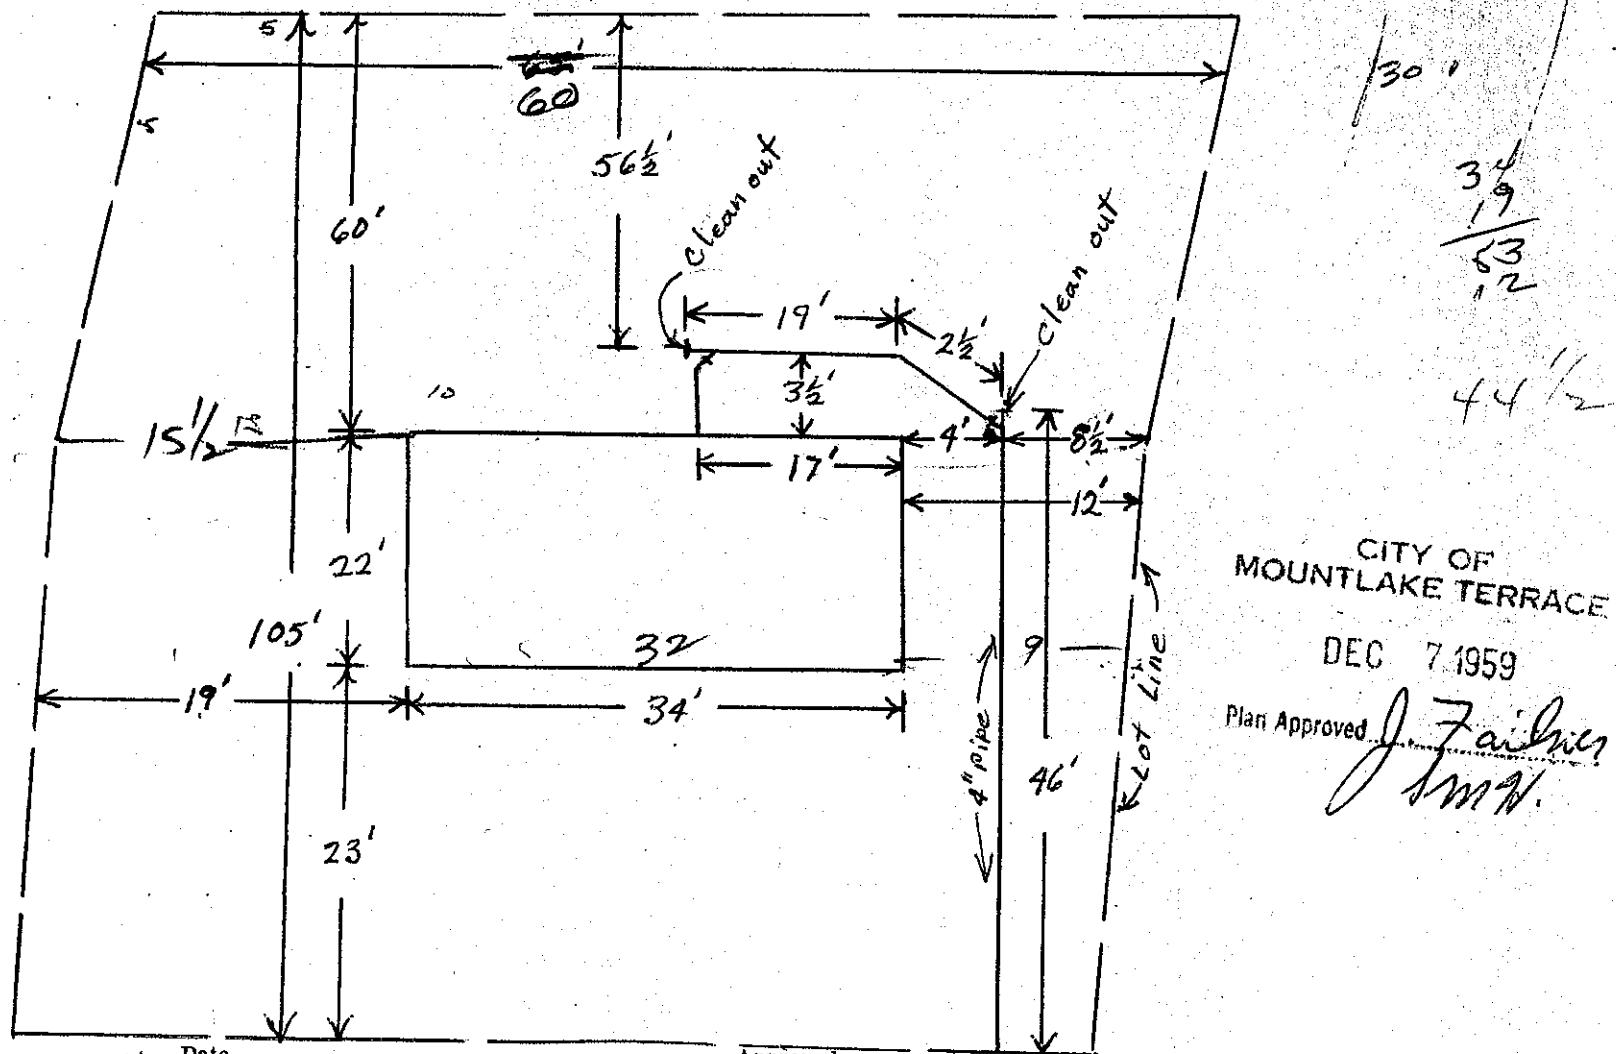CITY OF
MOUNTLAKE TERRACE

DEC 7 1959

Plan Approved

*J. Fairies**J. M. H.*

BACKFILL WORK ORDER ISSUED

DEPOSIT, \$

SEWER WORK ORDER ISSUED

DATE 12-7-59 BY Scott M Holton IWS

The City of Mountlake Terrace

APPLICATION

for

SIDE SEWER PERMIT

OUTSIDE INSIDE REPAIRS

CARD No.

BASEMENT No. None

INSTALLED FOR CITY

OWNER Chifton Nickers

HOUSE NO. 22806 - 55 1/2 W.

CONTRACTOR Wingfield

PERMIT NO. 462


STREET

AVENUE LOT NO. 8

BLOCK NO. 1

NAME ADD.

Div. # 14

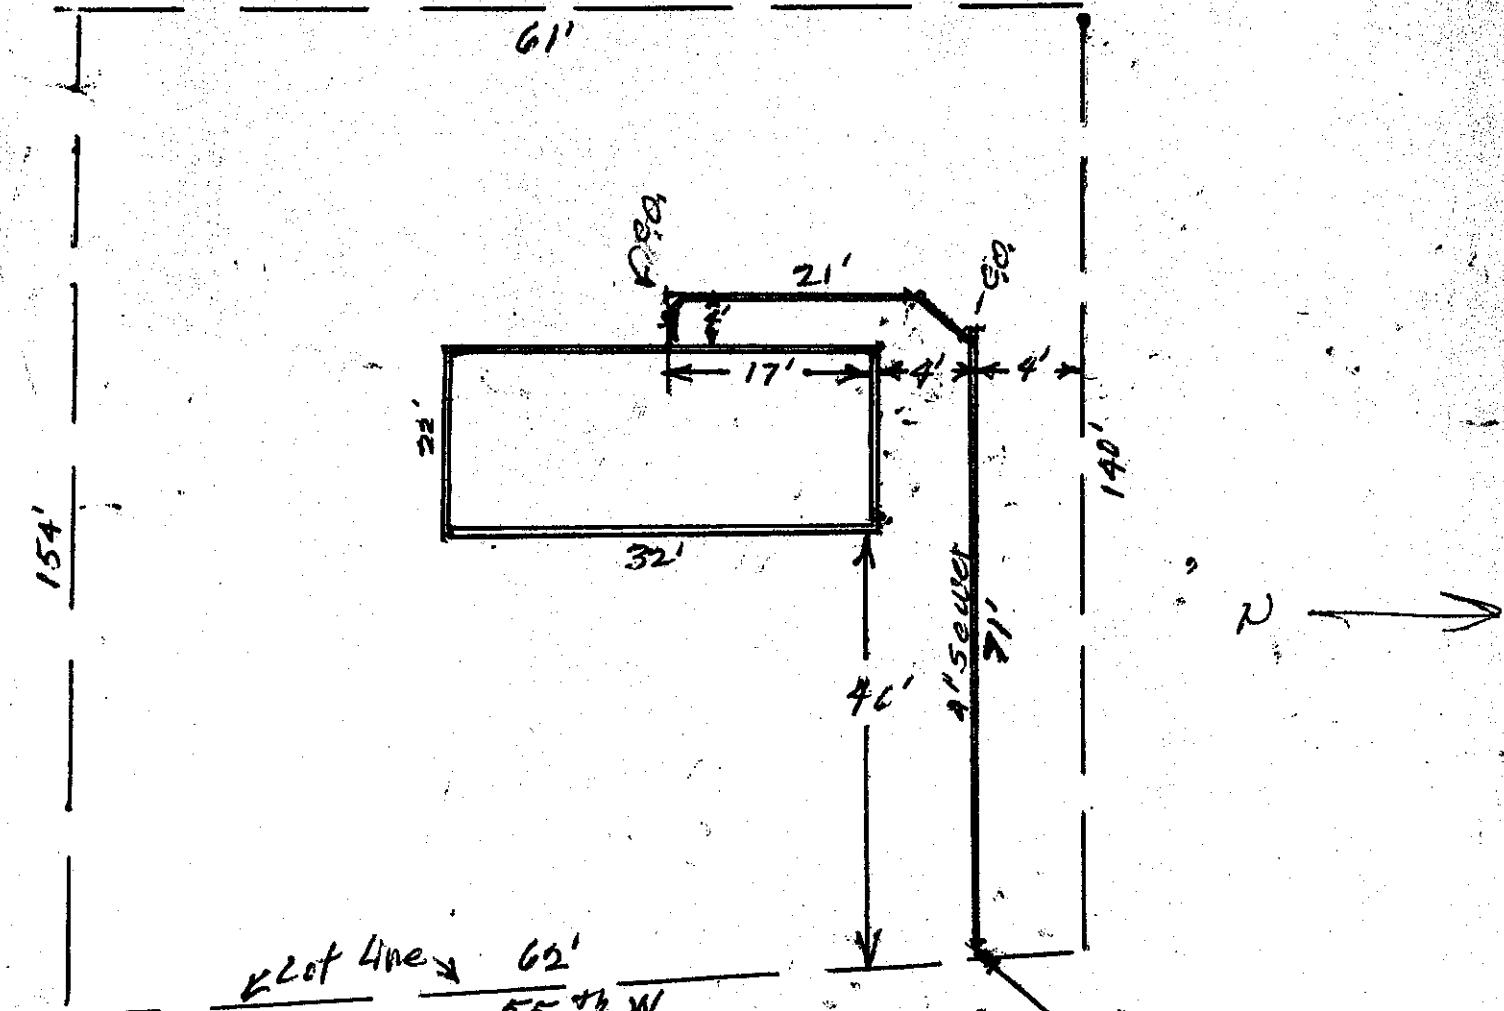

Date

Approved:

BACKFILL WORK ORDER ISSUED

DEPOSIT, \$10.00 8/26/60

SEWER WORK ORDER ISSUED

1825

DATE 8-26-60 BY S.M. Holton INS & CON

SM

APPLICATION

for

SIDE SEWER PERMIT

The City of Mountlake Terrace

CARD No.

OUTSIDE INSIDE REPAIRS


EASEMENT No.

OWNER C.M. Lewis
HOUSE NO. 22807 • 55th AV

CONTRACTOR _____

PERMIT No. 286STREET
AVENUE LOT No. 4BLOCK No. 2 Div No 14

NAME ADD. _____

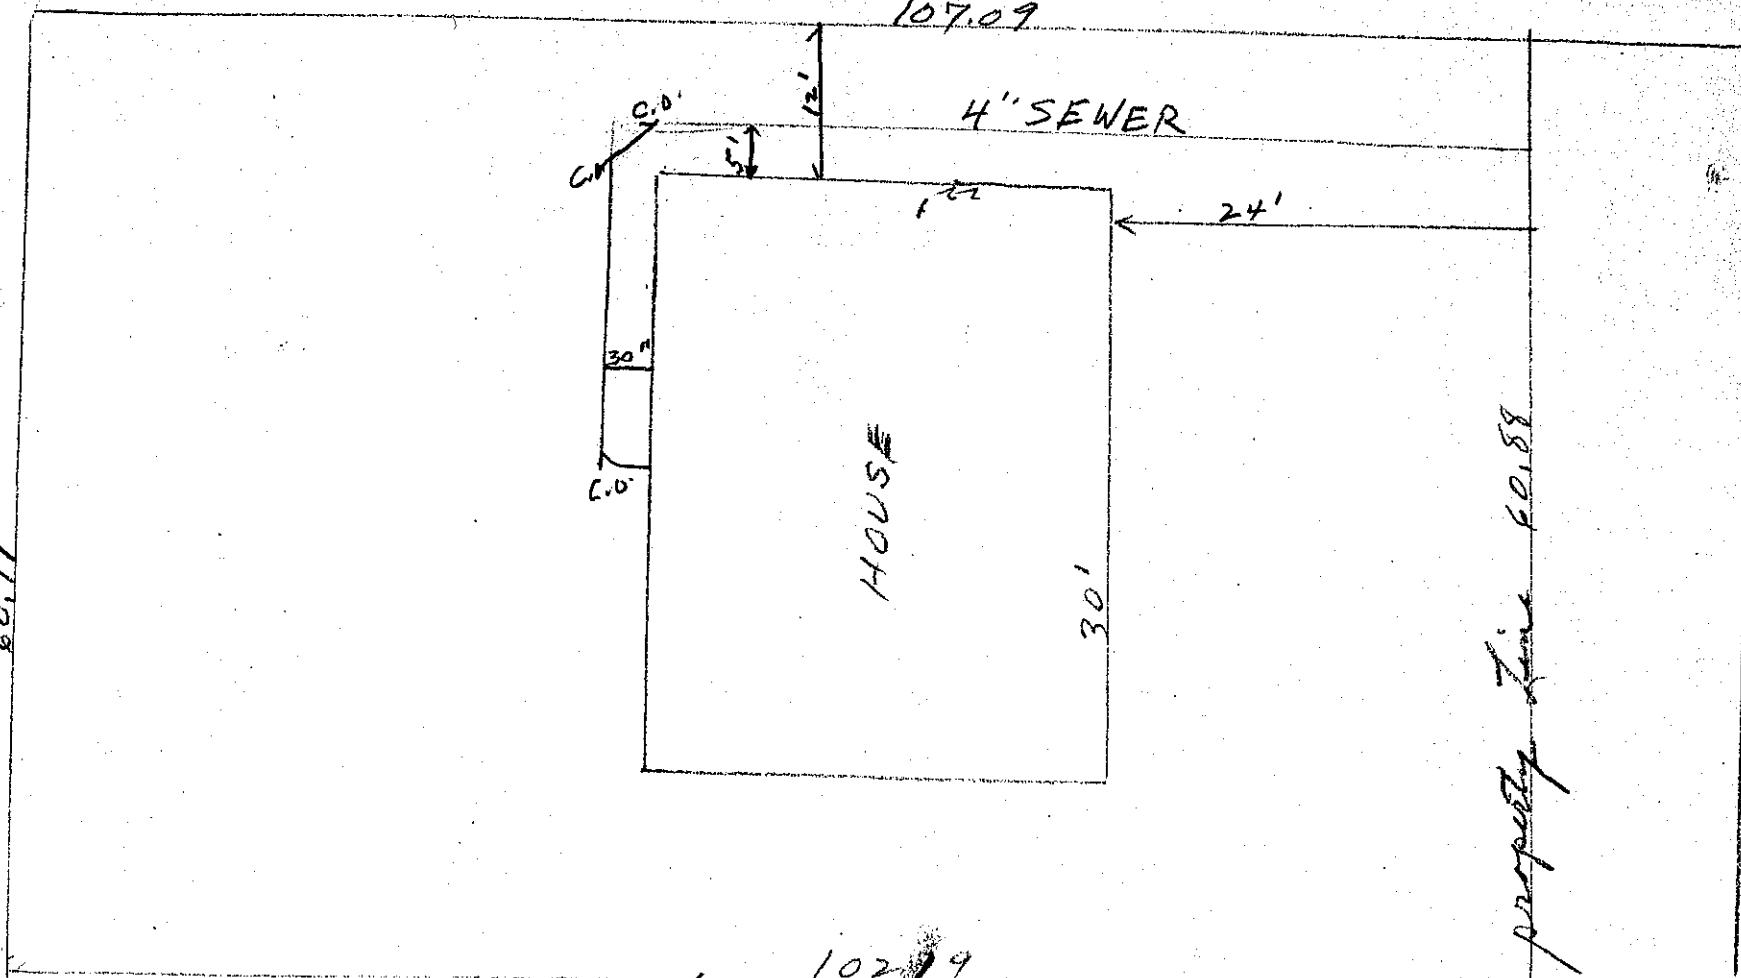Date 7/12/60

Approved:

BACKFILL WORK ORDER ISSUED

DEPOSIT, \$ 10.00

SEWER WORK ORDER ISSUED

7-14-60

DATE 7-22-60BY S. M. Holton INS+CW

APPLICATION

for

SIDE SEWER PERMIT

The City of Mountlake Terrace

CARD No.

OUTSIDE **INSIDE** **REPAIRS**

EASEMENT

OWNER A. Lymnfink
HOUSE No. 22810-55th W.

CONTRACTOR

STREET

AVENUE LOT No


PERMIT No. 1504

Bek 1

NAME ADD

NAME ADD 182.42.6.1

BLOCK NO.

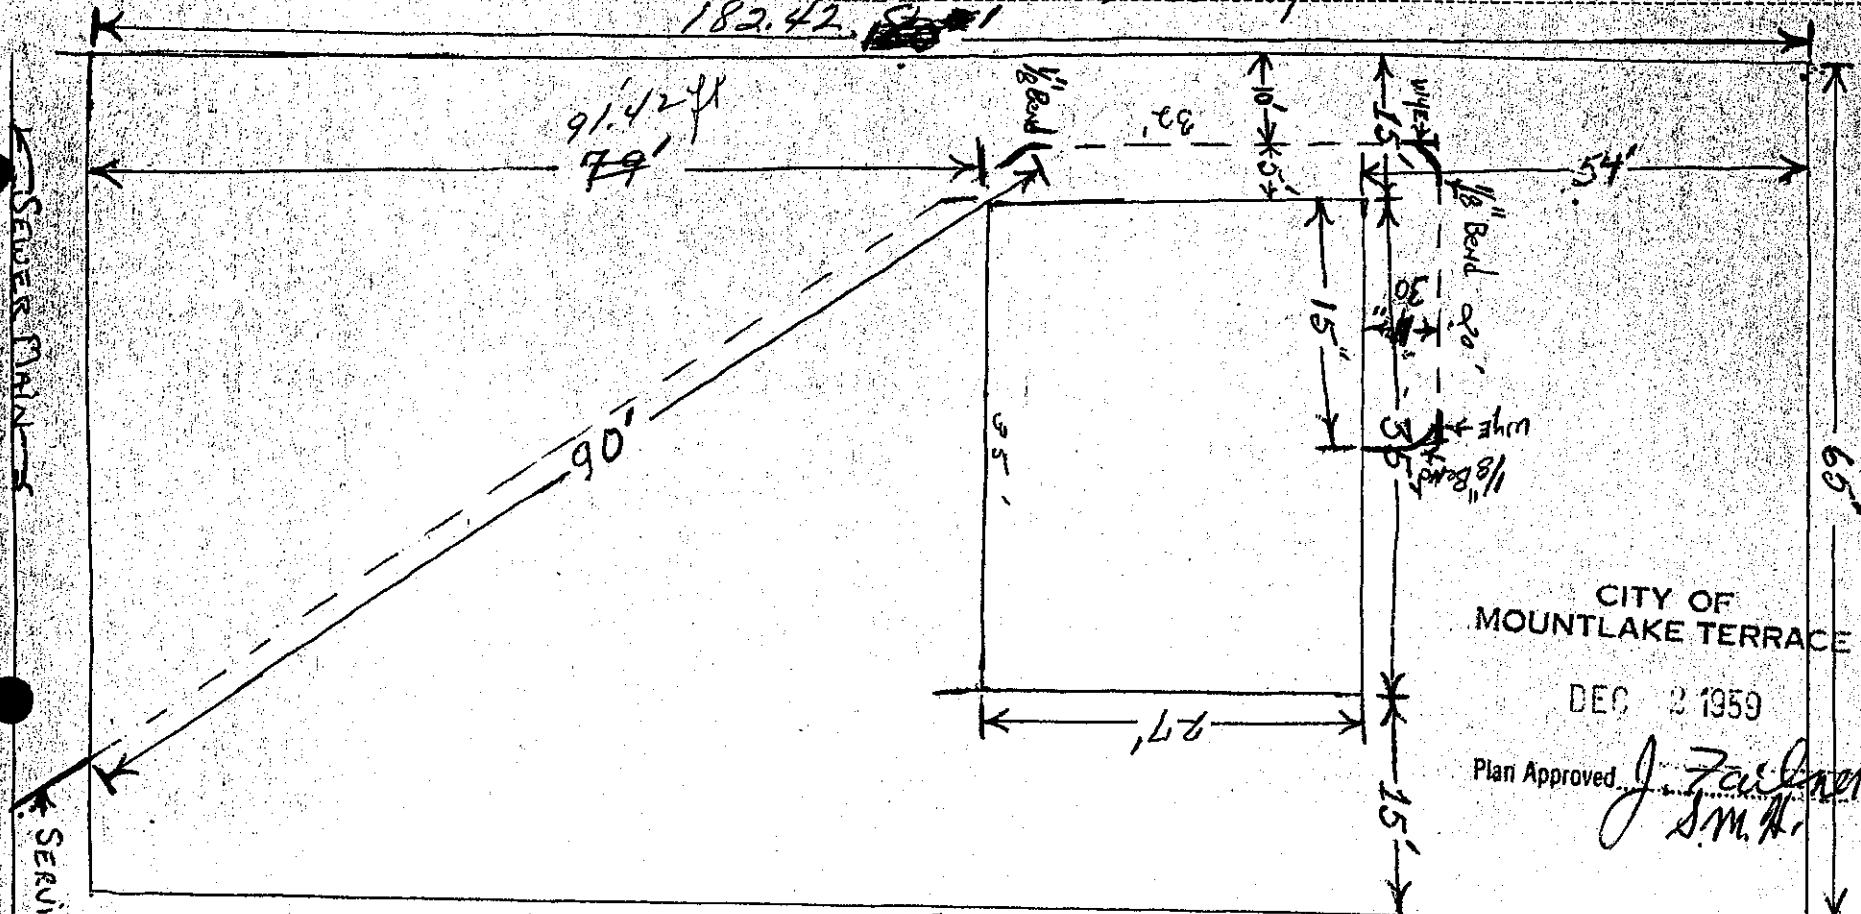

CITY OF
MOUNTLAKE TERRACE

DEC 23 1959

Plan Approved

BACKFILL WORK ORDER ISSUED.

DEPOSIT, \$

Approved:

BACKFILE WORK ORDER ISSUED.

~~10.00~~

DATE-12-7-59

SEWER WORK ORDER ISSUED.

丁

5426 DATE 12-7-
MAY 1961

Scott M Holton INS
NC

EARL JONES

The City of Mountlake Terrace

APPLICATION

for

SIDE SEWER PERMIT

OUTSIDE INSIDE REPAIRS

CARD No.

EASEMENT No. 1378383

OWNER Earl Jones
HOUSE No. 22901 - 55th W

CONTRACTOR B+E.


STREET
AVENUE LOT No. 6

- DIV - 14

BLOCK No. 2

PERMIT No. 2031

NAME ADD.

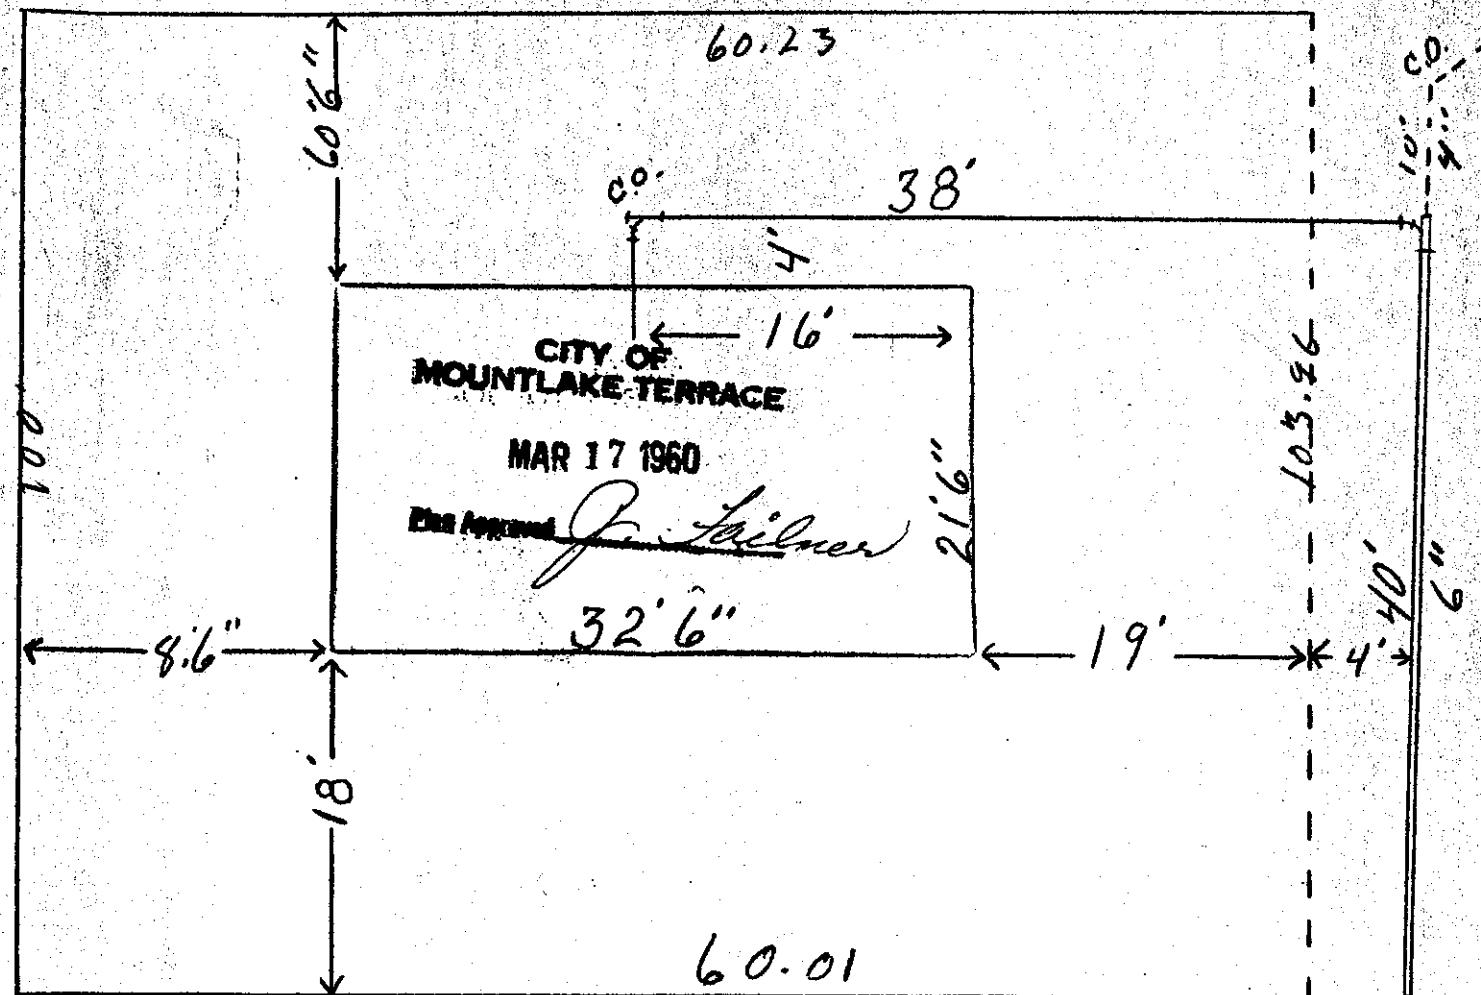

Date

Approved:

BACKFILL WORK ORDER ISSUED

DEPOSIT, \$

SEWER WORK ORDER ISSUED

DATE 3/18/00

BY

J. Fairman

The City of Mountlake Terrace

APPLICATION

for

SIDE SEWER PERMIT

OUTSIDE INSIDE REPAIRS

CARD No.

EASEMENT No. 1357264

OWNER C.P. Gravelle
HOUSE NO. 22902 - 55th W.


CONTRACTOR Wingfield - Brown

PERMIT No. 1168

STREET AVENUE LOT No. #9

DIV. #14 A
BLOCK No.

NAME ADD.

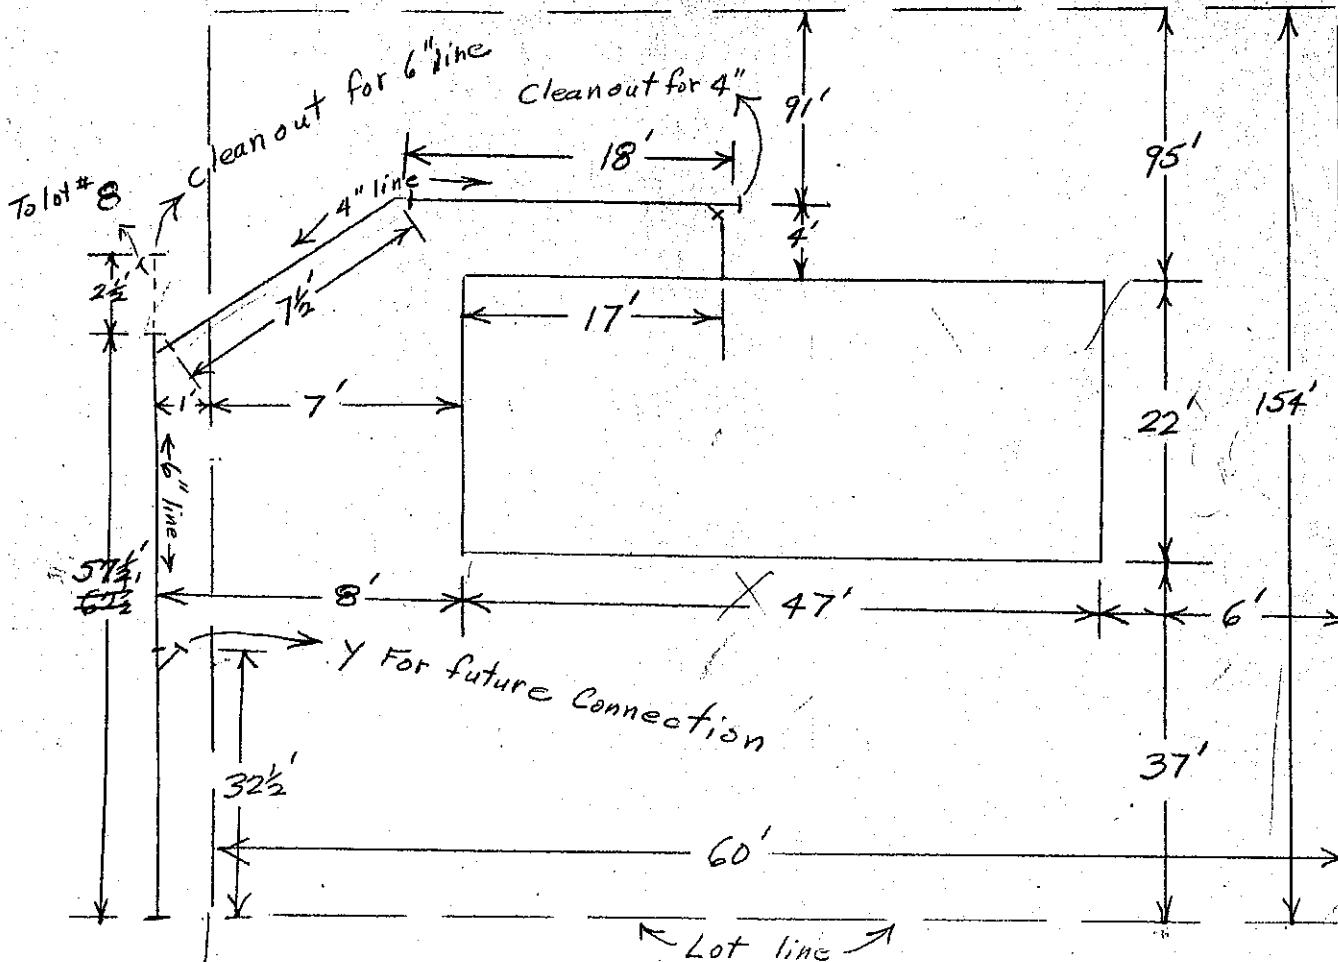

CITY OF
MOUNTLAKE TERRACE

NOV 25 1959

Plan Approved

J. Fairnes
S.M.G.

BACKFILL WORK ORDER ISSUED
SEWER WORK ORDER ISSUED

Date

DEPOSIT, \$10 ⁰⁰
5397

Approved:

11-17-59

DATE 11-25-59

BY Scott M Holton IWS
N.C.

The City of Mountlake Terrace

APPLICATION

for

SIDE SEWER PERMIT

OUTSIDE INSIDE REPAIRS

CARD No.

EASEMENT No. 1357269


OWNER Benning H. Rentfrow
HOUSE NO. 22904 - 55th W.

CONTRACTOR Wingfield - Brown
STREET # 8
AVENUE LOT NO.

PERMIT No. 1169

Div. # 14A
BLOCK No.

NAME ADD.

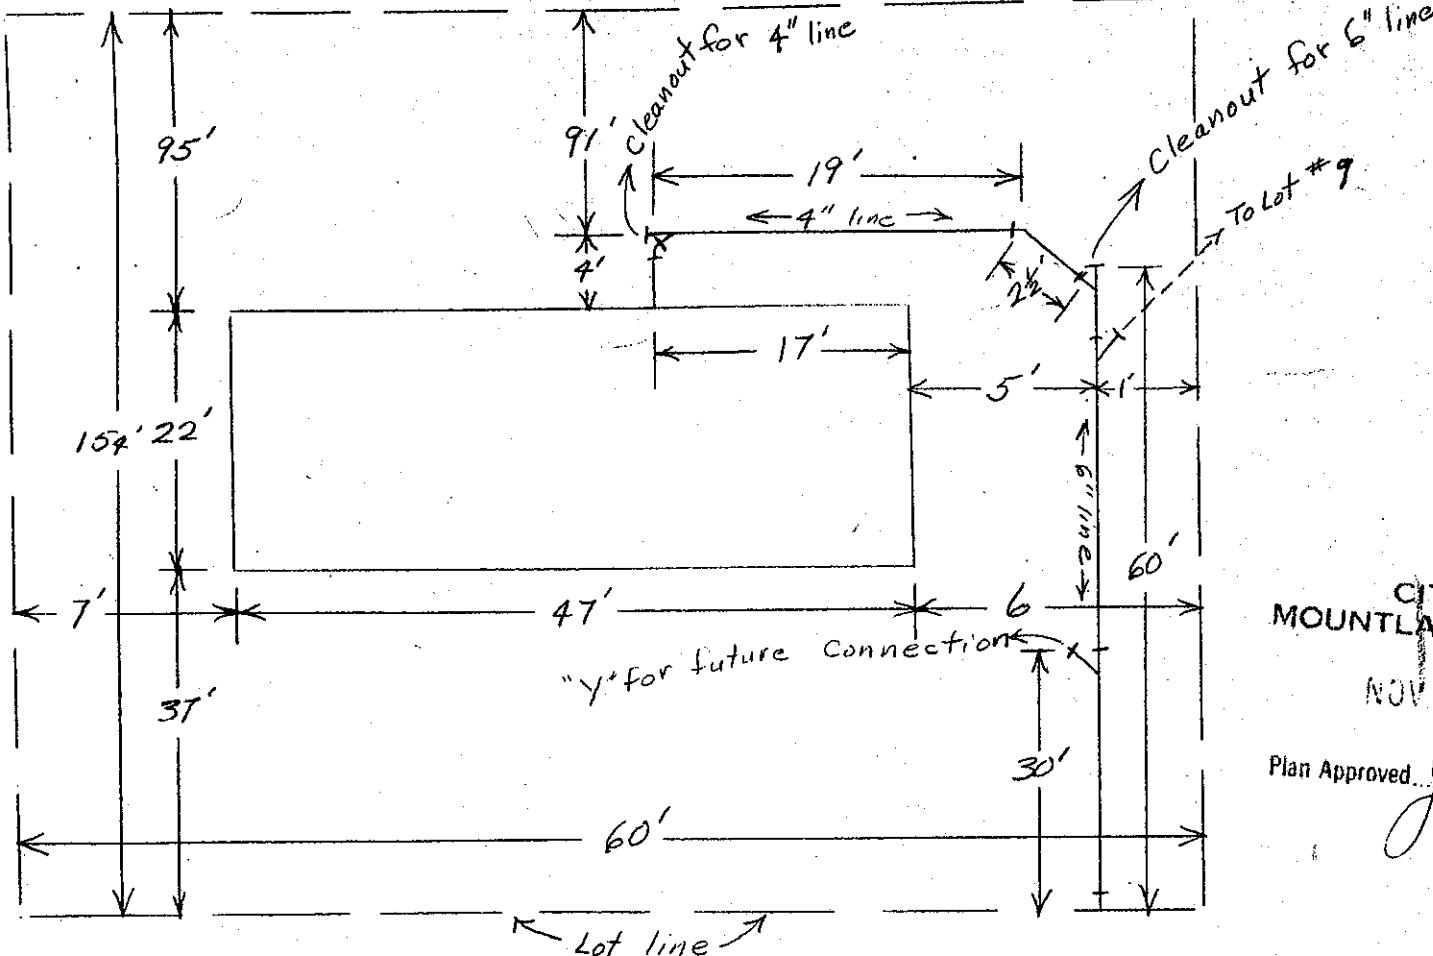

CITY OF
MOUNTLAKE TERRACE
NOV. 5 1959

Plan Approved

J. Gilmer
S.M.H.

BACKFILL WORK ORDER ISSUED
SEWER WORK ORDER ISSUED

Date

Approved:

DEPOSIT \$10⁰⁰ 11-17-59

5398

DATE 11-25-59 BY Scott M Holton MS
N.C.

APPLICATION

for

SIDE SEWER PERMIT

OUTSIDE INSIDE REPAIRS

HAROLD FARLIE

CARD No.

EASEMENT No. 1004

The City of Mountlake Terrace

OWNER HAROLD FARLIE
HOUSE No. 32906 55 1/2

CONTRACTOR WINGFIELD - BROWN


STREET AVENUE LOT NO. 7 2

NAME ADD.

PERMIT No. 1218

BLOCK No. 14

D 14-14

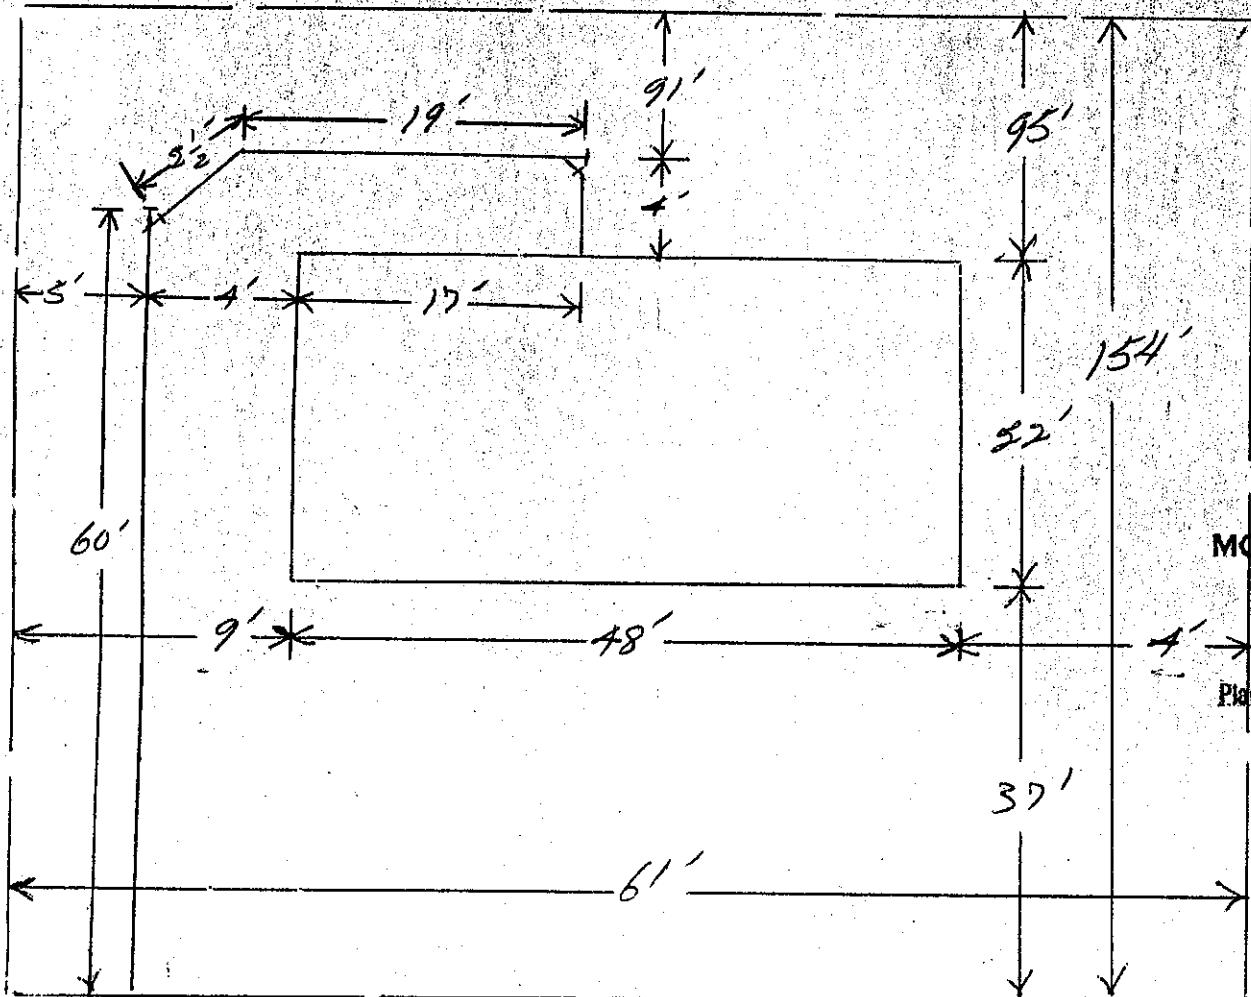

Date

Approved:

BACKFILL WORK ORDER ISSUED

DEPOSIT, \$ 10.00

SEWER WORK ORDER ISSUED

It 5446

DATE 11-30-59 BY

Scott M Holton M/S

S.A. FRINGER

CARD No.

The City of Mountlake Terrace

APPLICATION

for

SIDE SEWER PERMIT

OUTSIDE INSIDE REPAIRS

EASEMENT No.

OWNER Stanton A. FROGNER

CONTRACTOR L. O. FRANKELIN CO.

PERMIT NO. 1488


HOUSE NO. 22908 55th W

STREET

AVENUE LOT NO. 4

BLOCK NO.

NAME ADD Mountlake terrace Div. 1A -

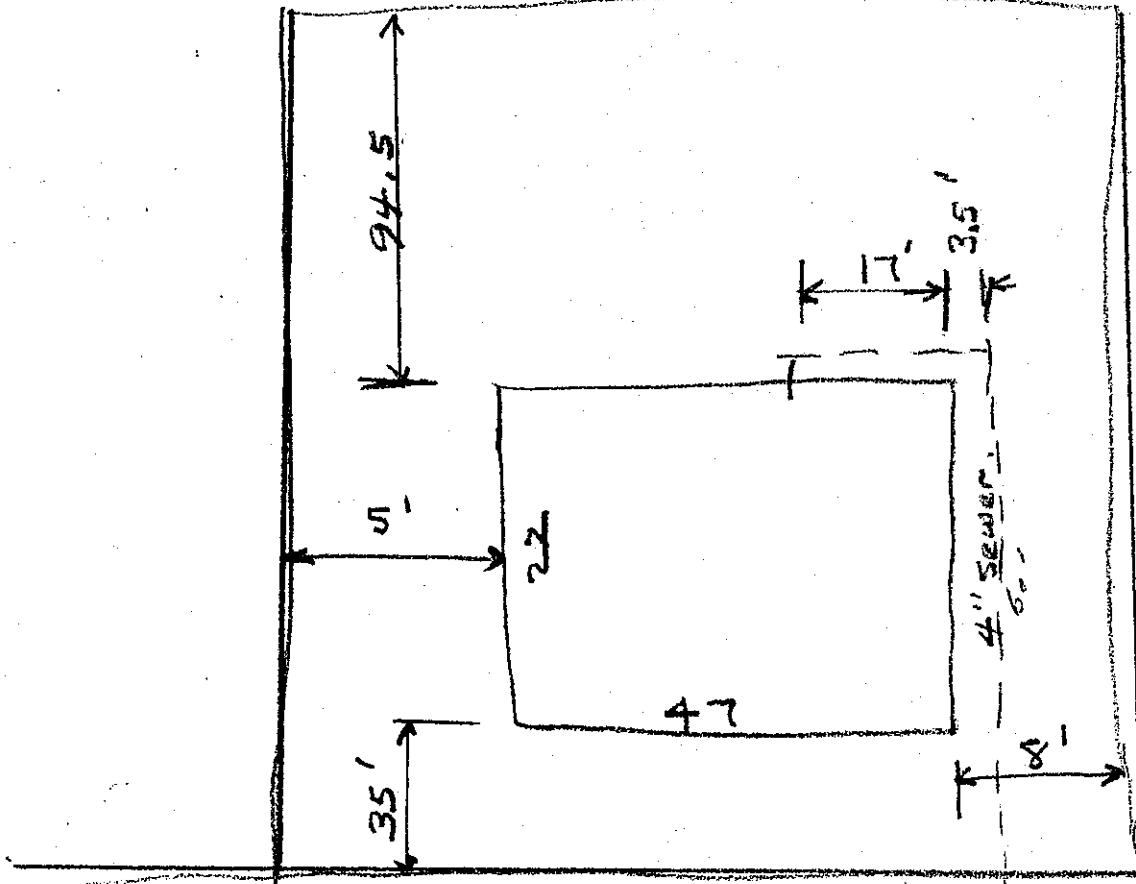

CITY OF
MOUNTLAKE TERRACE

JAN 21 1960

Plan Approved

55th W

Date

Approved:

BACKFILL WORK ORDER ISSUED

DEPOSIT, \$ 10.00

SEWER WORK ORDER ISSUED

-15763

DATE 1-21-60

BY

Scotton Holton INST+CO

APPLICATION

FOR

SIDE SEWER PERMIT

OUTSIDE INSIDE REPAIRS

CARD No.

EASEMENT No.

the City of Mountlake Terrace


OWNER _____
Tall Firs (Stop & Go)
HOUSE No. _____
23000 55 Ave W

CONTRACTOR _____

PERMIT NO. 44-42-77STREET
AVENUE LOT No. _____

BLOCK No. _____

NAME ADD

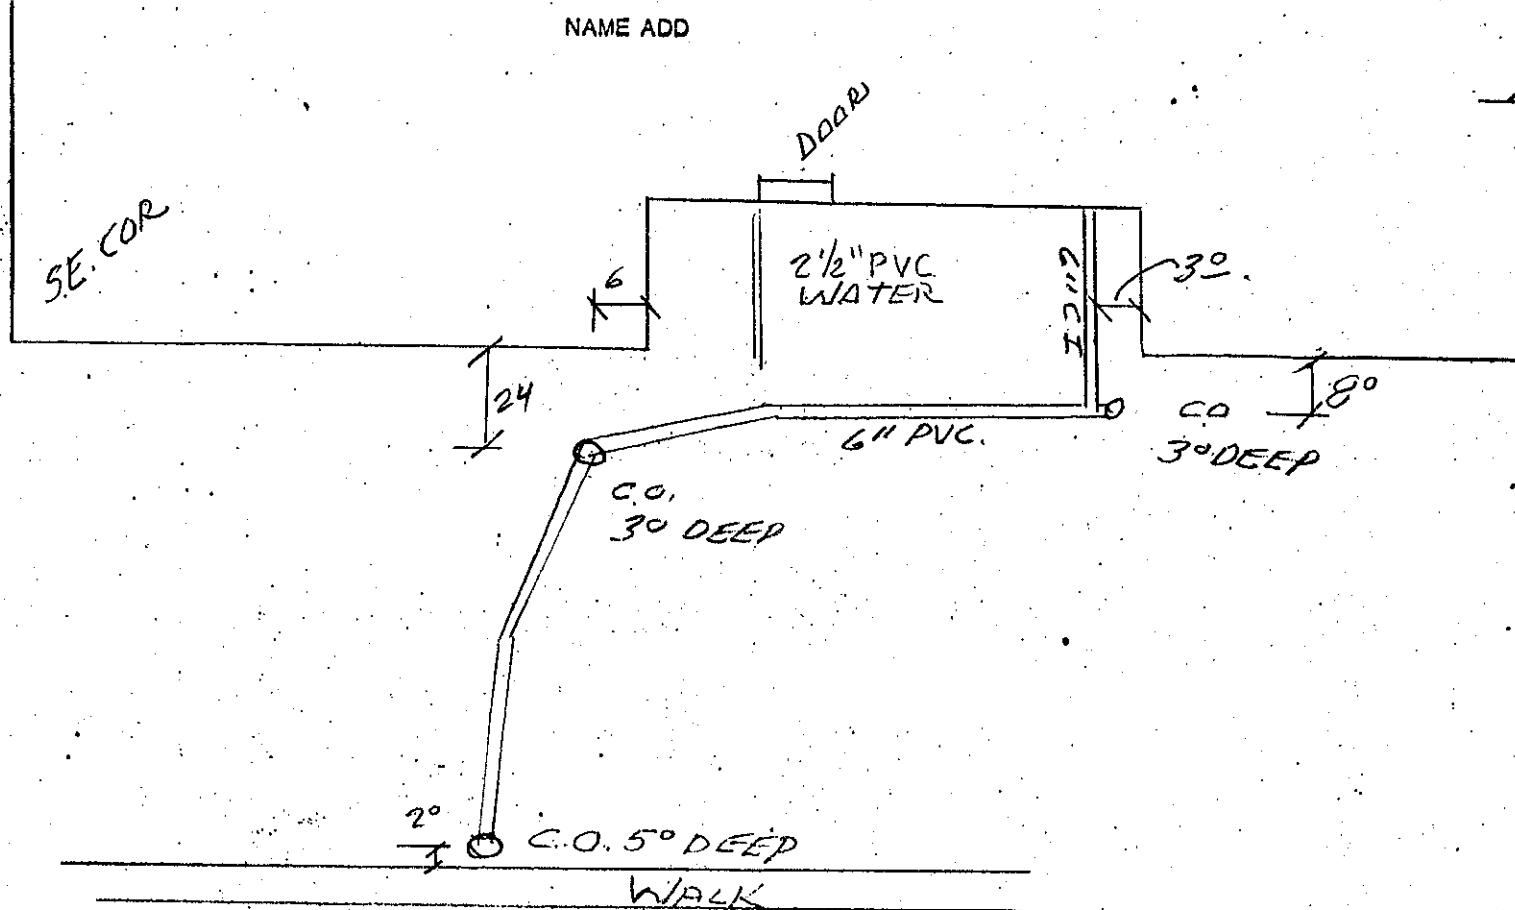23000 55TH AVE W

BACKFILL WORK ORDER ISSUED

Date

8-26-77

OWNER WORK ORDER ISSUED

8-25-77

DEPOSIT, \$

65.00

Approved:

DATE

P/M/144 ... 7/11-1977

APPLICATION

for

SIDE SEWER PERMIT

The City of Mountlake Terrace

CARD NO.

OUTSIDE INSIDE REPAIRS

EASEMENT No.

None


OWNER Helen I. Osborne
HOUSE No. 23003 - 55th W.CONTRACTOR Wingfield - Brown
STREET
AVENUE LOT No. 2

PERMIT No. 2238

BLOCK No. X 3

DIV. # X 14

NAME ADD.

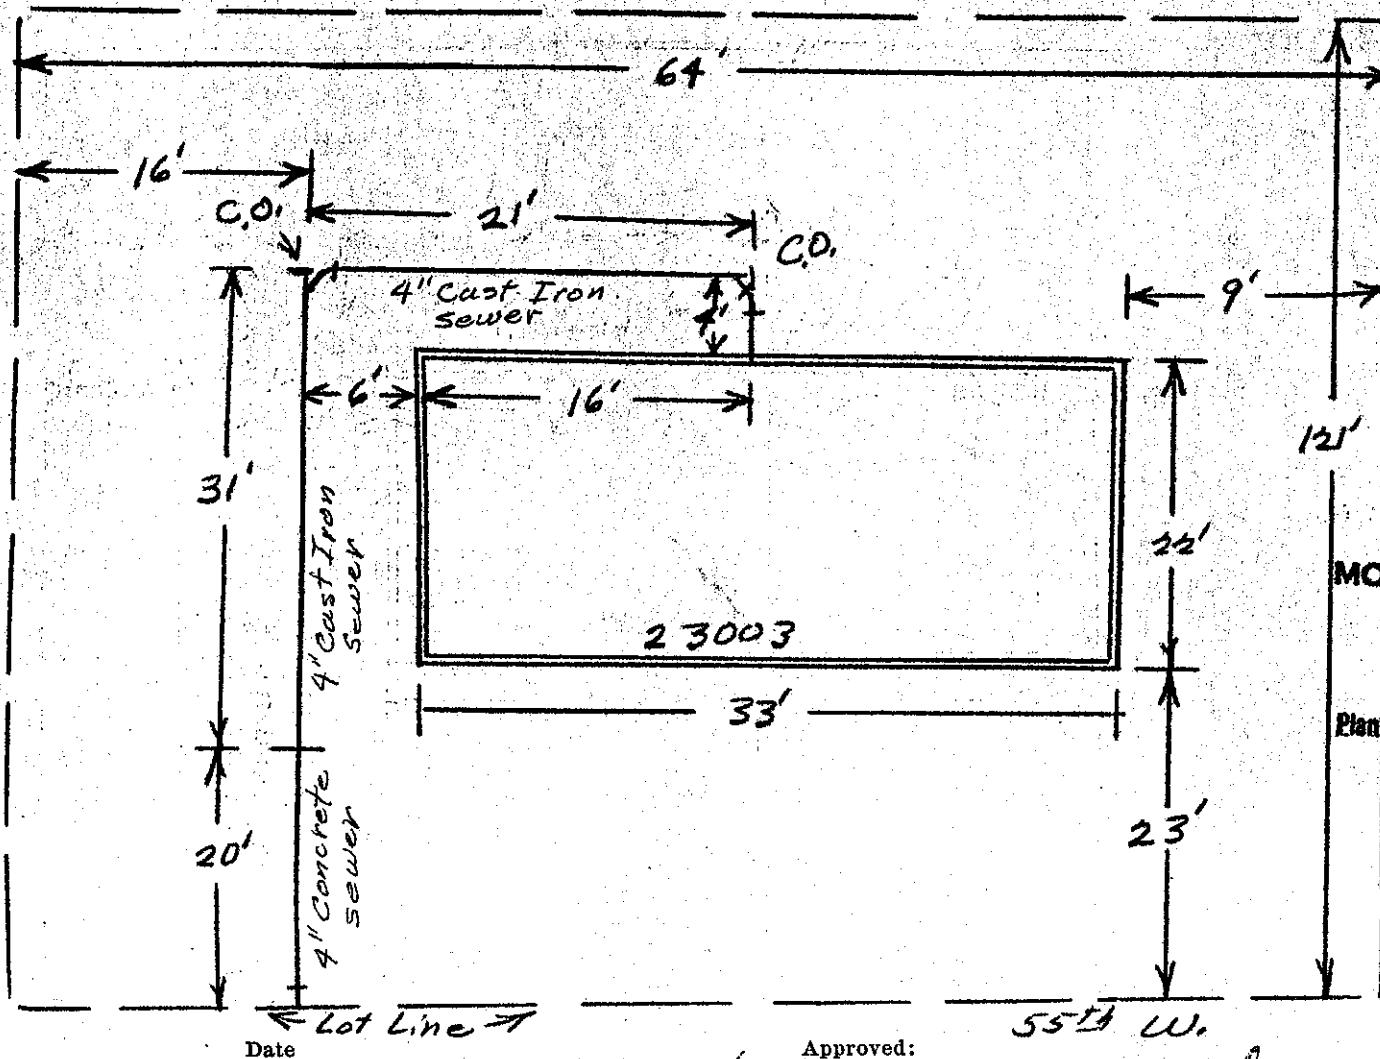CITY OF
MOUNTLAKE TERRACE

MAR 30 1960

Plan Approved _____

Date

Approved:

1044

DATE

3-31-60

BY

Scott M. Holloman, M.R.E.C.S.

BACKFILL WORK ORDER ISSUED

DEPOSIT, \$10.00 3/28/60


SEWER WORK ORDER ISSUED

APPLICATION

for

SIDE SEWER PERMIT

The City of Mountlake Terrace

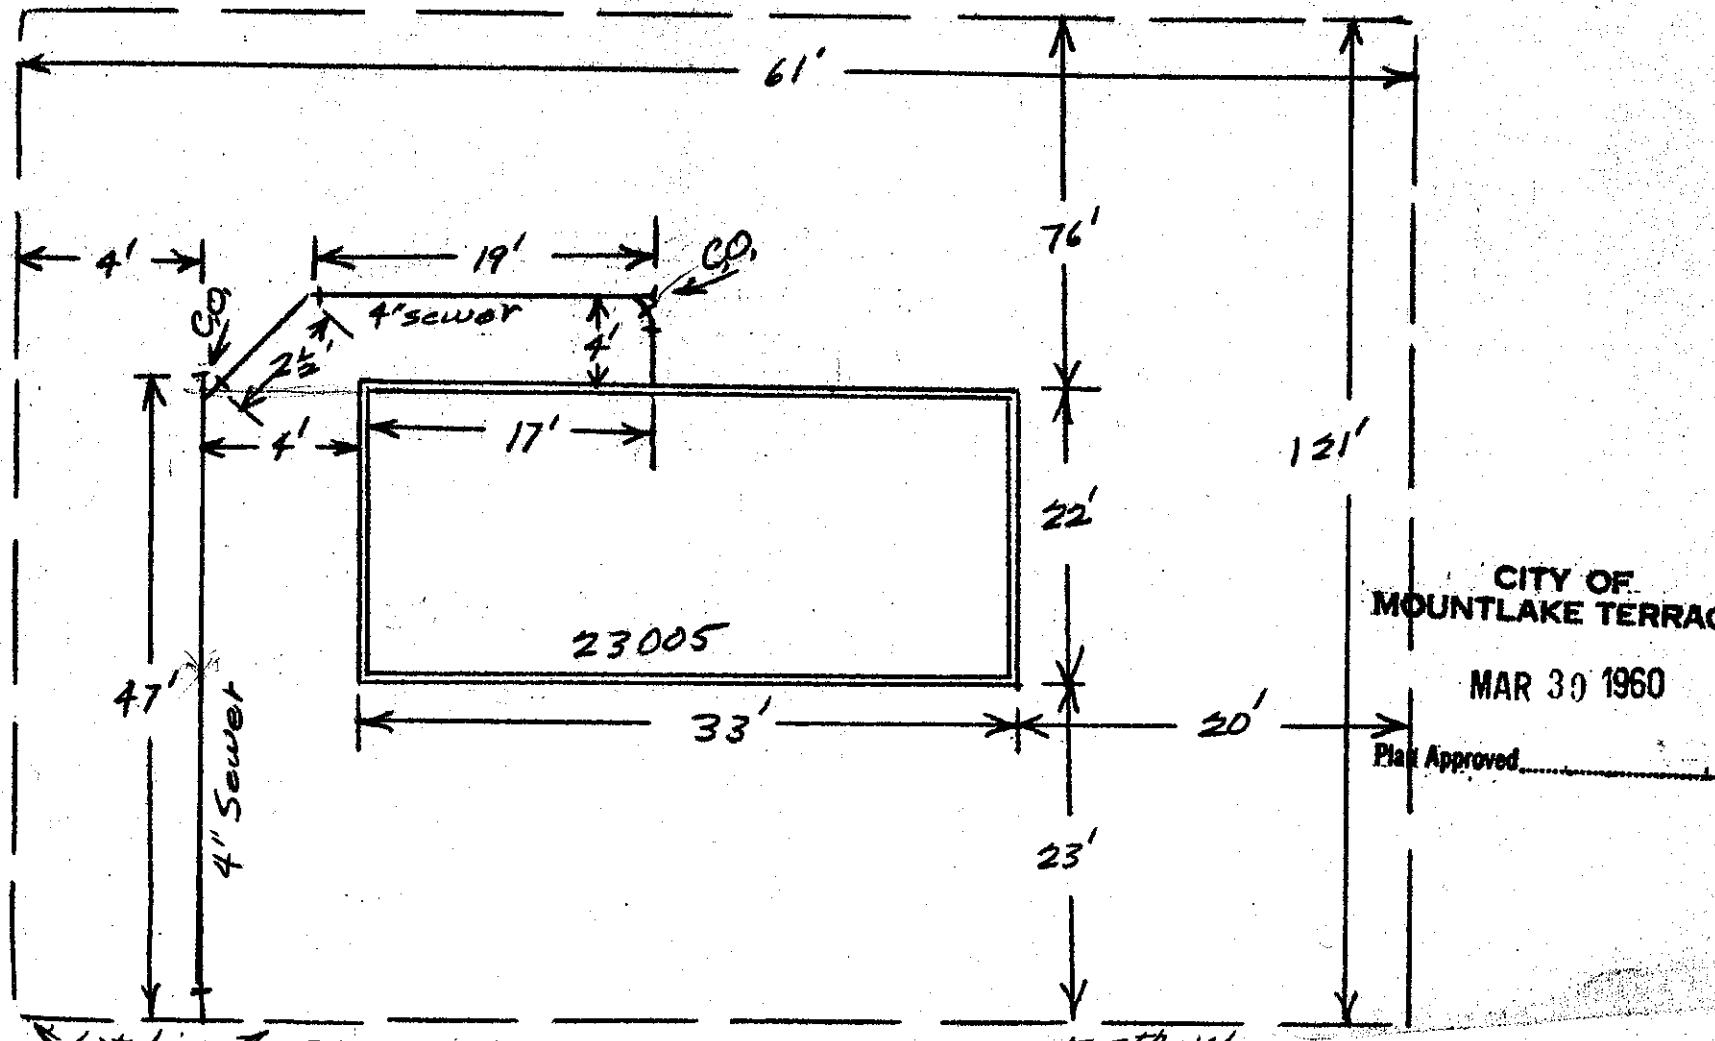T. A. Kitchens
CARD No.OUTSIDE INSIDE REPAIRS EASEMENT No. NoneOWNER Tom A. Kitchens
HOUSE No. 23005 - 55th W.CONTRACTOR Wingfield-Brown PERMIT No. 2257STREET 3 AVENUE LOT NO. 3 BLOCK NO. 3NAME ADD. Div. #X 14CITY OF
MOUNTLAKE TERRACE

MAR 30 1960

Plan Approved

BACKFILL WORK ORDER ISSUED

SEWER WORK ORDER ISSUED

DEPOSIT, \$10.00 3/28/60

Approved:

55th W.

DAP

The City of Mountlake Terrace

APPLICATION

for

SIDE SEWER PERMIT

OUTSIDE INSIDE REPAIRS

CARD NO.

EASEMENT No.

OWNER Mrs. Marvin Anderson
HOUSE No. 23007 - 55th W


CONTRACTOR Owner

STREET #4
AVENUE LOT NO. (#4)

PERMIT No. 3052

BLOCK NO. (#3) (DIV #4)

NAME ADD.

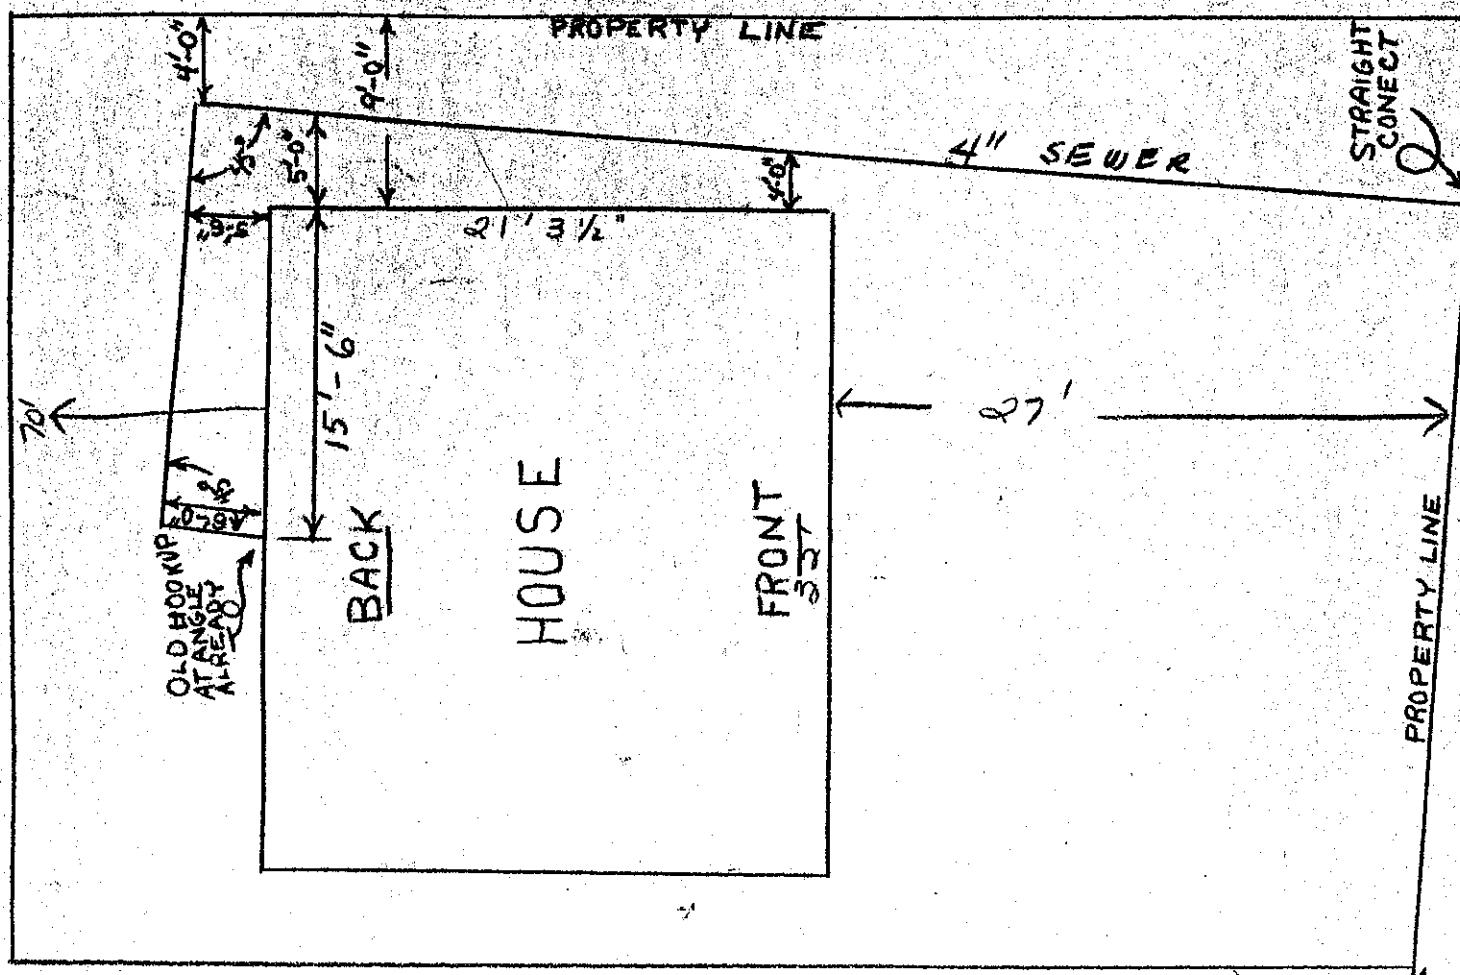

Date

Approved:

BACKFILL WORK ORDER ISSUED

DEPOSIT, \$10.00 3/18/60

SEWER WORK ORDER ISSUED

894

DATE 5/31/60

BY

R. M. Morris

APPLICATION

for

SIDE SEWER PERMIT

The City of Mountlake Terrace

OUTSIDE INSIDE REPAIRS

George Fischer Realty

CARD No.

EASEMENT No.

OWNER George Fischer Realty
HOUSE NO. 23009-55th W.

CONTRACTOR B. & E.

STREET AVENUE LOT NO. 5 DIV 14

PERMIT NO. 2257

BLOCK NO. 3


NAME ADD.

CITY OF MOUNTLAKE TERRACE

MAR 31 1960

Plan Approved

120.13

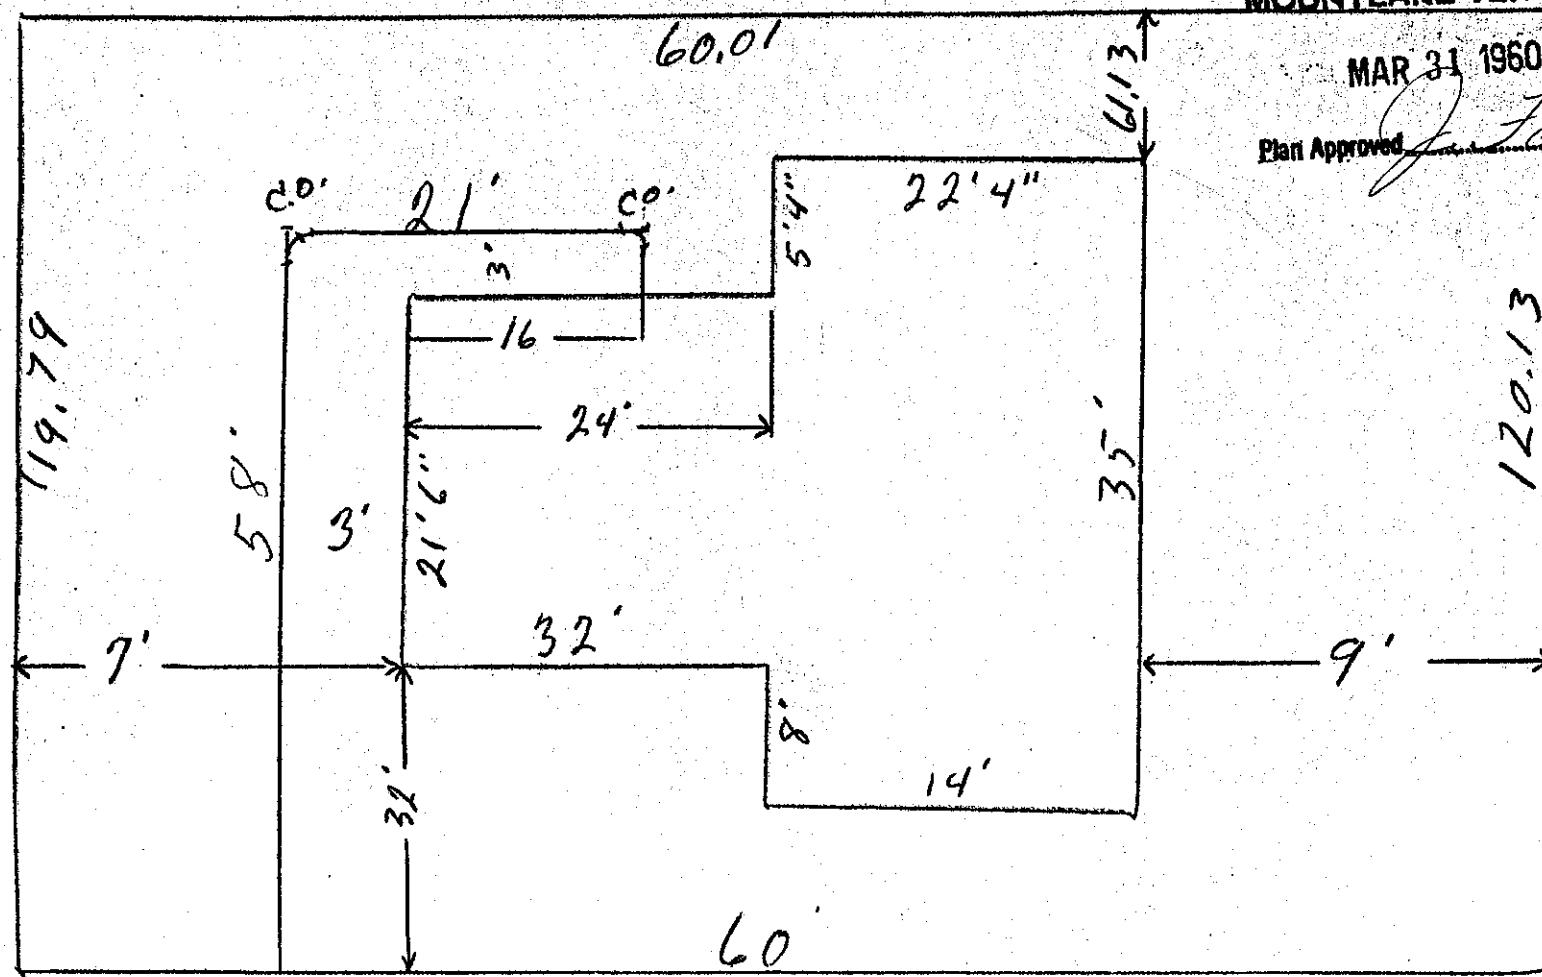

Date

Approved:

BACKFILL WORK ORDER ISSUED

DEPOSIT, \$10.00 3/29/60

SEWER WORK ORDER ISSUED

1055

DATE 4/1/60

BY

J. Laiher

The City of Mountlake Terrace

APPLICATION

for

SIDE SEWER PERMIT

OUTSIDE INSIDE REPAIRS

CARD No.

EASEMENT No. 1352696

OWNER ELIZABETH NOBLE


CONTRACTOR SELF

HOUSE NO. 23203-55TH. WEST

STREET
AVENUE LOT NO. 2

PERMIT NO. 26

BLOCK NO. 2

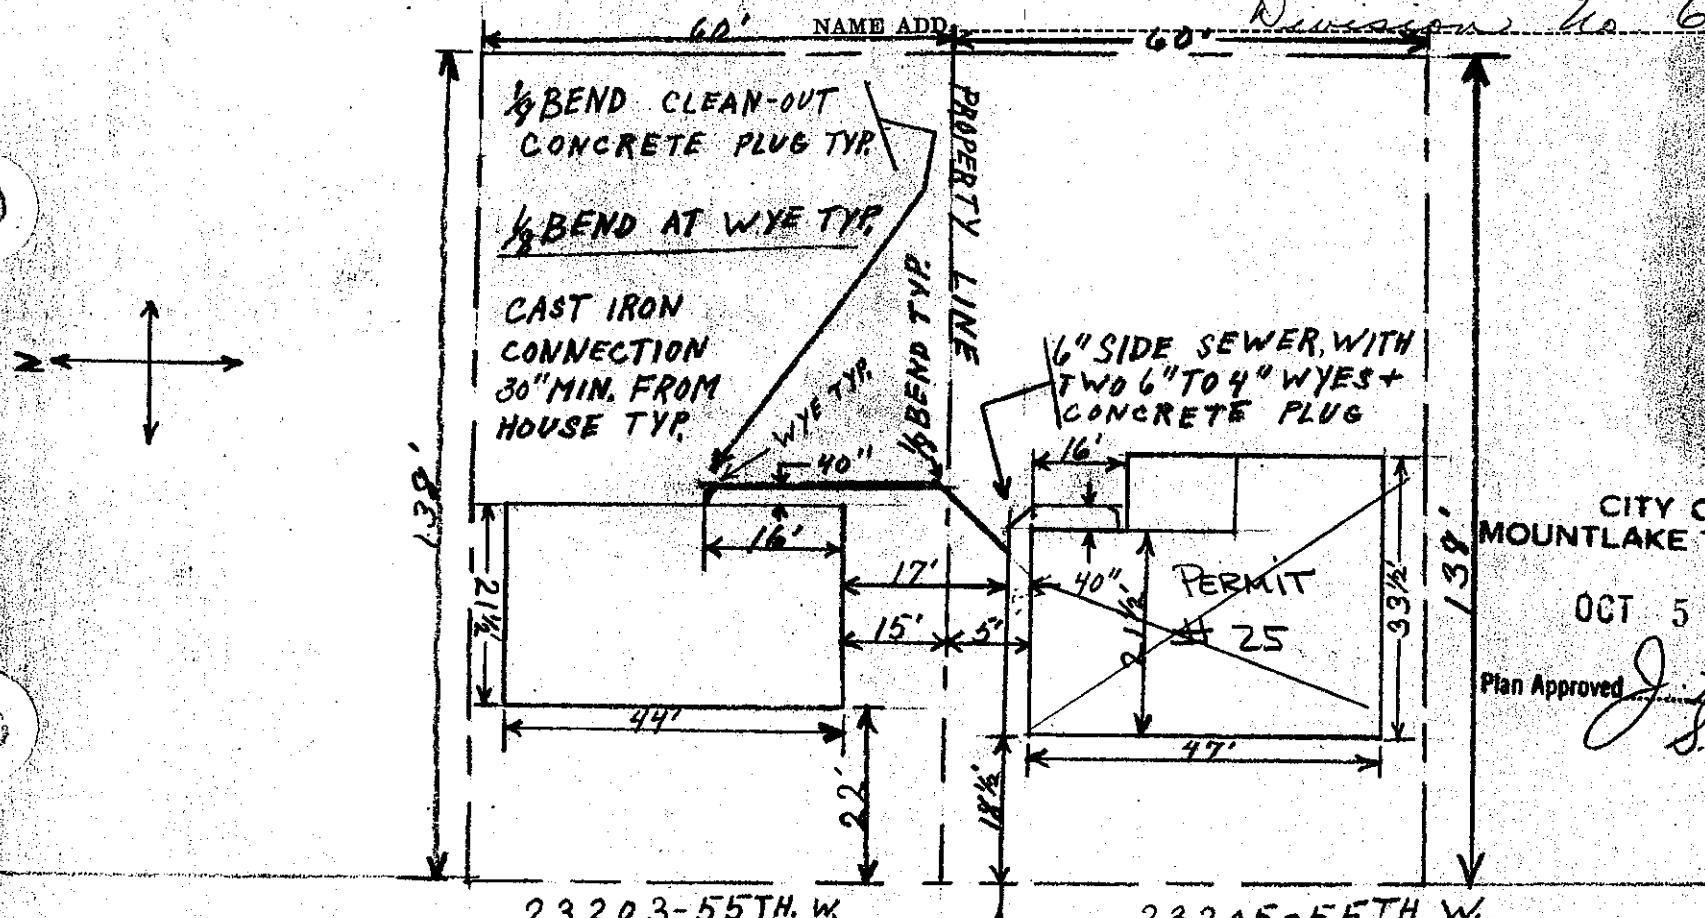

CITY OF MOUNTLAKE TERRACE

OCT 5 1959

Plan Approved

J. Fairless
S.M.H.

MAIN SEWER LINE

Date

Approved:

BACKFILL WORK ORDER ISSUED

DEPOSIT, \$10 8-18-59

SEWER WORK ORDER ISSUED

300

DATE 1-21-60 BY S. Scott m Holton INST CON

The City of Mountlake Terrace

APPLICATION

for

SIDE SEWER PERMIT

OUTSIDE INSIDE REPAIRS

CARD No.

EASEMENT No.

13526-26

OWNER MR. + MRS. THOMAS E. BYROM
HOUSE No. 23205-55TH. WEST

CONTRACTOR SELF

STREET AVENUE LOT NO. 3

PERMIT No. 25


BLOCK No. 2

No 6

NAME ADD.

Division
ALL 4" PIPE ON THIS
PROP TO BE CAST INN
POSSIBLE FUTURE
EXPANSION OF
HOUSE

6" SIDE SEWER, WITH
TWO 6" TO 4" WYES +
CONCRETE PLUG

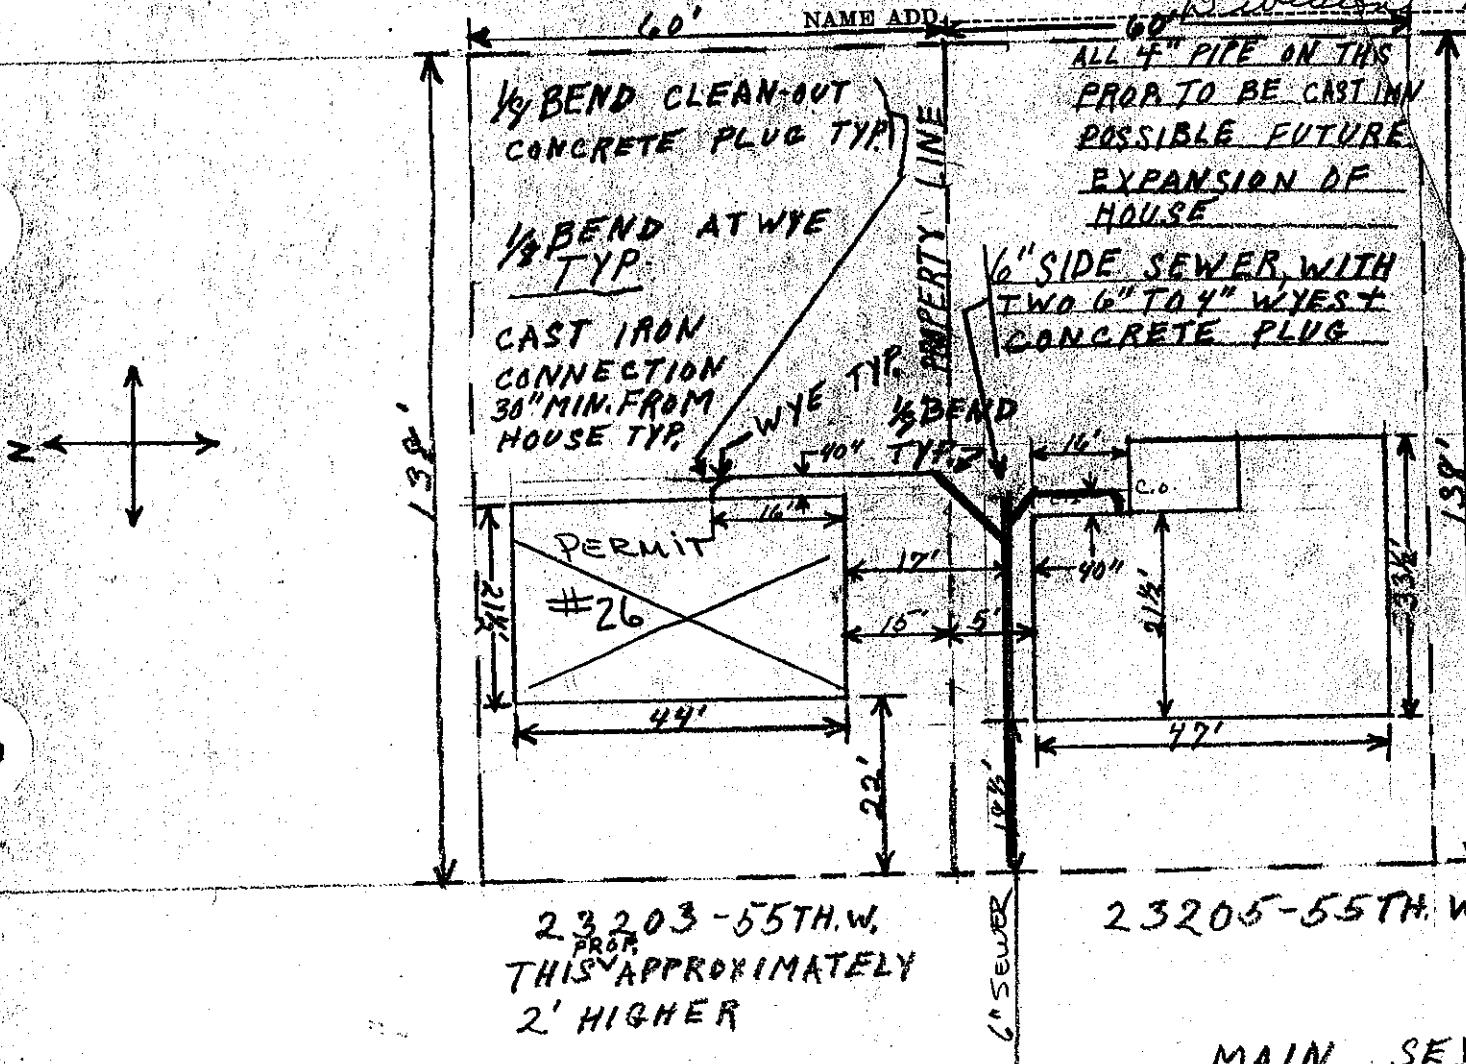

CITY OF
MOUNTLAKE TERRACE

OCT 5 1959

Plan Approved

J. Bainbridge
Sewer

Approved:

DATE 1-21-60

BY Scott M Holton INC

BACKFILL WORK ORDER ISSUED
SEWER WORK ORDER ISSUED

DEPOSIT, \$10.00 8/18/59
43906

R. T. HARRIS, JR.

CARD No.....

The City of Mountlake Terrace

APPLICATION

for

SIDE SEWER PERMIT

OUTSIDE INSIDE REPAIRS

EASEMENT No.....

OWNER Raymond T. HARRIS JR.
HOUSE NO. 2320 1/2 - 55th West

CONTRACTOR

PERMIT NO. 938


STREET
AVENUE LOT No. 55th West Lot 18

BLOCK No. 1

NAME ADD.

T. Section for cleanout.

DIV. 6

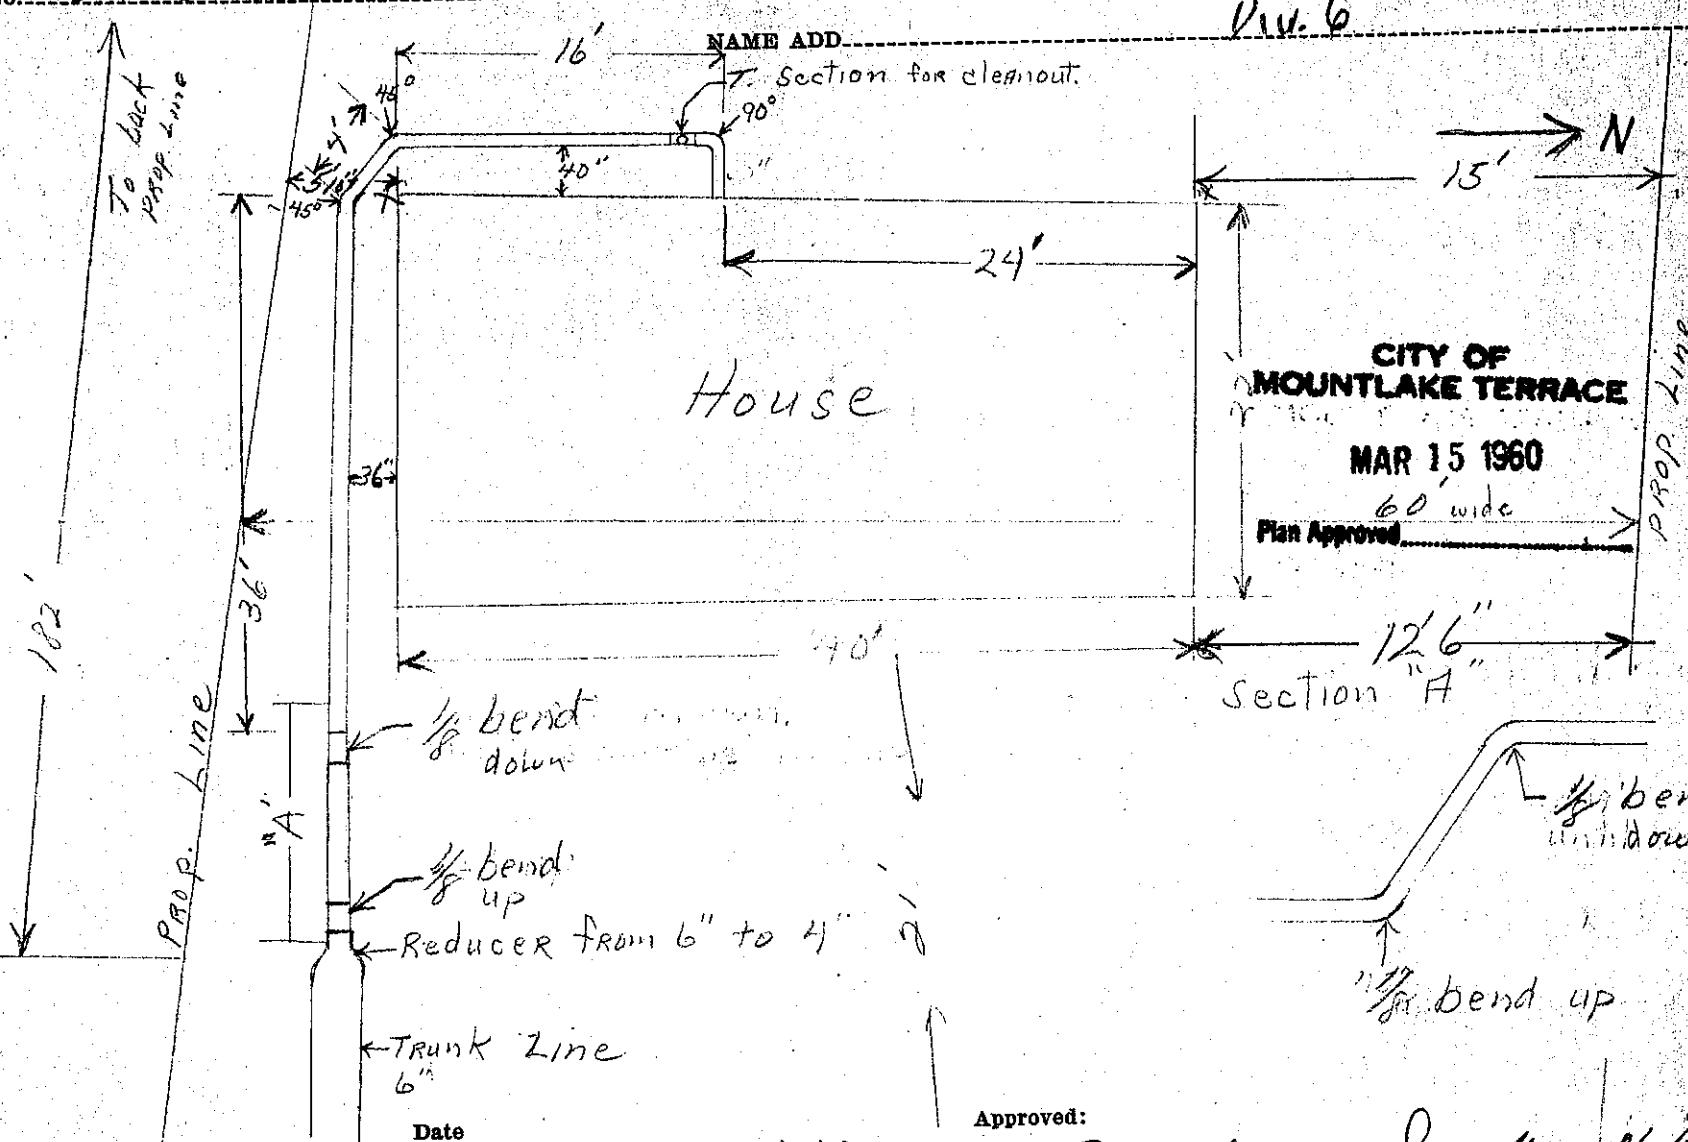

BACKFILL WORK ORDER ISSUED

SEWER WORK ORDER ISSUED

Date

DEPOSIT, \$ 10.00

3/11/60

Approved:

DATE

3-16-60

BY

Scott McHoltz Instco

The City of Mountlake Terrace

APPLICATION

for

SIDE SEWER PERMIT

OUTSIDE INSIDE REPAIRS

B.R. Willis
CARD No.

EASEMENT No.

OWNER B.R. Willis

HOUSE NO. 23207-55th W. M.L.T.

CONTRACTOR B&E.

PERMIT No. 1492


STREET

AVENUE LOT NO.

4 DIV 6

BLOCK NO. 2

NAME ADD

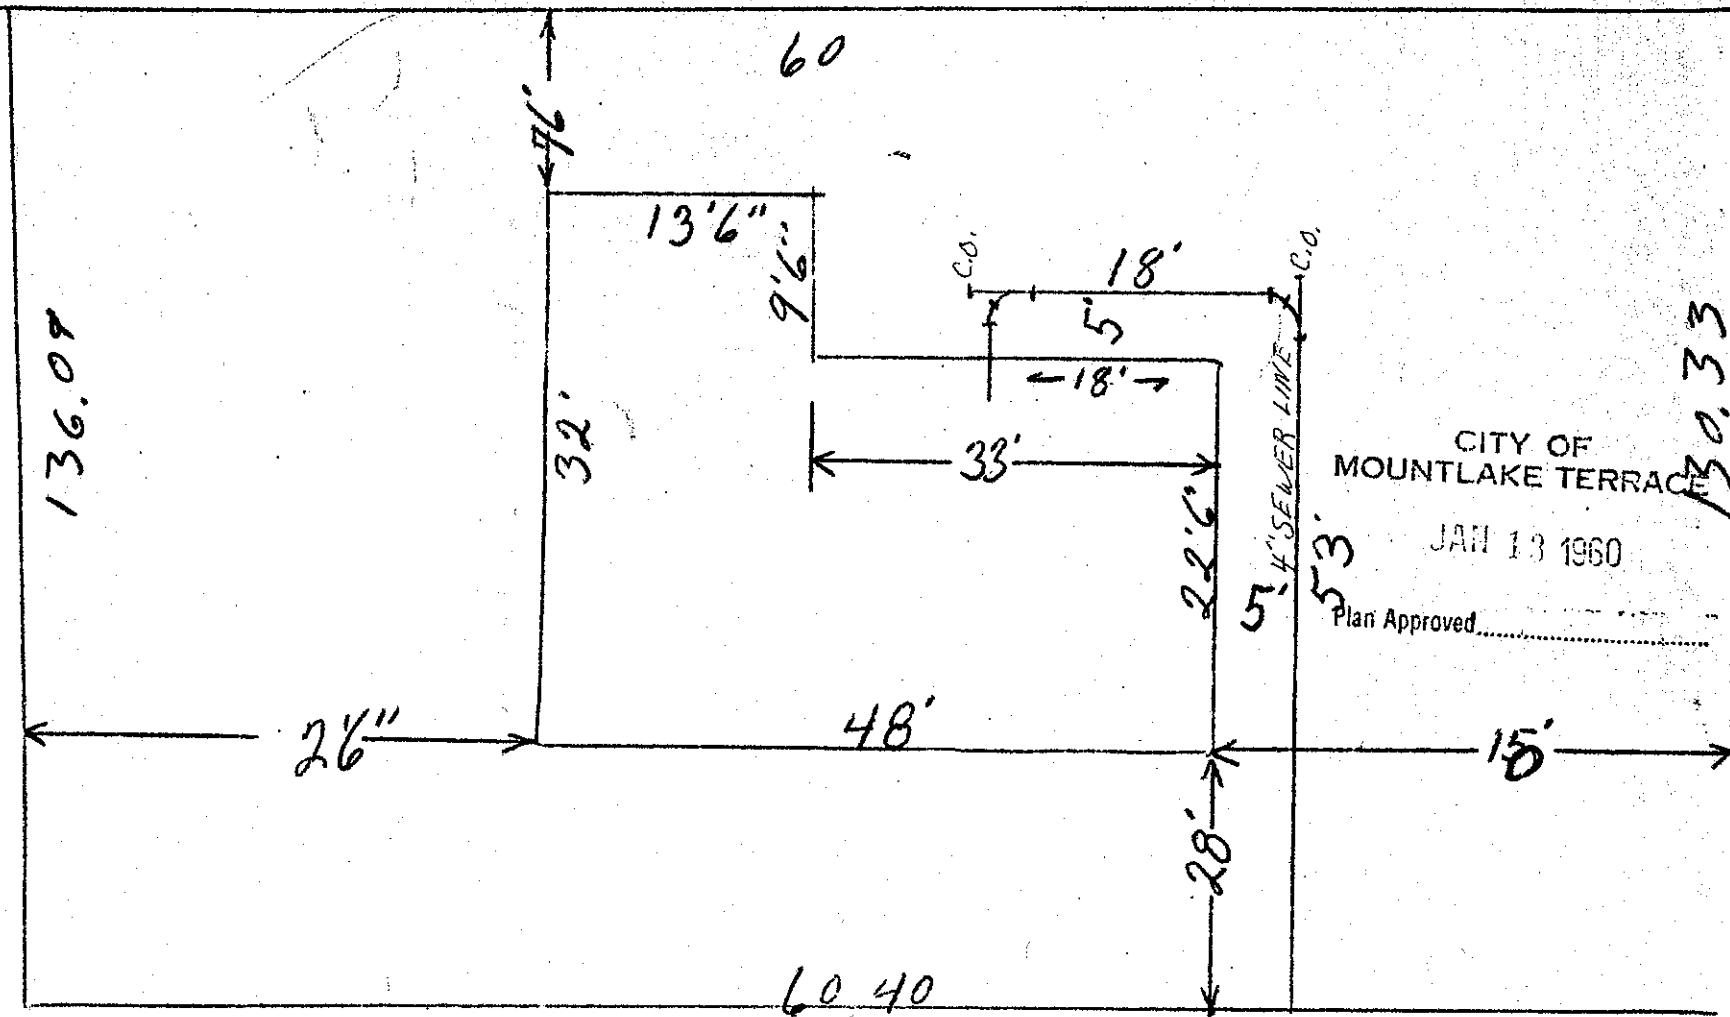

Date

Approved:

BACKFILL WORK ORDER ISSUED

DEPOSIT, \$ 10.00

SEWER WORK ORDER ISSUED

11/12/60

DATE 1-13-60

BY

The City of Mountlake Terrace

APPLICATION

for

SIDE SEWER PERMIT

OUTSIDE INSIDE REPAIRS

CARD No.

EASEMENT No.

OWNER ALLAN KARNES
HOUSE No. 23208 55 WEST

CONTRACTOR DURRETT CONST
STREET
AVENUE LOT NO. 11

PERMIT No. 2041

BLOCK No. 1

NAME ADD.

59'

DIV. 6


PROPOSED SEWER LINE
4" CONCRETE PIPE

43.6"

CLEANOUT

CLEANOUT

.87'

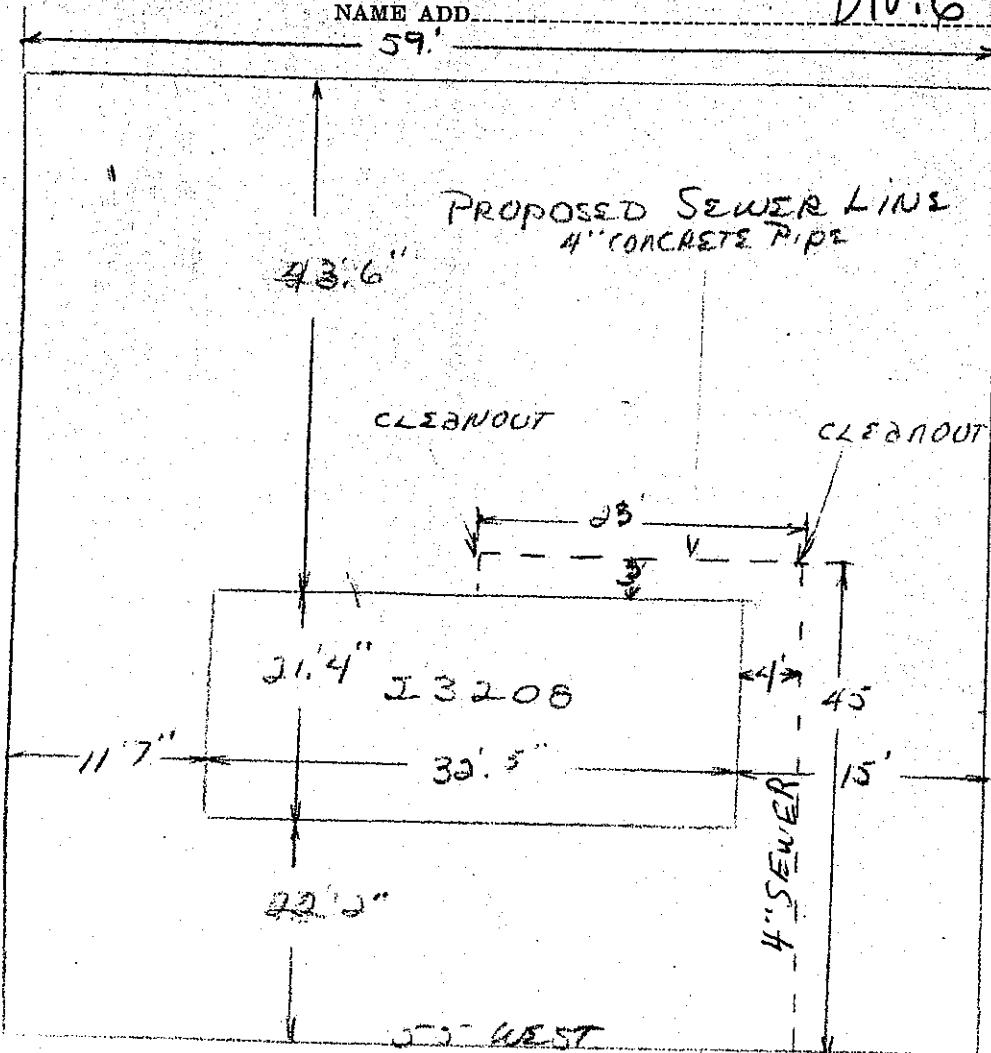

CITY OF
MOUNTLAKE TERRACE

MAR 18 1960

Plan Approved

BACKFILL WORK ORDER ISSUED
SEWER WORK ORDER ISSUED


Date

DEPOSIT, \$10.00 3/18/60 Approved:
885


DATE 3-18-60 BY Scott M Holton NSYCO

55 TH AVE. W.

232ND ST. S.W.

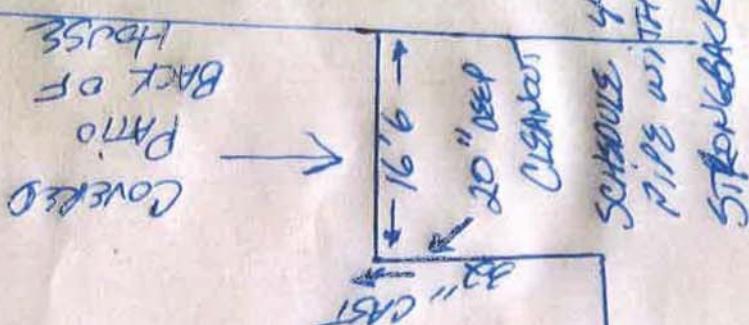

23209

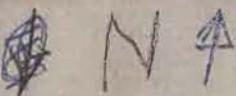

OWNER: ELIZABETH WYZINSKI
ADDRESS: 23209 55TH AVE. W.

DATE: 6-22-20

PERMIT #: 4-20-0026

Inspector's Signature:

Thomas Mohr

SIDE SEWER DRAWING

1. Drawing must be clearly labeled (streets, north arrow).
2. Indicate location of all piping, cleanouts, manholes or other fixed features.
3. Dimension pipe length and distance from other features.
4. Label diameter, bends, material type of pipe and depth at cleanouts.



Call before you dig:
1-800-424-5555 (or 811)

The City of Mountlake Terrace

APPLICATION

for

SIDE SEWER PERMIT

OUTSIDE INSIDE REPAIRS

D. M. JOHNSON
CARD NO.

EASEMENT No. 13582401

OWNER ALBERT M JOHNSON

HOUSE NO. 23210 - 55 W

CONTRACTOR

STREET


AVENUE LOT No. LOT # 16

PERMIT No. 9083

BLOCK No. 1 DIV # 6

NAME ADD.

WYE ← PLUG ← SEPTIC TANK
WYE ← PLUG ← BEND

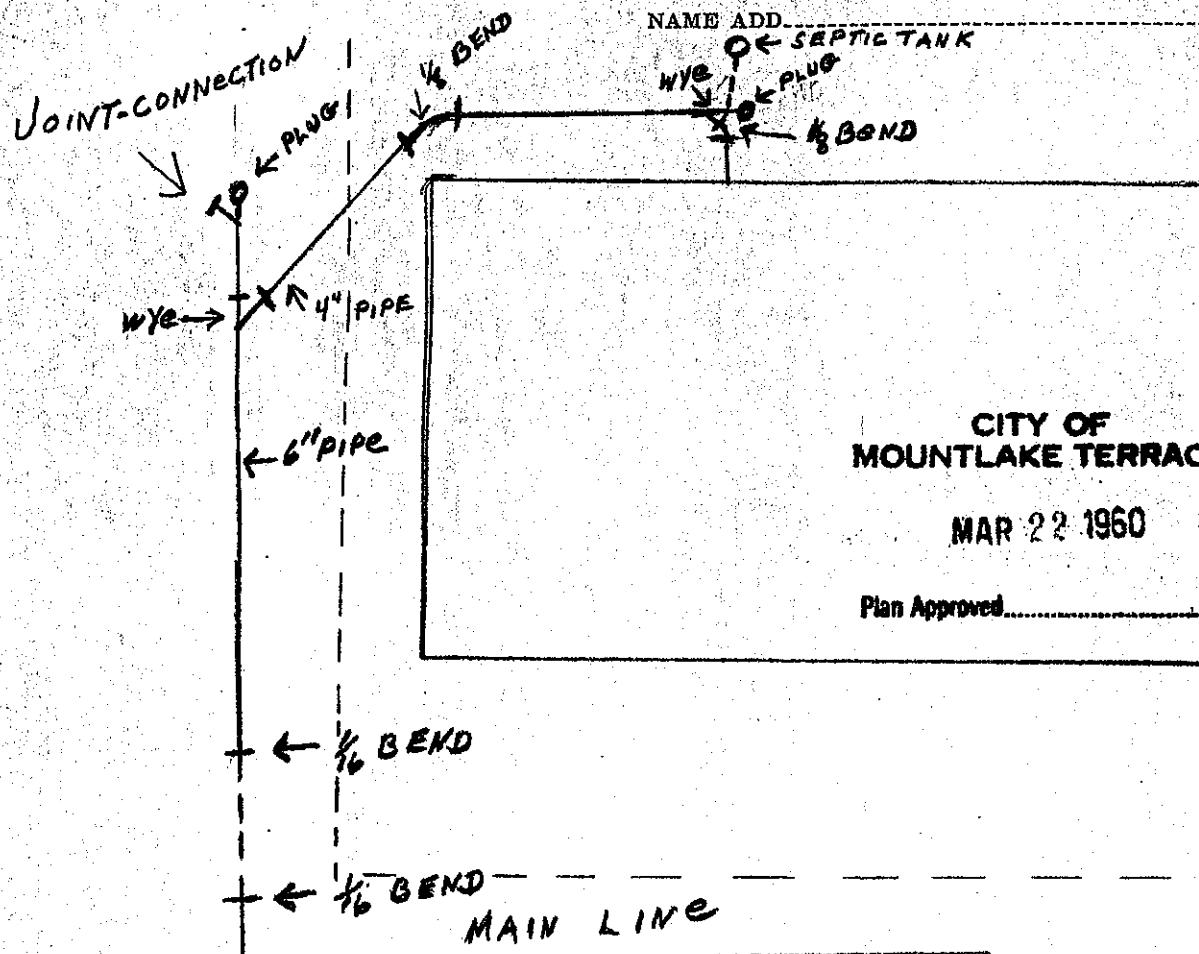

Date

Approved:

PACKFILL WORK ORDER ISSUED

DEPOSIT, \$10.00

3/21/60

SEWER WORK ORDER ISSUED

921

DATE

3-22-60

BY

Scott M Holton INSNC
8-18-60 INST CON 8m 4

The City of Mountlake Terrace

APPLICATION

for

SIDE SEWER PERMIT

OUTSIDE INSIDE REPAIRS

CARD No.

EASEMENT No.

NONE

OWNER Keith McDonald
HOUSE No. 23301 55th W.

CONTRACTOR

WINGFIELD-BROWN

PERMIT No. 1366

STREET

#6


AVENUE LOT No.

#2

BLOCK No.

DIVISION #6

NAME ADD.

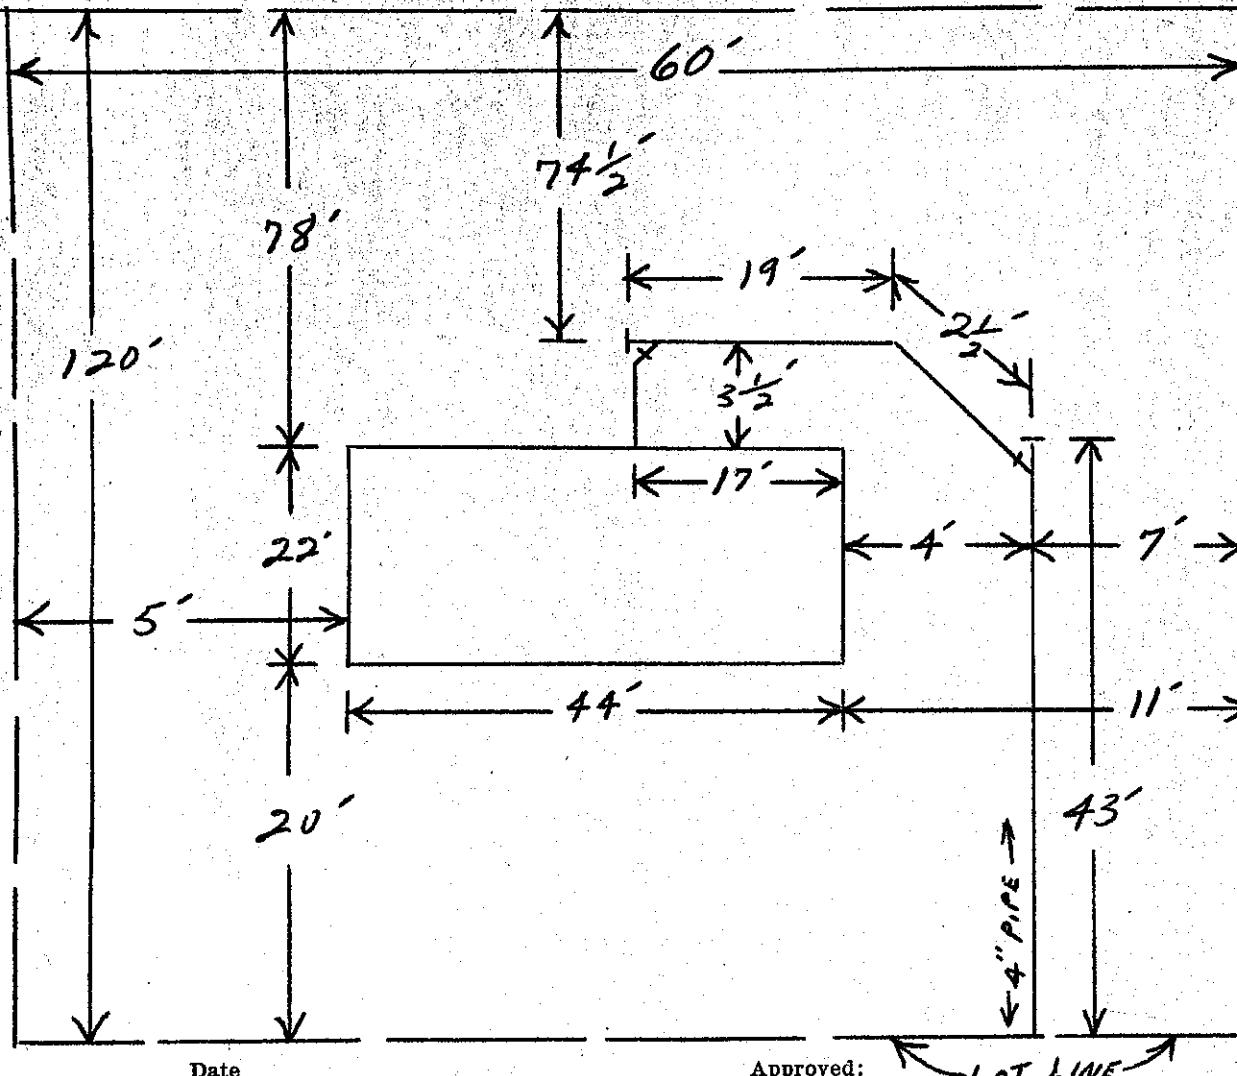

Date

Approved:

BACKFILL WORK ORDER ISSUED

DEPOSIT, \$

10.00

SEWER WORK ORDER ISSUED

5590

1-1-60

DATE 1-5-60

BY

R. L.

Scott M Holton INST CON

APPLICATION

for

SIDE SEWER PERMIT

OUTSIDE INSIDE REPAIRS

The City of Mountlake Terrace

(2) H. E. Witten

CARD NO.

EASEMENT No. 1358240 ✓


OWNER HAROLD E. WHISTEN & PHYLLIS WHISTEN CONTRACTOR

HOUSE No. 23302 - 53rd - WESTSTREET
AVENUE LOT No. ~~10~~ 15

BLOCK No. 1 DIG #6

PERMIT NO. 2082

NAME ADD.

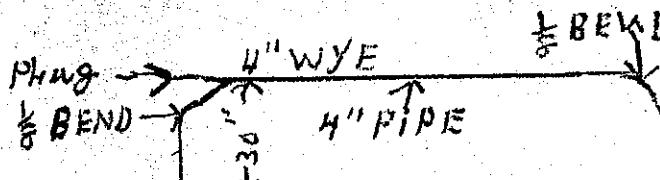CITY OF
MOUNTLAKE TERRACE

MAR 22 1960

Plan Approved

LOT LINE

SEWER MAIN

Date

BACKFILL WORK ORDER ISSUED

SEWER WORK ORDER ISSUED

DEPOSIT, \$10.00 Approved:
3/21/40

923

DATE

3-22-60

BY

Scott M. Holton INS NC

2-10-1 1980

The City of Mountlake Terrace

APPLICATION

for

SIDE SEWER PERMIT

CARD No.

OUTSIDE INSIDE REPAIRS

EASEMENT No.

OWNER RONALD W. and JEANIE E. SMITH CONTRACTOR
HOUSE No. 23303 - 55th W.

STREET
AVENUE LOT NO.


PERMIT No. 239

NAME ADD.

BLOCK No. 2

Div # 6

SIZE OF LOT 65 By 135

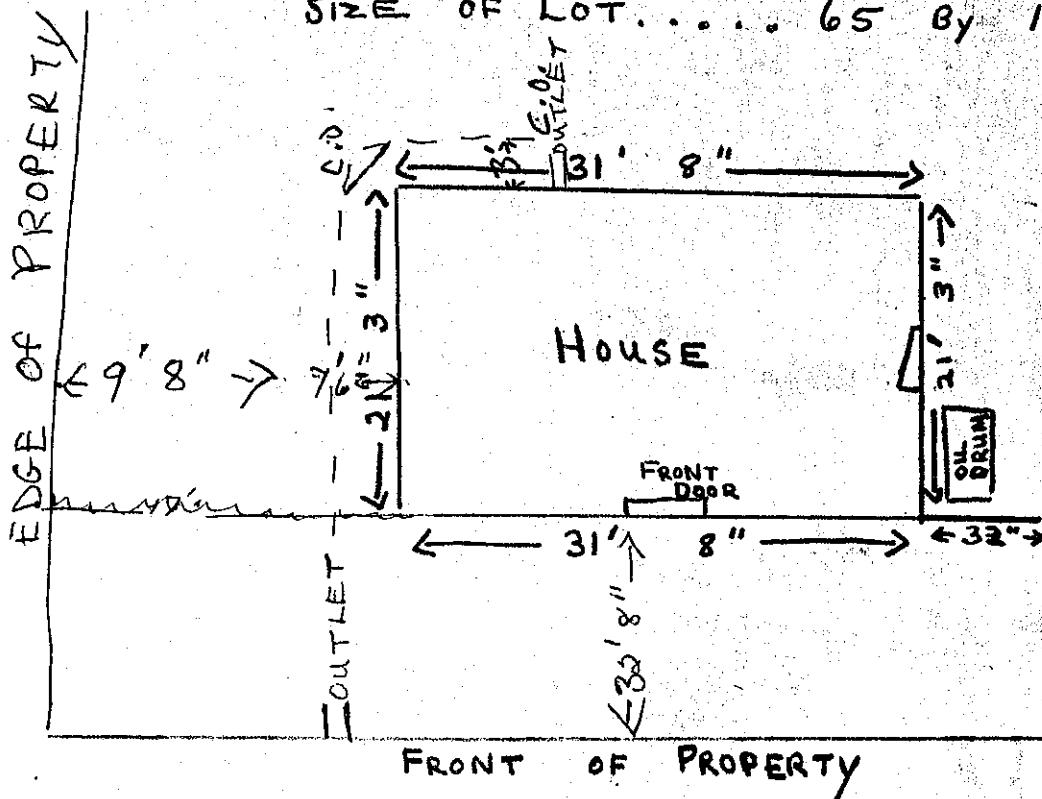

Date

Approved:

BACKFILL WORK ORDER ISSUED

DEPOSIT, \$ 10.00

SEWER WORK ORDER ISSUED

7/19/60

#11.00

DATE 7-25-60 BY S.M. Holton INS+COD

The City of Mountlake Terrace

APPLICATION

FOR

SIDE SEWER PERMIT

OUTSIDE INSIDE REPAIRS

J. S. Baker
CARD NO.

EASEMENT No. 135-3788

OWNER: JAMES S. BAKER

HOUSE NO. 23306 U.D. 55

CONTRACTOR


STREET

AVENUE LOT NO. 13

PERMIT NO. 2316

BLOCK NO. 1

NAME ADD. Add 426

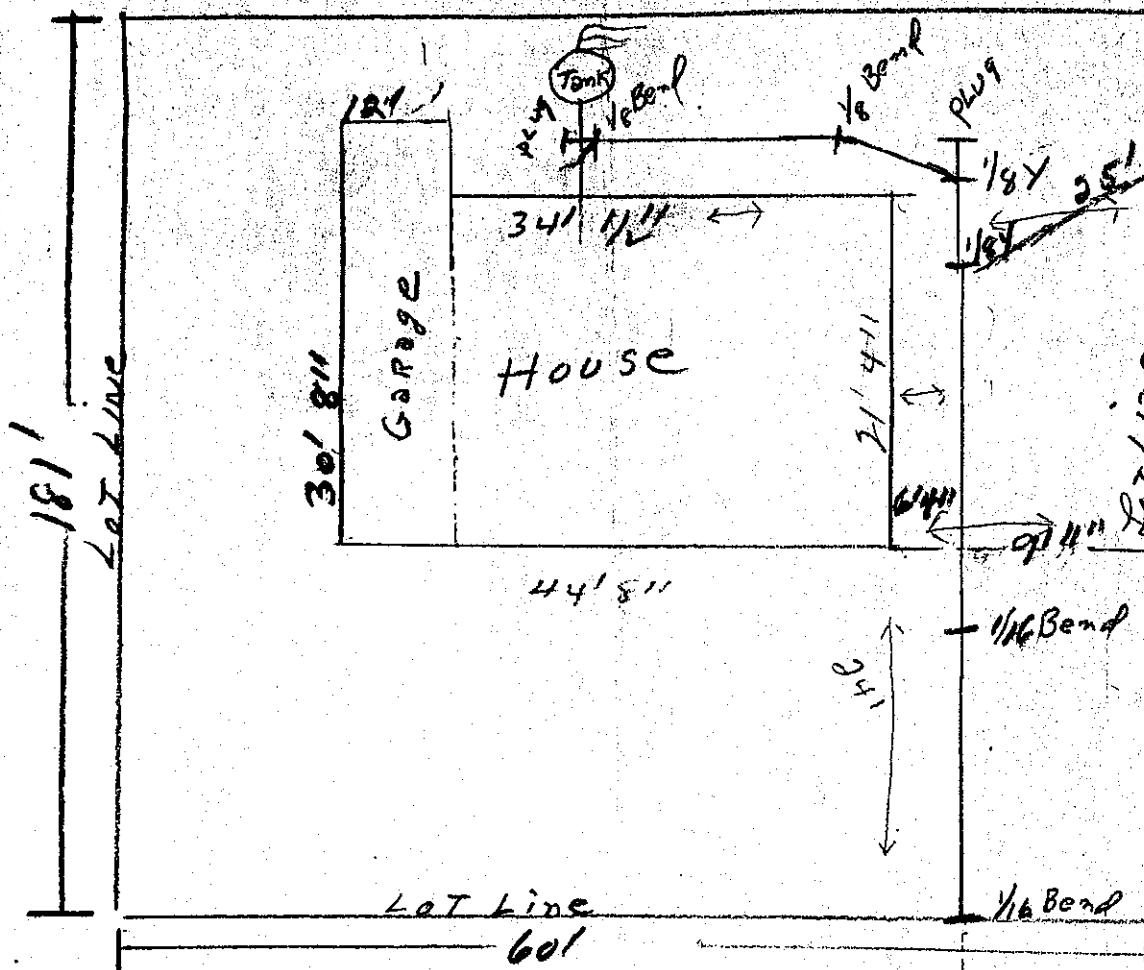

CITY OF
MOUNTLAKE TERRACE

APR 27 1960

Plan Approved: S.M. Abee

Date

Approved:

BACKFILL WORK ORDER ISSUED

SEWER WORK ORDER ISSUED

DEPOSIT, \$10.00 3/31/60 Sewer Main

1094

DATE

4-27-60 BY S.M. Holton INSTCON

APPLICATION

for

SIDE SEWER PERMIT

The City of Mountlake Terrace

G. N. BURRINGER

CARD NO.

OUTSIDE INSIDE REPAIRS

EASEMENT No. 135-0495

OWNER Gerald N. BurfingerCONTRACTOR T-5-11 Cont. PERMIT No. 219HOUSE No. 23327


STREET

AVENUE LOT NO.

9

BLOCK No. 2

NAME ADD.

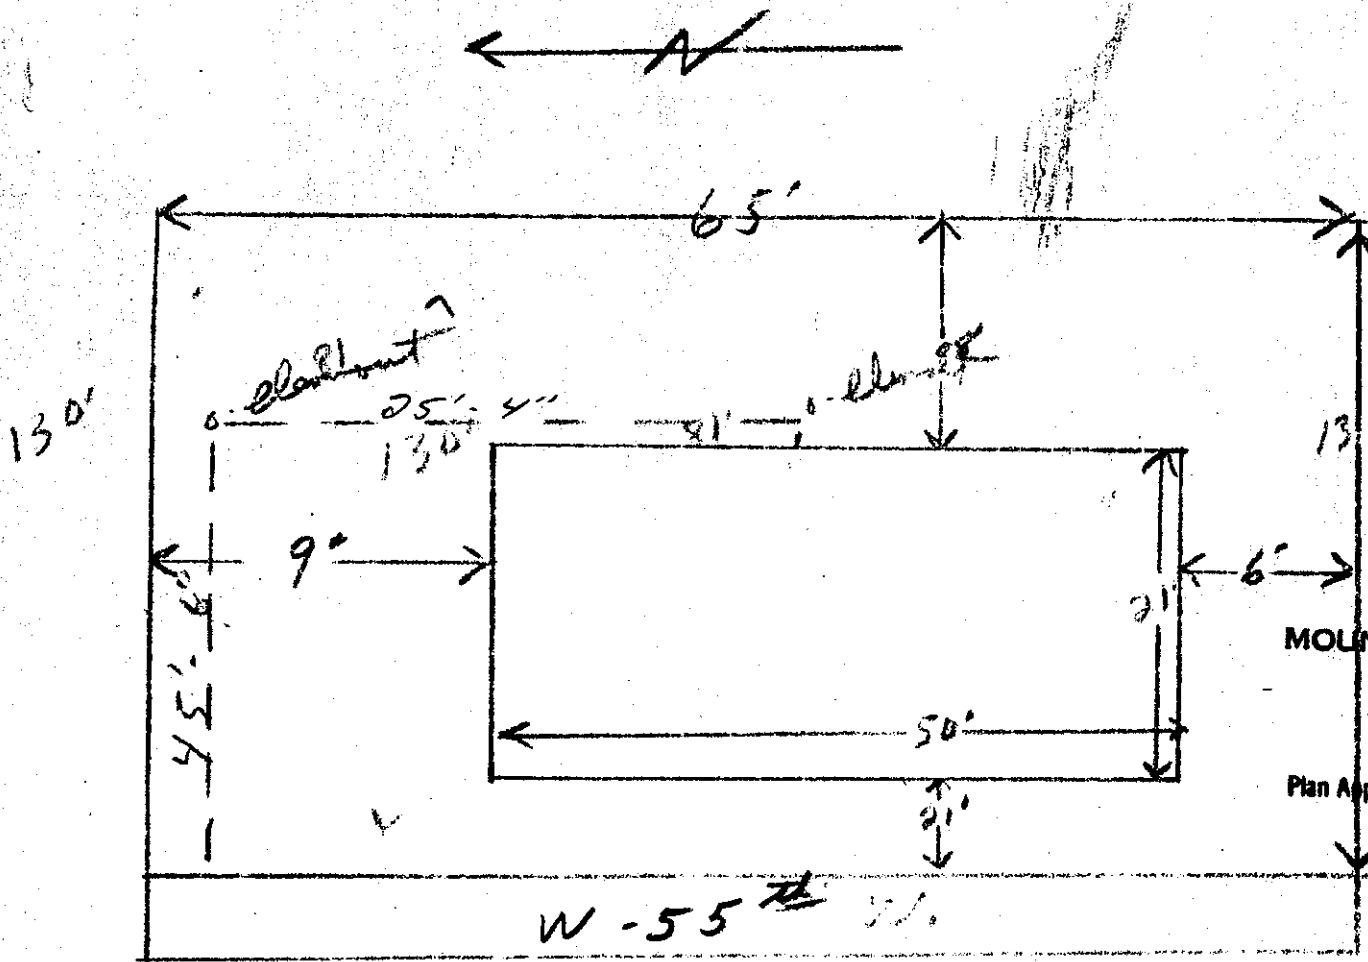Dix #6CITY OF
MOUNTLAKE TERRACE

SEP 11 1959

Plan Approved

Date

Approved:

BACKFILL WORK ORDER ISSUED

DEPOSIT, \$10⁰⁰ 9/10-59

DATE

9-11-59 BY Scott M. Holton INS

SEWER WORK ORDER ISSUED

7-2-60 INST CO 1 P.M.

N.C.

The City of Mountlake Terrace

APPLICATION

for

SIDE SEWER PERMIT

OUTSIDE INSIDE REPAIRS

R. W. CLARK C.N.
CARD NO.

EASEMENT No. None

OWNER R. W. Clarkson
HOUSE NO. 23308-55 W

CONTRACTOR Redford Russell

STREET AVENUE LOT No. 12

PERMIT NO. 1712


BLOCK NO. 1

NAME ADD. 6

Plan Approved

FEB 15 1960

CITY OF MOUNTLAKE TERRACE

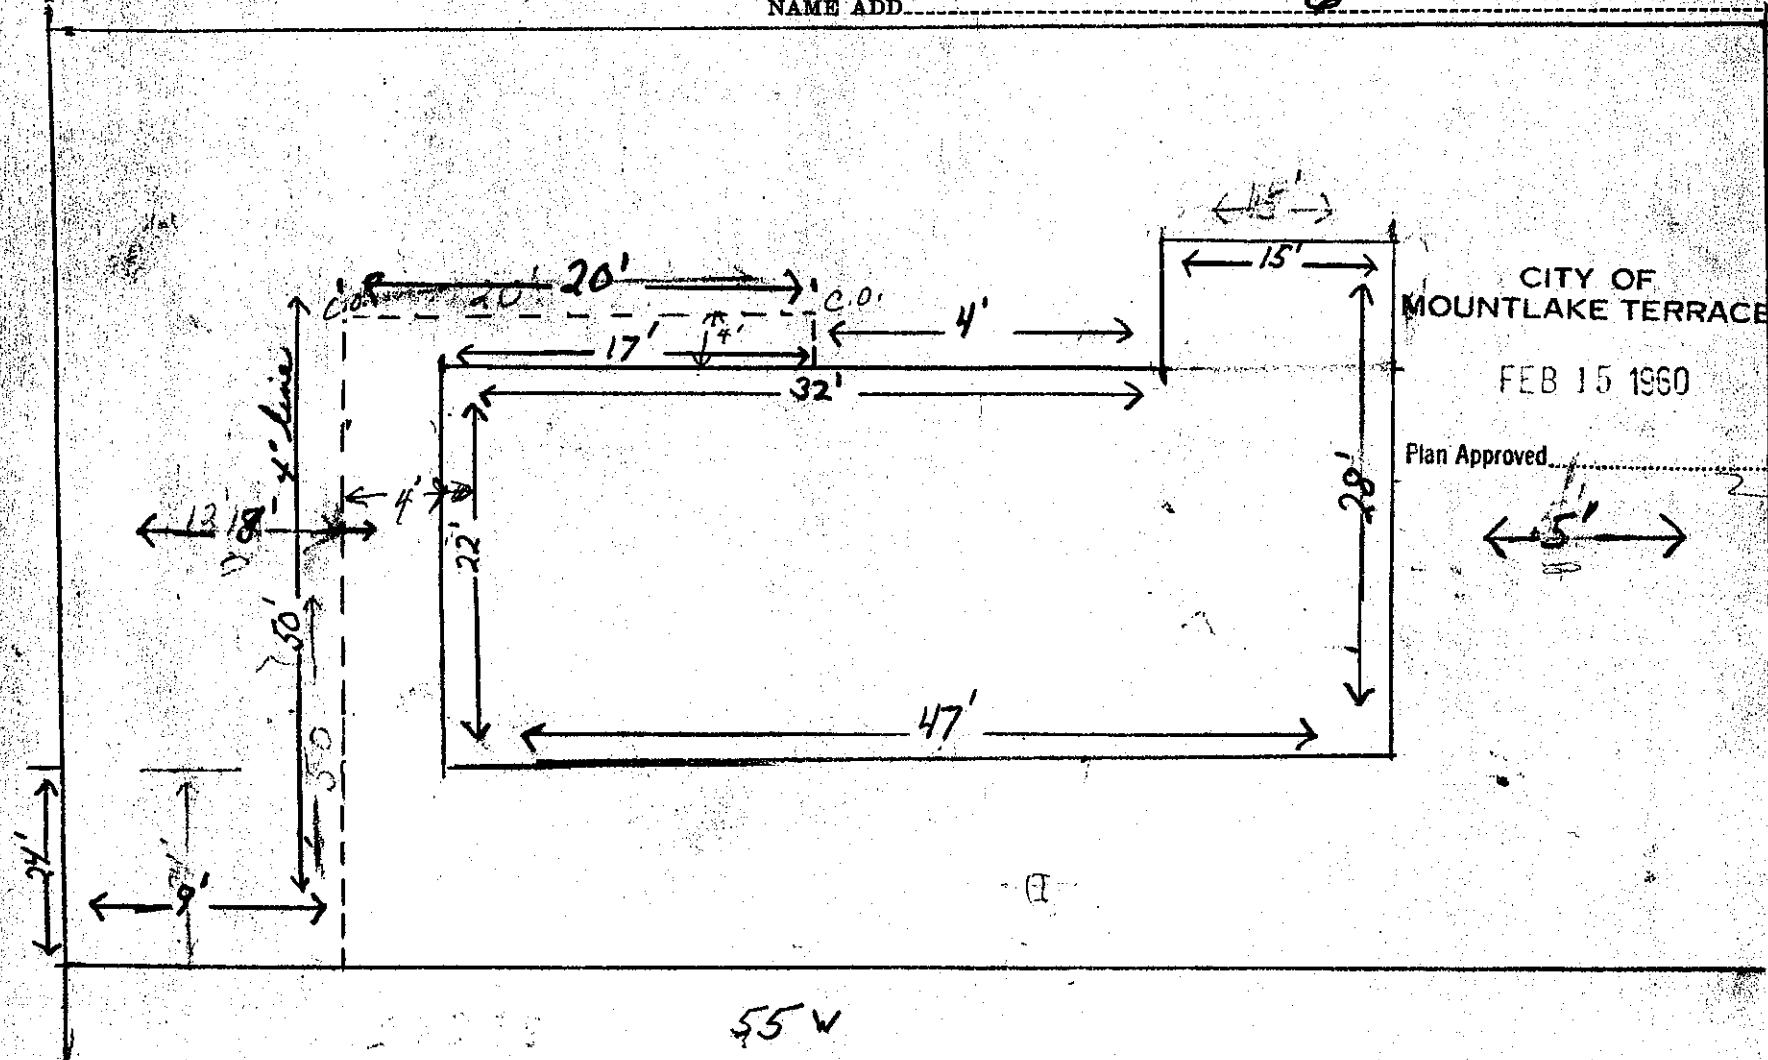

Date

Approved:

BACKFILL WORK ORDER ISSUED
SEWER WORK ORDER ISSUED

DEPOSIT, \$ 10⁰⁰ 2-12-60
6016

DATE 2-15-60

BY

Scott M. Holton INS+COP

The City of Mountlake Terrace

APPLICATION

for

SIDE SEWER PERMIT

CARD No.

OUTSIDE INSIDE REPAIRS

EASEMENT NO.

OWNER

L. J. PATRICK

HOUSE NO.

23403 55W

CONTRACTOR

Evergreen

PERMIT No. 1916

STREET


AVENUE LOT NO.

2

BLOCK No.

NAME ADD

M.L.T DIV #7

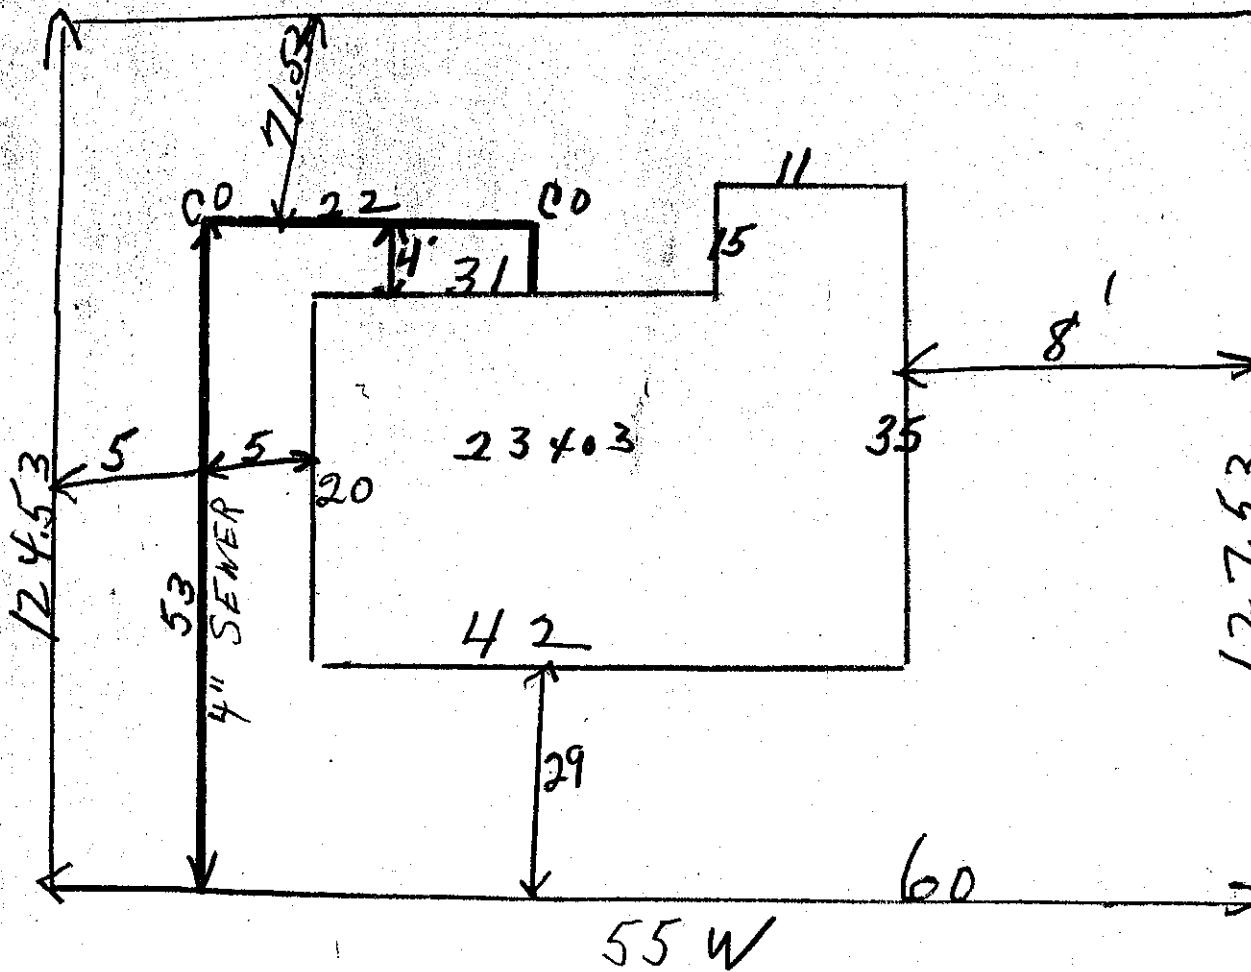

CITY OF
MOUNTLAKE TERRACE

MAR 10 1960

Plan Approved

S. M. Ghee

Date

Approved:

BACKFILL WORK ORDER ISSUED

SEWER WORK ORDER ISSUED

DEPOSIT: \$ 10.00

req'd

DATE 3-10-60

BY

Scott M Holton INSTCON

APPLICATION
for

SIDE SEWER PERMIT

The City of Mountlake Terrace

CARD No.

OUTSIDE INSIDE REPAIRS

EASEMENT No. 1385299

OWNER

JOHN V. MORRISON


CONTRACTOR DR. MAR SIDE SEWERS PERMIT NO. 2547

HOUSE No. 23405 W 55TH

STREET AVENUE LOT NO. 3

BLOCK No. 1 DIV. 7

NAME ADD.

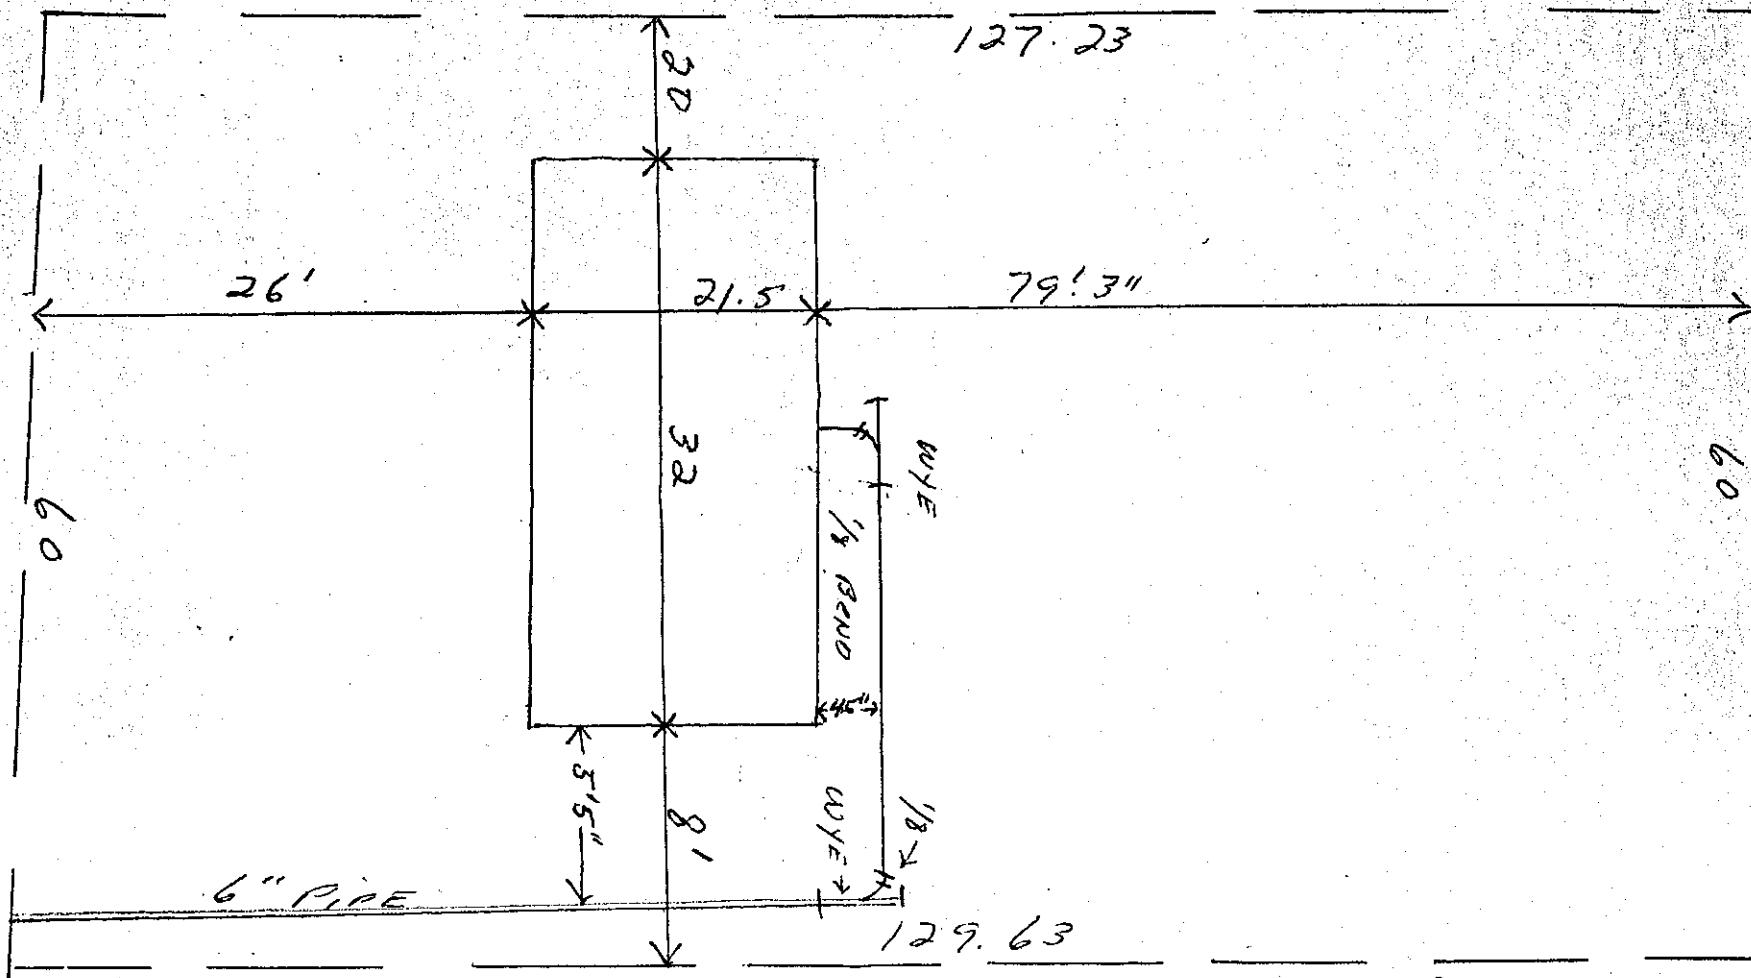

Date

Approved:

BACKFILL WORK ORDER ISSUED

DEPOSIT \$

10.00

4/25/60

SEWER WORK ORDER ISSUED

#1323

DATE

4/25/60

BY

APPLICATION

U.C. ENG 2001

The City of Mountlake Terrace

CARD No.

SIDE SEWER PERMIT

OUTSIDE INSIDE REPAIRS

EASEMENT No. 1385299

OWNER WESLEY C FENGSTROM

CONTRACTOR PAMAR SIDE SEWERS PERMIT No. 2546


HOUSE No. 23407 - W. 55TH

STREET AVENUE LOT No. 4

BLOCK No. 1 DIV 7

6" PIPE

NAME ADD.

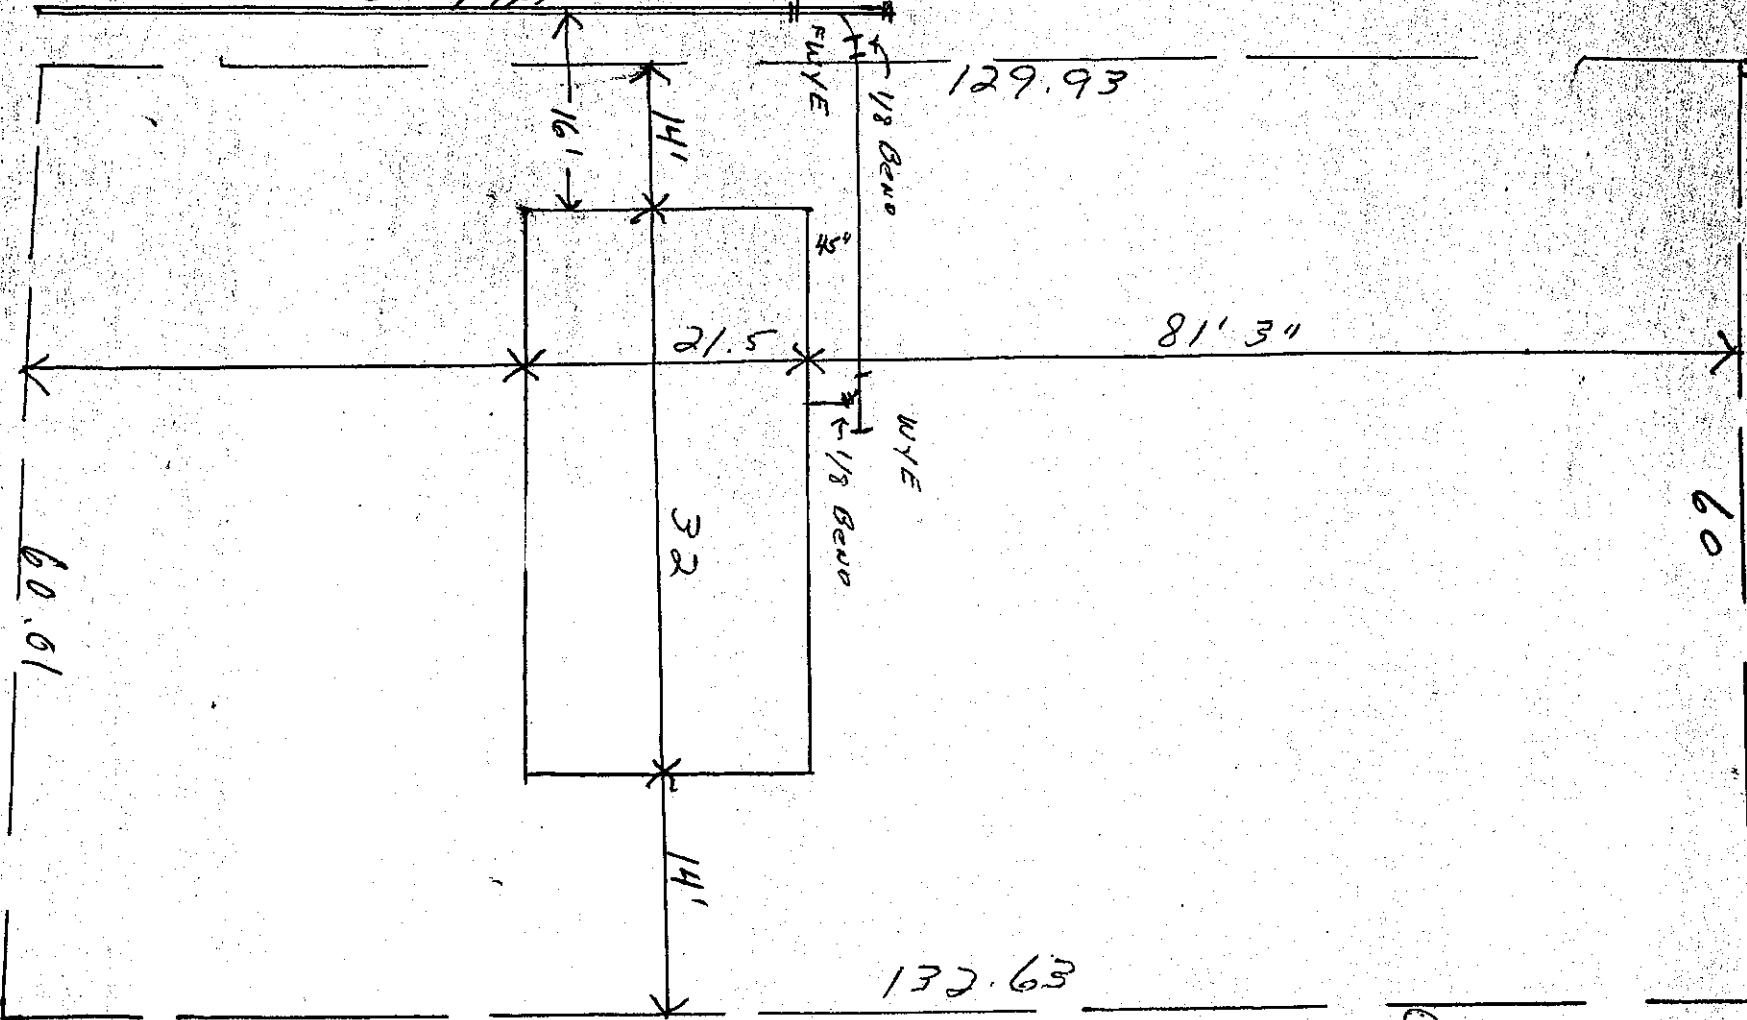

Date

Approved:

BACKFILL WORK ORDER ISSUED

DEPOSIT, \$

10.00

SEWER WORK ORDER ISSUED

4/25/60
#1323

DATE

9/25/60 BY

J. M. Moran

The City of Mountlake Terrace

APPLICATION

for

SIDE SEWER PERMIT

OUTSIDE INSIDE REPAIRS

CARD No.

EASEMENT No.

OWNER CYNRIC C. DAVIES

CONTRACTOR BY OWNER


HOUSE NO. 23409 - W. 55th

STREET AVENUE LOT NO. 5

PERMIT No. 2372

BLOCK NO. 1 DIV. 7

NAME ADD.

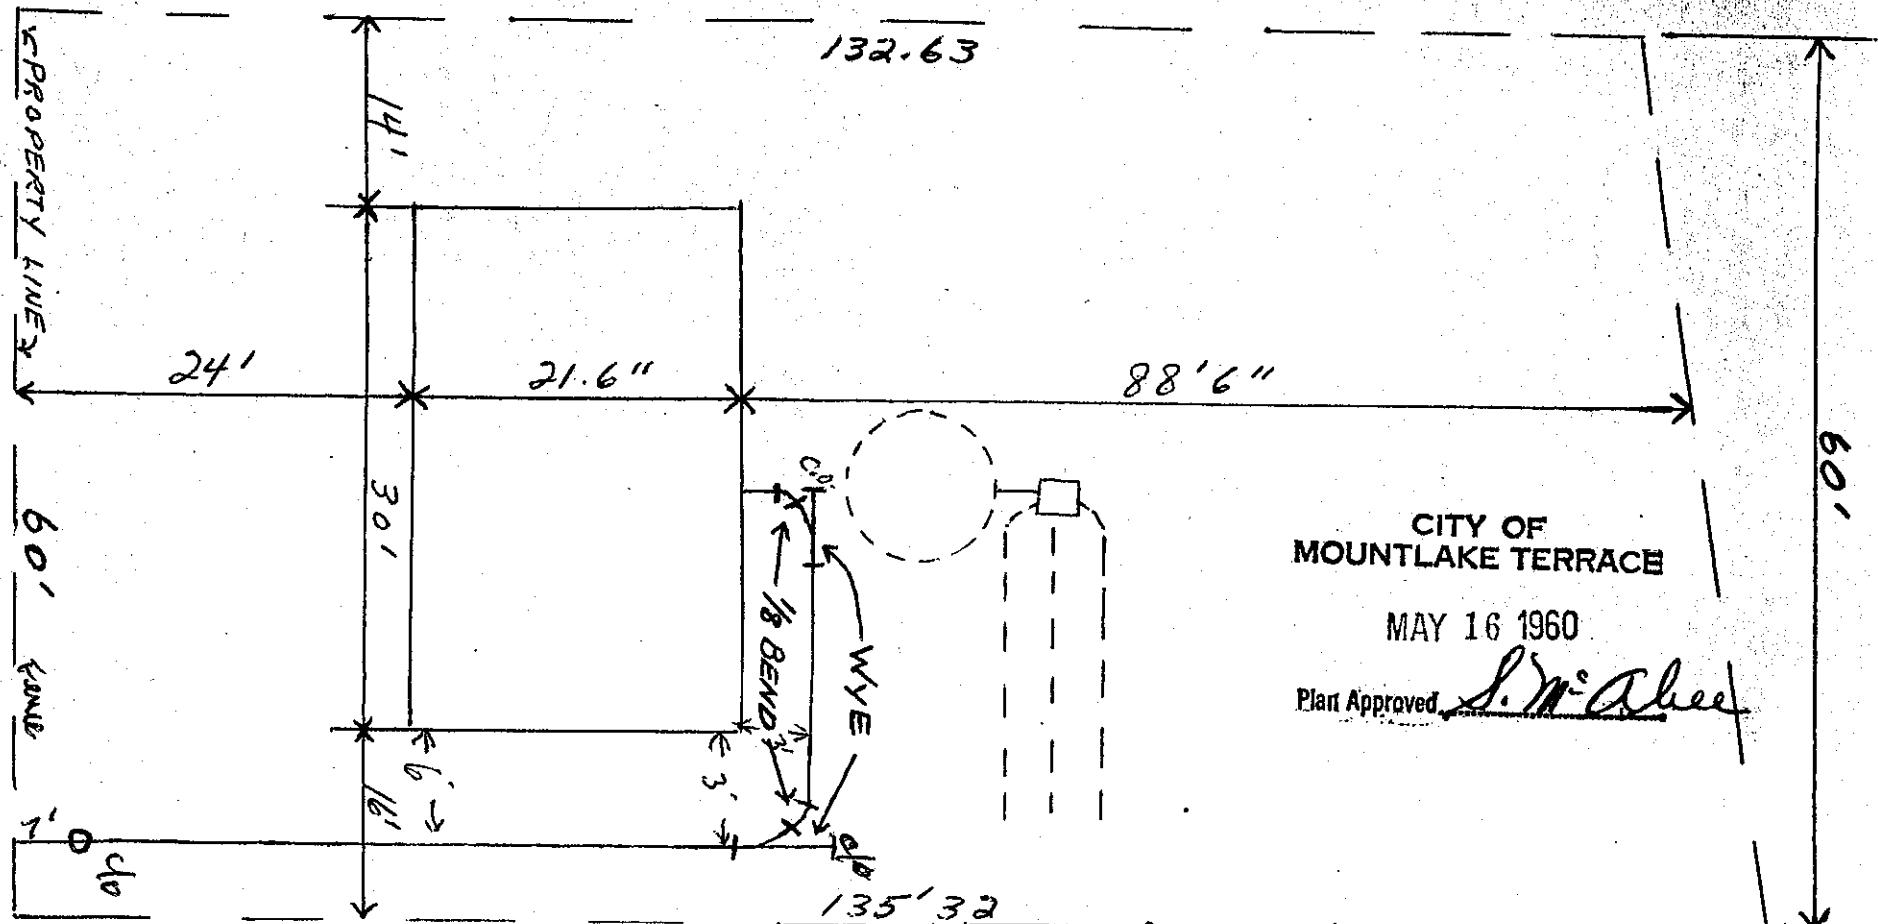

CITY OF
MOUNTLAKE TERRACE

MAY 16 1960

Plan Approved S. McAllee

BACKFILL WORK ORDER ISSUED
SEWER WORK ORDER ISSUED

Date

DEPOSIT, \$10.00 3/31/60

Approved:

1097

DATE 5-16-60

BY S. M. Holton INSTCON

The City of Mountlake Terrace

APPLICATION

for

SIDE SEWER PERMIT

OUTSIDE INSIDE REPAIRS

AGNE'S GARDEN

CARD No. _____

EASEMENT No. _____

OWNER Agnes Johnson
HOUSE No. 23501 - 55th W.


CONTRACTOR TB + E

STREET AVENUE LOT No. 6 - DIV 7

PERMIT No. 306

BLOCK No. 1

NAME ADD. _____

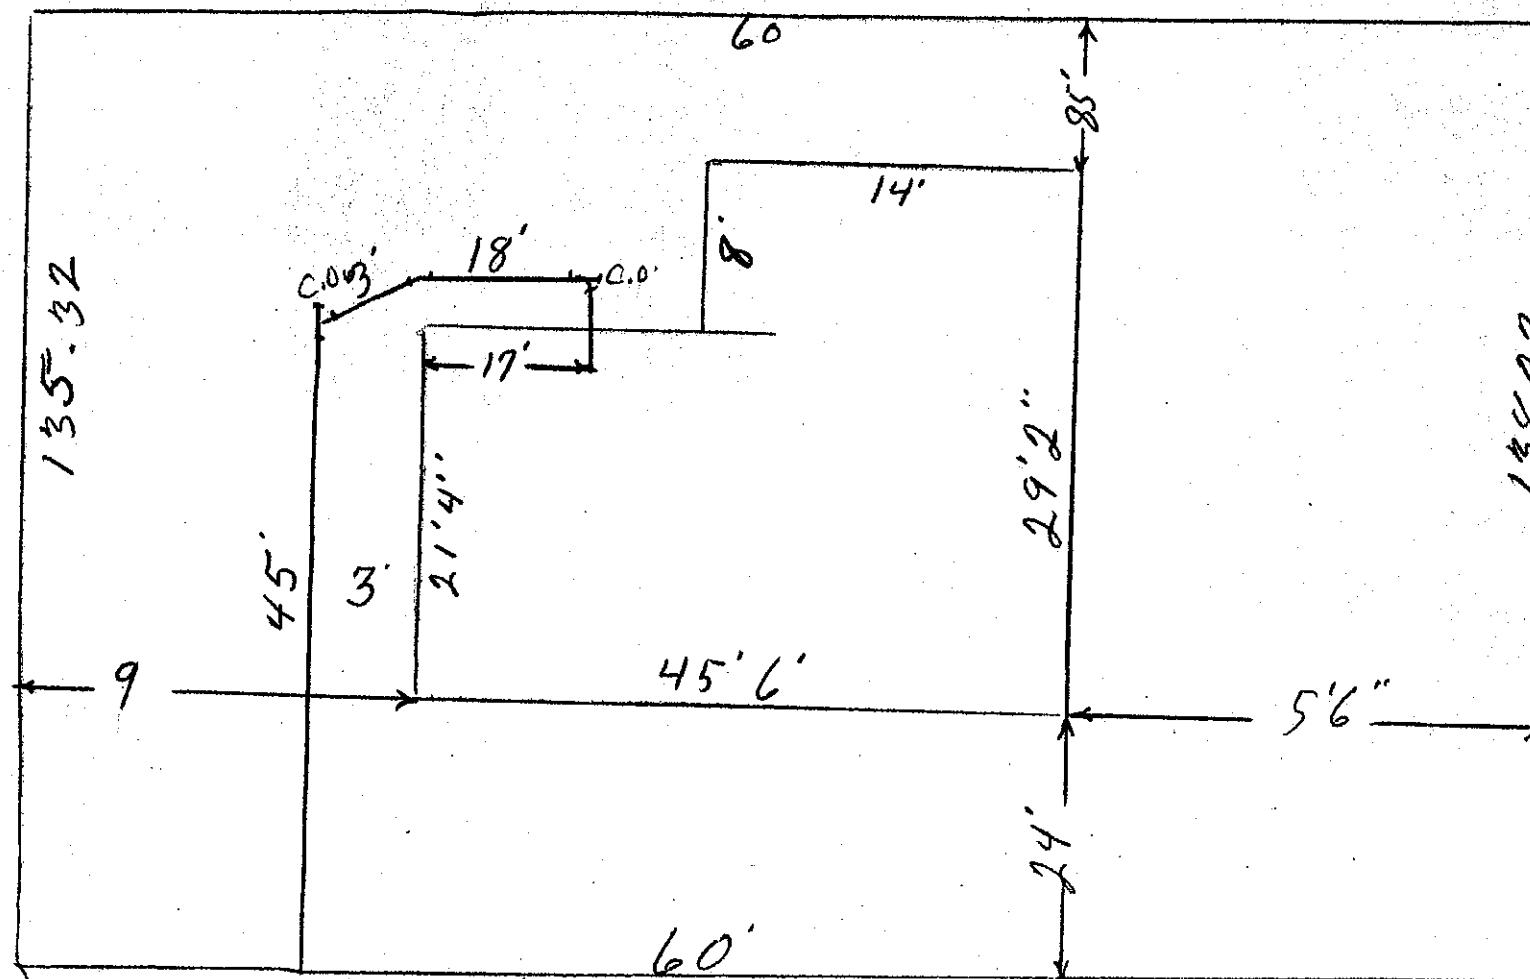

Date

Approved:

BACKFILL WORK ORDER ISSUED
SEWER WORK ORDER ISSUED

DEPOSIT, \$ 10.00

7-19-60

DATE 7-19-60 BY Son Holton INSTCON

APPLICATION

for

SIDE SEWER PERMIT

The City of Mountlake Terrace

CARD No.

EASEMENT NO.

OWNER J. G. Ruttan

HOUSE No. 23502 - 55 Th W.

OUTSIDE INSIDE REPAIRS

CONTRACTOR B+E Construction Co.

PERMIT NO.

34

STREET

AVENUE LOT NO. 14

Mountlake Terrace Blk 4
BLOCK NO. BTH No. 7

NAME ADD.

PLUG WITH W/T
CONCRETE PLUG

30'

WYE BEND 1/8

18'

20'

22' 10"

15' 5"

HOUSE

32'-1 3/4"

8' 5"


8' 6"

MOUNTLAKE TERRACE

AUG 21 1959

Plan Approved

Faller

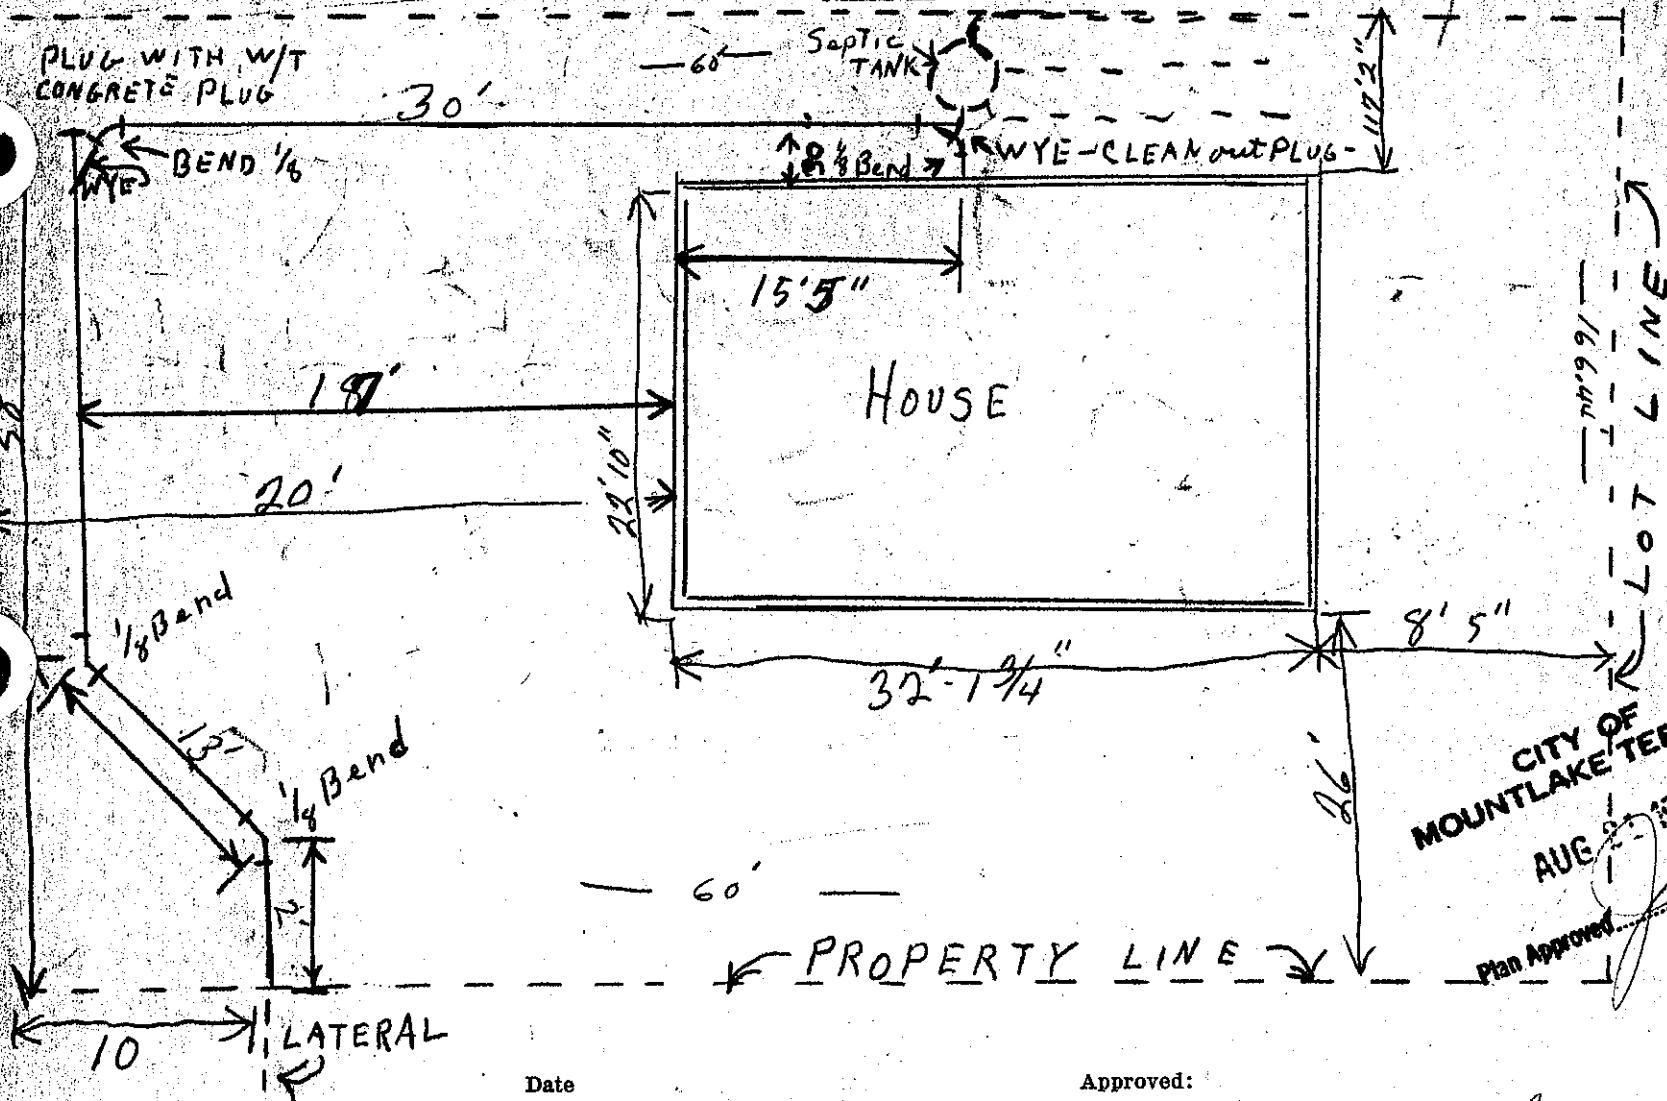

Date

Approved:

BACKFILL WORK ORDER ISSUED

DEPOSIT, \$ 10.00 8-21-59
* 39.41

DATE Aug 26/59 BY Scott M. Holton N.C.

SEWER WORK ORDER ISSUED

The City of Mountlake Terrace

APPLI CATION

for

SIDE SEWER PERMIT

OUTSIDE INSIDE REPAIRS

CARD NO.

EASEMENT NO.

1380033

OWNER HARRY L + MAUREEN J HARDEN

CONTRACTOR *self*

HOUSE No. 23503 - 55 W

STREET

AVENUE LOT No. 7

NAME ADD.


Division 7

PERMIT NO.

1869

BLOCK No.

1

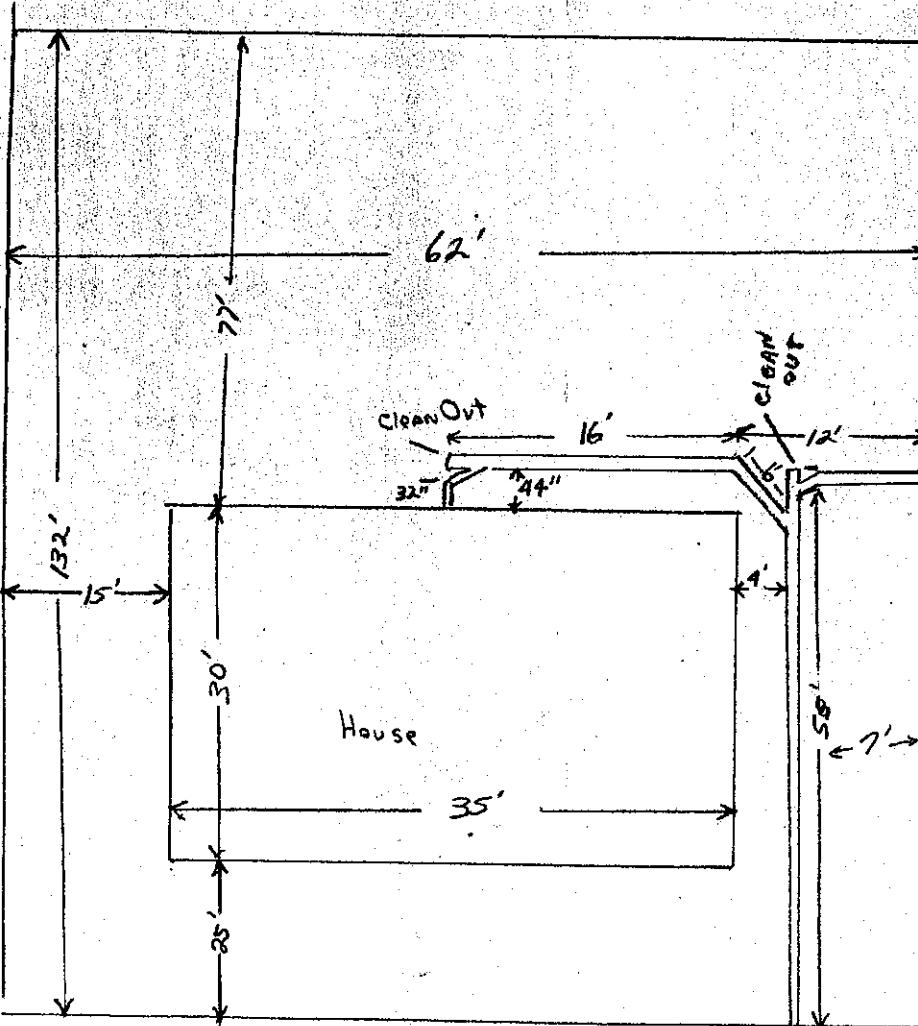

Date

DEPOSIT, \$

Approved:

10⁰⁰

BACKFILL WORK ORDER ISSUED

SEWER WORK ORDER ISSUED

DATE 3-7-60 BY Scott M Holton NS & CO
rec#7314
March 5, 1960

The City of Mountlake Terrace

APPLICATION

for

SIDE SEWER PERMIT

OUTSIDE INSIDE REPAIRS

CARD No.

EASEMENT No.

1380033

OWNER Keith C + Thelma V Robison
HOUSE NO. 23505 - 55W


CONTRACTOR *self*

STREET
AVENUE LOT No. 8

PERMIT No. 1868

BLOCK No. 1

NAME ADD. *Div. 7*

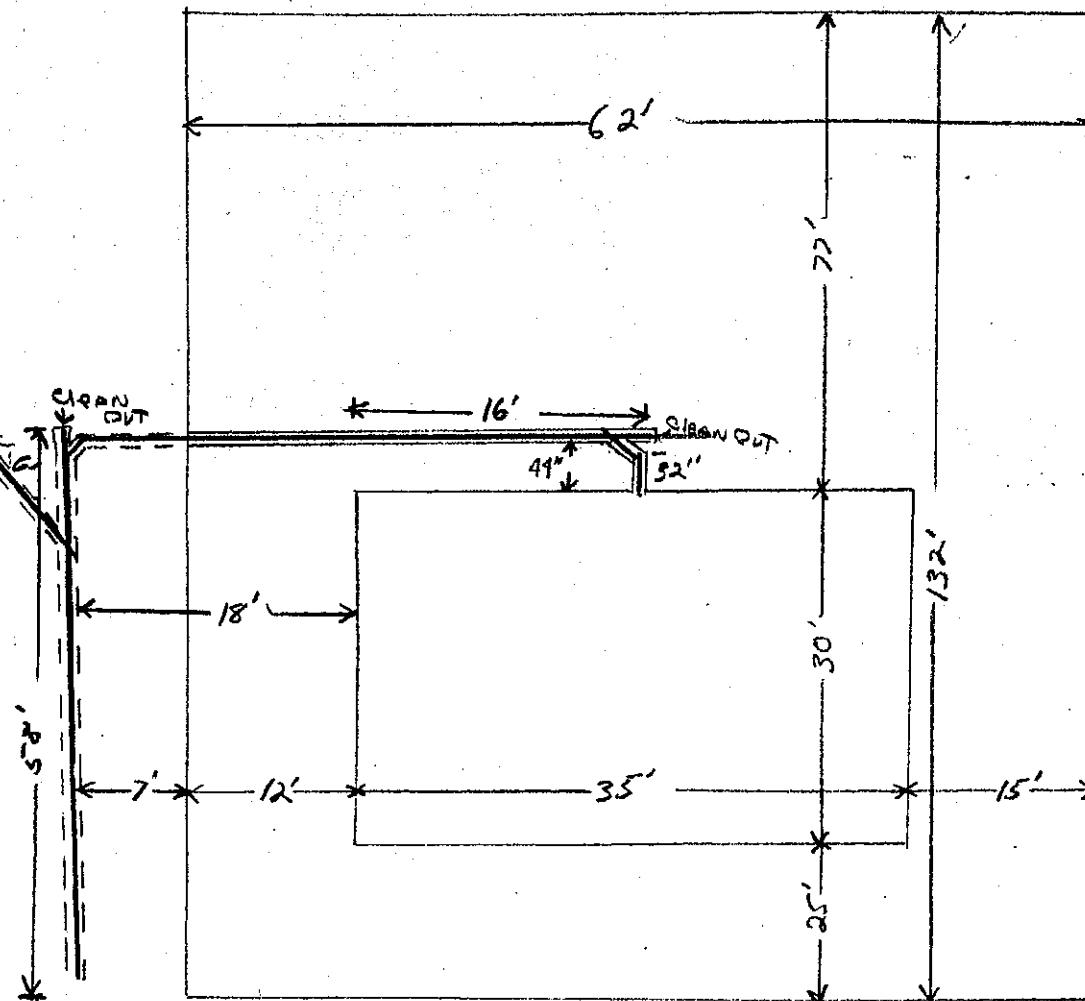

Date

Approved:

9/10/60

DEPOSIT,

\$10.00

DATE

3-7-60

BACKFILL WORK ORDER ISSUED

SEWER WORK ORDER ISSUED

rec # 731

BY

Scott M Holton NSCON

CITY OF
MOUNTLAKE TERRACE

MAR 7 1960

Plan Approved *S. M. Holton*

The City of Mountlake Terrace

APPLICATION

for

SIDE SEWER PERMIT

OUTSIDE INSIDE REPAIRS

CARD NO.

1381960


EASEMENT NO.

OWNER JOHN M. + VEDA D. OLSEN CONTRACTOR Owner

HOUSE No. 2350 1/2 - 55 WEST STREET AVENUE LOT No. Lot 9 Blk. 1 Div. 7 BLOCK NO.

NAME ADD.

PERMIT NO. 1696

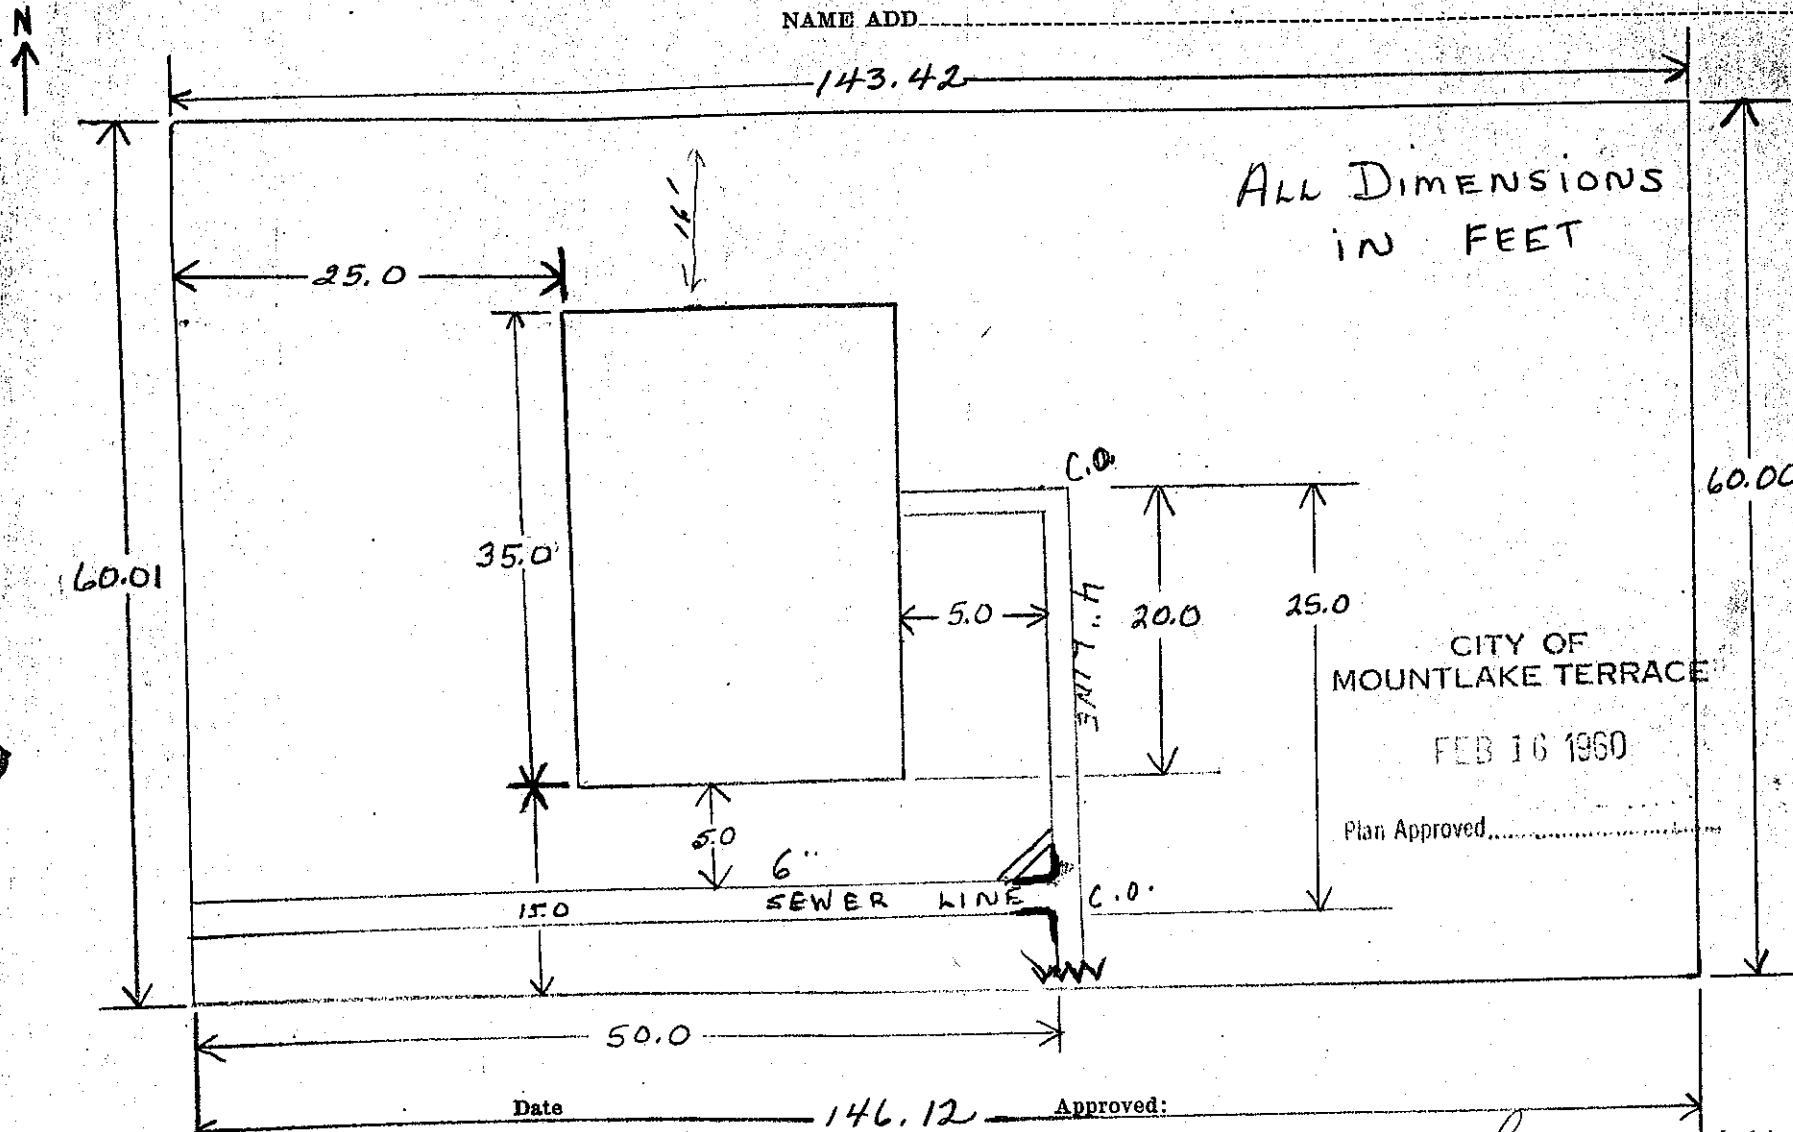

Date

146.12

Approved:

BACKFILL WORK ORDER ISSUED

DEPOSIT, \$

SEWER WORK ORDER ISSUED

DATE 2-17-60 BY Scotton Holton INS+CO.

APPLICATION

for

SIDE SEWER PERMIT

The City of Mountlake Terrace

CARD No.

OUTSIDE INSIDE REPAIRS

EASEMENT No. 1351440

OWNER David A. Paige

CONTRACTOR


HOUSE NO. 23605 W 55th

STREET
AVENUE LOT No. 4

TOP NOTCH PLUMBING CO. PERMIT NO. 1011

BLOCK No. Mountlake Terra. Div.

NAME ADD. 2 Vol. 8 Page 47 of Plats Sno. Co. Records

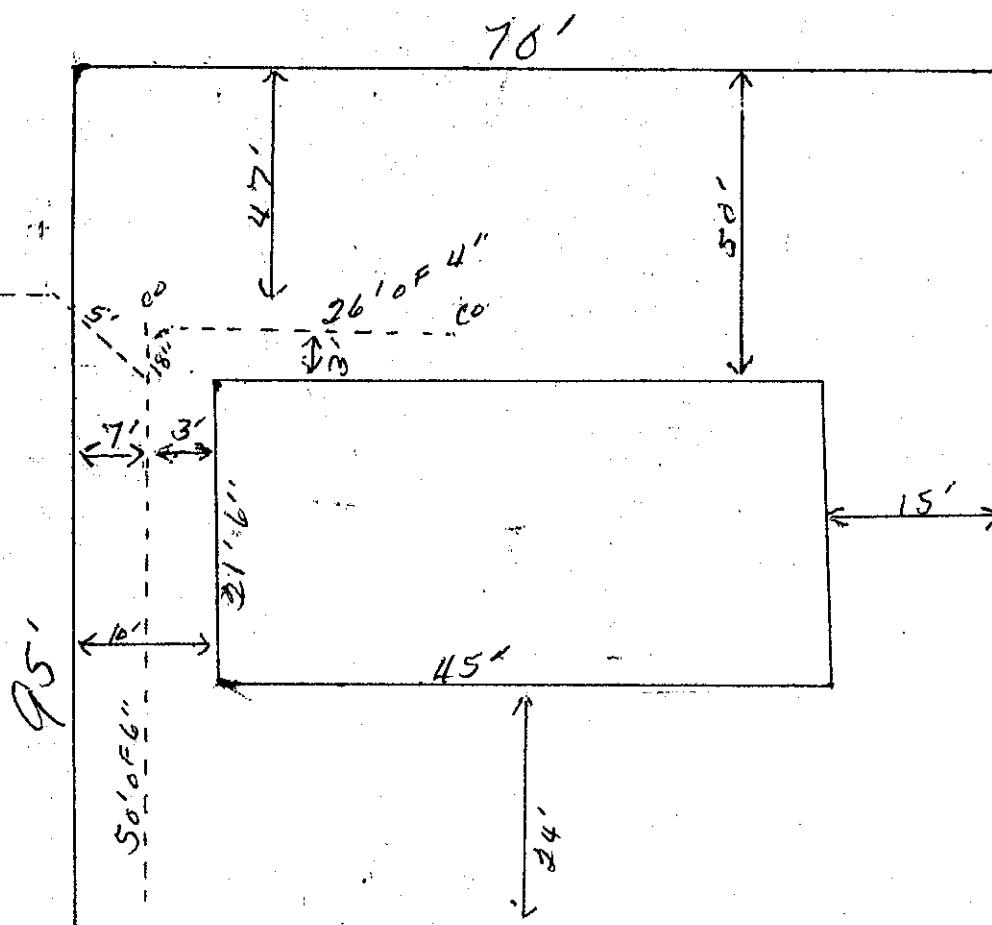

Date

Approved:

BACKFILL WORK ORDER ISSUED

DEPOSIT, \$ 10

SEWER WORK ORDER ISSUED

Rec 5223

DATE 10-23-59 BY Scott M Holton 1011

CITY OF
MOUNTLAKE TERRACE

OCT 23 1959

Plan Approved

J. Fairless
S.M.A.

The City of Mountlake Terrace

APPLICATION

for

SIDE SEWER PERMIT

OUTSIDE INSIDE REPAIRS

FRED R. REDFORD

CARD No.

OWNER FRED R. Redford
HOUSE No. 23608 55th W.


CONTRACTOR L. C. FRANKLIN CO. PERMIT No. 1486

STREET
AVENUE LOT No. 8

EASEMENT No.

BLOCK No.

NAME ADD. Mountlake Terrace - Div. II 3

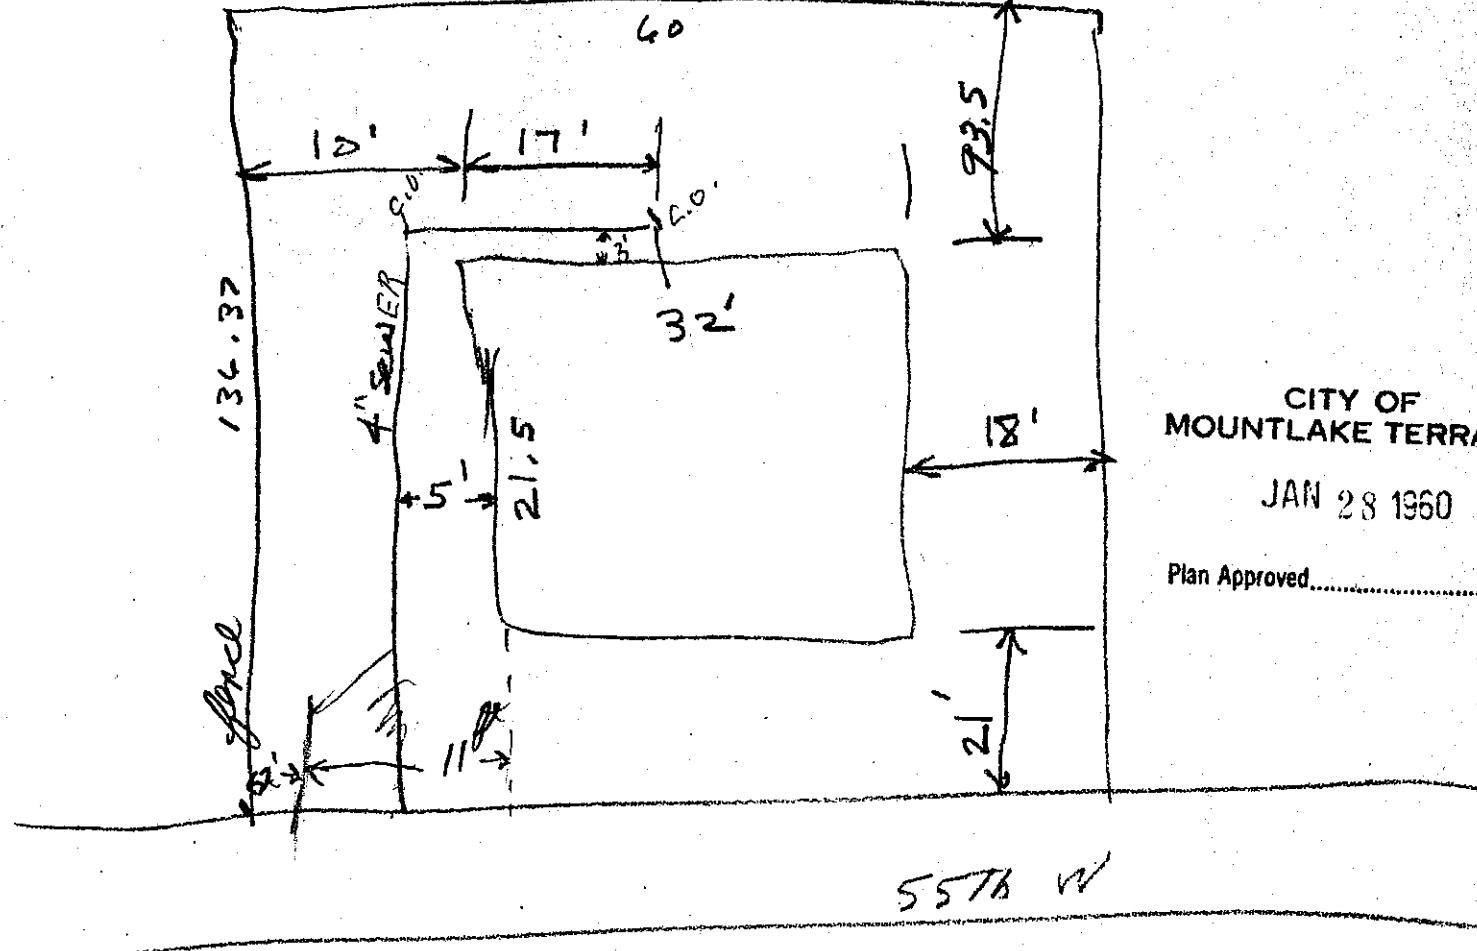

CITY OF
MOUNTLAKE TERRACE

JAN 28 1960

Plan Approved.....

Date

Approved:

BACKFILL WORK ORDER ISSUED

DEPOSIT, \$ 10.00

SEWER WORK ORDER ISSUED

57621

DATE 1-28-60 BY

Scott in Holton INS CON

The City of Mountlake Terrace

APPLICATION

for

SIDE SEWER PERMIT

OUTSIDE INSIDE REPAIRS

O. B. Leigh
CARD No.

EASEMENT No.

OWNER

O. B. Leigh

HOUSE No. 23610 - 55 WEST

CONTRACTOR


Self

PERMIT No. 1510

STREET

AVENUE LOT NO. None (Acreage) BLOCK NO. None (Acreage)

NAME ADD.

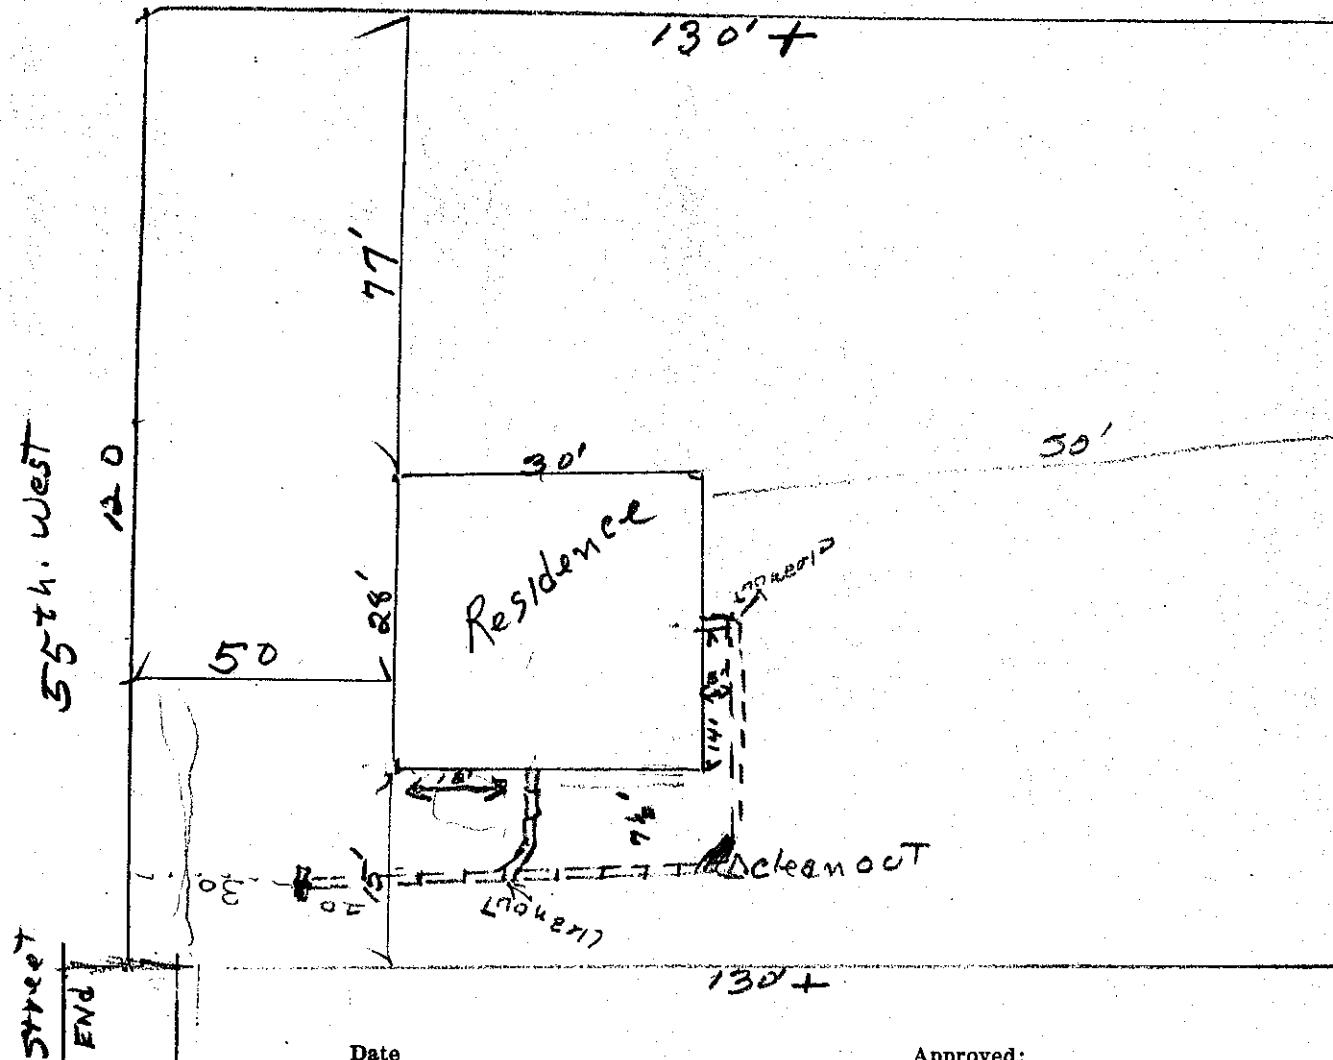

CITY OF
MOUNTLAKE TERRACE

APR 11 1960

Plan Approved

BACKFILL WORK ORDER ISSUED

DEPOSIT, \$ 10.00

SEWER WORK ORDER ISSUED

2-26-60

Date Approved:

DATE

4/11/60 BY J. Failean

SIDE SEWER AS BUILT

CITY OF MOUNTLAKE TERRACE

55TH AVE

(CUL-DE-SAC)

OWNER: TILA & BRENDA ABIAO

ADDRESS: 23612 55TH AVE W.


CONTRACTOR: LUTZ BACKHOE

PERMIT NO.: U-91-21

ISSUE DATE: 8-1-91

INSPECTED BY: D.M.S.

DATE: 8-18-91

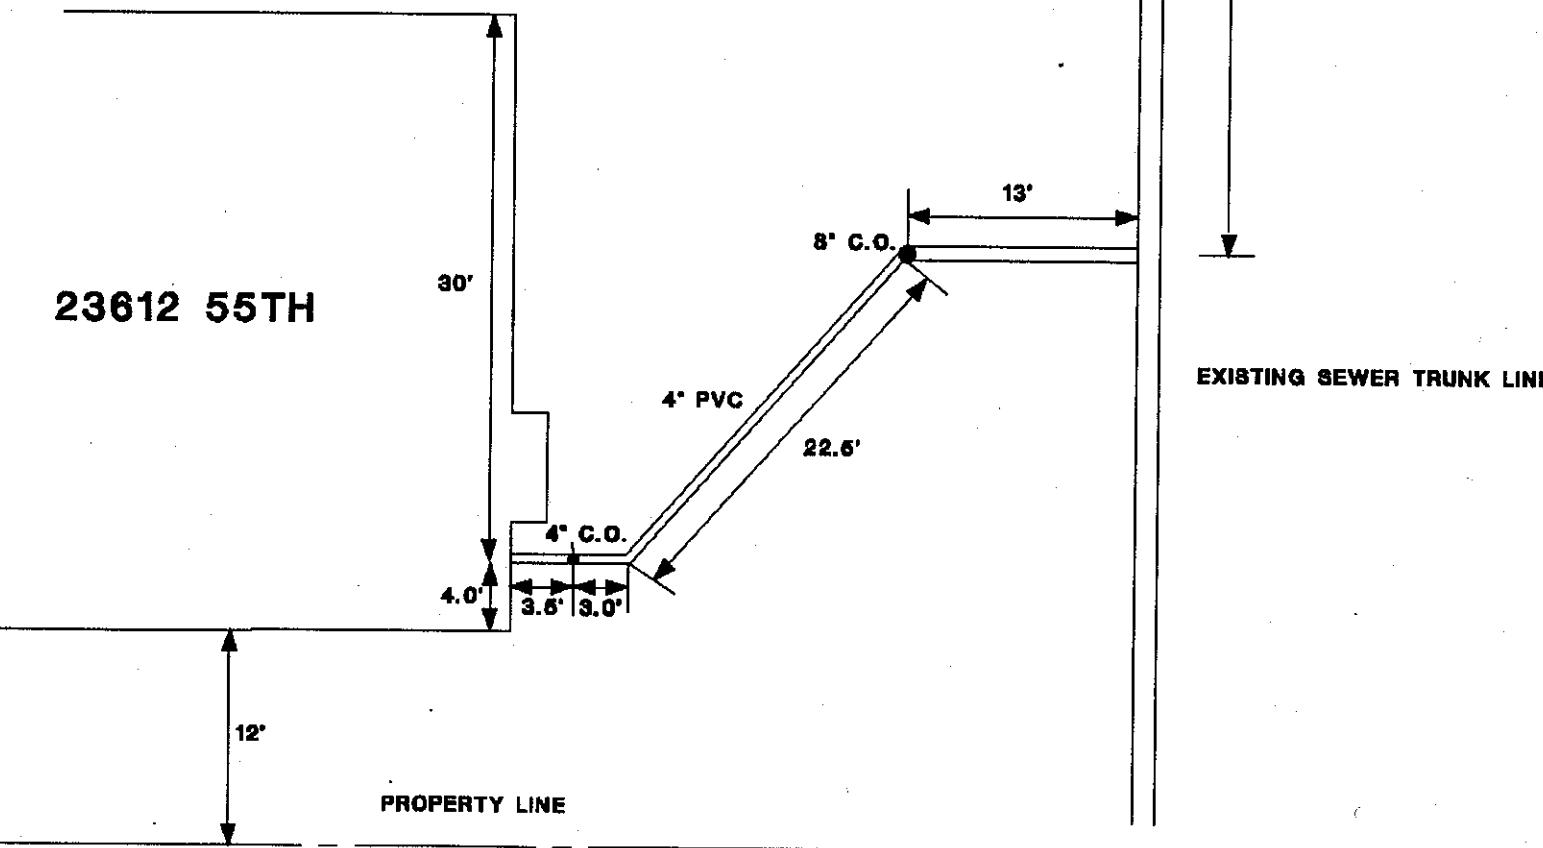

The City of Mountlake Terrace

APPLICATION

for


SIDE SEWER PERMIT

OUTSIDE INSIDE REPAIRS

BILL T. KRONE
CARD NO.

EASEMENT No.

OWNER Bill Chrone PERMIT No. 1690
HOUSE No. 23801 - 55th W. CONTRACTOR B+E.
STREET AVENUE LOT No. 21 BLOCK No. 2
NAME ADD. Replat of Land tract

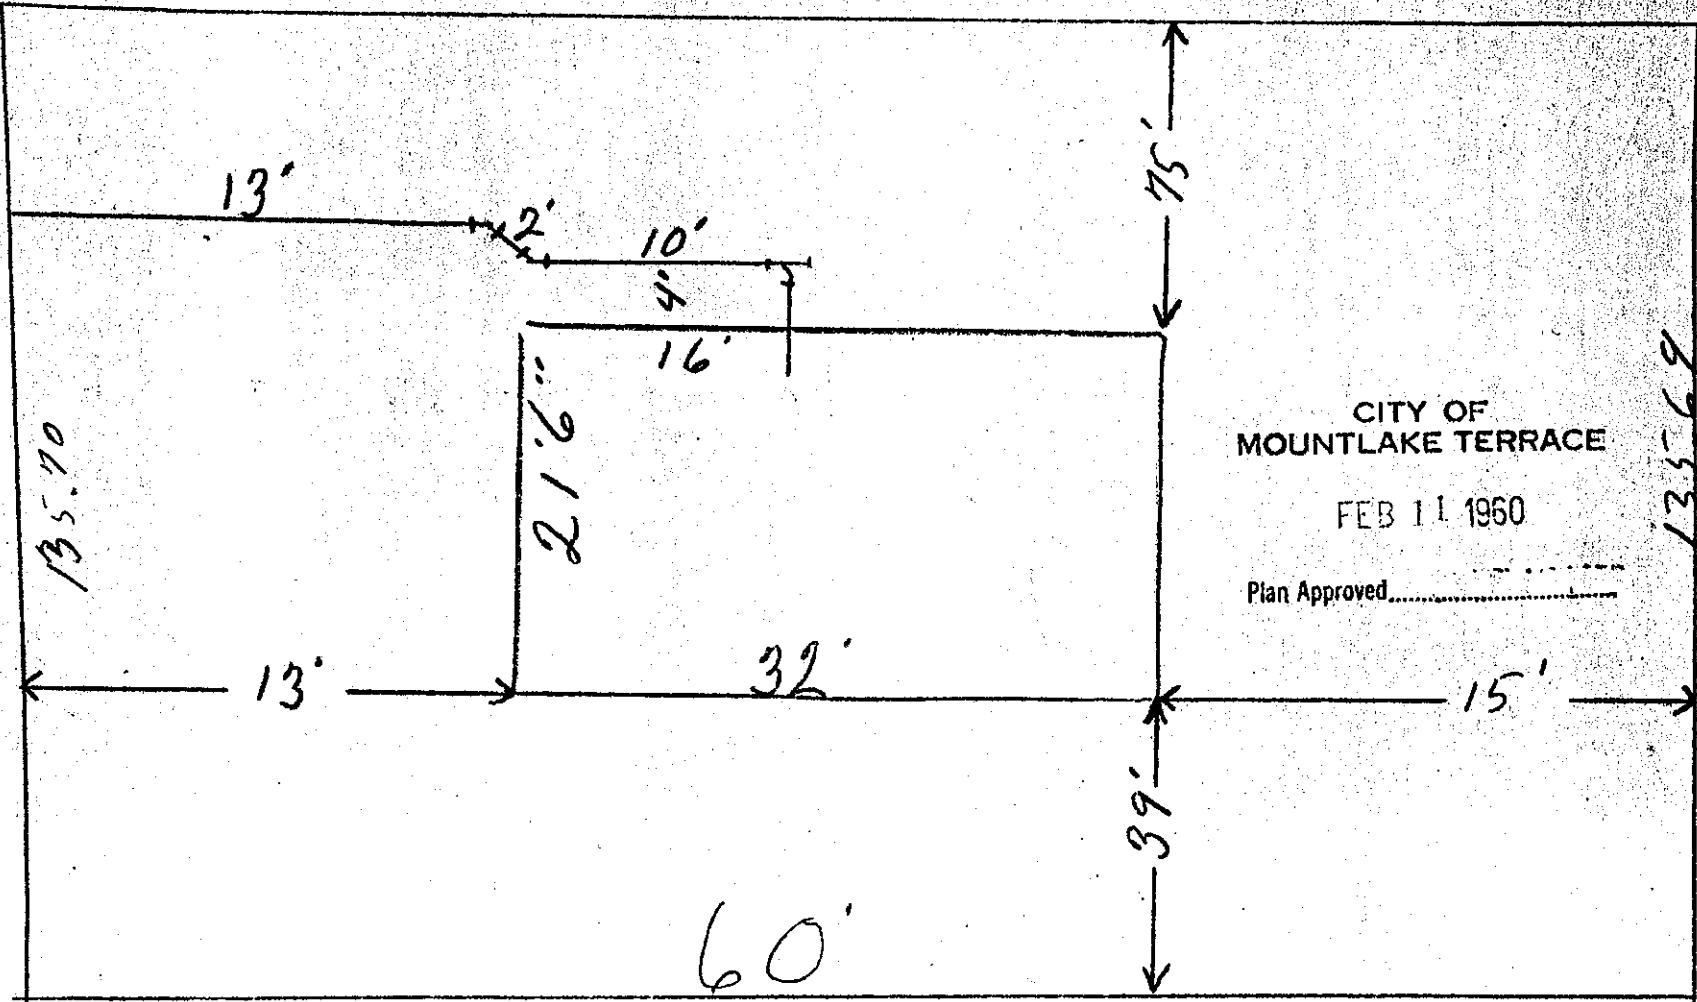

CITY OF
MOUNTLAKE TERRACE

FEB 11 1960

Plan Approved

Date

Approved:

BACKFILL WORK ORDER ISSUED
SEWER WORK ORDER ISSUED

DEPOSIT \$10 ~~10~~ 2-10-60

DATE 2-11-60

BY

Scotton Holton INSTCON

5782

The City of Mountlake Terrace

APPLICATION

for

SIDE SEWER PERMIT

OUTSIDE INSIDE REPAIRS

CARD NO.

1367604

EASEMENT No.

OWNER Hinton, J. M.
HOUSE No. 2380 5-55 th W.


CONTRACTOR

STREET
AVENUE LOT No. 23

BLOCK No. 1

PERMIT No. 1120

NAME ADD Replat of Lind Tract

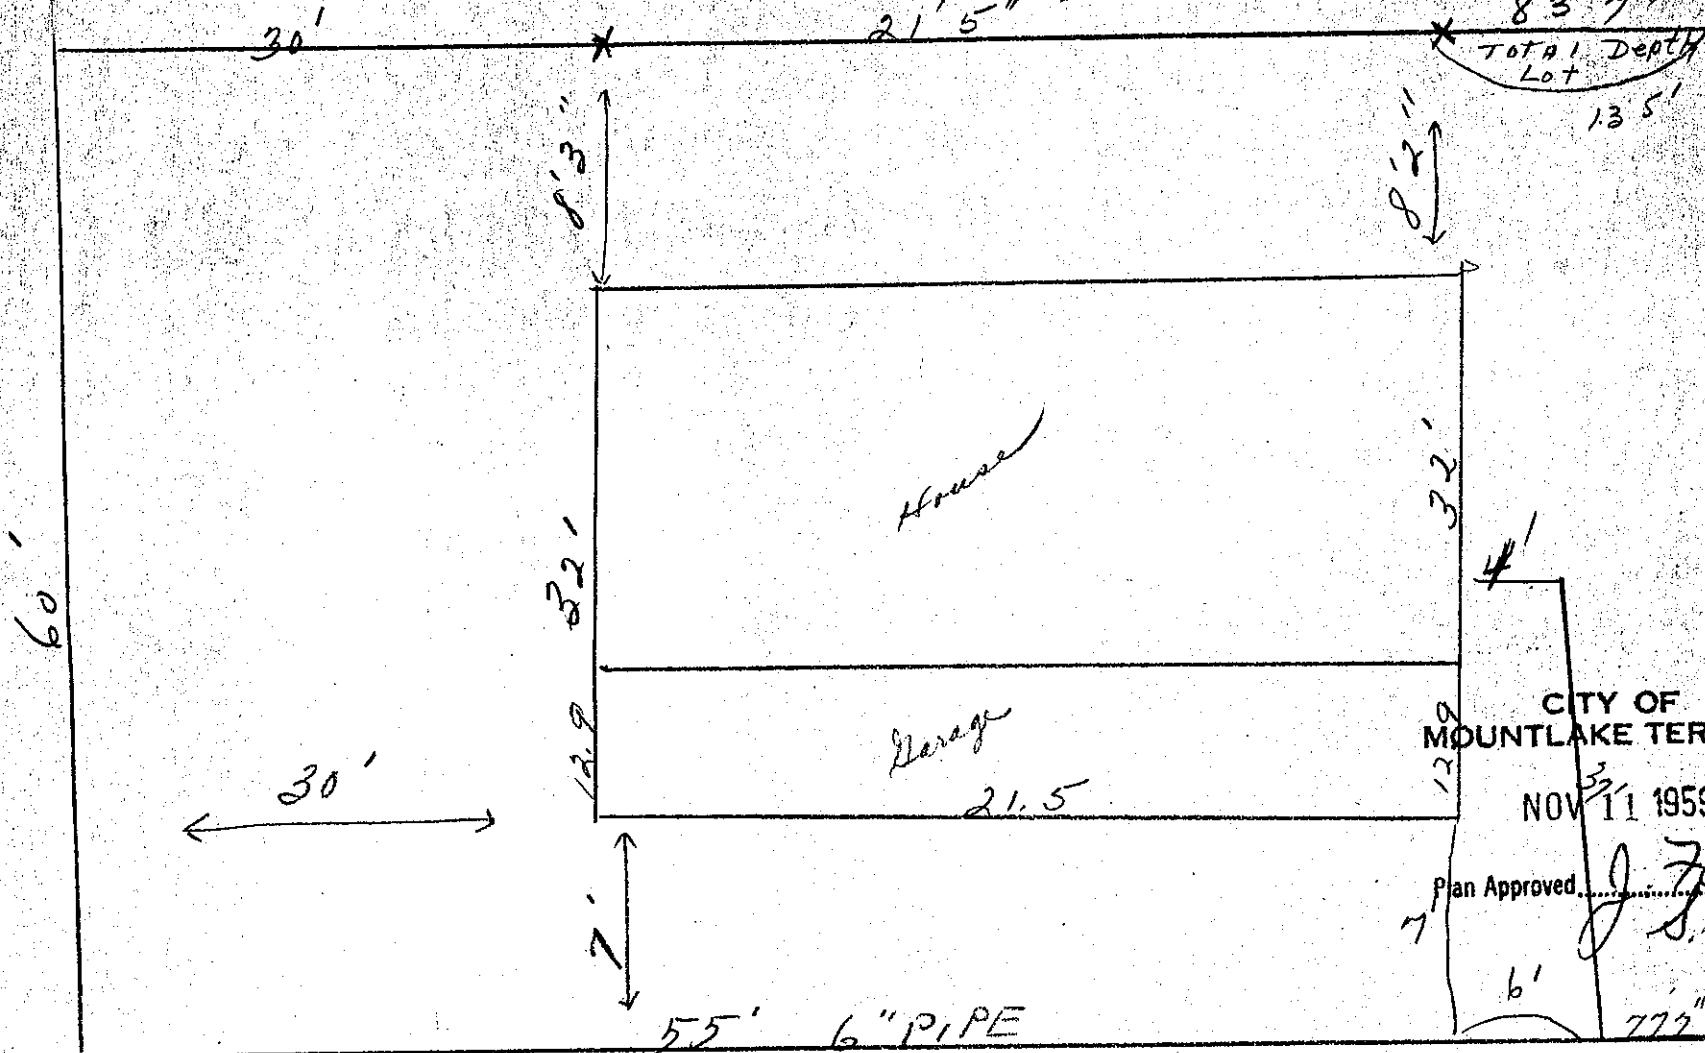

Date


Approved:

BACKFILL WORK ORDER ISSUED

DEPOSIT, \$

SEWER WORK ORDER ISSUED

DATE 11-11-59 BY Scotton Holton IWSN

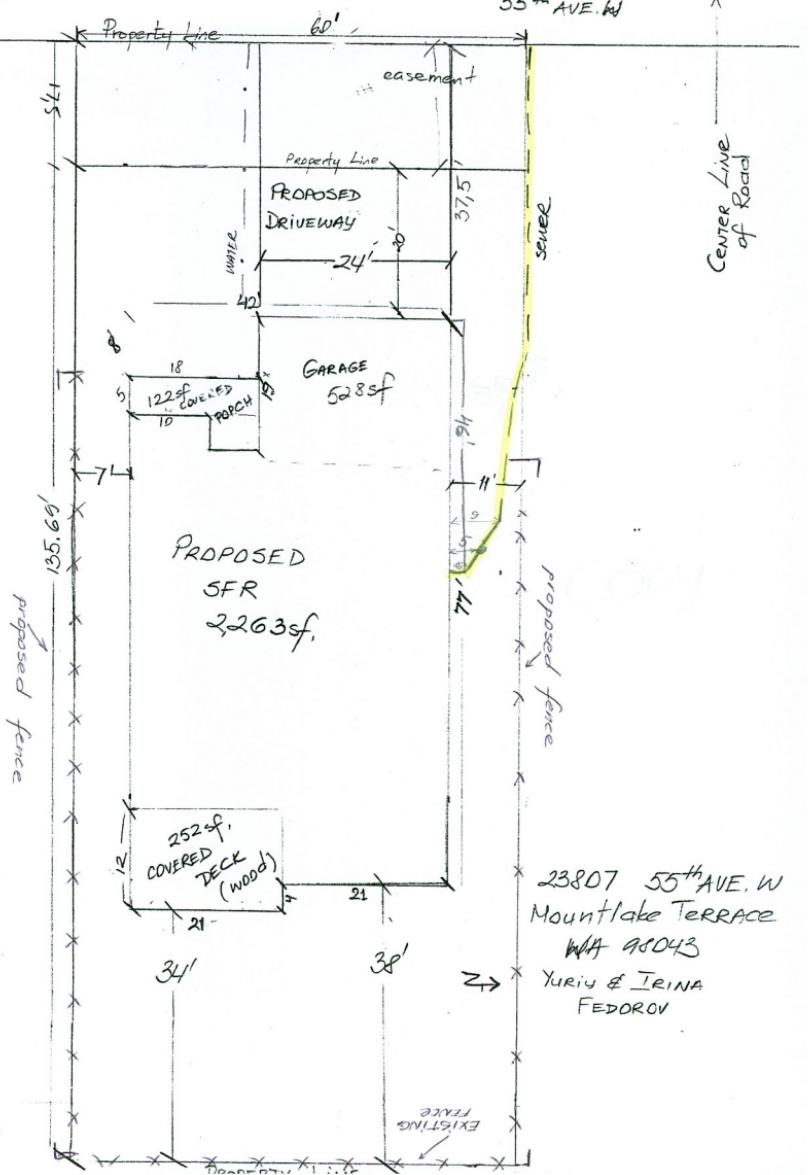

The City of Mountlake Terrace

APPLICATION

for

SIDE SEWER PERMIT

OUTSIDE INSIDE REPAIRS

CARD NO.

EASEMENT No.

OWNER

James W. Miner

HOUSE NO.

23901 - 55th W.

CONTRACTOR

B. & E.

PERMIT No. 1619


STREET

AVENUE LOT No. 26

BLOCK NO. 1

NAME ADD.

Replat of Lind tracts

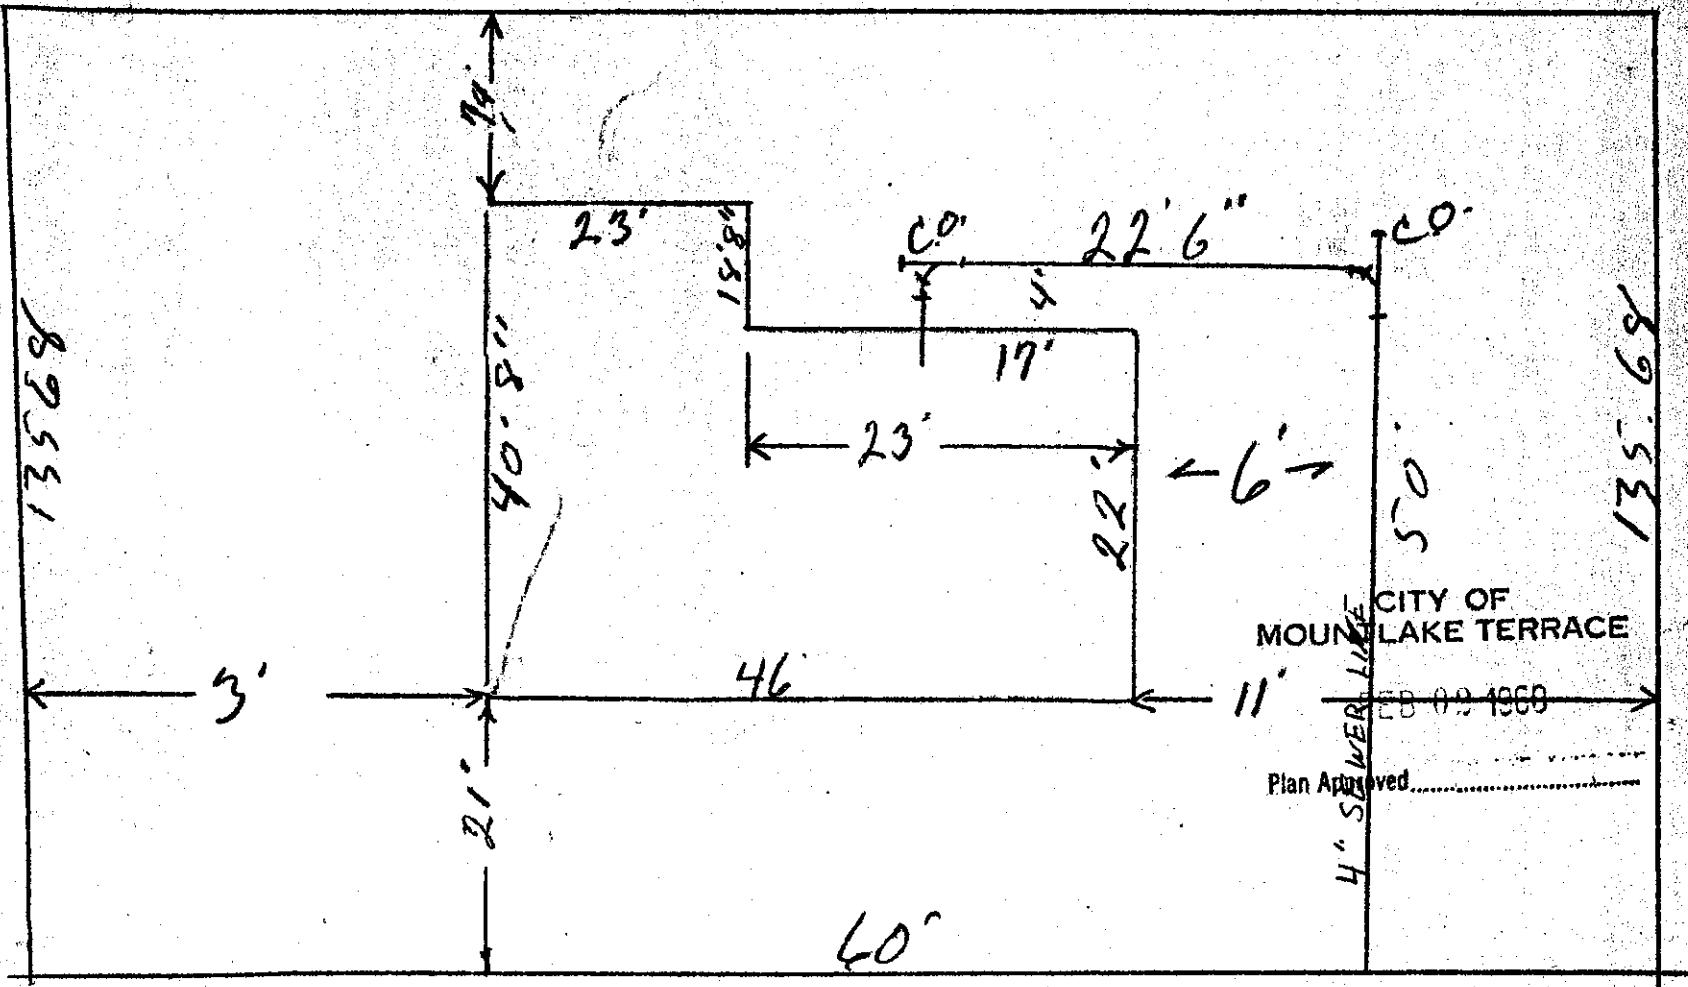

Date

Approved:

BACKFILL WORK ORDER ISSUED
SEWER WORK ORDER ISSUED

DEPOSIT, \$10 ⁰⁰

52-60
5897

DATE 2-3-60

BY

Scott M Holton INC CO

The City of Mountlake Terrace

APPLICATION

for

SIDE SEWER PERMIT

OUTSIDE INSIDE REPAIRS

CARD No.

EASEMENT No.

OWNER HARVEY Hardisty

HOUSE No. 23903 lot 55 1/4

CONTRACTOR Tasker Const. Co.

PERMIT No. 2517

STREET

AVENUE LOT No. LOT 27


BLOCK No.

NAME ADD

CITY OF
MOUNTLAKE TERRACE

APR 21 1960

Plan Approved

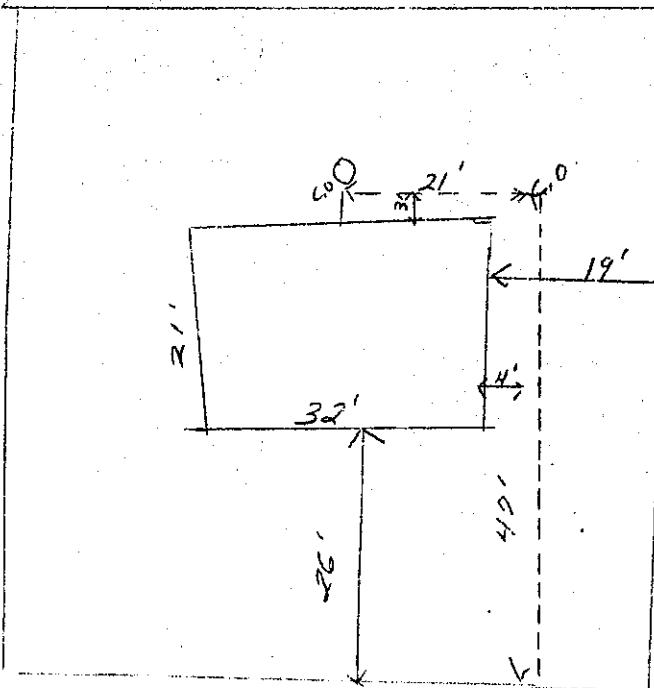

Date

BACKFILL WORK ORDER ISSUED

DEPOSIT, \$ 10.00 4/21/60 Approved:

SEWER WORK ORDER ISSUED

1299

DATE 4-25-60 BY

I.M. Holtom & Son

The City of Mountlake Terrace

APPLICATION

for

SIDE SEWER PERMIT

OUTSIDE INSIDE REPAIRS

CARD No.

EASEMENT NO.

1359955

OWNER Thomas Marsham

HOUSE No. 23905-55th w. M.L.T.

CONTRACTOR

B. and C

PERMIT No. 1072

STREET


AVENUE LOT NO.

28

BLOCK No.

1

NAME ADD.

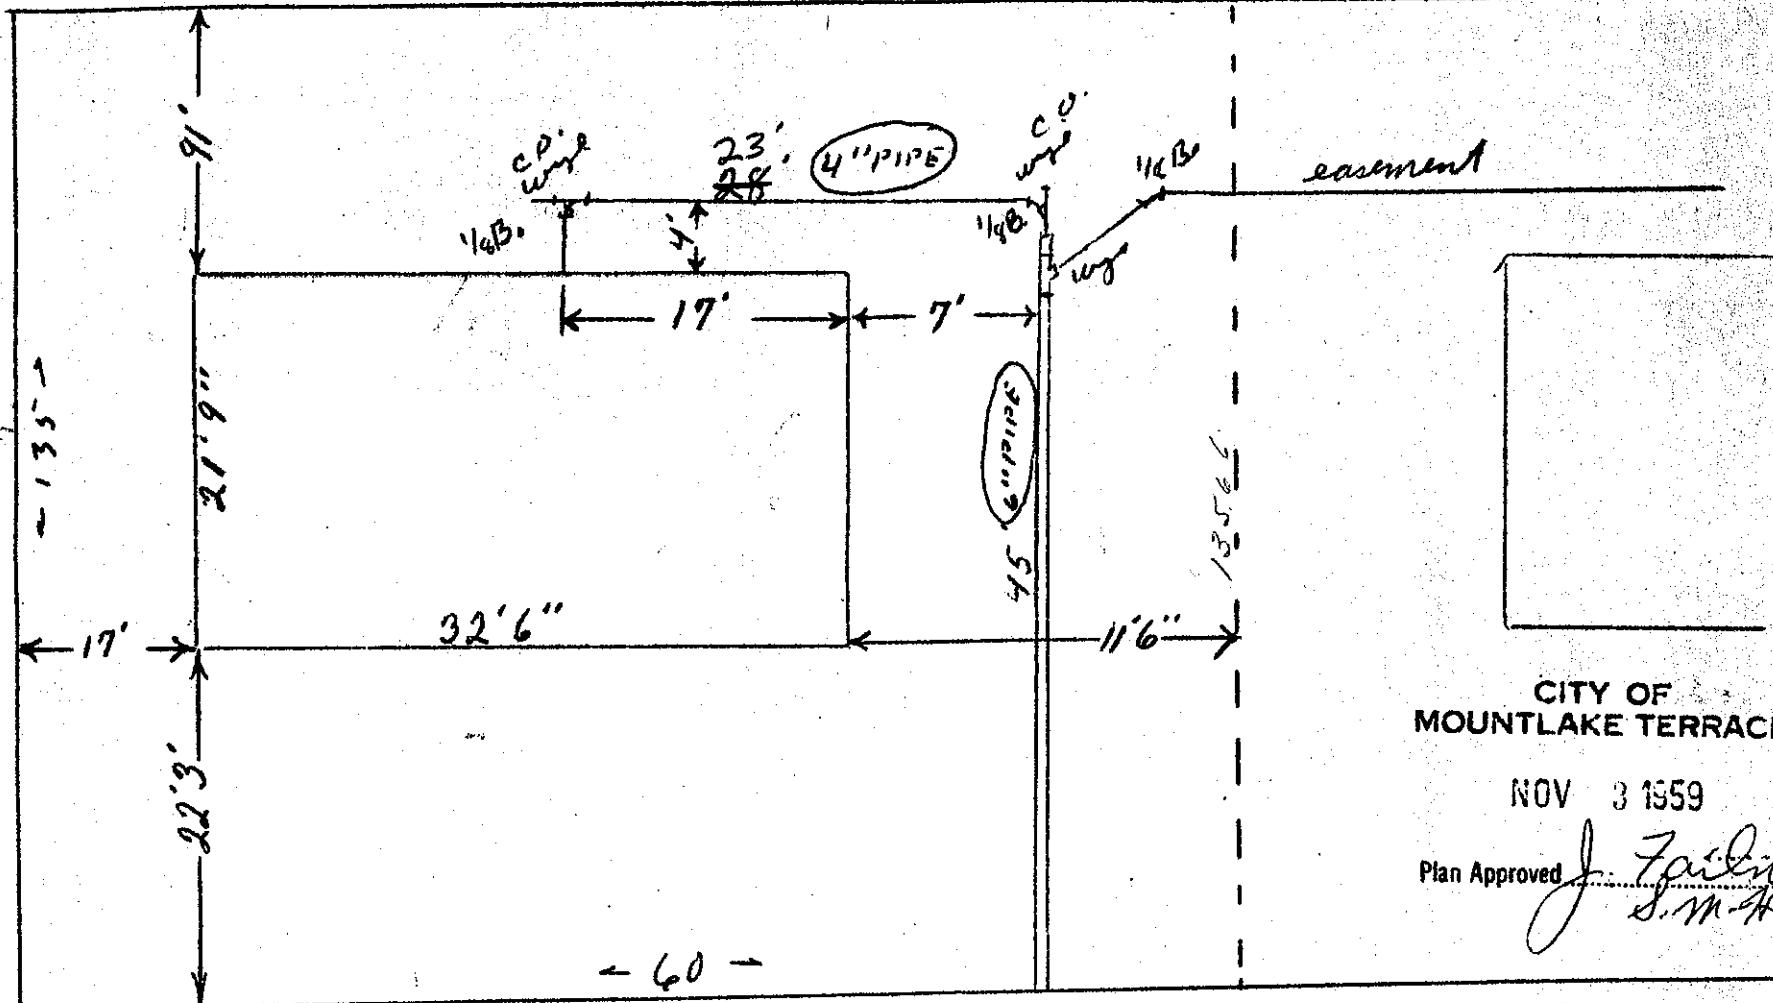

CITY OF
MOUNTLAKE TERRACE

NOV 3 1959

Plan Approved

J. Zuckner
S.M.H.

- 60 -

Approved:

DATE 11-3-59

BY Scott M Holton INS

BACKFILL WORK ORDER ISSUED

DEPOSIT, \$

SEWER WORK ORDER ISSUED