

APPLICATION

for

SIDE SEWER PERMIT

OUTSIDE ☐ INSIDE ☐ REPAIRS ☐

J. S. Baker

CARD No.

EASEMENT No. 1353788

The City of Mountlake Terrace

OWNER JAMES S. Baker

CONTRACTOR


PERMIT No. 2316

HOUSE No. 23306 W. 55

STREET AVENUE LOT No. 13

BLOCK No. 1

NAME ADD. add no 6

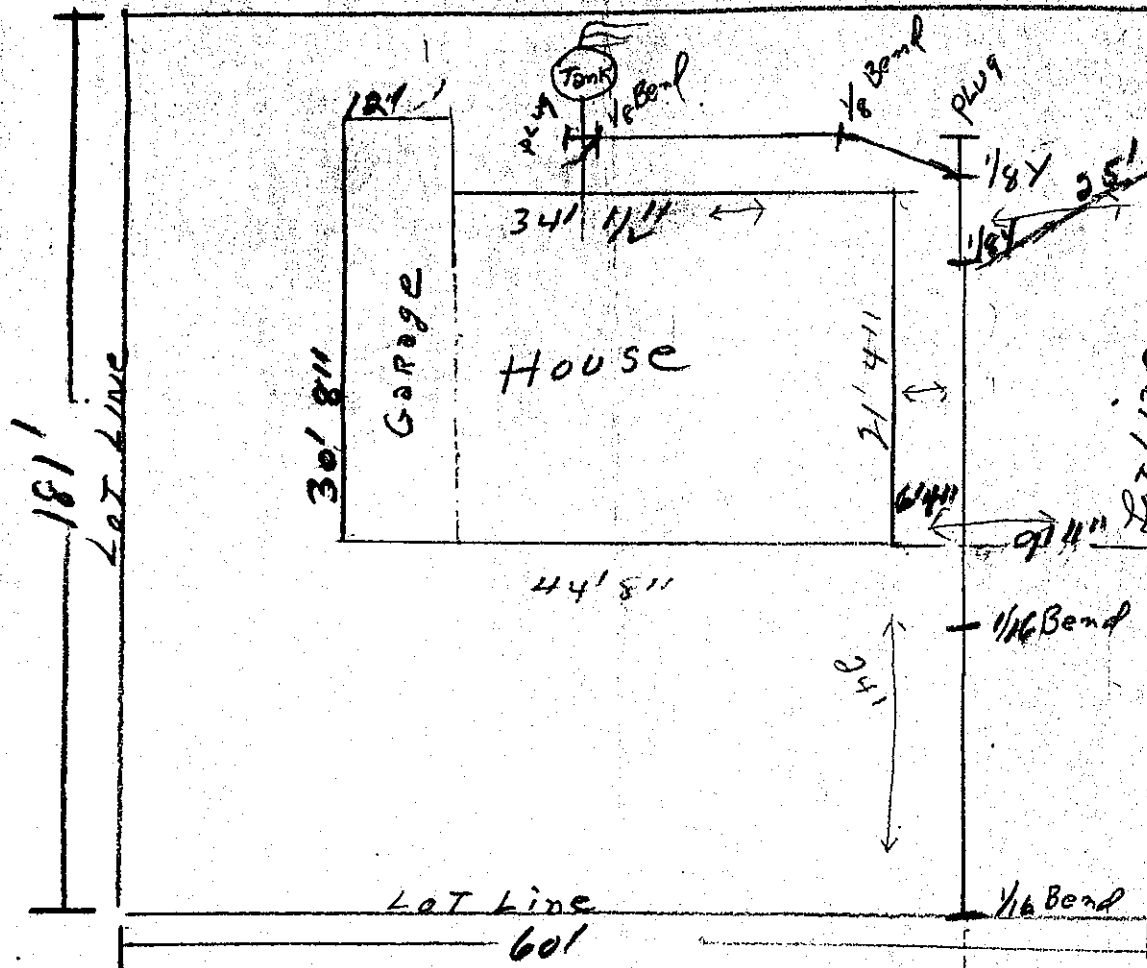

CITY OF MOUNTLAKE TERRACE

APR 27 1960

Plan Approved S. M. Ahee

BACKFILL WORK ORDER ISSUED

DEPOSIT, \$10.00

3/31/60

Approved:

Sewer Main

SEWER WORK ORDER ISSUED

1094

DATE

4-27-60

BY

S. M. Helton INSt. CO. W