

APPLICATION

for

CARD No. _____

The City of Mountlake Terrace


SIDE SEWER PERMIT

OUTSIDE ☐ INSIDE ☐ REPAIRS ☐

EASEMENT No. _____

OWNER CATHLEEN MICHKOFF CONTRACTOR CITY CREVIS FABIAN II, PAUL McP PERMIT No. NONE

HOUSE No. 4001 224th ST. SW. STREET CEDEAR PARK AVENUE LOT No. 50 BLOCK No. _____

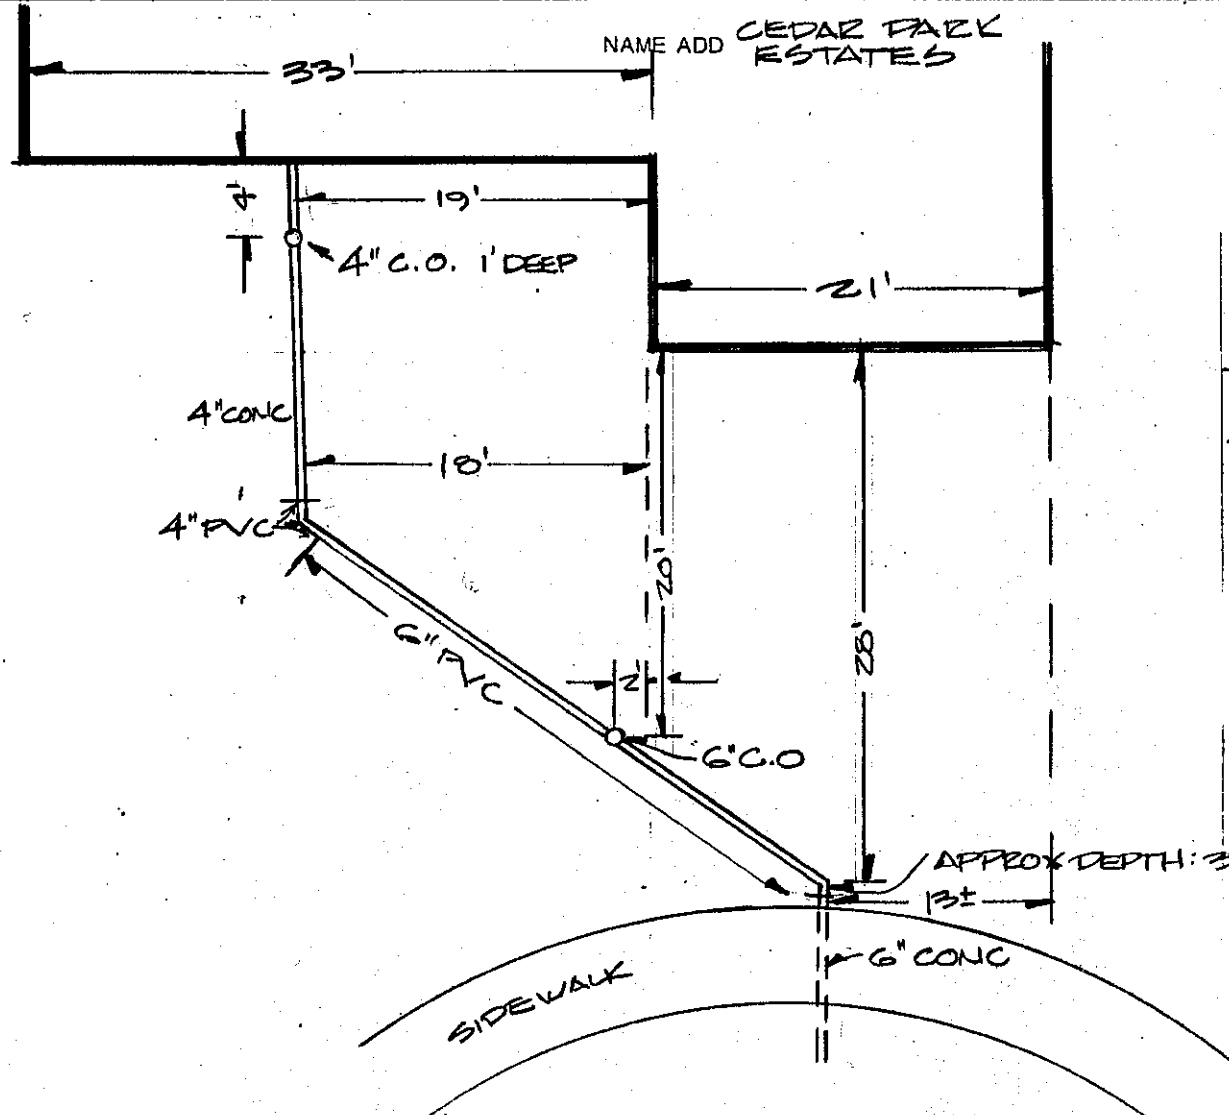

HISTORY

PREVIOUS SIDE SEWER LATERAL RAN TO WEST BUT HAD ADVERSE GRADE. CITY CONNECTED ON TO LATERAL IN DRIVEWAY AND REKEYED PORTION OF PRIVATE SIDE SEWER.

BACKFILL WORK ORDER ISSUED MARCH 8, 1984 DEPOSIT, \$ _____ DATE MAR 8, 1984 BY DRAWN: W. VAN DY