

The City of Milllake Terrace

SIDE SEWER PERMIT

CARD No. _____

H & H Homes P O Box 644 Lynnwood, Wash 98036

OUTSIDE ☒ INSIDE ☐ REPAIRS ☐


EASEMENT No. _____

OWNER _____ CONTRACTOR Universal Utility Contractors Inc.
11411 203rd St N E Woodenville

PERMIT No. 74-18

HOUSE No. 6605 224 TH ST. S.W. STREET 7 AVENUE LOT No. 7 BLOCK No. _____

NAME ADD Greenridge

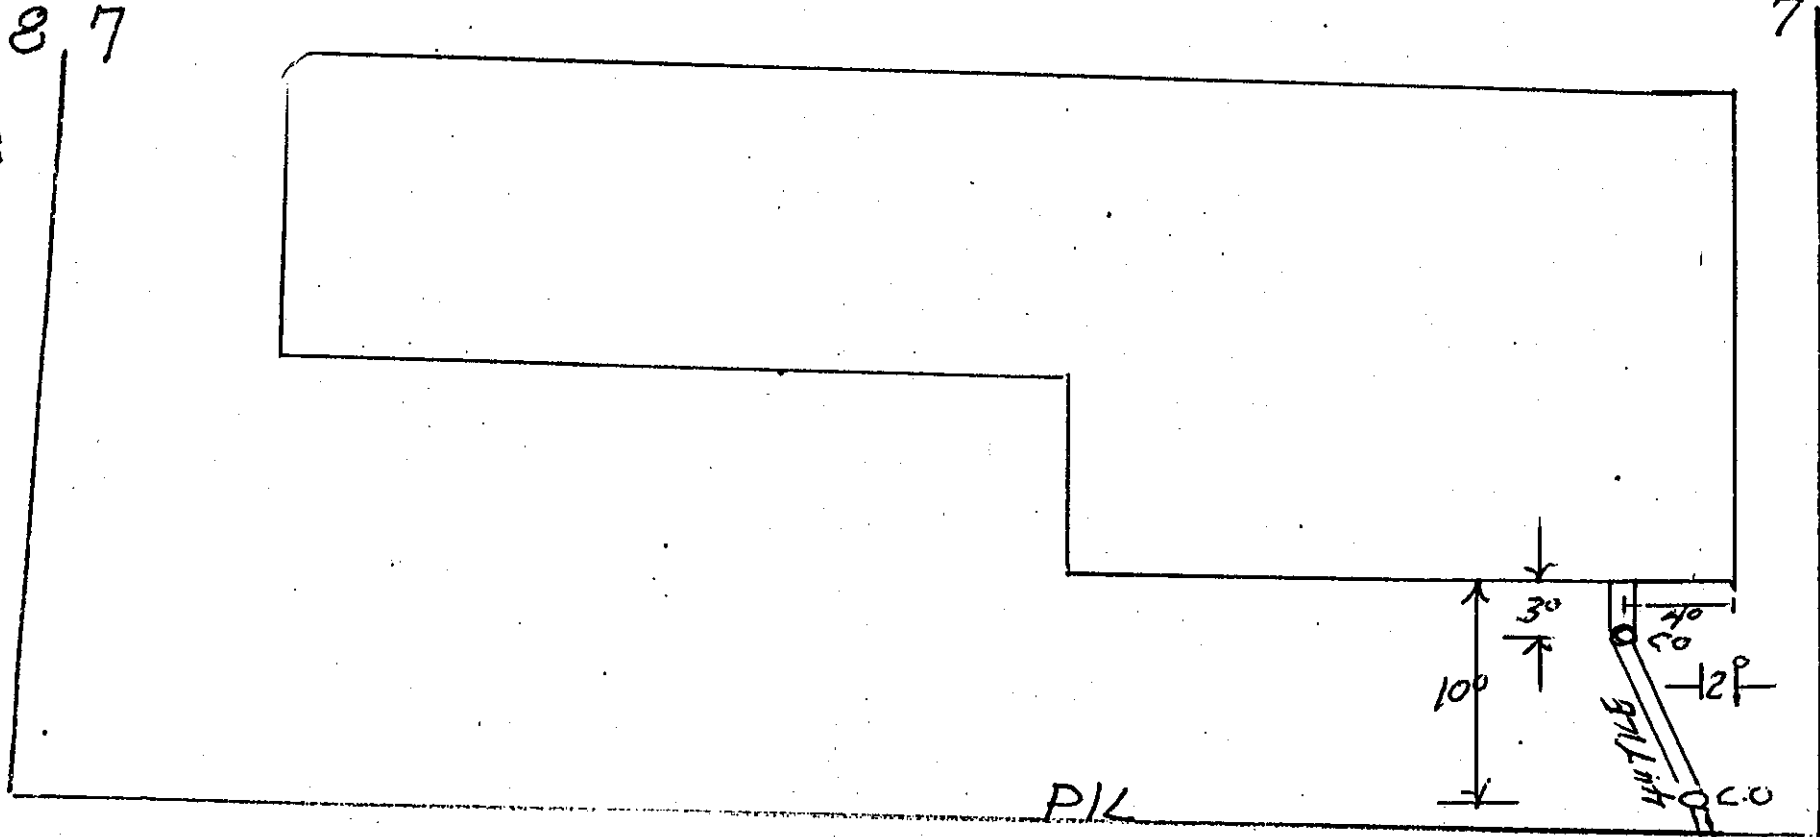

SAN
MHO

8th S.S.

224 TH ST S.W.

Side Sewer Permit No. U-7-75 Issued 2/26/75 to Lynnwood Septic Tank Co. by Fred H Smith

JACKFILL WORK ORDER ISSUED. June 14, 1974

DEPOSIT, \$ 20.00

Approved: _____

June 20, 1974

SEWER WORK ORDER ISSUED May 16, 1974

DATE _____

BY

Fred H. Smith