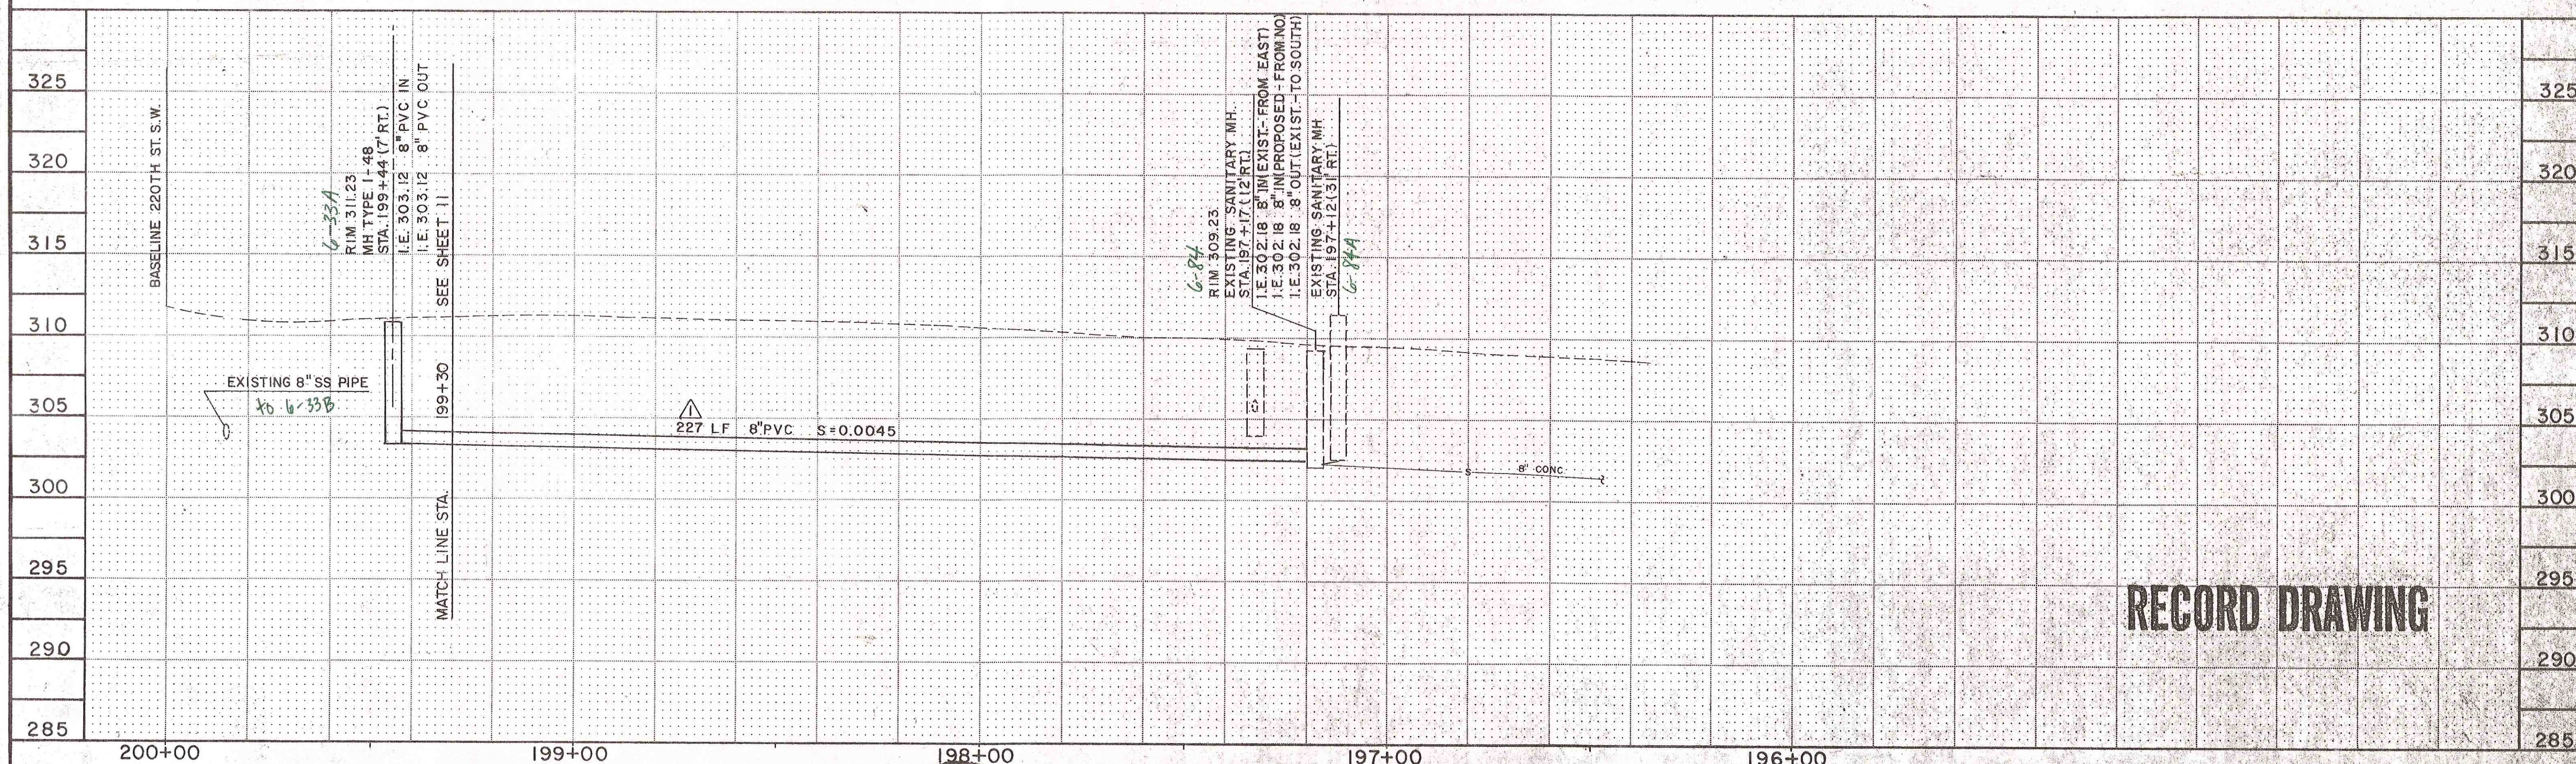
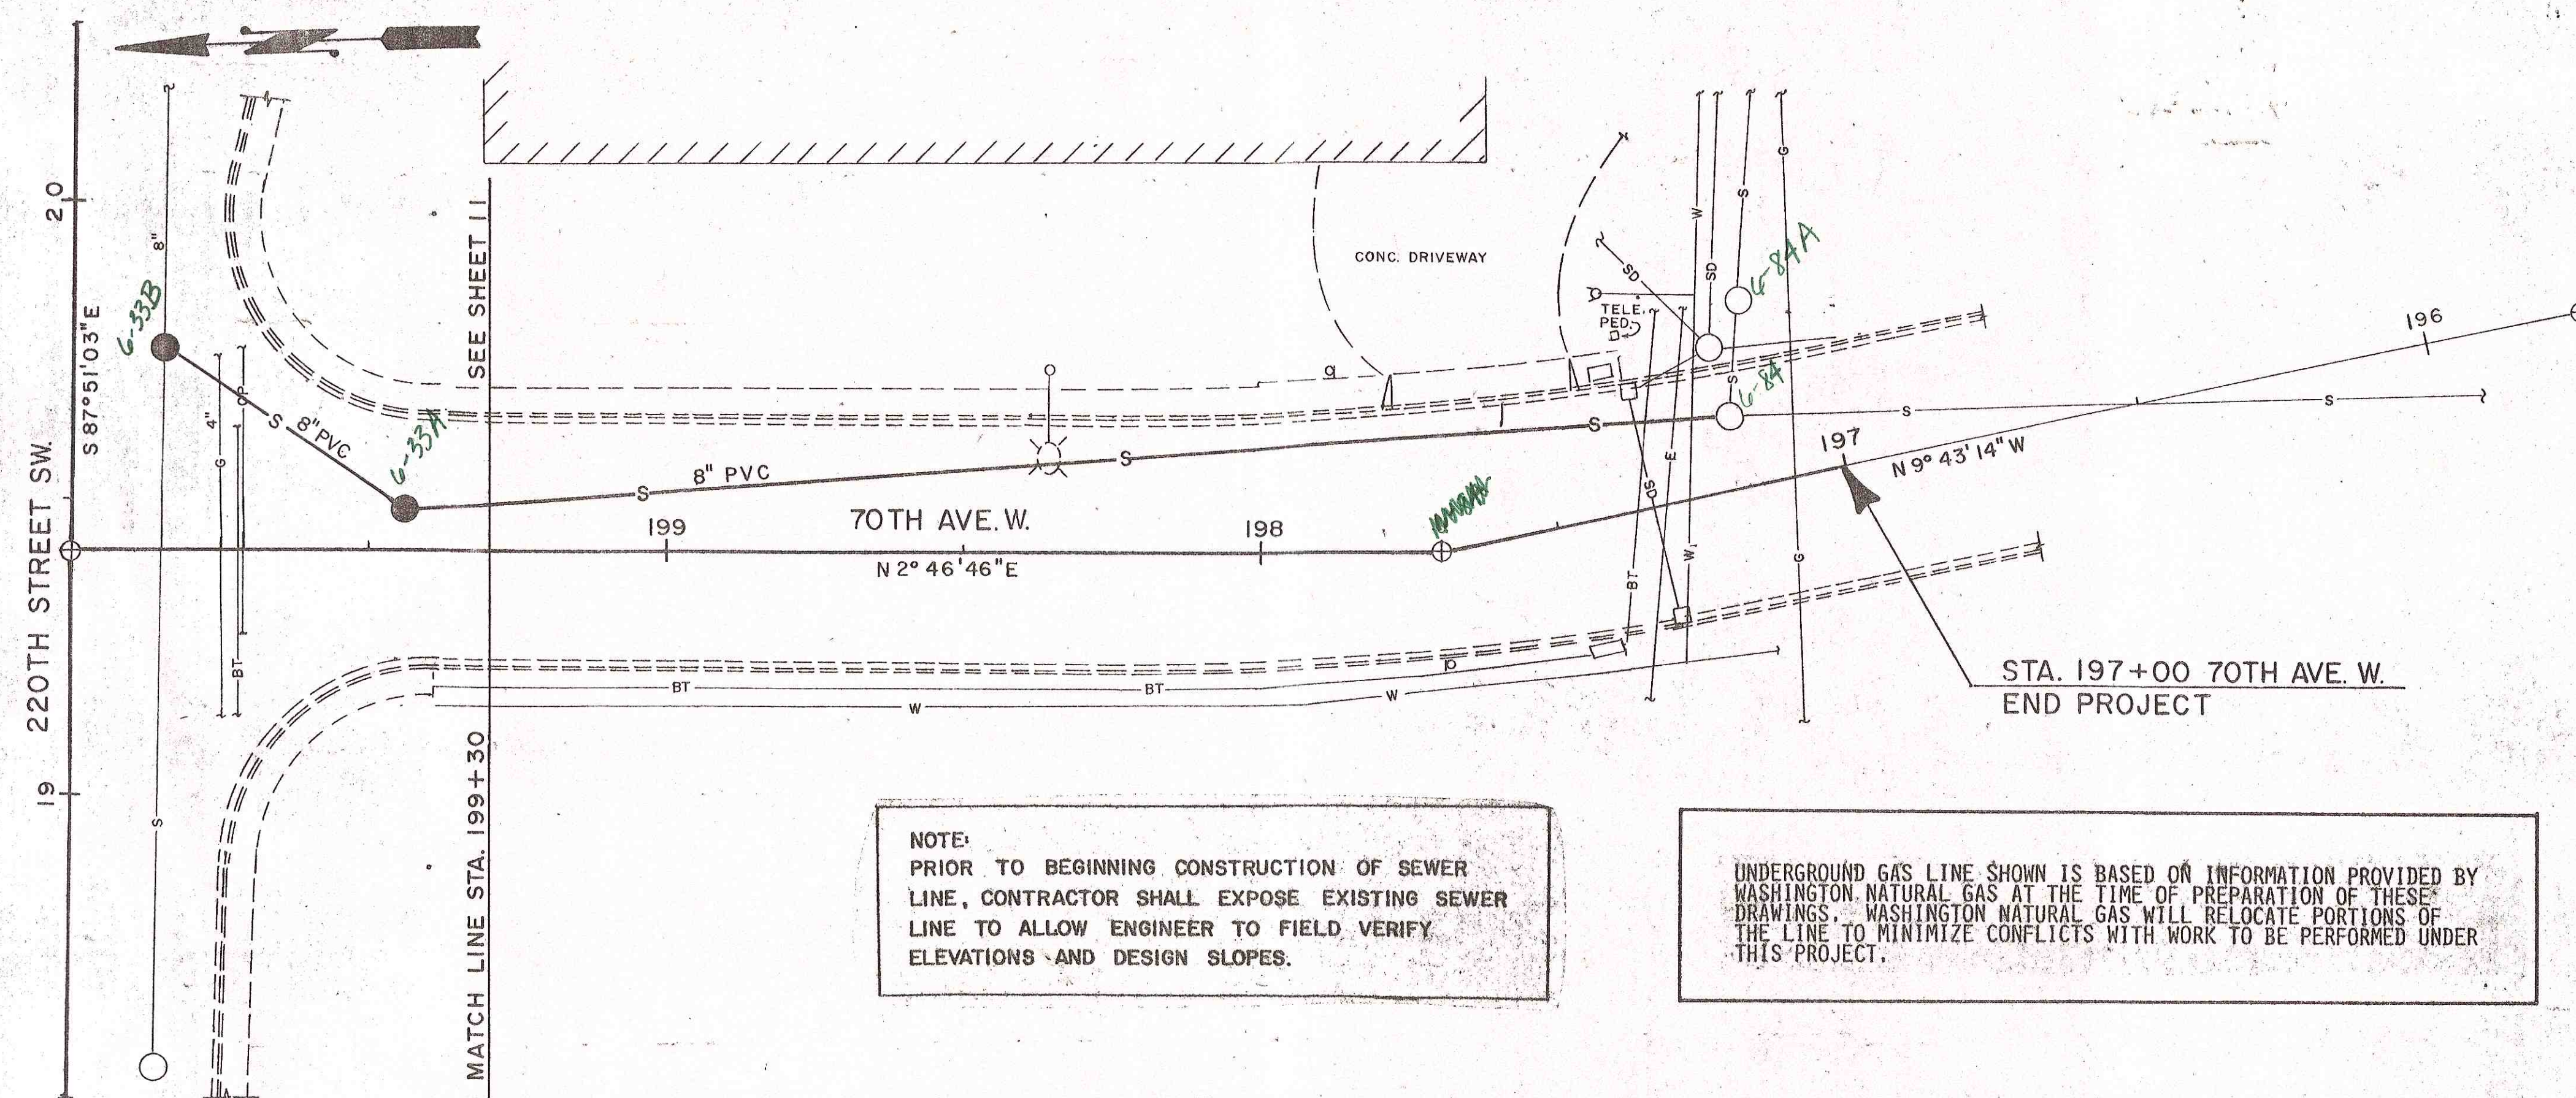


[illegible]

# RECORD DRAWING

[illegible]

6-30