

The City of Montlake Terrace

for
SIDE SEWER PERMIT
OUTSIDE ☒ INSIDE ☐ REPAIRS ☐

CARD No.

EASEMENT No.

OWNER Linn Hemes

CONTRACTOR Lynnwood Septic



U 18 77
PERMIT No.

HOUSE No. 4511 225th Pl SW

STREET
AVENUE LOT No. 3

BLOCK No.

NAME ADD Hidden Highlands No 2

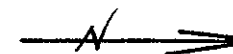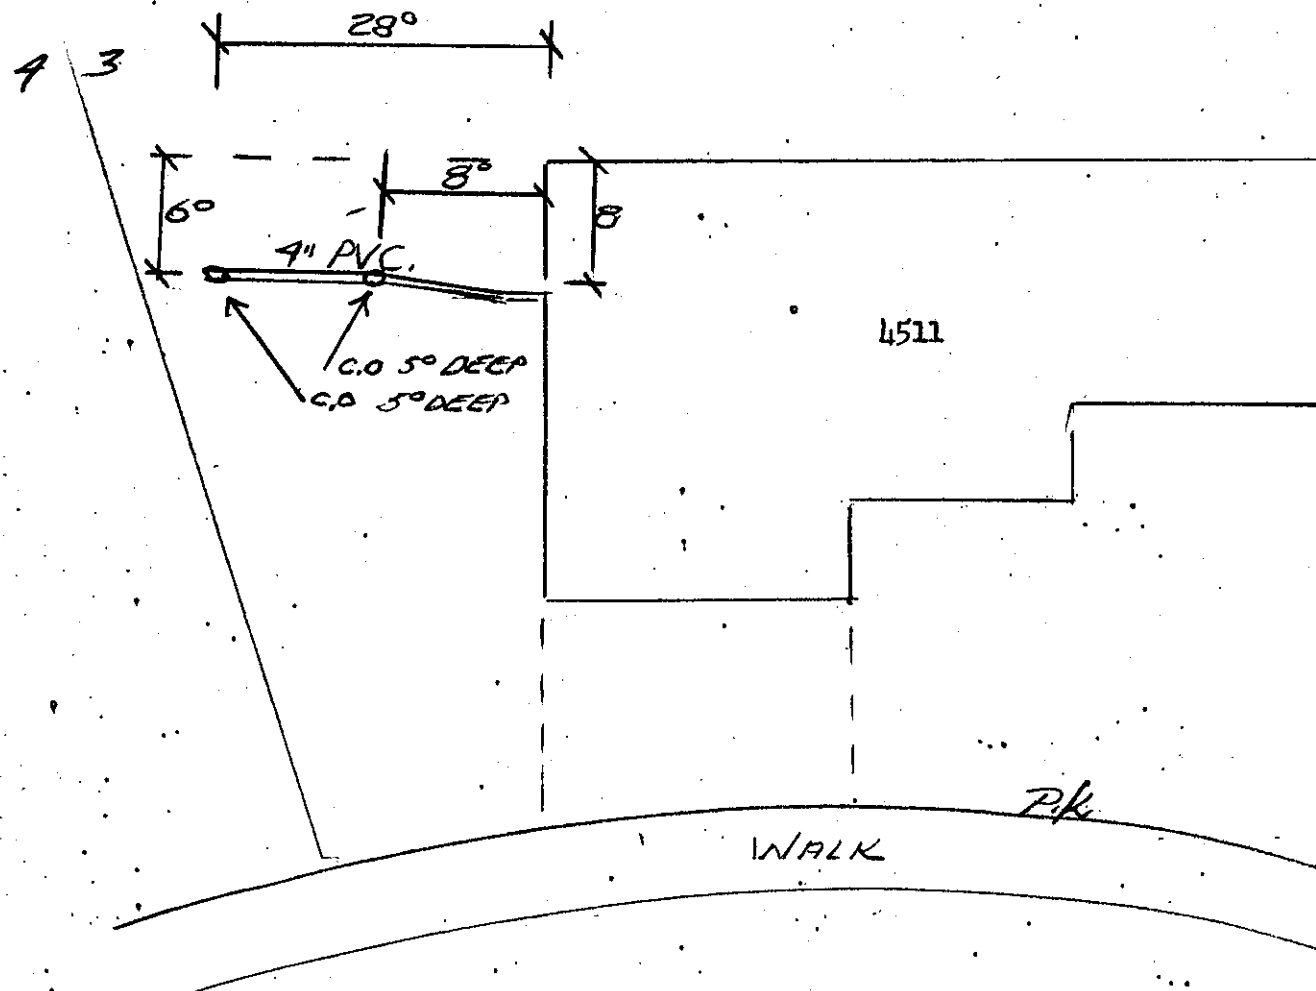

LOT 3 2

BACKFILL WORK ORDER ISSUED 5 2 77 Date
SEWER WORK ORDER ISSUED 3 18 77 DEPOSIT, \$ 20

Approved:

DATE 5 2 77

BY

Fred H. Smith