

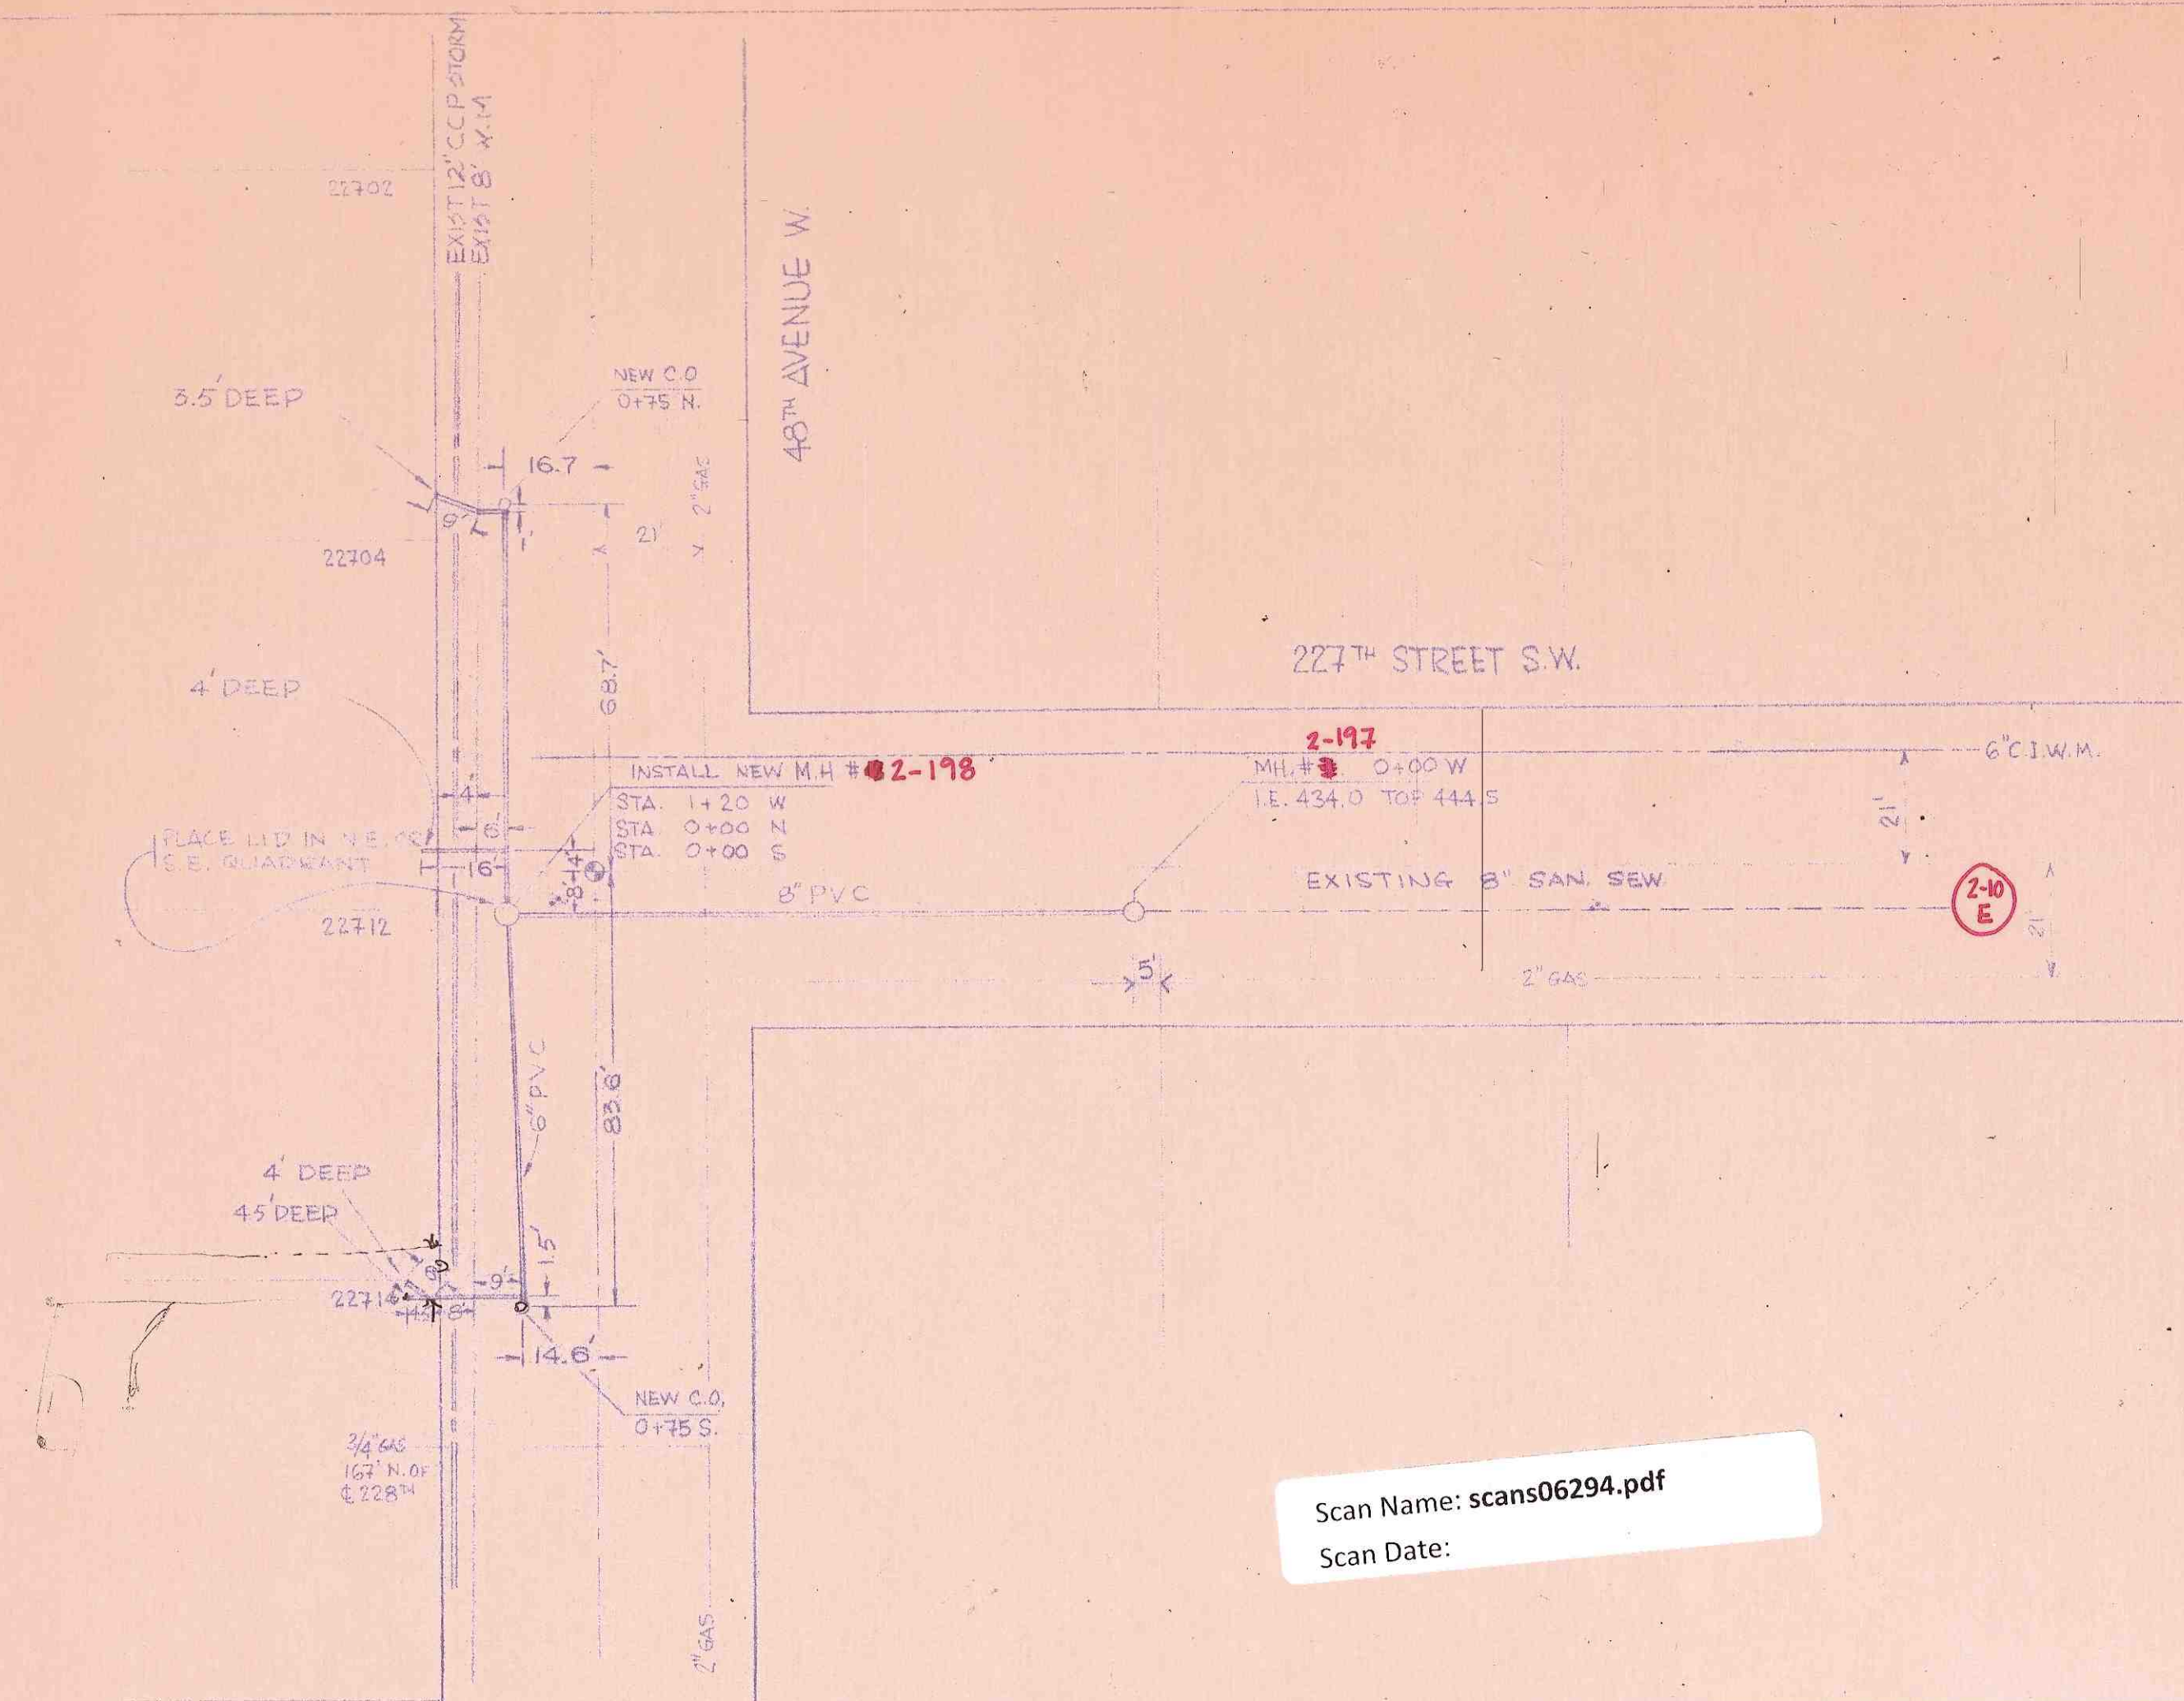
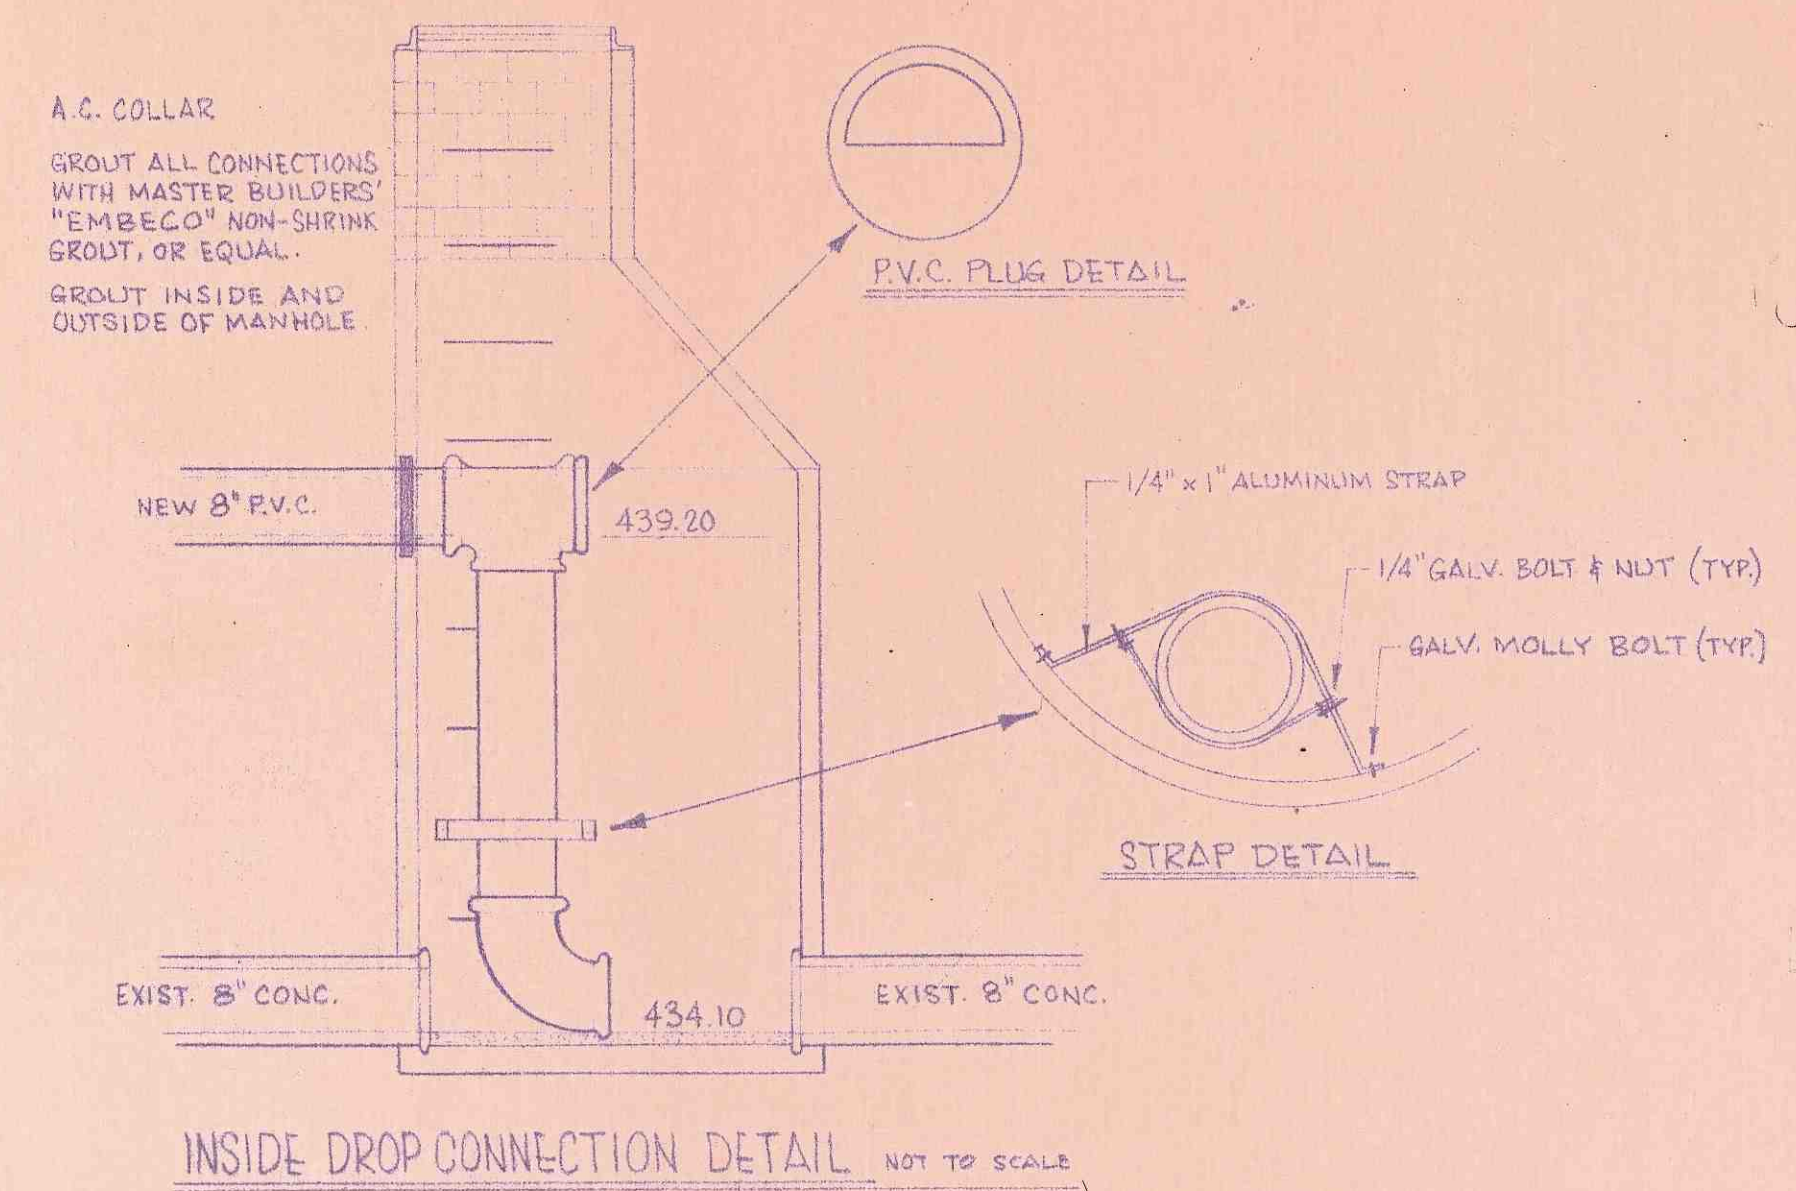


| | | |
|------|-----------|--|
| PLAN | DATE | |
| | BY | |
| | SURVEYED | |
| | NOTE BOOK | |

| | | |
|---------|-----------|--|
| PROFILE | DATE | |
| | BY | |
| | SURVEYED | |
| | NOTE BOOK | |

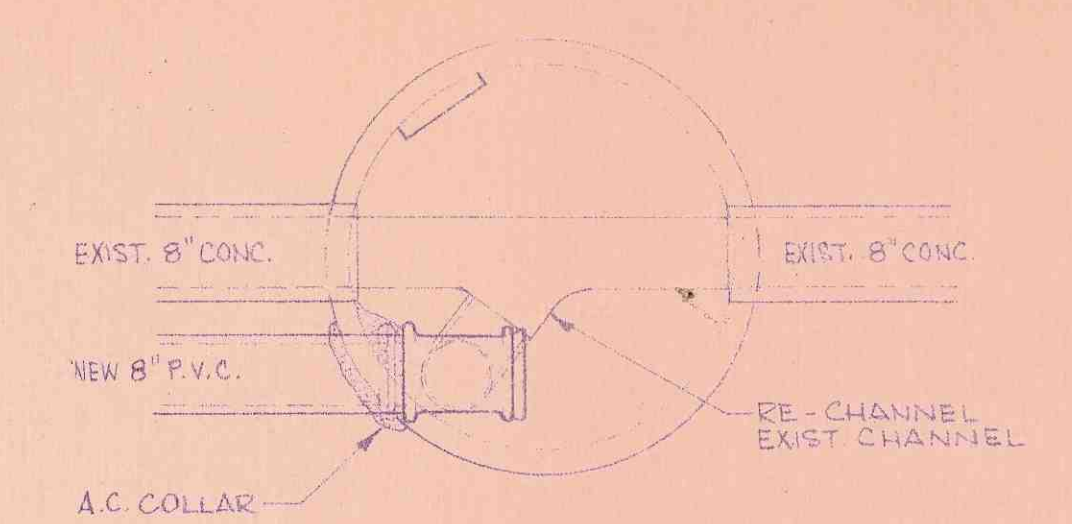

Scan Name: scans06294.pdf
Scan Date:

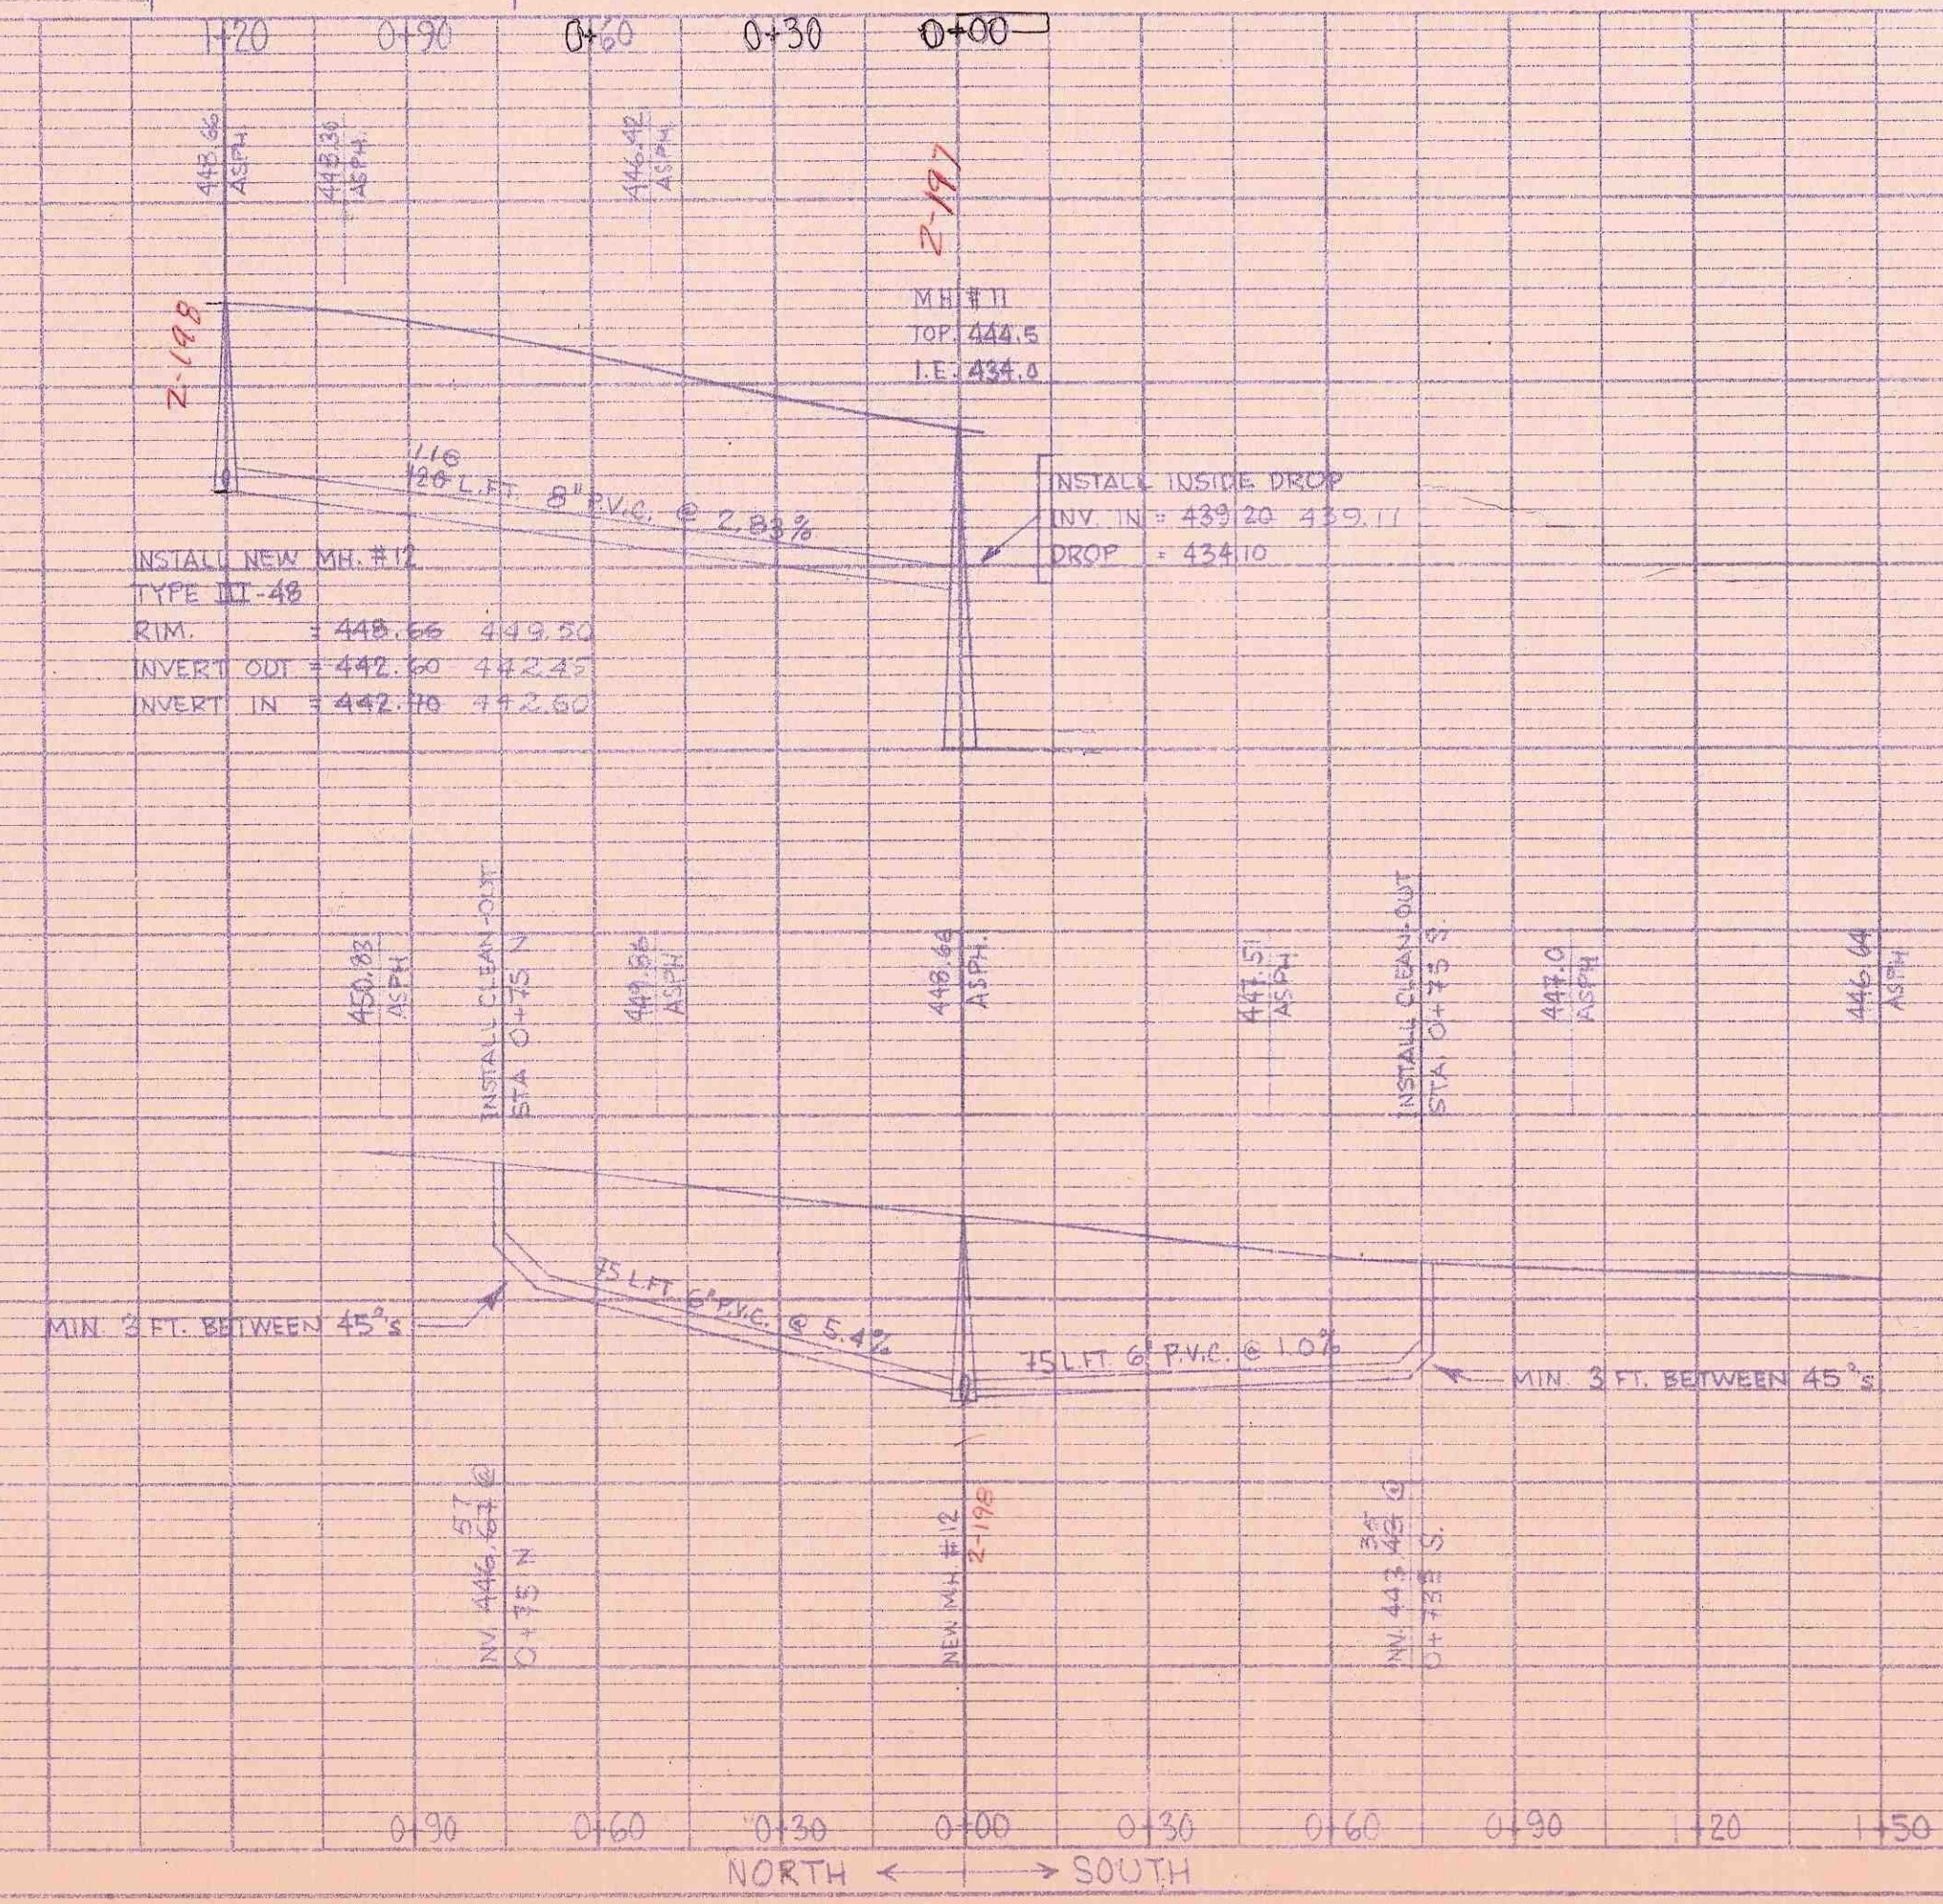

| | | | |
|-------------------------------------|-----------------------------|---------------------|--|
| AS BUILT - MARCH 24, 1982 BY D.E.N. | | | |
| SANITARY SEWER EXTENSION | | | |
| H. SCALE: 1" = 30' | Approved: Joel E. Birkenman | Drawn: Otto Johnson | |
| V. SCALE: 1" = 6' | Date: January 25, 1982 | | |
| 48th Avenue W. & 227th Street S.W. | | | |
| City of Mountlake Terrace 1 of 1 | | | |