
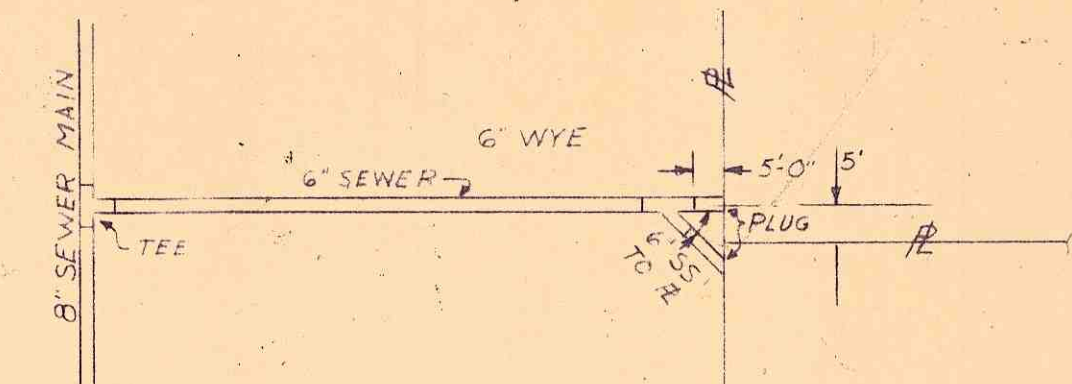


PLAN	BY	DATE
REVISIONS		
NO.		

PROFILE	BY	DATE
REVISIONS		
NO.		

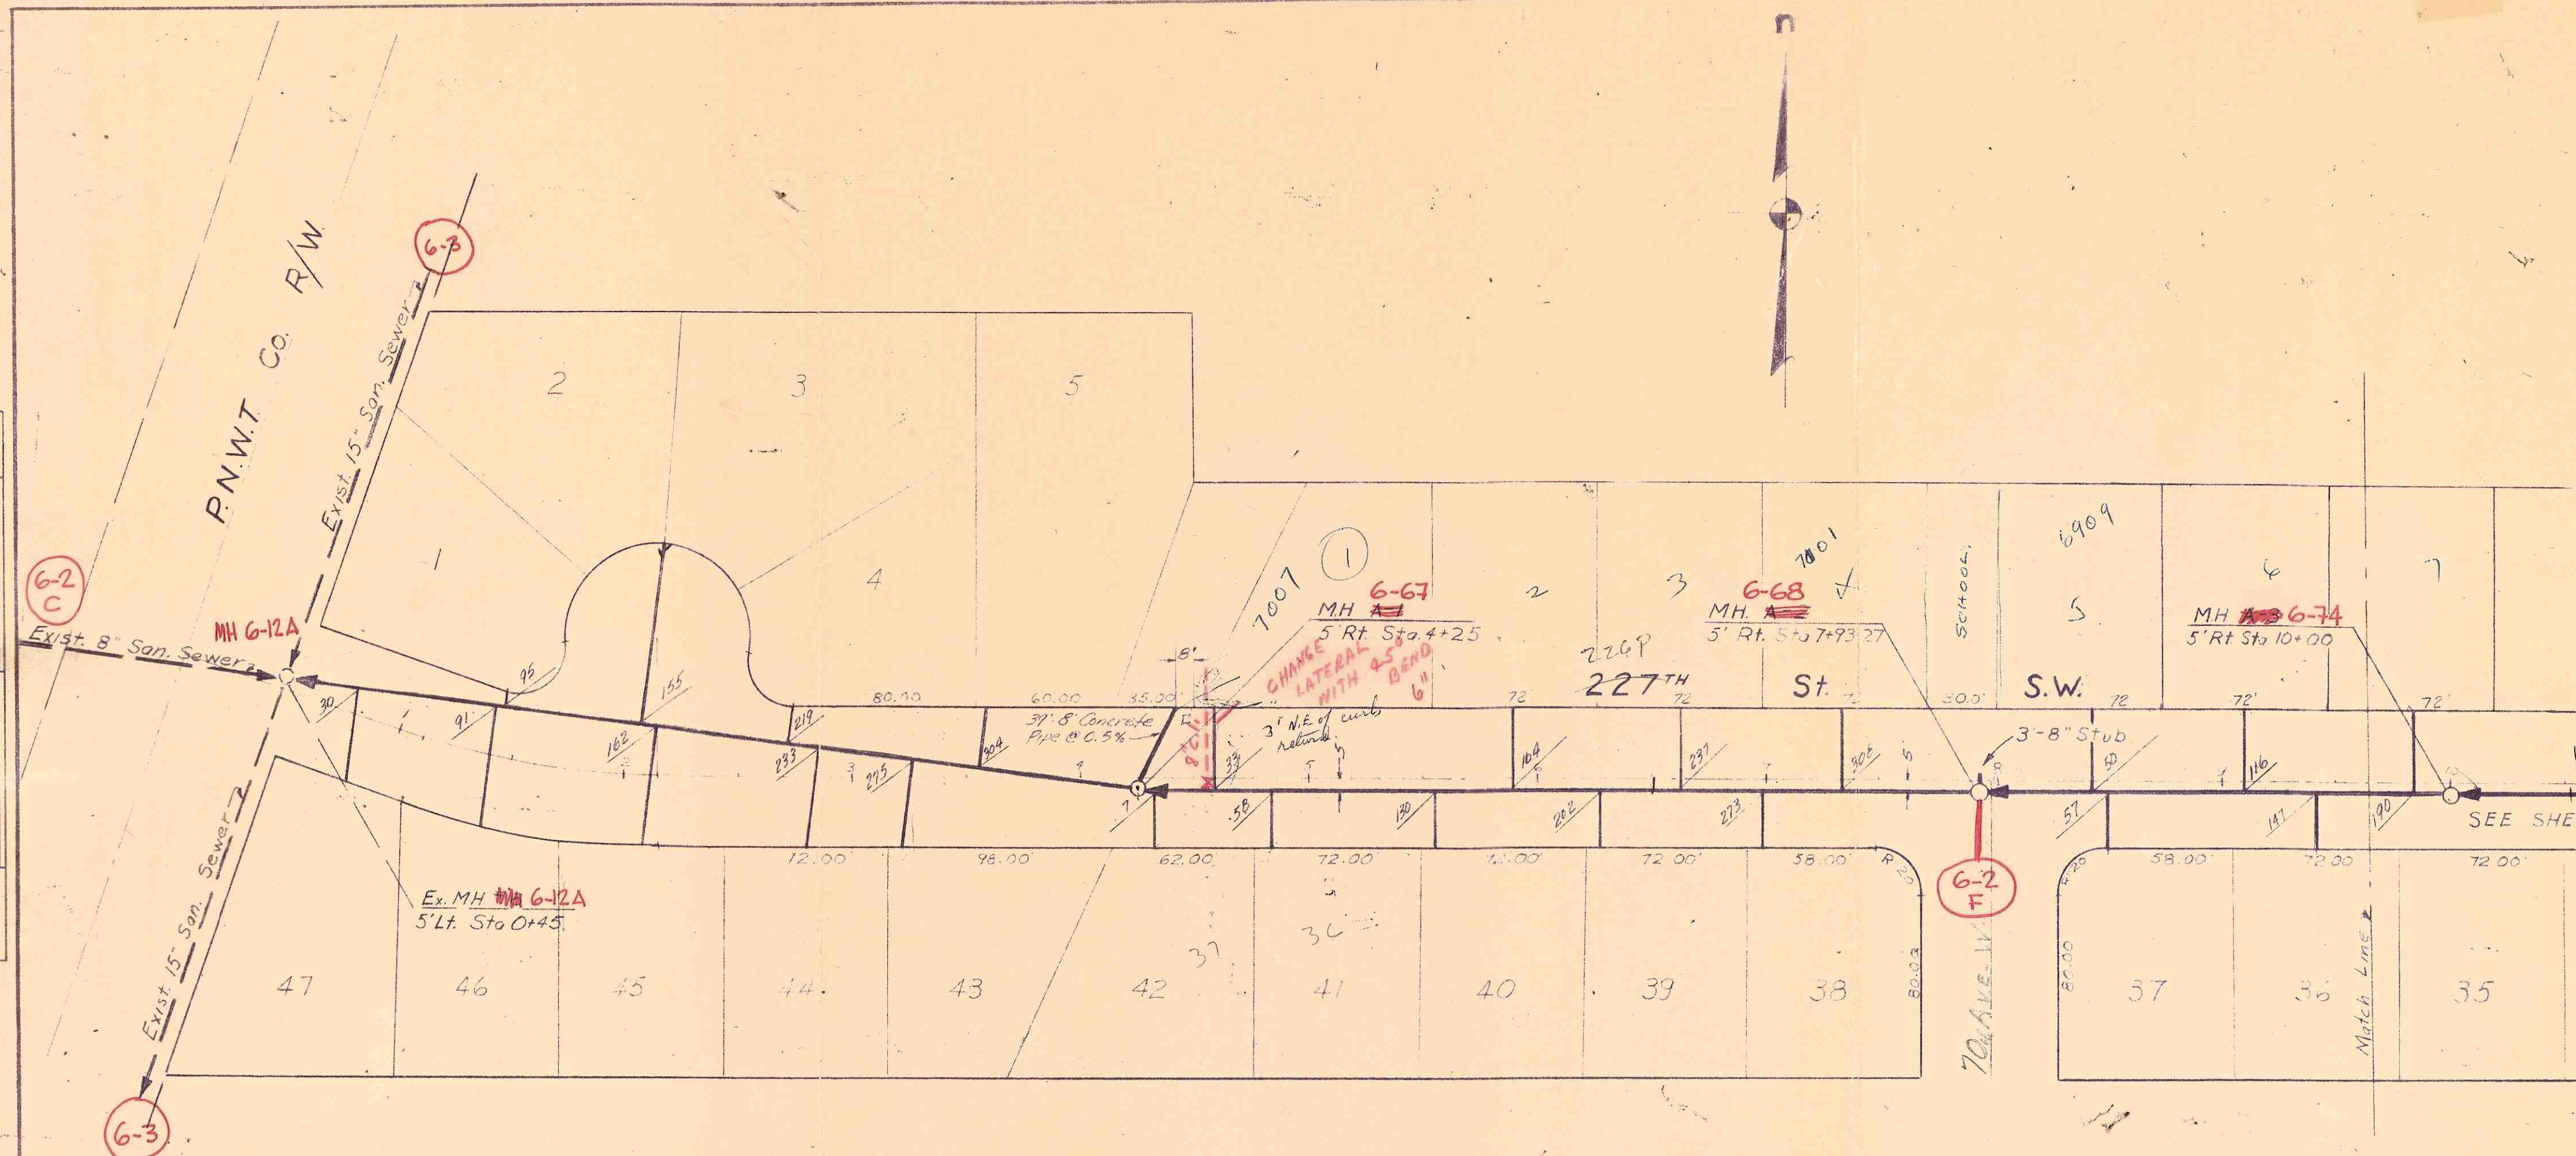

PLAN FOR COMMON SIDE SEWER
NO SCALE

- NOTES:
1. Double side sewer to be constructed as per detail.
 2. Single side sewers to be 6" Dia. to property line.
 3. Minimum slope on side sewers is 2 per cent.
 4. All materials & construction to be in accordance with City of Mountlake Terrace Requirements.

APPROVAL:
By _____ Date: _____
Mountlake Terrace
City Engineer

Scan Name: scans06556.pdf
Scan Date:

NO.	REVISION	DATE	BY
RUSKIN FISHER & ASSOCIATES CIVIL ENGINEERS LAND SURVEYORS SEATTLE, WASH.			
LAKE BALLINGER HOMES NO. 3 SANITARY SEWERS MOUNTLAKE TERRACE WASHINGTON			
DRAWN BY: H.R.H.		SCALE: Vert. 1" = 5' Horiz. 1" = 5'	
CHECKED BY: R.H.C.		DATE: 11-30-62	
APPROVED BY: C.P.Z.		DATE: 12-3-62	
JOB NO. 61704		SHEET 1 OF 2	

