

The City of Mountlake Terrace

APPLICATION

for


SIDE SEWER PERMIT

OUTSIDE ☐ INSIDE ☐ REPAIRS ☐

CARD No. \_\_\_\_\_

EASEMENT No. \_\_\_\_\_

OWNER Elaine V. Moss CONTRACTOR Lynnwood Septic Tank PERMIT No. 3193  
HOUSE No. 4405 STREET \_\_\_\_\_  
AVENUE LOT No. 24 BLOCK No. 243 p.l.s.n.  
NAME ADD. Terrace Ridge

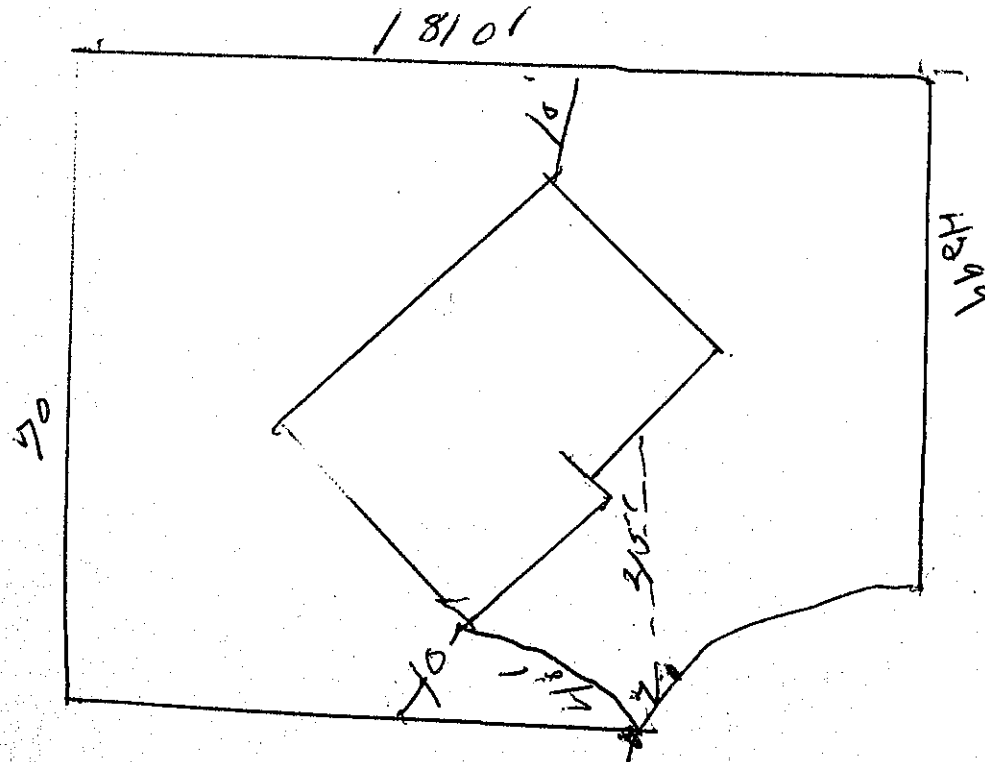

BACKFILL WORK ORDER ISSUED \_\_\_\_\_

Date \_\_\_\_\_

Approved: \_\_\_\_\_

DEPOSIT, \$ \_\_\_\_\_

SEWER WORK ORDER ISSUED \_\_\_\_\_

DATE \_\_\_\_\_

BY \_\_\_\_\_