

# APPLICATION

for

## SIDE SEWER PERMIT

CARD No. \_\_\_\_\_

The City of Mountlake Terrace

OUTSIDE ☐ INSIDE ☐ REPAIRS ☐

EASEMENT No. \_\_\_\_\_

OWNER

*Nord Homes*

CONTRACTOR

*Lynnwood Septic Tank &*

PERMIT No.

*4086*

HOUSE No.

*5504 - 214 SW*


STREET

AVENUE LOT No.

*15*

BLOCK No.

NAME ADD

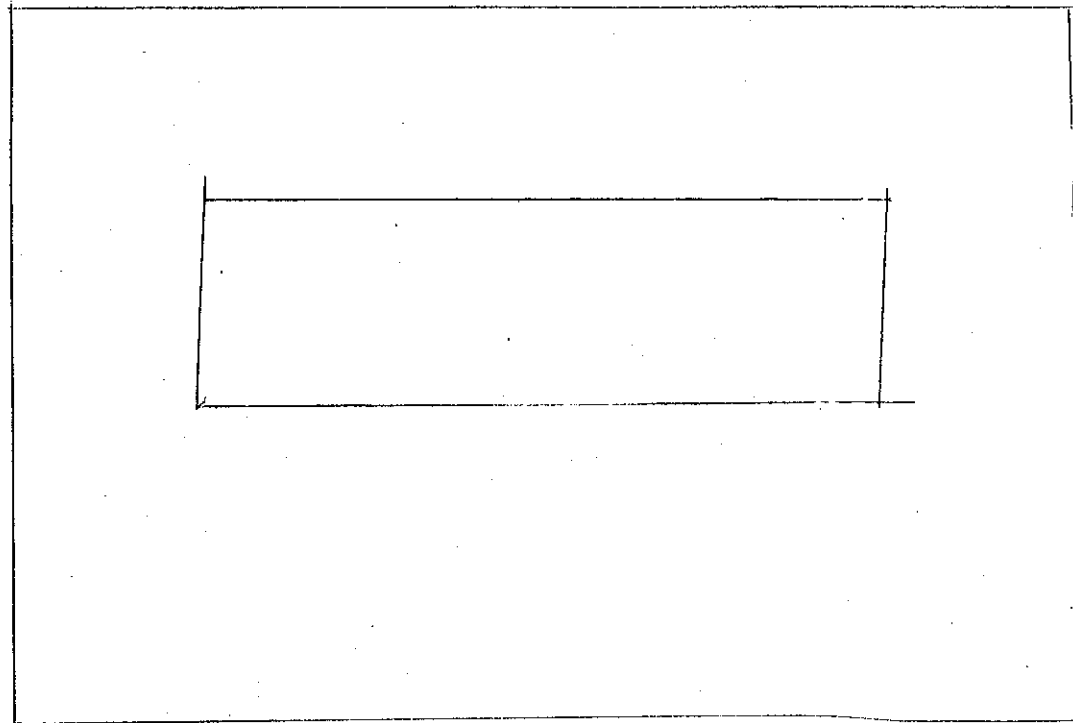

Date

BACKFILL WORK ORDER ISSUED

DEPOSIT, \$

*10 -*  
*[Signature]*

Approved:

SEWER WORK ORDER ISSUED

DATE

BY