
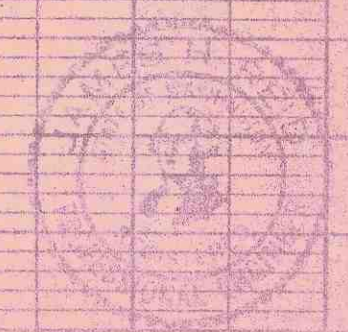


PROFILE	SURVEYED	BY	DATE
NOTE BOOK	PLOTTED	<i>P.L.</i>	<i>1-17-62</i>
<i>416-49</i>	GRADES CHECKED	<i>P.L.</i>	<i>1-18-62</i>
NO.	B. M. NOTED		
	STRUCTURE NOTATIONS CHECKED		

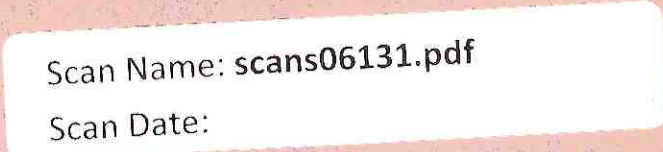

AS BUILT DRAWING

PLATE 1-PLAN-PROFILE-F.A.S.
CLEARPRINT PAPER CO. S.F.CAL.
No. 1000H-1

JAMES H. REID & ASSOCIATES
CONSULTING ENGINEERS, 324 MAIN ST., EDMONDS, WASH.