


PLAN	DATE
REVISIONS	BY
NOTE BOOK	PLANNED
NO.	ALIGNMENT CHECKED
	NO. OF WAY CHECKED

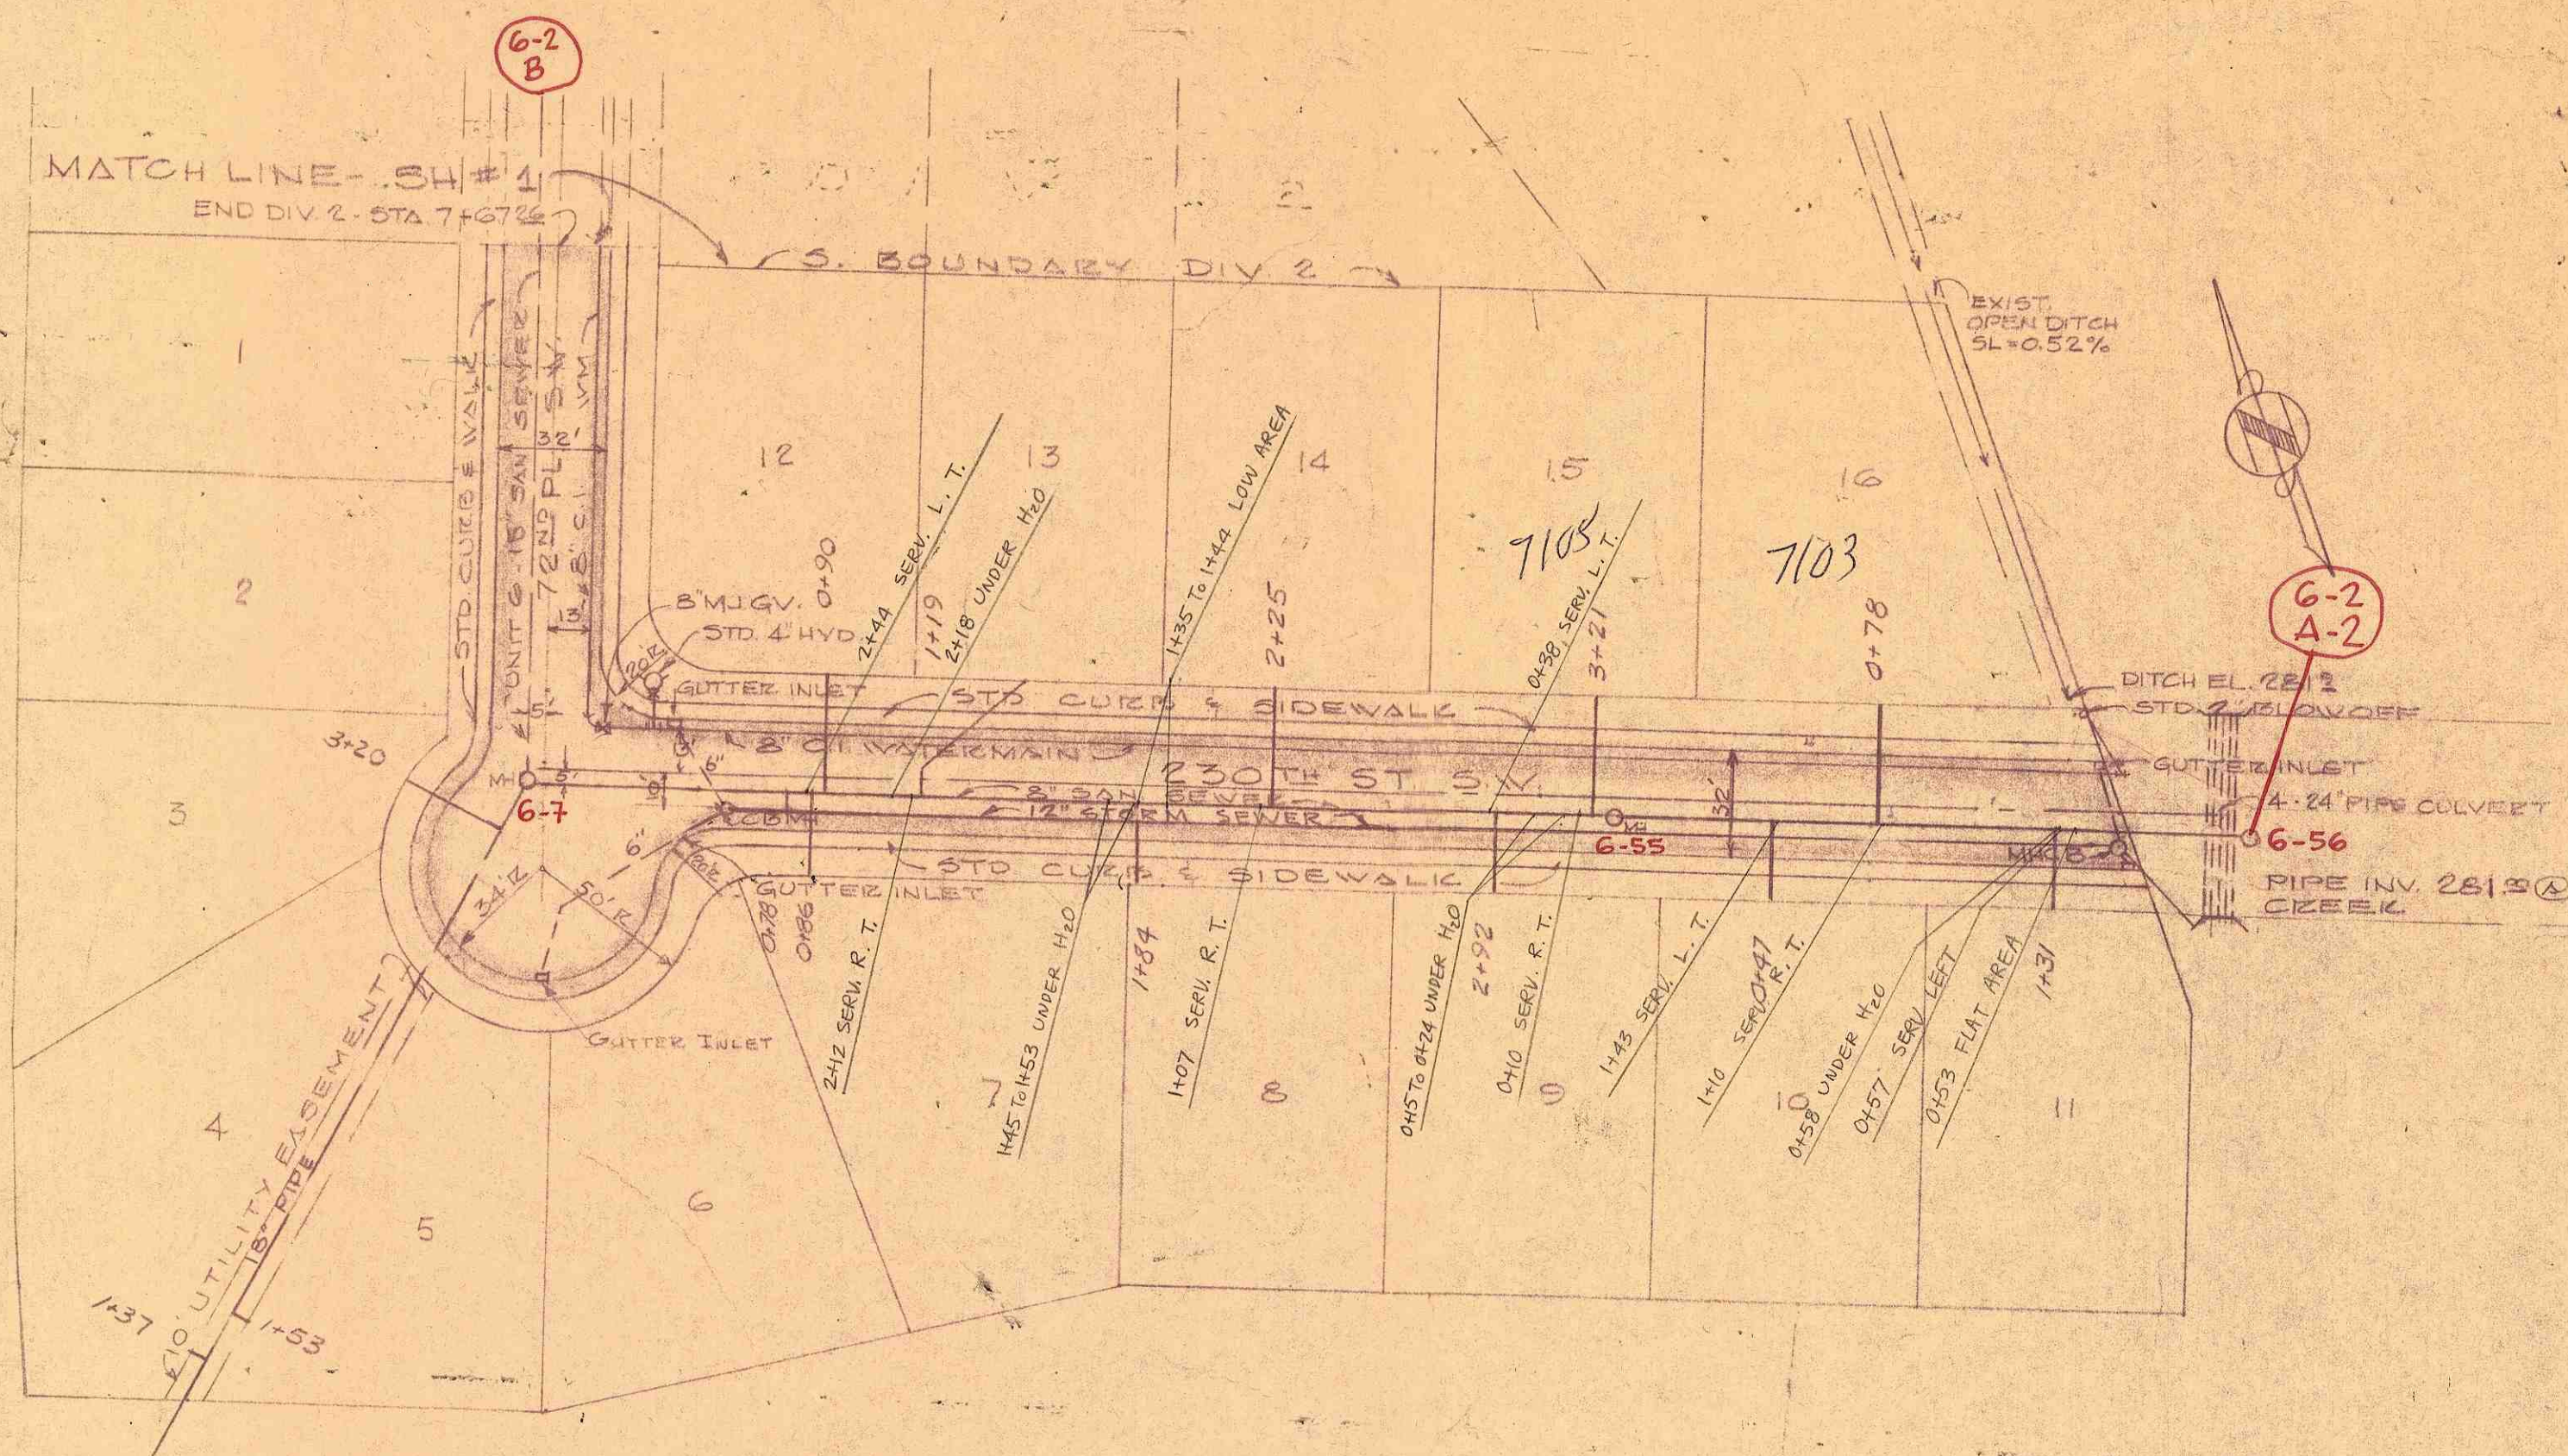

Scan Name: scans06548.pdf
Scan Date:

3	ADDED AS BUILT DATA
2	EXTENDED 3' WATER BEYOND PAVEMENT
1	ADDED 12" STORM SEWER, ETC.
NO.	REVISIONS
CITY OF MOUNTLAKE TERRAZA	
CURBS, SIDEWALKS, STREET PA	
8" 6" 4" C.I. WATER MAINS, SANITARY	
STORM SEWERS	
LAKE BALLINGER ESTATES - DIV.	
REID, MIDDLETON & ASSOCIATES	
CONSULTING ENGINEERS & LAND SURVEYORS	
324 MAIN STREET	
EDMONDS, WASHINGTON	



AS BUILT DRAWING

PROFILE	DATE
REVISIONS	BY
NOTE BOOK	PLANNED
NO.	ALIGNMENT CHECKED
	NO. OF WAY CHECKED

