APPLICATION
for
SIDE SEWER PERMIT

The City of Mountlake Terrace

OUTSIDE ☐   INSIDE ☐   REPAIRS ☐

CARD No. _____

EASEMENT No. _____

OWNER __Leon. C. Allison__   CONTRACTOR __Thunderbirds__   PERMIT No. __108__

HOUSE No. __5005 236th SW__   STREET AVENUE LOT No. __12__   BLOCK No. __10__

NAME ADD. __Div. 11__

Proposed Sewer Line to be constructed of the following materials:
4" Concrete Pipe
Rubber Gaskets Joints.

Cleanout   Cleanout

60'   70'   170'   20'   3'   3'   24   32   55'   11'   17   26   60'
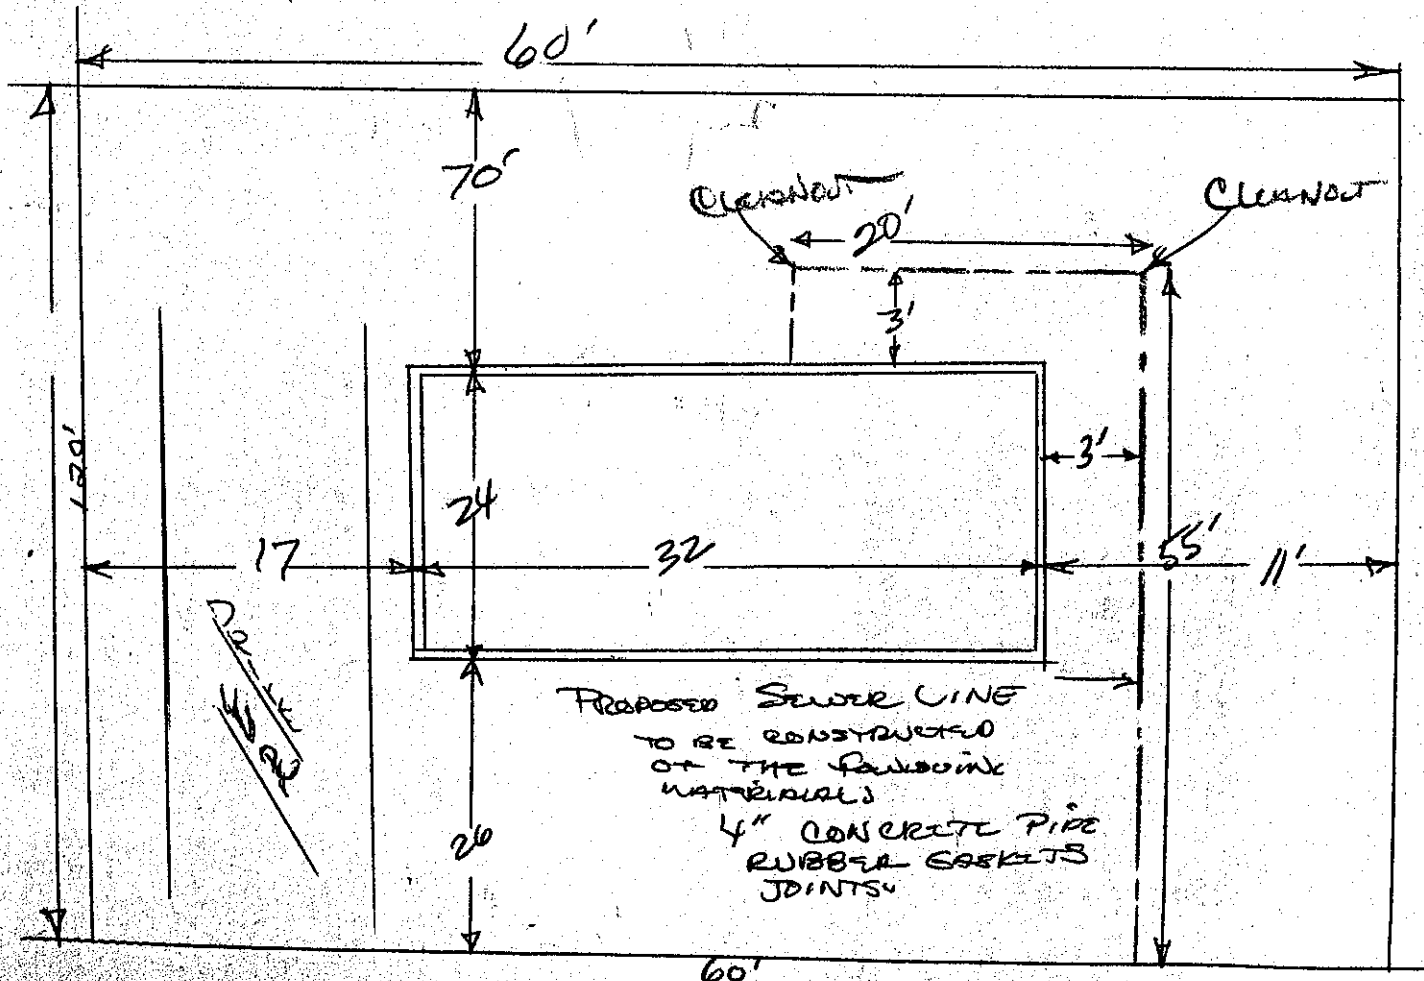
BACKFILL WORK ORDER ISSUED _____   DEPOSIT $10.00   Date 5/26/60   Approved:

SEWER WORK ORDER ISSUED _____   1541   DATE 5/31/60   BY _____