


NE 1/4, SEC 33, TWP 27N., R. 4E., W.M.

WOODLARK NO. 2 - DIV. C

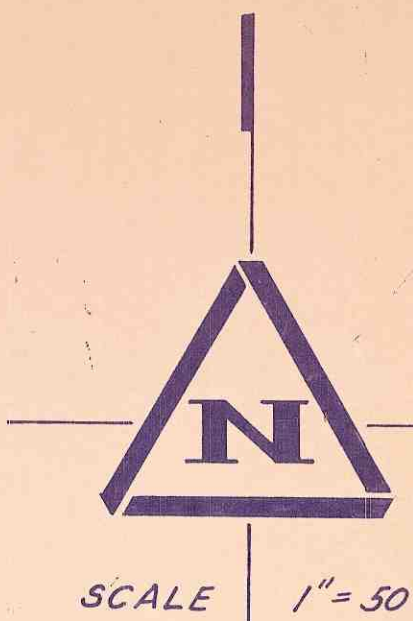

GENERAL NOTES

- 1- ALL WORK AND MATERIALS SHALL CONFORM TO THE STANDARDS AND SPECIFICATIONS OF THE CITY OF MOUNTLAKE TERRACE (A.P.W.A. - 1975 EDITION), AS APPROVED BY THE WASH. STATE DEPT. OF ECOLOGY AND THE DIVISION SOCIAL AND HEALTH SERVICES.
- 2- THE CONTRACTOR SHALL VERIFY SIZE, LOCATION, AND ELEVATION OF EXISTING UTILITIES PRIOR TO CONSTRUCTION TO AVOID DAMAGE OR DISTURBANCE.
- 3- TOPS OF MANHOLES WITHIN RIGHTS-OF-WAY SHALL NOT BE ADJUSTED TO FINAL GRADE UNTIL JUST PRIOR TO PAVING. TOP ELEVATIONS FOR MANHOLES IN EASEMENTS SHALL BE SET IN FIELD.
- 4- ALL SIDE SEWERS ARE TO BE LAID ON A MIN. OF 2% (PERCENT).
- 5- ALL PVC (POLYVINYL CHLORIDE) SEWER PIPE & FITTINGS SHALL CONFORM TO ASTM D-3034 (SDR 35) SPECIFICATIONS. BEDDING TO BE CLASS B. ALL D.I.P. (DUCTILE IRON PIPE) SHALL CONFORM TO AWWA-C151 AND BE CEMENT LINED WITH PUSH-ON JOINTS. BEDDING TO BE CLASS B.
- 6- ALL TESTING SHALL BE DONE IN THE PRESENCE OF A REPRESENTATIVE OF THE CITY OF MOUNTLAKE TERRACE.
- 7- IT SHALL BE THE CONTRACTORS RESPONSIBILITY TO SECURE ALL PERMITS PRIOR TO STARTING CONSTRUCTION.


SHEET
1
REVISIONS

TRIAD ASSOCIATES
846-108th Ave. NE Bellevue, Wa. 98004
454-0711

SANITARY SEWER PLAN & PROFILE
CEDAR TERRACE NO. 2
CITY OF MOUNTLAKE TERRACE
SNOHOMISH COUNTY

Date: APRIL 18, 1977
Designed: A. VASSET
Drawn: A. VASSET
Checked: A. VASSET
Project Manager: A. VASSET

JOB NO.
77-014

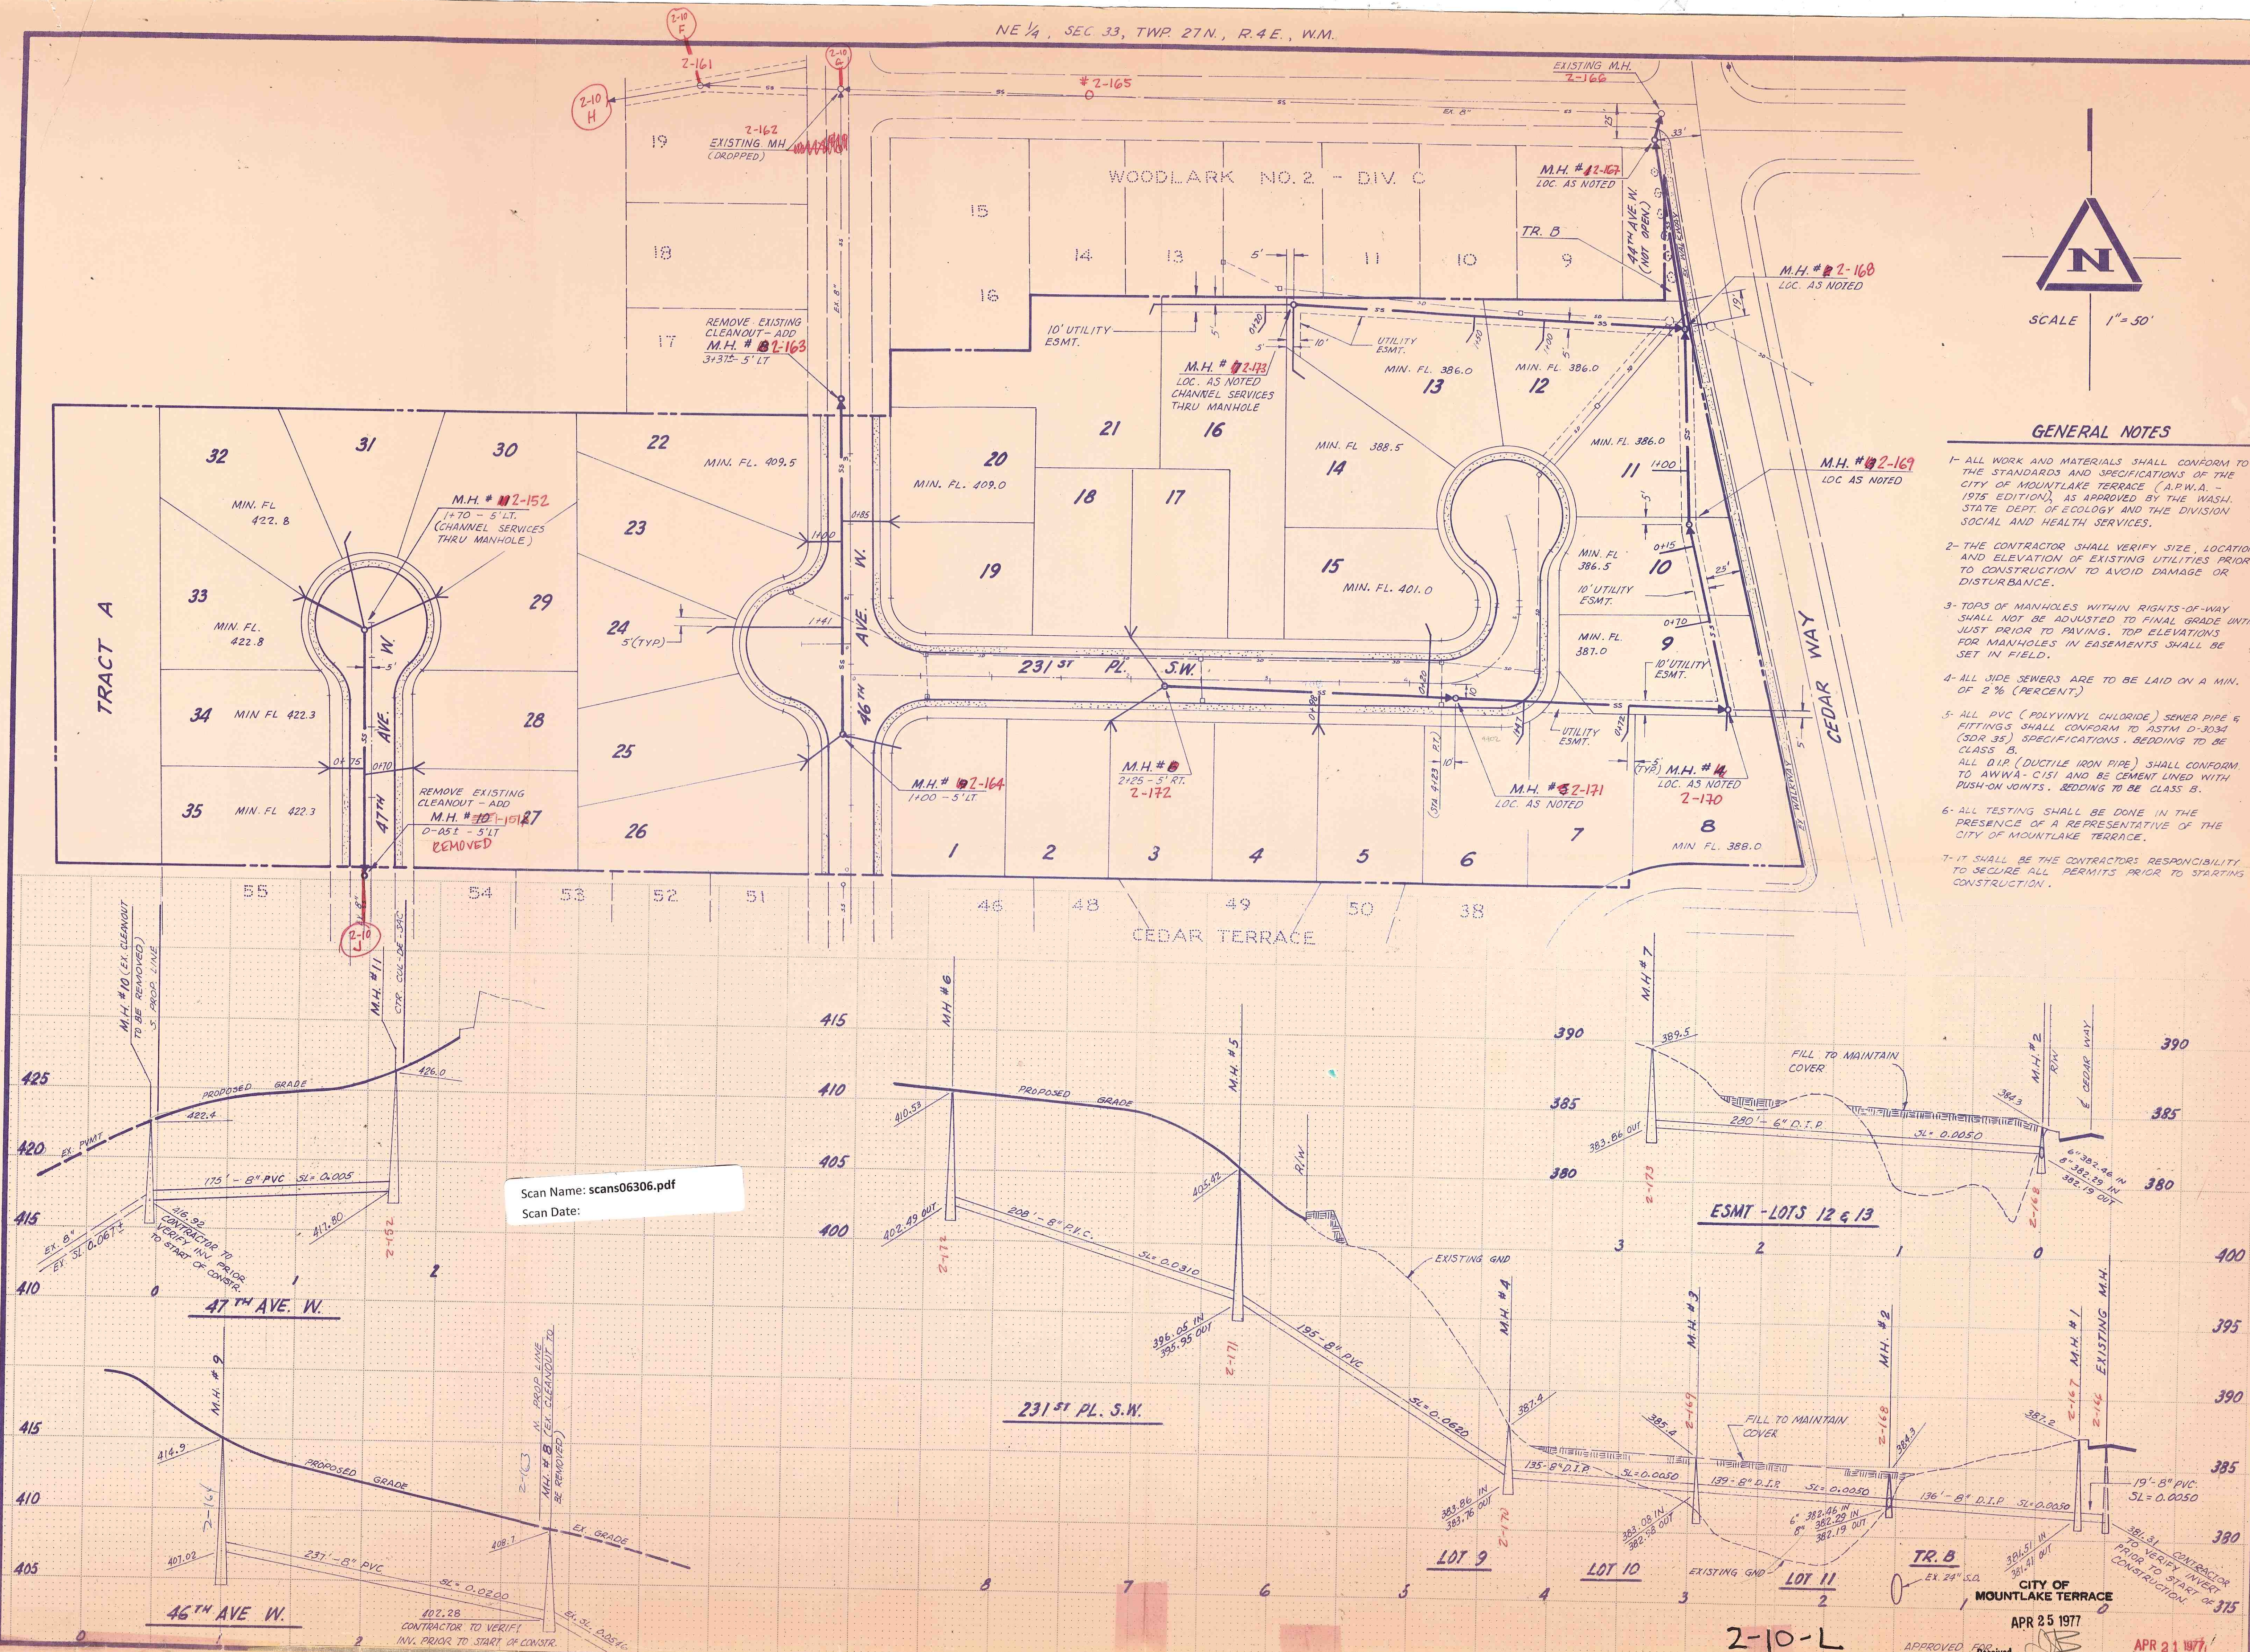

Scan Name: scans06306.pdf
Scan Date:

2-10-L

APPROVED FOR CONSTRUCTION
CITY OF MOUNTLAKE TERRACE
APR 25 1977
APR 21 1977