


PROFILE	SURVEYED	BY	DATE
	PLOTTED GRADES CHECKED B. M. NOTED STRUCTURE NOTATIONS CH'KD. NO.		

MELODY HILL SCHOOL

Scan Name: scans06584.pdf
Scan Date:

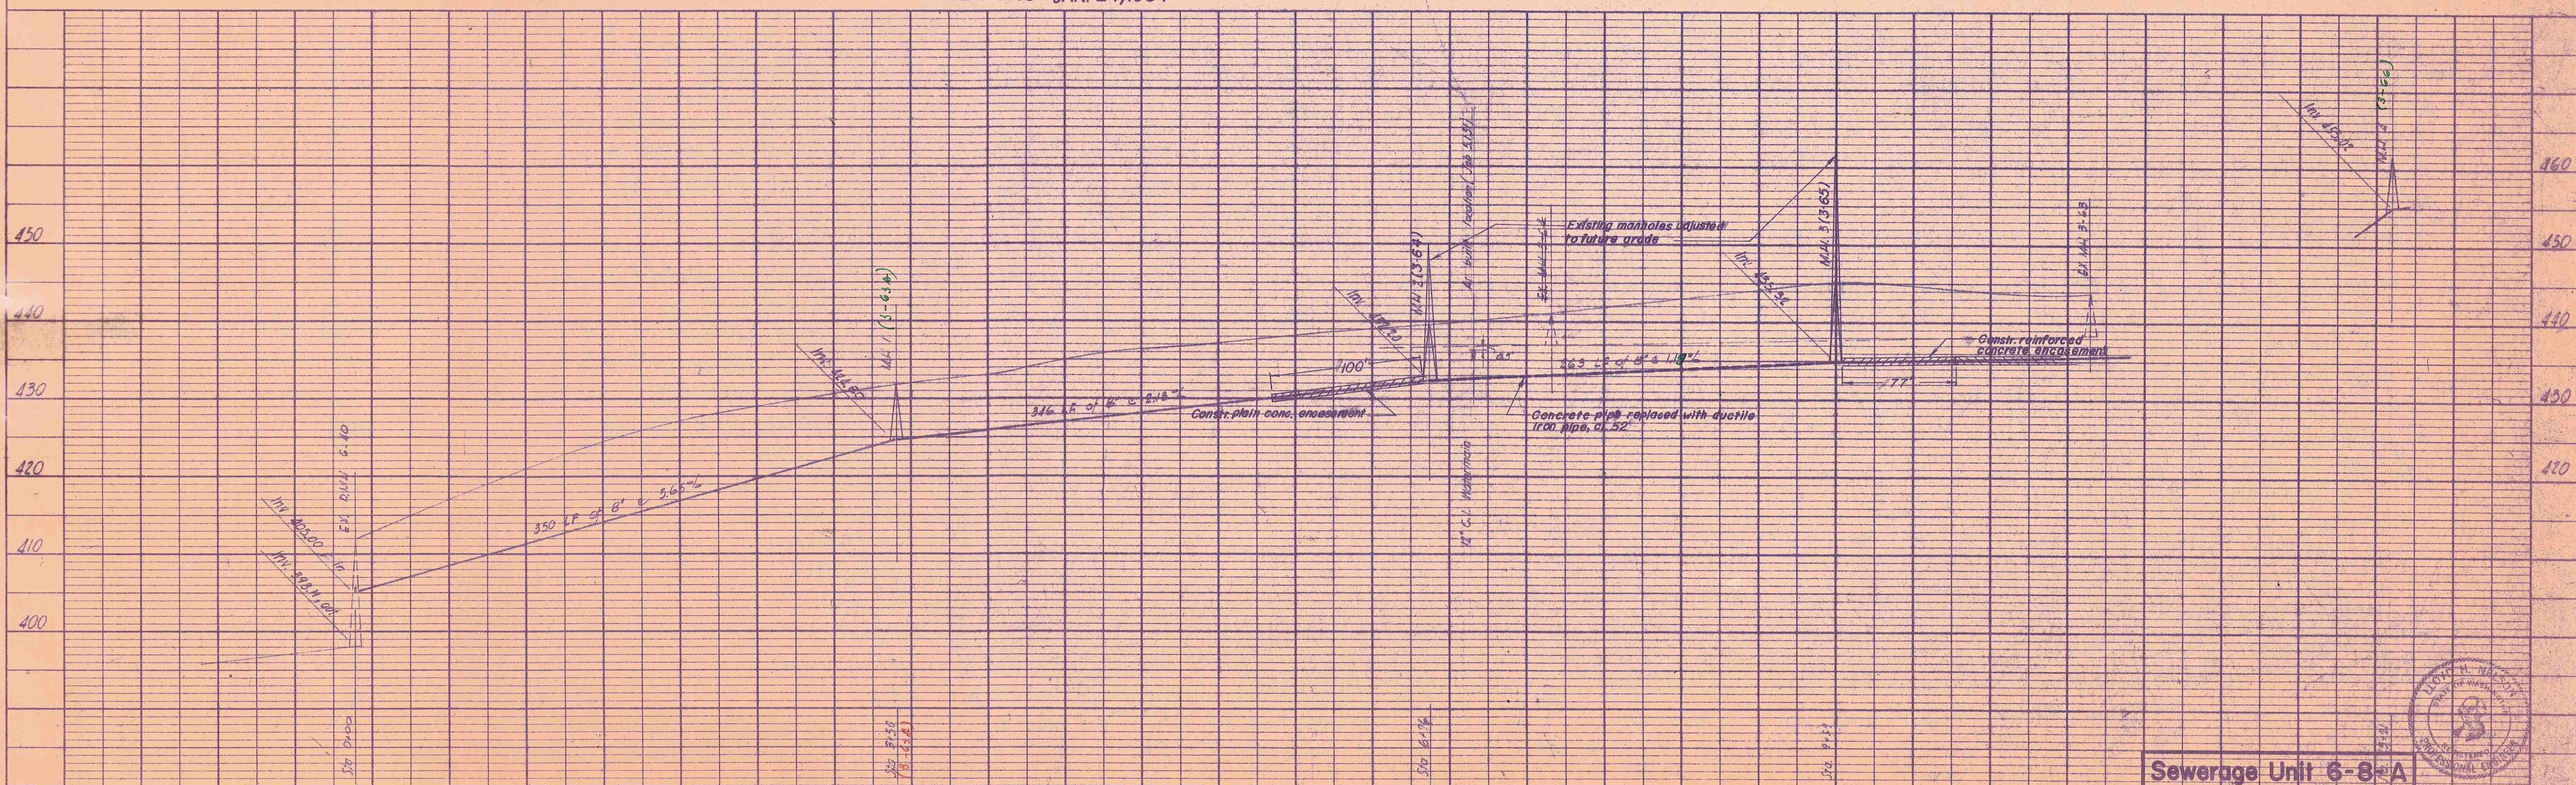

Sewerage Unit 6-8-A

PLATE 1-PLAN-PROFILE D.P.R. & R.E. STANDARD
100% AGEPROOF VELLUM—MADE AND PRINTED IN U.S.A.
EUGENE DIETZGEN CO.

REID, MIDDLETON & ASSOCIATES, INC.
CONSULTING ENGINEERS & LAND SURVEYORS, 324 MAIN ST., EDMONDS, WASH.

DESIGN LUN	DRAWN J	CHECKED LUN	DATE 1/17/62	H. SCALE 1"=50'	FILE NO. 5186-06
				V. SCALE 1"=10'	SHEET 6 OF 7

AS BUILT DRAWING

CITY OF MOUNTLAKE TERRACE

FREEWAY UTILITY RELOCATION
AREA V SHEET 2 OF 2 330' CB CIVIL UNDERGROUND