

Scan Name: scans06509.pdf  
Scan Date:

DATE	12-17-59
BY	CH
SURVEYED	PLAN
NOTE BOOK	ALIGNED CHECKED
NO.	15-2

DATE	12-17-59
BY	CH
SURVEYED	PLAN
NOTE BOOK	ALIGNED CHECKED
NO.	15-2

DATE	12-17-59
BY	CH
SURVEYED	PLAN
NOTE BOOK	ALIGNED CHECKED
NO.	15-2

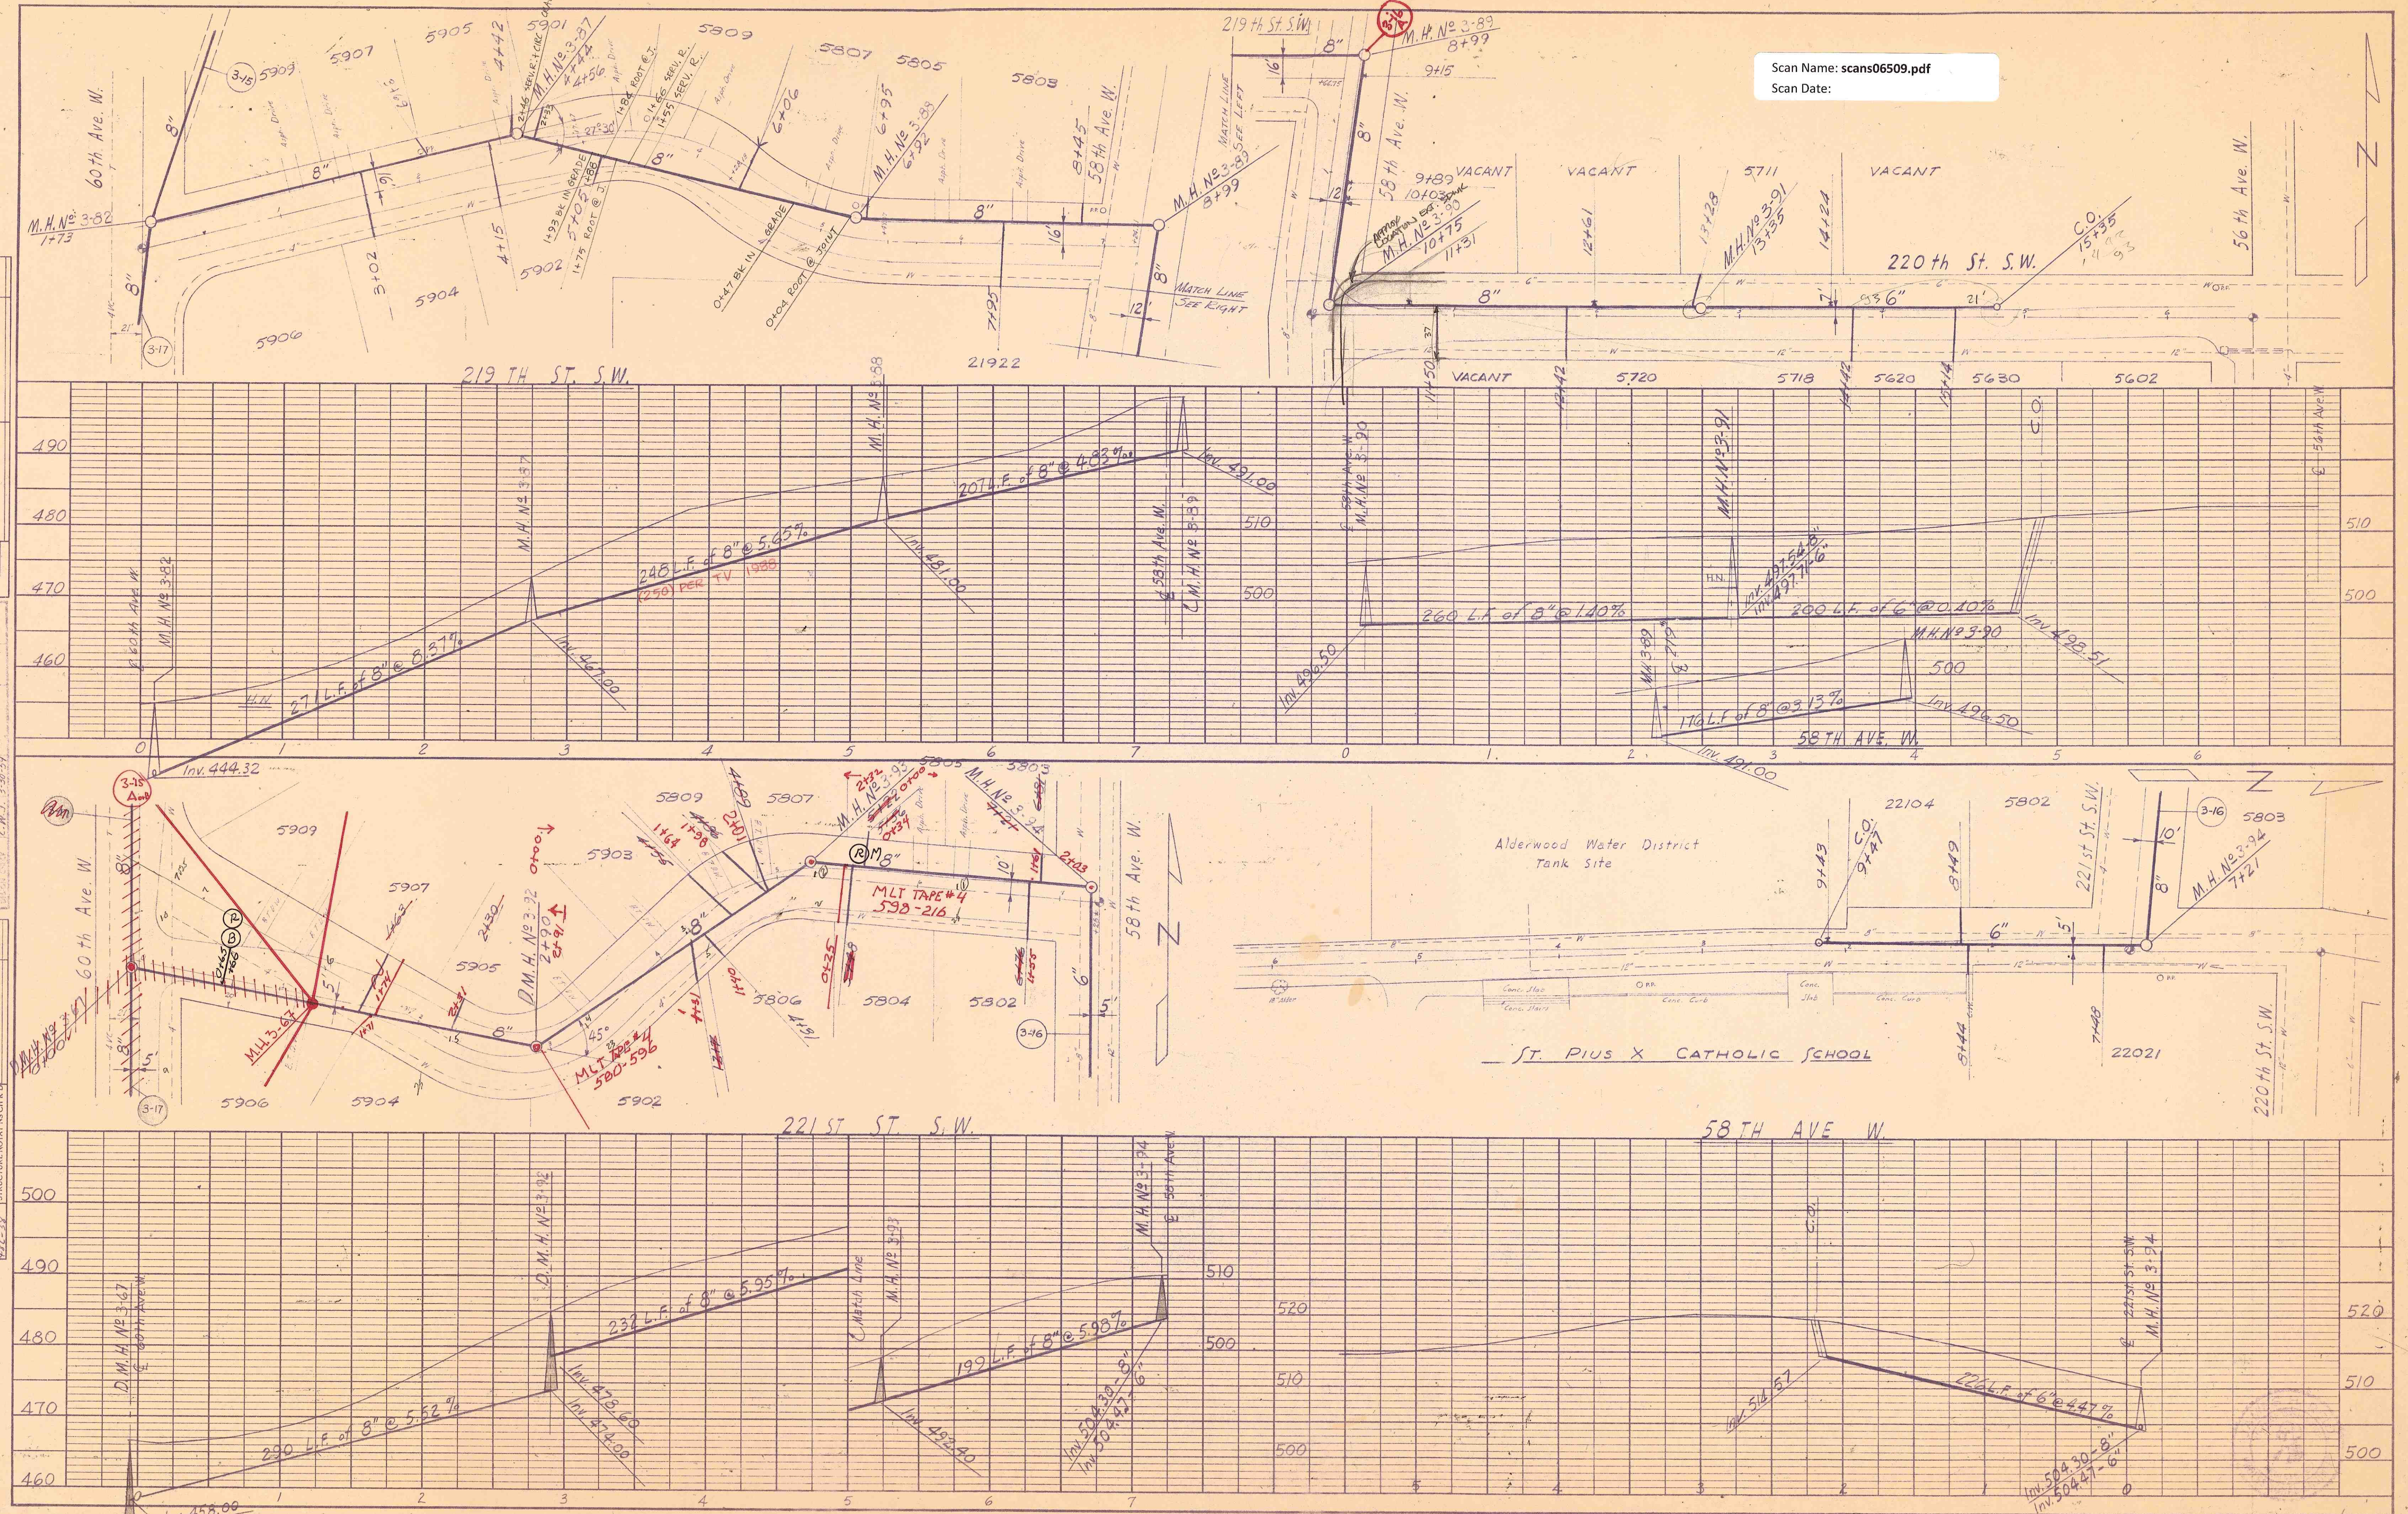


PLATE 2-PLAN-PROFILE 4 x 5  
CLEARPRINT PAPER CO. S.F. CA.  
No. 100092

JAMES H. REID & ASSOCIATES  
CONSULTING ENGINEERS, 324 MAIN ST., EDMONDS, WASH.

DESIGN	DATE	H. SCALE	FILE NO.
LN.	3-30-59	1"=50'	5,50/3-16
DRAWN		V. SCALE	
HH-DR		1"=10'	
CHECKED			
LN.			
SHEET 16 OF 19			

AS BUILT DRAWING

CITY OF MOUNTLAKE TERRACE  
SEWERAGE SYSTEM  
UNIT 3