22425 72nd ave. W.

Mount lake Terrace

S.S.M.H.

6" S.S.C.O.

Water Meter

Property corner

"B"
Property corner

6"x4" Reducer

2-4" 45° bends

4" C.O.

A"

Deck

Property corner

Measurements from Point "A"
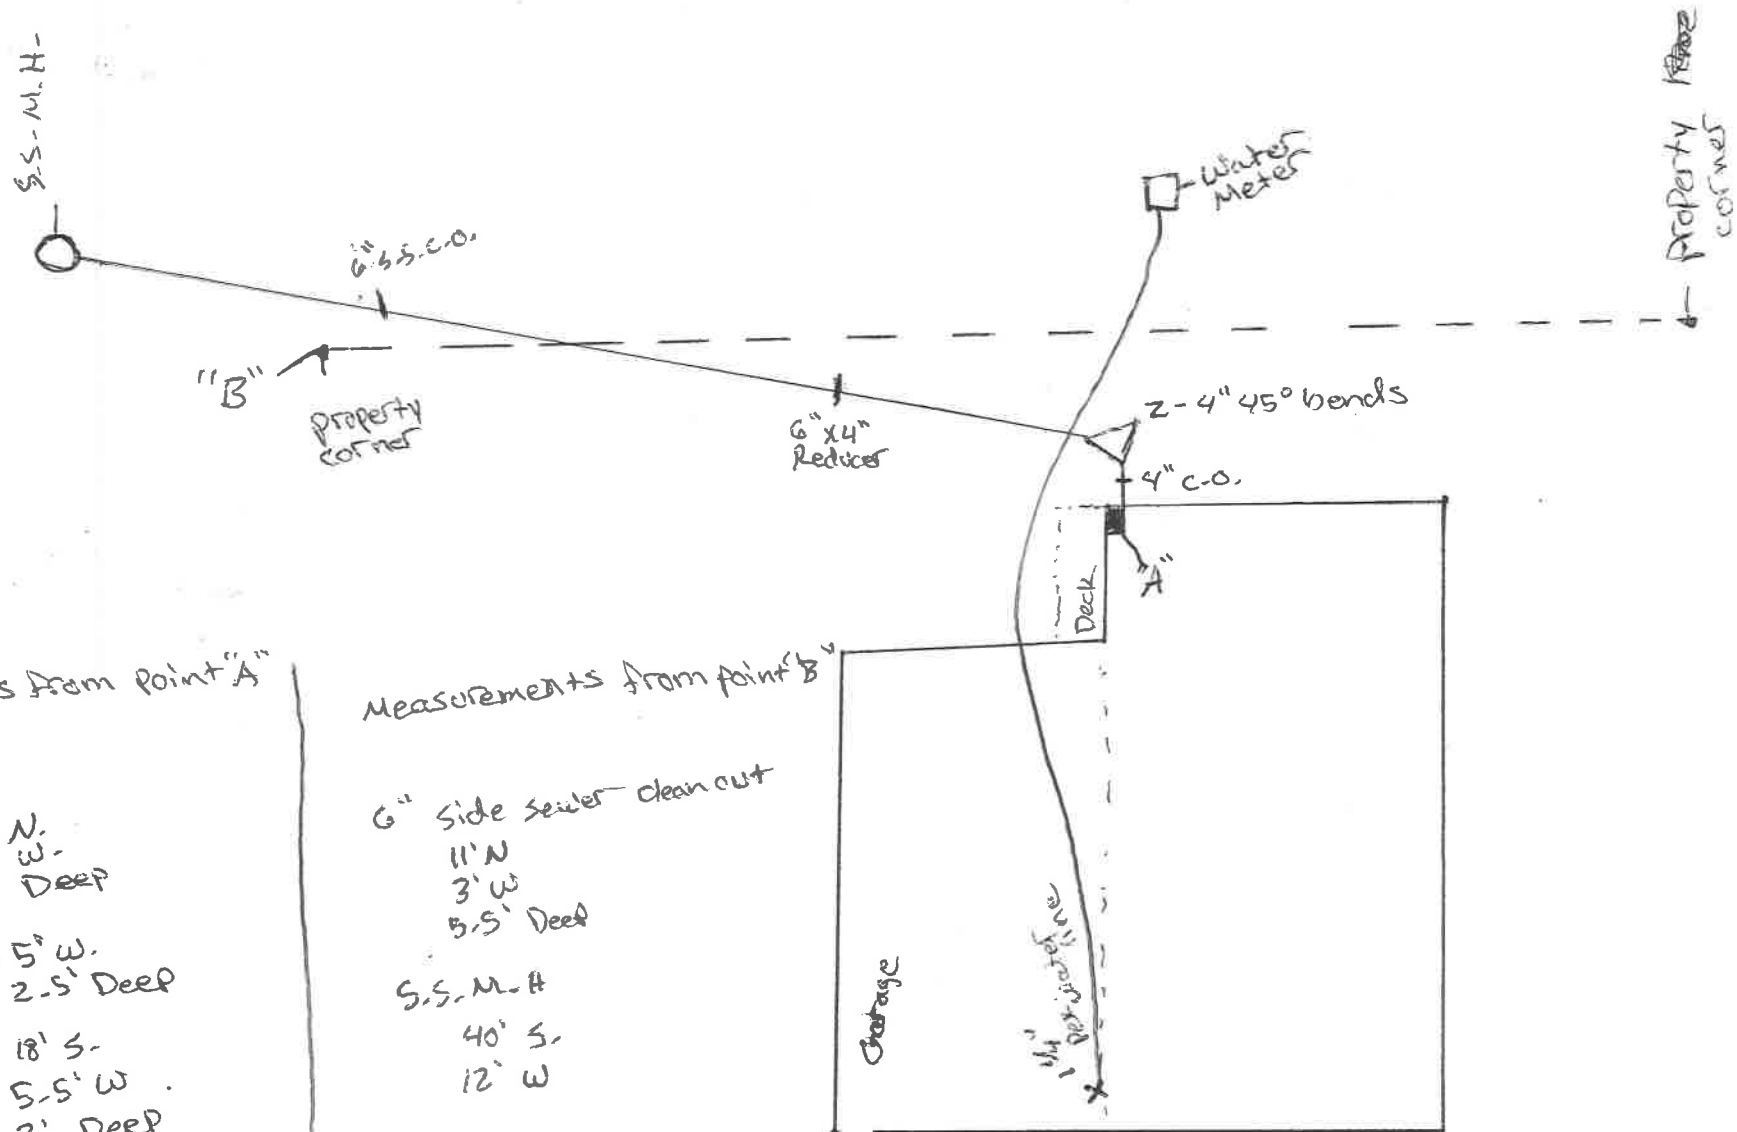
Measurements from point "B"

4" C.O. = 1.5' N.
1.5' W.
2.5' Deep

2 4" 45° bends = 5' W.
2.5' Deep

6"x 4" Reducer = 18' S.
5.5' W.
3' Deep

6" Side sewer clean out
11' N
3' W
5.5' Deep

S.S.M.H
40' S.
12' W

Footage

1'4" Perk water line